

OFFICE OF COUNTY ENGINEER
RAMSEY CO. MINN.

Road Map Survey

RICE CREEK RD.

From West Co. Line To New Brighton Rd.

Road Acc't. No. 22

Date Filed 9-12-25

File

of Ramsey Co. Engineer
ST. PAUL, MINN.

Date Filed 9-12-25

File No.

Alignment

S. H. #62

Rice Creek Road
from W. County line
to the New Brighton Road

Station Point Lt. Δ Rt. Corr.
Bearing


24+00 P.I. 00 04'

22+37⁵⁰ P.O.T. sec line.

N 89° 14' E ✓

0+00



Party { H.L. Wilshusen P.
 D. Skooglund H.C.
 A. Berthigume R.C.
 K. Rexford Stake
 8/11/12/25

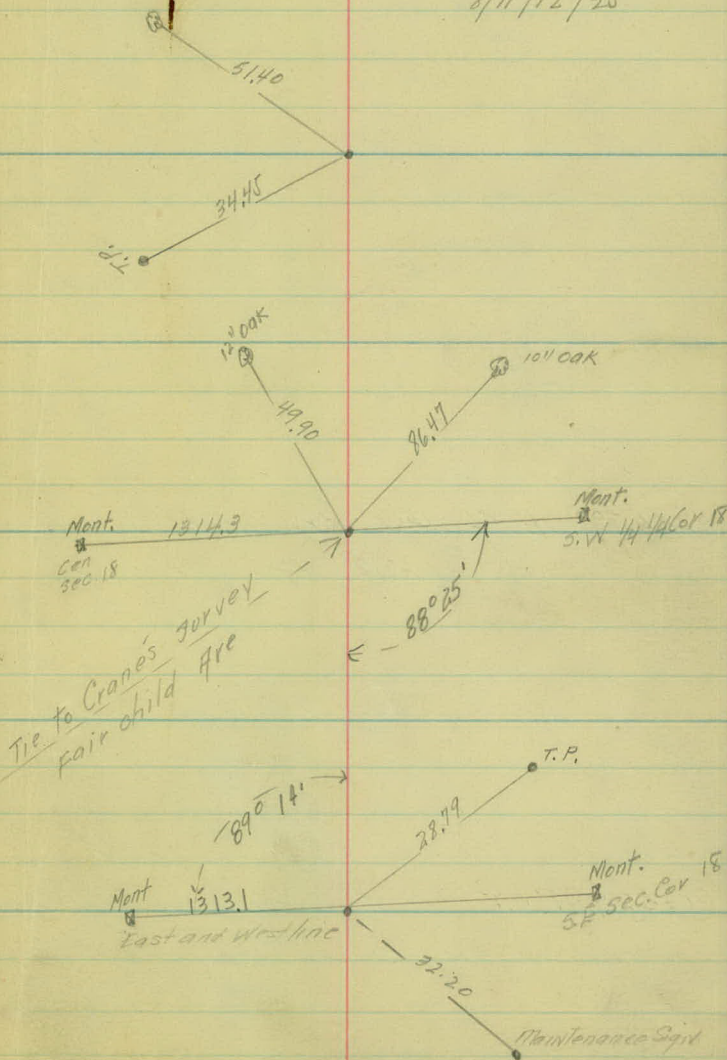


Station	Point	At.	Δ Rt.	Calc. Bearing
---------	-------	-----	-------	------------------

42+05 ⁰⁰	± of New Brighton Road			
	End of Survey			

30+52.9 P.O.T

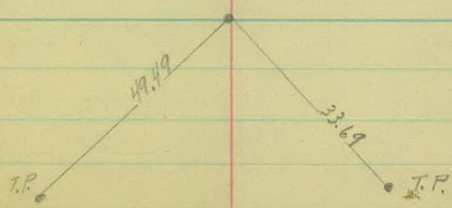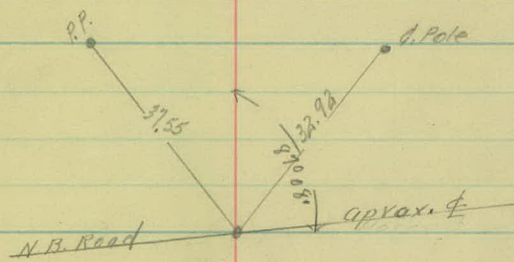

 

Topography

S. H. # 62

Rice Creek Road
From W. Co. line
to the New Brighton Road

6+00

5+00

4+00

3+00

2+00

1+00

0+00

H.L. Wilshusen
 Skookum H.C.
 Bernhart R.C.
 Rexford S.A.

8/11/25
 Warm -

✓ 3-L 10'

FL 28' SL 11' ✓

Cultivated

Cultivated

FL 29' ✓

✓ 265- Fence 20' E. of Pasture

Pasture

Cultivated

FL 29' ✓

✓ 178 Cross drain 30' W. 20' N. 20' N.E.

✓ 128- + Fence 30' E. of Cult

FL 28' ✓

✓ 3-L 10'

Cultivated

FL 29' ✓

✓ 106- Main Sign 19'

+ 25- N. 18' x 15'
 S-L 11
 + 10- FL 29'
 C.M. 18' - 20' x 15'
 103- 8' drive
 + 04- Fence 45'
 - 15- 30'

13+00

12+00

11+00

10+00

9+00

8+00

7+00

6+00

B- of Cult.
+69. E. of Orchard 28'

- ✓ +20. B- of Orchard 28'
- ✓ +18. P.P. 19'
- ✓ +18. E- of F yard
- ✓ +91. E drive 12'

- ✓ +79. P.P. 19'
- ✓ +70. E drive

+48. E. of F.L. 20'

3L. 10. F.L. 23'

- ✓ +65. P.P. 18'
- ✓ +46. F. Cor. 25'
- ✓ +27. E drive

✓ +56. T.P. 19'

✓ +57. E. of Cult.

Brush, farm yard and trees

Cultivated

Pasture

+28. T.P. 31'
+12. E drive
F.L. 36'

F.L. 30'
+92. T.P. 31'

Pasture

3L. 12. F.L. 30'

+42. T.P. 31'
+27. F.L. 27'
F.L. 23'

Pasture

F.L. 24'
+94. Cross drain
22.5 ft. 15" C.M.
16.5 ft.
39 0

F.L. 25'

+79. F.L. 27'
E. of Cult.

F.L. 27'

20+00

19+00

18+00

17+00

16+00

15+00

14+00

13+00

8/11/25

✓ 491 S.H. Marker 12.462
 ✓ +86-E.P. 27'
 ✓ +76-E drive

✓ FL. 23'

✓ +57-E.P. 21'

FL. 23'

✓ +29-E.P. 21'

FL. 23'

+24 Tree
 +15 Tree 18'
 FL. 22'
 +98-E.P. 20'

SL. 10 FL. 21

✓ +70-FL. 21'
 ✓ +67-E.P. 20'

✓ +39-P.P. 20'

Cultivated

Cultivated

Cultivated

+23 T.P. 31' ✓

+06-E drive ✓

+82-Cross drain
 16' AP 15" C.M.
 145 Lt.
 30

Hay Meadow

+81-T.P. 31' ✓

Hay Meadow

+45-T.P. 31' ✓

+74-E.G.P. 32' ✓
 E. of Pasture ✓

SL. 110'
 FL. 32 - T.P. 31' ✓

FL. 35' ✓

+77-T.P. 31' ✓

Pasture

SL. 31' ✓

27+00

26+00

25+00

24+00

23+00

22+00

21+00

20+00

8/11/25

✓ 131-E.P. 23'

✓ E. of Woods

Cultivated

Woods

✓ 105-E.P. 23' S.L. 10'

Woods

✓ 174-E.P. 23'
✓ 170-B. of Woods

Hay Meadow

✓ 140-E.P. 26'

✓ 140-E.P. 23'

✓ E. of Cult.

F.L. 29'

Cultivated

✓ 112-E.P. 24'
✓ F.L. 28'

✓ P.V. 25' S.L. 10'

Woods

114 T.P. 31

113-Cross drain N.W.

18' Ht. 15' Lt. C.M.

E. of Swamp-Woods

Swamp

S.L. 12'

166-T.P. 31'

X

152 S.H. ⁴⁶² ~~14~~

Woods and Swamp

123-T.P. 32'

137S
d. Fairchild Ave

154-S. drain 17S

grave / Road

25' W.

122-S. drain 18S

32' x 12" C.M.

E. of H. Meadow

190-T.P. 31'

Hay Meadow

107-T.P. 31'

S.L. 12'

34+00

33+00

32+00

31+00

30+00

29+00

28+00

27+00

8/11/25

✓ +93-E.P. 26'

+38-T.P. 32' ✓

✓ +67-E.P. 26'

Cultivated

Woods

+88-T.P. 30' ✓

✓ +35-E.P. 24'

Cultivated

+36-T.P. 35' ✓

✓ +10-E.P. 24'
✓ S.L. 11

S.L. 12'

Cultivated

Brush

✓ +82-E.P. 24'

+79-T.P. 30' ✓

✓ +16-E.P. 24'

Cultivated

Woods and Brush

+23-T.P. 30' ✓

41+00

40+00

39+00

38+00

37+00

36+00

35+00

34+00

8/11/25

+34 E.P. 28

S.L. 12'

Cultivated

+26 T.P. 33

S.L. 13'

Cultivated

+11 E.P. 28'

E. of Hay Meadow

X +96 S.H. Marker #12
+92 T.P. 33

16' RV

+81 E.P. 27'

Meadow

+37 E. of Cult.

X +45 S.H. Sharp Turn
+37 T.P. 33

16' Sup

+50 E.P. 27'

Hay Meadow

Cultivated

+15 T.P. 32'

E. of Meadow

+20 E.P. 26'

S.L. 11'

Cultivated

Wood Hay Meadow

S.L. 15'

+15 T.P. 32'

+30 E. of Woods

43+00

42+00

52
61

44+00

8/11/25

✓ +50. E.P. 78'

✓ +65.00 N.B. Road

15' C.N.

✓ +77 Cross drain

+75. G.P. 36'

✓ +47. E.P. 27'

New Brighton Road

+22. G.P. 29'

+15. Edge of Road


+88. T.P. 58'

+59. T.P. 34


Hay Meadow


X 102 S.W. MACKENZIE AVE

E. of Cult.

 

RICE CREEK ROAD (S.T.H. #62)

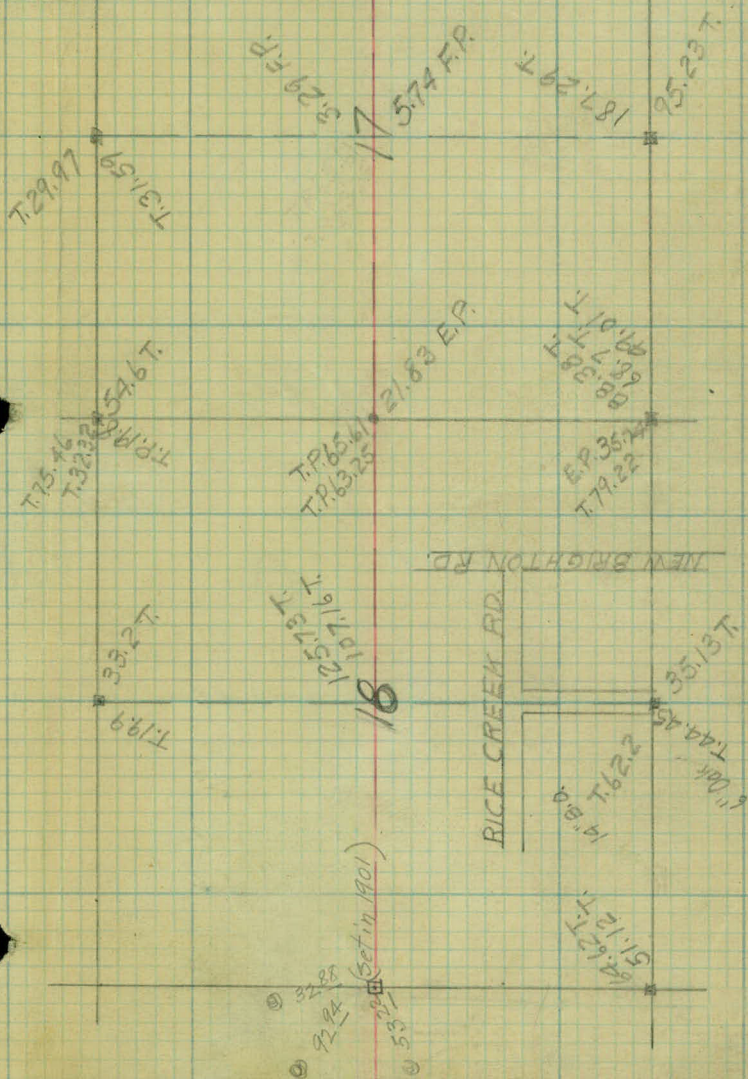

 

PROFILE
RICE CREEK Rd

± Silver Lake Rd = 0+00
To

Sta 10+75 E. of
Silver Lake Rd

STA	+	π	-	Elev
BM	2.98	912.58		909.60

0+00

+25

+50

+55

+75

1

+25

+50

+75

PK
CM
AS
DW

LT

£

July 16 1969
Clear 78°

1

08.93

3.65

08.86

3.72

08.89

3.69

08.90

3.57

3.68

Top Curb

08.94

3.64

08.75

3.83

08.60

3.98

08.54

4.04

08.41

4.17

STA + $\nearrow$ - Elev

912.58

420

2

+25

+50



+75

3

+25

+50

+75

4

TP 4.48 91286 4.20 908.38

4.48

LT

E

RT

2

08.44

4.14

08.47

4.11

08.43

4.15

08.38

4.20

08.33

4.25

08.31

4.27

08.36

4.22

08.37

4.21

08.38

4.20

STA + π - Elev

912.86

4+25

+50

+75

5

+25

+50

+75

6

+25

LT

E

RT

3

4.47
08.39

4.46
08.46

4.41
08.45

4.35
08.51

4.22
08.64

4.17
08.69

4.20
08.62

4.29
08.57

4.40
08.46

STA + π - Elev

912.86

6+50

+75

7

+25

+50

+75

8

+25

+50

LT

£

RT

4

4.41

08.45

4.38

08.48

4.41

08.45

4.42

08.44

4.37

08.49

4.32

08.54

4.33

08.53

4.32

08.54

4.40

08.46

STA + π - Elev

912.86

8+75

9

+25

+50

+75

10

+25

+50

+75

TP 4.24 912.61 4.49 908.37

7.53 905.08 (905.07)

LT

¢

RT

5

4.61

07.25

4.87

07.99

5.19

07.67

5.52

07.31

5.96

06.90

6.51

06.35

7.03

05.83

7.66

05.20

8.31

04.55

Spike in 28" Oak Sta 63+00 200' RT

