

OFFICE OF COUNTY ENGINEER  
RAMSEY CO. MINN.

Road Map Survey

COUNTY ROAD J

From Centerville Rd. To Otter Lake

Road Acc't. No. 25C

Filed 2-5-26

File \_\_\_\_\_

COUNTY ROAD J

From

CENTERVILLE RD

to

OTTER LAKE

9/c 25

Sta.

$\Delta$  Lt.  $\Delta$  Rt.

23+12.65 Mont.

18+34.0 P.O.T.

0+95.95 Mont.

0°-57'

0+00 Iron.  $\pm$  Centerville Rd. (2)

Mont. 2 M.C.

26.14



126.14



19.05 @ 10"

31.54

0 F.P.

1.67088

North

Mont. No 1/4 Cor. Sec. 4



S 1/4 SE

O.P.I.

Iron. Rd. Sign

20.25

603.3

90.15

95.95

53.0

T.P.

Centerville Rd

55.74



Station

Ang. ht. Ang. R<sub>1</sub>

21+76.7 P.O.T. & Bald Eagle Blvd. West (112+66.4)


20+08.30 P.I. Mont 0° 32'

11+18.5 P.I. 0° 18'

2+36.7 P.O.T.

0+00 P.O.T.

See Final Topog. 28-63  
From Turtle L. Rd. to Centerville

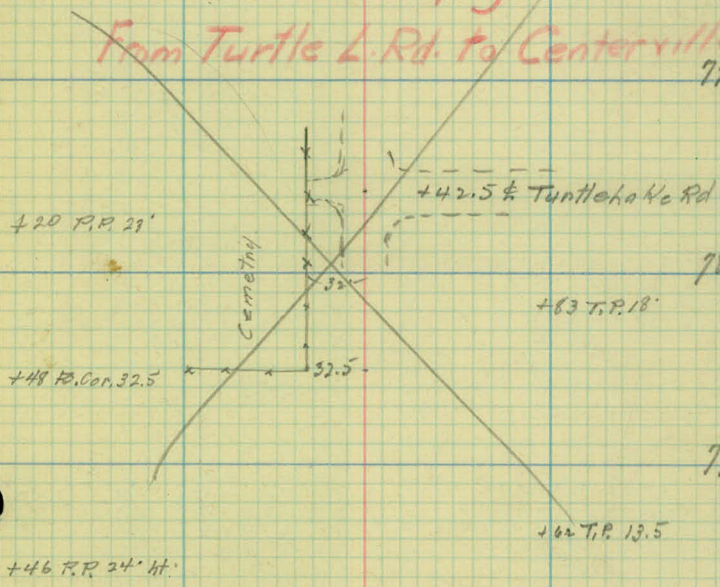

Shoulder Gravel  
width Surface

15 + 00 30 18'

10 + 00 26 18'

5 + 00 26 18

1 + 00 24 16'

0 + 00  $\frac{1}{2}$  Centerville Rd

18+00

17+00

16+00

15+00

10+00

5+00

0+00

Cultivated

Timber + Pasture land

Cultivated land

Cultivated land

19.5

19

21.5

419 Fc. Cor. 23

20 20

4+90 (12" x 40' C.M.P.)

Centerline Road

Shoulder Gravel  
width Surface

24' 18'

26' 18'

24+00

23+00

+882. Other Lake Road

+67 Fe. 30  
+55 Fe. 19

22+00

175

21+00

225

20+00

Cultivated

Farm Road

+11 M.B. 13' RI

19+00

+542. Drive

+97 Fe. Cor. 24'

+72 Fe. Cor. 24'

18+00

Shoulder Gravel  
Width Surface

16 8

0+00

16

8

(West From Bald Eagle Blvd)