

OFFICE OF COUNTY ENGINEER
RAMSEY CO. MINN.

Road Map Survey

McMENEMY ST.

From Koehler Rd To Co. Rd. F

Road Acc't. No. 27 B

Date Filed. 7-9-25

File

Alignment notes on
M^e Menemy St. Rd. # ~~77~~²⁷ from
the Kohler Rd. to Co. Rd. F.

Crane
McIntyre
Fritz
Franko.

Sta.	Point.	Lt.	Rt.	Bearing
39+83 ³⁸	P.O.T.			✓ N 00°-01' E
		2636.38		
13+47 ²	P.I.		0°-01'	X N 00°-00' E
1+13 ³²	P.T.			✓✓
0+71 ⁶³	P.I.		88°-10'	X N 88°-10' W
0+00	P.C.			✓

6/30/25

T.P. 56.3
~~56.3~~
 Stone Mont. $\frac{13}{37.45}$
 T.P. 33.45
 N. W. Cor. of Sec. 29.
 30.6 12" Oak

12" Oak.
 $\frac{13}{54.45}$
 Stone Mont. $\frac{13}{54.45}$
 1/4 Cor. W. line Sec. 29
 $\frac{13}{53}$
 12" Oak.

$\Delta - 88^{\circ} - 10'$
 $D - 85^{\circ}$ R.
 $T - 71^{\circ} 67'$
 $L - 113^{\circ} 82'$ Rot. R. set
 $R - 74^{\circ} 00'$ set

14
 37
 R. Cor.
 1319

Boulder
 104°
 10" Willow
 S. W. Cor. of Sec. 29
 T. 30 - R. 22
 Nail

Mon.

R.R.

P.O.T.

41+80

P.O.T.

Art. Topog on Rd # 44
from the Kohler Rd to Co. Rd F.

5

4

3

2

1

0+00

-1

F. 23' L.
 #90-12"-T-19 L.

#47-12"-T-22 L.

#46-18"-T-18 L.

F. 23' L.

G.L. - 6'
 S.L. - 7'

Cultivated field.

G.L. - 12'
 S.L. - 13'

F. 23' L.

G.L. 5'

S.L. 9'

F. 23'

WOODS

BRICK

#27 Barn 42' R.

#28 Barn 42' R.

G.L. 9'
 S.L. 15'

#42 Mail Box 10 L.

#13⁸⁷ F. 22' L.

#89 Iron Sign 20 L.

#11 Lake Vadnais 2 L.

F. 29' L.

G.L. 9'

S.L. 15'

#50 F. Ent.
 #40 Side Drain 19 L.
 12" x 18" C.M.
 Good Cond.

#44 I.R.S. Marker 14

#26 Lake Vadnais

17' R.
 #08-3"-T-24 A

G.L. 10'

S.L. 15'

F. 18' L.

11

10

9

8

7

6

5

7/2/25

F. 22' L.

x

x

x

x

x

x

x

x

x

x

x

x

x

x

x

x

x

x

Drush

G.L. 11'
S.L. 13'

F. 22' L.
G.L. - 7'
S.L. - 9'

+10-15"-T-21' L.
F. 22' L.

+67-15"-T-20' L.

F. 22' L.
G.L. 7'
S.L. 8'

Woods

Cultivated field

G.L. 11'
S.L. 14'

+15-15"-T-22' L.
F. 22' L.

+94-12"-T-18' L.

+48-15"-T-18' L.
+40-15"-T-17' L.

F. 22' L.
G.L. - 4'
S.L. - 10'

G.L. - 12'
S.L. - 14'

+37-12"-T-19' L.
+14-12"-T-19' L.

17

16

15

14

13

12

11

F. 27' L.

+98-12"-T.-25' L.

+98-8"-T.-24' L.

+63-12 T.-25' L.

+91-15"-T.-25' L.

F. 26'

S. L.-8'

G. L.-7'

F. 25' L.

F. 23'

G. L.-9'

S. L.-11'

F. 22' L.

F. 22' L.

G. L.-8'

S. L.-10'

F. 33' R.

F. 33' R.

G. L.-11'

S. L.-12'

F. 33' R.

F. 33'

G. L.-10'

S. L.-12'

+47 F. Cor. 33' R.

G. L.-10'

S. L.-13'

Woods

Woods

Cultivated field

Brus. H.

23

22

21

20

19

18

17

C.L. 5'
S.L. 8'

Cultivator Field

Q. 6-7
S. 1-10

Q.L. 7' L.
S.L. 10' L.

417 F. Cor. 272

Brush

Weeks

F 33 R

F. 33
C. L. - 11
S. L. - 15

531

F. 33'
B.L. - 11'
S.L. - 13'

F. 33 R

F. 33'
CL-11
SL 12

29

28

27

26

25

24

23

F. 33

F. 33
G.L. - 10
S.L. - 12

F. 33

F. 33
G.L. - 10
S.L. - 12

F. 33

F. 33
G.L. - 10
S.L. - 12

G.L. - 6
S.L. - 10
+ 83 Field Ent.

+ 70 Field Ent.

G.L. 6
S.L. 9

+ 49 - 4^{1/2} - T. - 19 1/2
+ 60 - 12 - T. - 17 1/2

G.L. - 7
S.L. - 10

Cultivated Field

Brush

Woods

35

34

33

32

31

30

29

Q. L-3
5, 4, 6

753 T, P. 152.

757 Farm Ent.

105-4th T. - 122.

A.L. 3'
S.L. 6'

498 T.P. 12' 1/2"

$175 - 4'' - T. - 12 L.$
 $159 - 4'' - T. - 15 L.$
 $132 - 3'' - T. - 10 L.$
 $125 - 3'' - T. - 15 L.$

+81 Farm Est.

465 Mail Box 92.

Q.L: 4
S.L: 7

B.L-14'
S.L-16'
F.33

C. L. - 14
S. L. - 18
F 53

F. 33

F. 33
C.L. - 12
S.L. - 14

Push & Small Trees

Feb 1908.

W/ doc/s

40

39

38

37

36

35

7/2/25

+05 T.P. 51' L.
+08 I.R.S. 23' L.
Marker

Co. Rd. F.

C.L. - 12' R
S.L. - 24' R
+88 F. Cor. 33' R

+44 Side Drain 12' L
12" x 36" C.P.M.
P.O.C. (G.O.)
+43 I.R.S. 21' L.
Marker
+53 T.P. 17' L.

+06 T.P. 16' L.
C.L. - 5
S.L. - 11'

Cultivated Field

Woods

F. 93
C.L. - 8
S.L. - 12

+74-8" T. - 23' R.

F. 93


+56 T.P. 16' L.

C.L. 5'
S.L. 7'
+88 Field Ent.

Brush & Trees

F. 93
C.L. - 11
S.L. - 14

+09 T.P. 15' L.

 

McMENEMY ST.

T. 30 - R. 22

Rd. # 44

Co. Rd. "F"

McMenemy St.

Kohler Rd.

LAKE

VANDERKILS

Boulder

1045

257

F.P.

6188

10" Willow

