

OFFICE OF COUNTY ENGINEER
RAMSEY CO. MINN.

.....Survey

COUNTY RD. F

From Snelling Ave. To Snail Lake Blvd.

From ~~Hodgson Rd.~~ To ~~McMenemy St.~~

From ~~Bellaire Ave~~ To ~~E. County Line~~

Road Acc't. No. 29 C.

Date Filed 4-7-27

File

4-7-27

1
COUNTY ROAD "F"


ROAD NO. 56 29

From Snelling Av. to Snail Lake Blvd

INDEX

Alignment Sta. 0-104+74.88 P. 2-P. 7

Topography " " " " P. 8-P. 24

 

ALIGNMENT

Station Point Lt. & Rt. Bear.

1961

S. 28°-24' E.

4+51.47 ✓ P.T. 6°-02'

4+00 4°-45'

3+50 3°-30'

3+00 2°-15'

2+50 1°-00'

2+10.14 ✓ P.C. 0°-00'

5° C.Lt.

Δ 12°-04'

P.I. 3+31.3

T. 121.16' ✓

L. 241.33 ✓

R. 1146.28 ✓

1962

1+65.00 ✓ P.T. 8°-15'

1+50 7°-30'

1+00 5°-00'

0+50 2°-30'

0+00 ✓ P.C. 0°-00'

S. 16°-20' E.

10° C.Lt.

Δ 16°-30'


P.I. 0+83.18

T. 83.18 ✓

L. 165.00 ✓

573.69

S. 0°-10' W.

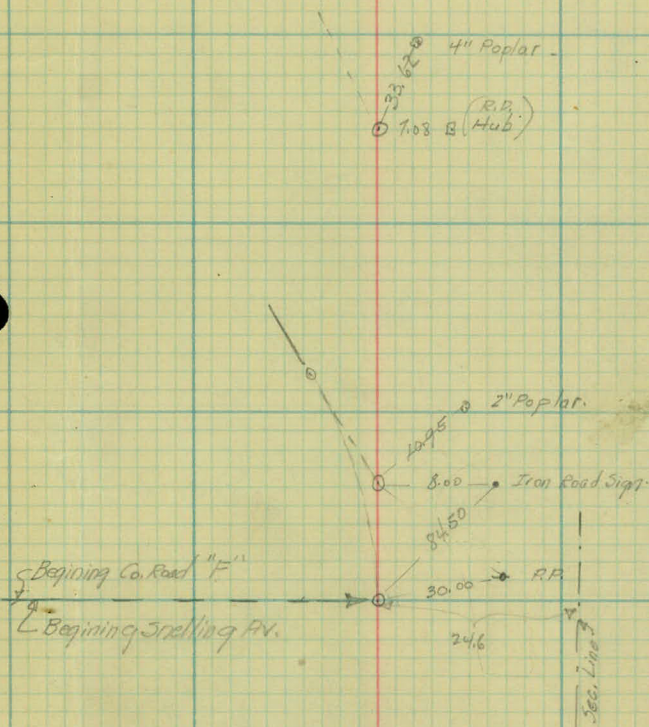

W.H.G.
C.W.S.
A.L.P.
M.G.
R.G.

July 22, 1925

Station Point Lt. A Rt. Bear.

843-12

N. 89° 32' E.

12+88.66 ✓ P.T. 28° 35.5'

53° C. Lt.

12+50 18° 21.0'

Δ 57° 11'

12+00 5° 06'

P.I. 12+41.75

11+80.77 ✓ P.C. 0° 00'

T. 60.98 (21.10)

L. 107.89

R. 112.057

407

S. 33° 17' E.

11+32.67 ✓ P.T.

7° 51'

11+00

6° 32'

8° C. Rt.

10+50

4° 32'

Δ 15° 42'

10+00

2° 32'

P.I. 10+35.75

9+50

0° 32'

T. 98.83

9+36.42 ✓ P.C.

0° 00'

L. 196.25

R. 716.78

411

S. 48° 59' E.

7+28.16 ✓ P.T.

10° 17 1/2'

7+00

8° 53'

10° C. Lt.

6+50

6° 23'

Δ 20° 35'

6+00

3° 53'

P.I. 6+26.50

5+50

1° 23'

T. 104.17



5+22.33 ✓ P.C.

0° 00'


L. 205.83

R. 573.69

S. 28° 24' E.

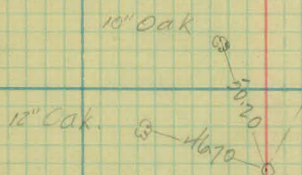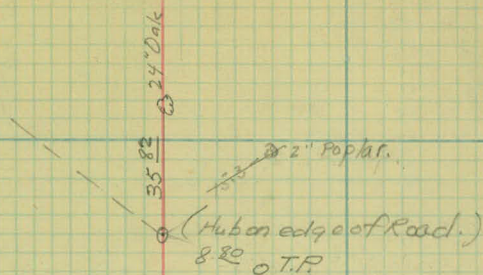

98.82

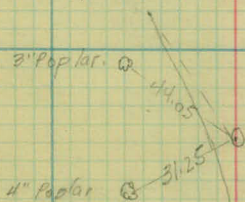

Station	Point	Lt. A Rt.	Bear.
58+43.4	Mon.	0°00'	S-89°-44'E.

50+19.40	P.O.T.		
----------	--------	--	--

47+54.15	P.O.T.		
----------	--------	--	--

2452.20

36+00	P.O.T.		
-------	--------	--	--

S-89°-44'E.

32+11.20	P.I. Mon.		
----------	--------------	--	--

0°28'

N. 89°-48'E



1140.40

20+70.8	P.I.		
---------	------	--	--


0°-16'

N. 89°-32'E

2 Lexington Ave.

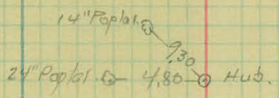
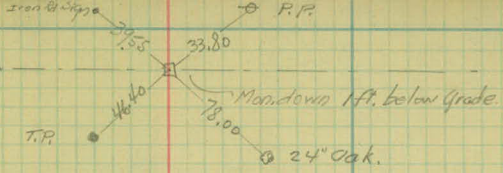


Hub.

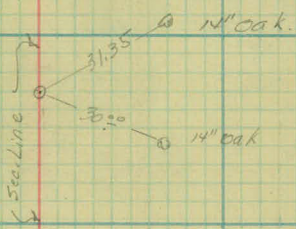

6" Oak. @

2 Hamline Av.

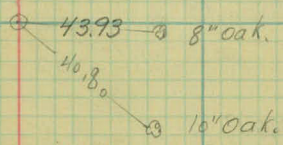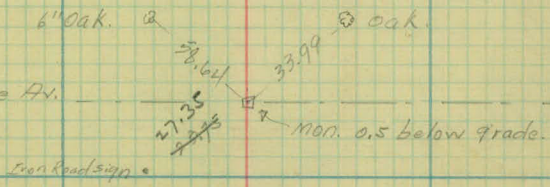

Station Point Lt. A Rt. Bear.

S-89°-44'E

98+59.20 P.O.T.

84+79.70 P.O.T.

77+29.90 P.O.T.

66+63.00 P.O.T.

S-89°-44'E

10' Oak. @ 56.00 43.34 T.P.

(Etab point and set
monument to grade.)
July 30, 1925

27.32 old T.P.
24.74 T.P.

44.32 T.P.
70.60 T.P.

T.P. 36.55 17.88 Cor. F.P.

Station Point Lt. A Rt.

@ 100 Beg Snail Lk. Blvd.

104472.80 End. of Co. Rd 'F'


64 79.70

1999.10

443.4

2642.50

S 89° 44' E.

 

TOPOGRAPHY

a/c 29

Station

4+00

3+00

2+00


1+00

0+00 S County Road "F"
Snelling Av.
-0+13- R.F. ENT RT.

-1+00

20
900
was Willem
Bros

9

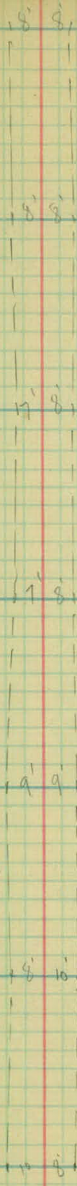

+63-5' Pop 13'

+30-9p Small Trees 22

+81 Co. Rd. 2p. 15'

+18-P.P. 25'

High Bank.

Small Trees

Meadow

station.

1100

1000

900

800

700

600


500

+02-Lake Sign 9'

0 cut.

Brush & Small Trees & Scattered Oaks

Small Brush

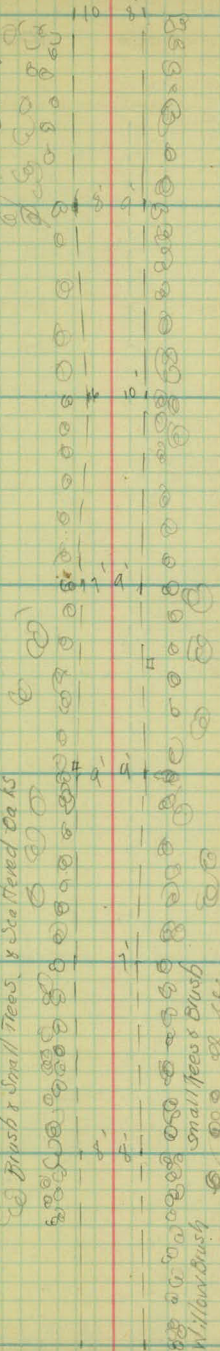

+58-Lake Sign 12'

station

1800

+52 Field Ent Lt.

1700

1600

1500

+80- L F. Ent Rt.

1400

1300

1200

Row of small brush.

+95 - F. cor. 25
24" oak.

F-19'

F-19'
12" X 20' C.M.

+90 Gate

cultivated.

small brush

Pasture.

F-34

Station

25

24

23

22

21

20

19

cultivated

Meadow

small brush.

timber. scattered oaks & brush

Meadow.

willow brush

F. 19'

F. 16-E. F. 17'



Station.

+112 E Hamline Av.

32

31

30

+32 F. Ent. Rt.

29

28

27

26

Timber
corner
graded to
Radius.

Scattered Oaks
Meadow.
+39-F. cor. 30'
+30-10" Oak 28'

13

+90-00. Rd. Sq. 18'

Meadow

+15-2 1/2" Poplars E.F. 29'

+36-B.F. 27'

cultivated

Large Poplars
Scattered Oaks & Brush

Large Poplars.

39

38

37

196 - L.F. Ent Rt.


36

192 - L.F. Ent Rt.

35

34

33

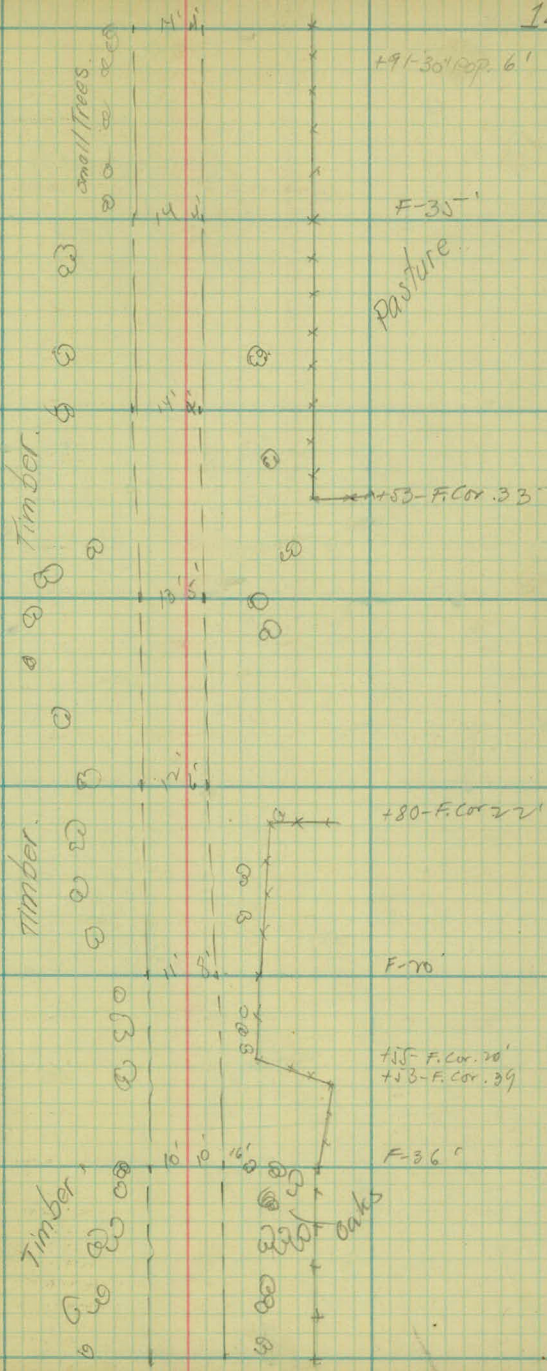

Station.

46

45

44

+90 - R Drive Lt.

+21 - Power Line Xing

43

42

41

40

+90

Timber

Smul Trees

oak brush

oak brush

Cultivated

Pasture

+02-30" oak 37'

+38-R.P. 38'

+32-R.P. 36'

+23-R.P. 24'

x x +37-F. Co. 35'

station.

53

52

51

50

+25 - F. Ent. Lt.

49

48

47

Timber.

stumps. 16

+50-2x W. 1/2 21'

Narrow

8" oak

cultivated.

Timber.

Narrow
Timber

brush
cultivated.

station.

60

+19- Field. Ent Rl.

59

+62 15"X40' C.M.

+43.4 4 Lexington Av.

58

57

56

55

54

+92-P.R. 271

Alfalfa.

Alfalfa.

+98-P.P. 26

+72-In. 21 9.28'

12' x 20' C.M.

+71-P.R. 21

+15-P.P. 87

+12-F. Cor. 20


Cultivated.

F-23

F-21

Timber:

Stumps +90-24" Oak 21

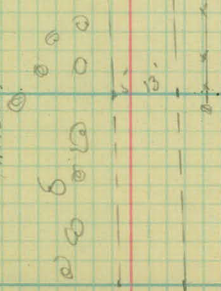

station

67

66

65

64

63

+10

12" x 4 1/2' Vit

62

1

61

+84-P.P.30'

0

Pasture.

F-15'

+70-P. (or 17')

+82-P.P.29'

cultivated.

0

+90-P.P.27'

Ditch

0

Alfalfa.

Meadow

+14

24'

22'

+06

station

74

73

72

71

70

40

15" X 47' C.M.

69

68

+39-P.P. 33'

Meadow

Meadow

cultivated

+39-P.P. 33'

Brush & small oaks

+99-F.Cor. 170

+85-P.P. 33'

F-15'

cultivated

Pasture

F-15'

+85-P.P. 33'

F-15'

Station

+14- 15" x 62' c.m.

81

80

+17- Farm Ent Lt. & Rt.

79

78

77

76

75

+66-P.P. 33'

+18' - 32'

F-17'

+73-T.P. 17'

Pasture.

+35-T.P. & F. 17'

F-52'

+65-P.P. 33'

+39-E.F. 17'

+92-T.P. 17'

+62-P.P. 36'

Meadow.

Alfalfa

F-17'

+61-T.P. 17'

F-17'

Meadow

ation.

88

87

86

85

84

83

82

+99-P.R. 28'

+60-T.P. 17'

+29-T.P. 16'

+90-P.R. 30'

Meadow

cultivated.

+95-T.P. 16'

+89-P.R. 30'



cultivated

+62-T.P. 15'

+38-T.P. 15'

+69-P.R. 31'

cultivated.

 +33-T.P. 15'
 +76-E. 100' 15'

Station

95

94

93

92

91

90

89

+33-P.P. 73

+05-T.P. 19

+13-P.P. 25

+15-T.P. 19

+47-T.P. 19

+07-P.P. 26

+19-T.P. 17

+89-T.P. 17

Meadow

Willow
drainage

cultivated

Station.

102

101

100

99

110 - 2 Victoria

98

97

96

+91-T.P. 38'

13' 8"

+95-F. Cor. 30'
+66-T.P. 19'
+42-Rd 59 Curve 13'

F-32'

W A

Pasture

F-21'

+34-16" Oak 20'
F-24'

+31-T.P. 20'
F-20'

+12-10" Oak 16'
F-25'

9' 10"

F-19'
+98-T.P. 14'
+81-E.W.
-T.P.
+42-F. Cor. 30'

+27-F. Cor. 21'

+27-3 M. Bx. W

+86-Tr. Rd 9.17

+56-P.P. 22'

+93-P.P. 31'
+14-E.W. 19'
+63-T.P. 14'

3' 0" Over
Road

Cultivated.

+34-T.P. 20'

Beg of Snail Lake Blvd

+78.8 End of Count Road "F"

104

108

F-34'



F-16'

+33-7.9.17'

