

OFFICE OF COUNTY ENGINEER
RAMSEY CO. MINN.

Road Map Survey

COUNTY ROAD J

From Hodgson Rd. To Centerville Rd.

Road Acc't. No. 30

Date Filed 2-5-26

File

COUNTY ROAD J (30)

FROM

HODGSON RD (S.T.H. 49)

TO

CENTERVILLE RD. (2)

a/c 30

Sta.

Φ
Alt. Alt.

78+42.5 Mont. Φ Turtle Lake Rd. (62)

45+87.15 P.I.

0°13'


26+38 P.I.

0°05'

8+32° P.I. 0°40'

0+00 Mont. Φ Hodgson Rd.

③

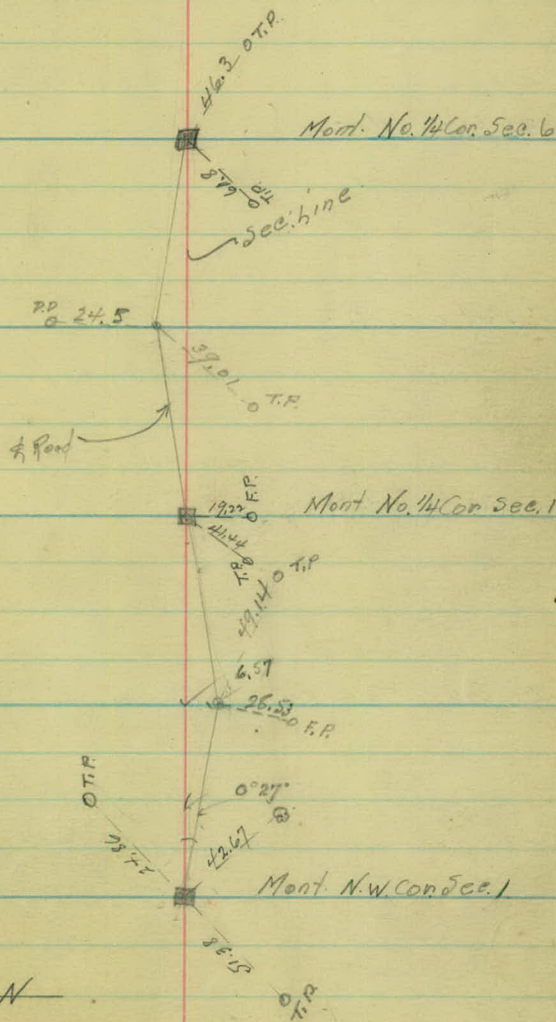

2

Station.

Ang. ht. Ang. Rt.

23+12.65 Mont.

18+34.0 P.O.T.

0+95.95 Mont.

0° 57'

0+00 In on $\frac{1}{2}$ Centerville Rd.

TOPOGRAPHY
COUNTY RD. J

From
HODGSON RD (STH 49)
to
CENTERVILLERD (2)

q/c N^o 30

3/8/34

Shoulder Gravel
Width Surface

LRG

5+00

28

20

1+00

25

20

0+00

± Hodgson Rd.

+50 P.P. 23' 6"

+20 T.P. 14' 11"

5+00

25'

+69 P.P. 22'

Cultivated land

+01 T.P. 15'

4+00

26'

Cultivated land

+66 (6" @ 25')

+07 (4" @ 25')

+31 (6" @ 25')

+11 (6" @ 25')

3+00

26'

+92 (4" @ 26')

+82 T.P. 15.5'

+74 (6" @ 24')

2+00

26'

+87 P.P. 21'

+63 T.P. 16.5'

1+00

26'

+92 (6" @ 25')

+74 (6" @ 25')

+51 (6" @ 25')

+39 T.P. 17'

+83 (6" @ 25.5')

+21 P.C. 26.5'

0+00

+23 G.P. 14.5'
+14 P.P. 19.5'
+04 Rd. Sign 15' 6"

£ Hodgson Rd

Shoulder Gravel
Width Surface

10+00 26' 19'

+63 P.P. 21.5

+95 P.P. 22.4

+13 P.P. 24.4

+34 P.P. 23.0

Cultivated land

Cultivated land

27.5

29

29.0

27.5

27

26

25.5

+47 T.P. 16

+59 (6" @ 28')

+22 T.P. 14.5
+12 (6" @ 27')

+96 (8" @ 27')
+78 (12" @ 25')
+63 (6" @ 25')

+50 (12" @ 25')
+11 (8" @ 25')
+00 (4" @ 21')

+93 (6" @ 26')

+64 (8" @ 25')
+28 (6" @ 25')
+38 (12" @ 25')

+00 (6" @ 26')

+93 (6" @ 25')
+78 T.P. 12.5
+68 (6" @ 25')
+48 (6" @ 25')
+30 (6" @ 25')

+99 (5" @ 25')

+68 (6" @ 25')
+60 T.P. 12.5
+53 (6" @ 25')
+41 (8" @ 25')
+81 (4" @ 25')
+21 (2" @ 25')

+05 F.E.

+87 (6" @ 25')
+59 (4" @ 25')
+41 (4" @ 25')
+41 T.P. 13

10

13+00

12+00

11+00

10+00

9+00

8+00

7+00

6+00

15 + 00 26' 18



19+00

+51 T.P. 18.5

18+00

+58 T.P. 18.1

17+00

+64 P.C. 414.6

+37 T.P. 18'

16+00

+21 T.P. 18'

15+00

+90 T.P. 16.5

14+00

+63 Rd. Sign. 12.0

13+00


Cultivated Land

Cult. land

Cult. land

+14 P.R. 30' L (End)

+92 Rd

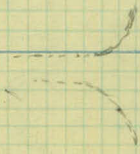

Shoulder Gravel
width Surface

25+00

22

16'

20+00

23

16

+37' +57 T.P. 19.5

26+0

29'

+08 T.P. 19.5 25+0

22.5'

24+0

23.5'

+51 T.P. 19'

23+0

22'

+56 T.P. 18.5

22+0

22.5'

+55 - 12" X +0.8 C.M.R.

21.7'

+27 T.P. 18.5

21+0

22.5'

+04 T.P. 19' 20+00

22.5'

Cultivated land.

Cultivated land.

Shoulder Gravel
Width Surface

20+00 22' 17'

34+00

194
+98 E. Con. 20.

22

Cult. land

+21 E. Con. 22.5

Pasture

33+00

+96 E. Con. 23.0

+79 T.P. 16.6

32+00

+55 T.P. 17

31+00

+934 Unire

Cultivated land

+26 T.P. 17.8

30+00

Cult. land

+97 T.P. 18.5

29+00

28+00

+68 T.P. 19.0

27+00

Shoulder Gravel
Width Surface

40+00 23' 17'

35+00 22' 16'

(13)

41+00

+52 T.P. 18.5

40+00

+20 P.R. 38' ht.

+30 ft. Drive

+19 F.C. Cor. 20' ht.

20'

+26 T.P. 16' Pk

39+00

20'

+97 T.P. 16' Pk

38+00

20'

Cult. hand

Cult. hand.

20'

37+00

+66 T.P. 16.5

36+00

21'

+35 T.P. 16.5

35+00

21.5'

+05 T.P. 16.5

34+00

Shoulder Gravel
Width Surface.

45+00 24' 18'

16

+88 P.P. 24.8

+98 T.P. 15' R.

48+00

47+00

+73 T.P. 15' R.

46+00

+87 P.P. 24.5

+51 T.P. 15.5

+28 (6' @ 17.5)

45+00

Cultivated land

Cultivated land

+27 T.P. 15.5

44+00

+92 P.P. 26' H.

+05 T.P. 16' R. 43+00

42+00

+95 P.P. 26'

+79 T.P. 15.5

41+00

Shoulder Gnave/
Width Surface.

22

17

+74 P.P. 24.5

Waste land

+28 T.P. 13.5

54400

Meadow

+04 T.P. 13.5

53400

+82 P.P. 25

+80 T.P. 12

52400

Bright Brush

51400

Beg. Brush 17' h

+56 T.P. 14 R

50400

+86 P.P. 25

Meadow land

Meadow land

+26 T.P. 12 R

49400

48400

Shoulder Gravel
Width Surface

60+00 22 16'

55+00 20 15'

(18)

62+00

+52 P.P. 24' 41"

+63 T.P. 14' 8"

61+00

+38 T.P. 13.5'

60+00

+58 P.P. 24' 41"

+15 T.P. 13.5'

59+00

Right Brush

Waste land

100 Fe. Cor.

58+00

+90 T.P. 13'

+64 P.P. 24.5'

+70-18" X 35.5 C.M.P.

57+00

Meadow land

Brush

Waste land

+65 T.P. 13'

56+00

+68 P.P. 24'

+50 T.P. 13.5'

55+00

Shoulder Gravel
width Surface

65+00

22

16

28'

X

X

X

28.5

X

+90 T.P. 14'

68+00

X

+36 P.P. 24

Meadow land

27.5

X

67+00

+69 T.P. 14' R.

X

X

28'

X

66+00

Waste land

+40 P.P. 24

+42 T.P. 14' R.

X

29'

+10

65+00

Light Brush

X

X

X

X

X

28.5

+13 T.P. 13.5

64+00

X

X

+43 P.P. 23.5

Meadow land

28.5

X

+90 T.P. 14'

63+00

Waste land

X

X

X

X

62+00

Shoulder Gravel
Width Surface

75 +00 21' 16'

70 +00 22 16'

76+00

+41 T.P. 13.5

+99 P.P. 23.

75+00

Cultivated

+22 T.P. 14.

74+00

Meadow land

+11 P.P. 23.5

73+00

+85 T.P. 13.5

+60 P.C. 31.



72+00

+59 T.P. 14.

+22 P.P. 24.

71+00

Meadow land

Waste land


+32 T.P. 13.5

70+00

+31 P.P. 23.

+09 T.P. 14.

69+00

 

+20 P.P. 28



+42.5 E Turtle Lk. Rd.

78+00

+83 T.P. 18'

+48 F. Cor. 32.5 x x x 32.5

77+00

+62 T.P. 13.5

+46 P.P. 24' Lt.

76+00

