

OFFICE OF COUNTY ENGINEER
RAMSEY CO. MINN.

Road Map Survey

ARCADE ST. (S.T.H. 36)

From Co. Rd. B To Keller Pkwy

Road Acc't. No.

Date Filed 1-10-27

File C

ALIGNMENT.

ARCADE ST. (S.T.H. 36)

FROM.

CO. ROAD "B" (S.T.H. 36)

TO

KELLER PARKWAY (42)



STA.	Point.	ΔL	ΔR	Brg.
55+05.60	P.T.		16°-18'	
+50			14°-05'	
54			12°-05'	
+50			10°-05'	
53			8°-05'	
+50			6°-05'	
53+07.70	P.I.		32°-36'	
52			4°-05'	
+50			2°-05'	
51			0°-05'	
50+98.10	P.C.		0°-00'	

52+56.80 Mont.

33+06.0 P.O.T.

1-3-27
Fair. Cool


H.A.W.
D.S.
A.B.
P.M.

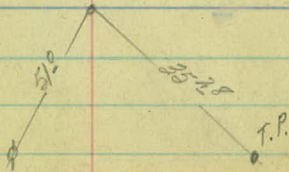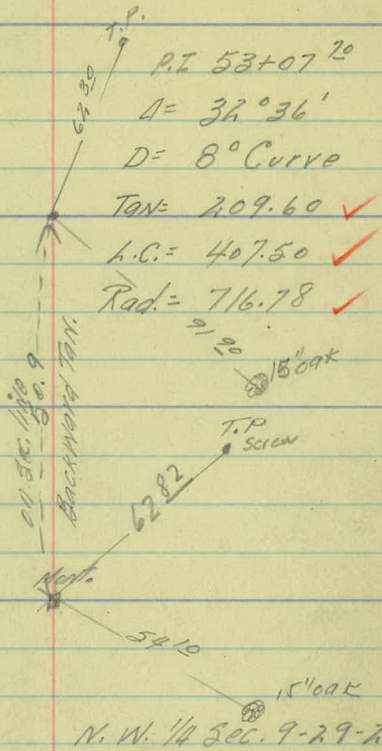


Station Point ang. ht. ang. ht. Bear.

57+

(59420)⁸⁵ P.I

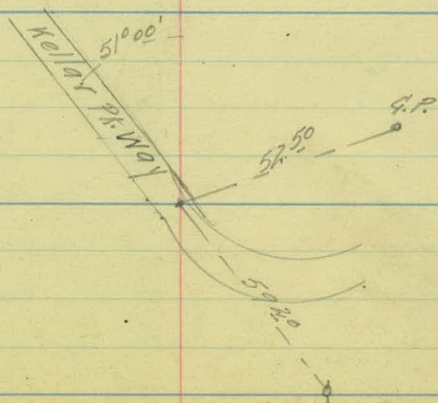

 

TOPOGRAPHY

ARCADE ST. (S.T.H. 36)

FROM.

CO. RD. B (S.T.H. 36)

TO.

KELLER PARKWAY (42)


+28

Co. Rd. B

16+00

+57 P.P. 29

+06 T.P. 28
+00 G.P. 26

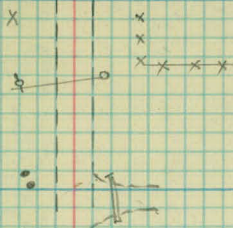

+66 F.C. 36
+69 T.P. 33
+67 G.P. 16
+59 P.P. 16
+51 E Drive
+30 M.B. 17
+28 Rd. Sq. 17
+25 Rd. Sq. 17
+08 G.P. 19

33

32

31

30

29

28

27

+61 - P.P. 25

FL. 33

+60 P.P. 25'

FL. 33

+69 P.P. 25

FL. 33

+84 + FL. 33

+64 P.P. 25'

+38 S.R. Sign 18'

FL. 26' S. 15. G. 13

+68 P.P. 27'

FL. 35'

+67 P.P. 28

P.L. 32'

+66 P.P. 29'

FL. 36

Woods

Woods

Yard

Yard

Woods

Woods

+48 P.P. L.P. 17

FL. 30'

+85 T.P. 29

+12 P.P. 17'
FL. 30

+53 P.P. 13

FL. 32

+73 P.P. 17'

+25 E. Drive 18

+25 T.P. 25
S. 15. G. 13
E. Drive FL. 37

+33 P.P. 16'

T.P. 30 FL. 38

FL. 38'
+03 T.P. 32'
+93 P.P. 16'

+21 T.P. 33

FL. 36

40+00

39+00

38+00

37+00

36+00

35+00

34+00

+57 P.P. 26'

FL. 26 5-17 4-11

+60 P.P. 26

FL. 26'

+60 P.P. 26

FL. 26'

+62 P.P. 26

FL. 27'

+58 P.P. 26

FL. 27

+60 P.P. 26

FL. 27

+88 G.P. 26

+60 P.P. 26
26 Fixing 32

FL. 26

Woods

Woods

+60 T.P. 25

+43 P.P. 16

4-12' 3-17 FL. 27'

Woods

+27 T.P. 24

+10 P.P. 16
FL. 24

+02 T.P. 25
FL. 32

+66 P.P. 16'

FL. 33'

+70 T.P. 28 T.P. 28

+25 P.P. 15'

FL. 28

+46 T.P. 26

G-13 3-15 FL. 32

+88 P.P. 15
+78 FL. 119 32

+NT T.P. 28
FL. 31

Woods

47+00

46+00

45+00

44+00

43+00

42+00

41+00

Fair-Loop


1-4-27

+57 PP 25

+36-PP 14'

+15 T.P. 22

+53 PP 26'
+35-13- Woods 30'

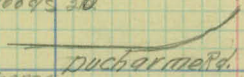

+95 & Dechamne Rd

+57 E of Woods

+57 PP 21

+57 F.C. 22

FL 30 9-16-9-13

S-16-G-13

Woods

+57 PP 24'

FL 36

+57 PP 21'

FL 34

+56 PP 21'

FL 33

+55 PP 24'

FL 31

Woods

Woods

+50 E of Hwy Woods
+45 PP 16'
+38 T.P. 35

Woods

+17 PP 16'
+13 T.P. 25
E of FL 28

FL 33

+90 T.P. 26

+19 P.P. 16

Woods

FL 31

54+00

53+00

52+00

51+00

50+00

49+00

48+00

1-4-27

+50 P.P. 34'

+29 P.P. 14
+26 - T.P. 22

+47 P.P. 28'

S-17 G-14

+18 T.P. 30'
+25 P.P. 15
S-18 G-14
+97 - + Rd. Sign 26

+50 P.P. 42'

+30 E. Woods 50'

E of Scattered
Timber

+21 T.P. 26'

+57 P.P. 29'

+68 - P.P. 1 P. 21

+12 T.P. 29

+57 - P.P. 26

+26 - P.P. 14

S-19 G-10

S-13 - G-10

+56 P.P. 26'

+70 T.P. 22'

+50 Int. of drainage 24.Rt 24.Lt
+51 P.P. 26
48' x 12" V.P.

+82 - P.P. 16

+37 - T.P. 22'

Brush 50' from 9

Woods Swamp

58+00

57+00

56+00

55+00

+30 Rd. 50'
+08 T.P. 39'

Rd - 50

1.9 Kd. 50'

+70 P.P. 62'

+50 Rd - 17

Gervias Lake

Standard
Hy. Way Cont.

Bridge

With Wing

Walls

With 5' Side

Walk on each

side

+49 T.P. 15'

+48 P.P. 45'

5-17-14

Keller

Bryn Way

+28 Rd - 50'

+87 Rd 48'

+68 P.P. - T.P. 24

+50 Rd - 15'

109. E of Bridge

Creek

KELLER


30' Wide

+61 B. of Bridge

+43 T.P. 21

6.18

5.17

 

ARCADE ST. # 43 - From S.T.H. # 61 to Keller Pkwy.


9.87



DUCHAENE ROAD

N.E. 1/4 SEC. 8-29-22

N.W. 1/4 SEC. 9-29-22

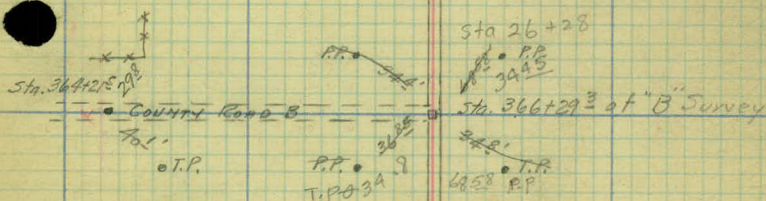

N.E. 1/4 SEC. 17-29-22

N.W. 1/4 SEC. 16-29-22

