

OFFICE OF COUNTY ENGINEER
RAMSEY CO. MINN.

Road Map.....Survey

S. T. H. 36 (Co. Rd. C).....

From Keller Pky..... To E. Co. Line.....

Road Acc't. No.

Date Filed 3-10-34.....

File.....

Alignment

Co. Rd. "C" S.T.H. # 36

FROM KELLER PARKWAY (7)

TO

EAST COUNTY LINE (S.T.H. 100)

(WELFARE PROPOSITION)

NOT BUILT,

FEB. 1933

Δ -Lt. Δ -Rt.

25+80.6 Mont. 0°09'

11+00 P.O.T.

0+00

T.P.

24.69

25.16 P.P.

T.P. 38.92

49.34 P.P.

67°00'

G.R.

15.18

E Keller Pkwy

22.30

G.R.

S.W. Cor. Sec 4-29-22

A-Lt A-Rt

67400 P.O.T.




52440.0 P.I.
Mont.

0°47'

38447.50 P.O.T. ESTH. #1

Top of Conc. Hand Rail

Top of Conc. Hand Rail

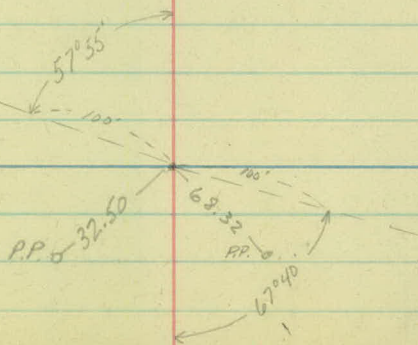
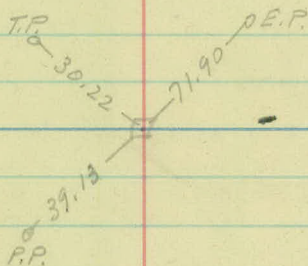
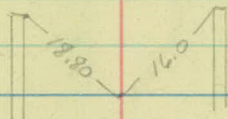


A-Lt. A-Pl.

104+96.70 P.I. 0°32'

86+00 P.O.T.

78+70.85 P.I. 0°21' E Back St.

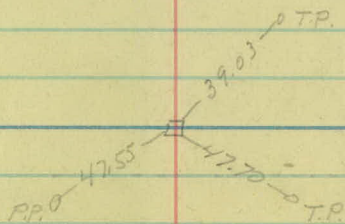
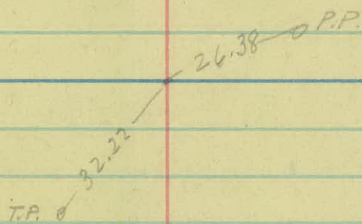
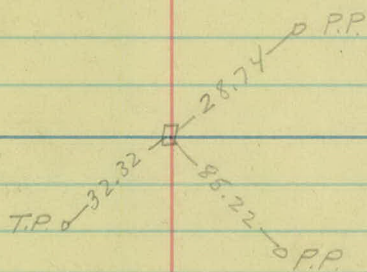


A-Lt. A-Rt.

147+00 P.O.T.

131+29.5 ^{Mont.}
P.I. 0°11'

121+25.6 P.O.T. E.W.B. Ave

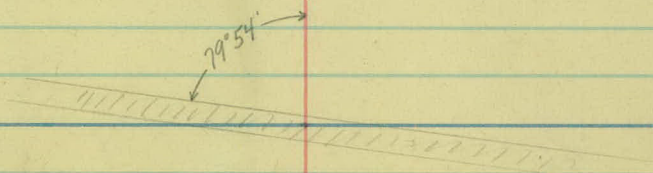
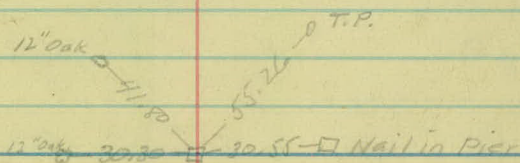
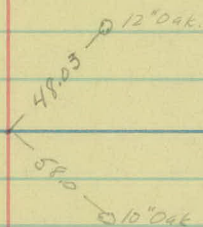



209+73.9 $\angle$ E. Co. Line

2609.2

183+64.7 Mont.
P.O.T.

157+54.3 P.I. 0°41'

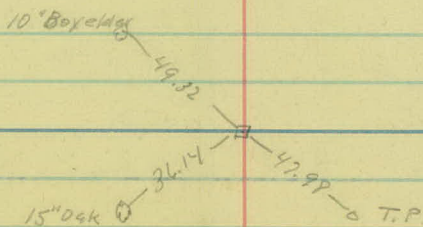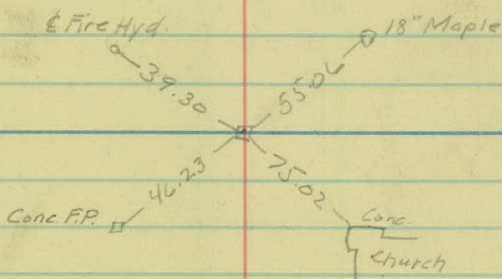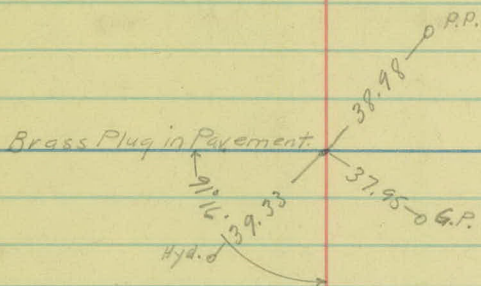

 

Topag.

Co. Rd. "C".

5

4

3

2

1

0400

F. 27'

+44-X Rd. 5g. 13'

F. 25'

+75-End of Woods

+39-Slow Sq. 13'

F. 23'

F. 25'

F. 22'

+33-Floor. 22'
+31-R.P. 23'

+00-G.R. 33'

Low Land

Low Land

Wooded

Wooded

4 Rd. 6'

+63-P.P. 28'

4 Rd. 6'

+88-Tr. 36'

+61-Tr. 36'
+49-End of Woods

+33-R.P. 25'

4 Rd. 6'

+07-R.P. 25'

+55-End F. 42'

+06-R.P. 26'
F. 37'-4 Rd. 7'

+50-4 Rd. 7'
+58-F. 36'
+25-R.P. 27'
+23-F. 32'-F. 57'
+00-F. 51'

12

11

10

9

8

7

6

+60-F. 47'

F. 34'

+90-T.P. 21'

+80-Beg. Woods

F. 31'

+65-T.P. 17'

F. 29'

F. 28'

+45-F. Ent.

+30-End Low Land

F. 33'

F. 36'

+20-24" X 41' C.M.

+14-F. Int. 38'

Woods

Pasture

Low Land

Cultivated

Low Land

+07-P.P. 26'

± Rd. 5'

+58-PP. 25'

+53-Tr. 41'

+38-± Dr.

+25-F. 59'

+14-F. 47'

+80-F. Int. 46'

+06-PP. 26'

F. Int. 42'

+15-End Low Land

F. 35'-Rd. 6'

+58-F. Cor. 34'

+55-P.P. 27'

+02-P.P. 29'

± Rd. 6'

14' 27'

19

18

17

16

15

14

13

+52-T.P. 24'

+49-F. Cor. 26'

F. 26'

+23-T.P. 23'

+10-End of Woods

F. 31'

F. 31'

+96-T.P. 22'

F. 25'

+73-T.P. 22'

+10-Beg. Woods
F. 28'

+77-18" X 46' C.M.

+49-T.P. 22'

F. 31'

+75-End Woods

+70-T.P. 21'

F. 32'

Low Land

Woods

Low Land

Woods

Cult.

Yard.

Cultivated

+78-P.P. 22'

+79-F. Cor. 27'

F. 26'-& Rd. 2'

+23-P.P. 26'

+13-F. Cor. 24'

+98-F. Ent.

+72-P.P. 25'

& Rd. 4'

+50-End Cult.

+30-End.

+15-P.P. 25'

14' 27'

Drain

& Rd. 4'

+63-P.P. 26'

26

25

24

23

22

21

20

End Lowland

+88-F, Ent.

End Lowland

+92-T.P. 25'

+83-P.P. 26'

+80-F, Cor. 26'

+65-T.P. 65'

+34-P.P. 26'

+33-T.P. 24'

Low Land

Low Land

CRd. on E

+81-P.P. 26'

+12-30"X41" C.M.
+08-T.P. 24'

← Ditch ——— 19' 22' ——— Ditch →

+29-P.P. 26'

+82-2 T.P. -20 & 26'

33

32

31

30

29

28

27

+23-T.P.23'

+35-P.P.26'

F.29'

+14-T.P.24'

+07-F.Ent.
F.29'

+16-P.P.25'

F.28'

+96-T.P.22'

Woods

Woods

+34-P.P.27'

F.29'

+82-T.P.24'

F.28'

+85-P.P.26'

+46-T.P.24'

+45-Beg. Woods

F.28

+26-T.P.25'
+20-Beg. Woods

+35-P.P.25'

40

39

38

37

36

35

34

F. E. +96-12'X16'C.M. 19'

✓ +75-T.P. 21'

+31-Conc. Steps 21'
+31-8'X10'C.M. 16'

4' Conc. S.W. 11111111
School Yard
4' Conc. S.W. 11111111

+87-Conc. Steps 21'
+87-8'X10'C.M. 16'
+30-6' Dr.
+28-Fg. Sq. 22'
+24-T.P. 19'
+21-R.P. 28'
+06-F. Cor. 42'
+03-T.P. 49'

+20-R.P. 26'
+99-R.P. 26'

Cultivated

+54-End 12" Vit. 47'
+38-AP 30'
+12-T. 29'
+03-R.P. 25'
+00-G.P. 25'

12"X25' Vit.
12"X68' Vit.

+70-M.H. 29'

+63.5-E. Edge Pavement 6
+34-W. Edge Pavement 6
+17-R.P. 19'
+10-T.P. 32'

S.T.H. #1.

2'X2'X77' Conc. Culv.

+65-6' Dr.
+50-End Woods
+19-T.P. 23'

+96-F. Cor. 25'
+93-2'X2' Conc. Culv. 30'
+84-R.P. 24'
+78-Sq. 24'
+53-R.P. 25'

F. 35'
End Woods

+74-T.P. 23'

+21-18'X46'C.M.

23' 22'

+29-R.P. 26'
F. 33'

Woods

Woods

+44-T.P. 22'

F. 31'
+91-School Sq. 12'
+85-R.P. 25'

+73-F. Ent.

+40-Occ. Woods
+34-X.Rd. Sq. 20'

+31-T.P. 28'

F. 38'

47

44

45

44

43

42

41

✓ +43-T.P. 20'

✓ +14-P.P. 28'

+08-Water Pump 33'

+21-End

+11-P.P. 26'

+32-End

✓ +14-T.P. 20'

+14-P.P. 25'

+75-F. 20'

x x x x

+25-End

✓ +14-P.P. 28'

+00-End

+12-P.P. 25'

✓ +84-T.P. 19'

+43-F. 20'

x x x x

Cultivated

+18-P.P. 26'

✓ +55-T.P. 19'

✓ +14-P.P. 28'

Cult.

+59-T. 28'

+50-End

+38-T. 28'

+10-P.P. 26'

+07-End Cult.

✓ +26-P.P. 29.20'

+16-T.P. 16'

+06-T. 32'

+93-End

+09-P.P. 26'

+64-T. 38'

+60-F. 33'

x x x x

Yard

Cultivated

✓ +15-P.P. 28'

+04-P.P. 25'

54

53

52

51

50

49

48

+02-P.P.28'

+13-P.P.23' ✓

+90-T.P.21'

+43-18" X 40' C.M.

23' 23'
=====

+08-P.P.24' ✓

+63-T.P.21'

+40-E Side Rd.

+13-R.P.29'

+15-P.P.23' ✓

+76-T.P.20'

Platted Property

Cultivated

+14-P.P.23' ✓

+55-P.P.29'

+02-T.P.20'

+12-P.P.25' ✓

+27-4 Dr.
+12-P.P.28'

+10-P.P.25' ✓

+74-T.P.21'

+15-P.P.26' ✓

61

60

59

58

57

56

55

+93-T.P. 19'

+13-P.P. 23' ✓

+61-T.P. 19'

+09-Edr.
+02-P.P. 27'

+14-P.P. 23' ✓

+30-T.P. 19'

+15-P.P. 23' ✓

+03-P.P. 27'

+94-T.P. 19'

+15-P.P. 23' ✓
+10-T.P. 18' ✓

+90-Edr.

+11-P.P. 23' ✓

+65-T.P. 19'

{ 12" X 20' C.M. 20'
+16-Edr.
+00-P.P. 27'

+12-P.P. 23' ✓

+29-T.P. 20'
+20-Edr.
12" X 20' C.M. 18'

+13-P.P. 23' ✓

Platted Property

Cultivated

68

67

66

65

64

63

62

+65-Beg. G.R. 11.5'
 +54-F.E.
 +42-End G.R. 11.5'
 +26-Tr. 42'
 +26-F. Cor. 34'
 +06-Tr. 20'
 G.R. 11.5'

+88-24" Tr. 43'

+50-F. Int.
 +19-P.P. 27'
 +12-F. Cor. 45'
 +08-R.R. F. 17'

+08-R.R. Fence 42'
 +01-P.P. 27'

G.R. 11'

+58-T.P. 19'

+30-Beg. G.R. 11'

+03-P.P. 28'

+88-E Elm St.
 15" X 36" C.M. 26'

+26-T.P. 19'
 +15-E Dr.
 12" X 16" C.M. 21'

+04-P.P. 28'

Cultivated

+10-P.P. 24'
 G.R. 12'

+12-End Bridge 4'
 +07-P.P. 24'
 +05-R.R. F. 17'

+15-T.P. 23'
 +05-P.P. 24'
 +05-Beg. Bridge 4'
 +04-R.R. Fence 25'

+10-P.P. 23'
 G.R. 12'

+27-Beg. G.R. 12'
 +12-P.P. 28'
 +05-G.P. 21'

+13-P.P. 23'

+14-P.P. 23'

Platted Property

Cultivated

75

74

73

72

71

70

69

+77-T.P. 20'

+15-P.P. 28'

+50-Q Dr.

+44-T.P. 20'

+52-Q Dr.
12" X 18' C.M. 18'

+19-T.P. 20'

+12-P.P. 28'

+08-T.P. 37'

+85-T.P. 20'

+50-Q Dr.

+13-P.P. 28'

+57-T.P. 20'

+10-Q Dr.

+85-End G.R. 115'

+30-T.P. 20'

+16-P.P. 29'

x

x

x x x

+33-F. Cor. 27'

+32-X Rd. Sq. 20'

+13-P.P. 23' ✓

+13-RR 23' ✓

+13-P.P. 23' ✓

+00-F.E.

+15-P.P. 23' ✓

+13-P.P. 23'

+14-P.P. 23' ✓

+03-End G.R. 115'

+13-P.P. 23' ✓

Planted Property

Cultivated

82

81

80

79

78

77

76

+92- $\angle$ Dr.

+46-Rd. Sq. 17'

+44-T.P. 17'

+44-F. Cor. 26'

+03-Tr. 23'

+00-F. Cor. 23'



+15-RR 23'

+15-RR 28'

+07-T.P. 19'

+74-End F. 28'

+18-RR 23'

+16-G.P. 23'

+10-Tr. 20'

F. 27'

+94-Tr. 26'

+80- $\angle$ Dr.

+70-Tr. 26'

+77-Tr. 20'

+63-Tr. 19'

+43-Tr. 27'

+30-Barn 32.5'

+20-Tr. 23'

+10-RR 22'

F. 25'

+25-Tr. 26'

+18- $\angle$ Dr.



+86-Tr. 27'

+72-T.P. 20'

+82- $\angle$ Dr.

12" x 16" C.M. 15'

+71-2 Tr. 23'

+50-Bush 42'

+40-Tr. 21'

+30-Tr. 23'

+18-2 Tr. 30'

+04-P.P. 22'

+14-P.P. 28'



+71- $\angle$ Back St.

+97-F. Cor. 24'

+71- $\angle$ Back St.

+28-T.P. 20'

+63-RR 22'

Yard

+13-P.P. 28'

+01-T.P. 20'

+61-Tr. 34'

+42-Tr. 34'

+14- $\angle$ Dr.

+04-Tr. 33'

+96-P.P. 22'



+66-F. Cor. 27'

+08-P.P. 23'

89

88

87

86

85

84

83

FEB. 1933.

+12-Tr. 25'

+15-P.P. 23'
F. 27'
+90-Stu. 24'

+97-Tr. 25'
+94-T.P. 16'
+80-Stu. 25'
+63-Tr. 25'
+48-Tr. 25'
+36-F.E.
+16-Tr. 25'
+00-Stu. 25'

[+41-Edr.
12"X16"CM. 16'

+33-P.P. 23'
+15-P.P. 23'
F. 27'

+67-T.P. 15'
+51-Tr. 24'
+33-Tr. 25'
+17-P.P. 27'
+04-Tr. 25'

+14-P.P. 23'
F. 27'

+88-Stu. 25'

+40-Tr. 23'
+50-Stump 23'

Cultivated

Cultivated

+00-Tr. 23'

+14-PA 22'
F. 27'

+72-T.P. 16'

+34-Tr. 24'
+16-P.P. 27'

+14-P.P. 22'
+00-F. 27'

+97-Tr. 24'
+86-Tr. 24'
+77-T.P. 16'

+33-F. Col. 26'
+14-P.P. 23'

+97-Tr. 19'

+21-Tr. 24'
+15-PA 21'

+13-P.P. 22'
+03-Tr. 19'

96

95

94

93

92

91

90

+88-T.P.17'

+83-Tr.36'

+53-Tr.36'

+23-Tr.36'

+14-P.P.23'

+58-T.P.17'

x x x x

+58-F.29'

+45-E Flindran St.

+15-P.P.23'

+24-T.P.17'

+15-P.P.22'

+91-T.P.16'

Cultivated

Cultivated

+38-E Or.

+25-End. F. 27'

+15-P.P.23'

F. 27'

+12-P.P.22'

F. 27'

+60-T.P.16'

+68-FE,

+30-Tr.30'

+15-P.P.22'

F. 27'

+93-18" X 40' C.M.

+75-F. Int.

21' 19'

+27-T.P.15'

+19-P.P.23'

F. 27'

103

102

101

100

99

98

97

+39-T.P.17'

+11-T.P.17'

+85-F.E.

+66-T.P.17'

+41-T.P.17'

+18-T.P.17'

+77-Tr.35'

+42-Tr.35'

+14-P.P.23'

+73-Tr.36'

+39-Tr.36'

+15-P.P.23'

+65-Tr.36'

+72-Tr.36'

+42-Tr.36'

+15-P.P.23'

+78-Tr.37'

+48-Tr.37'

+18-Tr.36'

+15-P.P.23'

+88-Tr.37'

+56-Tr.37'

+25-Tr.37'

+15-P.P.23'

+95-Tr.37'

+34-Tr.36'

+15-P.P.23'

+73-Tr.36'

+44-Tr.36'

+14-Tr.36'

+14-P.P.23'

110

109

108

107

106

105

104

+39-X Drain
7.5'X6'X22'

G.R. 10'

+98-T.P. 23'

G.R. 10'

+64-T.P. 21'

+27-Beg. G.R. 10.5'
+10-F.E.
15'X18' C.M. 19'

+93-T.P. 17'

+02-T.P. 14'

+70-T.P. 17'



+25-F. Int.

+11-PP. 24'

G.R. 11'-F. 25'

+45-10 Tr. 35'

+15-PP. 24'

+14-Beg. G.R. 11'

F. 25'

+80-F. 25

+66-F. 27'

+53-F. Cor. 32'

+44-End

12'X29' C.M. 19'

+22-5th. 20'

+14-PP. 23'

+14-PP. 23'

+14-PP. 23'

+14-PP. 23'

+08-Tr. 35'

+76-Tr. 35'

+14-PP. 23'

+10-Tr. 34'

117

116

115

114

113

112

111

+52 - 12" X 34" C.M.

14' 30'
=====

+43 - X Rd. Sq. 20'

+14 - P.P. 23'

+73 - T.P. 26'

+14 - P.P. 23'

+43 - T.P. 25'

+14 - P.P. 23'

+11 - School Sq. 23'

+04 - T.P. 24'

+14 - P.P. 23'

+81 - End.
12" X 20" C.M. 19'

+25 - End.
15" X 20" C.M. 18'
+14 - P.P. 23'

+70 - T.P. 23'

+70 - Tr. 40'

+39 - End G.R. 10'

+35 - T.P. 22'

G.R. 10'

+46 - F. Cor. 25'
+39 - End G.R. 11'
+15 - P.P. 24'
G.R. 11' - F. 25'

+15 - P.P. 24'
G.R. 11' - F. 25'

124

123

122

121

120

119

118

+77-Tn.22'

+47-Tn.27'

+70-Tn.26'

+46-F.34'

+46-P.P.31'

+40-T.P.29'

+28-Q.Dr.

+04-T.P.29'

+76-Stop Sq.27'

+67-R.P.31'

+00-Rd. Sq.27'

+70-T.P.29'

+43-T.P.27'

+12-T.P.27'

Cult.

School Yard

Cultivated

x x x

+75-F.35'

+64-T.P.18'

+51-Tn.24'

+11-Tn.24'

+98-Tn.24'

+74-Q.Dr.

12" X 20" C.M. 15'

+67-Tn.24'

+53-Tn.24'

+51-G.P.16'

+20-Tn.24'

+00-Tn.23'

+80-Tn.22'

+63-Tn.21'

+51-T.P.15'

+25.5-E. Edge Pave

+15.5-W. Edge Pave

+99-P.P.22'

+85-F. 111.544.39'

+62-Comp. W. 94.15'

+60-F. 111.544.32'

+52-Stop Sq.20'

+15-P.P.23'

+14-P.P.23'

+14-P.P.23'

Yard

16' 25'

Cultivated

131

130

129

128

127

126

125

+ 97 - Tr. 40'
+ 89 - Tr. 35'
+ 81 - Tr. 29'
+ 69 - Sp. 34'
+ 59 - Tr. 29'
+ 39 - Tr. 39'
+ 29 - Tr. 30'
+ 21 - E. Dr.
12" X 16" C.M. 14'

+ 74 - T.P. 31'
+ 36 - P.P. 31'
+ 29 - F. Cor. 30'
+ 19 - E. Dr.
12" X 20" C.M. 17'

Yard

+ 25 - T.P. 30'

+ 42 - 12" X 36" C.M.

17' 19'

+ 91 - E. Dr.
24" X 10" C.M. 17'

+ 04 - Tr. 38'

+ 71 - T.P. 26'

+ 95 - Tr. 23'
+ 61 - Tr. 30' + 22'
+ 60 - Tr. 22'
+ 58 - Tr. 36'
+ 37 - Tr. 22'
+ 01 - Tr. 23'

+ 83 - Tr. 35'
+ 74 - Tr. 18'
+ 44 - Tr. 19'
+ 23 - 3 Tr. 36'
+ 01 - Tr. 20'

Cult.

Cult.

+ 28 - T.P. 24'

+ 92 - Tr. 25'
+ 67 - Tr. 19'
+ 65 - Tr. 25'
+ 54 - Tr. 25'
+ 33 - Tr. 27'
+ 21 - 2 Tr. 21'

+ 81 - T.P. 26'

+ 71 - Tr. 17'
+ 66 - Sp. 16'
+ 53 - Sp. 17'
+ 38 - Tr. 16'
+ 10 - Tr. 19'
+ 03 - X Rd. Sq. 16'

138

137

136

135

134

133

132

+86-T.P.32'

F.32'

+12-Bcg.F.23'

+11-P.P.18'

+98-F.Cor.32'

+93-Edr.

12"X16'C.M.16

F.32'

+58-T.P.31'

+34-Edr.

12"X20'C.M.20'

12"X2'Vit.Ext.

F.32'

+44-P.P.14'

+20-18"X46'C.M.

+04-F.Int.32'

22' 18'

+15-T.P.31'

F.34'

F.30'

+89-P.P.16'

+49-Bcg.F.31'

+41-Edr.

12"X16'C.M.14'

+07-Stu.23'

+00-Stu.27'

F.32'

+78-T.P.31'

+59-F.Int.32'

12"X16'C.M.21'

+00-Edr. F.32'

+38-P.P.16'

+36-Tr.33'

+80-Tr.30'

+68-Tr.33'

+46-Tr.30'

+40-Stu.28'

+28-Tr.30'

+24-Tr.43'

+22-P.P.16'

+15-Tr.31'

+03-Tr.29'

+00-Stu.36'

+94-Edr.
12"X16'C.M.15'

+23-T.P.31'

F.32'

F.32'

145

144

143

142

141

140

139

+40 - P.P. 18'

F. 26'

#78 - S.H. 29'
+71 - T.P. 35'
+70 - Tr. 29'

F. 25

+89 - P.P. 18'

+98 - Tr. 28'
+95 - Tr. 28'
+87 - Tr. 28'

F. 25'

+47 - E.Dr.
12" X 16" C.M. 17'
+22 - T.P. 36'
+08 - Tr. 28'

+39 - P.P. 18'

Cultivated

+46 - Tr. 27'
+44 - Tr. 30'

+28 - E.Dr.
12" X 16" C.M. 17'

+75 - T.P. 36'

F. 24'

+94 - P.P. 18'

+14 - F. Cor. 33'

F. 24'

+27 - T.P. 32'
F. 33'

+97 - P.P. 18'

F. 23'

F. 34'

152

151

150

149

148

147

146

+79-PP.18'

F.27'

+22-PP.18'

F.27'

F.27'

+68-PP.17'

F.27'

+42-PP.17'

F.27'

F.27'

+88-PP.18'

F.27'

+84-Tr.33'

+27-T.P.24'
+08-Stu.27'
{+13-EDr.
12"X18'Vit.18'

+44-EDr.
15"X22'CM.17'

+68-T.P.26'
+60-EDr.
12"X16'CM.18'

+15-PP.28'

+63-T.P.31'
+53-EDr.
{12"X16'CM.17'

+16-T.P.33'

Cult.

Wooded

159

158

157

156

155

154

153

+93-F.Cor. 21'

+40-E.Dr.
15"X63'C.M. 17'

+05-End F. 27'

+83-P.P. 19'

+63-Tr. 29'

+42-Tr. 29'

+33-Tr. 30'

+29-3 Conc. Walk 25'

+26-2 Tr. 27'X30'

+10-Tr. 29'

F. 27'

+97-2 Tr. 26'X30'

+84-2 Tr. 25'X28'

+80-F.Cor. 26'

12"X32'C.M. 16'

+58-E Rd.

+44-F.Cor. 35'

+43-P.P. 18'

F. 26'

F. 25'

+89-P.P. 18'

F. 25'

+31-P.P. 18'

F. 26'

F. 24'

Yard

Cult.

+50-E Rd.

+88-Tr. 18'

+34-Tr. 20'

Wooded

+59-Tr. 35'

+49-Tr. 24'

+32-Tr. 33'

+24-E Dr.

12"X20'C.M. 17'

+11-Tr. 24'

+97-Tr. 32'

+80-Tr. 22'

+72-Tr. 27'

+56-E Dr.

12"X20'C.M. 18'

+48-Tr. 33'

+44-St. 32'

166

165

164

163

162

161

160

+82-RR.19'

F.20'

+22-RR.19'

F.20'

+74-18"X36' C.M.

F.21'

+74-RR.20'

+57-T.22'

F.20'

+16-RR.20'

F.21'

F.20'

+52-RR.21'

18' 18'

Pasture

Hay Field

173

172

171

170

169

168

167

+53-Stu.21'

+03-PA 20'
F.20'

F.21'

+50-P.P.21'

F.21'

+58-F. Int. 20'

F.21'

+97-P.P.20'

F.20'

+41-PR.20'

F.21'

F.20'

Pasture

Cult.

Hay Field

Pasture

Cult.

+38-Tr.30'

+83-Tr.30'

+52-Tr.31'

+58-F. Cor. 34'

F.32'

+94-G.P.30'

F.33'

+90-Tr.31'

+59-Tr.32'

F.32'

Boq. F.32'

180

179

178

177

176

175

174

+62-P.P.22'

+30-F.E.

Yard

+27-Tr.24'

+00-E Dr.

Cult.

+74-X Rd. Sq. 18'

+32-P.P.21'

Cult.

Yard

+88-E Dr.

+62-P.P.21'

+50-Tr.24'

Cult.

+34-P.P.22'

+26-Sq.22'

+22-Stu.26' Tr.30'

+97-F. Cor. 23'

+97-E Rd.

+10-P.P.21'

F.21'

+70-F.50'

+58-F. Cor. 20'

F.20'

Pasture

Cult.

F.20'

+68-Tr.28'

+38-Tr.28'

+22-Tr.30'

+17-F. Cor. 30'

+49-P.P.20'

Cult.

+75-Stu.28'

+61-Tr.28'

F.21'

+14-Tr.29'

+00-Tr.28'

187

186

185

184

183

182

181

+98-Tr. 33'
 +84-Tr. 33'
 +68-Tr. 33'
 +52-Tr. 33'
 +35-Tr. 33'
 +26-Dr.

+03-Tr. 33'

+87-P.P. 25'

+72-Tr. 33'

+26-Tr. 33'

+00-X Rd. Sq. 27'

+77-Tr. 33'

+62-Tr. 34'

+47-Tr. 34'

+32-Tr. 34'

+24-4' Brick Steps 27'

+05-P.P. 25'

+28-4' Conc. Steps 27'

+91-Tr. 37'

+84-Hyd. 35'

+65-4' Helen St.

+44-P.P. 24'

+33-F. Cor. 33'

F. 33'

+54-4' Conc. Steps 32'

+34-Dr.

+13-P.P. 20'

+01-Gar. 33'

Yard

Cult.

+91-Tr. 23'

+73-Tr. 22'

+32-X Rd. Sq. 17'

+08-Dr.

+99-F. Cor. 31'

+94-Tr. 23'

+78-Tr. 22'

+63-Tr. 22'

+41-4' Conc. Steps 8.5'

+37-Stu. 22'

+03-Stu. 22'

F. 32'

+86-Tr. 22'

+73-F. Cor. 31'

+68-Tr. 22'

+51-Tr. 22'

+33-Tr. 22'

+25-Dr.

+00-Tr. 22'

+83-Tr. 22'

+67-Tr. 23'

+50-Tr. 22'

+15-Tr. 23'

+85-G.P. 37'

+36-6' Conc. S.W. 33'

Church Yard

Cult.

+03-F. Cor. 33'

+56-Stu. 25'

+50-Dr.

+14-F. Cor. 33'

194

193

192

191

190

189

188

+78- Tr. 35'

+63- Tr. 35'

+11- Tr. 35'

+93- 3' Conc. S.W. 26'

+85- Tr. 35'

+73- 4 Dr.

+52- End. F. 31'

+50- Tr. 34'

+36- P.P. 29'

+28- Tr. 34'

+13- X Rd. Sq. 24'

+74- F. Cor. 30' Tr. 24'

+10- Tr. 32'

+96- Tr. 33'

+81- Tr. 33'

+60- Tr. 34'

+47- Tr. 34'

+32- Tr. 35'

+17- Tr. 34'

+01- Tr. 34'

+85- Tr. 33'

+68- Hyd. 23'

+63- 8" X 12' C.I.P. 20'

+63- 6' S.W. 27'

+59- Tr. 25'

+35- 4 X 5 ft

+11- Tr. 28'

+90- Tr. 34'

+57- Tr. 34'

+25- Tr. 33'

+09- Tr. 34'

+93- Tr. 34'

+67- 4' Conc. Walk 32'

+61- Tr. 34'

+45- Tr. 33'

+30- Tr. 34'

+14- Tr. 33'

+52- Tr. 21'

+42- R.R. Sq. 15'

+33- Tr. 22'

+13- 4 3' Conc. Steps 30'

+04- 4 Dr.

+92- R.R. Sq. 22'

+80- Tr. 22'

+44- Tr. 22'

+28- Tr. 23'

+11- 4 3' Stone Steps 28'

+60- St. 22'

+28- 2 St. 22'

+10- 4 St. 22'

+91- Tr. 24'

+63- 4 6' S.W. 24'

+57- P.P. 26'

+12- Rd. Sq. 22'

+94- Tr. 21'

+25- Tr. 22'

+98- 4 3' Conc. S.W. 31'

+91- Tr. 22'

+83- 4 Dr.

+76- Tr. 22'

+67- 4 Dr.

+26- Tr. 22'

+20- 4 2' Conc. Walk 11'

201

200

199

198

197

196

195

+97-Tr. 34'
 +90- ϕ Dr.
 +81-Stn. 34'
 +65-Tr. 34'
 +49-Tr. 34'
 +32-Tr. 34'
 +17-Tr. 34'
 +08-P.R. Sq. 24'
 +00-Tr. 34'

+92- ϕ Conc. Dr. 34'

+84-Tr. 34'
 +70-Tr. 34'
 +53-Tr. 33'
 +22-Tr. 34'
 +14-P.R. Sq. 19'
 +06-Tr. 34'

+90-Tr. 33'

+36- ϕ Dr.
 +28-Tr. 34'
 +11-Tr. 34'
 +04- ϕ 2' Wind Stems 27'

+76-Tr. 34'
 +60-Tr. 34'
 +19-Tr. 35'
 +06-Tr. 34'
 +02-Tr. 34'

+84-Tr. 34'
 +70-Tr. 34'

+35-P.R. Sq. 20'
 +25-12"X142" C.M.

+17.5- ϕ T.G.R.T. Co.
 +05- ϕ X-St.

+91-Conc. S.W. 24'
 +84-F. Con. 33'
 +82-Hyd. 26'

+22-F. 33'
 +20-Bog. 4' S.W. 28'
 +13- ϕ Dr.
 +03-Tr. 36'

+70-F. 34'

+50-Tr. 35'

+10-Tr. 35'

9" Sanitary Sewer

+97-Tr. 22'
 +88-Tr. 21'
 +79-Tr. 21'
 +71-Tr. 21'
 +45- ϕ Dr.
 +31-Tr. 20'
 +13-Tr. 21'

+97-Tr. 22'

+78-Tr. 21'
 +61-Tr. 22'
 +47-M.H. ϕ
 +27-Tr. 21'

+93-Tr. 21'

+60-Tr. 20'

+85- ϕ 4" Conc. S.W. 28'

+35-P.P. 34'

+92-P.P. 33'
 +90-M.B. 31'


+52-Store 33'

+25- ϕ Dr.

+99-Tr. 21'
 +84-Tr. 21'

+68-Tr. 21'

+38-Tr. 22'

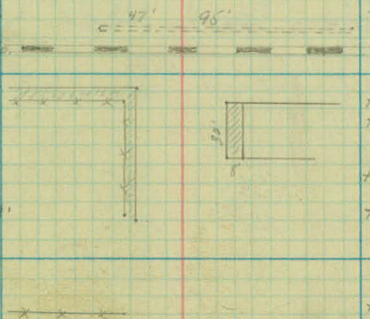

208

207

206

205

204

203

202

21'
18'

+41-30"X52" C.M.

+62-Tr. 23'

+48-E Dr.
12" X 20" C.M. 24'
+38-Tr. 35'

+06-Tr. 34'

+16-X Rd. Sp. 18'

+88-Tr. 33'

+94-Tr. 20'

+50-E Dr.
+41-Tr. 33'

+50-E Dr.

+26-Tr. 34'

+96-E Dr.
+83-Water Plug 26'

+87-E Dr.

+72-Conc. Steps 28'
+63-Tr. 33'

+59-Conc. Steps 16'

+04-Tr. 20'

+99-E Conc. Steps 29'

+78-E Dr.

+40-Tr. 34'

+55-Tr. 19'
+37-Tr. 19'

+19-E Conc. Steps 29'
+06-Tr. 33'
+95-Tr. 23'
+95-Hyd. 22'
+91-St. Sp. 31'

+82-P.P. 25'

+62-E X-5f
+60-M.H. 3.5'
+27-F. Cor. 33'
+23-Tr. 34'

+53-Tr. 21'

+77-Tr. 33'

+84-Tr. 20'

+29-Tr. 34'
+27-F. Cor. 33'

210

209

+73.9 - E. Co. Line



+49 - Rd. Sp. 29'
+41 - Hyd. 22'

+47 - G.P. 26'

+38 - Stop Sp. 25'
+20 - Sta. 27'

