

OFFICE OF COUNTY ENGINEER
RAMSEY CO. MINN.

Rd. Map Survey

CO. RD. J

From S.T.H. 8 To Lexington Ave.

Road Acc't. No. 3

Date Filed 2-5-26

File 3A

County Road. "J"

Rd. No. ~~63~~ 3

Cleveland Ave To Lexington Ave. ✓

~~Hodgson Rd. To. Turtle Lake Rd.~~

~~Centerville Rd To Otter Lake Rd.~~

~~S.H. #1 - West.~~

~~Bald Eagle Blvd West - West.~~

Austin	}	Party.
Skeoglan		
Fritz		
Tankeski		
Frankc		

2-4-26

Office of Ramsey Co. Engineer	
ST. PAUL, MINN.	
Date Filed	2-5-26
File No.	"16"

Station

Ang. ht. Ang. Rt.

52+53.9 P.O.T

45+30.55 P.I

0° 39'


39+35.7 P.I 0° 57'

26+30.8 P.I. 0° 14'

11+67.7 P.I. 0° 49'

0+00

½ Cleveland Ave.

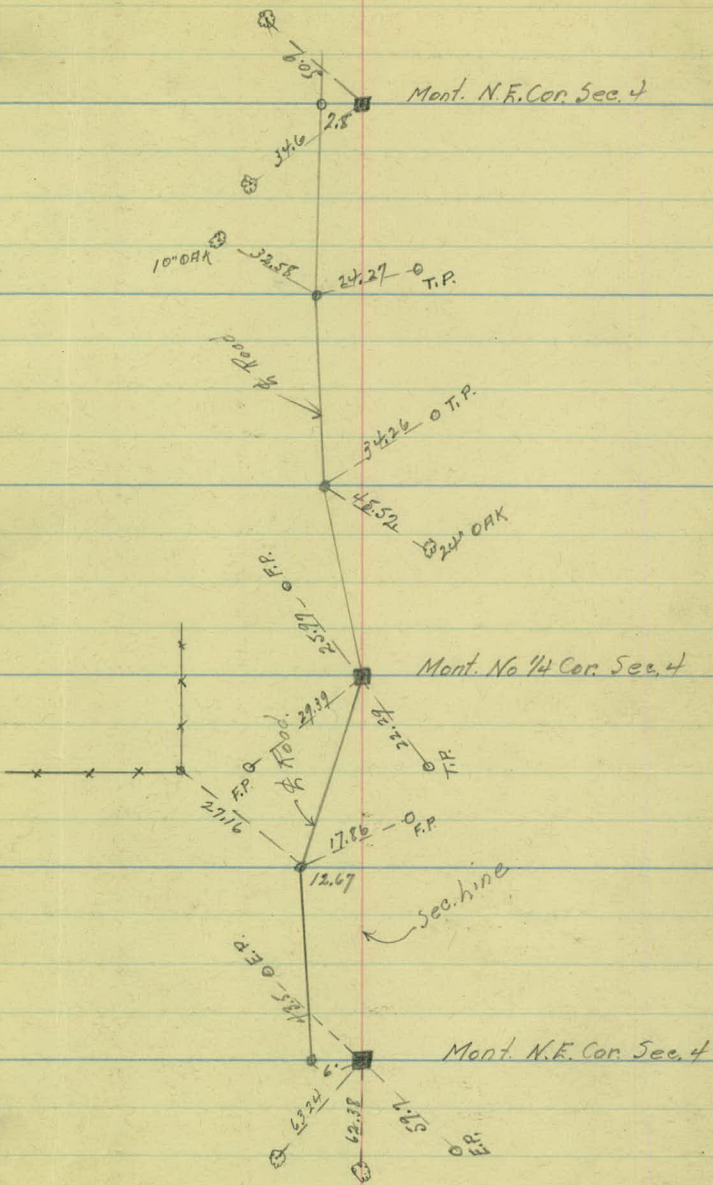


Station

²
Ang. ht. Ang. Rt

59 + 32.4

54 + 27.1 P.O.T.

52 + 53.9 P.O.T.

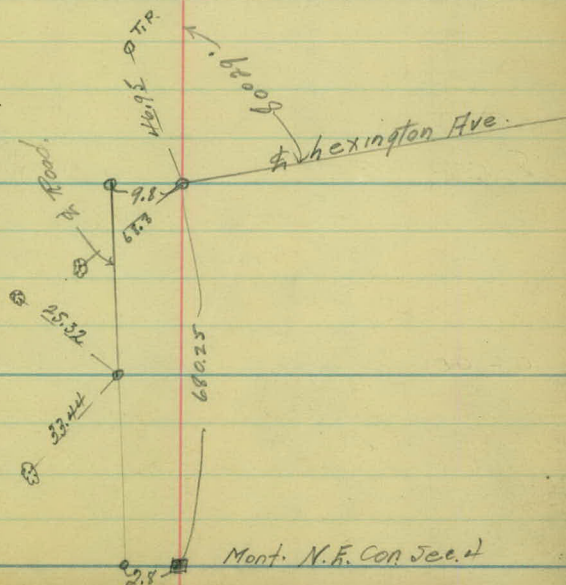

Station

Height Ang. Pt.

78+42.5 Mont. $\frac{1}{2}$ Turtle Lake Road

45+87.15 P.I. $0^{\circ}13'$

26+38.8 P.I. $0^{\circ}05'$

8+32.0 P.I. $0^{\circ}40'$

0+00 Mont. $\frac{1}{2}$ Hodgson Rd.

County Road. "J"

Road. No. 63.

Artificial Topography.

Shoulder Gravel
Width Surface



5+00 23' 17'

1+00 22' 17'

①

6+00

5+00

4+00

3+00

2+00

1+00

0+00

Pasture land

Cultivated land

+84 R.P. 24.5

+53 T.P. 22.5

~~+53 -~~

+11 T.P. 21.5

+32 P.P. 24

+82 R.P. 23.5

+78 T.P. 20

+33 P.P. 23

+17 Rd. Sign 9

+066 P.P. 9.5


+066 Cor. 16

+42 R.P. 23.5

+43 T.P. 19

+23 Rd. Sign 30

-05 1/2 Cleveland

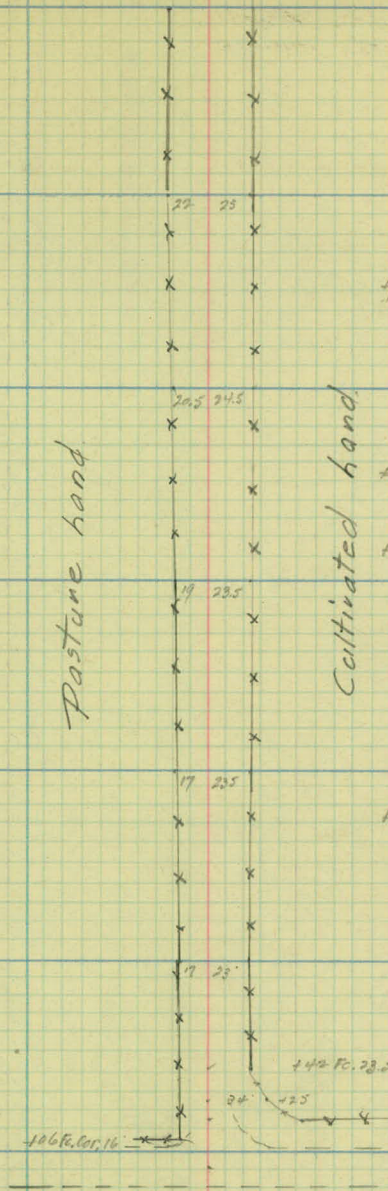

Shoulder Gravel
Width Surface

10+00

23'

18'

②

13+00

Cult

+44 T.P. 26.5

12+00

+84+85 M.B. 16.5

+87 Fe. Con 19

+78 G.P. 21.5

+68 $\frac{1}{2}$ Road

Cultivated

11+00

+89 P.P. 26.5

+89 T.P. 27' Nt.

10+00

+44 P.P. 26.5

+45

+28 T.P. 26' Fe. 27

9+00

Pasture land

+88 P.P. 25.5

Cultivated

8+00

+75 T.P. 25

7+00

+34 P.P. 25

+05 T.P. 23.5 6+00

Shoulder Gravel
Width Surface.

15+00 25' 18"

19+00

+12 T.P. 22.5

18+00

21.5 19

+17 T.P. 22.5

17+00

21.5 17

16+00

22 16

+16 T.P. 24.5

15+00

21.5 15.5

+05 T.P. 25.5 14+00

22 15.5

13+00

21 15.5

Cultivated Land

Cultivated Land

Station Shoulder Gravel
 Width Surface

25+00 22' 17'

20+00 25' 18'

(2)

27+00

21.5 25



+20 T.P. 20' R/L

26+00

21.5 22



25+00

21 21



+22 T.P. 20'

24+00

22 21.5



+23 T.P. 20.5'

23+00

22 22



22+00

22 22



+24 T.P. 21.5'

21+00

22 21.5



+25 T.P. 22

20+00

22 21

Cultivated land.


Cultivated land

Station	Shoulder Gravel Width Surface	
---------	----------------------------------	--


30+00	23'	16'
-------	-----	-----

(5)


24

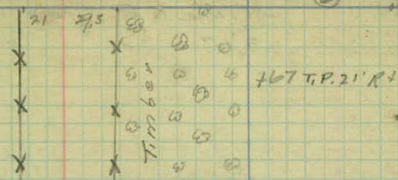

33

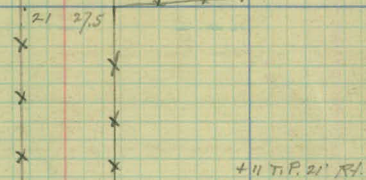


32

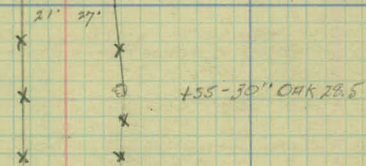


31

Cultivated land

Cultivated land

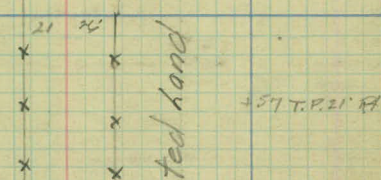


30

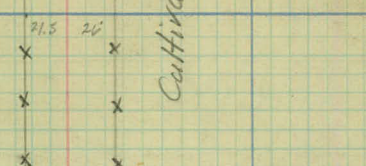

29



28

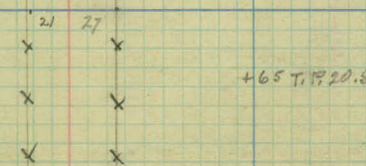

Shoulder Gravel
Width Surface

40+00 24 17

35+00 24 18

Cultivated land

Cultivated

40+00

20.

+63 T.P. 20

+35 Fohine

39+00

19.

105 Fc. Cor. 25.5

+15 T.P. 20 R1

38+00

41.0

Cultivated land

Timber + Pasture land

37+00

20'

23'

+70 T.P. 21 R1

36+00

22'

25'

+14 T.P. + Fc. 21

35+00

21

24

Shoulder Gravel
Width Surface.

45+00 24' 17

Pasture
Timber

+00 F. hie

+22 T.P. 20'

47+0

+17 (6" @ 19.5 ft)

+52 (10" @ 24 ft) Beg. Brush

+41 T.P. 22'

46+0

Cultivated land.

Cultivated land.

45+0

+12 T.P. 23' R4

44+0

43+0

+58 T.P. 22' R4

42+0

+77 F. Cor 29.0

+10 T.P. 21'

Station Shoulder Gravel
Width Surface.


50+00

23

16'

Opeland.
+66 Fa. Cor. 34'
+34 (18" @ 24.5)
+06 (16" @ 26.5)

+92 T.P. 15
+32 Fa. Cor. 17

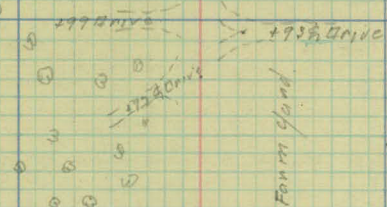

+83 M.B. 11.5 (+86 M.B. 15)
+49 (16" @ 23)

+70
+13
+56 R.P. 15'
+83 T.P. 17'

Orchard
Form. clund.
Cult.

+01 (30" @ 26)
+90 (24" @ 15)
+87 M.B. 14
+75 End Brush
+92 (12" @ 25)
+98 (6" @ 19)

+154 Drive
+94
+29 R.S.
+12
+33 T.P. 15'

Form. clund.
Timber land
Cultivated land

+37 (12" @ 24.4)
+02 (12" @ 25.5)
+16 (20" @ 26.4)

+73 T.P. 19.4'

Pasture + Timber land
Cultivated land

Station	Shoulder Gravel Width	Surface
---------	--------------------------	---------

58+00	24	17'
-------	----	-----

55+00	23	17
-------	----	----

6040

- +32.4 \$, Lexington

406 Rd 519 9.36 59400

495 M. Box 19.5

479 (12" x 51")

+56 (14" E 36')

435 (14" E) 30')

415 (12" @ 30")

+93 (14" E 30')

+71(10°E 29')

+48 (16" @ 28.5)

+ 28 (12" E 27.5)

406 (12" @ 27.5')

58+00

5740

+78 Ft. Cor. 34')

458 (12" @ 27')

437 $\angle 12^\circ \text{ @ } 27^\circ$

115 (16th to 27th ht)

+ 49 T.P. 15' R1.

5640

+75(12" E @ 26.5)

 $+50(12'' \text{ to } 26'')$

134 (12' E 26)

+0.5 (18' to 20')

432 P.P. 25

55700

Shoulder Gravel
Width Surface

5+00

28

20

1+00

25

20

0+00 & Hodgson Rd