

OFFICE OF COUNTY ENGINEER
RAMSEY CO. MINN.

Road Map.....Survey

CASTLE AVE.

From White Bear Ave To Margaret St.

Road Acc't. No. 40

Date Filed 1-19-26 File

Office of Ramsey Co. Engineer
ST. PAUL, MINN.

1-19-26

Ref. 9c # 40.

Alignment on Castle Ave
from the Old White Bear Rd. to
Margaret St.

Sta. Point Lt. Rt.

17+45¹ P.I. 0°-24'

N 89°-36' E

5 89°-58' E

13+45¹ P.I. 0°-24'

x

9+74³ P.O.T.

N 89°-36' E

0+00

12/23/25

34⁰⁵ 34" C&K

39⁰⁰
0 T.P.

24⁰⁰ 0 Hub

20¹⁵

0 Hub

33⁸⁷ 0 Hub

9¹⁵

0 Hub

77+16 Old White Bear Rd =
0+00 Castle Ave.

70°31'

31⁹

12³ Elm

5¹²

0 T.P.

Sta. Point Lt. Rt.

80+28⁸ East line of Margaret St.

N. 88°-39'E ✓

72+34⁶⁰ P.I.

37°-09'

x

N. 51°-30'E ✓

46+57³⁰ P.T.

45+04⁴ P.I. 38°-06'

N. 89°-36'E ✓ x

43+06³⁰ P.C.

12/28/95

Iron Mt. 99'

90°
50°
T.P.
55°
0 T.P.

43706[±] -

P.P.
0

Δ - 38°-06'

44 - 4°-41'

11 1/2°

D. - 10° H

45 - 9°-41'

Hop
H 17 48


T. - 198¹⁰

46 - 14°-41'

L. - 381⁰⁰

787³⁰ - 19°-03'

R. - 573⁴⁹

 

Rd # 40.

Castle Ave from the
White Bear Rd. to Margaret Ave.

5

4

3

2

1

0+00

12/22/23
Crane

✓ S.L.-12
C.L.-10

S.L.-12 ✓
C.L.-10

Cultivated field

Cultivated field

✓ S.L.-12
C.L.-10

S.L.-12 ✓
C.L.-10

✓ 730 Co. Rd. S. 1/4 Sec. 14,
Mar. 1922 H.

124 Cross Grain ✓
15 x 30 C. M.
Extends 102.80' N.
Very Good Cond.

WHITE BEAR AVE.

one course Conc.
Pavement

11

10

9

8

7

6

5

12/28/25

✓ S.L.-13
G.L.-10

✓ S.L.-13
G.L.-10

Cultivated field

Cultivated field

✓ S.L.-13
G.L.-10

✓ S.L.-13
G.L.-10

17

14

15

14


13

12

11

12/28/25

✓ F. 33 L.

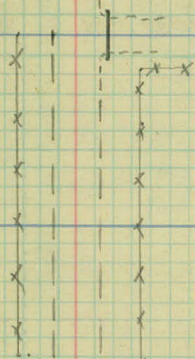

400 Farm Ent. ✓
 400 Silo Drain 10' 6"
 10' x 24' C.M. 10' 6" Cont. ✓
 484 F. Cor. 35' N. ✓
 455 C. Fence 34' ✓

✓ S.L. - 12
 G.L. - 10

S.L. - 12 ✓
 G.L. - 10

✓ 432 F. Cor. 18' L.

445 Iron Road 34' ✓
 415 F. Cor. 34' N. ✓

Cultivated Field

Cultivated Field

S.L. - 12
 G.L. - 10

S.L. - 12
 G.L. - 10

23

22

21

20

19

18

17

12/29/65

S.L.-12
G.L.-10

S.L.-12
G.L.-10

Woods

145 T.P. 31

✓ F. 31 L.

✓ 155 P.P. 16 L.

Woods

189 Iron Mont. 353 ✓
184 P.P. 31 R. ✓
168 C. 57 1/2 ft. ✓
168 Siph. 17' ✓
15 X 30 C. Wood 34 ✓
154 Iron Mont. 34 ✓
154 F. Cor. 35 R. ✓
155 T.P. 35 R. ✓
120 P.P. 16 ✓

✓ F. 31 L.

✓ 142 C. Fence 34

S.L.-12
G.L.-10

S.L.-12
G.L.-10

Woods

188 P.P. 29 ✓

177 C. Fence 34 ✓

Cultivated field

Cultivated field

F. 37 L.

153 P.P. 26 R. ✓

142 C. Fence 34 ✓

121 F. Cor. 34 R. ✓
118 P.P. 34 R. ✓
110 Nail Box 18

29

28

27

26

25

24

23

14/29/25

S.L.-12
G.L.-10

S.L.-12
G.L.-10

- ✓ +97 Mail Box 14
- ✓ +92 P.P. 17 L.
- ✓ +48 F. Int.
- ✓ +41 F. Cor. 21

- +48 Iron Post 33
- E. line of Street
- +38 Mail Box 13 R.
- +04 Street
- +77 Side Drain 19 R.
- 12' X 28' C.M.
- Good Cond.
- +77 P.P. 22
- +53 T.P. 32 R.

x x

pasture

- ✓ +32 P.P. 17 L.
- ✓ F. 26' L.

- +99 P.P. 21
- +20 T.P. 26

- ✓ +59 O. Fence 35

x x x

S.L.-12
G.L.-10

- ✓ +83 P.P. 14 L.

Woods

- S.L.-12
- G.L.-10
- +97 T.P. 32 R.
- +93 P.P. 20 R.

- ✓ +22 P.P. 35^E L.
- ✓ F. 38' L.

- +14 T.P. 33

Woods

- ✓ +33 Mail Box 13
- ✓ +13 Farm E. Int.
- ✓ +55 Side Drain 19 L.
- 15' X 58' C.M.
- Good Cond.
- +03 P.P. 15 L.

- +51 T.P. 31 R.

35

34

33

32

31

30

29

12/29/25

✓ S.L.-12
G.L.-10

✓ 114 Cross Drain
36" X 40' G.M.
Good Cond.
Drains 14'
✓ Extends 12' R. & 19' R.
✓ 112 Cross Drain 192

✓ 175 P.P. 17' L.


Cultivated Field

Cultivated Field

✓ S.L.-12
G.L.-10
✓ 184 Ridge 10' R.
✓ 175 Hedge 31' R.
✓ 183 T.P. 32 R.
T.P.

✓ 122 T.P. 30 R.

✓ 133 F. Cor. 35
✓ 125 P.P. 18

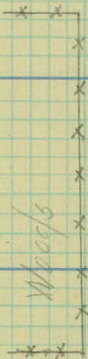

Woods

✓ 180 F. Ent.
✓ 130 Side Drain 12'
12" X 26' G.M.
Good Cond.
✓ 114 Nail Box 12 R.

✓ 132 T.P. 27' R.

✓ 183 P.P. 17'
✓ 157 F. Cor. 51'
✓ 105 Cross Drain
18" X 36' G.M.
Good Cond.
Extends 18' R. & 18' L.
Drains 14'

✓ 162 F. Ent.
✓ 162 Side Drain 20'
12" X 20' G.M.
Good Cond.

S.L.-12
G.L.-10

✓ S.L.-12
G.L.-10

✓ 135 P.P. 18

✓ 165 T.P. 23' R.
T.P.

41

40

39

38

37

36

35

14/49/20

✓ 184 P.P. 18' L.

3.2-12
C.L.-10

✓ 145 P.P. 18' L.

✓ 103 P.P. 18' L.

✓ 161 P.P. 18' L.

3.2-12
C.L.-10

✓ 134 Field, East
134 Side of Drain 25
12 X 26 C.M.
Good Cond.
✓ 117 P.P. 18' L.

Cultivated field



104 F. Cor. 31' 5" ✓
3.2-12
C.L.-10
104 P.P. 18' L.
104 Side of Drain 25 ✓
12 X 26 C.M.
Good Cond.
104 F. Cor. 31' 5" ✓

100 P.P. 32' R. ✓

103 End of Hedge 33 ✓
103 F. Cor. 33' 15" ✓
103 P.P. 32' ✓
112 Hedge Cor. 33 ✓
103 Pri. Est. ✓
103 Side of Drain 25 ✓
12 X 26 C.M.
Good Cond.

108 Hedge Cor. 33 ✓
101 Mail Box 13

140 P.P. 31' R. ✓
139 C. Fence 30' 15" ✓

3.2-12
C.L.-10

139 Hedge Cor. 31' ✓
115 Farm Est. ✓
119 Hedge Cor. 31' ✓
135 Side of Drain 25 ✓
12 X 26 C.M.
Good Cond.

47

46

45

44

43

42

41

12/27/23

✓ S.L. 13
G.L. 11

S.L. - 13
G.L. - 11

✓ S.L. 14
G.L. 12

S.L. 14
G.L. - 12

✓ S.L. 14
G.L. 12

S.L. 14
G.L. 12

✓ +72 P.P. 10' L.

+68 Farm Ent.
+68 1/2 P.P. 12' L.
12' X 14' G.L. 11
Good Cond.

✓ S.L. 14
G.L. 12

S.L. 12
G.L. 10

✓ +24 P.P. 18' L.

✓ +20 Cross P.M. 17
34' X 40' G.L. 11
Fence 19' R.R. 4' L.
Bridg 11'
Good Cond.

+15 F. Cor 33

Cultivated field

Cultivated field



53

52

51

50

49

48

47

12/29/23

✓ S.L.-12
G.L.-10

S.L.-12
G.L.-10

Hay Meadow

Hay Meadow

100' Cross drain ✓
30' x 57' C.M.
Extends 19 ft.
Good Good
prins Lt.

✓ +48 Egan Ent.
✓ +48 Side Drain 257
12" x 24" C.M.
Good Cond

S.L. 12
G.L. 10

+25 P.P. 14 ✓

S.L. 12 ✓
G.L. 10

59

58

57

56

55

54

53

12/29/25

✓ S.L.-12
G.L.-10

Hay Meadow

Cultivated Field

S.L.-12
G.L.-10

+16 Side Drain 18⁵

+84 Side Drain 18⁵ L.
18" X 30" G. M.
Good Cond.

+86 Street.

+84 Side Drain 18⁵
+82 Side Drain 18⁵
24" X 30" G. M.
Good Cond.

✓ S.L.-12
G.L.-10

Hay Meadow

Hay Meadow

S.L.-12
G.L.-10

65

44

43

42

41

40

59

12/29/25


S.L.-12
C.L.-10

✓ 415 Path to House
✓ 419 Side Drain 18"
12" X 6 C.M. Good Land

✓ 486-14"-T-34
✓ 449 Side Drain 18"
12" X 6 C.M. Good Land
✓ 475-14"-T-34
✓ 445-12"-T-34
✓ 432-6"-T-34
✓ 418-12"-T-34 L.

S.L.-12
C.L.-10

Cultivated field

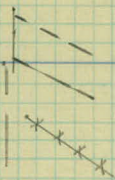

477 Side Drain 18"
15" X 32 C.M. Good Land

472 C.Fence 14 R. ✓

S.L.-12
C.L.-10

462-14"-T-31 R. ✓
448-14"-T-31 R. ✓
421-14"-T-31 R. ✓

495-14"-T-31 R. ✓

468-12"-T-31 L. ✓

427-12"-T-31 ✓

S.L.-12
C.L.-10

Cultivated field

71

70

69

68

67

66

65

12/29/25

S.L. 16'
G.L. 14'

S.L. 10'
G.L. 8'

✓ 74-4"-T-36 L.

144-18"-T-30 R.

✓ 74-10"-T-35 L.

✓ 782 Pri. Ent.

✓ 782 Side Drain 43
12' X 18" C.M. Good Cond.

189 Pri. Ent.
189 Side Drain 18"
12' X 26" C.M. Good Cond.

✓ 148-16"-T-50 R.

✓ 703-14"-T-35 L.

Yard

✓ 798-12"-T-35 L.

✓ 164-12"-T-50

✓ 754-10"-T-35

✓ 157-14"-T-30

✓ 700-12"-T-35 L.

Yard

✓ 700-12"-T-35 L.

✓ 775-6"-T-35 L.

✓ 759-6"-T-35 L.

125 Pri. Ent.
125 Side Drain 19"
12' X 24" C.M. Good Cond.

✓ 732-14"-T-36 L.

✓ 705-12"-T-36 L.

✓ 779-18"-T-36 L.

✓ 722-14"-T-36 L.

✓ 794-14"-T-36

✓ 780-14"-T-36 L.

✓ 778 Iron W. Sign 36

✓ 752 Side Drain 18"

✓ 714 Side Drain 18"
15' X 36" C.M. Good Cond.

✓ 710 Iron Man 4' 11"
W. Inc. First St. N.E.

756 Pri. Ent.
756 Side Drain 18"
12' X 24" C.M. Good Cond.

✓ 710-18"-T-30

✓ 778 Pri. Ent.

✓ 778 Side Drain 18"
12' X 20" C.M. Good Cond.

✓ 751 Hydr. 17"

✓ 719 Side Drain 18"

✓ 714 X Street

77

74

75

74

73

72

71

12/29/22

- ✓ +89-10"-T-22
- ✓ +68-6"-T-22
- ✓ +52-12"-P-21
- ✓ +48-6"-T-22
- ✓ +38-14"-T-22
- ✓ +10-6"-T-22
- ✓ +77-6"-T-22
- ✓ +72-6"-T-22

- ✓ +99 P.P. 22
- ✓ +47-2"-T-22

- ✓ +57 R.R. Sign 22
- +54 Bay View 22
- of Sign Wall 25 ft.
- 4" Wide
- ✓ +45 P.P. 22
- ✓ +07 Stone Wall 95

- ✓ +34-0 Stone Wall 31
- ✓ +08 Stone Wall 31
- 4" x 12"

- ✓ +52-13"-T-22
- ✓ +41-12"-T-22
- ✓ +02-13"-T-22

+96-6"-T-22 ✓

+54 P.P. 23 ✓

+08-4"-T-22 ✓

+55-4"-T-22 ✓

+08-4"-T-22 ✓

+00-4"-T-22

+13-4"-T-22 ✓

+69-6"-T-22 ✓

+54 Bay View 9
- +54 Sign Wall 25
- 4" Wide
- +27 4" Nelson St

+55 S.L. 17 ✓


+06 P.P. 19 K. ✓

S.L. 9

S.L. 8

+55-14"-T-50 ✓

4" HIGH

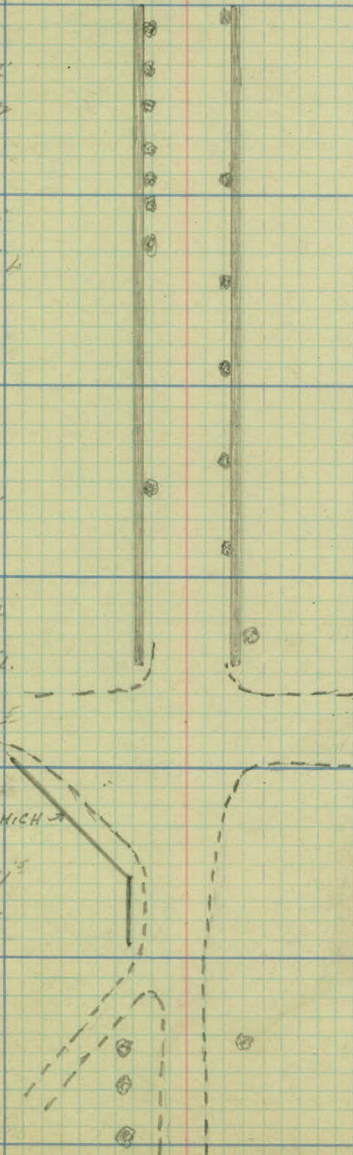

81

80

79

78

77

12/29/24

+39 Side Drain 12"
15" C.M.
+32 Side Walk 11"
16" Cross Drain
15" x 60 C.M.
Extends 30' L & 30' R

+77 Cross Drain
15" x 60 C.M.
Extends 30' L & 30' R
+70 End of S. Wall 25'

+63 Side Drain 17"
+62 P.P. 20' L
+59-12" T-22

✓ +24-12" T-22

✓ +89-12" T-22
✓ +60-2" T-22

✓ +40 School Sign 10'

✓ +30-2" T-22

✓ +08 P.P. 20' L

✓ +81-2" T-22

✓ +52-2" T-22

✓ +13-10" T-22 L

✓ +09-10" T-22

+19 Side Drain 12"
15" C.M.
+12 Side Walk 21"

+70 End of Side
Walk 24'
+63 Side Drain 16'

+58-10" T-22 ✓

+46-10" T-22 ✓

+20-14" T-22 ✓

+08-14" T-22 ✓

+46-14" T-22 ✓

+28-4" T-22 ✓

+12-8" T-22 ✓

+95-1" T-22 ✓

+47-0" T-22 ✓

+31-6" T-22 ✓

+14-4" T-22 ✓

+10-4" T-22 ✓

