

OFFICE OF COUNTY ENGINEER
RAMSEY CO. MINN.

Road Map Survey

COUNTY ROAD A2

From Dale St To McCarron's B.

Road Acc't. No. 41

Date Filed.....

File.....

ALIGNMENT.

CO. ROAD A2

From Dale St. to McCarrons Blvd

 $\frac{1}{2}$ 41

Station Point Lt. A Rt




13+03.4 P.O.T. (End)
on Sec. Line


11+77.78 = 0+00 - ME C. Blvd. S.

11+03.7 = 0+00 - ME C. Blvd. N.

8+35.7 P.O.T.

0+00 Mont.

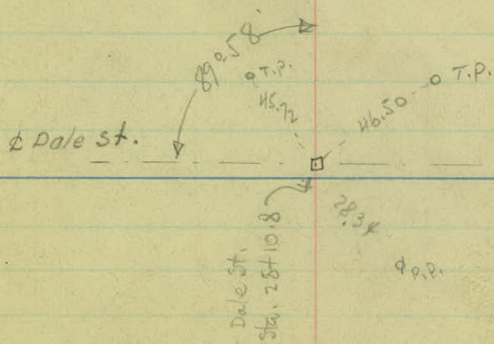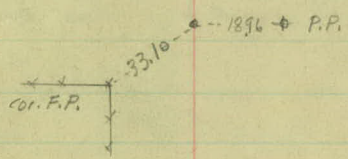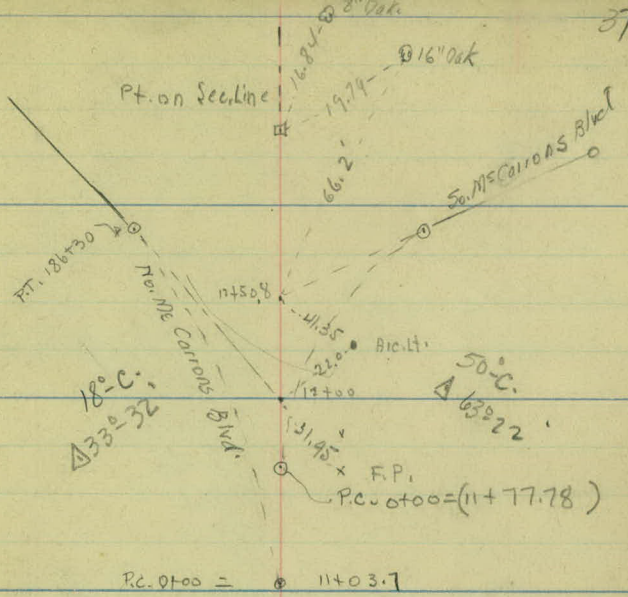

 

TOPOGRAPHY

CO. ROAD A2

FROM

DALE ST. (S.T.H. 49)

TO

MC CARRON'S BLVD.

a/c 41

106 - 2 Drive Lt.

5400

+82 - 2 Drive Lt.

+57 15" X 40' c.m.

+50 15" X 43' c.m.

4400

+75 - 2 Drive Lt. -


3400

+66 - 2 Front Lt.

2400

1400

0400

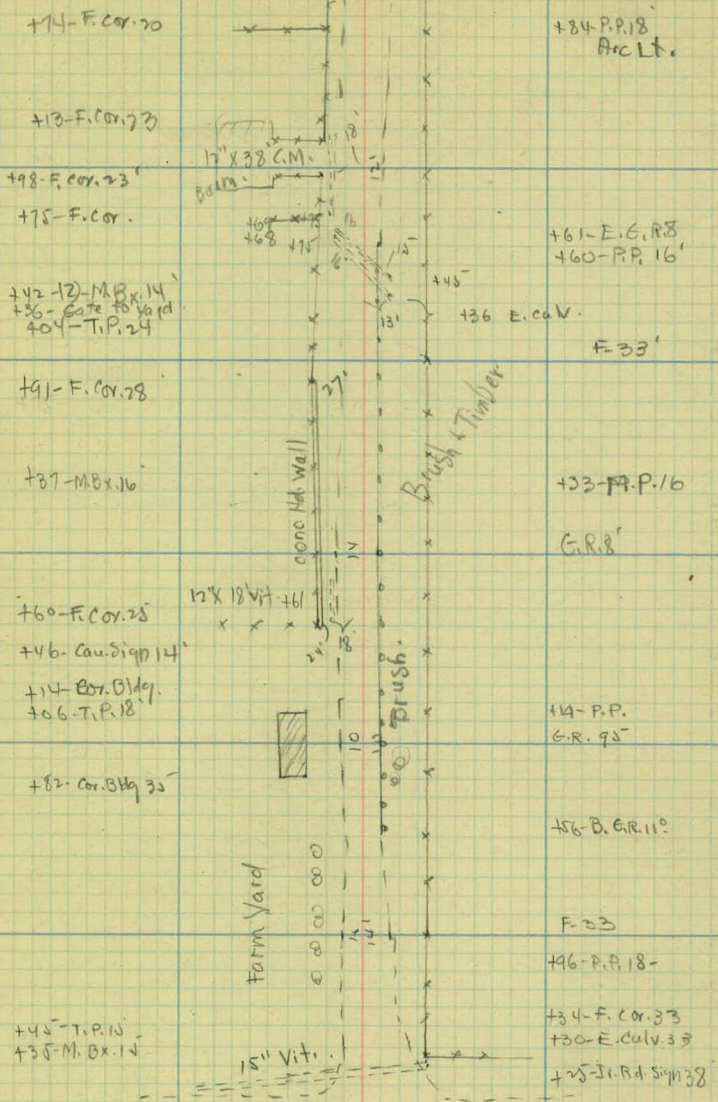

See
Dale St. Notes

13

12

11

10

9

+23- 2 F Ent + W.

8

+35- 2 F Ent + L.

7

6

See M^cCarsons Blvd.
North & South.

404-Shoulder 18

+30-A.F. 44'
F-35

+34-A.F. 24
+4-Arc. Lt. 18'
F-18

F-22

+50-F. 12'

F-17

+98-R.P. 15'

F-20

pasture

+34-B.F. 22
+22-F. cor. 22
F-32

E 18'

cultivated

+77-R.P. 18

+36-F. cor. 18'

+34-R.P. 19'

+68-F. cor. 18'

+99-M. Bx. 18

+44-F. cor. 18

10" x 20" C.M.
+26

+04-R.P. 18

+99-F. cor. 18

+50-F. cor. 18

Timber & Brush

#