

OFFICE OF COUNTY ENGINEER
RAMSEY CO. MINN.

Road Map Survey

ARCADE ST.

From S.T.H. 61 To C.O. RD. B

From Keller Pkwy To La Bore Rd.

Road Acc't. No. 43

Date Filed 1-10-27 File

402-57
623.68

1-5-27

Alignment

Road #43

Arcade St. from S.T.H. #61
to CO. RD. "B" (S.T.H. #36)

ROAD MAP.

Received 1-8-27
C. J. H. [Signature]

Office of Ramsey Co. Engineer	
ST. PAUL, MINN.	
Date Filed	1-10-27
File No.	

Sta.

Δ -Lt.

Δ -Rt.

26+28

P.I.

$0^{\circ}05'$


0+00

14-31-26

Wilshugen
Berthigume
SKOOGLUN
Messenburg

Co. Rd. B

Meint Inp.

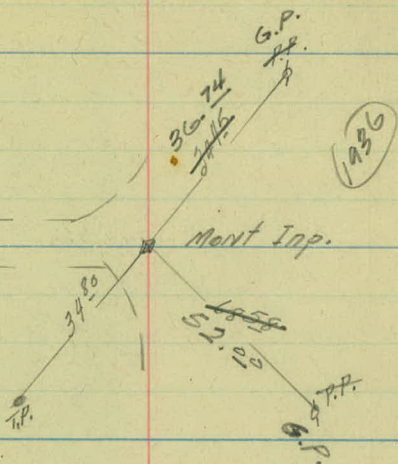


N.E. 1/4 Sec. 17-29-22

N.W. 1/4 Sec. 16-29-22

Co. Rd. 4.3

No. 1

Brass Plate gone

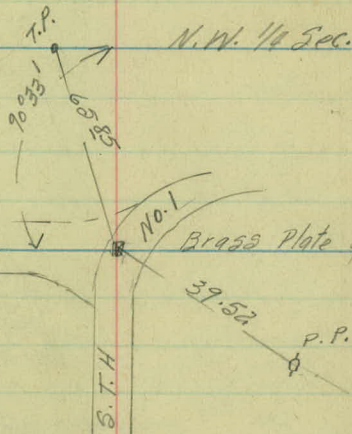

Station	Point	ang. H.	ang. H.	Bear.
55+05 ⁶⁰	P.T.	✓	16° 18'	
+50			14° 05'	
54+00			12° 05'	
+50			10° 05'	
53+00			8° 05'	
+50			6° 05'	
53+07 ⁷⁰	P.L.		34° 36'	
52+00			4° 05'	
+50			2° 05'	
51+00			0° 05'	
50+98.10	P.C.	✓	0° 00'	

52+56⁸⁰ Mont.

33+06² P.O.T.

Artificial Topography

Arcade st.

From S.T.H. # 61 to ~~the Hwy~~ PK. Hwy

CO. RD. "B" (S.T.H. 36)

Sta.

Wibhusen

Goldberg

Stoogkum

Berthiaume

Mossenburg

5+00

4+00

3+00

+83

F. Ent. Lt.

2+00

+92

F. Ent. Lt. 12" x 14' C.M

1+00

0+00

+90 @ 22'

+71 Caution Sq. 15'

+34 P.P. 16'

Pasture

ARCADE ST.

Fence 25'

+04 P.P. 16'

+77 @ 25'

+67 @ 25'

+49 X Fence

Woods

Shoulder 12'

Farm Yard

Shoulder 15'

+93 F. Cor.

+83 F. Ent

+75 F. Cor. 23'

+69 @ 23'

+34 @ 22'

+22 G.P. 14'

Farm Yard

+67 P.P. 17'

+10 Rd. Sq. 29'

+07 P.P. 37'

+03 Rd. Sq. 36'

+92 F.E.

+85 F. Cor. 24'

+81 G.P. 16'

+77 @ 22'

+57 Steps 23' (4' Wide)

+44 T.P. 12'

Orchard

+65 Rd. Sq. 26'

+60 T.P. 26'

+60 F. Cor. 26'

+50 Rd. 20'

+25 Rd. 50'

+00-18 x 135 C.M. 21'

+66 S.T.H. #1 - a.0'

+50 S.T.H. #1 - 4.9'

+25 S.T.H. #1 - 9.7'

+29 Spillway

+21 @ 24'

+21 G.P. 28'

+07 P.P. 39'

Co. Rd. A2

S.T.H. #61

Woods

+88

Drive Rt.

12+00

+48

F. Ent. Lt 15' x 24' C.M Inp.

11+00

10+00

9+00

8+00

7+00

6+00

+88 Drive

Cult.

+13 @ 28'

+13 P.P. 16'

+78 F. Cor. 25'

+97 C.M. 15'

+85 F. Ent 23'

+75 C.M. 21'

+48 F. Ent.

+10 to +70 12 Trees
Fence 23

+86 P.P. 16'

Shoulder 14'
Fence 22

Shoulder 13'

Pasture

+56 P.P. 16'

Fence 23'

Fence 24'

+12 Light P. 16'

+00 2 @ 25'
Fence 25

+74 P.P. 16'

Reg. of Swamp

19+00

+59

Drive Rt.

18+00

+83

Drive Rt.

17+00

16+00

15+00

14+00

13+00

+27 P.P. 16'
+25 Beg. Swamp

19' 12'

+52 G.P. 21'
+49 26
+34 26
+12 24

+59 Drive
+53 Light P. 16'

+92 24
+83 25

+85 P.P. 16'
+83 Drive

Cultivated

+40 P.P. 17'

Woods

Shoulder 14'

12' 12'

+79 G.P. 17'

Shoulder 16'

+80 P.P. 18'

+36 Light P. 17'

End of Swamp

10' 10'

+28

Co. RD. B

26+00

+98

Drive 12" x 16' C.M.

25+00

24+00

+24

Drive Rt. 12" x 20' C.M. Inp.

23+00

22+00

21+00

+92

Cross Drain 24" x 48' C.M.

20+00

+57 P.P. 29'

+06 T.P. 28.
+00 G.P. 26

+67 @ 26'

+18 Rd. Sign 16'
Shoulder 14'

+52 G.P. 22'

Cultivated

+92-24' x 48' C.M.

23' 25'

✓
+66 EC. 36
+69 T.P. 33
+61 G. P. 12
+59 P.P. 16
+51 G.P. 10
+30 M.B. 17
+28 Rd. Sq. 17
+25 Rd. Sq. 17
+08 G.P. 19'
+98 Drive
12' x 16' C.M.

Shoulder 16'

+49 P.P. 16'

+24 Dr. 12' x 20' C.M.
+08 P.P. 16'

+90 End Swamp

+34 Rd. Sq. 16'

+78 P.P. 16'

+61 P.P. 17'

33+00

32+00

31+00

30+00

29+00

28+00

27+00

1-5-27

{ Wischusen
D.S.
P.B.
P.M.

Alignment.

Arcade St. #43

From Keller Pk. Way to Labore Rd.

Road Map.

Received 1-8-27
O. J. Handerson

91

1-10-27

Station Point ang. ang.R. ^{Cal.} Bearing

10+74¹⁰

E of Labore Road

6+83²⁰ West.

0+00

12" Br. ddr

Iron Pipe

1-5-27

Austins Survey
Sta. 23+42.19
P.P.

T.P.

55.88

Labore Road

P.T.
H. Survey

N.E. 1/4 Sec. 5-29-22

N.W. 1/4 Sec. 4-29-22

6" Br. ddr


6" Br. ddr

4 1/2

39.92

Note: Went down 4'

Spire

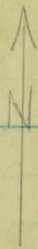

Arcade St.

S.E. 1/4 Sec. 5-29-22

S.W. 1/4 Sec. 4-29-22

58° 01'

P.P.

P.P.


57.85

37.08

Weller Ph. Way

Note: Not in.

N.C.

 

1-4-27

Fair-cold

Arcade St.

From Keller Pk. Way to Labore Rd.

{Wilshusen
Skoglund
Berthiaume
Meisenburg

Topography

a/c 43

4+00

Note = from 3+90 to 8+70
Cons. by C&N. Starts with Wells
at 3+90 00 to 8+70 2' deep 3.5'

3+00

Wide wells 12" thick

2+00

1+00

0+00

+71 FL 27

+51 T.P.

+34 F.G.P. 38'

+07 Drive Way 11 14 1/2 Timber

+93 F of Row Trees 25

+87 F.R.P. Sign 8

+37 T.P. 16'

S-11 +13 Cor Shack

+97 Cor Shack 36' 30' Deep - 16' W

+89 Cor Shack 36' 24' Deep

+34 Cor Shack 32'

Trees 25

+03 Cor House 37

+78 B-Row Trees 25

+79 T.P. 13

+52 Cor House 36' 38' Deep

+52 T.P. 13

Rd 19 + 36

+44 Rd Sign 23

+39 P.P. 16'

Rd 22 + 16' 6" P.P.

24" V.P. 50' long

Woods

Large and Trees

Yellow

Arco 34

Park Way

Gervias Lake

+58 T.P. 19'

F.L. 33

+26 T.P. 20'

+26 - 2 M. P.S. 14

F.L. 33 S. 12'

+76 - 2 Trees - 33

F.L. 33

+92 T.P. 23

F.L. 32

+40 T.P. 26'

Rd 31 - F.L. 41

Waste land and Scattered Timber

11+00

10+00

9+00

8+00

7+00

6+00

5+00

+45 T.P. 48
+48 Rd. 75
+37 F.G. 32
+30 Rd. 15

F.L. 29 - Rd

+79 T.P. 17'

R.L. 24

+70 - 20' end Cult.

+55 T.P. 16'

F.L. 24

+53 - F.L. 24

+18 E. of Woods 37
+18 T.P. 16
F.L. 37'

F.L. 37

+84 T.P. 16'

+47 F.L. 34 - 45

+107 F.L. 37'
S. 10

T.P. 4
Labore Road

+60 F.G. 25
+60 Rd. 25
+55 F.L. 39'
+30 Rd. 14'

F.L. 30 Rd. 10
+94 T.P. 17

14' out. 60' long. 6' wide
Beginning of Conc.
Rubble Stone 700 ft.
P.P. 13 - F.L. 30

+89 int of Pipe 47 X 30" C.M.
+72 T.P. 16'

F.L. 33

+60 B. Woods 32
+42 T.P. 16'

F.L. 33

+85 Rd. 50 ft 19

T.P. 18 - F.L. 33

S. 12' F.L. 33

Yard and Scattered Trees

Woods


Wash land and scattered timber

Woods

+70 F. of
conc. ditch 10'
3.5' wide
2' deep
12" T&E.R.

ditch 20'

ditch 20'

 

284131

ARCADE ST. #43 - From Keller Pkwy. to Labore Rd.

