

OFFICE OF COUNTY ENGINEER
RAMSEY CO. MINN.

Road Map.....Survey

LARPENTEUR AVE (Ord. A)

From Hamline Ave. To Wheelock Pky.

From Edgerton St. To Payne Ave.

From Phalen Blvd. To Lake St.

From Prosperity Ave. To East Ave.

Road Acc't. No. 50

Date Filed 5-27

File

Warpenteur Ave.

Rd % # 50

Alignment.

Road Map Survey.

Hamline

From Snelling Ave. to Wheelock Pkwy.

Received 3.4.27
J. H. [Signature]

Office of Ramsey Co. Engineer
ST. PAUL, MINN.
Date Filed 4-7-27
File No. 16

Sta Point Lt Rt.

105+44⁹⁰ PI 1°-07'

262815

79+16⁵² PI 0°-11'

264244







52+74⁴⁴ PI 1°-41'

39+62² P.I. 0°-01'

26+62² PI 0°-30'

SEE RD NO 14

0+00

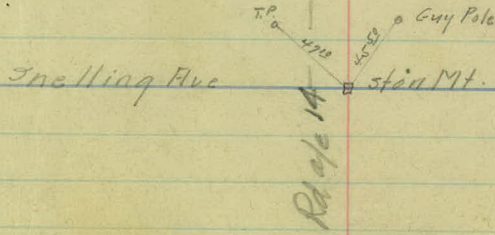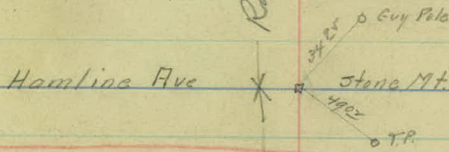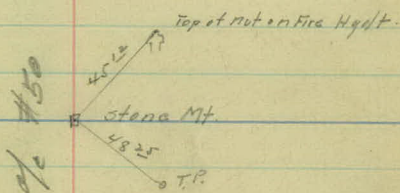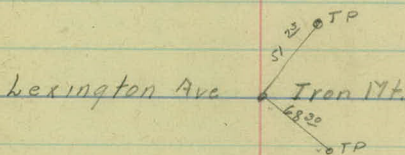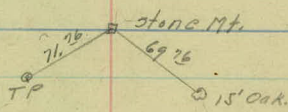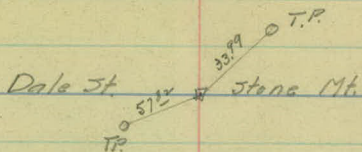

Rd/c #50

Rd/c 14

Sta Point Lt. Rt.

140+60⁶⁵

138+23⁴⁰ P.I. ✓

136+45³⁰ P.I. 29°-10'

134+58²² P.C. ✓

125+46²⁰ P.T. ✓


123+65²⁷ P.I. 14°-30'

121+83²⁰ P.C. ✓

Help in Par Wheelock PKing.
End.

135123 ⁴⁰ 14°-35'		A 29°-10'
138400 13°-38'		D 8° Rt.
137400 9°-38'	Spike	T 186 ⁴⁸ ✓
136400 5°-38'		L. 364 ⁵⁸ ✓
135400 1°-38'		R. 716.78 ✓
134458 ⁸² = 0°-00'		

125446 ⁵⁶ 7°-30'	6" Willows	A 14°-30'
125400 6°-19'		D. 4° Rt.
124400 4°-19'		T 182.27 ✓
123400 = 2°-19'		L. 362 ⁵⁰ ✓
122400 = 0°-19'	58" Willows	R. 1432.69 ✓
121483.7° = 00		

 

TOPOGRAPHY

2/50

LARPENTEUR AVE.

FROM

HAMLIN AVE

TO

WHEELOCK PARK

v8

v7

+62.2

v6

1-6-27

+61 T.P. 23

+63 G.P. 18

+62 T.P. 18

+02 Beg. of curve
3' x 6" Curb

+02 Beg. Curb
3' x 6" Curb

+87 F. Cor 32

+78 P.P. 17

Arg. Lt. #18

+55 Side drain 20
15" x 52" C.M. + Vt.

+74 G.P. 33

+55 Side dr 20

+55 E Mainline Ave

15" x 48" C.M.

+32 Co. Rd. Sq.

+39 Hydr. 39


+32 T.P. 23

+30 F. Cor. 47

+30 G.P. 30

+30 18" T 30

+22 T.P. 28

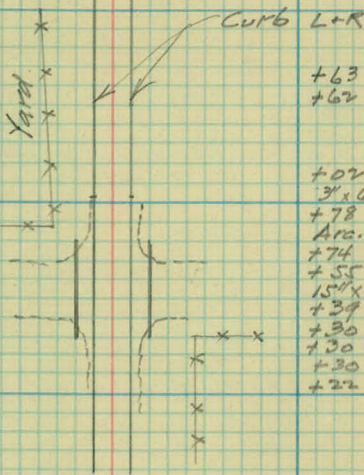

34

33

32

31

30


29

28

1-6-27

+85 T.P. 23

+100 Surface Drain
F. 48 6' x 6' Corp.

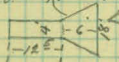

+52 T.P. 23

+21 T.P. 23

F. 53

+84 Cross R/R Sign 12'

+92 T.P. 24

+57 C.F. 44

Pasture

Cultivated

+37 T.P. 20

+61 T.P. 18

+10 Ent Gravel 197

+31 T.P. 17

Gravel pit

Corp.

+91 T.P. 18

40

39

38

37

36

35

34

40

+65 F. Cor. 37

+50 T.P. 23

F. 38

+92 End of Curve

+03 T.P. 25
+03 T.P. 21

+28 F. Cor. 39

+71 T.P. 22

+48 Surface Drain
10" X 10 C.M.

+27 Guy 13/16 25

+04 F. Cor. 42

+41 T.P. 22

+12 T.P. 22

Pasture

6" X 4' X 5' Head Wall

+10 Side Drain 20
24" X 82" C.M.

+91 Hyd. 39

Uncultivated

+24 T.P. 19

+92 End of Curve

+23 Mail Box 15

+ Curve L. & R. +72 T.P. 18

Same type as at Sta. 54 + 59 R.

+48 Surface Drain
10" X 20 C.M.

+27 T.P. 19

Swamp

+88 T.P. 19

26" X 6" Corp
10" X 2' X 4' Head Wall

+39 Surface Drain
15" X 40 C.M.



46.

45

44

43

42

41

40

+68 T.P. 23

+74 T.P. 19

+75 Farm Rd.
+75 Side Drain 27
15" X 30 W.T.

+75 Mail Box 14

+36 T.P. 23

+42 T.P. 19

+07 T.P. 23

+09 T.P. 19

Cultivated

Uncultivated

+99 T.P. 24

+84 T.P. 19

+68 Farm Ent.
+68 Side Drain 26
15" X 22 C.M.
+47 T.P. 23

+69 Mail Box 15

+53 T.P. 20

+29 Co. Rd. Sign 27

+10 H. Fernwood St.
+20 Side Drain 20
24" X 82 C.M.

52

51

50

49

48

47

46

+73 Foot Path.
+73 - 6' Conc. Side
Wall R. 22.5
+73 Side Prgin 18
12" X 8' C.M.
+36 T.P. 23

Yard

+96 Ent.
+73 Mail Box 14

+86 Egrm Ent.
+86 Side Prgin 20
12" X 32' C.M.

+90 T.P. 18

+86 T.P. 25
+36 T.P. 21

+27 T.P. 23

Cultivated.

+68 T.P. 18

+09 Cross Rd. Sign 10

+27 T.P. 23

Uncultivated.

+33 T.P. 19

+2

+99 T.P. 23

+08 T.P. 20

58

57

56

55

54

53

52

+80 T.P. 22'

+44 T.P. 22'

+10 T.P. 22'

+72 T.P. 28'

+73 J+G. Sp. 19'

+45 T.P. 22'

+59 Rds. 20'

35# Drive Rt.

+66 T.P. 25'

+46 M.B. 16'

+35# Drive

+00 Tree 26'

+35 T.P. 20'

+55 Cult. Field

+22 M.B. 16'

+14# Drive

+07 End Hdr. 23'

+03 T.P. 19'

44# Drive

+80 Bay Hdr. 24'

+19 Tree 25'

+95 Tree 25'

+84 T.P. 20'

+63 Tree 26'

+30 to Tree 27'

+26 Hyd. 26'

+06 G. Tree 22'

+04 T.P. 20'

+98 Rds. 29'

+08 T.P. 19'

64

63

62

61

60

59

58

Fence 33'

+946 Drive

+37 BF 32

+95 T.P. 23'

+64 Beg Fence 32'

+29 E Drive


+72 T.P. 23'

+51 Beg Yard

+68' M.B. 15'

+39 T.P. 23'

+09 T.P. 23'

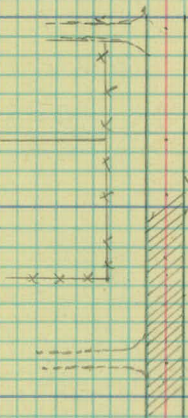

+96 T.P. 18'

+92 Tree 27'

+92 Hyd. 23'

+76 Tree 35'

+38 Tree 35'

+25 Tree 15' 34'

+07 E Drive

4' Wall

+75 Side W 30'

+72 M.B. 17'

+61 T.P. 18'

+44 End Rasp P. 30'
yard 30'

+80 Rasp B. Patch 30'

+39' T.P. 19'

+11 T.P. 19'

+10 G.P. 20'

+88 T.P. 19'

Cultivated

Cultivated

70

69

68

67

66

65

64

+40 T.P. 23'

+28 T.P. 20'

+10 T.P. 23'

+10 T.P. 19'

Cultivated

Cultivated

+91 T.P. 19'

+52 Rd. Sq. 13

+82 T.P. 23'

+00 Bag Cul. Field
+00 E. Drive

+00 E. Drive

+82 F.R. 16'-22'

+00 Bag Cul. Field

+87 E.F. 31'

+78 M.B. 15'

+76 M.B. 15'

+52 F.R. 20'-26'

F 31'

+27 M.B. 23'

+23 Gate

+20 T.P. 23'

F-33

+77 S.H. 28'

+18 T.P. 18'

+85 Tree 27'

+75 Tree 31'

+64 M.B. 24'

+61 S.W. 23' 4'

+27 Tree 27'

+14 Tree 25'

+07 E. Drive

4'

76

75

74

73

72

71

70

Hedge 34

+86 T, P 22'

+47 GP 17'

+37 Rd 5g 19'

+75 Rd 5g 13'

+57 TP 23'

+32 25" Tree 30'

Hedge 34'

+26 TP 23

Hedge 34

91' TP 23

+42 Bg Hedge 34'


+06 Victoria St

+76 Co Rd 5g 22'

+70 TP 23

Rose Lawn Cemetery.

+06 E Victoria St

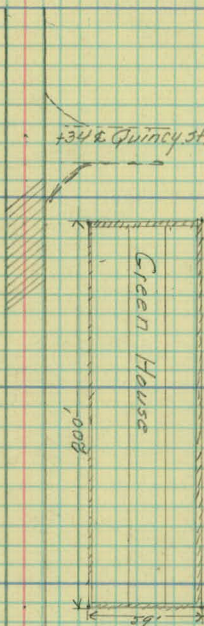

+84 TP 19'

+68 Rd 5g 28'

+34 E Quincy St.

+12 Hyd 39'

+12 PP 32

X +12

+89 End E Hous 36'

+54 TP 24'

+22 TP 19'

59' wide

+89 Bg Green Hous 36'

+76 TP 23'

+11 5g Rd 14'

+66 TP 19'

82

81

80

79

78

77

76

+09 Beg. Hedge 33'
 +09 End of S.W. 33'
 08 T.P. 22

+67 Break W. 33'

+40 Break W. - 60-69'
 +27 Beg. W. 69' to Drive
 +12 to Drive Rose Lawn Cemetery

+98 End Wall 69'

+85 Break Wall 60-69'

+58 Break Wall 33'

+12 Stage Wall 33'

+12 End Hedge 33'

+62 T.P. 23'

+48 T.P. 23'

+16 T.P. 23'

Hedge 33'

Rose Lawn Cemetery

27' Rad.

27' Rad.

27' Rad.

+91 T.P. 19'

+67 T.P. 20'

+48 Hyd 24'

+50 H.P. 19 23

+54 13" T. 28'
 +47 7" T. 28'
 +39 T.P. 19'
 +17 13" T. 27'
 +10 12" T. 27'

+10 T.P. 19'

+00 12" Tree 27'

+62 18" T. 31'
 +51 7" T. 28'
 +28 7" T. 26'
 +00 36" Tree 32'

Cut

88

87

86

85

84

83

82

+13 TP 23

H. 36'

+96 T.P. 22'

H. 37'

+67 TP 22'

736 TP 22'

+09 Bog Hedge 33
+09 End St. W. N 33

Rose haww Cemetery

Cultivated

Farm Yard

Cultivated Field.

402 T12 19'

+ 75 Bq Cal
+ 66 P Drive

+88' 20' 27'

472 T.R. 19'

+ 52 30" T 27'

+ 25 End Cul Beg
Farm Yard

 $+67 \text{ E } 17 \text{ } 18'$

TS4 TP 19

+24 TP 20°

94

93

92

91

90

89

88

F-27'

+75' E Drive

F-25'

+73 TP 24'
+30 F Cor 33'
+30 End Comp 170'
+12 End Hedge 316'
+12 TP 25'

+37 TP 23'

+03 TP 23'
H 36'

+68 TP 27'

Form Yard.

Rosehawn Cemetery.



Den E Lane
Plotted Land.

+10 TP 19'

+40 Plotted Land

+75 G.P. 21'

+20 End Cor Field
+11 TP 32'

+48 TP 19'

+76 TP 19'

+58 TP 19'

+27' TP 19'

Cultivated Field.

100

99

98

97

96

95

94

F-27'

+27 TP 23

+97 Ent

+89 XF 27'

F 27'

+91 TP 24

F 27'

+87 F Ent

+65 TP 23

F 27'

+60 Bag Cul.
+60 AF 28

+41 TP 23

F 27'

+10 TP 23

F 27'

Cultivated Field.

Farm Yard.

W 20
W 20
W 20

+79 TP 20'

+60 Bag Timber
+60 Ent Plotted
Land.

+60 24° T 26'

+33 TP 18'

Dem E Lane Plotted Land.

+90 TP 19'

+61 TP 19

+40 AP. 17'-23'

106

105

104

103

102

101

100

+78 Force 60
00 T.P. 38
00 & Dale St. Lt.

+91 T.P. 22
+89 E.F. 27

F-27

+53 T.P. 23

F-27

+19 T.P. 20

F-27

+70 Beg. F. 27

+60 g Drive

+60 End F. 27

F 39

+79 T.P. 27

Dale St.

Cultivated

20' Cor. Rd.
Dale Street

+78 F.C. 28
+66 T.P. 17-27
+17 P.P. 32
+16 H.C. 26
+54 90 End Pav.
+12 Rd. 39 26
+10 Rd. 39 22
+07 T.P. 17
+05 End Timber 60
+96 P.P. 29

Timber 60

+71 T.P. 19

+50 Timber 50

Timber 40

+42 T.P. 19

+39 Rd. 39 14

+64 T.P. 19

+70 Timber 36

Timber

112

114

110

109

108

X Drain 107+15 18" X 40 P.3.

107.

106

+12 Cul. 15" x 24" 20
H/R Farm Ent

+51 T.P. 30'

End.
+39 F.C. 30
+34 T.P. 29

+78 R/Sg 15'

+15 T.P. 27
E 32

F 33

+82 T.P. 24

+07 C.R. 25'

+06 F 33

Cultivated Field

Temple Aaron Cemetery

Cultivated

Farm Yard

Cultivated

+81 Farm Ent

+81 Cul 15" x 24" 20

+07 Cul. 15" x 24"
+07 Farm Ent

End.
+91 House 44'

+63 P.P. 29'

+22 House 36 24.5

+99 T.P. 19'

+83 T.P. 20
+80 F.C. 1 Bdg. F. yard.
+40 T.P. 30'

+14 P.P. 29

118

117

116

115

114

113

112

+22 TP 49'

+95 TP 42'

+50 TP 37'

Cultivated.

+05 TP 35'

Cultivated.

+11 TP 33'

+30 Colv.

124

123

122

121

120

119

118

CR 14'

CR 16'

CR 14'

CR 15'

Swamp

Celery Farm

CR 14 1/2
+80 CR 20
+96 BOP GP 26
+76 TP 46
+83 CR 14
+70 Farm Ent
+70 Cul 15' x 24'

CR 14

+85 CR 15
+81 CR 20
+80 BOP GP 26

+70 Farm Ent
+70 Cul 15' x 32'

+70 Farm Ent

+70 Farm Ent

+95 TP 47'

+40 End Culv

Farm Yard

+59 TP 50'

Cultivated

+56 Farm Ent
+56 Cul 15' x 24'

130

129

128

127

126

125

124

141

+96 Ender 14

141

145

+84 Beg R 14.5

+58 Beg R 141

+49 E Farm Ent.

+49 E Farm Ent.

+70 E Farm Ent.

+70 Farm Ent.

+70 Cul Box 32

+36 Ender 141

143

+54 Ender 145

145

141

145

Celery Farm.

141

151

135

125

Swamp

Celery Farm

141

155

136

135

134

133

132

131

130

GR 141

GR 141

GR 141

GR 141

GR 141

GR 141

GR 141

Uncultivated Field

Uncultivated Field

141

140

139

138

137

136

+50 Curb 15⁵

+00 Curb 15⁴

+80 Pav 11² & 15³

+50 Curb 15⁵

+50 Edge Pav 8⁵

+00 Curb 15⁴

+00 Edge Pav 2⁵

+78 Edge of Pav 0

+52 End of R 15³

+61 Beg. of Curb &


6'0" f.c.

15' Face of gutter

14'

141

141

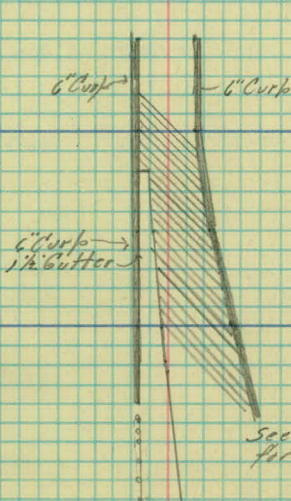


+50 Curb 14^{7.5}


+00 Curb 16¹⁵

+50 Face of Curb 22⁵

+00 Face of Curb 35

See next page
for detail.

 

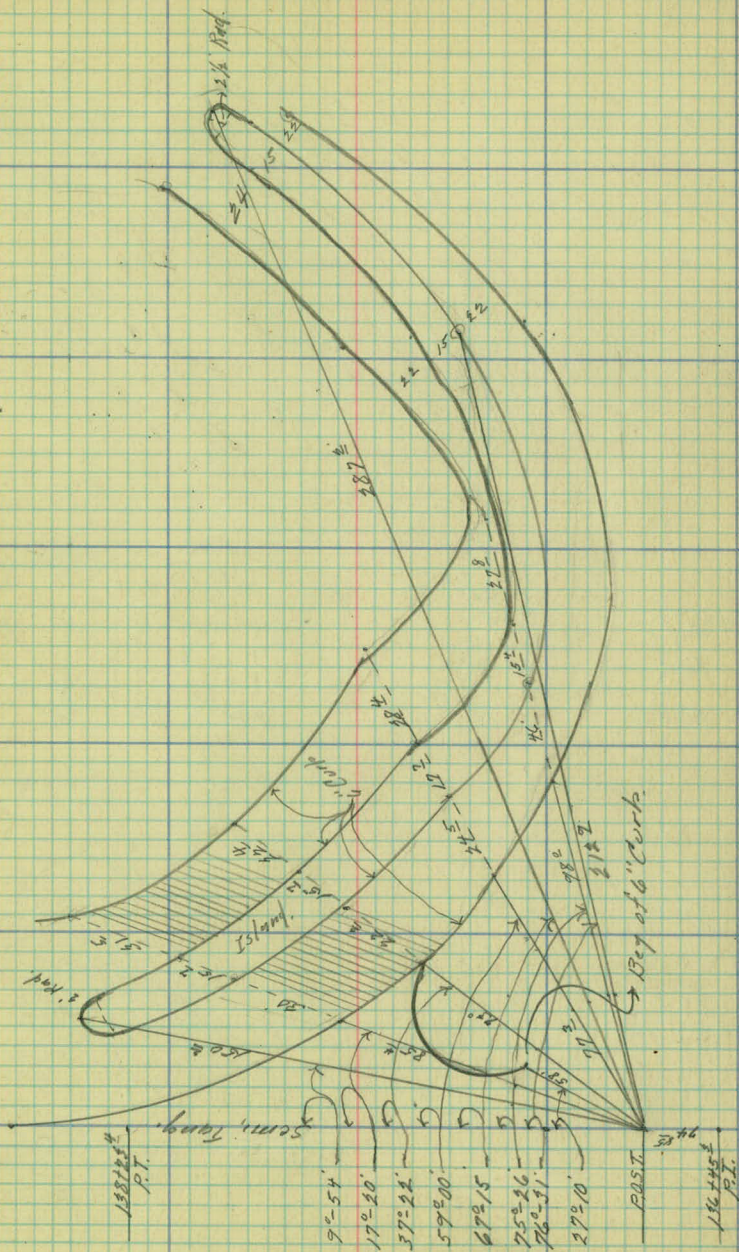

179-60
29-10

150-50

123+65.97

105+44.90

18+51.07

18+20.63 to pay

3/19/28

C.W.S.

A.B.

W.A.

T.W.

Alignment.

From Edgerton St

To

Payne Ave.

COUNTY ROAD "A" - Road Acct. #50



Road Map


3-27-28

C. W. S.

6+5225

0+00

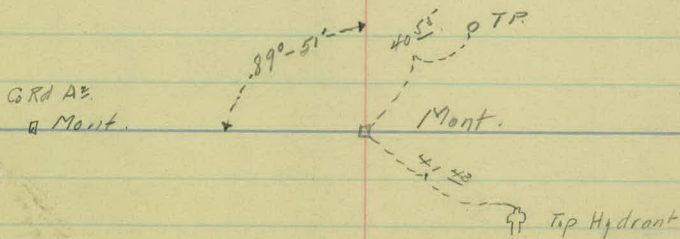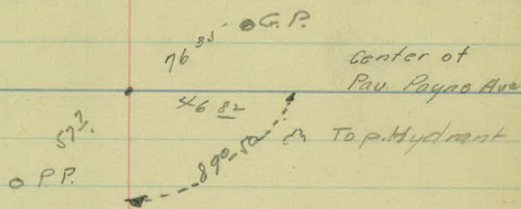

 

3/19/28

C.V.S.

A.B.

W.A.

T.W.

Topography
From Edgerton St.

To

Payne Ave.

Pctd

L R
135 135

5+00

4+00

+08 & Drive Rt.

3+00

Φ 69 SW 8' 30' Rt

2+00

+23 & Drive Lt 12" X 12 C.M.

135 135

1+00

+20' X Drive 18" X 107' C.M. Lt 79' Rt 28'



0+00



Pasture

Plotted Property

+25 1E 27'

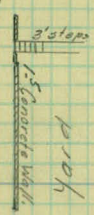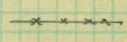


+19 E Wall 20'
+61 TP 24'

W 30'

+88 Beg Wall 30'
+43 T.P. 24'

+12 Beg Culv. 19'

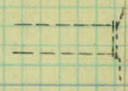

+22 E Wall 30'
W 30'

+46 Culv 19.5
+64 Pav 18.5-14.5
+35 Pav 21
+22 Pav 31.4
+11 Pav 6.4
+10 Pav 6.4

Yard
64' Rd.

+88 W 30
+88 W 30
+34 39 19.5
+35 Wall 30
+35 Pav 13.5
+25 TP 27
+10 Pav 30'

Edgerton St.


6+00

+
 +85 End Curb 14'
 +85 End Curb 25
 +74 M.H. 30.5
 +70 E Curb Rad 37


+50 Pav 29'

+35 E.C. 37

+34.5 Pav 29'
 +21 Cul 31'
 +19 Pav 13

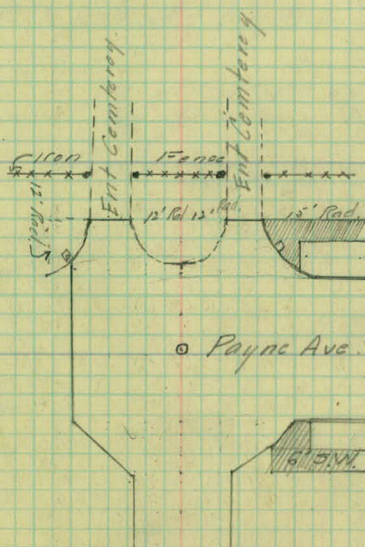

+97 Fence 40
 +71 E.S.W. 32'
 +85 E.S.W. 215
 +85 E Curb 11'
 +85 E Curb 215
 +70.8 E Curb Rad 36.5
 +79 G.W. 32'
 +73.2 Curb 40
 +75.2 M.H. 28.5
 +77 M.B. 33'
 +79 I.R. 36' 292
 +34.3 Pav 29.5
 +34.5 Pav 29.5
 +26 Pav 39
 +26 J.W. 34'
 +27 Pav 28'
 +29 J.W. 24'
 +20 Pav 13.5

 

CIVIL 3/14/28
A.M.C.
A.B.
W.A.

Larp Ave

0+00-16+32

COUNTY ROAD A - Road Acct. #50
From Phalen Blvd. to Lake St.

Road Map.

3-27-28

W.A.

249

Point

Alt

Alt.


16+32'

Point




0+00



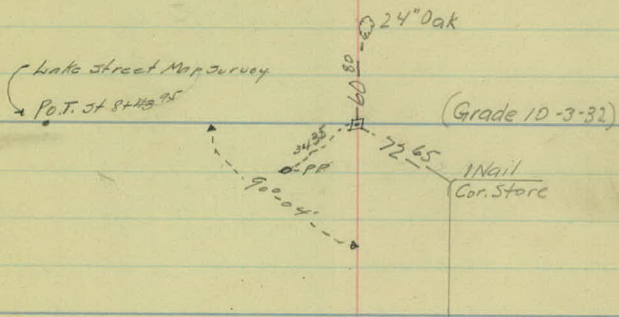

See Paklan Blvd
Rd. Map Survey

∴ 5 Nails in pav.

 

3/14/28
C. V. S.
A. M. C.
A. B.
W. A.

No 50

Larp. Ave
From Pahlen Blvd.

Sta. to To 10+32

Lake Street

5+00

4+00

+ 20 to Drive Rt

3+00

2+00

789 to Drive Lt 2+75

1+00

0+00

3/14/21

+ 86 TP 25'

+ 59 Tr Fence 33'

+ 26 Tr 33

+ 06 Tr 23

SL 14'

+ 99 Tr 31'

+ 58 Tr 34

+ 54 TP 24

+ 17 Tr 32'

+ 20 MB 18'

SL 15 + 00 Tr 24'

+ 86 Tr 33'

+ 76 Tr 33'

+ 52 Tr 30

+ 24 TP 24

+ 00 FF 31' SL 15

+ 20 Bay FCh 31' A + 20

SL 12

97 TP 23

SL 15

+ 58 Edge Pav 34

+ 20 Pav 46'

- 15 Pav 10.8'

+ 68 Tr 22'

+ 05 PP 23'

SL 6'

SL 6'

+ 72 PP 23

+ 30 Tr 27'

+ 12 Tr 25

+ 09 F Rer Tr 22'

SL 3

+ 96 Tr 25

+ 84 Tr Rer 24

+ 73 Tr 24

+ 73 MB 13

+ 70 E 4' Wall 13

+ 02 Tr 24

+ 45 Tr 21

+ 30 F Rer 26

SL 14

+ 95 PP 22

+ 25 Tr 22'

+ 64 Bay Rer 20

+ 51 Tr 21

+ 38 Hyd 32'

+ 29 Tr 21'

+ 07 Tr 21'

SL 0'

+ 58 PP 22'

+ 58 F Pav 19'

+ 49 Edge Pav

+ 40 Pav 56

+ 32 Pav 59

Cultivated.

Yard

Yard

- 15'

+41 ϕ Drive Rt

11+00

+36 ϕ Drive Lt

10+00

9+00

+98 ϕ Drive Lt

8+00

7+00

6+00

3/14/68

+ 90 B = 7 F 23'
+ 68 MB 18
+ 46 GP 24

+ 100 TP 24'
SL 11

+ 65 MB 17
+ 30 EP Cor 33

+ 20 MB 17
12

+ 73 TP 25'
+ 72 X.F. 23'
+ 23 Tr 24

F 31 SL 10

+ 63 MB 18'
+ 28 TP 25'

F 31' SL 10'

+ 53 Tr 21'

+ 12 Tr 31'

F 31' SL 11'

+ 98 TP 25'

SL 12'

+ 46 PP 23

+ 30 End Br. 4 Tr 33

+ 25 MB 9

SL 7'

+ 60 PP 23

SL 7

+ 63 Bay Brook
+ Tr 23
+ 25 PP 23

SL 7

+ 89 Tr 26

+ 13 F 29'

SL 7

+ 87 PP 23

+ 87 Tr 28

+ 94 Tr 29

+ 06 Tr 19'


SL 6'

+ 78 Tr 16

+ 81 Tr 20

+ 46 PP 23

SL 7'

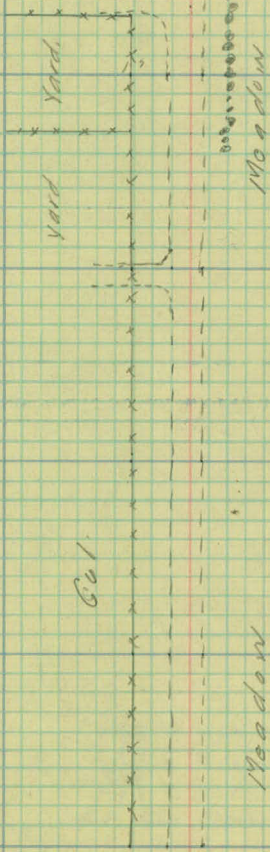

16+00

15+00


+58 ft Drive Lt.


14+00

13+00

12+00

3/14/28

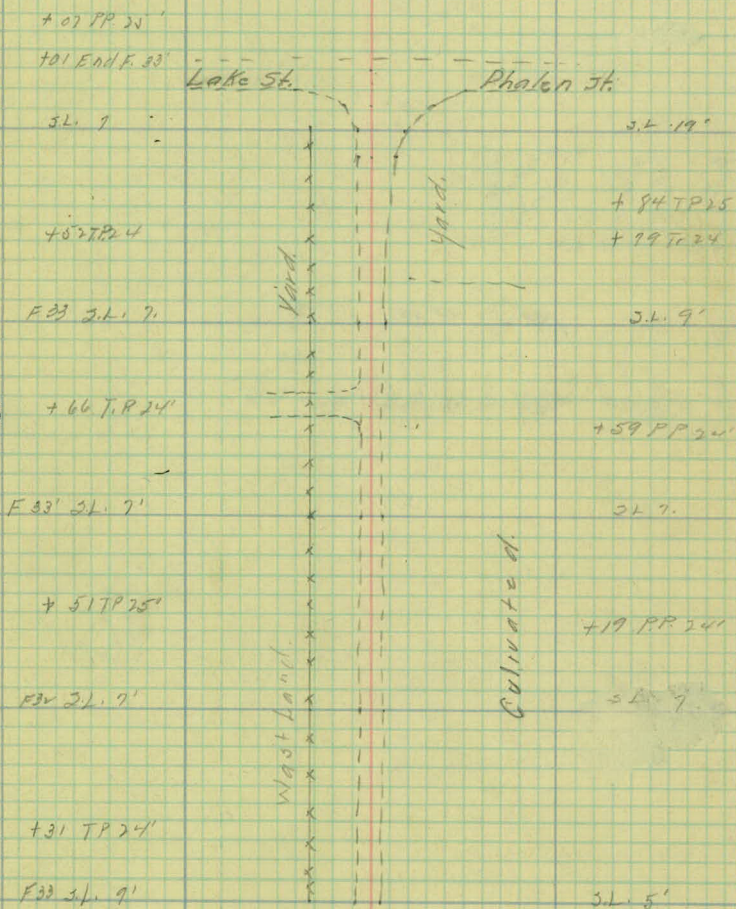

 

1-17-27

County Road "A"

From Prosperity Ave
to ~~E Co. Line~~. EAST AVE
Road a/c 50
Road Map

Alignment.

party

{ Wilshusen
Skoglund
Berthiaume
Messenburg

Leaving 1-22-27
[Signature]
Office of Ramsey Co. Engineer
ST. PAUL, MINN.

Date Filed

1-24-27

File No.

16



Station Point ang. ht. 909.74 ^{col.} Bear.

10+72.3 Mont. 0°26'

4+17.2 P.O.T

0+00 P.O.T

N 86° 16' E

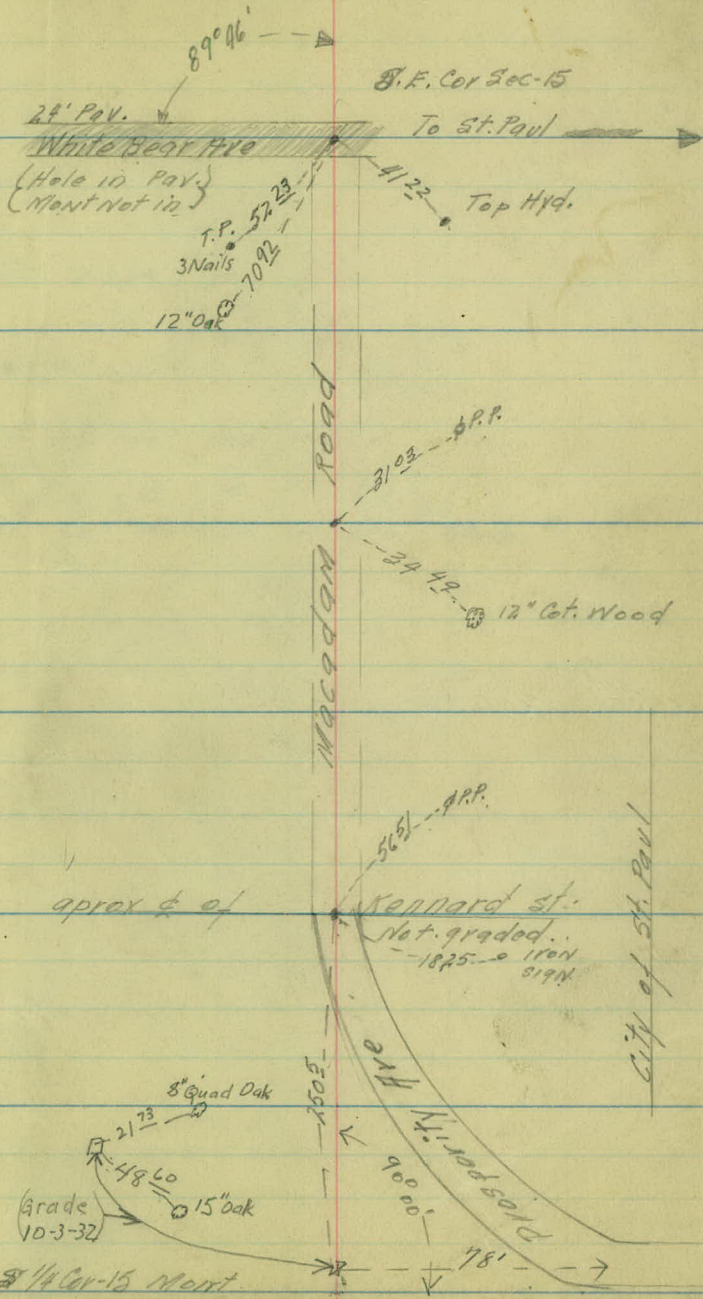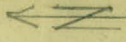

Station	Point	ang. ht.	ang. Pt.	Col. Bearing
---------	-------	----------	----------	--------------

49+98 <u>55</u>	Mont.			
-----------------	-------	--	--	--

48+872	P.O.T			
--------	-------	--	--	--

37+082	Mont.			
--------	-------	--	--	--

0°01'

23+925	Mont.	0°02'		
--------	-------	-------	--	--

7.860980

7.860980

1-17-27

Iron Rd. Sq. = Cold =

10" Oak

23.58

56.17

(Grade 10-3-32)

15" Maple

54° 04'

± of Twincity Rapid Tr. Co.

Gravel Road

Cor. Porch

85.0

S 1/4 Cor 14

T.P.

(Grade 10-3-32)

54.2

26.15

Iron Rd. Sq.

City of St. Paul

T.P.

29.32

S 1/4 Cor 14

F.P.

33.25

(Grade 10-3-32)

P.P.

39.62

25.2

T.P.

Station Point ang. ht. 99.9 ft. ^{Cal.} Bear.

89+27⁶ Mont. 0° 01'

70+00 P.O.T

Road Ang. #14



N 89° 04' E


62+91⁵ Mont. 0° 58' EAST AVE

N 86° 43' E

51+76² P.O.T

1-17-27

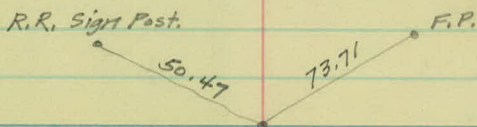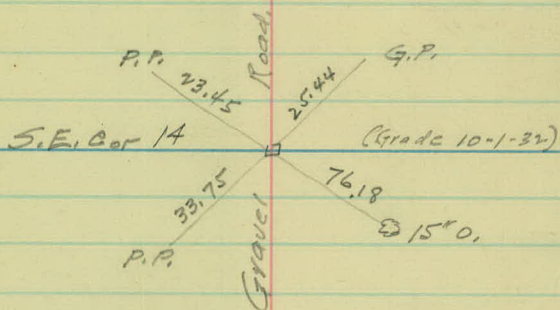

 

CO. ROAD "H."

From Prosperity Ave
to E. Co. line EAST AVE

Topography
Road g/c 50

1-18-19-27

Party
Wishusen
Skoglund
Berthiaume
Messenburg

5+00

4+00

+29 E drive St.

3+00

+27 E drive St.

2+00

1+00

0+00

approx $\frac{1}{2}$ of Kennard St

Note =

(Macadam Road)
from 0+00 to
White Bear Ave

from White Bear Ave
to F. Co. line
gravel road

+71 T.P. 27'

F.L. 29'

+43 T.P. 27'

F.L. 29

+15 T.P. 26'

FL 27 B. Brush 21'

FL 28

+83 T.P. 28

+70 T.P. 30'

+40 T.P. 28

+P.L. 28 Rd 9'

Rd. 9'

Rd. 9'

Macadam Road

N. 9

Prosperity Sign

1-18.27

+25 P.P. 20'

H.L. W/brush 20'
D. 3
P. 8
H. 11

+41 P.P. 21

+88 T.P. 27'

+44 N.B. x 15'

+09 P.P. 22'

+83-M.B. x 46 P.P. 22'

+52-P.P. 24'

Even Sign 19'

Woods x 1/2 rd

Yard

Cultiv

Cultivated

Cultivated

12+00

11+00

10+00

9+00

8+00

+05 $\frac{1}{2}$ drive Rt.

7+00

6+00

1-18-27

+56 P.P. 26'

Rd. 12'

Waste land

Rd. 10'
+68 T.P. 22'

+52 T.P. 26'
+43 Cor. F. 18 35'

+64 Cor. F. 18 to 34-5
P.P. 27

1109
Station
35'

+95 Rd sign 27'

+73 3/4 White Blv
24' P.P.

+43 N. 10/8 20'
+28 T.P. 27

15' Coll.
+65 F. F. 21' Brush



To at Paul
+51 P.P. 21

+37 N. 10/8 14'
+70 P.P. 27

End of Macdonald
Road

+52 T.P. 26'

F.L. 27'

Cultivated

+28 T.P. 27'

F.L. 26'

Waste land

F. Yard - Woods

F.L. 27'

+58 P.P. 27

Cultivated

Yard. Shrub trees

+17 N. 10/8 P.P. 27

19+00

18+00

17+00

16+00

15+00

14+00

13+00

1-18-27

+78 T.P. 22' +87. F.L. 20

474 Fred 21

Type 22

466 P.P. 25'

46/1 r p p 22

L. Cult.

1957.P.22.

Cell 10/10/10

439 P.P. 25

430T.P.22'

ward x Cultivator

1/2 yard

762 T.P. 22

442 + F.L. - 22

408 N.P. 25-1

+06 T.P. 20

Cultivated

+90 M. bx. 12'

+65-E Ppp 10

16 x 12" C. M.

+ 33 T. P. 23

+71 T.P. 22

494 P.P. 25'

Ref. 10

+86 +86 319 1111

4415, 8, 23'

17 p.p. 20'

Tree 23

207 1.5. 13

Cultivar

Edwards

+ 96 T.P. 22'

Feb 12

*60 PL 34

 $+587.5 = 2$

Waste/and

+34 F. CoK -35

A 28 T.P. 22

F. L. 34'

26+00

25+00

24+00

+93 ft drive ht.

23+00

22+00

21+00

+68 ft drive ht.

20+00

1-18-27

+99 T.P. 23'

+11 T.P. 21'
+05 P.P. 25'

+14 T.P. 23'

+87 T.P. 22'
+84 P.P. 25'

+20 M. by 12'

+18 T.P. 21'

x - x - x

x - x - x

Hazel 9' 2'
+70 T.P. 20' 26'

+62 P.P. 25'

+72 T.P. 21'

+53 T.P. 23'

+22 P.P. 25'

Rd. 11'

Rd. 13'

+24 T.P. 20'
+15 T.P. 19'
+99 P.P. 25'
+99 M. by 10'
+69 T.P. 21'
+60 P.P. 25'
+49 T.P. 20'

Cultivated

Hard

+24 T.P. 20'

Cultivated

20x12' C.M.

33+00

+37 $\frac{1}{2}$ drive lt

32+00

31+00

+104 $\frac{1}{2}$ drive lt.

30+00

29+00

+72 $\frac{1}{2}$ drive Rt.

28+00

27+00

1-18-27

+76 P.P. 25'

Cultivated

+28 F.V. 19' 26'

FL 26'

+32 P.P. 25'

FL 26'

+29 T.P. 26'

FL 27 Rq 12'

+43 F. Cor 28'

+39 P.P. 26' 1/2

+49 T.P. 20'

+60 P.P. 20'

+40 E. Colt.

+44 T.P. 21'

+41 P.P. 26'

12 X 8' - 12' CA
+66 E. Colt. 20'
+60 M. 2 X 16'

FL 28'

+70 T.P. 23'

FL 28'

+64 T.P. 23'

Rq 10' FL 27

+76 E. Colt. 22 1/2'
15' E. N. 25 1/2'
+45 F.L. 28'

+31 T.P. 22'

+75 F. Cor 29'

+86 M. 2 X 15'

+47 P.P. 29'

+89 T.P. 23'

+64 F. Cor 20 1/2'

+70 T.P. 23'

+55 B. Patch 30'

Cultivated

Cultivated

Pasture

Yard - Trees

Berry Patch

Yard

40+00

39+00

38+00

#96 & drive Lt

37+00

36+00

35+00

34+00

1-18-21

+14 PP 26'
Rq. 11 F 23

+59 T.P. 23'

+15 23' x 15" C.V.
C.V. 16' x 15'
Rq. 12

+41 M. 6 x 20'
+33 T.P. 23'

+93 PP 1.6'

+74 F Cor 27'

-X-X-X-

+64 F.F. 27'

X-X-X-

+69 T.P. 23'

+89 B. C.V. 15' x 16' x 12" C.V.
+76 PP 26'

F.L. 26'

+32 PP 49'

+87 A. 6 x 20' drive

X-X-X-V
+77 B. C.V. 17' x 16' x 12" C.V.
20' x 15" C.V. +90 T.P. 23'

+21 PP 25'

+23 M. 6 x 20'

F 31

+78 C.V. 19' x 16' x 15" C.V.

+96 A. drive
12' gate

+57 F. Cor 26'
+52 T.P. 23'

F 26'

+59 P.P. 26'

F 31

F 26'

orchard

yard

yard

cultivated

47+00

+63 to drive st.

46+00

45+00

44+00

+24 to drive st.

43+00

42+00

41+00

1-18-27

+03 T.P. 23'

+75 P.P. 26'

Swamp

+75 G.P. 23'

Rd 12'

+16 E. Woods 8-36'

Rd 13

+35 P.P. 26'

+69 T.P. 23'

+08 R.P. 5, 9, 16
Woods - Brush 40'

Cultivated

+04 P.P. 20'

Woods

+42 T.P. 23'

+02 G.P. 23'

+14 E. F.h. 21
+08 N. 15 "

+12 T.P. 23'

+70 P.P. 26' h
+68 P.X. 17 9 21

x x x x

P.V. 21

Brush 30

+93 P.P. 27'

+76 T.P. 23'

Rd 21'

Cultivated

Woods

Woods - Brush

54+00

53+00

52+00

+09 & drive RT.

51+00

+05 & Winthrop Ave RT.


50+00

49+00

+36 & drive LT

48+00

+72 R.P. 24'

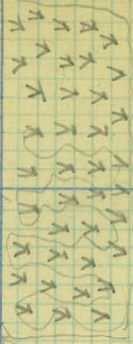

+71 R. Walk 15'
+75 M. B. 30'
+80 R. C. 14' - 80
20 x 12" C. 11.

Rd. 12

Woods Coll. Road

Rd. 13'

+68 R.P. 16'

+32 T.P. 31'

+22 E. Wood's

F.L. 31

Woods

+46 C.P. 231
+3 F.L. 34
+38 R.P. 16'
+25 R.P. 3. 90 131
+20 B.L. 34

+47 T.P. 23'
+42 E. C. 122



Woods

+785 X. 109 31
+49 E. C. 34
+46 T.P. 23'

+25 E. Wood's 35'

+77 R.P. 27'

+92 Rd. 110

+04 T. 24

Woods

Woods

+77 R.P. 28'
+92 F.L. 34
+31 T. 10. 30 31
+39 F.L. 34
+12 R.P. 5. 90 16'
+04 F.L. 41

+31 T.P. 23
+20 R. 37
+91 M. B. 25
+85 M. B. 24

Woods

+13 R.P. 31
+33 M. B. 12
+20 F. C. 34
+18 T.P. 23
+12 M. B. 10

+64 P.P. 59'
+50 M. B. 10
+44 F.L. 34

+59 R. 11. 31 20 31
+42 C. 11. 18'
+32 T.P. 23'
G.L. 55'

62+00

61+00

60+00

59+00

58+00

57+00

+ 12 ft drive MH

56+00

55+00

EAST AVE

1-18-27

+57 P.P. 20

+30 F. Cor 39

F.L. 36

+10 P.P. 20'

+69 F.L. 19

F.L. 23

+81 P.P. 19

F.L. 27

+55 P.P. 28

F.L. 23

+39 P.P. 22

F.L. 32

+15 P.P. 20 h.
F.L. 30

+80 B Woods

F.L. 30

Woods and Waste land

Woods Waste land

Rd 11

Rd 13

+59 R.S. 22

+55³ MDX 16

+40 T.P. 23

+82 T.P. 24

+14 T.P. 26

+63 + Rd 5 sign 15'

+89 T.P. 27

+28 A Tract 30

+53 T.P. 29

+24 T.P. 31

B Golf Course

Golf Course Tract

Hill Crest

Golf Course

Y V
Y V
Y V
Y V
Y V

68+00

67+00

66+00

65+00

64+00

63+00

199 1/2 East Ave 14 W.

62+00