

OFFICE OF COUNTY ENGINEER
RAMSEY CO. MINN.

Road Map Survey

COUNTY RD. G2

From Lexington Ave. To Hodgson Rd.

Road Acc't. No. 59

Date Filed 8-8-25

File _____

8-8-25

COUNTY ROAD G-2

ROAD No. 59

From Lexington Av. to Hodgson Road.

INDEX.

Alignment Sta. 0+52+61

P2- P3

Topography. " " "

P3- P12


Office of Ramsey Co. Engineer
ST. PAUL, MINN.

Date Filed 8-8-25

File No. "16"

Carlson
Spurlock
Persons
Graham

Aug 1925

 

ALIGNMENT.





Station Point Lt. A Rt. Bear.

52+61.⁰⁰ Mon.

26+32.65 P.I.
Mon. 0°-01'


18+83.25 P.O.T.

0+00 Mon.

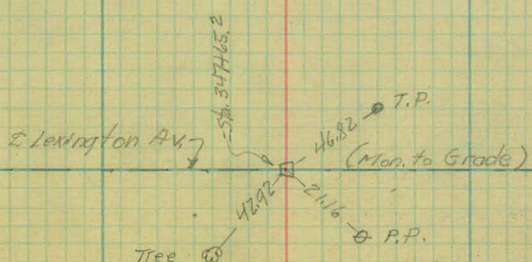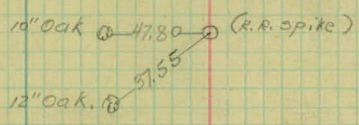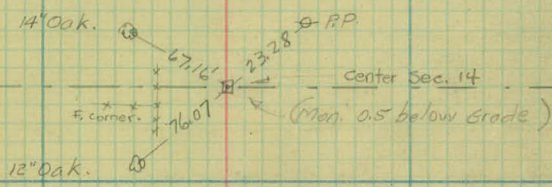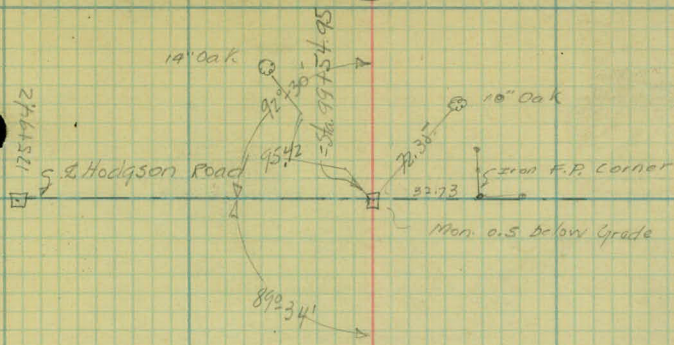

W.H.C.
C.W.S.
A.L.P.
M.B.
R.G.

Aug 6, 1914

 

TOPOGRAPHY.

Station.

5+00

4+00

3+00

2+00

1+00

+37-

15"X28"CM - ✓

0+00

Monument

PROJ. NO.	
PARCEL NO.	
OWNER	
.....	
SEC.	T. R.

Cultivated


Meadow

Meadow

Pasture

Timber
Stumps

LEXINGTON AV.

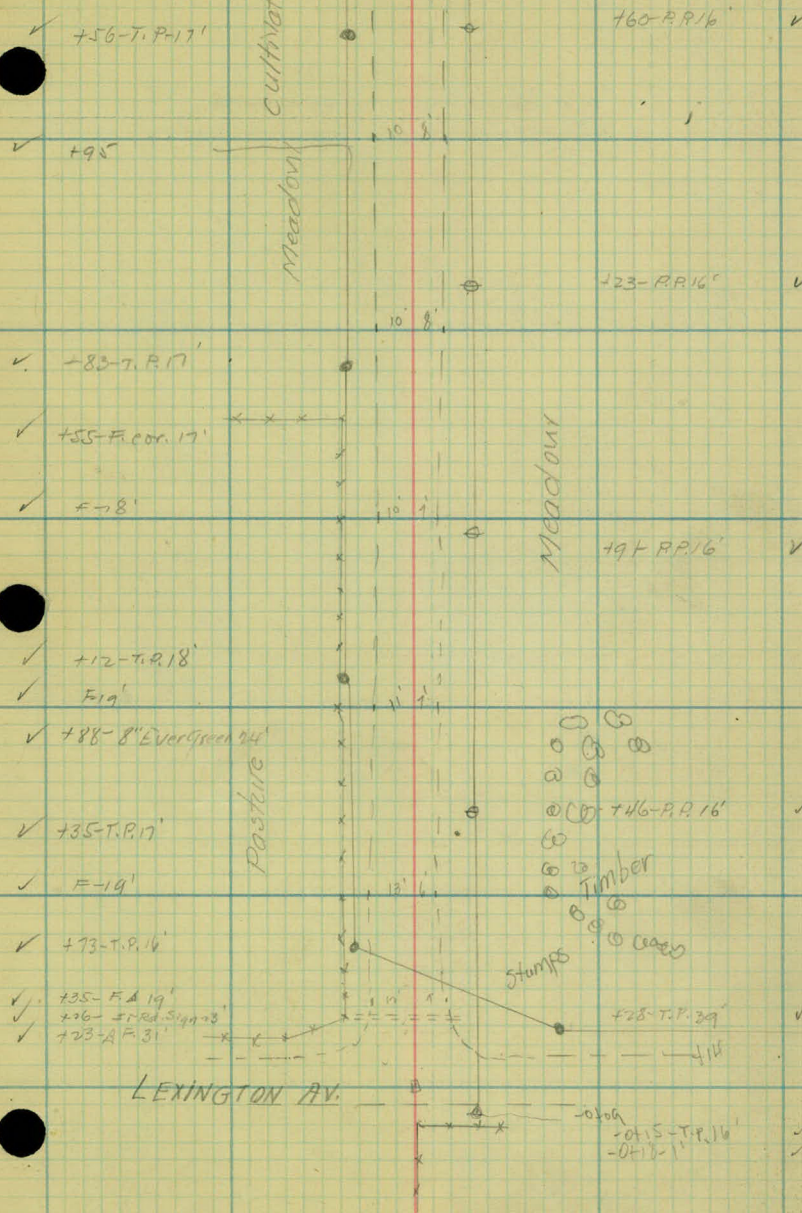

station

12+00

11+00

10+00

9+00

8+00

7+00

6+00

✓ +38-T.P. 18'



+87-P.P. 16

✓ +66-T.P. 18'

+27-T.P. 16

✓ +96-T.P. 18'

+73-P.P. 16

✓ +75-T.P. 18'

+370
+17-P.P. 16'

cultivated.

cultivated.

Meadow.

Station.

19

18

17

16

15

14

+16 & Road Lt.

13

✓

F-34'

✓ +76-T.P. 20'

✓ +55-14" oak 33'

✓ F-34'

✓ +54-T.P. 19'

✓ F-34'

✓ F-35'

✓ +83-T.P. 19'

✓ +05-T.P. 19'

✓ F-35'

✓ +50-F. Cor. 35'

Small Brush

Timber Brush

Small Brush

cultivated

✓ +22-R.P. 16'

✓ +76-R.P. 16'

+31

✓ +35-R.P. 16'

✓ +86-R.P. 16'

+72

✓ +49-R.P. 16'

+18-M. Bx. 14'

cultivated

Timber

Scattered Oaks

Station.

+32.65 - Stone Men.

26

25

24

23

22

21

20

Timber

+13-T. con 34'
+11-T.P. 18'

cultivated

+150-P.P. 16'

+139

✓ F-34'

✓ +41-T.P. 19'

Timber
Oak & Brush
small Brush

cultivated

+160-P.P. 16'

+140

✓ +71-T.P. 19'

Timber
Oak & Brush
small Brush

scattered Oaks

+109-P.P. 16'

+178

✓ F-35'

✓ +95-T.P. 19'

cultivated

+167-P.P. 16'

Station.

33

32

31

117- L Field Ent Lt. ✓

30

29

141 F. Ent Rt ✓

28

27

✓ F-24

9

✓ F-24

✓ +90-T.P. 17'

Scattered Oaks

✓ +33-F. Cor. 24'

✓ +20-T.P. 17'

Timber Scattered Oaks

✓ +52-T.P. 18'

✓ F-24'

✓ +97-F. Cor. 33'

✓ +82-T.P. 18'

+99-F. Cor. 41'

cultivated.

+62-P.P. 16'

+18-P.P. 16'

+70-P.P. 17'

orchard.

+10

+46-P.P. 16'

+28-6" Pop 30

+66-6" @ 30'

+14-11.8 x 10'

+96-P.P. 16'

+70

Farm Yard.

cult.

Station.

40

+43 2 Road Lt. ✓

39

+46 - Power Line Xing ✓

+48 - 2 Power Co. Road- ✓

38 +46 - Power Line Xing. ✓


+87 - Power Line Xing. ✓

37

36

35

34

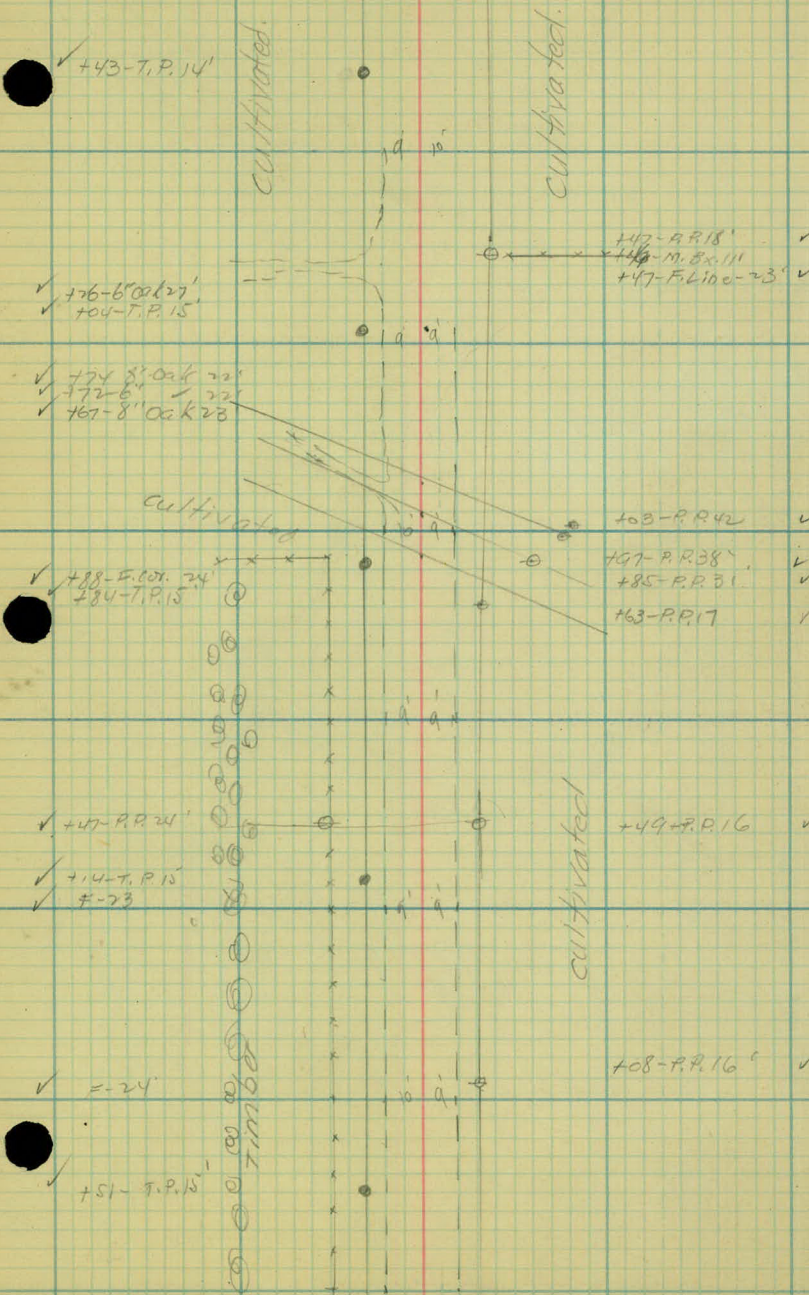

Station

47

46

45

44

43

42

41

✓ +63-T.P.15

✓ +26-T.P.14

✓ +87-T.P.15

✓ +46-T.P.15

✓ +89-T.P.14

10

9

9

9

10

9

open field.

+24-P.P.21

+05

+73-P.P.20

cultivated

cultivated.

+16-P.P.19

+62-P.P.19

+02-P.P.15

station.

54

53

5261

Stone Mon.

52

51

50

49

48

+98-T-34

+53-T-29

+08 G.P. 33

cultivated.

31.19'
G.L. 16'

L. Hudson Road.

+38-E.V. 14
+36-T.P. 37
+18-T.P. 14

+18-T.P. 13

+10-T.P. 13

+88-T.P. 14

cultivated.

Open Field.

Pasture

+34 T
+27 T 30'
+24 T 36'

F.L. 22'
G.L. 10'
G.L. 14'
+78 P.P. 22' R ✓
+41 F. Cor. 32' ✓
+47 T.P. 43' R ✓
+25 T.P. 24 R ✓

+64-Ir. Rd. Sq. 12 ✓
+61-F. Cor. ✓

+20 G.P. 15

+53-P.P. 21

+38-P.P. 21

+82 P.P. 21

61

60

59

58

57

56

55

6-2 T-21

+26 P.P. 20' ✓
F.L. 30' ✓

S.L. 16'
G.L. 13'

SL 13' G.L. 10'

✓ +75-T. 32'

+77 P.P. 20' ✓
+60 T. 25' ✓

S.L. 16'
G.L. 13'

+32 T. 24' ✓

F 30' ✓

✓ +59 T. 33'
+36-T. 36'

Cultivated

Pasture

+28 P.P. 20' ✓
+27 T. 35' ✓

F. 31' ✓

✓ +59 T. 26'

+77 T. 30' ✓
+71 T. 34' ✓

+43 T. 32' ✓
+21 T. 34' ✓

✓ +96 T. 24'
✓ +96 T. 25'
✓ +75 T. 35'
✓ +62 T. 35'

SL 14' G.L. 11' ✓
+93 F. Cor 32' ✓
+86 F. Ent. ✓
+79 F. Cor 32' ✓
+77 T. 35' ✓
+76 P.P. 21' ✓

S.L. 13'
G.L. 11'

+91 T. 34' ✓

+27 T. 22' R ✓
+18-T. 34 R ✓

68

67

66

65

64

63

62

+89 F. 29'
+87 P.P. 18'
INT. E. & W.
FENCE WITH N
S. fence

194-T. 21
196-T. 28

+41 P.P. 21

S.L. 12' G.L. 9'
F.L. 29'

Cultivated field

S.L. 17'
G.L. 14'

+73 T. 34'
+90 T. 37'

S.L. 15'
G.L. 13'

+22 T. 36'
+06 T. 37'

+43 T. 31'

F.L. 29'

S.L. 15'
G.L. 14'

Pasture

F.L. 29' ✓

+60 P.P. 19' ✓

S.L. 12' G.L. 9'
F.L. 29' ✓

+44 T. 19'
+30 P.P. 20' ✓

F.L. 29' ✓

+67 T. 29' ✓
+59 T. 28' ✓
+39 T. 27' ✓
+34 T. 25' ✓

S.L. 12' G.L. 9'

F. 29' R.
+79 P.P. 20' ✓

+41-T. 22' ✓

70

69

LOWER TURTLE LAKE RD.



