

OFFICE OF COUNTY ENGINEER
RAMSEY CO. MINN.

Road Map Survey

COUNTY ROAD H2

From West Co. Line To Cleveland Ave. (S.T.H. 8)

From Centerville Rd. To Bald Eagle Blvd. W.

Road Acc't. No. 61

Date Filed 4-5-25

File

1976.6

4-5-25

Road #61

West. Co. line To Cleveland

Alignment Notes

Sta. 0+00 to 101+46-

4/2/25 to 4/12/25

Austin
Skoglund
Benthiaume
Jankoski

} Party.

Station

Ang. ht. Ang. R4.

48+52.5 P.I.

1° 26'




29+00 P.O.T.

22+44.65 Mont.

14+00 P.O.T.

0+00 Mont.

H3

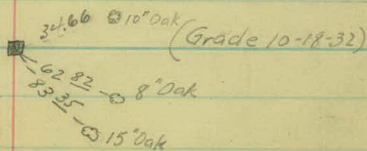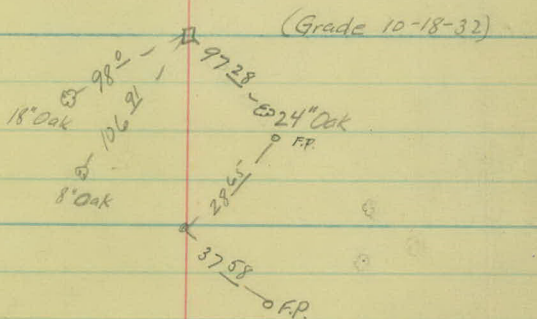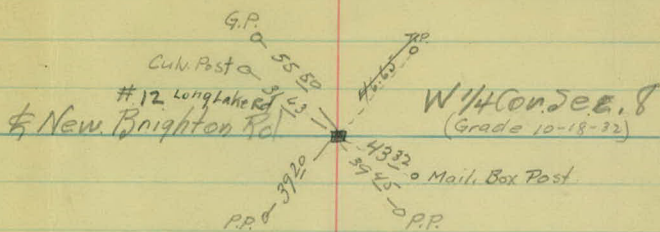

Ang. ht. Ang. R4

101+46¹ Mont.

93+88³⁵ P.O.T.

75+19² Mont.
P.O.T.

2

* Cleveland Ave.

Conc. Mont.

Conc. Mont.

39.90 = Iron Rd. Ky.

56.16

51.48

55.40

46.60 P.P.

E. 1/4 Cor. Sec. 8

Brass Plug
in Pavement

TRIPLE
OAK

38.30

43.24 10"

1940.185
1789.165
2510.2


Ch. Sec. 8
(Grade 10-19-32)

27.73 T.P.

58.88

46.82

6" Oak

 

Road #61

West Cobine to Cleveland Ave

Artificial Topography

Sta 0+00 to 101+46⁺

Austin.

Skoglund.

Berthiaume

Tankoski.

} Panty

$\frac{1}{2}$ to $\frac{1}{4}$

Hint Road

Sta 0+00 to 48+70

Gravel Road

Sta 48+70 to 101+46⁺

Width
Road Bed

16.0

16.0

16.0

Dirt Road.

16.0

16.0

16.0

H² 4-9-25

Rd #61

6000

Meadow
land

BRUSH

5000

0.6"

4000

0.18"

3000

2000

Scrub Timber

Scrub Timber

1000

+35 Road

0000

Width
Road Bed

15.0

15.0

14

Dirt Road

15

15

16.0

16.0

Rd #61

17.5

13+00

17.5

12+00

17.5

11+00

16.5

10+00

20'

9+00

20'

8+00

+80

7+00

6+00

Waste land. scrub Timber

Pasture

right of way

Width
Road Bed

14.0

14.0

14.5

14.5

14.5

15.0

16.0

Road #61

Meadow
band

Waste band

Pasture

15.5

19 24"

10.5

16.1

17

17.5

16.1

17

16.5

12.8

16.5

20+00

19+00

18+00

17+00

16+00

15+00

14+00

13+00

Width
Road Bed.

12.5

14.0

15.0

13.0

15.5

16.0

16.0

RD #61

±

27.00

+63 drive

+52 T.P. 16.5

26.00

25.00

24.00

23.00

22.00


21.00

20.00

Cultivated.

Meadowland

Barland

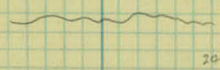

12
14.5

20'

15.5

14'

12.2"
12"

Width
Road Bed

15.0

15.0

13.0

14.0

14.0

15.0

13.0

Rd #6

34+00

+77 T.P. 16' R1

16"

20" Twin

33+00

20"

+29 T.P. 16.5

32+00

+00-8" x 16.4 V.P. 31+00

+76 T.P. 16' R1

Posture
+13
+12
+11
+10
+9
+8
+7
+6
+5
+4
+3
+2
+1
0
-1
-2
+265-15' x 31.4 C.M.P

30+00

Cultivated

+53 T.P. 29' R1

+67 F.COR. 16' R1

+54 R.O.M.

+32 T.P. 16.5

29+00

+93 T.P. 17' R1

28+00

27+00

Width
Road Bed

15.0

16.0

16.0

15.0

14.0

14.0

15.0

Rd. #61

E

41+00

+68 T.P. 14' Rf.

40+00

+26 T.P. 14' Rf.

39+00

Meadow land

+89 T.P. 12.5

38+00

Cultivated

37+00

+53 T.P. 15' R

36+00

+59

+16 T.P. 16' Rf.

35+00

Pasture

34+00

Width
Road Bed

16.0

15.

16.0

15.0

16.0

16.0

15.0

First Road

Rd #61

48+00

+75 T.P. 12.5

47+00

+35 T.P. 14.5
+22.5-12" x 20.5 G.M.P.

46+00



Cultivated

Dirt Road

Meadow land

45+00

+89 T.P. 13.5

44+00

+45 T.P. 14.5

43+00

+06 T.P. 13.5

42+00

41+00

Road. Shoulders
Surface Widths

18' 27'

17.0

Rd #61

55400

+55 T.P. 27.5

54400

Meadow land

+17 T.P. 28.5

53400

Brush and scattered timber

28' 20'

Gravel Surface

+56 T.P. 28'

52400

Cultivated

51400

+56 T.P. 28.5

50400

+19 T.P. 28.5

+02-18" X 34" C.M.P.

49400

+82.5 ft New Brighton Road

48400

20

26

18

24

62+00

+44 T.P. 28.5

61+00

Cultivated

+12 T.P. 28.5

60+00

~~~~~

Small Timber and Brush.

59+00

+74 T.P. 28.5

Cultivated

58+00

+34 T.P. 28.5

57+00

~~~~~

Meadowland

+94 T.P. 28.5

56+00

55+00

15 24

69400

+86 T.P. 30' R1.

68400

Anoka Survey

+99 T.P. 30' R1.

67400

+97 M. Box 11.5

+944 Drive

66400

+54 T.P. 29.5

65400

Cultivated

Cultivated

+21 T.P. 29' R1.

64400

+83 T.P. 29.5

63400

62400

17.0 24'

17 23.5

76+00

~~~~~

Small Timber

+15 T.P. 27.5

75+00

74+00

+73 T.P. 28' Pt

~~~~~

73+00

Cultivated

+28 T.P. 28.5

72+00

71+00

+61 T.P. 28.5

Cultivated

70+00

+55 T.P. 29' Pt

69+00

18

25

8400

+56 T.P. 27.5

8200

12" X 20' G.M.P.
NEW

+55 1/2 Drive

+15 T.P. 27.5

81400

80100

+61 T.P. 28' Ht.

79400

Cultivated

Cultivated

+15 T.P. 27.5

78100


77400

+68 T.P. 27.5

76400

20 27

90400

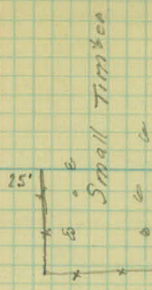

89400

+57 T.P. 25.5
+46 F. Cor. 25.5

88400

+09 T.P. 28.41 87400

86400

+63 T.P. 28.41

85400

Cultivated

Cultivated

+09 T.P. 27.5 84400

83400

17' 23'


19 24

977+00

Uncultivated

96+00

+75 T.P. 25

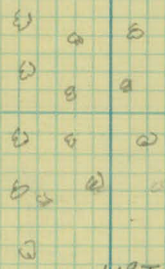

95+00

+19 T.P. 23.5


94+00



22' x x x +47 F. Con.

93+00

+90 T.P. 11.5

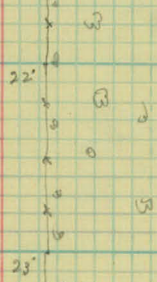

92+00

23'

+50 T.P. 23.5

91+00

Cultivated

Small Timber


23.5'

+02 T.P. 24.5

90+00



18 25

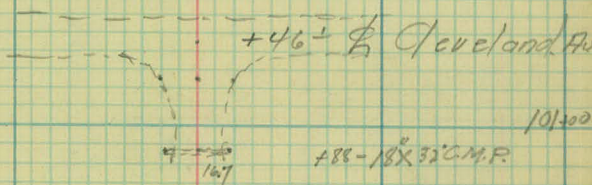


101+00

+88-18X 32' C.M.P.

+66 T.P. 29' R.V.

+178 Drive.

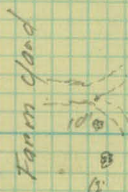

100+00

Uncultivated

+91 T.P. 28.5


99+00

Cultivated

98+00

+30 T.P. 28' R.V.

97+00

 

Road #61

Centerville Road to Bald Eagle.

Transit Notes

Sta. 0+00 to 60+52.5

Astin
Skooglund
Berthiaume } Parly.
Jankowski

Apr - 1925

Station



Ang. ht. Ang. Rt

26 + 54.6 P.O.T

12 + 16.25 P.O.T.


0 + 00 = (1/4 Centerville Road = 67 + 12.9)

H² (Rd #61)

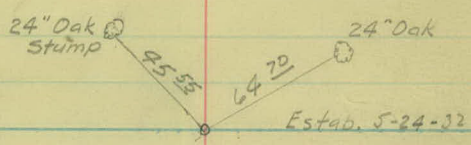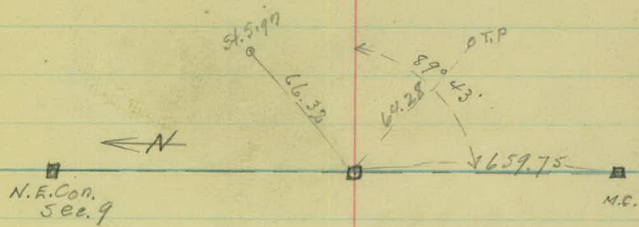

0+00 H²-67+12.9

Centerville Rd

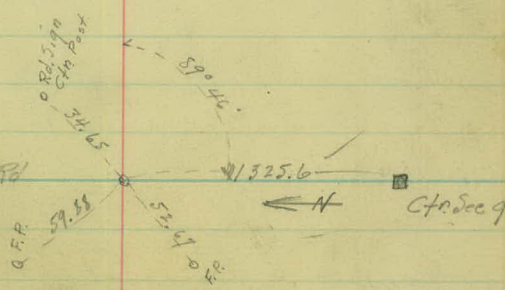

Station

Ang. ht Ang. Rt.




80+52.5 $\frac{1}{2}$ Bald Eagle Rd


65+32.0 P.O.T.

52+89.9 P.I. $0^{\circ} 34'$ = (Sta 152+88 Otter Lake Rd)
Carlson's Survey.

47+18.6 P.I. $0^{\circ} 23'$

Rd #61

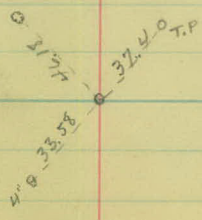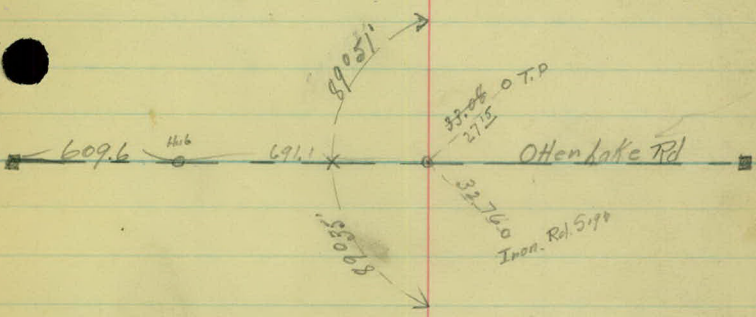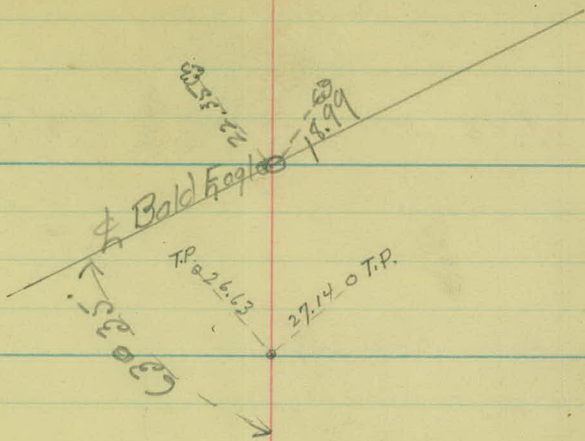

 

County Road. #61

Centerville Rd to Bald Eagle

Sta 0+00 to 80+51.

15.0 25

16.0 25

20.5

6400

X

X

X

20'

5400

+93 Caution Sign 17.5
"School"

X

X

X

20.5

4400

X

X

X

3400

+10 Beg. Fence. 21' H

Cultivated

2400

Meadow land

1400

+26 I. Rd Sign 26'
+22 I. Rd Sign 21.5'
+20 I. Rd Sign 26.5'

± Centerville Rd



{+17-10" X 30.5 C.M.P.
Barried}

0400

17.0 24'

17.0 23.5

13+00

+51 & Drive

+73 T.P. 26.5
+57 & Drive

Farm Land

School Grounds

12+00

11+00

10" X 36.5 C.M.P

+12 & Rd

+50 T.P. 26.5

+22 & Rd

12" X 52' C.M.P

10+00

+97 E. Cor. 195

+31-12" X 24.5' V.P.

9+00

← 22.5'

30.5

30.0

20.5

Meadow land

Cultivated

8+00

7+00

6+00

16.0 25

16.0 28

16.0 28

16.0 30.0

16.0 23.0

20+00

19+00

+48 T.P. 26.5

18+00

+52 Caution Sign 14'
School

17+00

+50 T.P. 27.4

16+00

Cultivated

15+00

Cultivated

+22 T.P. 25.5

14+00

13+00

17.0 23.5

17.0 25

16.0 27'

16.0 22

16.0 22

16.0 22'

16.0 23

27+00

26+00

+04 T.P. 25

25+00

24+00

Cultivated

Cultivated

+00 T.P. 26

23+00

22+00

21+00

+ 52 T.P. 26.5

20+00

16.0 22

16.0 22

17.0 24

17.0 29'

18.0 30

17.0 28.0

19.0 27.0

34400

203

Cult.

+18 T.P. 23.5
12" X 16" C.M.P.

114. Drive

33400

Platted lots.

Small
Trees

32400

12" X 30.0" C.M.P.

+187 Rd

172

15.5

Cultivated

+23 T.P. 24.5

31400

Platted lots.

30400

12" X 30.5" C.M.P.

+28 Rd

113

12.5

+19 T.P. 24.5

29400

Platted lots.

+87-12" X 40.0" V.P.

175

Cultivated

28400

+13 T.P. 25.0

27400

16.0 22 -

17.0 25

16.0 23.0

16.0 23.0


16.0 22

16.0 22.5

16.0 23.5

41+00

Garden

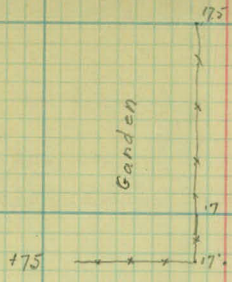

40+00

144 T.P. 23' RT

39+00

+50-10" x 30.7 V. P.



38+00

+56 T.P. 23' S

+28 1/2 Drive

Cultivated




+36 1/2 Drive

37+00

+29 1/2 Drive

Cultivated

36+00

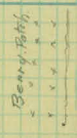

+29 T.P. 23' RT

35+00

Cult.

34+00

16.0 22

15.0 22.2

15.5 22.5

16.0 24.0

16.0 27.0

16.0 27.0

17.0 26.0

25.5

46+00

1/2" S

14" B

+47 T.P. 20'

4" G

4" B

47+00

+89

21

27'

Chicken
Yard

27

+31

+09

24.5

46+00

+64 T.P. 24' RT.

20.5

45+00

Cultivated

Garden

19.5

44+00

+60 T.P. 23.5

Drive

19

43+00

+94

6" B

Garden

18

42+00

Cultivated

+53 T.P. 23.5

41+00

17.0 26.0

16 21

16 21

16.0 21

16 21

16.0 21

55+00

+94 P.P. 34.5

23

+15 T.P. 15' ht

Meadow land

22.5

Pasture

54+00

+15 T.P. 21.5
+11 P.P. 34.5
+07 E. Cor. 22

53+00

+85 & Other 4 K. Rd

+55 & Rd

15" x 40.5' C.M.P

+61

+62 I. Rd. Sign 17' W

52+00

Farm
Yard

+61 T.P. 22.0
+59 P.P. 35.5

+24 & Drive (12" x 16' C.M.P.)
+16

51+00

Cultivated

23.5

199

Tennis
Court

22.5

+50 +55 T.P. 23.5

50+00

Cultivated

49+00

24

+71 End Fence

+32 & Drive

48+00

17.0 21

18.0 21.5

17.0 22

18.0 22

17.0 37.0

18.0 40

17 37

62+00

+66 T.P. 19.5'

+66 T.P. 21'

61+00

Cultivated

Hwy. band

+68 T.P. 35.5'

60+00

+56 T.P. 19.5 ft

+58 T.P. 21.5'

+51 F.Gor.

21.5

59+00

Cultivated

+78 P.P. 35

58+00

+16 T.P. 19' 11"

+19 T.P. 21.5'

+96 P.P. 35' R/L

57+00

Meadow band

Pasture

56+00

22

+38 T.P. 22'

55+00

17.0 23

17 23

17 23

17.0 22.5

17. 22

16.0 21.0

17.0 21.0

69+00

68+00

67+00

66+00

65+00

64+00

63+00

62+00

+83 T.P. 19'

+68 P.P. 36' R1

+96 T.P. 20'

Cultivated

Cultivated

12" X 16' C.M.P.

+52 T.P. 19.5
+97

+29 Foot. 19.5

+27 P.P. 36'

+51 T.P. 19.5

+50 T.P. 20.5

Hedge

Wood.

+80 Drive (12" X 16' C.M.P.)
+80

+80

Hedge

Farm.

+34 P.P. 36' R1

+51 T.P. 19'

+57 T.P. 20' R1

+35 Drive

Cultivated

Hog. band

+53 P.P. 35.5

17 27.0

17.0 29.0

17.0 24.0

17.0 25

17.0 25

17.0 23

17.0 23.0

H²

76100

+75 F. Cor. 25.5 ft



+47 T.P. 25.5

+20 P.P. 36'

75100

(4-10")
6"
8"
8"

⊗ 14"

12" ⊕

74100

Cultivated

Cultivated

+65 P.P. 35.5

+44 T.P. 26'

73100

+56 T.P. 22

+24 P.P. 36'

72100

+41 T.P. 27'

71100

+122 T.P. 20.5

+76 P.P. 36' R1

70100

Cultivated

Cultivated

+36 T.P. 17.5

+35 T.P. 20'
+25 P.P. 35.5


69100

17. 23.0

16.0 22

16 23

16.0 25.0

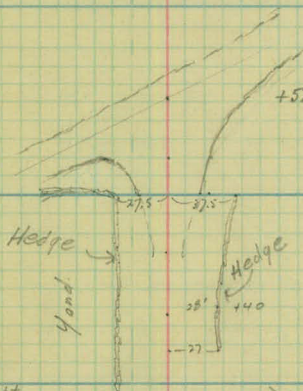

+52.55 & Bald. Eagle Blvd.

80+00

Hedge

Yard

Hedge

+67 R.R. 20' RT

+17 Bag Hedge 29'

79+00

+95 Bag Hedge 28' RT
12" X 20.4 C.M.P.

+82 1/2 Drive

+70 17.5

86"

84"

816"

66"

6" @

Yard

+38 R.R. 21.5

76+00

Willow Clump
4-5" Trees

Willow Clump
7-8" Trees

+57 R.R.

16" @

(Willow Clump)
8-10"

+17 T.R. 24.5

77+00

Yard

+69 Rod. Fence

+60 Drive

145

Yard

+77 R.R. 27'

+63 - Foot Bridge 3.5 Wide

Farm

76+00

