

OFFICE OF COUNTY ENGINEER
RAMSEY CO. MINN.

Road Map.....*Survey*

TURTLE LAKE RD.

(S.T.H. 49)
From *Hodgson Rd.* To *N. County Line*

Road Acc't. No. *62*

Date Filed *1-17-28* File

1-17-28

Road $\frac{1}{2}$ # 62

TURTLE LAKE ROAD

Alignment from the Hodgson
Road to the North Co. Line Road.

ROAD MAP SURVEY

Received 12-22-27
O. J. [Signature]

Office of Ramsey Co. Engineer
ST. PAUL, MINN.

Date Filed 1-17-28

File No.

Sta. Point Δ Lt. Δ Pt.

21+72⁴⁴ P.T. ✓

N. 19° 00' E. ✓

21+19⁸⁵ P.I. ✓

$\Delta - 91^{\circ} - 00'$

P - 60° L

T - 71³³ ✓

L - 123⁹² ✓



20+48⁵² P.C. ✓

R - 100⁰⁰ ✓

0+00

N. 90° - 00' E. ✓

12-5-27
 P.C.
 A.P.
 P.S.
 A.B.

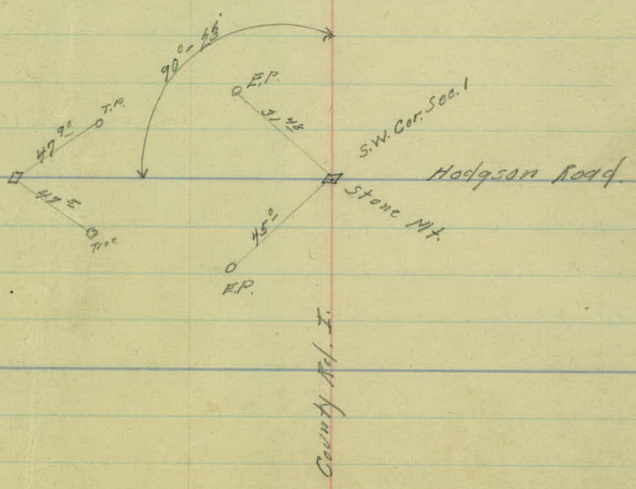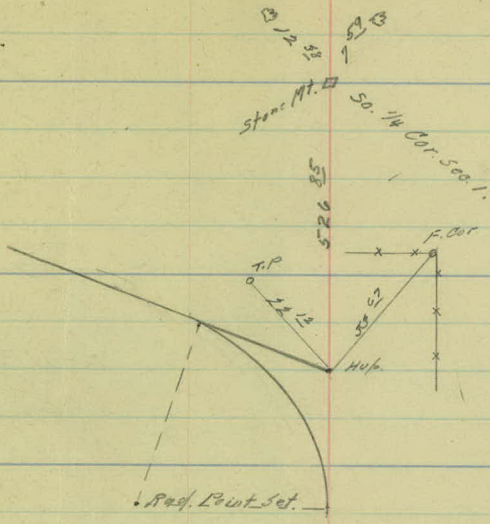

Sta. Point Δ Lt. Δ Rt.

29 + 58 ⁶⁷ P.T. ✓

14° - 16°

+50

13° - 45°

29

10° - 45°

+50

7° - 45°

28 + 42 ⁴⁵ P.I. ✓

Δ - 28° - 33'

28

4° - 45°

D - 12° R.

+50

1° - 45°

T - 121 ⁷⁰ ✓

27 + 20 ⁷⁵ P.C. ✓

0° - 00'

L - 237 ⁹² ✓

R - 478 ⁵⁴ ✓

25 + 45 ²⁰ P.T. ✓

2° - 24'

25

1° - 57'

+50

1° - 27'

24 + 25 ²⁵ P.I. ✓

Δ - 4° - 48'

24

0° - 57'

D - 2° R.

+50

0° - 27'

T - 120 ⁰⁵ ✓

23 + 05 ²⁰ P.C. ✓

0° - 00'



L - 240 ⁰⁰ ✓

R - 2864 ⁹³ ✓

N. 19° 00' E. ✓

N. 52° 21' E. ✓

N. 23° 48' E. ✓

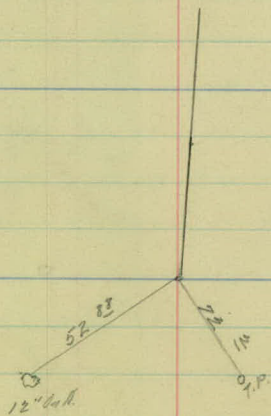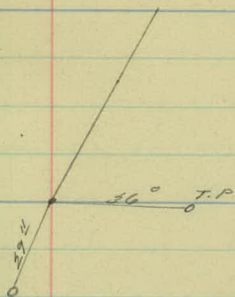

Sta. Point Δ Lt. Δ Rt.

34+42 ⁸² P.O.T.

N 00° 16' W.

32+30 ²⁸ P.T. ✓ 26°-18' ^E
 32 21°-41' ^E
 +50 14°-11' ^E 0.43

31+50 ² P.I. ✓

31 0°-41' ^E 45.02

30+55 ³² P.C. ✓ 0°-00

Δ -52°-37'


D-30° L.

T-75 ⁵¹ ✓

L-175 ³⁹ ✓

R-193 ¹⁹ ✓

N 52°-21' E.

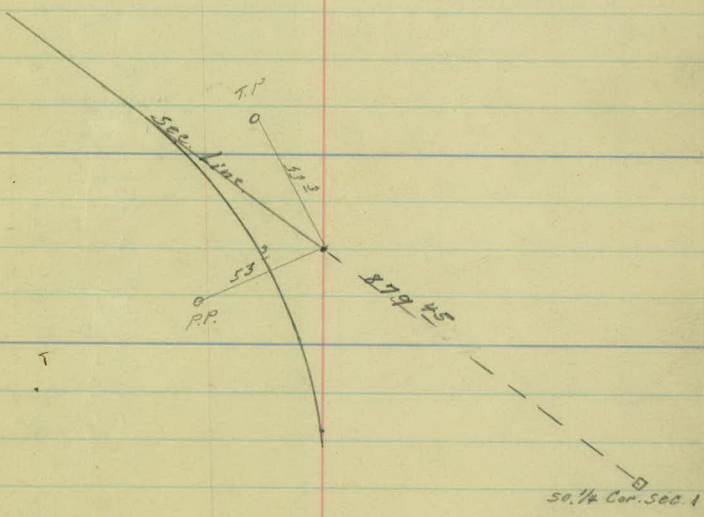

Sta. Point A Lt A Rt.

76+42⁰⁰ P.T. ✓

S. 88°-16' ✓

75+30[±] P.T. ✓

Δ-2°-14'

D-1° Rt.

T-111⁰⁰ ✓

L-223⁰⁰ ✓

74+18⁷³ P.C. ✓

R-5729⁶⁵ ✓

N. 89°-30' ✓

49+56²⁰ P.T. ✓

47+19⁰⁰ P.T. ✓

Δ-89°-46'

D-100° Rt.

T-65⁰⁰ ✓



L-102⁰⁰ ✓

48+54⁰⁰ P.C. ✓

R-65⁰⁰ ✓

N. 00°-16' N. ✓

12-13-27

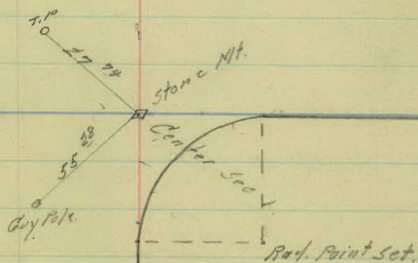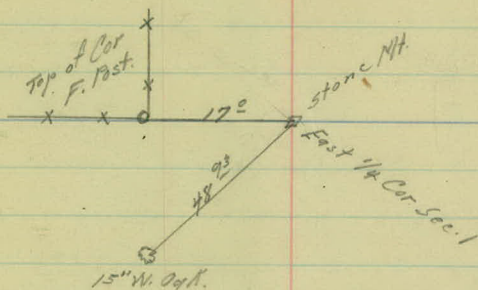

Sta. Point Δ Lt. Δ Rt.

113+60 ⁵⁸ P.O.T.

N 00° 05' W ✓

101+23 ⁴³ P.T. ✓

100+86 ¹ P.I. ✓

Δ -91° 49'

D-100° L.

T-67 ³² ✓

L-104 ⁶⁰ ✓




100+18 ⁸³ P.C. ✓

R-65 ⁴⁷ ✓

83+72 ⁰⁰ P.O.T.

S. 88° 16' E. ✓

12-13-27

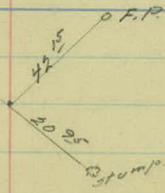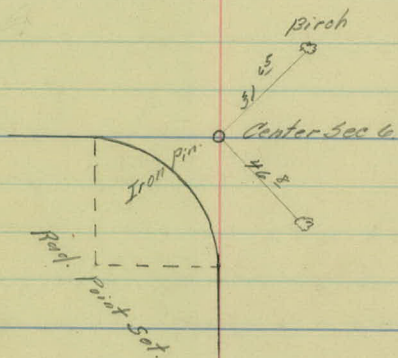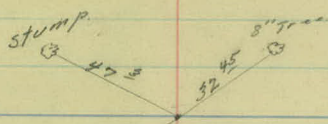


5th.


Point Lt. Lt.

132706²⁸

P.I.

N 00°-05' W.

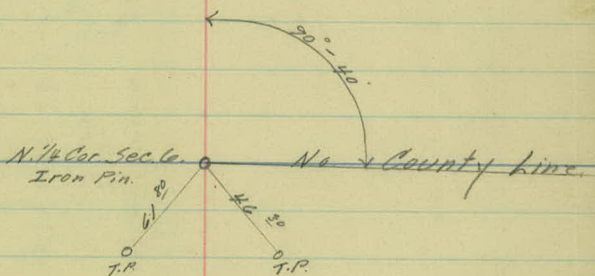

 

Road $\frac{9}{16}$ H 65.

Co. Road "I."

Art. Topog. from the
Hodgson Rd. to Co. Rd. "I."

4

3

2

1

0700

12-12-27
P.C.
A.P.
D.S.
A.B.

S.L. 11
+92 -6" T-

S.L. 11

+10 P.P. 24

+13 T.P. 20

+66 -12" T-33

Waste land

+60 P.P. 22

Cultivated

+06 F. Cor. 33

+81 T.P. 22

School Yard.

F. 33

+23 Mail Box 20
+29 P.P. 22
+17 Iron N/ Sign 26

+52 T.P. 21

+32 F. Cor. 33

Hofgson

Boyd.

County Road I

10

9

8

7

6

5

4

12-12-57

Timber Bridge.
15-5'x12' Floor
2-12x12x24 Caps
3-5' Pike Posts
11-6" I. Beams 16 long

+75 P.P. 27

S.L. 8

+78 P.P. 26

S.L. 9

+72 P.P. 26

S.L. 9

S.L. 10

+74 F.C.P. 25
+73 P.P. 25

S.L. 10

+40 P.P. 25
+30 Bay of F. 25
+16 X. 15 of Sign 11

Bottom Land

Bottom Land

Bottom Land

+79 End of Bridge
+81 Bay of Bridge

+45 T.P. 25

S.L. 10

+20 T.P. 25-

S.L. 10

S.L. 10

+84 T.P. 23

S.L. 11

+54 T.P. 23

S.L. 11

+52 T.P. 23

16

15-

14

13

12

11

10

S.L. 8
+78 T.P. 28

S.L. 12

+16 P.P. 28

S.L. 8

S.L. 8

+74 P.P. 28

+61 F.Cor. 21

S.L. 4

+12 P.P. 27

S.L. 7
F. 27

+01 F.Cor. 24

Scrub Oaks

Bottom Land

Cultivated

Bottom Land

S.L. 14
F. 33

+67 P.P. 24

F. 33
S.L. 13

+48 T.P. 26

F. 34
S.L. 12

+23 F.Cor. 36
+23 T.P. 26
+03 Overhead Power Line
S.L. 13

+70 Overhead Power Line
+61 Mail Box 15

S.L. 12

+97 T.P. 26

S.L. 12

+67 T.P. 24

22

21

20

19

18

17

16

S.L. 11
 +97-8" T-25
 +72 Apple T. 56

+59 P.P. 21
 +52 Apple T. 20
 +56 Ever Green 26
 +24 Ever Green 20
 +17-8" T-21
 +05-6" T-33
 S.L. 10

+84-P.P. 24
 +82-10" T-30
 +60-6" T-21
 +25 Twin T. 27
 +07-6" T-24

S.L. 10

+94-8" T-23
 +80-6" T-22
 +64-8" T-22
 +39-6" T-22
 +21-12" T-22
 +11 Ever Green T. 25
 +09 P.P. 28
 S.L. 9

+95 Farm Eat
 +86 Ever Green T. 24

S.L. 9

+84 P.P. 28

S.L. 8

Cultivated

Orchard

Lawn

500 line

Bush & Small Trees

Cultivated

S.L. 11
 F. 21

+72⁴ Fence 20

+37 X Fence

+27 T.P. 22

S.L. 15
 +00-6" T-35

+58 P.P. 19

+48⁵ F. 34

S.L. 11

+37 P.P. 19

F. 33
 S.L. 14

+13 T.P. 23

S.L. 14
 F. 33

+26 Sharp Turn Sp. 15

S.L. 15
 F. 34
 +95 T.P. 24
 +92-18" T-31

28

27

26

25

24

23

22

F. 26
F. 16
S.L. 10

P. 22
S.L. 13

S.L. 19
F. 13
F. 23

+34 Sharp Turn Sign

+19 T.P. 14

S.L. 12
F. 17

+54 P.P. 14

S.L. 11
F. 17
+97 F. Cor. 27

S.L. 10
F. 16
+94 T.P. 18

S.L. 12
F. 24
+96 P.P. 19
+68 Sharp Turn Sign 12
+57 P. 28
+49 F. 85
+29-18" T-33
+22 F. Cor. 33

S.L. 11
F. 17
+74 T.P. 17

S.L. 11
+97 Farm Ent.

S.L. 11
F. 21
+97 Field Ent.

+17 P.P. 18


+56 T.P. 18

+00 S.L. 10
+89-10" T-26
+75 Farm Ent.

F. 23
S.L. 12

+88 Evergreen St
+59-8" T-28
+55 Mail Box 15
+45-6" T-32
+34 Pier Green 30
+13-10" T-31

+35 T.P. 14

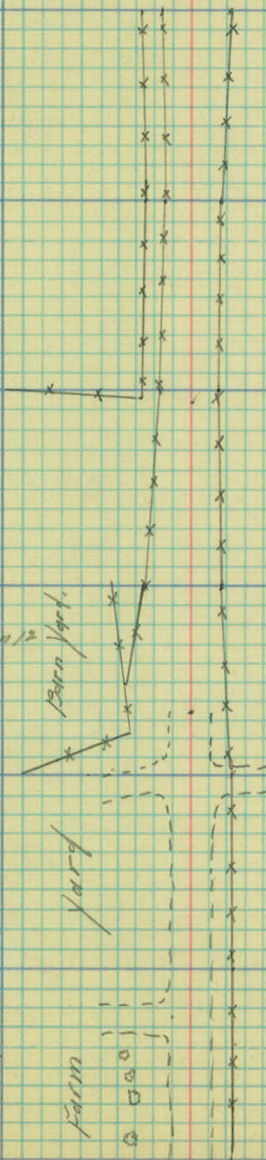

34

33

32

31

30

29

28

F. 34
F. 24
S.L. 12

F. 16
S.L. 11

F. 34
F. 24
S.L. 12
+92 P.P. 22
+50 F. 34
+50 F. 24

F. 15
S.L. 9
+91 P.P. 14
+91 F.P. 14

+
+49 F.Cor. 23

F. 34
F. 24
S.L. 13

F. 21
S.L. 8
+72 F. 25
+72 T.P. 25

+66 F. 34
+66 F. 24
+50 F. 34
+50 F. 24
+41 P.P. 31

+60 F. 27
+21 F.Cor. 39

F. 46
F. 36
S.L. 12

F. 32
S.L. 12

+77 T.P. 22

+50 F. 45
+50 F. 35

+50 F. 23

F. 37
F. 27
S.L. 10

F. 24
S.L. 12

+68 P.P. 21
+50 F. 30
+50 F. 20

+68 T.P. 20
+50 F. 24

F. 27
F. 17
S.L. 10

F. 21
S.L. 12

+50 F. 30
+50 F. 19

+50 F. 27
+44 T.P. 21

+11 P.P. 18

Cultivated.

Cultivated

40

39

38

37

36

35

34

12-14-27

S.L. 13
F. 25

+20 P.P. 22

+085 Pump 22

F. 25
S.L. 13

S.L. 12
F. 24

+56 P.P. 23

F. 24
S.L. 13

+79 10" T-22

+17 F. 23
+19 F. Cor. 33

F. 22
F. 22
S.L. 11
+72 P.P. 22

+08 Sharp Turn Sign 11

F. 34
F. 24
S.L. 11
+64 Box of F. 34
+60 Box of F. 34

+49 End of F. 34
+43 End of F. 34
+35 P.P. 23

Wooded Pasture

Cultivated

S.L. 10
774-18" T-31

Cultivated

S.L. 10
+97 T.P. 17

S.L. 11
+80 T.P. 17

S.L. 12
+57 T.P. 17

S.L. 11

+50 T.P. 17

+86 W. of Box 12
+79 P.P. 30
+72 P.P. 33
+71 End of F. 18
+63 P.P. Line Road

+10 T.P. 14

+95 Power Line Xing
+72 T.P. Xing
+59 Power Line Xing

46

45

44

43

42

41

40

S.L. 13
F. 24
+99 T.P. 22

F. 17
S.L. 10

+24-4" T-21
+107-4" T-20

+25 hasp Turn Sign 34
+11 T.P. 17

S.L. 11
F. 25

S.L. 12
F. 17

+99-4" T-21
+88-4" T-23

+29 P.P. 24
+23-2" T-23

+109-6" T-19

F. 24
S.L. 11

F. 17
S.L. 10
+91 T.P. 17

wooded pasture

F. 25
S.L. 12

F. 17
S.L. 11

+56- P.P. 23
+40-6" T-20

+65 T.P. 17

F. 25
S.L. 11

S.L. 11
F. 17


+96-8" T-21
+91-12" T-19
+68-6" T-24
+68-6" T-19
+55-6" T-24

+46 P.P. 17
+28 X Fence 16

F. 26
S.L. 11
+86 P.P. 23

S.L. 10
F. 16
+65 F. Cor 16
+46 Farm Ent.
+37 Nail Box 18
+17 T.P. 17

cultivated

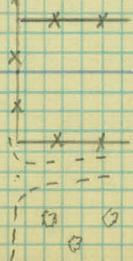


52

51

50

49

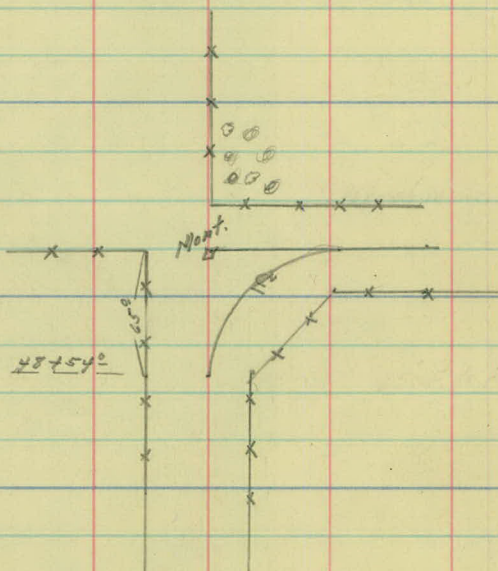

48

47

46

F. 32
S.L. 12

F. 31
S.L. 12

+95 Field Ent.

+55 P.P. 17

F. 24
S.L. 11

+56²⁶ F. 20
+42 P.P. 20
+27 Stump 28

+13 F. Cor. 39

+02 P.P. 54
S.L. 14

+64 T.P. 19
+54 F. 32

F. 30
S.L. 12

+67 F. 29
+62 F. 23
+58 P.P. 22

+32 - 4" T. 21

F. 34
S.L. 10

+99 - 6" T. 19

+48 - 4" T. 21
+43 - 4" T. 22
+20 - 4" T. 22

Hay Meadow.

see opposite page.

Washed part for 2x

F. 27
S.L. 12
+84 T.P. 26

F. 26
S.L. 13

+57 T.P. 26

+49 Field Ent.

F. 29
S.L. 13

+56²⁶ F. 29
+41 F. 28

S.L. 8

+50 F. 20
+55 T.P. 20

F. 19
S.L. 10

+53 T.P. 18

F. 18
S.L. 9

+31 T.P. 19

Cultivated

58

57

56

152 x Drain?

55

54

53

52

S.L. 13
F. 28

+08 P.P. 20

S.L. 12
F. 27

S.L. 13
F. 24

+51 X Fence 24
+50 P.P. 19

F. 28
S.L. 12

F. 31
S.L. 13

+85 P.P. 19

F. 32
S.L. 12

Highway Turn Sign. 11
+12 P.P. 19

Brush & Meadow Land.

Meadow
Waste
Land.

Cultivated

Bottom Land.

Cultivated

S.L. 11

+98 T.P. 23

S.L. 11

+75 T.P. 24

+29-14" T-15
+22-12" T-17

S.L. 11

+52 T.P. 23

S.L. 11

+36 T.P. 25

S.L. 11

+42 F. Cor. 26

F. 25
S.L. 12

64

63

62

61

60

59

58

12-19-21

S.L. 13
F. 27

S.L. 12

+58 P.P. 22

+530
S.L. 13

+04 T.P. 21
S.L. 12


Hail Meadow

Cultivated

+11 X Fence 30
S.L. 12

+10-12" T-33
S.L. 12

+95 P.P. 22

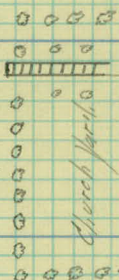

+86 2 Conc Steps 20
7' Wide
+65 T.P. 21

S.L. 12
F. 28

S.L. 12

+32 P.P. 21

+78-14" T-30
+40 T.P. 22

S.L. 11
F. 28

S.L. 12

Meadow Land

Grub

Cultivated

S.L. 11
F. 28

+17 T.P. 23
S.L. 11

+72 P.P. 21

70

69

68

67

66

65

64

12-14-27

F. 23
S.L. 11

+63-24"-T-20

+104 P.P. 25
S.L. 12
F. 23

+60 Field Ent.

F. 23
S.L. 12

+14 P.P. 25

S.L. 13
F. 24S.L. 13
F. 25

+18 P.P. 22

S.L. 13
F. 25

+40 Stumps 24

Cultivated.

Woods.

Cultivated.

Cultivated.

Cultivated.

S.L. 13

S.L. 12

+80 End F. 22
+74 X Fence 22

S.L. 12

+60 S.L. 10
+70-30"-T-16
+44-24"-T-25
+34 End of Orchard 35
+35-4"-T-19
+24-4"-T-20
+11-4"-T-20+60 S.L. 10
+60 P.P. 24
+92 Evergreen 26
+86-14"-T-20
+74-12"-T-20
+66 T.P. 21
+62-14"-T-20
+52-16"-T-20
+39 Apple T. 30
+15 Farm Ent.+66-14"-T-28
S.L. 10

+30 T.P. 21

76

75

74

73

72

71

70

12-14-27

+30 F. Cor. 18

+16 P. Cor. 19

S.L. 11

+90 P.P. 27
+84-18-T-18

+99 Peg of F. 20

S.L. 10

+95 Peg of F. 21

S.L. 10
F. 21

+87 P.P. 27

+63-30-T-18


+31-8-T-21

+24-6-T-20

F. 20
S.L. 11

F. 23
S.L. 10

+96 P.P. 25

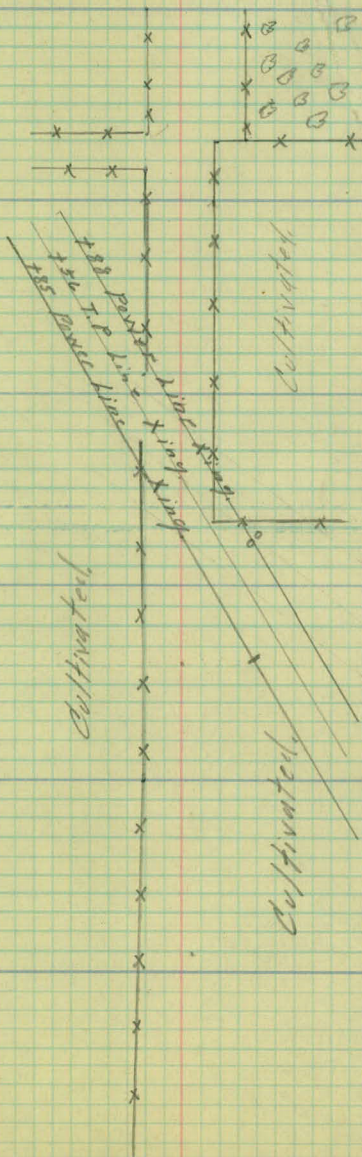

+30 F. 33
+30 F. Cor. 19

S.L. 12

F. 18
S.L. 10

+34 F. Cor. 17

+36 P.P. 42
+21 P.P. 36
+12 T.P. 26

S.L. 13

+63 Steel Tower 36
8' Wide.

S.L. 13

+41 Farm Ent.

S.L. 14

82

81

80

79

78

77

76

F. 28

+63 P.P. 31

+09 Field Ent

F. 27

F. 35

S.L. 12

+70 P.P. 30

Cultivated

F. 33

+44-6"-T-28

+40-6"-T-28

+35-8"-T-23

+19-14"-T-25

+14-12"-T-25

F. 33

S.L. 12

Woods

S.L. 14

F. 20

S.L. 12

+70 P.P. 21

F. 33

88

87

86

85

84

83

82

F. 24
S.L. 12+55
+55 F. Cor 24
+55 F. 28

F. 30

+52 P.P. 34

F. 30

F. 32

+42 P.P. 34


F. 33

F. 32

+57 T.P. 34



Cultivated

 

Woods

Uncultivated

F. 33
S.L.

+80-8" T-28

+65-12" T-28

F. 33

F. 33

94

93

92

91

90

89

88

F. 27
S.L. 11

F. 27
S.L. 12

+54 T.P. 35

F. 27
S.L. 12

F. 27
S.L. 12

+52 P.P. 53

F. 24
S.L. 12

F. 24
S.L. 12

+52 P.P. 33

Cultivated

Woods

F. 32
S.L. 13

F. 33
S.L. 12

F. 33
S.L. 12

+42 Twin T. 46

F. 33
S.L. 12

+60 Triple T. 26

+106-12"-T-23
F. 33
S.L. 13
+98-6"-Willows 29

+90-4 Willows 26

S.L. 12
F. 33
+91-30"-T-23
+73-10"-T-24
+58-6"-T-22

+48-8"-T-31

+36-8"-T-27

+18-10"-T-28

100

99

98

97

96

95

94

F. 29
S.L. 14
+94 P.P. 29

F. 27
S.L. 12

+38 P.P. 31

F. 26
S.L. 12

F. 26
S.L. 12

+44 P.P. 30

F. 27
S.L. 12

S.L. 11
F. 26

+50 T.P. 31

Cultivated

F. 31
S.L. 12

F. 31
S.L. 13

F. 32
S.L. 13

+46-6"-T-23

+15-4"-T-31

+08-6"-T-21

F. 32
S.L. 13

+79-4"-T-25

F. 32
S.L. 13

S.L. 12
F. 32

+20-4"-T-25

Woods

106

105


104

103

102

101

100

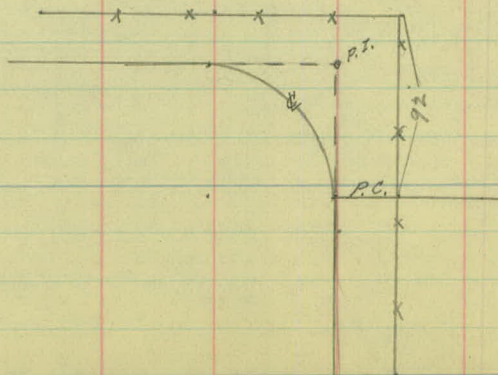

12-22-27

F. 26
S.L.

+24 P.P. 27

F. 25
S.L. 15

F. 25
S.L. 15

+24 P.P. 26

F. 24
S.L. 12

F. 23
S.L. 13

+34 P.P. 26
+23 F. 23
S.L. 13

+90 F. 18

+60 F. 22
+18² F. 29

Cultivated.

F. 25
S.L.

+38-6"-T-18
+26-4"-T-18

F. 25
S.L. 9

+64-6"-T-23

F. 25
S.L. 10

Woods

F. 25
S.L. 12

+23-6"-T-18

F. 14
S.L. 12

+90-4"-T-18

+61-6"-T-21
+51-6"-T-19
+27-6"-T-20
+23 F. 25
+19-6"-T-15
S.L. 11

See opposite page
for detail

+18² F. 31

112

111

110

109

108

107

106

F. 32
S. L. 18

F. 25
S. L. 6

+08 P.P. 31
F. 31
S. L. 18

S. L. 7
F. 25

F. 30
S. L. 18

F. 25
S. L. 7

+17 P.P. 30

F. 30
S. L. 18

F. 25
S. L. 7

+44 Boy of F. 30
+56 Farm Ent.

+28 F. Cor. 29
F. 29
S. L. 16

F. 25
S. L. 9

+23 P.P. 29

F. 26
S. L. 15



F. 25
S. L. 9

+21 X. Fence.

Cultivated.

Cultivated.

Cultivated.

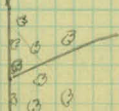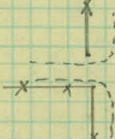

118

117

116

115

114

113

112

S.L. 18

+73 Power Line Xing
+55 T.P. Xing

+58 T.P. 28

+56 Power Line Xing

+25 P.P. 24

+19 P.P. 20

S.L. 14

+97 P.P. 34

+49 -12" T-27

+05 -12" T-28

S.L. 17

Orchard

Farm Yard

S.L. 19

+99 P.P. 33

+85 -6" T-40

+10 -6" T-39

+95 Farm Ent.

+82 F. Cor. 34

S.L. 20

F. 32

+00 P.P. 32

X X

X
X
X
X
X
X
X
X
X
X
XX
X
X

Cultivated

S.L. 8

+85 T.P. 16

+85 F. Cor. 16

S.L. 4

+02 T.P. 15

S.L. 6

Orchard

Farm Yard

+45 -12" T-13

+29 T.P. 14

S.L. 4

+72 -12" T-12

+06 -12" T-11

+95 Farm Ent.

+85 -12" T-11

S.L. 4

+68 F. Cor. 28

124

123

122

121

120

119

118

S.L. 13

S.L. 10

S.L. 15

+92 P.P. 29

+18 X Fence 24

S.L. 15

S.L. 16

+99 P.P. 31

S.L. 14

+01 P.P. 33

S.L. 18

+21 End of F. 17

S.L. 9

S.L. 9

F. 17

+63 T.P. 17

F. 17

S.L. 9

+37 T.P. 16

F. 17

S.L. 8

+11 T.P. 15

S.L. 8

F. 14

Cultivated.

Cultivated.

130

129

128

127

126

125

124

S.L. 12

Hay field

S.L. 12

S.L. 12

+90 P.P. 24

+08 T.P. 20
S.L. 11

S.L. 13

S.L. 11

+84 T.P. 20

S.L. 13

+79 P.P. 24

Cultivated

Cultivated

S.L. 11

+62 T.P. 19

S.L. 13

S.L. 11

+35 T.P. 18

S.L. 13

S.L. 11

+89 P.P. 27

+14 T.P. 17

132 + 06.5


133

132

131

130

+39 X Fence
+30 P.R. 22

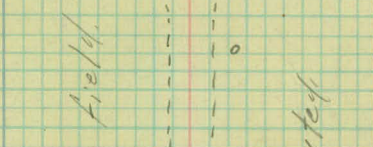

Hay Field

Cultivated

+87 T.P. 42

+52 T.P. 21

S.L. 12

S.L. 10

+84 P.R. 22

+32 T.P. 20

