

OFFICE OF COUNTY ENGINEER
RAMSEY CO. MINN.

Road Map Survey

COUNTY RD. B2

From Victoria St. To Rice St.

From Edgerton St. To Arcade St.

Road Acc't. No. 66

Date Filed 3-27-28 File

3-27-28

3/16/28

CWS.
A.B.
W.A.
T.W.

Co "B" 2

From Victoria St.

To.

Rice Street.

0+00 To 78+62²⁰

ROAD ACCT. #66

Road Map

3-27-28

C. J. M. H.

Sta Point Alt Art.

$$78 + 62 \overset{20}{\underline{\quad}}$$


2422.40

$$52 + 39 \overset{80}{\underline{\quad}} \text{ P.O.T.}$$



2613.70

$$26 + 26 \overset{10}{\underline{\quad}} \text{ P.I. } 1^{\circ} - 26'$$


0+00

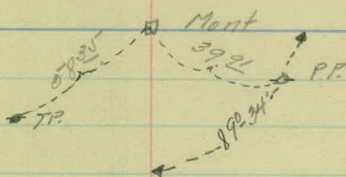

Mont
Co Rd. B.

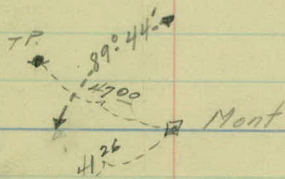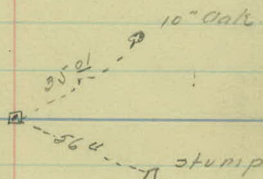


Mont
Co Rd. C.

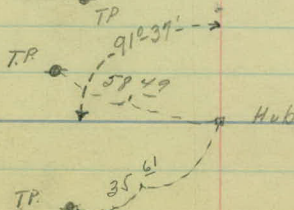

Mont
Co Rd. C.

7

 

3/16/28
C.W.S.
A.B.
W.A.
T.W.

Topography.
From Victoria St.
To
Rice Street

5+00

4+00

+40 R Drive Lt 12" X 24 CM.

3+00

+31 R Farm Ent 12" X 24 CM.

2+00

1+00

+ 32 X Drain 18" X 40 R₃ Rt 205 L 195 ✓

0+00

✓ 3L 14

3L 15

✓ +91 TP 30

Cul.

✓ +13 TP 24

3L 14

3L 15

✓ +97 X 89 14

✓ +89 TP 24

✓ +72 TP 30

✓ +62 TP 24

+218 C 6 24

Farm yard

+58 MB 16

✓ +19 TP 25

✓ 3L 15

3L 15

3L

✓ +62 TP 30

+47 PP 27

+39 EF 27

+39 Reg Cul 24

✓ 3L 14

3L 14 F 27

✓ +55 TP 30

+32 PP 31

✓ 3L 15

3L 16 F 29

✓ +50 TP 30

Cul.

+56 F 33

+36 F 47

+22 PP 39

Victoria Street

12+00

11+00

10+00

+12 R Drive Rt

C.M. ?
1

9+00

8+00

7+00

6+00

✓ +62 TP30

✓ S.L. 15'

S.L. 15' ✓

✓ +34 TP29'

✓ S.L. 14'

S.L. 14' ✓

✓ +06 TP30

✓ S.L. 14'

S.L. 14' ✓

✓ S.L. 14

+02 Bag Cul. ?

S.L. 15' ✓

✓ +77 TP30'

✓ S.L. 14

S.L. 15' ✓

✓ +49 TP30

✓ S.L. 15

S.L. 14' ✓

✓ +19 TP 30'

✓ S.L. 15

S.L. 14' ✓

Cul.

Woods.

Cut
Timber

18+00

17+00

16+00

+01 $\pm$ Drive

12 x 24 CM

15+00

14+00

13+00

✓ 32. 14

32. 10" ✓

✓ +81 TP30

Cul.

✓ 32. 15

32. 15 ✓

✓ +51 TP30

Timber

✓ 15"

15" ✓

Cul.

✓ +23 TP30

+89 Bag Cul/22'

+78 M.B. 14' X

✓ 32. 15

32. 10" ✓

✓ +95 TP30

Cul.

Cul.

2400

2300

2200

2100

2000

1900

✓ +42 TP30

15'

Cul.

15'

✓ +99 TP30^{15'}

Cul.

15'

✓ SL 15

Timber

+29 Sg Rd. 17'

SL 15'

✓ +67 TP30

✓ SL 14

SL 14'

✓ +39 TP30

✓ SL 14

SL 15'

✓ +10 TP30

✓ SL 15

Cul.

Timber

SL 15'

30+00

29+00

28+00

+48 Farm Ent Lt No Culv.

27+00

+60 X Drain

18" X 40' P₃

R. 195
R. 205

✓

26+00

+93 X Drain

18" X 40' P₃

R. 205
L. 195

✓

25+00

✓ +234 Rdog 14

✓ 14'

15'

33245

✓ 14

Cul.

15'

✓ +365 End Bar 27.5

14

✓ +44 Beg Bar 26.5



8'

Cul

15

✓ +77 E.P.H.

✓ +71 Punip Horse 28

14

15'

✓ +66 Tr 21

✓ +65 C.P. 29

✓ +53 Tr 35

✓ +39 + M B 31

✓ +04 T.P. 44

Dale

Street.

✓ +71 TP 30'

14

Cul.

Cul.

15'

36+00

35+00

+78 & Direct

15' x 24' CM. ✓

34+00

33+00

32+00

31+00

✓ 14

✓ 15

Col

Col

✓ 15

✓ 15'

✓ +66 Deg Bulb 24"

✓ 14'

✓ 15'

✓ 14

✓ 15'

✓ +75% 2 Row Tr. 36'

•••••
•••••

✓ 14

✓ 15'

Col

Col

✓ 15

✓ 15'

+20 Drive Lt

15" x 24 CM /

42+00

41+00

40+00

39+00

38+00

37+00

✓ +85 Rom Treco 26'

✓ +08 Beg Culo 23'

✓ +66 Tr 21

✓ +63 Tr. 30'

✓ +98 Tr 21

✓ +24 XF, 30
+ Treco.

Cul

Cul

Cul

Cul

47+00

46+00

45+00

44+00

+14 to Farm Ent. Rt 15x24 CM. ✓

43+00

✓ 3L 15'

52. 15

15

✓ +71 Tc 30

✓ 441 T₁ 21

✓ 403E Row Tr 31

✓ 14

141

5214

+48 End Tr 30'v

 15^{-}

+85 Bag Cluster Tr 30

+ 76 Tr 291 ✓

+57 Tr 29' ✓

14

15-1

+82 Tr 30' W

+02 Beglich 23.

SL 15.

53+00

52+00

51+00

+63 R Drive Rt. 15x24 CM. ✓


50+00

+14 R Drive Lt 12x16" CM. ✓

49+00

48+00

3/16/28

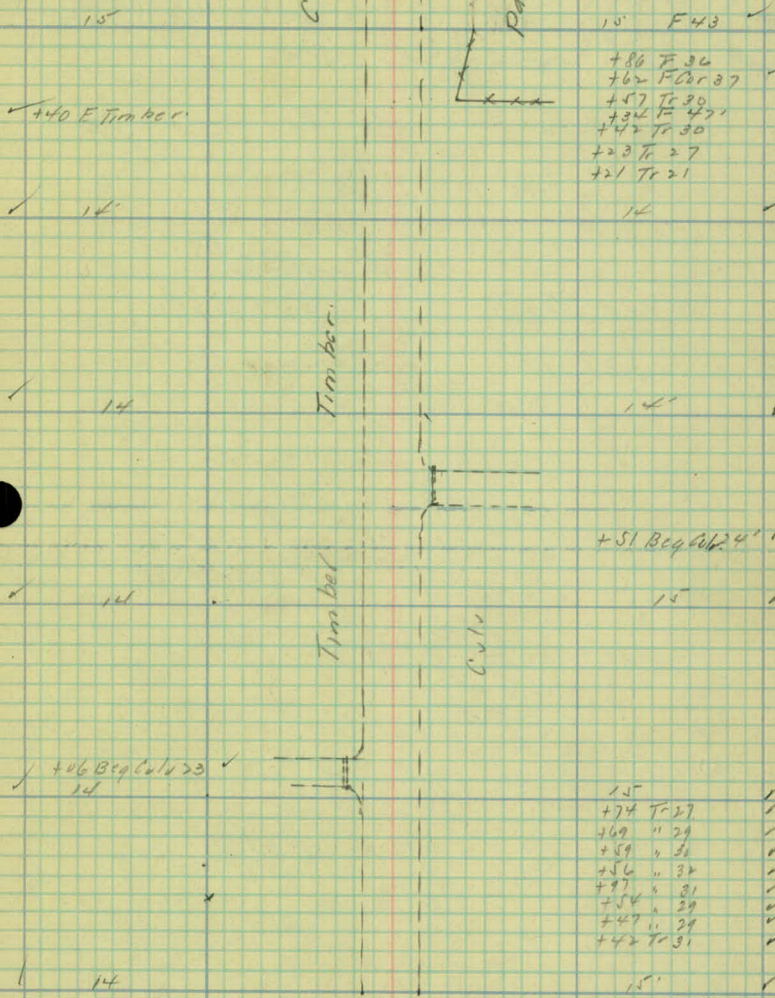

59+00

58+00

474 B Drive wt 15" x 24 cm. ✓

57+00

56+00

55+00

54+00

✓ SL 14

✓ + 22 TP 29'

✓ SL 15

✓ + 51 TP 29'
✓ + 62 TP 29'
✓ + 60 TP 30
✓ + 44 TP 30

15

+ 94 TP 30 ✓

+ 69 TP 29 ✓

+ 60 TP 29 ✓

+ 46 TP 28 ✓

✓ 14

✓ SL 14

0.1

0.1

Pasture

Pasture

+ 20 TP 30 ✓

✓ F 34 SL 14 ✓

+ 28 F 37 ✓

SL 14 F 36 ✓

+ 50 TP 28 ✓

+ 02 TP 28 ✓

15 F 30 ✓

+ 90 TP 28 ✓

+ 93 F 30 ✓

14 F 41 ✓

SL 14 F 41 ✓

+ 54 F 38 ✓

F 41 ✓

†37 x Drain

24" x 42 B

R21
L21



65+00

R21
L21

64+00

63+00

62+00


61+00

60+00

3/16/28

✓ +68 TP 28

✓ +54 FGR 31

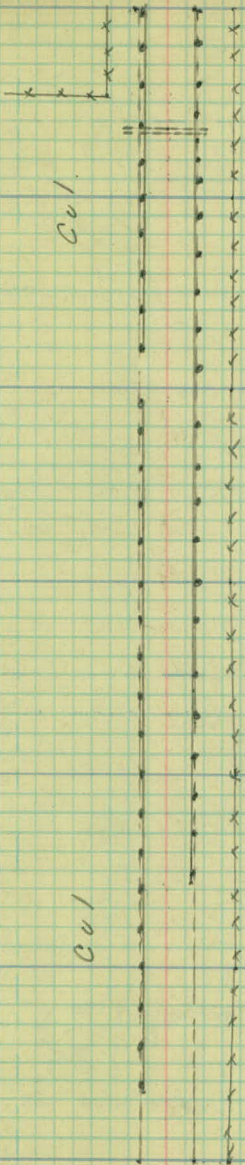

Pasture

GRB F 34 ✓

✓ +30 TP 28

✓ +20 BGR 134

✓

✓ +94 FGR 13

14 F 34 ✓

✓ 14

14 F 35 ✓

✓ +93 T.P. 28

✓ GR 135 14

14 F 37 ✓

✓ +56 TP 28

+50 F 33 ✓

+44 BGR 139 ✓

F 36 F 36 ✓

✓ 15

14 F 39 ✓

Pasture

✓ +33 BGR 135

+62 F 33 ✓

✓ +22 TP 29

✓

15 F 34 ✓

71+00

70+00

69+00

+50 @ Drive 17" 15X24CM.

68+00

67+00

66+00

✓ +48 Beg GR 13

✓ +32 T.P. 28'

✓ +07 E F Cor 30

✓ F 30

✓ +50 T.P. 32'

✓ F 46'

✓ +90 T.P. 28

✓ F 46' 14"

✓ +50 T.P. 39'

✓ +26 E GR 13'

✓ F 31

✓ +08 T.P. 28'

GR 13' 15"

✓ F 29' GR 13'

Cul.

Scattered Trees.

Produce

Cul.

F 36

+39 X F 36'

F 38

+65 T.P. 28'

N F 36.

+38 Beg Cul 23'

+05 T.P. 30'

F 33

+92' E GR 13'

14 GR 13'

GR 13 F 33

27+00

26+00

25+00

24+00

23+00

+98 X Drain 24X48 P3

R 23
L 25.

22+00

✓ +74 TP 28'

15'

✓ +81 EGR 13'

✓ +96 TP 28'

15'

+06 TP 28'

✓ +78 Tr 31

✓ +45 Tr 30

✓ +70 TP 28'

+13 X Rdog 13'

+02 EGR 13'

15'

15'

Cul

Cul

+18 Bcy GR 13'

+07 EF Cor 34'



79400


78400

Rice Street

+49.5 E Pav.

+44 P.P.L. 35

+11 TP 29'

 

Party

Wibhusen
A.B.
D.S.
A.M.

Alignment
County Road B₂ #66
From Edgerton to Arcade St.

ROAD MAP

Office of Ramsey Co. Engineer
ST. PAUL, MINN.

Date Filed 1-10-27
16

File No.

Received 1-6-27
J. A. [Signature]

Fair - Cold

Jan-5-27


{ Wilshusen
Skoglund
Berthigum
Messenburg

26+43⁷⁰ P.O.T.

24+00 P.O.T.


0+00

Co. Road B² from Edgerton to Arcade St.

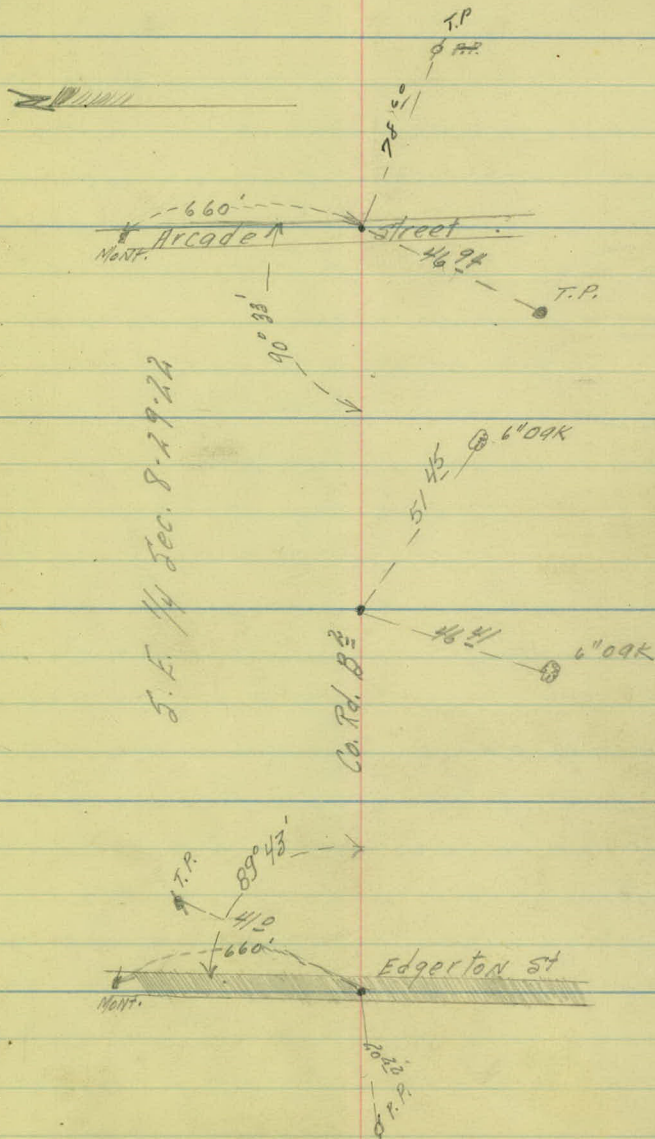

S.E. 1/4 Sec. 8-29-22

S.E. 1/4 Sec. 8-29-22

 

1-6-27
Party.
W. Shusen
P.B.
P.S.
H.M.

Topography

Co. Road B?

From Edgerton St. to Arcade St.

Sta. 0+00 to 26+43 70

5+00

4+00

3+00

2+00

1+00

0+00

1-6-27

✓ +41 T.P. 27'

✓ Rd. 9 - Timber 31'

Rd = 11'

✓ +58.5 Rd 31 90.9'
✓ +80 T.P. 28'

Woods

✓ +41 T.P. 28'

✓ +30 B. Woods 30

✓ +47 B. Woods 24'

✓ T.P. 29'

✓ +15 T.P. 45'

~~T.P. 44'~~

Cultivated

20' Pavement

Cultivated

Rd. 10'


Rd. 10'

+15 T.P. 45'

20' Pav.

20' Pav.

Edgerton St.

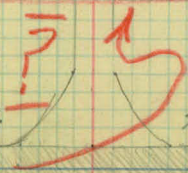

11+00

10+00

9+00

✓ Garage 14' wide = 16' deep

8+00

7+00

495 ft drive 10' wide ✓

6+00

Hoodo
R

✓ +86-T.P. 24

Swamp

✓ Rd. 9' FL 33

✓ +62 F-X 109 85
+53-T.P. 25

Yard

✓ +95 Cor. garage 30
✓ +63 E. of Woods 533
✓ +62 E. Cor. 33
✓ +61 E. of Colv. 17 20' x 12' 54' 2'

Woods

✓ +85 E. Colv. 17 20' x 12' C.M.
✓ +68-T.P. 76

Woods

Hay Meadow

42' x 18" C.M.
+31 Int. Colv.
21-45-21 17
Rd. 11

Meadow

✓ +60 E. Woods 33
✓ +59 E. of Colv. 20
✓ 18' x 15' C.M.

Woods

17+00


16+00

15+00

14+00

13+00

12+00

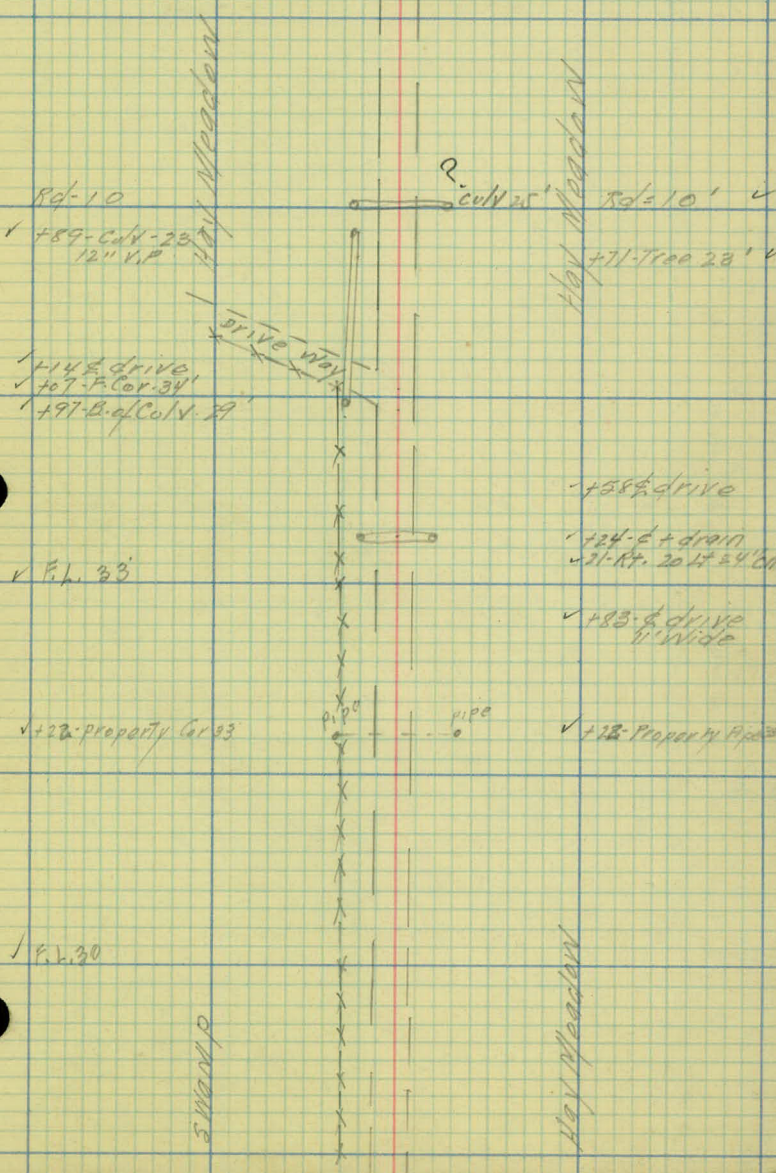

23+00

22+00

21+00

20+00

19+00

18+00

1-6-27

Cultivated

Cultivated

Rd 10'

- ✓ +76 Tree 33'
- ✓ +69 E. of C.V. 13
- ✓ 40' x 18" CM
- ✓ +40 E. of Hay Meadow
- ✓ +29 E. of C.V. 16
- ✓ +15 Rd. 15'

Hay Meadow

Woods

Woods

Hay Meadow

✓ F.L. 35'

✓ F.L. 40'

✓ F.L. 38'

✓ Rd-10' F.L. 35'

✓ +75 F. Cor. 42' E. of Hay Meadow

27+00

26+00

25+00

24+00

gravel Arcade street.

58.5' Steeper
Grade 80'

✓ +15' E. of Wood's 38'
✓ Rd. = 15'

+18' P.P. 40'
✓ +18' F.C. 40'
Rd = 10

Noods

✓ 45' E. of Cult. 35'

F.L. 50'

Cultivated

F.L. 35

Noods

