

OFFICE OF COUNTY ENGINEER
RAMSEY CO. MINN.

Road Map Survey

LAKE ST.

From *Larpenteur Ave.* To *Frost Ave.*

Road Acc't. No. *81*

Date Filed *3-27-28*

File

3-27-28

C.W.S.
A. Mc.
A. B.
W.A.

Lake Street.

From Warp. Ave

to

Frost Ave

Rd 9018'

Road Map

3-27-28

O. J. Van

Sta Point Alt Az

19+65⁴⁵



18+93⁴⁰

Track.

8+43⁹⁵ P.O.T.

0+00 Meet

3/13/28

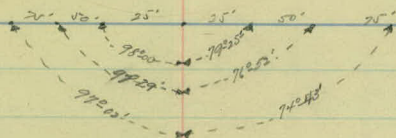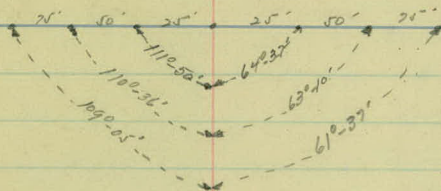

8" Oak

48 26

pick

6" Oak

39 21

90° 04'

PP

0

34 38

Mont

5 N

PP

53 20
PP

26+38⁷⁰

Mount

21+18³⁰

Track.




20+13²⁰


Track.

Frost Ave

Plate in Pav.

P.O.T.

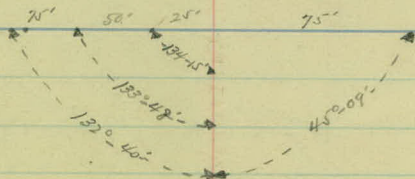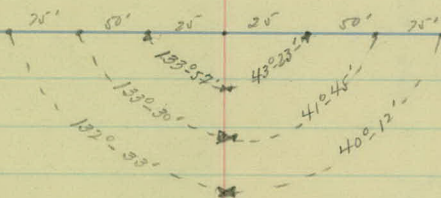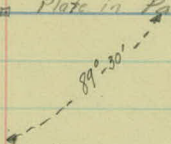

 

3/13/28

C.V.D.
A.M.C.
A.B.
W.A.

Topography
Lake Street

From Carpenter Ave
To
Fr Frost Ave

5+00

+28 & Drive Lt

4+00

3+00

2+00

+30 & Drive Lt

1+00

+81 & Side Walk Lt. 3. Drain 12" x 4.5' CM.

0+00

81 PP 25'

SL 15'

SL 14'

+96 PP 25'

SL 14'

+70 EF 32'
+69 PP 25'

SL 14' F32'

+39 MB 19'
+39 PP 25'
+37 Bg F 31'

+21 Tr 35'

SL 18'

+97 F 35'
+76 Tr 35'
+32 XF 31'

+25 PP 24'

Larp Ave.

Pasture

Cul.

Yard

Cultivated.

Cultivated

SL 8'

+20 MB 10'

SL 5'

SL 5'

SL 6'

SL 7'

+25 Rd 35'

11+00

+35 Drive Rt.

10+00

+64 Drive Rt.

+30 Drive Rt.

9+00

+60 Drive Lt.

8+00

7+00

+71 Drive Rt.

6+00

+ 94 MB 22
+ 93 Tr 26
+ 70 F Cor 28'
+ 66 TP 26'
+ 50 Tr 26'
+ 38 F Cor 27'

SL 4'

SL 13'

+ 74 PP 25'

+ 65 Tr 32'

+ 18 Tr 31

SL 7

+ 77 Tr 25'

+ 70 Tr 25'

+ 63 Tr 32'

+ 52 Tr 30

+ 34 PP 25'

+ 33 Tr 32'

+ 26 Tr 31

SL 10'

+ 81 Tr 31'

+ 33 Tr 28'

+ 23 Tr 30

+ 18 Tr 31

+ 01 PP 25'

SL 14

+ 97 Tr 32'

+ 46 Tr 30

+ 34 Tr 31'

07 Tr 31'

SL 15

+ 69 Tr 32

67 PP 25'

+ 55 Tr 29

+ 23 Tr 29

SL 16

Cultivated

Pasture

XXXXX
XXXXX

Yard

+ 77 Tr 32'

+ 12 MB 20

+ 11 Tr 26

SL 13'

+ 81 Tr 29'

+ 74 MB 19'

+ 58 Tr 30

+ 41 Tr 29'

+ 21 Tr 20'

+ 95 Tr 25'

SL 10'

+ 15 Tr 17'

SL 5'

SL 8

+ 87 MB 7'

SL 3

97 E Drive Lt

12" X 14 QID DM

17+00

+ 36 E Road Lt.

16+00

15+00

14+00

+ 28 E Ripley Ave

13+00

12+00

+91 Beg 3D 16'

S.L. 11' F347

+76 Beg FCor 34'

+17+15 FCor 34'

S.L. 101

S.L. 11'

+84 FCor 34'

+82 PP 26'

+27 Tr 27'

S.L. 10

+57 PP 25'

+95 TP 24'

+13 P.P 25'

S.L. 6

Waste Land

+44 TP 26

S.L. 11'

+69 FCor 26'

S.L. 10 281

+98 TP 25

S.L. 10 F 28'

+84 TP 25'

+24 Tr 26'

S.L. 10' F 28

+61 TP 25'

+50 Beg F 28'

Pipley Ave.

+86 FCor 26'

+87 26

+61 Tr 26'

S.L. 13

Cultivated

Cul.

Cul.

23+00

22+00

+18³⁰ & Tracks

21+00

13³⁰ & Tracks

+00 & Drive Lt.

20+00

+65⁴⁵ & Tracks

19+00

+93⁴ & Track

+66 & Drive Lt

18+00

F342 SL 12'

SL 9'

L342 SL 11

SL 10'

F342 SL 8

SL 8'

+25' Tr 27'

SL 8' F342

SL 8'

F342 SL 11'

SL 11'

F342 SL 10'

SL 11'

Plant

Guthrie

Waste Land

+70 N B 11'

+58 TP 26

+1/6 X Drain 15 X 40 CM.

236
#7 Rt

26+00

25+00

24+00

+28 Edge Pav.
+28 PP 27'
+26 EFC 13'

Frost Ave

F. 33' SL. 14'

SL. 6'

F. 33' SL. 14'

SL. 6'

F. 33' SL. 13'

SL. 7'

Grass Plant

Waste land

