

Book 24, Dr. 11

X

OFFICE OF COUNTY ENGINEER
SEY CO. MINN.

Plan Survey

COUNTY ROAD "C2"

From Lexington to Victoria

Road Acc't. No.

Date Filed 1-6-36


File 11

Alignment
Twp. Rd C²
Lex to Vict.

5+31.75 POT


2+49.24 POT

0+00 POT Lexington Ave Beg. Prop. C²

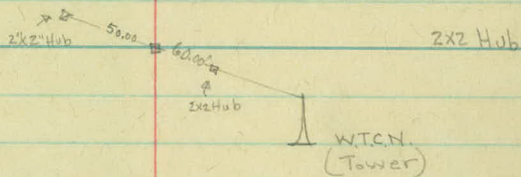

91°08'30" A

Mont
W 1/4 Cor Sec 2
& Lex. Produced



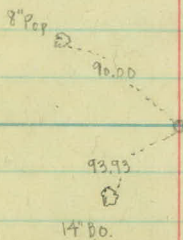



RR SpK

28+77.00 P.O.T.

26+51.00 P.O.T. & Victoria - End Prop. C²

11+97.63 P.O.T.

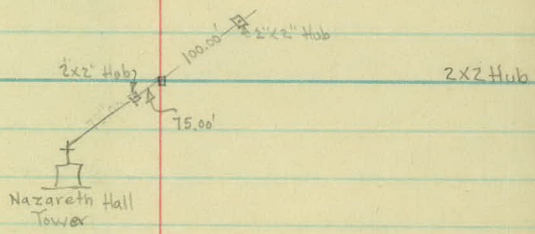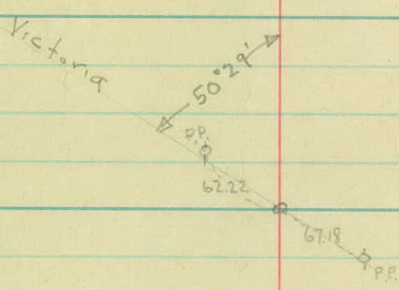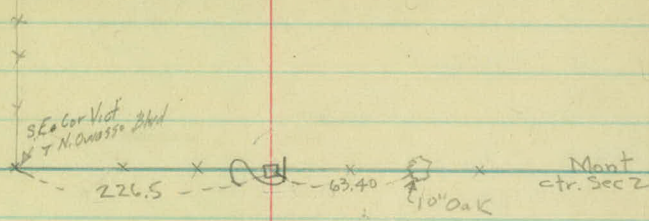

 


11/20/35

Trasit Location

Victoria St.

C²

 

Victoria St.
22' Gravel Top

P.I. Δ $40^{\circ}46'$
E 12.0'

N. Owassee Blvd
24' Bit Top

P.I. Δ $50^{\circ}20'$
E 17.85

$\Delta 50^{\circ}20'$

328.10

$\Delta 50^{\circ}29'$

226.00

Mont
ctr Sec 2

2401.75

$\Delta \frac{1}{4}$ Line


Mont
West $\frac{1}{4}$ Cor.
Sec 2

436.17

$\Delta 18^{\circ}01'$

P.I. Δ $18^{\circ}01'$
E 09.95
T 165'


Victoria
20' Black Top

 

11/20/35

Transit Location

Lex. Ave + C²

 

Pl. $\Delta 16^{\circ}32'$
E 6.00

$16^{\circ}32'$
Lex 27 Pav

100
C

0+00 Twp. Rd 2
(Civ. Rd)

110.24924

Mont. W 1/4
Cor Sec 2

2627.75

Mont. Gr. Sec 2

148.12
A 108.12
x 20


$91^{\circ}08'30''$

300.60

160
C

Pl. $\Delta 39^{\circ}14'$
E 22.00

W Lane Sec 27
(Lex. 27 Pav)

 

TOPOG
C²
LEX TO VICTORIA

4

3

2

1

0 + 00

$$\begin{array}{r} +95-12'' \text{ Tr} \\ \hline 0 \end{array}$$

$$\begin{array}{r} +74-3-15'' \text{ Tr} \\ \hline 2 \end{array}$$

$$\begin{array}{r} +50 \text{ Sh. old Fill} \\ \hline 40 \end{array}$$

$$\begin{array}{r} +11 \text{ Sh. old Fill} \\ \hline 0-27 \end{array}$$

$$\begin{array}{r} \text{Sh. old Fill} \\ \hline 6-15 \end{array}$$

$$\begin{array}{r} 3-8'' \text{ Tr} \\ \hline 17 \end{array}$$

$$\begin{array}{r} +65-3-12'' \text{ Tr} \\ \hline 3 \end{array}$$

$$\begin{array}{r} +76-6-8'' \text{ Tr} \\ \hline 0 \end{array}$$

$$\begin{array}{r} +40-3-12'' \text{ W. Tr} +33 \text{ Sh. old Fill} \\ \hline 25 \end{array}$$

$$\begin{array}{r} +02-18'' \text{ Tr} \\ \hline 0 \end{array}$$

$$\begin{array}{r} \text{Sh. old Fill} \\ \hline 26-4 \end{array}$$

$$\begin{array}{r} +84 \text{ Steps} \\ \hline 5 \end{array}$$

$$\begin{array}{r} +35 \text{ Tr. Sh. old Fill} \\ \hline 7 \end{array}$$

$$11-36$$

$$\begin{array}{r} +53 \text{ End Culu} \\ \hline 28 \end{array}$$

$$\begin{array}{r} \text{Ed Pav} \\ \hline 43-34 \end{array}$$

$$\begin{array}{r} +19 \text{ Ed Pav} \\ \hline 0 \end{array}$$



$$\begin{array}{r} +10 \text{ End Culu} \\ \hline 61 \end{array}$$

$$\begin{array}{r} \text{Ed Pav} \\ \hline 31 \end{array}$$

$$\begin{array}{r} \text{Ed Pav} \\ \hline 36 \end{array}$$

$$\begin{array}{r} -24 \text{ Ed Pav} \\ \hline 0 \end{array}$$

$$\begin{array}{r} 11-89-45 \text{ Rec. Tr} \\ \hline 0 \end{array}$$

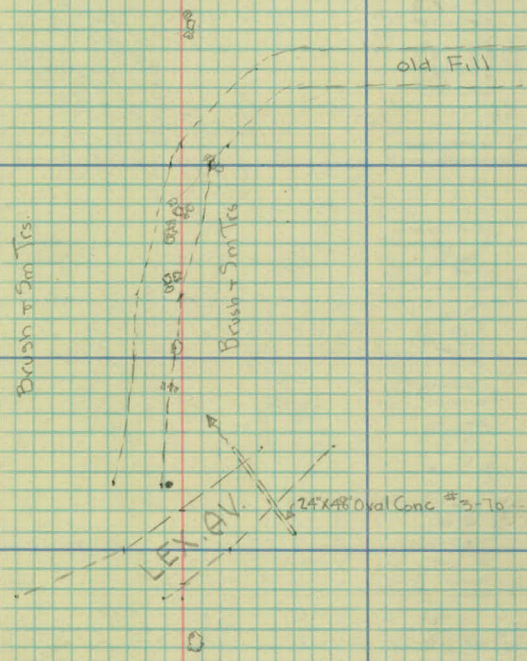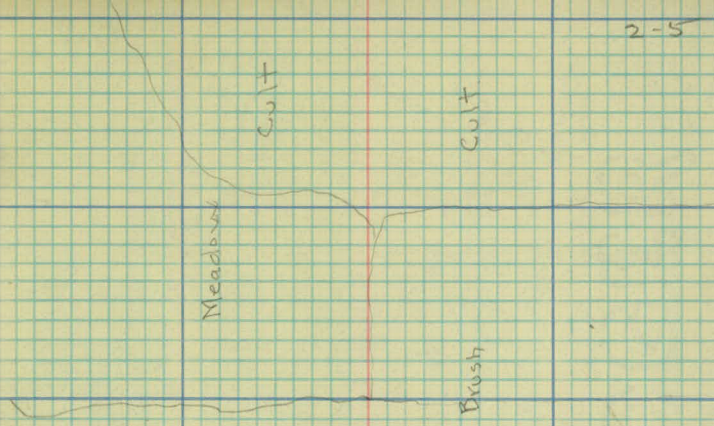

11

+ 01 Hoose
178

10

+ 3b Shoulder
4

9

+ 1h Sn.
4

8

7

6

5

3-5

20' Ho
20'

Cult

Cult

12' OIL TOP (OXFORD ST)

Cult

Cult.

Trail
13-22

18

17

Trail
13-20

16

15

Trail
4-12

14

+30 Trail

+60 Trail
6-15

+30 Wagon Trail

13

12

4-5

1821

Ed Pav
53-83

+50 Ed Rd
98-132

+26 Beg Brush
63-110
Trail
45-61

25

+50 Trail
10-19

24

Trail
7-15

23

Trail
9-16

22

21


Trail
8-18

20

19

5-5

o w a
o Brush
o o o o

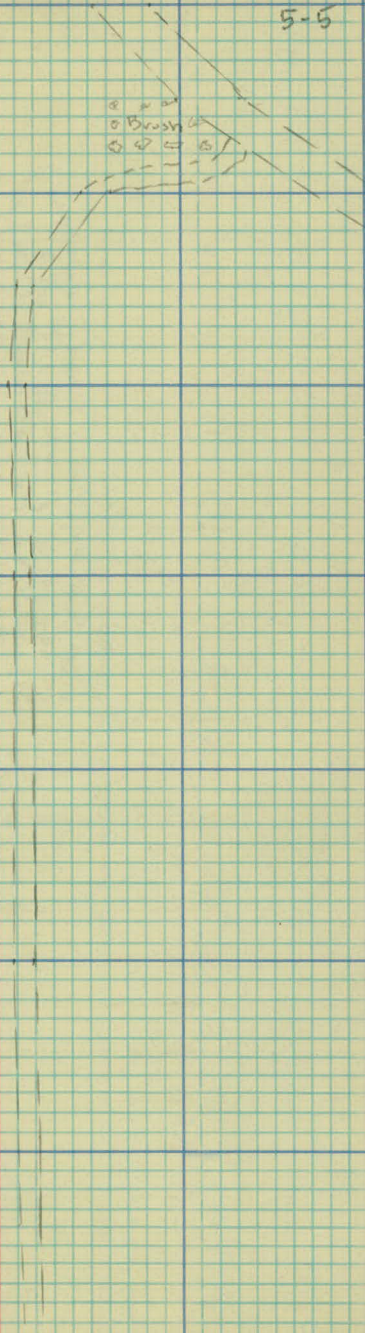

27

Ed. Pav
80 - 44

P.P.
35

+85 T.P.
71

+64 Ed. Pav
0

+51 Ed. Pav
0

+38 Ed. Pav
0


+65 Rd Sm
11

+23 P.P.
62

+10 T.P.
23

26

VICTORIA

 

11/14/35

Levels

Proposed Hwy. Co. Rd. C²

Lexington to Victoria

Sta	+	π	-	
B.M.	142	911.75		910.33
○	210	903.51	10.34	901.41
B.M.	11.76	912.77	250	901.01
○	9.71	920.03	2.45	910.32
○	13.36	932.80	0.59	919.44
○	13.24	944.89	1.15	931.65
○	654	950.67	0.76	944.13
B.M.			0.29	950.38
○	0.77	938.50	12.94	937.73
○	0.61	925.78	13.33	925.17
○	0.58	913.45	12.91	912.87
○	0.72	901.99	12.18	901.27

Spk. in 18" Oak W. Side School Yard @ Victoria + Co Rd "C"

Placed SpK in 12" W. Oak 20' W. of Victoria 275' S. of C²

Top Stake Sta 23+00

Top Stake Sta 13+00

Top Door Sill (W. Edge) House 200' Rt. Sta 11+00


Top Stake Sta 4+50

Sta	+	x	-	
		901.99		
B.M.			10.73	891.26
⊙	4.79	894.37	12.41	889.58
B.M.			3.84	890.53

Top Rock 10' R+ Sta 2+25

Top Stake Sta 2+00

SpK in 24' Oak 50' W. Sta 0+00

 

X-Sections
Twp. Rd C²
Lex. to Victoria

Sta	+	Σ	-	
B.M.	3.84	894.37		890.53
0+00				89.12
+23				88.1
+29				85.6
+50				84.5
1+00				84.6
+28				86.6
+50				86.7
2				88.8

SpK in 24" B. Oak 50' w/ Sta 0+00

[illegible]

7.9 9.0 9.3 9.2 7.2 7.7 6.4 6.8 8.3 8.4
 9.2 8.7 7.0 5.2 4.0 3.5 1.6 1.1 7 4 63
 7.5 9.2
 98 110

E.R. E E.R.
 5.91 5.24 4.95 5.2 8.5 8.2 6.9
 5 26 46 56 69 88 92-100
 (Oval)
 #3-70 F.L. 24" long W. End. 8.98
 " " " E. 9.86
 48' long

8.8

										FF.	E.	ER.					
98	128	98	100	75	79	80	68	76	99	90	61	579	502	476	49	76	80
120	90	62	38	33	30	17	11	3		21	27	33	53	73	74	86	100

7.6	7.2	10.2	7.8	8.0	7.5	9.8	10.2	10.0	9.5	4.8	4.11
100	92	60	32	27	19	6	28	47	71	93	100

7.8

$$\frac{82}{100} \quad \frac{10.2}{42} \quad \frac{10.4}{27} \quad \frac{7.1}{18} \quad \frac{80}{7} \quad 7.7 \quad \frac{10.3}{7} \quad \frac{10.6}{100}$$

$\frac{9.5}{100}$ $\frac{10.4}{14}$ $\frac{6.0}{6}$ 5.6 $\frac{5.3}{14}$ $\frac{9.9}{28}$ $\frac{10.3}{100}$

Sta

+

x

-

894.37

2 + 12

88.7

+25

84.6

+50

84.4

B.M.

11.22

896.39

9.20

885.17

+71

84.6

3

84.9

+70

87.6

4

90.9

0

12.32

908.12

0.59

895.80

3-10
908.12
901.27
6.85

5.7

$$\frac{10.6}{100} \quad \frac{10.4}{48} \quad \frac{10.2}{5} \quad 9.8 \quad \frac{5.5}{8.33} \quad \frac{10.0}{46} \quad \frac{10.4}{100}$$

$$\frac{11.0}{100} \quad \frac{10.6}{49} \quad \frac{10.3}{27} \quad 10.0 \quad \frac{9.8}{20} \quad \frac{5.0}{42} \quad \frac{2.7}{100}$$

Top Mont. W 1/4 Cor Sec. 2. 11/14/35

$$\frac{13.0}{100} \quad \frac{12.5}{31} \quad 11.8 \quad \frac{10.4}{36} \quad \frac{8.7}{100}$$

$$\frac{12.8}{100} \quad \frac{12.4}{37} \quad 11.5 \quad \frac{10.2}{32} \quad \frac{7.9}{100}$$

$$\frac{12.5}{100} \quad \frac{11.3}{27} \quad 8.8 \quad \frac{8.1}{14} \quad \frac{5.9}{45} \quad \frac{0.9}{100}$$

$$\frac{12.1}{100} \quad \frac{10.7}{37} \quad \frac{5.6}{5} \quad 5.5 \quad \frac{4.9}{10} \quad \frac{0.3}{48} \quad \frac{+5.6}{100}$$

Sta	+	π	-	
		908.12		
4+50				01.2
①	12.19	919.91	0.40	907.72
5				13.4
①	9.26	928.46	0.71	919.20
+32				19.1
6				21.1
+30				20.6
7				24.1
+70		Place 24" Culvert		20.5

$$\begin{array}{r} 22.5 \quad 20.7 \quad 13.7 \quad 9.3 \quad 7.2 \quad 6.9 \quad 4.3 \quad 1.7 \quad 0.0 \quad +6.1 \\ 100-92 \quad 80 \quad 43 \quad 19 \quad 4 \quad 19 \quad 41 \quad 50 \quad 100 \end{array}$$

Top Stake Sta 4+75

$$\begin{array}{r} 55. \quad 25.2 \quad 22.5 \quad 13.4 \quad 9.9 \quad 7.7 \quad 6.5 \quad 1.1 \quad +4.4 \quad +4.9 \\ 150 \quad 100 \quad 84 \quad 34 \quad 21 \quad 7 \quad 41 \quad 85 \quad 100 \end{array}$$

$$\begin{array}{r} 55. \quad 24.0 \quad 21.6 \quad 13.0 \quad 9.6 \quad 9.4 \quad 2.0 \quad 1.3 \\ 225 \quad 120 \quad 46 \quad 17 \quad 3 \quad 71 \quad 100 \end{array}$$

$$\begin{array}{r} 22.0 \quad 23.0 \quad 21.8 \quad 13.0 \quad 7.4 \quad 3.0 \quad 3.2 \\ 140 \quad 100 \quad 90 \quad 32 \quad 68 \quad 100 \end{array}$$

$$\begin{array}{r} 23.0 \quad 21.2 \quad 10.8 \quad 7.7 \quad 5.0 \quad 5.5 \quad 5.7 \\ 150 \quad 100 \quad 35 \quad 64 \quad 100 \quad 130 \end{array}$$

$$\begin{array}{r} 55. \quad 17.9 \quad 12.1 \quad 6.1 \quad 4.4 \quad 4.8 \quad 7.0 \quad 7.0 \quad 6.5 \\ 150 \quad 100 \quad 78 \quad 36 \quad 22 \quad 68 \quad 100 \quad 150 \end{array}$$

$$\begin{array}{r} 19.8 \quad 13.7 \quad 9.1 \quad 8.0 \quad 7.4 \quad 6.6 \\ 100 \quad 59 \quad 8 \quad 61 \quad 100 \end{array}$$

Sta

+

x

-

928.46

8

20.7

9

26.2

⑩

13.38

940.16

1.68

926.78

+11

Shoulder Rt

27.2

+20

E Oxford St Rt

27.6

+33

Shoulder

27.7

+38

27.6

10

28.7

+35

31.1

$$\frac{19.8}{100} \quad \frac{12.4}{43} \quad 7.8 \quad \frac{5.7}{56} \quad \frac{2.8}{100}$$

$$\frac{15.6}{100} \quad \frac{12.2}{85} \quad \frac{8.0}{61} \quad \frac{4.6}{33} \quad 2.3 \quad \frac{1.6}{58} \quad + \frac{1.0}{100}$$

Top Iron Sta 9+06

$$\frac{24.2}{100} \quad \frac{21.0}{80} \quad \frac{15.0}{25} \quad 13.0 \quad \frac{9.7}{61} \quad \frac{7.0}{100}$$

$$\frac{27.0}{100} \quad \frac{22.0}{80} \quad \frac{15.5}{24} \quad 12.6 \quad \frac{12.6}{4} \quad \frac{8.5}{70} \quad \frac{7.4}{100}$$

$$\frac{27.5}{100} \quad \frac{23.0}{83} \quad \frac{19.6}{61} \quad \frac{15.7}{28} \quad 12.5 \quad \frac{12.5}{3} \quad \frac{4.9}{24} \quad \frac{9.0}{70} \quad \frac{6.7}{100}$$

$$\frac{25.5}{100} \quad \frac{19.3}{61} \quad \frac{16.0}{32} \quad 12.6 \quad \frac{11.0}{46} \quad \frac{8.8}{86} \quad \frac{7.7}{100}$$

$$\frac{25.0}{100} \quad \frac{19.7}{61} \quad \frac{15.0}{28} \quad 11.5 \quad \frac{10.6}{12} \quad \frac{3.1}{58} \quad \frac{0.0}{100}$$

$$\frac{24.0}{100} \quad \frac{22.3}{86} \quad \frac{18.3}{54} \quad 9.1 \quad \frac{8.0}{10} \quad \frac{1.0}{53} \quad \frac{0.0}{67} \quad + \frac{0.5}{100}$$

Sta

+

K

—

940.16

11

358.

①

6.59

944.21

254

937.62

+50

37.1

12

37.6

+40

36.0

13

31.2

①

0.04

931.64

1257

931.64

931.65

+50

27.3

14

25.7

6-10 936.5
12.56

$$\begin{array}{r} 15.3 \quad 7.4 \quad 7.5 \quad 4.4 \quad 3.4 \quad 0.0 \quad + 1.8 \\ \hline 100 \quad 57 \quad 25 \quad 12 \quad 52 \quad 100 \end{array}$$

Top Stake Sta 11+97.63

$$\begin{array}{r} 17.4 \quad 12.1 \quad 4.7 \quad 8.2 \quad 7.1 \quad 6.2 \quad 2.5 \quad 0.6 \quad + 3.3 \\ \hline 100 \quad 63 \quad 46 \quad 20 \quad 15 \quad 55 \quad 72 \quad 100 \end{array}$$

$$\begin{array}{r} 16.7 \quad 9.6 \quad 7.2 \quad 6.6 \quad 6.4 \quad 2.8 \quad 0.0 \quad + 2.6 \\ \hline 100 \quad 63 \quad 38 \quad 13 \quad 51 \quad 82 \quad 100 \end{array}$$

$$\begin{array}{r} 16.1 \quad 10.9 \quad 8.8 \quad 8.2 \quad 8.8 \quad 5.3 \\ \hline 100 \quad 65 \quad 39 \quad 8-12 \quad 100 \end{array}$$

$$\begin{array}{r} 17.7 \quad 14.8 \quad 13.4 \quad 13.0 \quad 13.0 \quad 14.0 \quad 12.8 \quad 9.8 \quad 9.0 \\ \hline 100 \quad 65 \quad 33 \quad 3 \quad 6 \quad 16 \quad 53 \quad 100 \end{array}$$

Top Stake Sta 13+00

$$\begin{array}{r} 9.4 \quad 6.2 \quad 4.9 \quad 5.0 \quad 4.4 \quad 3.1 \quad 2.9 \quad 0.5 \quad + 3.8 \\ \hline 100 \quad 64 \quad 35 \quad 12 \quad 3 \quad 44 \quad 57 \quad 100 \end{array}$$

$$\begin{array}{r} 17.3 \quad 14.5 \quad 11.0 \quad 6.0 \quad 4.7 \quad 4.2 \quad + 4.6 \quad + 6.9 \\ \hline 100 \quad 62 \quad 27 \quad 5 \quad 20 \quad 80 \quad 100 \end{array}$$

St

931.69

14+47

24.1

+65

24.5

15

24.5

0

4.02

928.31

7.40

924.29

+65

22.9

16

18.5

0

5.05

924.01

9.35

918.96

17

13.6

18

13.8

$$\frac{19.5}{100} \quad \frac{17.5}{65} \quad \frac{13.2}{29} \quad \frac{9.2}{10} \quad 7.6 \quad \frac{6.0}{4} \quad \frac{1.3}{53} \quad + \frac{4.0}{100}$$

$$\frac{19.8}{100} \quad \frac{17.5}{58} \quad \frac{7.6}{4} \quad 7.2 \quad \frac{7.0}{2} \quad \frac{5.3}{4} \quad \frac{4.6}{15} \quad \frac{1.1}{51} \quad + \frac{4.0}{100}$$

$$\frac{22.8}{100} \quad \frac{16.3}{42} \quad \frac{8.2}{6} \quad 7.2 \quad \frac{7.1}{2} \quad \frac{5.4}{4} \quad \frac{5.1}{12} \quad \frac{0.0}{48} \quad + \frac{6.5}{100}$$

Top Iron Sta. 15+63

$$\frac{22.0}{100} \quad \frac{8.3}{18} \quad \frac{7.3}{2} \quad 5.4 \quad \frac{4.1}{3} \quad \frac{3.3}{15} \quad \frac{0.0}{34} \quad + \frac{6.8}{75} \quad + \frac{8.0}{100}$$

$$\frac{22.1}{100} \quad \frac{13.0}{28} \quad \frac{10.0}{6} \quad 9.8 \quad \frac{7.0}{3} \quad \frac{6.6}{9} \quad \frac{6.5}{18} \quad + \frac{5.7}{90} \quad + \frac{7.0}{100}$$

$$\frac{21.5}{100} \quad \frac{21.0}{89} \quad \frac{20.7}{84} \quad 10.4 \quad \frac{10.3}{1} \quad \frac{8.2}{6} \quad \frac{6.4}{9} \quad \frac{5.4}{13} \quad \frac{3.9}{41} \quad \frac{1.1}{86} \quad + \frac{4.8}{115}$$

$$\frac{20.8}{100} \quad \frac{18.6}{76} \quad \frac{16.8}{68} \quad \frac{10.6}{5} \quad 10.2 \quad \frac{7.3}{4} \quad \frac{6.0}{13} \quad \frac{3.0}{53} \quad \frac{0.0}{74} \quad + \frac{5.5}{100}$$

Sta

+

x

-

924.01

18+20

13.8

19

12.5

+45

12.1

20

12.0

21

13.1

22

12.2

+60

11.5

0

0.60

913.57

11.04

912.97

✓

325

910.32

910.32

S.S. = Same Slope

$$\frac{3.5}{100} \quad \frac{18.3}{50} \quad \frac{11.8}{43} \quad \frac{10.3}{3} \quad 10.2 \quad \frac{9.6}{3} \quad \frac{7.2}{7} \quad \frac{5.9}{12} \quad \frac{5.0}{25} \quad \frac{2.5}{66} \quad \frac{5.5}{100}$$

$$\frac{11.2}{100} \quad \frac{11.0}{89} \quad \frac{13.8}{38} \quad \frac{12.0}{9} \quad 11.5 \quad \frac{11.3}{4} \quad \frac{9.6}{9} \quad \frac{8.8}{21} \quad \frac{8.0}{82} \quad \frac{+2.5}{100}$$

$$\frac{9.5}{100} \quad \frac{9.2}{85} \quad \frac{12.8}{38} \quad 11.9 \quad \frac{11.3}{6} \quad \frac{11.0}{15} \quad \frac{10.0}{29} \quad \frac{7.2}{70} \quad \frac{3.8}{100}$$

$$100 - \frac{9.5}{87} \quad \frac{11.0}{40} \quad \frac{12.0}{13} \quad 12.0 \quad \frac{11.4}{9} \quad \frac{11.3}{16} \quad \frac{10.6}{20} \quad \frac{9.0}{73} \quad \frac{5.7}{100}$$

$$\frac{10.6}{100} \quad \frac{9.9}{88} \quad \frac{10.2}{69} \quad \frac{10.3}{12} \quad 10.9 \quad \frac{10.6}{7} \quad \frac{10.1}{8-18} \quad \frac{8.6}{100}$$

$$\frac{12.9}{100} \quad \frac{12.0}{83} \quad \frac{11.7}{7} \quad 11.8 \quad \frac{10.9}{10} \quad \frac{10.4}{18-33} \quad \frac{10.7}{100}$$

$$\frac{12.0}{100} \quad \frac{11.8}{85} \quad \frac{13.2}{58} \quad \frac{12.2}{13} \quad 12.5 \quad \frac{11.8}{9} \quad \frac{11.9}{19} \quad \frac{13.0}{34} \quad \frac{15.1}{59} \quad \frac{15.4}{100}$$

Top Stake Sta 22+00

Top Stake Sta 23+00

Sta

+

π

-

913.57

23

09.8°

+75

07.2°

24

07.0°

+40

07.8°

25

07.7°

26

10.9°

+25

10.4°

+33

07.2°

$$\frac{2.4}{100} \quad \frac{2.3}{83} \quad \frac{3.8}{63} \quad \frac{3.1}{37} \quad \frac{3.3}{5} \quad 3.8 \quad \frac{3.7}{8-15} \quad \frac{6.3}{61} \quad \frac{6.4}{100}$$

$$\frac{4.0}{100} \quad \frac{3.6}{88} \quad \frac{4.5}{74} \quad \frac{5.9}{34} \quad 6.4 \quad \frac{6.3}{5} \quad \frac{6.7}{14} \quad \frac{8.4}{61} \quad \frac{6.0}{100}$$

$$\frac{3.2}{100} \quad \frac{3.0}{89} \quad \frac{4.1}{74} \quad \frac{6.3}{18} \quad 6.6 \quad \frac{6.5}{6} \quad \frac{6.7}{15} \quad \frac{7.8}{42-56} \quad \frac{7.3}{75} \quad \frac{6.8}{100}$$

$$\frac{3.3}{100} \quad \frac{2.8}{86} \quad \frac{3.7}{73} \quad \frac{5.0}{24} \quad 5.8 \quad \frac{5.4}{7} \quad \frac{4.9}{12} \quad \frac{5.7}{20} \quad \frac{6.7}{36} \quad \frac{11.3}{66} \quad \frac{10.5}{88} \quad \frac{11.0}{100}$$

$$\frac{5.6}{100} \quad \frac{4.8}{32} \quad 5.9 \quad \frac{5.6}{9} \quad \frac{6.6}{16} \quad \frac{8.1}{47} \quad \frac{11.3}{100}$$

$$\frac{2.0}{100} \quad \frac{0.4}{81} \quad \frac{1.6}{31} \quad 2.7 \quad \frac{2.6}{7} \quad \frac{2.0}{12} \quad \frac{1.7}{31} \quad \frac{7.5}{42} \quad \frac{8.2}{51} \quad \frac{8.34}{69} \quad \frac{7.6}{121} \quad \frac{9.8}{97} \quad \frac{9.4}{87}$$

$$\frac{2.6}{100} \quad \frac{0.8}{80} \quad \frac{1.8}{30} \quad 3.2 \quad \frac{6.3}{8} \quad \frac{7.2}{16} \quad \frac{6.7}{33} \quad \frac{7.5}{48} \quad \frac{8.1}{56} \quad \frac{4.4}{65} \quad \frac{6.2}{100}$$

6.4

913.57

26 + 38

Edge Road

07.0

26 + 51.0

Victoria St.

907.64

B.M.

2.10

903.11

12.56

901.01

901.01

0

10.18

911.60

16.9

901.42

B.M.

1.27

910.33

910.33

901.41
10-10

6.56

			DTZ	ER		ER	DTZ		
<u>2.5</u>	<u>1.0</u>	<u>2.8</u>	<u>5.7</u>	<u>6.08</u>	5.93	<u>6.70</u>	<u>7.0</u>	<u>3.5</u>	<u>6.1</u>
100	85	28	25	15		16	24	32	100

SpK in 18" W. Oak W. Side School #24 yard

