

OFFICE OF COUNTY ENGINEER
RAMSEY CO. MINN.

Road Map Survey

COUNTY ROAD "C"

From S.T.H. 49 To Little Can. Rd.

Road Acc't. No. 52

Date Filed.....

File.....

Extension of Co. Rd. "C"
East of Rice
To Little Canada Road.
Road # 52

Sta.	Ft.	Anglt.	Anglt.	Calc. Brg.
------	-----	--------	--------	------------

31+21.22				
----------	--	--	--	--

31+21.22		90° 32'		
----------	--	---------	--	--

31+21.22		90° 32'		7
----------	--	---------	--	---

31+21.22	700.22			
----------	--------	--	--	--

24+21.0				
---------	--	--	--	--

24+21.0		0° 23'		
---------	--	--------	--	--

22+94.2	126.8			
---------	-------	--	--	--

22+94.2	126.8			Intersection of 500 Line Track
---------	-------	--	--	--------------------------------

22+94.2	2294.2			
---------	--------	--	--	--

0+00				
------	--	--	--	--

111°59' to Little Canada Rd.
 4375.14
 Spike
 111°59'


112°00' 59.56
 2 nails
 40.29
 Mon.
 G.P.

89°28'
 Guard Rail Posts
 21.45
 19.55
 50.6
 T.P.
 Mon.

N.S. 1/4 Line

500 Line Track
 90°40'
 89°00'

Sec. Line
 Mon.
 on Ride

 

TOPOGRAPHY

EXTENSION OF CO. RD. "C"

EAST OF RICE ST.

Road 9C 52

11+03 E Street

7+87 Drive

6+39 Drive

4+50 Drive

3+48 Drive

3+40.5 Side Rd Sign

19.0

2+21 Drive

1+21 Drive

0+29 Stop Sign

24.2

12+00
16.0 16.0

Street
Gravel

10+00
16.0 16.0

8+00
17.0 16.0

12' Cap Iron 16' Cap Iron
20' Long 20' Long

DRIVE

DRIVE

6+00
15.0 16.0










1+00
16.0 16.0
28.4
Stop Sign

Conc. Pavement
on Rice St.

11+00
16.0 16.0

Begin G.R.

23+42.9 End Bridge Begin G.R.

22+44.6 Begin Bridge End G.R.

22+30 Drive

22+20 End Guard Rail

20+30 Begin Guard Rail 15.4 15.8 20+30 Begin Guard Rail

19+96 Drive


17+60 $\frac{1}{2}$ Street

15+30 Drive

14+37 Drive

13+32.5 Drive

12+45 Drive

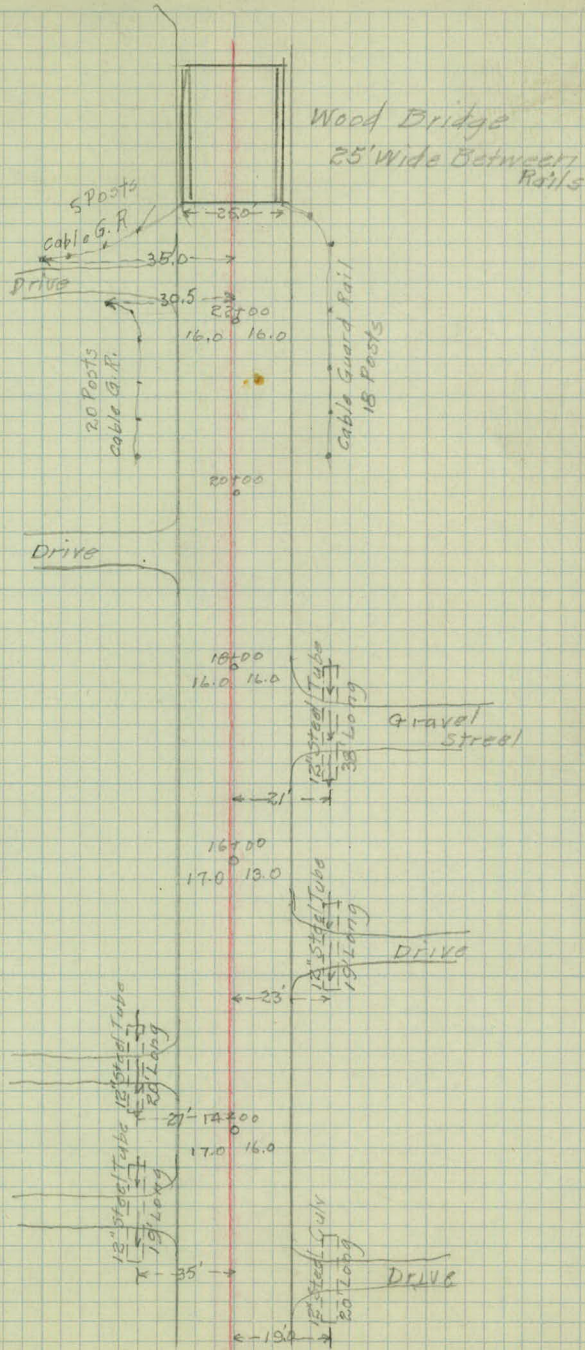

100.00
21.22
78.78

20+43 16" Corr. Iron Culv.

16.0 27+90 Turn Sign

27+75 End Guard Rail 13.0 14.0 27+75 End Guard Rail

27+06 24" Corr. Iron Culv.

Begin G.R.

23+42.9

End Bridge Begin G.R.

8" Square Reflector

Mori.

31+21.22

33.0'

31+00
5.00

30+75

19.0 5.5

30+50

14.0 10.5

16" Comp. Iron

34' Long

28+00

13.0 12.0

Cable Guard Rail 30' Posts

24" Comp. Iron

48' Long

26+00

12.0 12.5

24+50

14.0 14.5

Cable Guard Rail
41' Posts

Va Line

Mori

24+21.0

Dirt Road

Bridge

Cable Guard Rail
41' Posts

41+40 DRIVE


40+43 DRIVE

30.6 39+61 Cross Rd Sign

39+56 DRIVE

34+71 Turn Sign

4.5

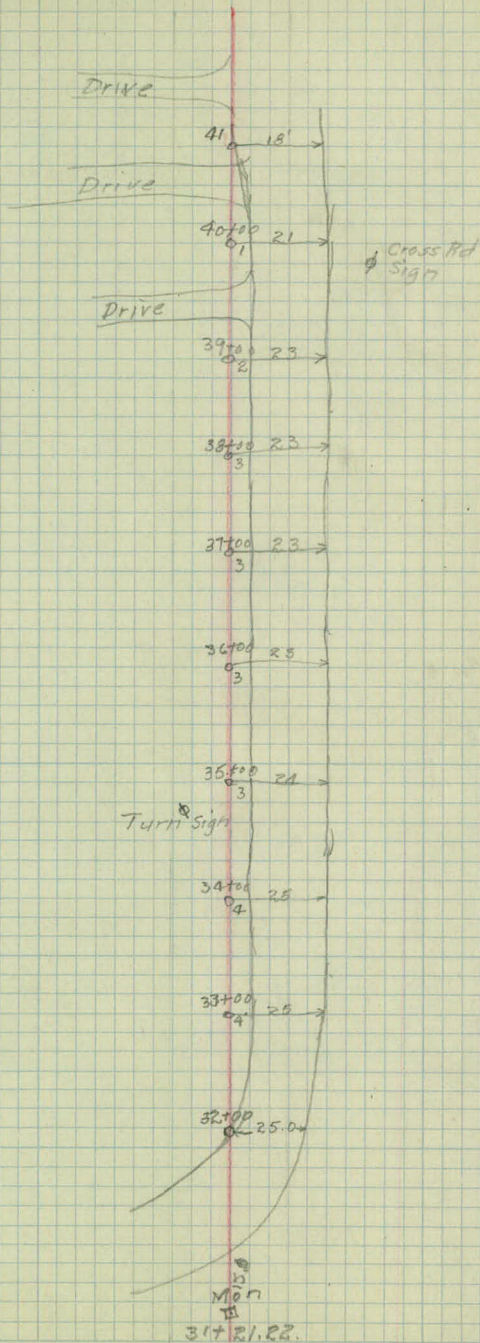

5

43+55.14 Intersection of Little Canada Rd.

200 42+51 Stop Sign

Little Canada Rd

43+55.14

43+25

13.1 49.0

43+00

7.0 3.60

Ø stop
sign

42+00

5.0 17.0

