

Book-8-Dr. 11-A

OFFICE OF COUNTY ENGINEER
RAMSEY CO. MINN.

Plan Survey

GRAMSIE ROAD

From $\frac{1}{2}$ mi. W of Rice St. to Rice St.

Road Acc't. No. 33-M18

Date Filed 1933

File 11

33-M18



26+37.75 @ Rice St.

23+18.10 P.O.T.


20+16.90 P.O.T.


0+00

0-100

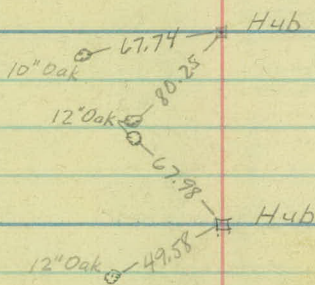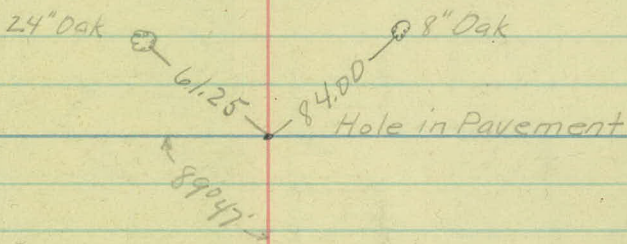

Hub

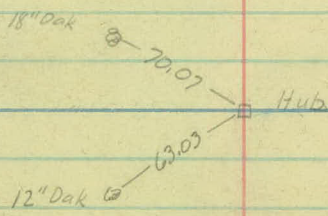

 

33-M18

Topog.

5

4

3

2

1

0+00

Cult.

+30-16.22'

115-15" X 20' C.M.

15' 5"

Hay Field

Hay Field

+48-54.9'

12

11

10

9

8

7

6

Hay Field

Pasture

Hay Field

F. 10'

F. 12'

+02-F. Cor. 13'

+82-12"x20' C.M.
+80-End Brush 20'

+10-Beg. Brush 30'

Brush 20' x 20'

15' 5'

19

18

17

16

15

14

13

+73-Side Rd.

+57-T.P. 30'
+26-F. Cor. 30'
+22-2-Tr. 19'
+07-Tr. 24'

+79-2-Tr. 25'

+57-Tr. 15'

+13-F. Cor. 33'

+62-Tr. 20'

+57-Tr. 28'
+55-Tr. 26'
+40-5-Tr. 20'

Orchard
cult.

Wooded

15 Small Trees

Wooded Pasture

Pasture

+81-F. E.

+23-Tr. 7'
F. 19'

+88-Tr. 8'
+85-F. Int.

+25-Tr. 8'
F. 17'

F. 14'

+69-Tr. 7'
+42-Tr. 7'

+10-Tr. 8'
F. 11'

F. 11'

+95-Tr. 18'
+84-Tr. 21'
+78-Tr. 13'
+75-3-Tr. 14'
+66-Tr. 12'

F. 11'

26

25

24

23

22

21

20

24' 100' Pavement 4" Curb

+16-15" X 25' P3 1'

6' Stone Gutter +11-T.P. 17'

Cult.

Cult.

+57-T.P. 29'

+27-Side Rd. ---

+00-End Brush + Woods

+97-F Cor. 16'

+77-Tr. + End Brush 10'

Woods

Wooded Pasture

F. 15'


+58-T.P. 29'

+20-Beg. Brush 25'

F. 16'

+25-Beg. Brush 10'

F. 19'

 

33-M.18

B.M.	5.75	✓ 893.96		888.21	
0-100				88.0	
0-50				86.5	
0+00				85.7	
+30		✓		✓ 84.5	
T.P.	1.69	887.07	8.58	885.38	
+65				83.4	
1				82.1	
+50				81.1	
2				80.3	
+50				80.3	
3				81.1	
+30				81.5	
+50				82.3	
+80		✓		✓ 83.3	
B.M.	4.11	889.54	1.63	885.44	885.43

Spk. in 12" Oak 40' Lt 0-115

60

7.5

$\frac{44}{40}$	$\frac{4.3}{35}$	$\frac{4.6}{23}$	$\frac{5.5}{12}$	$\frac{8.3}{8}$	8.3	$\frac{8.0}{7}$	$\frac{8.5}{12}$	$\frac{6.5}{22}$	$\frac{6.5}{40}$
-----------------	------------------	------------------	------------------	-----------------	-----	-----------------	------------------	------------------	------------------

$\frac{10.3}{40}$	$\frac{9.8}{22}$	$\frac{9.5}{9}$	$\frac{9.2}{7}$	$\frac{9.1}{5}$	$\frac{9.5}{3}$	9.5	$\frac{9.5}{2}$	$\frac{9.0}{5}$	$\frac{9.2}{9}$	$\frac{8.1}{40}$
-------------------	------------------	-----------------	-----------------	-----------------	-----------------	-----	-----------------	-----------------	-----------------	------------------

$\frac{7.5}{40}$	$\frac{7.0}{18}$	$\frac{6.6}{13}$	$\frac{5.7}{40}$	$\frac{5.7}{30}$	$\frac{5.5}{17}$	$\frac{5.0}{13}$	$\frac{3.6}{7}$	3.7	$\frac{3.7}{3}$	$\frac{4.4}{5}$	$\frac{5.0}{12}$	$\frac{4.6}{26}$	$\frac{4.6}{40}$
------------------	------------------	------------------	------------------	------------------	------------------	------------------	-----------------	-----	-----------------	-----------------	------------------	------------------	------------------

$\frac{9.4}{40}$	$\frac{9.4}{20}$	$\frac{9.0}{14}$	$\frac{6.7}{40}$	$\frac{6.6}{27}$	$\frac{7.0}{18}$	$\frac{6.2}{14}$	$\frac{4.6}{8}$	5.0	$\frac{4.8}{2}$	$\frac{4.6}{6}$	$\frac{6.1}{25}$	$\frac{6.1}{40}$
------------------	------------------	------------------	------------------	------------------	------------------	------------------	-----------------	-----	-----------------	-----------------	------------------	------------------

$\frac{11.8}{20}$	$\frac{11.1}{15}$	$\frac{5.8}{40}$	$\frac{9.5}{33}$	$\frac{8.5}{31}$	$\frac{8.7}{17}$	$\frac{7.8}{15}$	$\frac{6.0}{9}$	6.0	$\frac{6.0}{1}$	$\frac{8.0}{5}$	$\frac{8.5}{9}$	$\frac{8.5}{25}$	$\frac{8.5}{40}$
-------------------	-------------------	------------------	------------------	------------------	------------------	------------------	-----------------	-----	-----------------	-----------------	-----------------	------------------	------------------

$\frac{12.2}{17}$	$\frac{9.5}{40}$	$\frac{9.5}{37}$	$\frac{10.2}{35}$	$\frac{10.2}{32}$	$\frac{9.4}{31}$	$\frac{9.3}{23}$	$\frac{9.3}{17}$	$\frac{6.7}{10}$	6.8	$\frac{8.2}{4}$	$\frac{10.0}{11}$	$\frac{9.8}{19}$	$\frac{9.8}{20}$	$\frac{9.8}{40}$
-------------------	------------------	------------------	-------------------	-------------------	------------------	------------------	------------------	------------------	-----	-----------------	-------------------	------------------	------------------	------------------

$\frac{8.5}{40}$			$\frac{11.8}{23}$	$\frac{11.5}{18}$									
$\frac{8.5}{37}$	$\frac{9.3}{36}$	$\frac{8.3}{32}$	$\frac{8.2}{28}$	$\frac{9.0}{22}$	$\frac{9.5}{18}$	$\frac{6.8}{13}$	$\frac{6.5}{11}$	$\frac{6.5}{2}$	6.8	$\frac{9.6}{8}$	$\frac{9.8}{12}$	$\frac{9.5}{15}$	$\frac{10.2}{40}$

$\frac{12.0}{20}$	$\frac{10.8}{16}$	$\frac{7.7}{40}$	$\frac{8.4}{36}$	$\frac{8.2}{20}$	$\frac{8.3}{25}$	$\frac{7.6}{24}$	$\frac{8.3}{16}$	$\frac{6.6}{13}$	$\frac{5.8}{11}$	6.0	$\frac{8.0}{6}$	$\frac{8.2}{14}$	$\frac{8.8}{26}$	$\frac{9.2}{40}$
-------------------	-------------------	------------------	------------------	------------------	------------------	------------------	------------------	------------------	------------------	-----	-----------------	------------------	------------------	------------------

$\frac{11.1}{19}$	$\frac{9.3}{15}$	$\frac{6.8}{45}$	$\frac{7.3}{39}$	$\frac{8.2}{36}$	$\frac{8.0}{28}$	$\frac{7.5}{15}$	$\frac{6.0}{12}$	$\frac{5.5}{11}$	$\frac{5.6}{3}$	$\frac{6.2}{5}$	$\frac{7.7}{20}$	$\frac{7.8}{20}$	$\frac{8.2}{40}$
-------------------	------------------	------------------	------------------	------------------	------------------	------------------	------------------	------------------	-----------------	-----------------	------------------	------------------	------------------

$\frac{11.1}{35}$	$\frac{9.5}{31}$	$\frac{6.9}{22}$	$\frac{6.5}{45}$	$\frac{6.5}{40}$	$\frac{7.7}{38}$	$\frac{7.4}{31}$	$\frac{5.5}{18}$	$\frac{4.8}{10}$	4.8	$\frac{5.5}{2}$	$\frac{6.9}{5}$	$\frac{7.2}{24}$	$\frac{7.4}{40}$
-------------------	------------------	------------------	------------------	------------------	------------------	------------------	------------------	------------------	-----	-----------------	-----------------	------------------	------------------

$\frac{5.0}{41}$	$\frac{6.0}{38}$	$\frac{7.5}{37}$	$\frac{6.7}{34}$	$\frac{5.5}{33}$	$\frac{4.6}{30}$	$\frac{4.2}{18}$	$\frac{3.4}{12}$	$\frac{3.8}{38}$	$\frac{5.8}{8}$	$\frac{5.7}{26}$	$\frac{6.0}{40}$
------------------	------------------	------------------	------------------	------------------	------------------	------------------	------------------	------------------	-----------------	------------------	------------------

Spk. in 15" Oak 80' Rt. 4+22

✓
889.54

4

84.3

+30

84.9

+55

84.6

+80

84.5

5

B.M.

13.22

✓
898.65

4.11

✓
885.93

84.4

4+80

5

T.P.

1.85

✓
887.10

13.40

✓
885.25

+40

84.3

+70

83.7

6

82.8

+50

81.4

7

80.4

+50

80.4

$\frac{6.5}{40}$ $\frac{6.8}{38}$ $\frac{10.0}{36}$ $\frac{10.0}{34}$ $\frac{7.5}{32}$ $\frac{6.7}{29}$ $\frac{6.4}{20}$ $\frac{5.1}{14}$ 5.2 $\frac{5.3}{2}$ $\frac{7.3}{12}$ $\frac{7.5}{24}$ $\frac{7.5}{40}$

$\frac{3.3}{45}$ $\frac{3.5}{41}$ $\frac{9.5}{35}$ $\frac{9.5}{34}$ $\frac{6.7}{31}$ $\frac{5.1}{22}$ $\frac{4.8}{14}$ $\frac{4.6}{11}$ $\frac{4.5}{1}$ 4.6 $\frac{5.3}{9}$ $\frac{5.5}{15}$ $\frac{4.5}{21}$ $\frac{4.3}{31}$ $\frac{4.1}{40}$

$\frac{1.4}{50}$ $\frac{0.8}{45}$ $\frac{9.4}{35}$ $\frac{9.4}{34}$ $\frac{6.6}{31}$ $\frac{5.2}{16}$ $\frac{4.7}{11}$ $\frac{4.6}{6}$ 4.9 $\frac{5.5}{3}$ $\frac{6.1}{14}$ $\frac{5.4}{17}$ $\frac{0.0}{26}$ $\frac{0.8}{40}$

$\frac{3.5}{45}$ $\frac{3.2}{40}$ $\frac{9.0}{33}$ $\frac{9.0}{32}$ $\frac{6.5}{29}$ $\frac{5.2}{19}$ $\frac{4.6}{6}$ 5.0 $\frac{6.3}{13}$ $\frac{5.4}{18}$ $\frac{0.5}{22}$

$\frac{5.3}{45}$ $\frac{5.0}{39}$ $\frac{9.1}{34}$ $\frac{9.1}{33}$ $\frac{4.6}{30}$ $\frac{5.0}{20}$ $\frac{4.6}{6}$ 5.1 $\frac{5.8}{10}$ $\frac{4.2}{18}$ $\frac{2.2}{29}$

14.2

$\frac{5.8}{27}$ $\frac{3.0}{32}$ $\frac{2.7}{40}$

14.3

$\frac{4.0}{38}$ $\frac{2.0}{40}$ $\frac{1.5}{43}$ $\frac{2.2}{50}$

$\frac{7.4}{38}$ $\frac{7.2}{32}$ $\frac{5.8}{21}$ $\frac{5.5}{18}$ $\frac{4.2}{15}$

$\frac{5.5}{45}$ $\frac{7.7}{39}$ $\frac{5.2}{37}$ $\frac{7.0}{36}$ $\frac{7.0}{33}$ $\frac{5.0}{32}$ $\frac{4.4}{18}$ $\frac{2.7}{12}$ 2.8 $\frac{2.9}{15}$ $\frac{3.0}{27}$ $\frac{2.0}{37}$ $\frac{1.0}{43}$

$\frac{7.5}{23}$ $\frac{6.9}{18}$ $\frac{5.9}{14}$

$\frac{5.7}{45}$ $\frac{5.6}{37}$ $\frac{7.0}{36}$ $\frac{6.7}{34}$ $\frac{5.2}{33}$ $\frac{4.7}{14}$ $\frac{3.5}{12}$ $\frac{3.3}{10}$ 3.4 $\frac{4.2}{5}$ $\frac{4.7}{8}$ $\frac{4.7}{24}$ $\frac{4.0}{40}$

$\frac{8.8}{24}$ $\frac{8.4}{19}$ $\frac{7.4}{14}$ $\frac{6.2}{42}$ $\frac{6.2}{37}$ $\frac{7.2}{36}$ $\frac{7.2}{33}$ $\frac{6.0}{32}$ $\frac{5.8}{14}$ $\frac{4.0}{9}$ 4.3 $\frac{4.3}{1}$ $\frac{5.3}{4}$ $\frac{5.8}{11}$ $\frac{5.0}{28}$ $\frac{5.0}{40}$

$\frac{8.6}{26}$ $\frac{9.1}{22}$ $\frac{7.8}{15}$

$\frac{7.1}{45}$ $\frac{7.1}{37}$ $\frac{8.2}{36}$ $\frac{8.1}{33}$ $\frac{7.1}{32}$ $\frac{6.1}{27}$ $\frac{7.0}{20}$ $\frac{6.7}{12}$ $\frac{5.7}{10}$ 5.7 $\frac{6.4}{5}$ $\frac{6.8}{8}$ $\frac{6.8}{24}$ $\frac{6.6}{40}$

$\frac{7.0}{45}$ $\frac{9.6}{28}$ $\frac{8.9}{24}$ $\frac{8.3}{14}$

$\frac{7.0}{37}$ $\frac{8.5}{36}$ $\frac{8.5}{33}$ $\frac{7.5}{32}$ $\frac{6.0}{27}$ $\frac{7.5}{23}$ $\frac{7.8}{13}$ $\frac{7.5}{12}$ $\frac{6.6}{9}$ $\frac{6.6}{5}$ 6.7 $\frac{7.0}{3}$ $\frac{7.0}{8}$ $\frac{7.4}{24}$ $\frac{7.4}{40}$

$\frac{8.7}{34}$ $\frac{7.8}{31}$ $\frac{8.1}{17}$

$\frac{6.8}{45}$ $\frac{7.4}{36}$ $\frac{8.1}{35}$ $\frac{8.1}{33}$ $\frac{7.1}{32}$ $\frac{6.2}{26}$ $\frac{6.8}{23}$ $\frac{7.6}{12}$ $\frac{6.8}{9}$ 6.7 $\frac{7.1}{4}$ $\frac{7.3}{8}$ $\frac{7.1}{25}$ $\frac{6.5}{40}$

887.10 ✓

8

80.9

+50

82.3

9

T.P.

4.22

890.12 ✓

1.20

885.90 ✓

83.3

+50

84.4

10

86.0

+45

86.4

+70 x

86.3

11

x

85.4

+50

x

84.1

12

82.8

+50

82.8

13

83.8

+50

85.3

$$\begin{array}{r} 7.1 \ 8.5 \ 8.3 \ 7.7 \ 7.4 \\ 35 \ 31 \ 27 \ 22 \ 14 \end{array}$$

$$\begin{array}{r} 5.4 \ 6.2 \ 8.8 \ 7.2 \ 6.0 \ 5.5 \ 6.3 \ 6.5 \ 6.0 \\ 45 \ 36 \ 36 \ 33 \ 30 \ 20 \ 12 \ 10 \end{array} \quad 6.2 \quad \begin{array}{r} 6.6 \ 7.0 \ 7.0 \ 6.8 \\ 4 \ 7 \ 22 \ 40 \end{array}$$

$$\begin{array}{r} 8.4 \ 8.0 \ 7.4 \ 6.3 \\ 31 \ 28 \ 23 \ 14 \end{array}$$

$$\begin{array}{r} 5.0 \ 4.8 \ 7.7 \ 6.6 \ 5.5 \ 4.2 \ 5.0 \ 5.1 \ 4.6 \\ 50 \ 38 \ 36 \ 33 \ 33 \ 27 \ 22 \ 12 \ 7 \end{array} \quad 4.8 \quad \begin{array}{r} 5.4 \ 5.6 \ 6.0 \ 6.6 \ 6.2 \ 6.2 \\ 5 \ 7 \ 19 \ 27 \ 31 \ 40 \end{array}$$

$$\begin{array}{r} 8.0 \ 6.9 \ 6.4 \ 6.5 \\ 30 \ 28 \ 22 \ 13 \end{array}$$

$$\begin{array}{r} 4.2 \ 5.1 \ 5.7 \ 6.7 \ 6.8 \ 5.7 \ 4.2 \ 4.4 \ 3.8 \\ 45 \ 39 \ 36 \ 36 \ 34 \ 33 \ 27 \ 13 \end{array} \quad 9 \ 3.8 \quad \begin{array}{r} 4.6 \ 4.8 \ 5.5 \ 5.3 \ 5.5 \\ 5 \ 9 \ 25 \ 28 \ 40 \end{array}$$

$$\begin{array}{r} 3.0 \ 3.3 \\ 40 \ 45 \end{array}$$

$$\begin{array}{r} 4.3 \ 7.7 \ 8.0 \ 6.0 \ 4.3 \ 3.8 \ 5.4 \ 5.6 \ 5.3 \ 5.7 \\ 37 \ 35 \ 34 \ 22 \ 31 \ 24 \ 22 \ 16 \ 9 \ 7 \end{array} \quad 5.7 \quad \begin{array}{r} 6.4 \ 7.6 \ 8.1 \ 8.0 \ 8.2 \\ 6 \ 23 \ 26 \ 29 \ 40 \end{array}$$

$$\begin{array}{r} 5.7 \ 5.3 \ 7.5 \ 8.2 \ 4.2 \ 2.8 \ 4.5 \ 4.7 \ 4.2 \\ 45 \ 39 \ 36 \ 34 \ 32 \ 28 \ 24 \ 18 \ 9 \end{array} \quad 4.1 \quad \begin{array}{r} 4.6 \ 5.5 \ 7.0 \ 6.0 \ 6.4 \\ 11 \ 20 \ 26 \ 33 \ 40 \end{array}$$

$$\begin{array}{r} 5.3 \ 5.0 \ 7.5 \ 7.6 \ 4.5 \ 2.0 \ 4.3 \ 4.5 \ 4.0 \\ 45 \ 38 \ 36 \ 34 \ 31 \ 27 \ 24 \ 17 \ 9 \end{array} \quad 3.7 \quad \begin{array}{r} 4.4 \ 5.0 \ 6.5 \ 5.5 \ 4.5 \ 4.0 \ 4.4 \ 4.2 \\ 12 \ 22 \ 25 \ 27 \ 30 \ 37 \ 42 \end{array}$$

$$\begin{array}{r} 5.0 \ 5.1 \ 7.5 \ 7.4 \ 5.0 \ 3.8 \ 4.5 \ 4.6 \ 4.0 \\ 45 \ 37 \ 36 \ 34 \ 32 \ 28 \ 24 \ 18 \ 9 \end{array} \quad 3.8 \quad \begin{array}{r} 4.2 \ 4.8 \ 6.6 \ 6.6 \ 5.8 \ 4.8 \ 4.8 \\ 11 \ 21 \ 25 \ 26 \ 27 \ 31 \ 40 \end{array}$$

$$\begin{array}{r} 5.8 \ 5.8 \ 7.8 \ 7.8 \ 5.4 \ 5.0 \ 5.6 \ 5.2 \ 4.8 \\ 45 \ 36 \ 35 \ 34 \ 33 \ 29 \ 27 \ 11 \ 9 \end{array} \quad 4.7 \quad \begin{array}{r} 5.0 \ 5.7 \ 6.2 \ 7.5 \ 7.5 \ 6.3 \ 6.0 \\ 3 \ 9 \ 23 \ 26 \ 27 \ 28 \ 40 \end{array}$$

$$N \quad \begin{array}{r} 7.0 \ 7.0 \ 7.8 \ 7.7 \ 7.0 \ 6.1 \ 7.0 \ 5.7 \\ 45 \ 36 \ 36 \ 33 \ 32 \ 24 \ 15 \ 9 \end{array} \quad 6.0 \quad \begin{array}{r} 6.0 \ 6.5 \ 7.5 \ 7.7 \ 6.7 \ 8.5 \ 7.6 \ 7.6 \\ 2 \ 5 \ 8 \ 15 \ 18 \ 25 \ 31 \ 40 \end{array}$$

$$\begin{array}{r} 7.8 \ 7.8 \ 8.4 \ 8.4 \ 7.8 \ 7.2 \ 8.2 \ 8.8 \ 7.6 \ 7.2 \\ 45 \ 36 \ 36 \ 33 \ 32 \ 27 \ 22 \ 15 \ 12 \ 9 \end{array} \quad 7.3 \quad \begin{array}{r} 7.3 \ 9.2 \ 8.7 \ 7.5 \ 8.7 \ 7.8 \\ 2 \ 7 \ 15 \ 19 \ 26 \ 40 \end{array}$$

$$\begin{array}{r} 7.3 \ 7.8 \ 8.6 \ 8.4 \ 7.7 \ 7.8 \ 8.5 \ 8.0 \ 7.8 \ 7.3 \\ 40 \ 36 \ 35 \ 32 \ 31 \ 22 \ 19 \ 13 \ 11 \ 9 \end{array} \quad 7.3 \quad \begin{array}{r} 7.4 \ 8.2 \ 9.1 \ 8.5 \ 8.3 \\ 2 \ 4 \ 8 \ 14 \ 40 \end{array}$$

$$\begin{array}{r} 7.1 \ 7.1 \ 8.0 \ 7.8 \ 7.1 \ 6.6 \ 7.6 \ 7.7 \ 6.6 \ 6.3 \\ 45 \ 36 \ 36 \ 33 \ 32 \ 28 \ 23 \ 15 \ 11 \ 8 \end{array} \quad 6.3 \quad \begin{array}{r} 6.8 \ 7.8 \ 8.1 \ 7.7 \ 8.0 \ 8.3 \\ 2 \ 6 \ 11 \ 19 \ 31 \ 40 \end{array}$$

$$\begin{array}{r} 5.8 \ 5.8 \ 6.8 \ 7.0 \ 6.3 \ 5.8 \ 4.7 \\ 45 \ 34 \ 36 \ 33 \ 32 \ 18 \ 12 \end{array} \quad 4.8 \quad \begin{array}{r} 5.4 \ 7.0 \ 6.8 \ 8.2 \ 7.4 \ 7.6 \\ 5 \ 8 \ 23 \ 26 \ 29 \ 40 \end{array}$$

890.12 ✓

14
T.P. 9.06 898.15 ✓ 1.03 889.09 ✓ 86.6.

+50 88.8.

B.M. 1.64 896.51 ✓

15 90.7.

+50 92.2.

16 94.9.

+50

B.M. 8.48 904.99 ✓ 1.64 896.51 ✓

16 +50 98.4.

17 01.4.

T.P. 9.06 911.76 ✓ 2.29 902.70 ✓

+50 04.6.

18 07.1.

T.P. 12.71 921.41 ✓ 3.06 908.70 ✓

18

+50 09.3.

+75 10.3.

$\frac{3.6}{40}$ $\frac{4.7}{35}$ $\frac{4.6}{19}$ $\frac{3.5}{15}$ $\frac{3.1}{9}$ 3.5 $\frac{4.8}{7}$ $\frac{5.5}{12}$ $\frac{6.0}{26}$ $\frac{6.2}{40}$

$\frac{2.7}{45}$ $\frac{4.3}{37}$ $\frac{5.3}{37}$ $\frac{8.2}{33}$ $\frac{10.5}{27}$ $\frac{10.5}{19}$ $\frac{9.5}{17}$ $\frac{9.0}{12}$ $\frac{9.0}{2}$ 9.4 $\frac{10.5}{4}$ $\frac{11.1}{9}$ $\frac{12.0}{14}$ $\frac{13.2}{27}$ $\frac{13.8}{40}$

Spk. in 15" Dak 40' Lt. 15+10

$\frac{2.5}{45}$ $\frac{2.6}{38}$ $\frac{8.6}{31}$ $\frac{9.5}{23}$ $\frac{7.5}{19}$ $\frac{6.5}{15}$ $\frac{7.0}{10}$ $\frac{7.0}{3}$ 7.5 4 8 $\frac{8.1}{10}$ $\frac{8.2}{13}$ $\frac{10.2}{27}$ $\frac{12.2}{40}$

$\frac{3.5}{45}$ $\frac{4.0}{37}$ $\frac{8.0}{32}$ $\frac{7.8}{26}$ $\frac{5.8}{21}$ $\frac{4.3}{14}$ $\frac{4.7}{3}$ 6.0 $\frac{8.5}{6}$ $\frac{9.7}{11}$ $\frac{11.4}{25}$ $\frac{12.7}{40}$

$\frac{2.5}{45}$ $\frac{3.5}{38}$ $\frac{5.5}{34}$ $\frac{5.5}{25}$ $\frac{3.7}{19}$ $\frac{2.0}{14}$ $\frac{2.0}{9}$ 3.3 $\frac{7.5}{7}$ $\frac{8.4}{11}$ $\frac{9.9}{17}$ $\frac{11.9}{30}$ $\frac{12.3}{40}$

10.2

$\frac{6.6}{12}$ $\frac{8.2}{18}$ $\frac{10.6}{40}$

$\frac{6.4}{45}$ $\frac{7.4}{37}$ $\frac{10.0}{32}$ $\frac{8.4}{23}$ $\frac{6.8}{18}$ $\frac{6.2}{14}$ $\frac{6.2}{3}$ 6.6 $\frac{10.0}{5}$

$\frac{2.5}{40}$ $\frac{5.2}{29}$ $\frac{4.7}{21}$ $\frac{3.4}{14}$ $\frac{3.3}{2}$ 3.6 $\frac{7.2}{7}$ $\frac{8.6}{14}$ $\frac{9.4}{16}$ $\frac{10.8}{32}$ $\frac{12.0}{40}$

$\frac{3.0}{40}$ $\frac{4.2}{33}$ $\frac{6.7}{27}$ $\frac{8.1}{20}$ $\frac{7.4}{16}$ $\frac{7.5}{12}$ $\frac{7.7}{5}$ 7.2 $\frac{7.3}{2}$ $\frac{9.2}{10}$ $\frac{10.0}{17}$ $\frac{11.4}{28}$ $\frac{12.2}{40}$

$\frac{4.7}{17}$ $\frac{4.5}{13}$ $\frac{4.9}{3}$ 4.7 $\frac{5.3}{2}$ $\frac{5.0}{6}$ $\frac{2.2}{9}$ $\frac{2.7}{17}$ $\frac{3.8}{26}$ $\frac{5.0}{40}$

$\frac{6.0}{40}$ $\frac{7.0}{31}$

14.3

$\frac{1.4}{40}$ $\frac{2.0}{31}$ $\frac{11.0}{16}$ $\frac{12.0}{10}$ 12.1 $\frac{12.4}{4}$ $\frac{6.0}{14}$ $\frac{6.5}{23}$ $\frac{8.0}{40}$

$\frac{0.7}{40}$ $\frac{1.0}{28}$ $\frac{11.0}{14}$ $\frac{11.0}{10}$ 11.1 $\frac{11.2}{7}$ $\frac{4.5}{17}$ $\frac{4.7}{20}$ $\frac{6.5}{40}$

921.41 ✓

19

11.3 ↓

+50

13.3 ✓

T.P.

3.83

918.33 ✓

6.91

914.50 ✓

+65

13.5 ✓

+75

13.6 ✓

20

13.6 ✓

+35

13.0 ✓

+65

12.3 ✓

21

T.P.

9.31

924.02 ✓

3.62

914.71 ✓

12.8 ✓

+50

14.4 ✓

22

17.0 ✓

+50

T.P.

4.84

928.26 ✓

0.60

923.42 ✓

19.5 ✓

23

22.7 ✓

+50

24.0 ✓

$$\begin{array}{cccccc} \frac{0.4}{40} & \frac{1.5}{29} & \frac{9.5}{15} & \frac{9.8}{10} & 10.1 & \frac{10.1}{4} & \frac{8.4}{11} & \frac{5.0}{19} & \frac{4.7}{25} & \frac{6.0}{40} \end{array}$$

$$\begin{array}{cccccc} \frac{1.5}{40} & \frac{2.0}{35} & \frac{5.5}{24} & \frac{7.2}{20} & \frac{7.5}{16} & 8.1 & \frac{8.4}{6} & \frac{6.5}{10} & \frac{6.2}{15} & \frac{5.3}{18} & \frac{6.0}{28} & \frac{7.0}{40} \end{array}$$

$$\begin{array}{cccccc} \frac{2.2}{40} & \frac{2.8}{33} & \frac{3.8}{15} & \frac{4.4}{10} & 4.8 & \frac{5.0}{7} & \frac{4.0}{11} & \frac{4.3}{18} & \frac{5.2}{28} & \frac{5.7}{40} \end{array}$$

$$\begin{array}{cccccc} \frac{2.2}{40} & \frac{3.0}{28} & \frac{4.0}{13} & 4.7 & \frac{6.0}{18} & \frac{6.2}{29} & \frac{6.6}{40} \end{array}$$

$$\begin{array}{cccccc} \frac{2.0}{40} & \frac{3.4}{31} & \frac{4.5}{27} & \frac{4.0}{20} & \frac{4.0}{8} & 4.7 & \frac{5.4}{5} & \frac{6.7}{9} & \frac{7.4}{17} & \frac{8.0}{30} & \frac{8.5}{40} \end{array}$$

$$\begin{array}{cccccc} \frac{4.5}{40} & \frac{5.5}{31} & \frac{6.2}{28} & \frac{6.0}{24} & \frac{4.8}{15} & \frac{4.7}{2} & 5.3 & \frac{6.0}{3} & \frac{10.5}{10} & \frac{11.7}{16} & \frac{13.0}{21} & \frac{15.0}{40} \end{array}$$

$$\begin{array}{cccccc} \frac{4.0}{40} & \frac{5.5}{32} & \frac{6.1}{28} & \frac{6.0}{20} & \frac{4.7}{16} & \frac{5.0}{4} & 6.0 & \frac{8.4}{3} & \frac{10.4}{9} & \frac{11.5}{15} & \frac{13.0}{25} & \frac{15.0}{40} \end{array}$$

$$\begin{array}{cccccc} \frac{3.0}{40} & \frac{4.5}{29} & \frac{5.4}{26} & \frac{5.2}{19} & \frac{4.3}{16} & \frac{4.5}{5} & 5.5 & \frac{6.2}{2} & \frac{8.5}{5} & \frac{11.1}{16} & \frac{11.7}{29} & \frac{13.0}{40} \end{array}$$

$$\begin{array}{cccccc} \frac{6.6}{40} & \frac{7.2}{33} & \frac{9.2}{29} & \frac{9.6}{22} & \frac{9.1}{18} & \frac{9.1}{7} & 9.6 & \frac{10.0}{4} & \frac{11.3}{8} & \frac{12.2}{16} & \frac{12.7}{18} & \frac{15.3}{40} \end{array}$$

$$\begin{array}{cccccc} \frac{3.6}{40} & \frac{4.2}{36} & \frac{6.2}{32} & \frac{6.5}{21} & \frac{7.2}{17} & \frac{7.2}{2} & 7.0 & \frac{7.2}{2} & \frac{8.8}{7} & \frac{9.4}{14} & \frac{11.2}{29} & \frac{11.8}{40} \end{array}$$

$$\begin{array}{cccccc} \frac{2.5}{45} & \frac{3.5}{37} & \frac{4.5}{35} & \frac{4.2}{20} & \frac{5.0}{16} & \frac{4.6}{4} & 4.5 & \frac{4.7}{8} & \frac{5.2}{15} & \frac{5.4}{28} & \frac{5.5}{40} \end{array}$$

$$\begin{array}{cccccc} \frac{5.6}{40} & \frac{6.3}{26} & \frac{5.6}{20} & \frac{6.5}{17} & \frac{6.0}{5} & 5.6 & \frac{6.2}{10} & \frac{6.2}{17} & \frac{5.4}{19} & \frac{5.6}{40} \end{array}$$

$$\begin{array}{cccccc} \frac{5.3}{40} & \frac{4.8}{23} & \frac{5.2}{22} & \frac{5.0}{8} & 4.3 & \frac{4.7}{3} & \frac{4.7}{23} & \frac{4.7}{40} \end{array}$$

✓
928.26

24 24.9

+50 25.7

25 26.3

+50 24.7

26 23.6

+10 23.9

+14 20.7

+21 22.4

+37.75 @ Rice St. ✓ 22.2

B. M. 3.90 924.36 924.36

$$\frac{4.0}{40} \frac{3.5}{18} \frac{4.0}{15} \frac{4.0}{9} \frac{3.5}{6} \quad 3.4 \frac{3.8}{4} \frac{4.1}{25} \frac{4.1}{40}$$

N

$$\frac{2.0}{40} \frac{2.0}{22} \frac{2.6}{15} \quad 2.6 \frac{2.8}{4} \frac{3.4}{7} \frac{3.8}{40}$$

$$\frac{1.8}{40} \frac{1.5}{21} \frac{2.0}{17} \quad 2.0 \frac{2.4}{5} \frac{3.2}{12} \frac{3.8}{40}$$

$$\frac{3.5}{40} \frac{3.0}{33} \frac{3.5}{28} \frac{3.2}{22} \frac{3.6}{18} \quad 3.6 \frac{3.6}{4} \frac{4.1}{8} \frac{5.0}{40}$$

$$\frac{3.7}{40} \frac{4.6}{18} \frac{5.2}{16} \frac{5.4}{9} \frac{4.8}{7} \quad 4.7 \frac{5.0}{25} \frac{5.0}{40}$$


$$\frac{4.4}{40} \frac{5.0}{19} \frac{5.4}{17} \frac{5.7}{8} \frac{4.7}{4} \quad 4.4 \frac{4.5}{10} \frac{5.2}{15} \frac{5.2}{40}$$

$$\frac{6.7}{40} \frac{7.0}{27} \quad 7.6 \frac{8.4}{20} \frac{8.5}{40}$$

$$\frac{5.0}{40} \frac{5.5}{20} \quad 5.9 \frac{6.8}{20} \frac{7.4}{40}$$

$$\frac{5.0}{40} \frac{5.6}{20} \quad 6.1 \frac{6.7}{20} \frac{7.4}{40}$$

Spk. in 24" Oak N.E. Cor. Rice & Coleman Ave

 

Plains in hand. Proj. 33-M18

8/1/33

Vair
Carley
Beateir

0+00 -1+00 Gr. 2

2+20 Pl. 24" X 42 P₃ Inv. 78.0

3+15 20' Reint. Rep. at 6+00 Lt

4+00 5+00 Cl. 4 Gr. 7

6+82 20' Reint.

Check Drain. 7+00 West

6+00 Lt. & Rt Pl. 15" X 20 C.M.⁵

12+25 Pl. 24" X 36 P₃

14+00 Rt. & Lt Pl. 15" X 20 C.M.

14+00 15+00 Cl. 8 Gr. 10

16+00 19+50 Cl. 18 Gr. 23

19+73 Lt Pl. 15" X 20' C.M.

19+81 Rt No. coll. req.

20+25 23+00 Cl. 20 Ft Gr. 20 Ft. Rt 0.13

20+50 23+00 " 10 " " 10 " Lt. 0.06

23+27 Lt. Pl. 15" X 20' C.M.

24+50 Rt No coll. req.

26+ 15" P₃ Pl. Extended to 48'

