

Bk. 24 Dr. 12

OFFICE OF COUNTY ENGINEER
RAMSEY CO. MINN.

~~Plan~~ Survey
Drainage

Ditch From No Side
From Mississippi To Lak. Vadnais

Road Acc't. No.

Date Filed 6-11-41

File

PLAN SURVEY

DITCH

LAKE VADNAIS to MISSISSIPPI ST.

INDEX Page

Align. - 1-4

Topog. - 5-11

X Sections - 12-20



Alignment


Sta	pt.	Angle	
		LT	RT
5+68.51	P.I.	36°34' Lt.	
5+03.70	P.O.T.	± Centerville Rd.	
4+36.55	P.I.	46°12' Rt.	
2+59.08	P.I.	33°45' Lt.	
1+78.74	P.I.	9°40' Rt.	E. End Culu.
1+46.66	P.O.T.	± Edgerton St = ^{R. Ankers Survey} _{Edgerton from Centerville} 0+94.45	
1+13.26	P.I.	6°44' Lt.	W. End Culu.
0+00	P.O.T.		

42°20'
Centerline Rd

83°12'
to 10 1/2
Edgerton 649.40

Sta.	Pt.	Angle
14 + 03.4	P.I.	60°31'
13 + 38.5		15°42' Rt.
11 + 20.5	P.I.	12°26' Rt.
10 + 31.00	P.I.	14°54' Rt.
9 + 93.5	P.I.	74°48' Rt.
8 + 29.1	P.I.	13°08' Rt.
7 + 35.70	P.I.	10°47' Lt.
7 + 09.1	P.I.	29°56' Lt.
6 + 98.08	P.O.T. = R.R. Track.	
6 + 70.00	P.I.	58°07' Rt.

6470.
28.08
6498.08

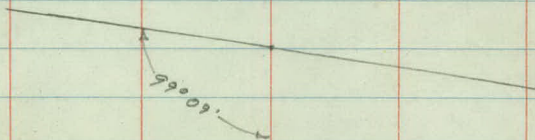



Sta	Point	ΔLt	ΔRt
-----	-------	-------------	-------------

38 + 22.30	P.I.	0°08'30"	
------------	------	----------	--

17 + 34.55	P.I.		
------------	------	--	--

15 + 37.0	P.I.	9°09'	
-----------	------	-------	--

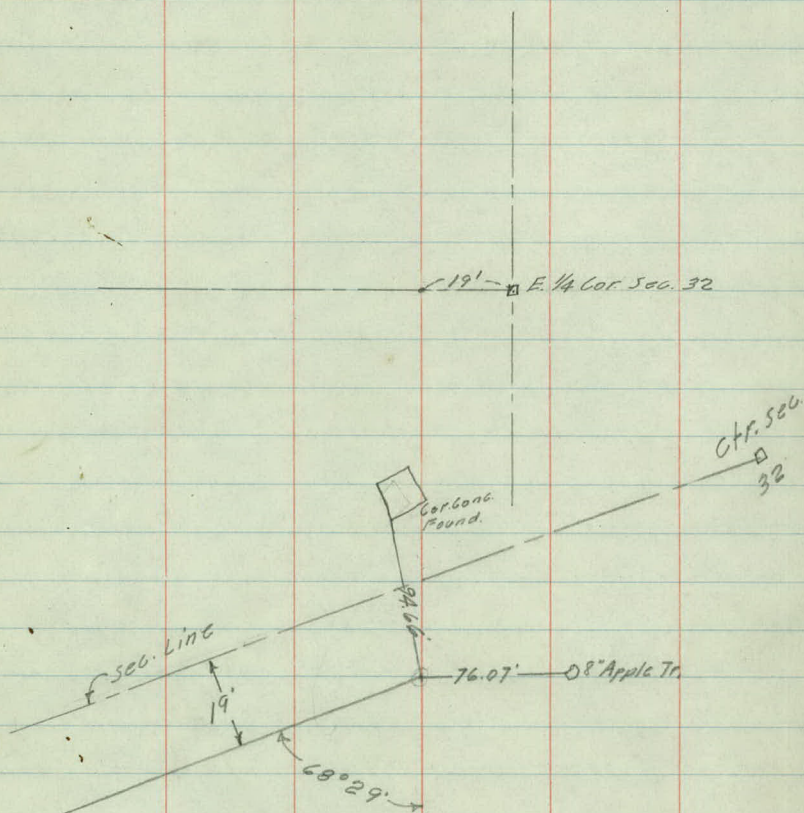

 

Topography

Note: See Xsections to spot ditch.

+50-D in Fe-5'

5 +27-D in Fe-00 +20-G.R.X5E +05-T.P-27'
Fe-45 G.R-18' Fe-23'

+80-G.R.X5E

+4.04=E+End Barrel Mono. Cu.N. 4' Wide 6' Deep.

+36-D in Fe-8'

4 Fe-8'

3 Fe-3' G.R-23'

1150

+76-D in Fe-1'
+67-D in G.R-20'
+59-D in G.R-19'
+46-D in G.R-22'

+63-D in Fe-5'

2 Fe-4'

G.R-21'

+79-Fe.Cor-5'

+80-D in G.R-21'
+60-Edge Rd. +66-Box G.R-12'


+30-End G.R-6'

+25-G.R-17'

+13-R Drive-2.5'

1

0400 E Drive -30'

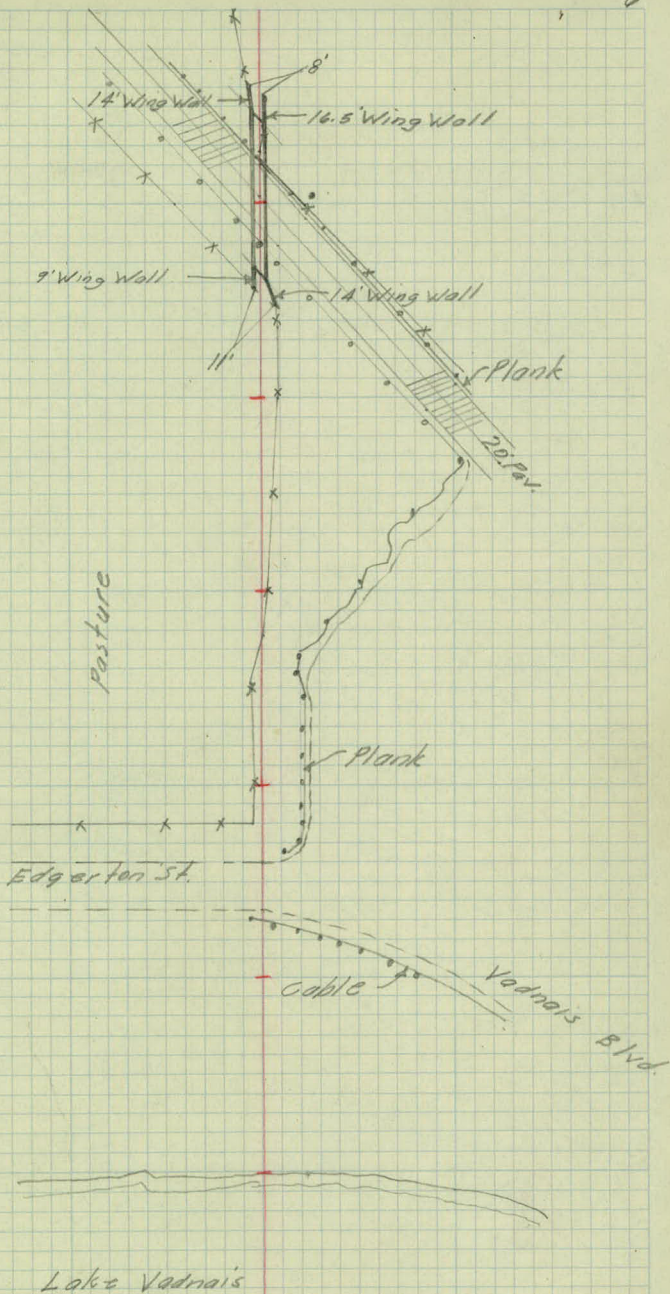

12'

Fc. - 3'

11

Fc. - 4'

+33-Fc. Cor.-13' E + W Fc. +34-Fc. Cor.-10'

10 Fc. - 26'

+27-D in Fc.-12'
+18-Range 11c to Fc.-

9 Fc.-11

Fc.-55

+30-Fc.-14'

8

+16-D in Fc.-25'

+46-End Wing Wall.-9' Fc.-11'
+36.5-End Barral.-3.2'

+42-End Wing Wall.-11.3'

7

+09.1-Bes. Conc. Wall.-3'

+09.1-D in Conc. Wall.-33'
+4.5-Bes. Conc. Wall.-35'
+03-End Timber Wall.-12'

+92-D in Wall.-6'

+85-End Wing Wall.-17'

+88-D in Wall.-9'

+10-D in Fc.-5'


+42-End Wing Wall.-9'

+21-D in Fc + T.P.-25'

+38-End Fc.-8'

6

Fc.-22'

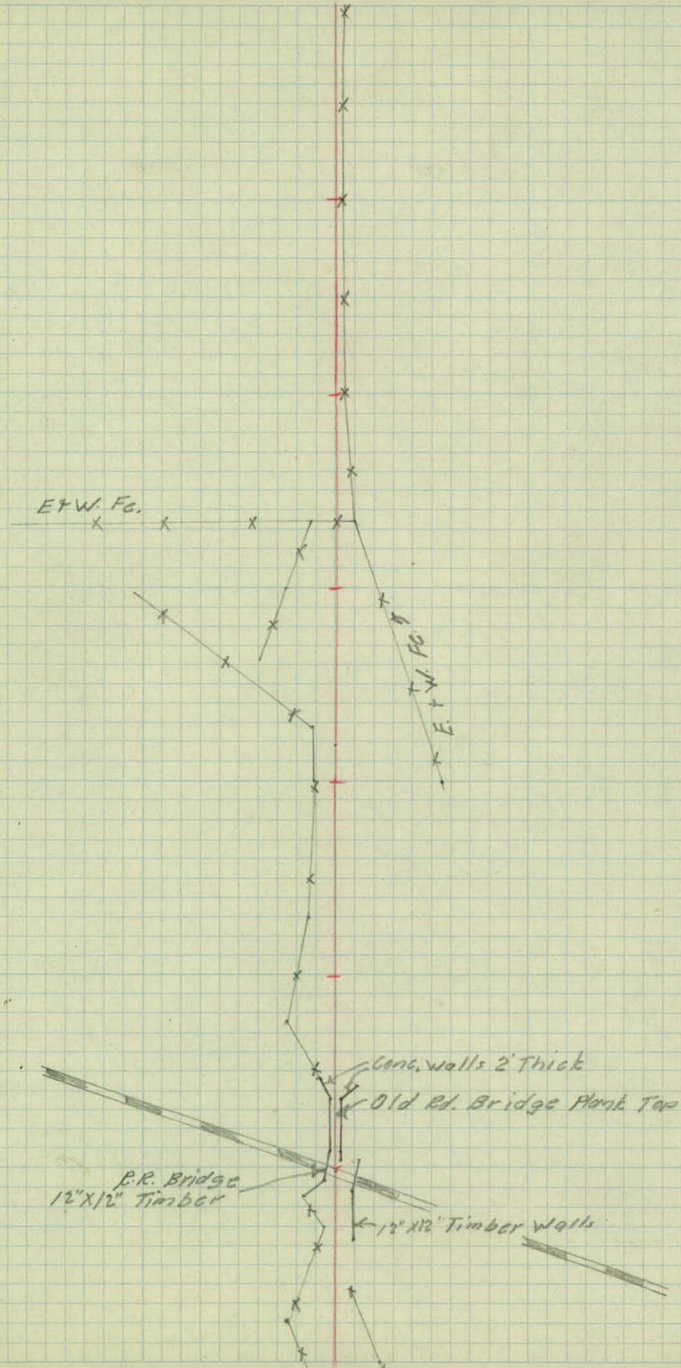

+96-Ent-15"X21' C.M.-1'

19'

+97-Ent-18"X20' C.M.-1'

+54-S.W. Cor Ho.-55'

18

17

+89-End Fc.-9'

16

+98-Beg. Fc.-5'

off Fore Tang.
+37-PP-47'

15

+18-Power Line Xs &

14

+69-End 24" C.M.-2'
+53-End 24" C.M.-1.5'

13

+28-End Fc.-7'
Fc.-5'

20'
1-S.F.
34'

— — — — —
— — — — —

X
X

26

25

24

23

+60-Ent. $\frac{12'' \times 16' 6'' M}{00}$

22

21

+09-S.W. Cor Ho. - 54"

20

$$\begin{array}{r} 252 \\ 6 \overline{) 1512} \end{array}$$

43 Ent - $\frac{15'' \times 26' 6'' \text{ M.}}{00}$

42 Ent - $\frac{12'' \times 21' 6'' \text{ M.}}{00}$

+56-S.W. Cor. Ho. - 59'

+41-Ent - $\frac{12'' \times 22' 6'' \text{ M.}}{1''}$

41
+95-S.W. Cor. Ho. - 97'

+19-Ent 12" C.M. - 00
40 +02-S.W. Cor. Ho. - 83'

+71-Ent 12" C.M. - 00

+35-S.W. Cor. Ho. - 94'

+18-N.W. Cor. Ho. - 93'


+37-N.W. Cor. Ho. - 91' ✓

39

+78-S.W. Cor. Ho. - 147' ✓

+33-Ent - $\frac{12'' \times 37' 6'' \text{ M.}}{00}$

38

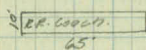


+27-S.W. Cor Ho. - 56'

+35-N.W. Cor Ho. - 89'

$$\begin{array}{r} 22 \\ \boxed{\begin{array}{r} 5 \\ 15 \\ 15 \end{array}} \\ 24 \end{array}$$

$$\begin{array}{r} 1-5-F \\ \boxed{30} \\ 24 \end{array}$$

 

Levels.

Sta	+	π	-	Elev
B.M.	7.51	896.60		889.09

Elev. Lake Vadnais			14.91	81.69
--------------------	--	--	-------	-------

0	+00		14.8	881.8
---	-----	--	------	-------

	+50		13.8	82.8
--	-----	--	------	------

1			15.3	81.3
---	--	--	------	------

	+13.26		15.4	81.2
--	--------	--	------	------

	+13.26		15.58	81.02
--	--------	--	-------	-------

	+14		12.4	84.2
--	-----	--	------	------

	+23		7.2	89.4
--	-----	--	-----	------

	+28		5.0	91.6
--	-----	--	-----	------

	+46.6		5.5	91.1
--	-------	--	-----	------

	+75		11.2	85.4
--	-----	--	------	------

Lt.

C.

Rt.

Top N. End Conc. Ctr. Pier of Bridge Edgerton St. & C.R. Bridge
Note: These levels are 0.43 higher than
the Mississippi St. levels.

Ground

Flow Line 30" Conc. Cully

Sta	+	π	-	Elev
		896.60		
1	+78.74		15.4	81.2
	+78.74		15.8	80.8
2			13.2	83.4
	+50		13.3	83.3
	+59.08		12.4	84.2
3			10.7	85.9
	+50		10.2	86.4
4			10.9	85.7
	+36.55		10.0	86.6
	+54.5		9.8	86.8
	+64		9.9	86.7

Flow Line 30" Long. 64 N.

Ground.

Note: Drainage seems to spread
out to the N.W. and W. to Edgerton St.
From Sta 4+25 then thru X Drain. & levels are
not always at the low point. From
Sta. 4+25 West.

at End of wing walls.

at End of Barrel.

} Flow Line

Sta	+	π	-	E/CV
		896.60		
4	+64		2.2	94.4
T.P.	12.86	905.53	2.93	892.67
	+80		4.6	00.9
5	+03.7		4.0	01.5
	+25		3.2	02.3
	+42		7.6	97.9
	+42		17.7	87.8
	+68		17.5	88.0
6			14.5	89.0
	+40		14.9	90.6
	+70		13.0	92.5
7	+09.1		11.7	93.8
T.P.	9.03	912.49	1.07	904.46

Top H.W.

= R Centerville Rd.

Top H.W.

End Barrel Flow Line

Top Timber

Sta	+	π	-	Elev.
		913.49		
7	+35.7		17.9	95.6
	+68		17.1	96.4
8			15.4	98.1
	+29.1		15.8	97.7
	+63		15.4	98.1
9			13.2	00.3
	+47		11.7	01.8
	+93.5		9.5	04.0
10				04.6 03.9
	+31			04.1
	+64			04.7

Lt.

2

Rt.

Flow Line End Barrel

98 48 ^v 9 5 1 0 ^v 5 7 11 ^v 5 ^v 10 ^v
 $\frac{42}{100}$ $\frac{48}{50}$ $\frac{51}{24}$ $\frac{48}{11}$ $\frac{69}{7}$ $\frac{82}{3}$ $\frac{96}{2}$ $\frac{89}{3}$ $\frac{88}{5}$ $\frac{72}{9}$ $\frac{65}{20}$ $\frac{55}{50}$ $\frac{53}{100}$ $\frac{49}{150}$ $\frac{47}{200}$

Reverse sides
 $\frac{47}{100}$ $\frac{48}{33}$ $\frac{54}{24}$ $\frac{65}{11}$ $\frac{74}{8}$ $\frac{82}{2}$ $\frac{94}{1}$ $\frac{94}{1}$ $\frac{94}{1}$ $\frac{82}{1}$ $\frac{67}{7}$ $\frac{50}{9}$ $\frac{51}{14}$ $\frac{50}{46}$ $\frac{38}{100}$
 Reverse sides

$\frac{34}{100}$ $\frac{43}{50}$ $\frac{46}{21}$ $\frac{46}{8}$ $\frac{48}{6}$ $\frac{88}{3}$ $\frac{88}{4}$ $\frac{70}{5}$ $\frac{59}{8}$ $\frac{51}{19}$ $\frac{50}{63}$ $\frac{45}{100}$ $\frac{42}{100}$

Sta	+	T	-	Elev	
		913.49			
11				04.6	04.3
	+50			06.9	04.7
12				06.6	05.1
	+50			06.4	05.8
13				05.9	
T.P.	804	915.55	5.98	907.51	
	+53.0			06.4	
	+69				
14				06.4	
	+50			06.9	
15				07.1	
	+50			07.2	

Lt.

R.

Rt.

04.3

0

$$\frac{35}{100} \quad \frac{37}{85} \quad \frac{41}{55} \quad \frac{44}{90} \quad \frac{50}{7} \quad \frac{92}{2} \quad \frac{89}{5} \quad \frac{50}{18} \quad \frac{54}{60} \quad \frac{44}{100}$$

$$\frac{38}{100} \quad \frac{41}{32} \quad \frac{46}{8} \quad \frac{88}{5} \quad \frac{88}{2} \quad \frac{66}{5} \quad \frac{37}{15} \quad \frac{44}{58} \quad \frac{41}{58} \quad \frac{39}{100}$$

$$\frac{35}{100} \quad \frac{37}{60} \quad \frac{38}{32} \quad \frac{42}{9} \quad \frac{84}{4} \quad \frac{84}{2} \quad \frac{69}{2} \quad \frac{39}{14} \quad \frac{45}{58} \quad \frac{41}{58} \quad \frac{38}{58}$$

$$\frac{35}{100} \quad \frac{40}{52} \quad \frac{39}{51} \quad \frac{44}{8} \quad \frac{77}{4} \quad \frac{77}{2} \quad \frac{71}{5} \quad \frac{37}{19} \quad \frac{45}{63} \quad \frac{40}{100} \quad \frac{36}{100}$$

$$\frac{38}{100} \quad \frac{37}{49} \quad \frac{40}{23} \quad \frac{36}{8} \quad \frac{76}{3} \quad \frac{76}{3} \quad \frac{32}{8} \quad \frac{40}{22} \quad \frac{38}{66} \quad \frac{36}{100}$$

Top N. End Gully.

(10.04 FL. 24' W.)

1.5' ↗

$$\frac{63}{100} \quad \frac{63}{75} \quad \frac{59}{32} \quad \frac{62}{4} \quad \frac{92}{3} \quad \frac{92}{1} \quad \frac{74}{5} \quad \frac{57}{26} \quad \frac{57}{60} \quad \frac{58}{100} \quad \frac{57}{100}$$

105.55

(F.L. 24' G.M. 2')

$$\frac{60}{100} \quad \frac{61}{57} \quad \frac{62}{18} \quad \frac{51}{8} \quad \frac{92}{25} \quad \frac{92}{15} \quad \frac{92}{2} \quad \frac{78}{7} \quad \frac{58}{22} \quad \frac{60}{54} \quad \frac{53}{50} \quad \frac{51}{50}$$

$$\frac{63}{100} \quad \frac{58}{45} \quad \frac{66}{17} \quad \frac{57}{4} \quad \frac{87}{2} \quad \frac{87}{2} \quad \frac{87}{2} \quad \frac{77}{6} \quad \frac{52}{15} \quad \frac{55}{55} \quad \frac{47}{100} \quad \frac{49}{100}$$

$$\frac{60}{100} \quad \frac{60}{51} \quad \frac{64}{21} \quad \frac{59}{3} \quad \frac{65}{1} \quad \frac{85}{2} \quad \frac{85}{6} \quad \frac{54}{21} \quad \frac{56}{61} \quad \frac{54}{100} \quad \frac{49}{100}$$

$$\frac{60}{90} \quad \frac{58}{51} \quad \frac{61}{22} \quad \frac{56}{5} \quad \frac{84}{15} \quad \frac{84}{15} \quad \frac{57}{5} \quad \frac{54}{18} \quad \frac{53}{50} \quad \frac{47}{100}$$

Sta.	+	π	-	Elev
		915.55		
16				07.1
	+50			07.3
17				07.5
	+30			07.6
	+34.55		8.1	07.5
B.M.			6.43	909.12
18				07.3
19				07.5
20				07.3
21				07.3
J.P.	5.16	915.58	5.12	910.49
22				08.5
23				08.5

Lt.

K

Bt.

$$\frac{54}{85} \frac{54}{60} \frac{58}{18} \frac{55}{4} \frac{85}{1} \frac{85}{2.0} \frac{57}{5} \frac{54}{26} \frac{5.5}{58} \frac{5.0}{100}$$

$$\frac{56}{100} \frac{56}{82} \frac{54}{46} \frac{60}{76} \frac{55}{4} \frac{83}{3} \frac{83}{4} \frac{65}{14} \frac{59}{58} \frac{61}{100}$$

$$\frac{63}{100} \frac{58}{58} \frac{59}{26} \frac{56}{4} \frac{81}{2} \frac{81}{1} \frac{81}{3} \frac{66}{7} \frac{60}{27} \frac{66}{45} \frac{57}{100}$$

$$\frac{80}{5} \frac{6.2}{29} \frac{64}{63} \frac{64}{100} \frac{5.3}{100}$$

L. Road.

Top 5. End Gorge. X.D. mid S.W. sta. 17+34.55

83

5.3

8182

5.1

8371

5.2

71

Sta	+	π	-	Elev
		915.58		
24				08.4
25				08.5
26				08.2
27				08.5
T.P.	4.93	915.92	4.59	910.99
28				08.3
29				08.4
30				08.7
31				08.9
32				09.2
33				08.1
T.P.	5.64	916.74	4.82	911.105
34				08.1

Lt

E

Et

E Road

7.2

5.2

7.17.4

4.8

7.17.6

4.9

7.57.290.5
5.07.06.75.07.81.18.6

5.4

Sta	+	π	-	Elev
		916.74		08.1
35				0
36				08.6
37				08.5
38				08.7
B.M.		3.13		913.61 (912.75)

LT

E

RT


8.68.1

5.3

8.28.0

4.7

Top Elec. Conduit N.W. Cor. Ho. of S.E. Cor. Arcade & Mississippi St.

 

Profile Levels

Proposed Ditch Relocation

Mississippi Str.

A Line = Location on
Hiawatha + Orchard Str

B Line = Lots 6 & 7 Block 2
" 6 & 7 Block 3

Sta	+	π	-	Elev
B.M	12.15	914.79		902.64
	5.77	917.07	3.49	911.30

10+31

+42

11

+50

12

+50

+94

Δ Pt.

13

+03

+50

14

£

Top Drill/hole £ Miss + Edgerton

12.9

12.7

12.6

12.1

11.8

11.3

11.1

8.8

6.7

7.5

7.2

Sta + π - Elev

912.07

14+50

15

+50

16

+50

17

+50

18

+50

19

+32

+44

Rd Ditch

4.02 913.01

4

6.4

4.9

3.4

3.4

5.0

5.3

5.5

6.1


6.7

6.7

7.7

9.2

Spk in P.P on N.E Cor Lot 12

 

B Line

10' East of West Property line of

Lots 6 & 7 Block 2 "

6 & 7 " 3

Sta	+	X	-	Elev
T.P	4.05	917.06.		913.01
10+42				044
+52				08.9
11				08.9
+10	P.I			09.0
+50				09.5
12				09.6
+50				09.8
13				09.9
+50				10.1
14				09.8
+29	Pitch along Farm Rd.			09.5
+33				07.9

2

12.7

8.2

8.2

8.1

7.6

7.5

7.3

7.2

7.0

7.3

7.6

9.2

Sta	+	π	-	Elev
		717.06		

14+37				09.7
-------	--	--	--	------

+50				09.7
-----	--	--	--	------

15				09.6
----	--	--	--	------

+50				09.6
-----	--	--	--	------

16				09.6
----	--	--	--	------

+50				09.2
-----	--	--	--	------

17				09.2
----	--	--	--	------

+25	No Prop Line			08.8
-----	--------------	--	--	------

+36				08.4
-----	--	--	--	------

+38				07.9
-----	--	--	--	------

+45				09.8
-----	--	--	--	------

158 = 9+15.40 E Mississippi 10.30
 3.48 714.77 5.77 711.29

2

7.4

7.4

7.5

7.5

7.5

7.9

7.9

8.3

8.7

9.2

7.3

6.8

Sta

+

π

-

Elev

12.13

902.64

2

