

OFFICE OF COUNTY ENGINEER
RAMSEY COUNTY, MINN.

PLAN

Survey

10TH ST. N.W.

From I 694 To 3RD AVE NW.

Road Acc't. No. 12 8 45

On 12

Date Filed 1-21-82

File Bk 37

ML
LPD
MR
RC

SEPT 8, 78


SUNNY 82° 1

ALIGNMENT OF

10TH ST N.W.

STA 0+00 TO 31+00

STA	PT	AL	AR	DATA
4+68.85	PT		0°00'	
4+50			1024'50" ✓	
4+00			5°09'50" ✓	
3+50			8°54'50" ✓	Δ 55°43'30"
3+00			12°39'50" ✓	D=15°
2+99.28	PI			T=201.93
2+50			16°24'50" ✓	L 371.5
2+00			20°09'50" ✓	R=381.97
1+50			23°54'50" ✓	
1+00			27°39'50" ✓	
0+97.35	P.C		27°51'46"	

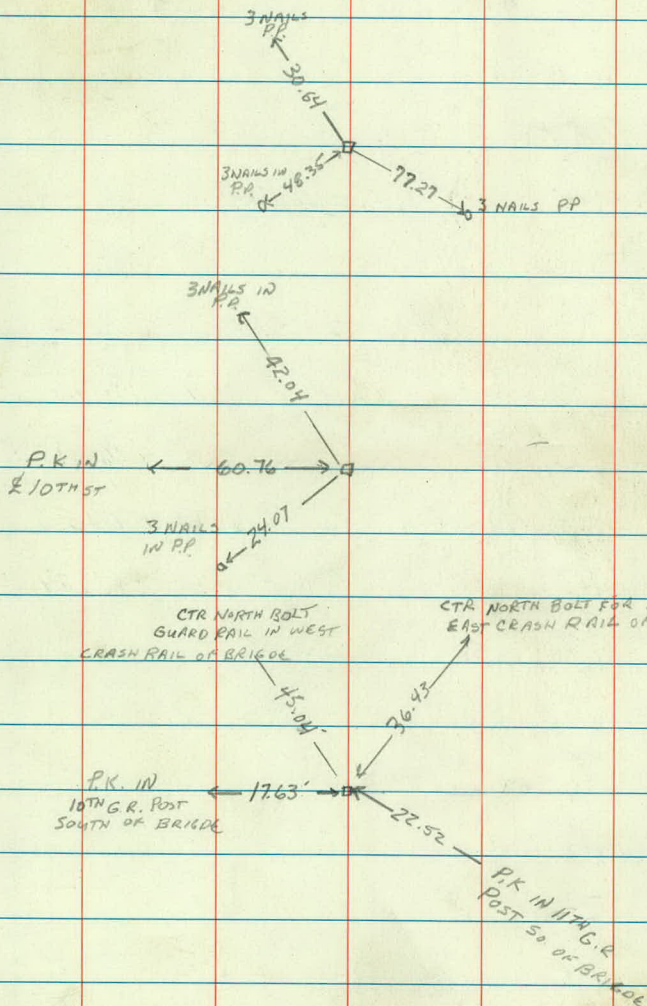

STA	POINT	ALT	APT	CURVE DATA
-----	-------	-----	-----	---------------

13+19.43	P.T.			
----------	------	--	--	--

$A = 35^{\circ} 11' 05''$

$R = 476.71$

$T = 151.15$

11+77.84	P.I.			
----------	------	--	--	--




$L = 292.74$

10+26.69	P.C.			
----------	------	--	--	--

ML
LPD
MR
RC

SEPT 8, 18
SUNNY 80°

3

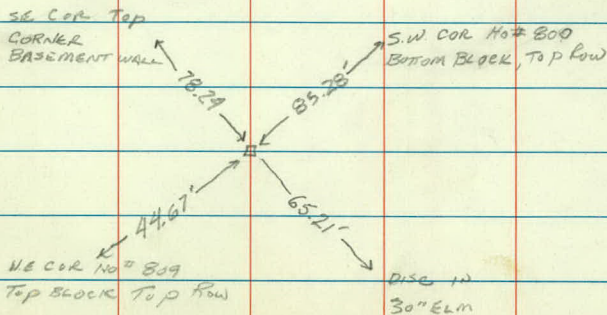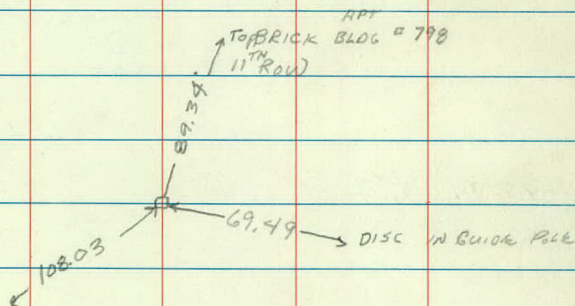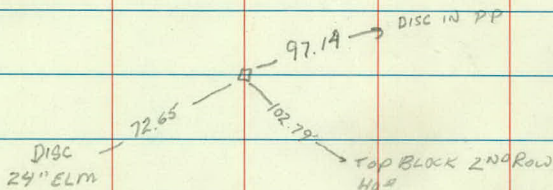

POINT	AKI	Δ R _T	DATA
-------	-----	------------------	------

19+74.21	P.T		
----------	-----	--	--

17+47.74	PI		
----------	----	--	--

$$\Delta = 42^{\circ} 55' 21''$$

$$R = 636.15$$

$$T = 250.09$$

$$L = 476.56$$

14+97.65	P.C.		
----------	------	--	--

3 NAILS
PP

20.87

85.03

3 NAILS
PP

83.08

Top
NW COR BOTTOM BRICK
LUMBER COMPANYNAIL +
WASHERS PP


87.56

61.97

NAIL +
WASHERS
PP

63.32

NAIL +
WASHERS
PP

 

M.L.
M.R.
J.T.

AUG 30, 78

Sunny 75°

1

BENCH MARKS

10TH ST NW

T.H. # 694 to 5TH AVE

STA	+	π	-	ELEV
BM ₁	3.33	897.84		894.51
T.P. 2	0.95	890.12	8.67	889.17
BM ₃	3.62	889.58	4.16	885.96
BM ₄	3.75	891.01	2.32	887.26
BM ₅			4.39	886.62
T.P. 6	4.96	891.27	4.20	886.81
BM ₇	4.15	892.72	2.70	888.57
BM ₈			2.73	889.99
BM ₉	4.37	891.55	5.54	887.18
BM ₁₀	1.39	888.73	4.21	887.34
BM ₁₁	3.08	888.59	3.22	885.51
BM ₁₂	4.79	888.34	5.04	883.55
BM ₁₁	2.89	888.40	2.83	885.51
BM ₁₀	4.37	891.72	1.05	887.35
BM ₉	4.16	891.34	4.54	887.18
BM ₇	2.65	891.23	2.76	888.58
BM ₆	3.97	890.80	4.40	886.83
BM ₄	2.28	889.55	3.53	887.27
BM ₃	4.59	890.56	3.58	885.97

M.L.
M.R.
J.T.

AUG 30, 78
SUNNY 75°

9/2/88 BJ

→ VOID — SEE LLRD. 1988 Const.
DISC S.E. COR. BRIDGE #9389

1st BOLT ON S.E. TWISTED END GUARD RAIL

Top HYD NE COR 5TH AVE & 10TH N.W

Top HYD 22+46 LT 23'

N.E. COR BOTTOM STEP N.B. LUMBER CO

P.K. NAIL & 19+00

Top HYD N.E. COR 7TH AVE & 10TH ST N.W

NE COR BOTTOM STEP H₆ #715

SPIKE IN P.P. 12+37 LT 32'

SPIKE IN P.P. 9+51 RT 25'

Top HYD 6+03 RT 22'

SPIKE IN PP 4+41 LT 27'

STA	+	π	-	ELEV
		890.56		
T.P. ₂	8.48	897.65	1.39	889.17
B.M.			3.14	894.51 (894.51)
	7.74	891.29	1.55	883.55
			1.25	890.04

ML
DS
BW
MR

APR 7, 20

GAS MAIN ELEVATIONS (Top)
10TH ST

	+	∇	-	FLV
B.M	4.89	892.07		887.18
			7.75	884.32
B.M.	3.15	888.66		885.51
			7.71	880.95
			8.24	880.42
			9.19	879.47
			5.14	883.52
			8.18	880.48
				883.55
B.M.	7.66	894.84		887.18
			10.00	884.84
			10.78	884.06
B.M.	2.76	891.33		888.57
			9.44	881.89
			9.21	882.12

DESCRIPTION

SPIKE IN PP 12+37 LT
12" To SOUTH ON 8TH AVE

Top HYD 6+03 RT

7+75

5+80

4+40

SPIKE P.P. 4+41 LT

BELL TELL 4+40

SPIKE IN PP 12+37 LT

12" SB' RT ON 8TH AVE

13+80

Top HYD SE CR 7TH AVE & 10TH ST

18+05

18+40

Sta.	+	π	-	Elev
B.M.	2.37	889.63		887.26
			7.30	882.33
			7.20	882.43
B.M.	0.20	886.16		885.96
			10.04	876.12
			9.96	876.20
Bm	2.75	888.71		885.96
			7.69	881.02
			10.20	878.51

H.P.
J.A.
B.W.

Description

Top Hyd 22+46 Rt 23

Top Gas Main S.W. COR 6th & 10th St N.W.

Top Hyd 5th Ave & 10th St N.W.


TOP GAS MAIN RT STA FRONT HO[#] 339

(27+20)

Top Hyd 5th Ave & 10th St

24+30

29+85

 

M.L.
MR
JT


AUG 30, 78

SUNNY 75°

3

SPIKE IN PP 4+41 LT

SPIKE IN PP 2+45 RT 40'

 

M.L
R.C
MR

SEPT 13, 78
Cloudy 63°

1

25

TOPOGRAPHY

10TH ST N.W

0+00 - 31+00

LT

RT

1+00

+96 C.B.
14

RD 16 RD 15

+96 C.B.
14

+100 PP
14

+59 END WINGWALL

+77 END WINGWALL

+58 END BRIDGE
13

+58 BEG G.R.
16

+65 BEG CURA 16
+65 BEG G.R. 21
+65 END BRIDGE 16

+58 BEG CURA 15
(B624)

+50

+48 SURGE BASIN
66

+00 C.B. 21
+00 S.W. 16-21

RD 16 RD 15

+00 S.W. 15-16

+00 C.B. 16


0+00

ML
RC
MR

SEPT 12, 78
Cloudy 62°

±

2

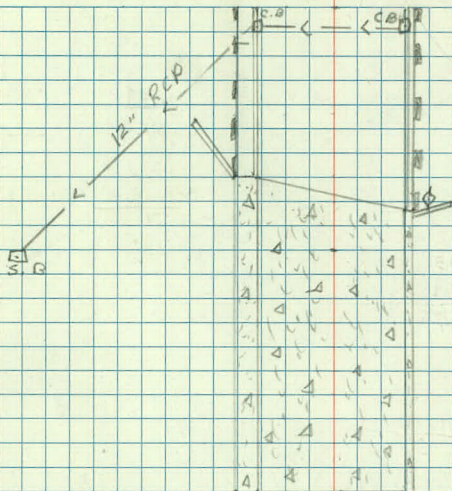

Lr

Rt.

3+50

+50 FEN
79

R₀ R_n
17

+50 END 50 EDGE R₀

33

+30 50. EDGE R₀
40

3+00

+00 FEN
32

+93 END 12" RCP

47

+91 ER
18

+06 BEG Bush

+00 57
50 EDGE R_n
50

+79 PP
75

+73 M.H.
58

+57 BEG FEN.
35

+63 BR
15

+63 S.D.
32

+63 ER
45

+50

+30 ER MED
14

+46 PP
40

+21 END CURB +21 ER
109

+15 POR MED
36

+10 POR
11

+02 BR MED
47

+18 PP
31

+18 RAN. TIL. ROAD
96

+13 ER
18

+13 BEG FENCE
35

2+00

R₀ R₀

+91 BEG MED
15

+86 POR
28

+75 END FENCE
120

+75 ER
45

+66 END G.R.
35

+70 BR
65

+70 END CURB
(96)
65

+50

+50 G.R.
23

+50 POR
19

+46 POR
50

+45 END G.R.
50
+34 ER
90

+32 G.R.
18

+32 BR
16

+32 LITE BIL
19

+08 BR
15

+08 G.R.
18

1+00


+00 G.R.
20

R₀ R₀
16 15

+00 G.R.
17

④

3

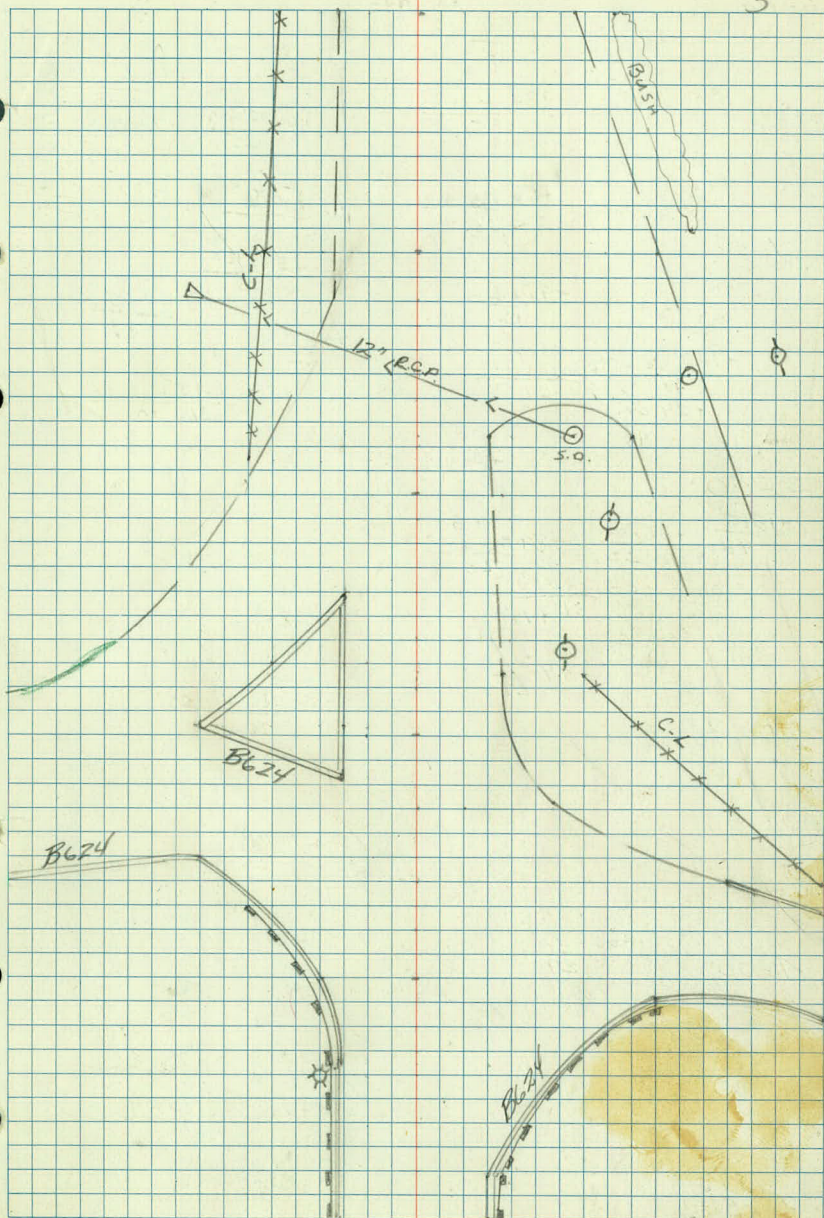

LT

E

RT

6+00

✓
+95 END
WOODS
30-51

✓
+95 PP
25
✓
+82 COR FEN
51
✓
+63 BEG WOODS
← 33

R₀ R₀
13 13

✓
+83 8" PINE
48 ✓
+69 15" CMP
25 ✓
+73 NW COR HO
59 ✓

+50

✓
+95 ER
13

✓
+48 15" CMP
28

✓
+48 20" BOX
37

✓
+30 POR
27 ✓
+30 BEG CURB
27
+24 BR
43

✓
+44 PP
22

✓
+23 END WOODS
21-70

✓
+00 M.N
1

5+00

✓
+98 ER
48

✓
+89 POR
28

✓
+89 BEG CURB
28
✓
+83 COR FEN
31

✓
+75 BR
14

✓
+54 PP
27

R₀
13

✓
+50 BEG WOODS
26-62

+50

✓
+27 PP
25

✓
+20 RAW TIE

✓
+00 FEN
29

✓
+00 BUSH
29

4+00

R₀ R₀
16 16

✓
+75 BUSH
40


✓
+75 50 EDGE RD
25

3+50

✓
+50 FEN
29

R₀
17

4

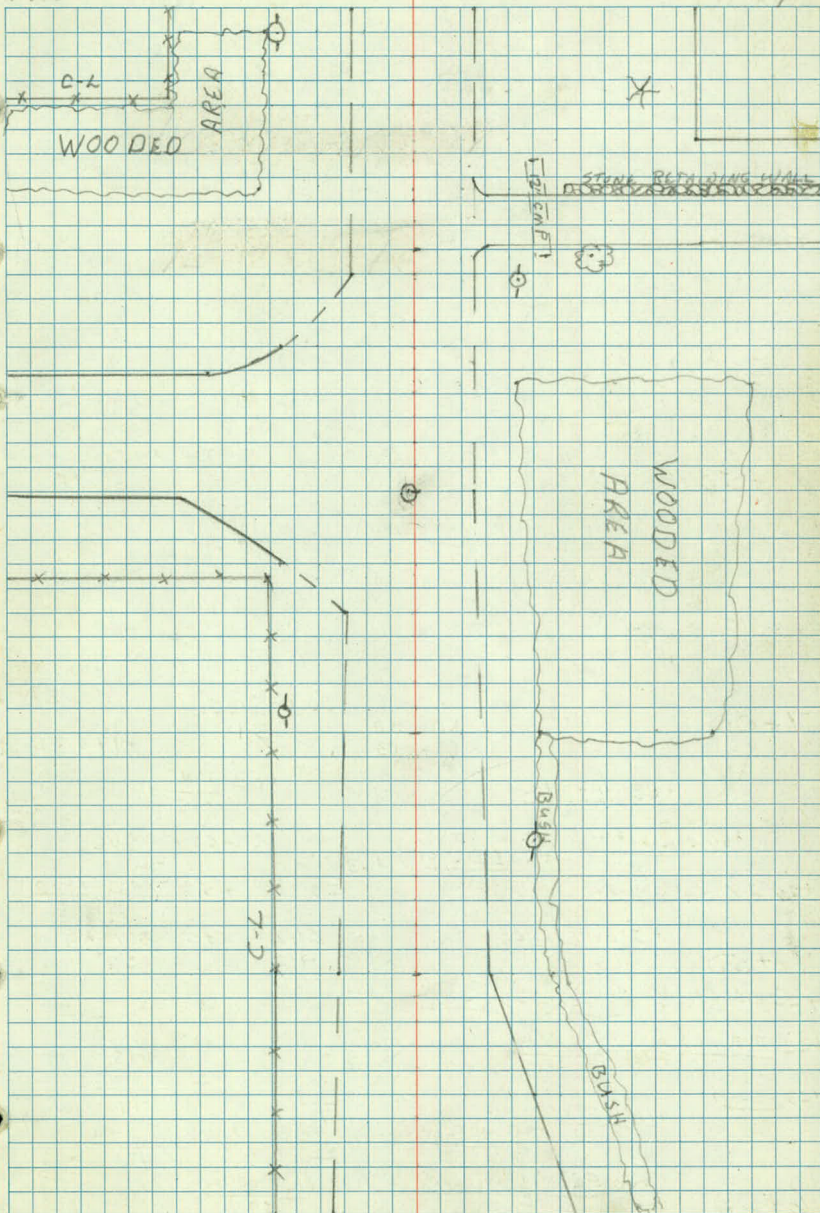

LT
+50 SECOR #818 2

KT

+50
+38 1" ASH
37
+21 SW HO #818
+21 10" ELM
44
+11 10" ELM
37

+49 & ROCK DRIVE 10'

+43 COR GARAGE
46

+17 & DIRT DRIVE 10'

8+00
+00 END SPILLWAY
20-32 RD RD
13 14

+83 18" CMP
32 ✓ BIT
+75 BEG SPILLWAY
20

+95 PP
24

+84 18" CMP
27

+67 END WOODS
22-43
+67 PP
27

+67 BEG. WOODS
24-59
+55 6" TWINE ELM
71

+55 6" TWINE
78
+55 10" TWINE ELM
75

+50

+33 BEG. WOODS
24-43

+41 & ROCK DRIVE 13'

+27 10" PINE
73
+27 24" ELM
65

+08 COR HO #912
62

+22 BUSH
43

+27 10" PINE
52

+21 COR HO 909
92
+03 COR HO 909
82-92

+08 18" WILLOW
40

+18 6" PINE
46

+00 E. BUSH
34

+94 COR HO 909
82

7+00

RD RD
13 13

+83 YARD LT.
34

+83 PINE
45

+66 COR HO #912
64

+60 & BIT DRIVE 10'

+63 PP
23

+66 8" PINE
46

+54 24" COTTONWOOD
60

+57 PASSWOOD
46

+50

+51 END FENCE
51

+51 6" PINE
45

+55 8" PINE
55

+25 4" ELM
49

+29 3" ELM
50

+34 2" ELM
50

+22 7" TWINE ELM
49

+18 3" ELM
50

+35 M.H.
2

+33 PINE
45

+23 6" ELM
50

+11 10" POPEL
53

+08 4" ELM
51

+08 ARC P.
27

+03 4" YD
22

+06 BEG. BUSH
34

6+00

+00 FENCE CYCLOPS
51

+02 NE COR HO #
59

RD RD
13 13


ML
MR
JT
RD
RW

Lt

Rt

8-23-78
Cloudy 76°

5

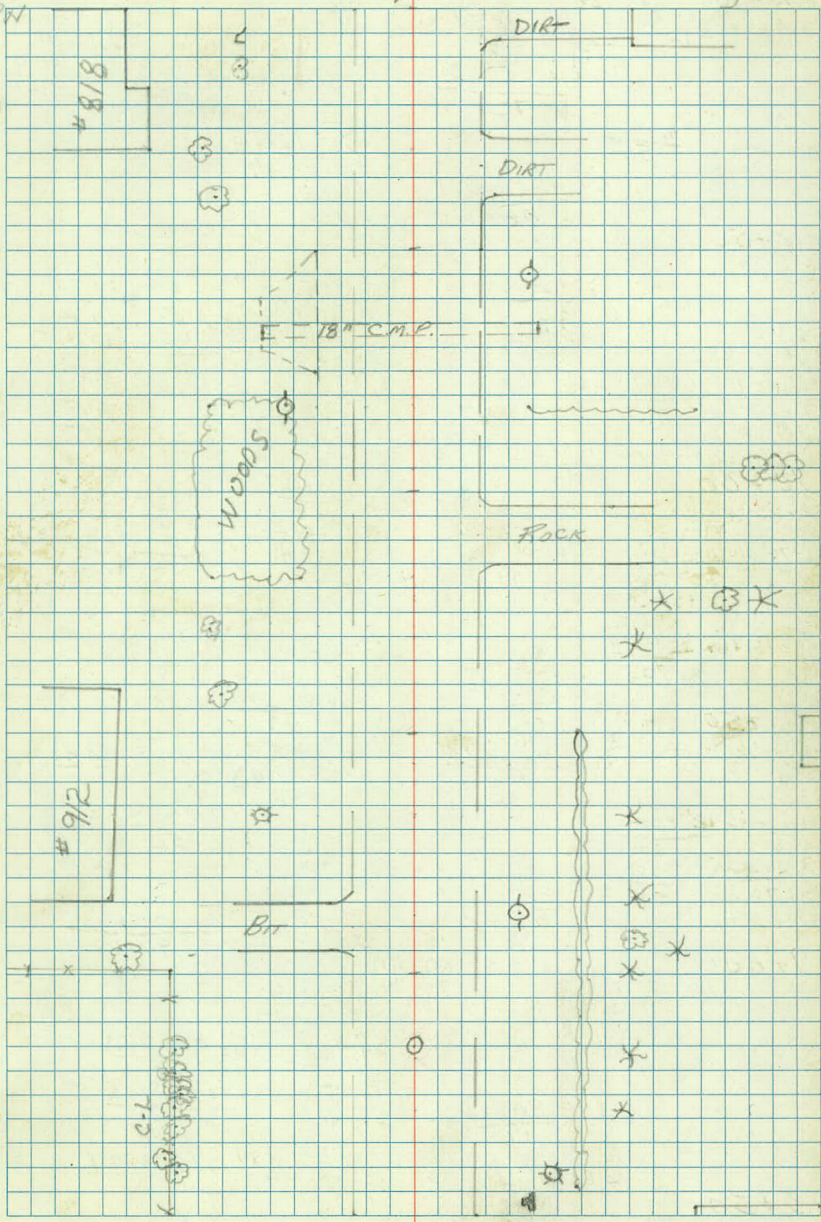


11+00 [✓] +100 BUSH 28 RD 14 RO
 +92 COR #800 71-81 [✓] +78 SW HO #800 72 +64 BR 21 +86 POR 37 +91 TELE M.H. 41
 +70 6" ASH 50 +62 12" ELM 39 +70 BUSH 36
 +54 9" LOCUST 28 +52 20" ELM 60
 +50 +23 3" LOCUST 44
 +09 SE HO #812 71 +12 END S.W. 34
 +03 NE HO #809 39
 10+00 [✓] +100 10" ELM 44 RD 13 RD 14
 +86 COR HO #812 +84 10" ELM 44 +97 BUSH 26 +85 BUSH 27
 +73 SW HO #812 +76 18" BOX 44 +84 BEG 2' SW. 36-41 +75 NW COR #809 41
 +66 2" PINE 52 +61 BUSH 31
 +64 22" ELM 70 +57 MH 4 +51 PP 25
 +50 +56 M.H. 23 +50 8" PINE 49
 +97 4" DRIVE 18' +52 8" MAPLE 37 +45 PLANTER 41
 +36 12" ELM 80 +30 NE HO #811 50
 +3. 20" ELM +36 BUSH 70 52 +30 PP 27 +06 BUSH 24
 +03 4" CONC SIDEWALK 24-49
 9+00 RD 13 RD 14 +95 NW COR HO #811 49
 +95 BUSH 26 +88 8" MAPLE 36
 +83 6" PINE 49
 +78 BUSH 37 +59 COR GARAGE 46
 +61 4" DRIVE 13
 8+50

ML
MR
LT
RD RN

AUG 23-78
CLOUDY 76°

6

2

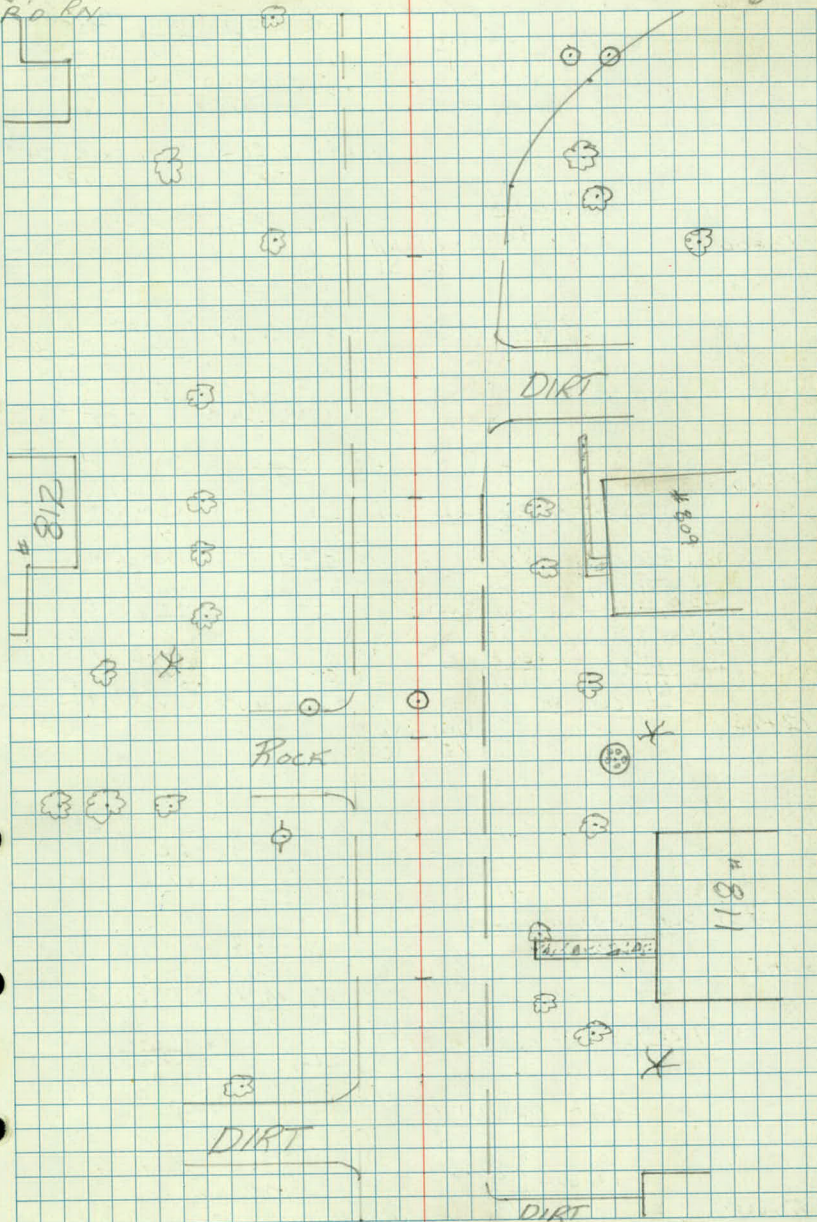

LT

RT

+50

+49 MH
35

+44 20' 6" 1
1

+48 N.W. 1/4 727
99

+40 MH
33
+38 4' PINE

+33 TWIN 20' OAK
51'

+30 12' OAK
54

+31 TRIPLE 14' OAK
68'

+08 BUSH
36

+00 BIT DRIVE 53'

13+00

RD RD
21 6

+75 4' S.W.
47

+80 END PARKING
37

+75 RETAINING WALL

+72 18' OAK
58

+61 4' S.W.
55

+67 10' PINE
62

+61 10' PINE
68

+50 12' ELM
45

+48 10' PINE
79

+50

+33 BEG. PARKING LOT
35

+40 PP
18

+44 NE COR 40' 2
94

+31 BIT CURB

+37 PP
32

+31 18' ELM
60

+33 16' ELM
60

+23 BIT DRIVE

+19 END FENCE
58

+21 8' PINE
73

+16 12' ELM
50

+10 4' PINE
65

+14 BEG BIT CURB

+00 SIGN
61

+00 BEG FENCE
61

+07 6' PINE
69

+05 6' PINE
68

+08 18' ELM
77

+00 SE COR 10' 2
51

+00 NW COR 40' 2
160

+02 10' PINE
80

12+00

RD RD
15 12

+75 BUSH
41

+75 ER
17

+61 SW COR APT BUILD.
74

+59 M.H.
45

+50 POR
31

+50

+41 M.H.
24

+38 BR
75

+44 20' BOX
55

+35 ARC LIGHT
28

+41 G.S.O.
22

+26 G.S.O.
26

+20 BIT DRIVE 13'

+20 M.H.
2

+21 2 8TH AVE

+16 M.H.
7

+02 TELE M.H.
39

+06 SE 1/4 800
79

+02 ER
55

11+00

RD RD
14

ALC
AIR
ST
RD
RD
RD

AUG 23, 78
CLOUDY 76°

LT

Q

RT

7

PARKING


Lot

BIT

APT
BLDG

BIT

8TH AVE

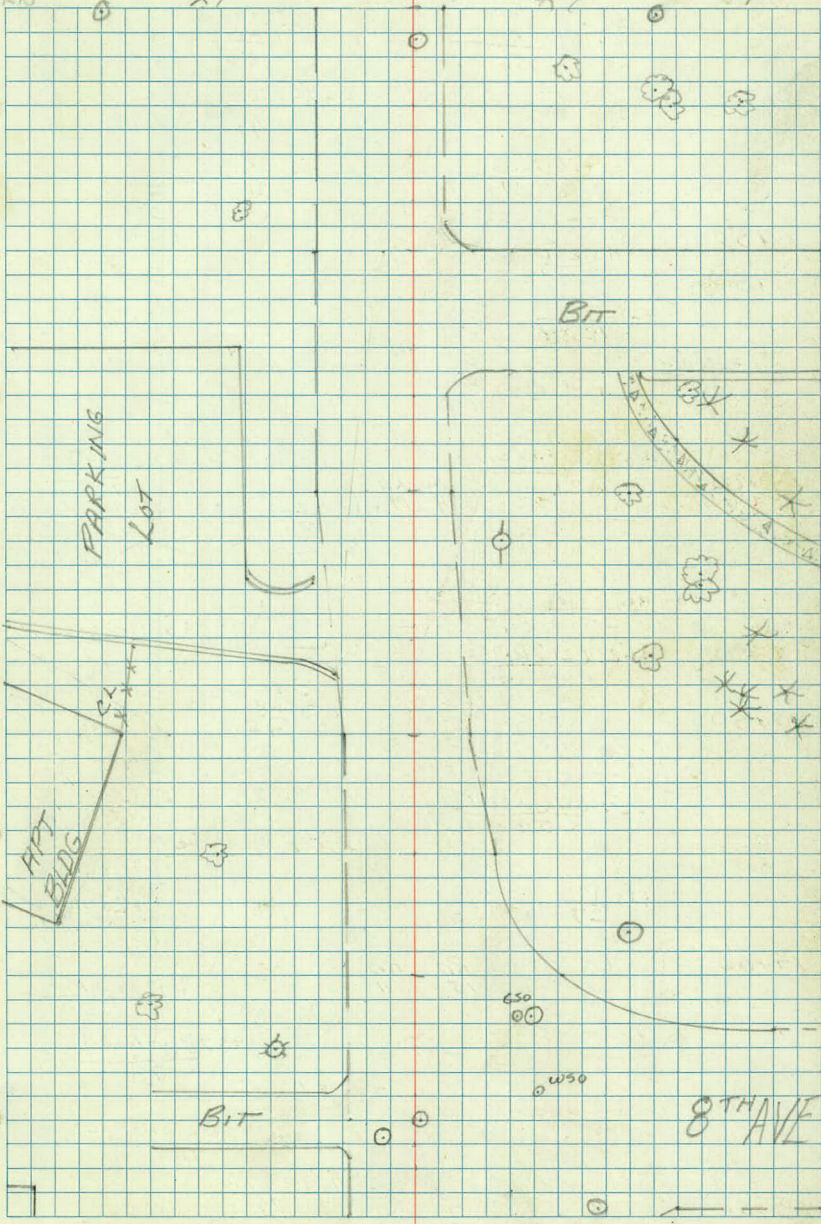

16+00

✓ RD
+98 SW No 7049
56

RD
17

✓
+79 ER
56

+84 POR
40

+56 ARC LT.
17

+66 BR
21

✓
+50 END PARKING LOT

✓
+66 36" COTTONWOOD
43

+50

45 ✓
+43 END FEN. RD RD
18 8 18

WOOD
+28 FEN.
18-34

✓
+28 MH
10

BIT
+18 DRIVE 20'

15+00

+00 END FENCE
21

RD RD
9 17 +98 BUSH
55

+07 NE No 709
77

WOOD
+82 BEG. FENCE
21

✓
+81 SKEW
29-32
BIT

✓
+61 NW COR No 709
77

+62 & 21' DRIVE

+50

✓
+39 BEG. PARKING LOT
56
+27 CHAIN FENCE
59

✓
+50 PP
42

✓
+35 & 13' DRIVE
BIT

+13 PP
27

✓
+20 NE No 75'

14+00

RD RD
15 11

+97 NW No 75'

✓
+87 NE No 727
78

DIRT
+80 & 11 DR.

✓
+75 COR NW No 727
78-100


13+50

RD RD
17 9
+59 18" OAK
79

ML
MR
JT
RD
RD

AUG 24, 78
CLOUDY 78°

7TH ST 8

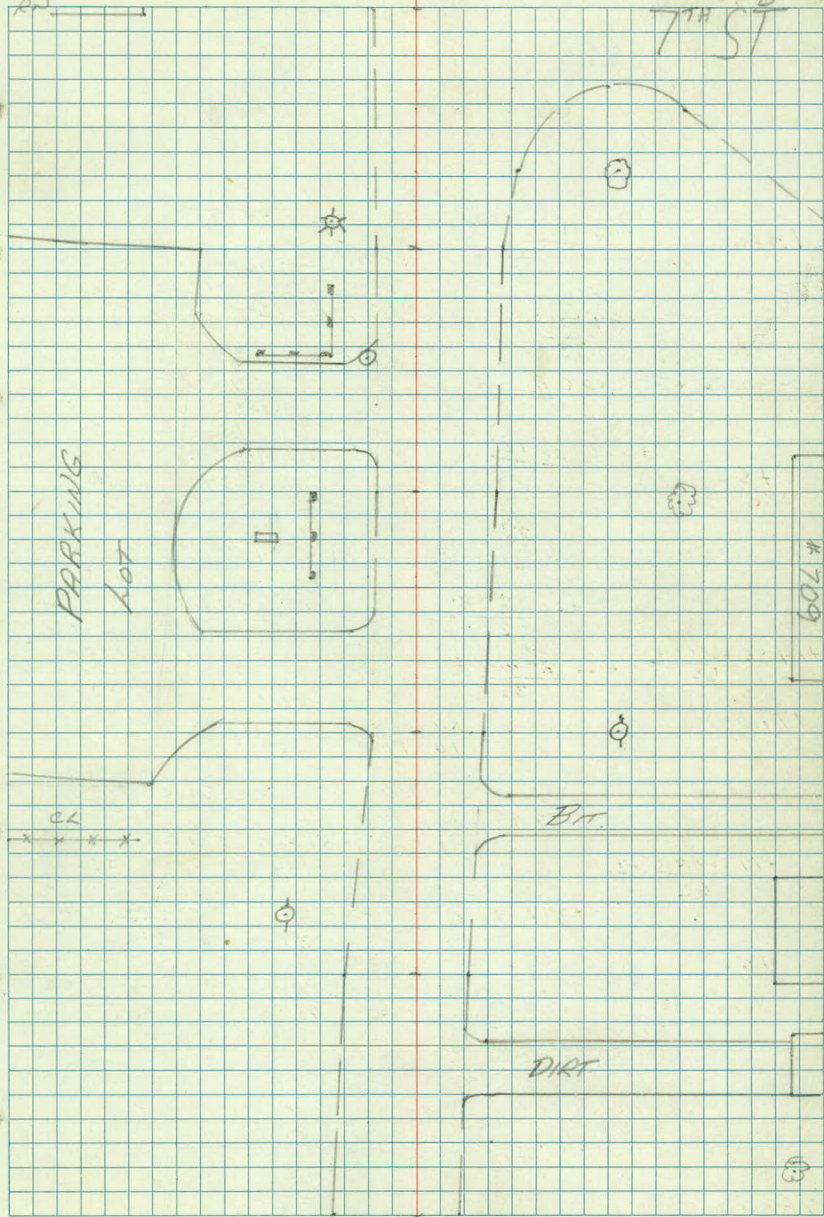

LT

RD 7 RD 18

Rt

+50

+26 PARKING LOT
80

18+00

+00 (9) WILLOW

32

+07 M.H. +00 TELE M.H.

29

RD RD 9 18+74 8" PINE+77 12" PINE+76 PARKING LOT

80

+89 PP

33

✓
63
✓ROCK+72 8" PINE+85 M.H.

64

+68 8" DR 12'+71 APPLE 8"+79 QUAD CATTANWOOD

38

+53 8" PINE

81

37

+50 8" PINE

40

+54 8" DR 18'+46 12" PINE

37

+42 N.E. HO#657

+50

+23 M.N.

34

+16 10" APPLE

84

+22 CONC 8'

23

+09 8" PINE

51

+10 8" PINE

43

+14 SE HO#664

63

+12 18" MAPLE

33

+04 NW HO#657

104

17+00

RD RD

10 17

+02 6" PINE

93

+87 9' S.W.

27-57

+89 10" APPLE

78

+81 F.P.

44

+81 NE HO#669

99

+77 SW HO#664

62

+57 DIRT 23'+58 4" DR

26

+66 ER

11

+50

+46 NW HO#669

83

+47 42" MAPLE

46

+45 PP

24

+42 PP

90

+46 16" MAPLE

52

+33 M.H.

46

+31 8" DR 11'

11

+37 FOR

30

+24 SECOR HO#704

59

+25 BR

44

+11 4' S.W.

31-53

+17 RTH AVEN NW+10 M.H.

32

16+00


RD

9

ML
MR
JT
RN

AUG 25, 78
CEN 04 80°

9

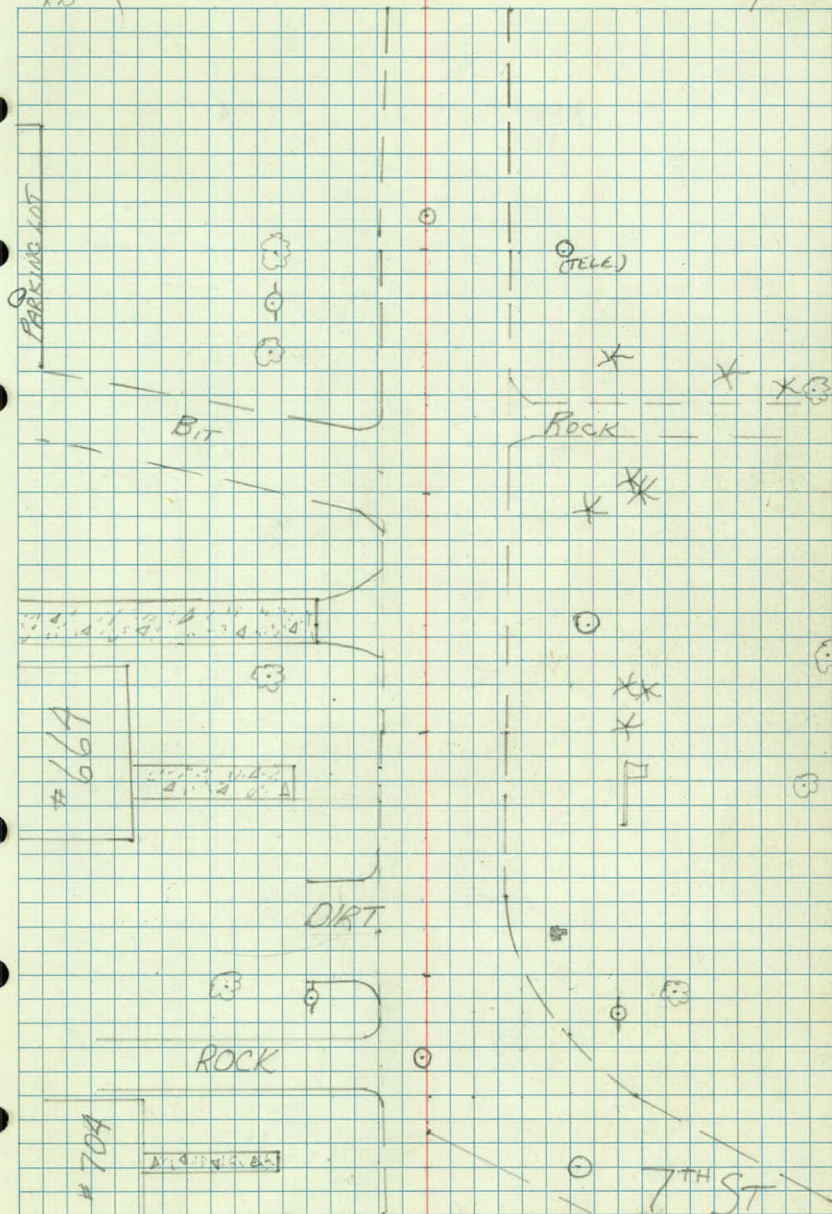

21+00

Rd Rd
19 30

+97 3/4 C&D LUMBER CO
41

+70 END TAPER
18

+60 10" COTTONWOOD
30

+50 PP
21

+50

+96 BEG CONC CURB
30
+46 BEG S.W.
30-40
N.B.
+47 SW COR LUMBER CO
40

TCAMP
MH

+17 13

+18 E.M.H.
36

+02 NE COR BUILDING
88

20+00
W.M.H.
+89 24

+70 MH 52
+70 MH 42

Rd Rd
10 30

+74 BEG TAPER
BIT

+65 PP
20

+81 NW COR BUILD
88

+50

Rd Rd
4 30

+70 G50
21

+38 PARKING LOT

+17 E RAIL

+17 E RAIL 31-84

+15 E RR TRACKS

+15 E RR TRACKS

+12 W RAIL

+12 W RAIL BIT

+89 BEG TAPER
22

19+00

+87 FEN

+95 3" ELM 22
28

+99 BUSH CB

+88 DIRT DRIVEWAY

+44 +75 PET. V.P.
35

+15 PETROLEUM SIGN

+71 M.N.
74

+69 4" ELM
92

+60 PP
18

+60 PP
114

+52 12" CMP
42 Rd
7 18


+52 12" CMP
25

18+50

M.L.
M.R.
J.T.

AUG 29, 78
SUNNY 60°

10

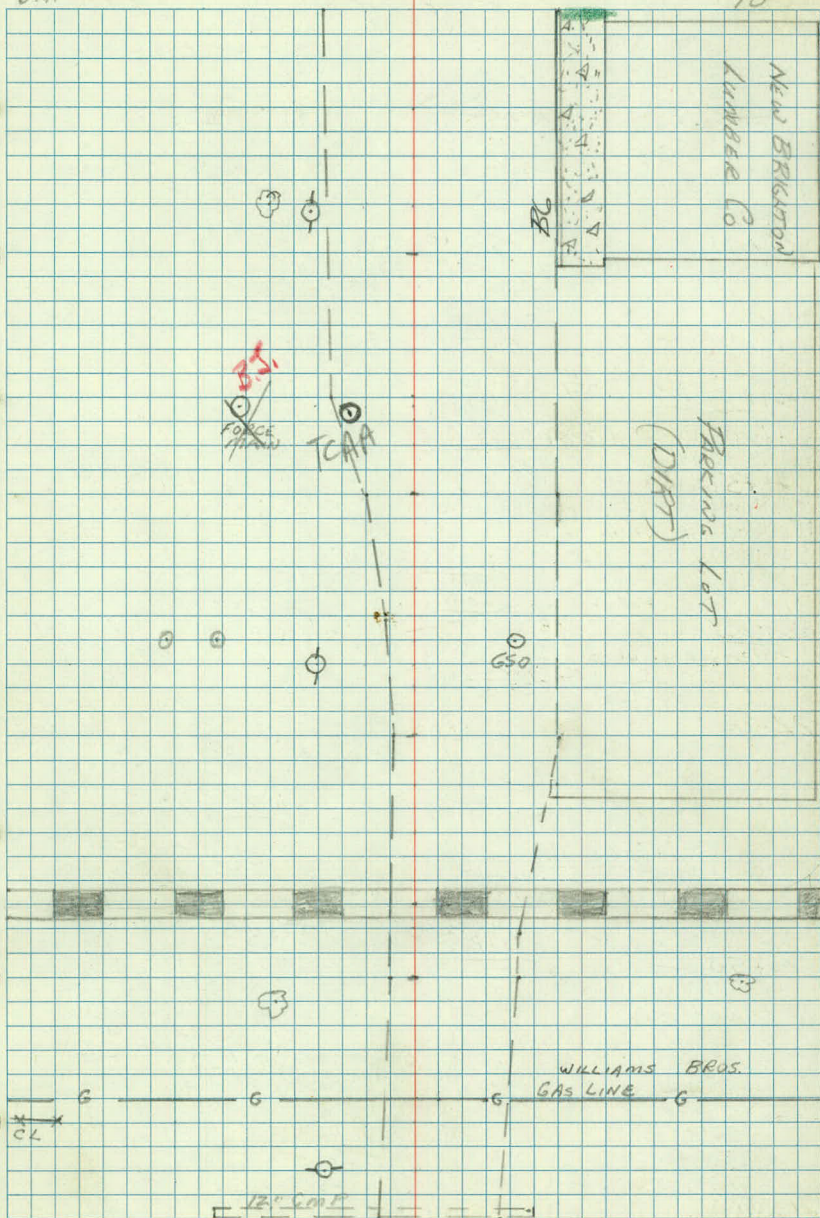

Lt

E

RT

+50

+47 BEG SM. TREES

34-37

+42 NE COR BLDG

38

+20 NW COR BLDG

38

+18 NE COR BLDG

38

+08 GSO

30

23+00

RO RO
19 30

+81 ARC LT.

21

DIRT

+76 PP

24

+60 SW

27-33

+77 CONC
SPILLWAY

39 →

+78 NW COR BLDG

39

+76 NE COR BLDG

39

+69 E DA 14'

+60 3' SW

32-43

+56 SE COR BUILDING

38

+50

+46 NYD

23

+37 WSO

10

+27 SW COR BUILDING

38

+25 N.W. BLDG

39

+11 ER

30

+27 ARC LT

31

+20 6' S.W.

39 →

+09 S.W.

30-38

+04 POR

37

+09 C.B.

42

+07 C.B.

30

+07 BEG
CONC.
CURB

42

+07 BR

42

+22 4' S.W.

35-73

+22 PARKING
LOT

18-42

+22 S.W.

28-35

22+00

RO
19

+80 E CTN AVE

+02 MH

+71 M.H.

44

+71 ER

41

+65 PP

62

+52 LIGHT POLE

92

+52 PARKING
LOT

21-42

+50 PP

22

+53 END CONC
CURB

30

+53 BR

30

+63 POR

36

+45 NE COR BUILDING

40

+35 NW COR BUILDING

40

+50

+02 SW

30-38

21+00

RO RO
19 30


M.L.
M.R.
J.T.

LT

Rt

AUG 29, 78
SUNNY 60°

11

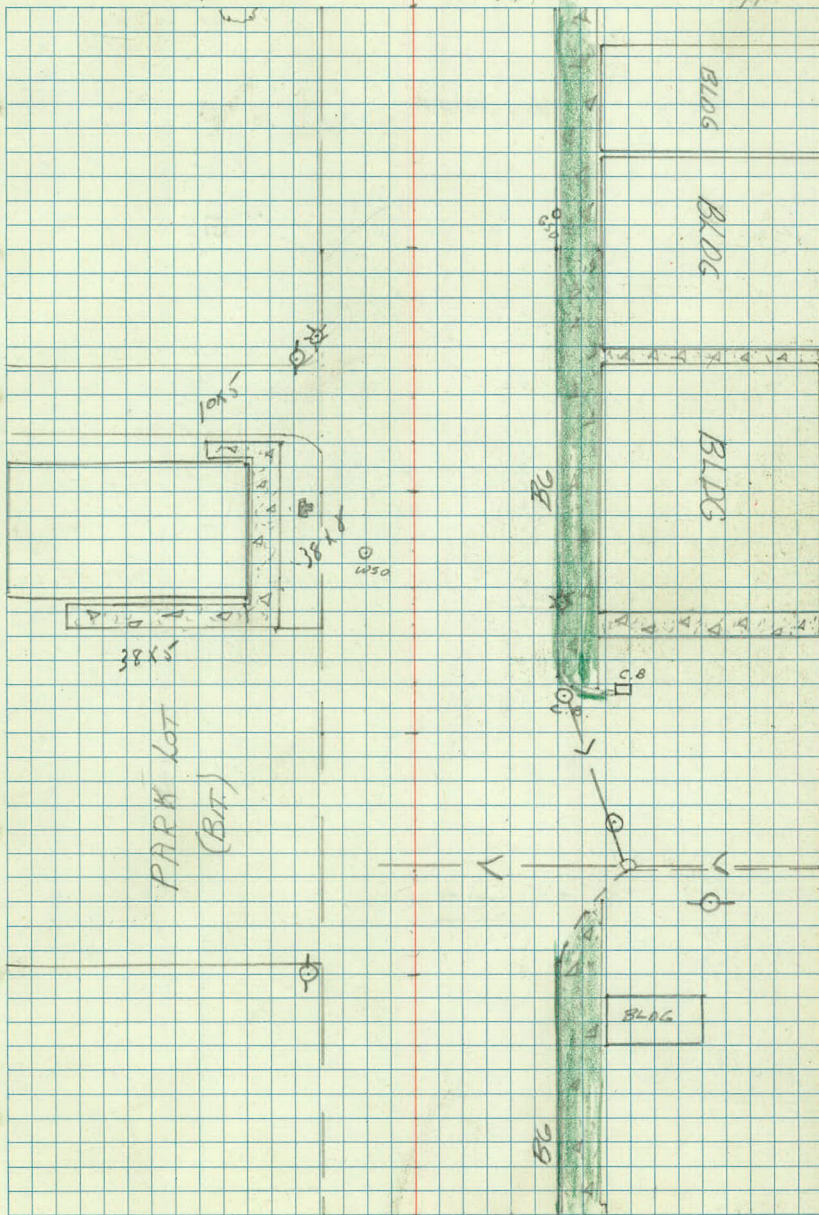

LT

RT

26+00

RO

20

RD

22

+01 CURB
33+00 GAS MED
47+65 H.H.
24+58 BEG WOODS
36-58+85 GAS MED 48
+87 M.H. 25
+85 GSO 27+84 NW COR BLDG 25
+79 GSO 2673 +76 BEG CURB
33

+54 CONC 33' DR

+48 MH
181+43 ENO CURB ISLAND 33-43
+40 M.H. 5+38 LT SIGNAL 25
+37 ER 22+33 H.H. 28
+31 CURB ISLAND 33-43

+28 POR 25

+30 BEG. S.W. 23-33

+25 BR 32

+25 BEG 6'S.W.

25+00 RW 18 (B624)

+72 BEG C4G 37
+72 ER 37
+72 C.B. 82+68 H.H. 33
+65 POR 25
+71 C.B. 30+66 S.S.W. 25
+61 LT SIGNAL 26+56 PP 65
+57 PP 27+50 BR (B6)
17+79 LT SIGNAL 39
+77 POR 32

+70 BR 30

+67 C.B. 29

+68 COR BLDG 43

+67 COR BLDG 38

+50

+42 BEG CURB
17+40 F.M.M.H.
25+40 GSO
31+21 ARCT.
21

+00 PP 25

+00 END SM. TREES

24+00

33-38

RO

17

RD

30

+98 NW COR BLDG
39+51 ARC LT.
31

23+50

M.L.
MVR
J.T.


LT

Q

Rt

AUG 29, 78
SUNNY 60°

12

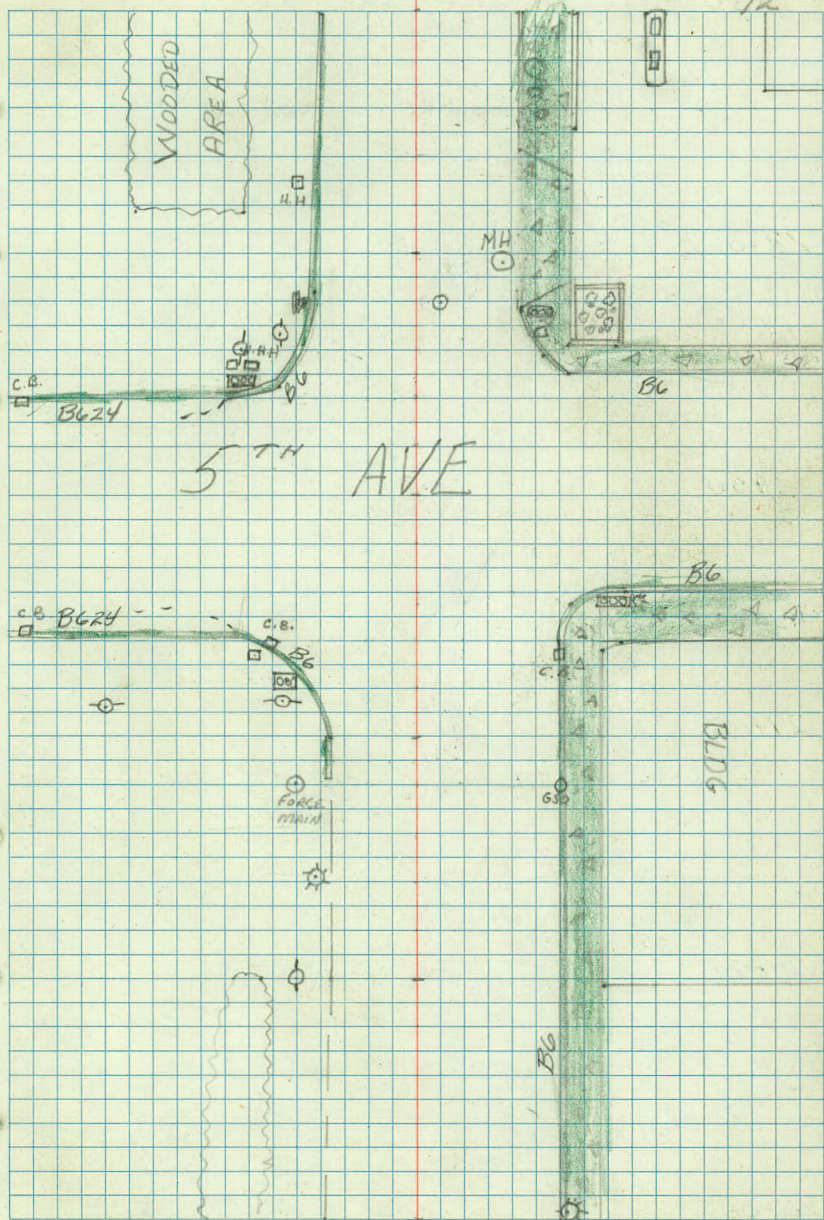

LT

RT

+50

+44 PP
29R₀
23+16 36" APRON
65+07 BEG WOODS
44-150

28+00

R₀
23R₀
10+66 BEG WOODS
22-41+53 6" POPPEL
30

+50

+52 6" POPPEL
26

27+00

R₀
23R₀
10+92 (5) 3" BOX
37+85 PP
30+58 6" BOX
57

+50

+11 60' DR+72 END CURB +72 BEG TAPER
22+72 END S.W
33-38+52 BEG S.W +70 M.N
33-38+52 WJS
33+52 END CURB
34-64+72 NE COR
BLOG
38+52 NE COR
BLOG
38+90 END WOODS
42-58+34 END CURB
21+31 PP
29

26+00


R₀
20R₀
22+47 GT PLE +45 BEG CURB
36 34-64+31 229' DR+26 GAS TANK
53+15 END CURB
32+18 GAS TANK
55+11 GAS TANK
56+11 NE COR BLOG
69

ML
LAD
MR

SEP 7 78
SUNNY 80°

13

2

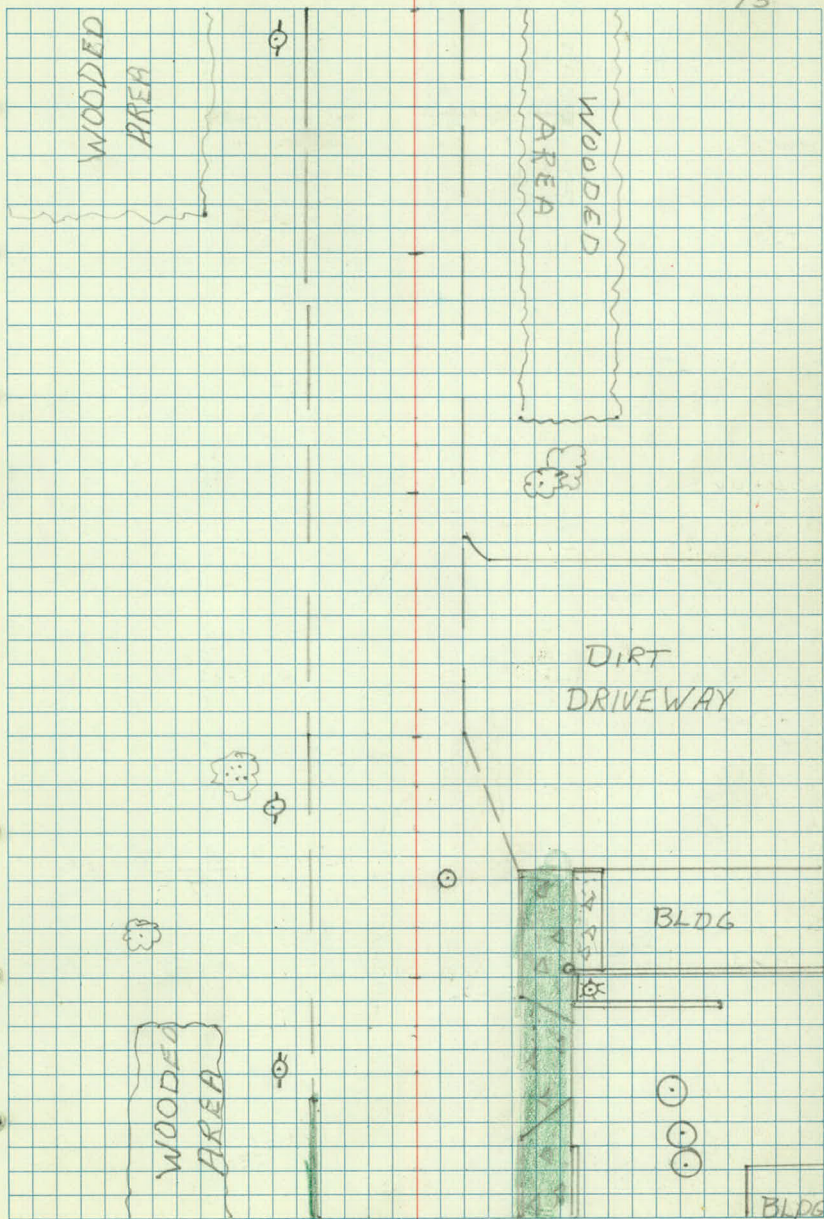

31+00

+00 [✓]WOODS
34

Rd Rd
19 14

Rt

+63 NW COR HD #303
121

+56 8" PINE
42

+66 TRIPIS 8" PINE
70

+56 8" PINE
34

+60 8" PINE
34

+50

+46 [✓]DIRT
12" DR
33

+42 [✓]DIRT
10' DR

+33 24" ELM
77

+31 24" ELM
29

+33 16" ELM
52

+08 RT. DR

+63 24" BOX
79

+00 [✓]WOODS
35

+03 18" ELM +03 24" BOX
29 79

30+00

+89 [✓]PP
29

Rd Rd
20 12

+96 NE COR BLDG #339
26

+83 [✓]TWIN 12" ELM
28

+59 [✓]9'S.W.
39-61

+50

+33 MH
2

+21 NW COR BLDG #389
64

29+00

+00 [✓]WOODS
39-150

Rd Rd
22 10

+96 [✓]DIRT
12" DR

28+50

+74 [✓]END WOODS
23-60

ML
LPO
MR

SEPT 7, 78
SUNNY 80°

14

WOODED

AREA

DIRT

DIRT

DIRT

WOOD
AREA

APT
339
BkDg

32+00

+50

+22 NR COR HO
119

+27 8" PINE

+27 30" ELM

50

35

+16 8" PINE

+17 10" TWIN PINE

35

70

31+00

ML
MR
RC
JT

SEPT 14, 78

CLEAR 68° 1

10TH ST N.W

X SECTIONS

0500 TO 3100

Sta	+	π	-	ELEV
BM	8.67	898.71		890.04

0+08
0+00

✓

0+58
0+50

✓

+96			3.85	894.86
-----	--	--	------	--------

+96			3.92	894.79
-----	--	--	------	--------

1+08
1+00

M.L.
R.C.
MR
JT

LT

E

RT

2

SEPT 14, 18

SPIKE IN PP 2+25 RT 40'

98.19	97.38	97.50	97.39	98.13
0.52	1.33	1.21	1.32	0.58
15	14	15	15	15
CONC	CONC	CONC	CONC	CONC S.W.
SW				

97.08	96.31	96.40	96.29	97.01
1.63	2.40	2.31	2.42	1.70
15	15	15	15	15
CONC	CONC	CONC	CONC	CONC S.W.
S.W.				

C.B. 0+96 RT 14

81.61	88.41	95.21	95.17	94.51	95.00	94.74	95.21	95.11	93.11	88.81
17.1	10.3	3.5	3.54	4.20	3.71	3.97	3.50	3.6	5.6	9.9
75	42	20	16	15	15	15	16	22	32	55
		T.C.	T.C.	CONC		CONC	T.C.			

88.11

10.6
75

STA

+

X

-

ELEV

898.71

1+57

1+50

✓

1+79

1+73

E Ramps ON + OFF

✓

2+06

2+00

✓

2+55

2+50

ML.
RC
MR
JT

SEPT 17, 1980

LT

A

R

3

91.01

7.7
75

91.71

7.0
50

93.41

5.3
26

93.62

5.09
20
T.C.

93.17

5.54
19
conc

93.42

5.29

93.20

5.51
12
B.T
RAMP

92.71

6.00
54
B.T
RAMP

92.49

6.22
75
Ramp

91.1

7.61
75

91.77

6.94
50

92.43

6.28
13

92.70

6.01

92.53

6.18
13

91.93

6.28
50

92.32

6.39
75

90.49

8.22
75
RAMP

91.17

7.54
45
conc

91.59

7.12
44
T.C.

91.99

6.72
16
T.C.

91.53

7.18
conc

91.79

6.92

91.36

7.35
21
conc

91.41

7.3
34

92.01

6.7
47

90.51

8.2
75

83.81

14.9
75

89.11

9.6
33

89.23

9.48
27

89.72

8.99

89.55

9.16
15

89.21

9.5
29

88.11

10.6
37

89.71

9.0
51

90.37

8.34
59
B.T

STA	+	π	-	ELEV
		898.71		
<u>T.P.</u>	1.41	889.30	10.82	887.89
+73			0.48	888.82
+93			7.69	881.61
3+03				
3+00				
✓				
3+51				
3+50				
✓				
4+00				
5+00				

M.L.
R.C.
M.R.
J.F.

SEPT 17, 18

LT

2

RT

4

Run on S.D. 2+63 RT 32'

M.H. 58' RT'

80.7	INVERT	85.4	86.64	86.96	86.87	87.41	87.1	81.8	79.3
8.6	7.5	3.85	2.66	2.34	2.43	1.89	2.2	7.5	10.0
77	54	32			14	57	62	73	98

79.2	83.8	82.7	84.09	84.75	85.31	85.4	78.4	77.5
10.1	9.5	6.6	5.21	4.55	3.99	3.9	10.9	11.8
75	41	28	16		32	42	60	67

77.9	78.9	80.2	82.3	82.86	84.15	84.14	84.1	81.2	76.7
11.4	10.4	9.1	7.0	6.44	5.15	5.16	5.2	8.1	12.6
75	46	38	24	16		16	28	39	50

STA

+

K

-

ELEV

889.30

4+30

✓

4+45

L DITCH

✓

4+80

T.P.

8.89

892.44

5.76

883.54

883.55

M.L.
R.C.
MR
JT

Sept 14, 198

LD

2

RT

5

77.3	77.5	82.1	83.02	83.87	83.91	83.7	82.8	76.2
12.0	11.8	7.2	6.28	5.43	5.39	5.6	6.5	13.1
68	35	22	13		13	22	45	53

72.2	73.27	76.0	82.3	83.0	83.83	83.79	83.8	82.3	74.39
17.1	16.03	13.3	7.0	6.30	5.47	5.51	5.5	7.0	14.91
79	44	42	23	13		14	24	46	57
	INVERT 24"								INVERT 24"

83.4	82.4	82.6	83.28	83.87	83.73	83.7	79.6	78.5
5.9	6.9	6.7	6.02	5.43	5.57	5.6	9.7	10.5
77	48	29	14		13	21	36	54

78.1
11.2
75

SPIKE in PP 4+41 4T

STA

+

K

-

ELEV

892.44

5+00

+18

11.54

880.90

+15

L R0

+57

+69

11.24

881.20

6+00

ML
RC
MR
JT

SEPT 14, 196

LT

E

RT

6

83.59	83.46	83.53	83.80	83.71	83.54	79.74	79.94
8.85	8.98	8.91	8.64	8.73	8.9	12.7	12.5
75	54		M.H	12	21	33	54
BIT	BIT						
CURB	CURB						

15" C.M.P. Rt 28'

83.59	83.50	83.58	83.90	83.69	83.44	79.94	80.34
8.85	8.94	8.88	8.54	8.75	8.7	12.5	12.1
75	52	12		12	23	40	57

78.44	80.04	83.94	83.67	83.87	83.63	82.14	80.94
13.9	12.4	8.5	8.77	8.57	8.81	10.3	11.5
59	44	23	12		12	25	71

15" C.M.P. Rt

81.54	83.34	83.70	83.94	83.74	83.54	82.74	85.04	84.84
10.9	9.1	8.74	8.50	8.70	8.9	9.7	7.4	7.6
51	26	12		13	17	24	34	53
FENCE								

STA	+	π	-	ELEV
-----	---	-------	---	------

		892.44		
--	--	--------	--	--

6+35				
------	--	--	--	--

			8.46	883.98
--	--	--	------	--------

6+60				
------	--	--	--	--

			ENTRANCE LT	
--	--	--	-------------	--

T.P.				
------	--	--	--	--

	5.00			
--	------	--	--	--

		889.22		
--	--	--------	--	--

			8.22	
--	--	--	------	--

				884.22
--	--	--	--	--------

7+00				
------	--	--	--	--

+41				
-----	--	--	--	--

			ENTRANCE RT	
--	--	--	-------------	--

+83				
-----	--	--	--	--

			& DITCH	
--	--	--	---------	--

ML
RC
MR
JT

SEPT 14 1978

Lt

R

Rt

7

M.H. $\frac{1}{2}$

83.14	83.44	83.78	84.07	83.95	84.04	88.44	88.24
9.3	9.0	8.66	8.37	8.49	8.4	4.0	4.2
49	35	14		14	23	33	70

P.K. $\frac{1}{2}$ STA 7+00

83.72	83.72	84.12	83.92	83.92	84.22	84.12	84.12	84.32	87.62	88.42
5.5	5.5	5.1	5.3	5.3	5.0	5.1	5.1	4.9	1.6	0.8
50	32	23	22	14		13	17	27	40	82

83.12	83.72	84.12	83.62	83.82	84.34	84.42	85.42	86.32
6.1	5.5	5.1	5.4	5.4	4.88	4.8	3.8	2.9
60	28	23	19	13		13	53	70

77.32	77.41	83.32	83.82	84.33	84.32	84.02	77.41	81.02
11.9	11.81	5.9	5.4	4.89	4.9	5.2	11.81	8.2
38	32	20	13		13	20	32	50
INVERT								

81.22
8.0
55

82.02
7.2
79

83.12
6.1
57

+

K

-

ELEV

889.22

T.P.

5.64

890.13

4.73

884.49

8+17

+60

ENTRANCE LT + RT

9+00

+36

ENTRANCE LT

+56

4.26 885.87

+57

4.08 886.05

M.L.
B.W.
MR
JT

LT

E

RT

8

PK E STA. 8+00

85.13	85.13	85.93	84.33	84.71	84.53	84.03	83.13	83.13
4.4	5.0	6.2	5.8	5.72	5.6	6.1	7.0	7.0
55	26	20	13		13	19	50	58

86.33	85.53	84.73	84.83	85.18	84.93	84.73	84.45
3.8	4.6	5.4	5.3	4.95	5.2	5.4	5.68
80	52	22	13		13	24	45

CONC. SLAB

86.43	86.53	85.83	85.03	85.23	85.59	85.33	85.23	86.23	86.53
3.7	3.6	4.3	5.1	4.9	4.54	4.8	4.9	3.9	3.6
64	46	24	21	13		13	21	25	40

87.43	86.63	85.63	85.63	85.87	85.53	85.63	86.13	86.23
2.7	3.5	4.5	4.5	4.26	4.6	4.5	4.0	3.9
75	50	22	13		13	20	52	66

M.H. LT

M.H. E

+

A

-

ELEV

890.13

10+00

+25

ENTRANCE RT

+50

+91

2.90 887.23

+91

8.50 881.63

11+02

2.30 887.83

11+16

3.00 887.13

11+20

2.74 887.39

11+41

2.88 887.25

+59

7.62 882.51

B.M.

2.83 887.30 (887.34)

M.L.
B.W.
M.R.
JT

LT

2

RT

9

87.53	86.93	85.53	85.63	85.83	86.31	86.13	86.03	86.13
2.6	3.2	4.6	4.5	4.3	3.82	4.0	4.1	4.0
72	36	26	22	13		13	20	37 40.

86.83	86.13	85.93	85.83	85.93	86.51	86.43	86.13	86.43	85.83	85.53
3.3	4.0	4.2	4.3	4.2	3.57	3.7	4.0	3.7	4.3	4.60
78	65	23	20	13		13	20	24	49	70

CONC.
SLAB

87.03	86.43	86.03	86.33	86.03	86.13	86.76	86.63	86.63	85.93
3.1	3.7	4.1	3.8	4.1	4.0	3.37	3.5	3.5	4.2
78	66	32	24	22	15		15	21	70

M.H. RT 34

M.H. RT 41

M.H. RT 38

M.H. LT 5'

M.H. RT 2'

M.H. RT 24'

M.H. RT 45'

STA	+	π	-	ELEV
	8.92	896.10		887.18

11+20

Ent. Lt.

+21

E 8th St. Rt.

+50

12+00

+23

Ent. Lt.

T.P.	6.07	893.34	8.83	887.27
------	------	--------	------	--------

ML
BW
MR
JT

Lt.

£

Rt.

10

SPIKE P.P. 12+37 Lt

84.70 85.30 86.60 87.44
11A 10.8 9.5 8.66
83 51 18

87.68 88.80 90.10 91.40
8.52 7.3 6.0 4.7
8 50 100 150

84.80 85.00 85.80 86.90 86.70 87.52 88.10 88.50 91.40 95.60
11.3 11.1 10.3 9.2 9.4 8.58 8.0 7.6 4.7 0.5
75 59 38 26 17 32 60 78 109

85.30 85.40 85.70 86.30 87.00 87.59 87.70 88.20 88.50 90.10 95.10 95.70
10.8 10.7 10.4 10.8 9.1 8.51 8.4 7.9 7.6 5.4 1.0 0.4
72 60 36 35 15 11 19 29 45 76 100
Bit Carb

84.30 84.90 87.00 87.54 87.70 88.66 91.30 94.60 95.70
11.8 11.2 9.1 8.46 8.4 7.5 4.8 1.5 0.4
86 24 16 10 29 45 65 88

P.K. & STA. 14+00

STA	+	π	-	ELEV
		893.34		
13+00			Ent. Rt.	
+44			5.98	887.36
+49			7.51	885.83
+49			6.18	887.16
+80			Ent. Rt.	
TP	4.78	892.35	5.77	887.57
14+35			Ent. Rt.	
+62			Ent. Lt.	
15+18			Ent. Lt.	
+17				

ML
BW
MR
JT

Lt.			Rt.		
83.34	84.74	86.44	87.49	87.64	87.84
10.0	8.6	6.9	6.4	5.85	5.8
83	59	30	20	6	30
					4.8
					4.2
					100

MH Lt. 1'

MH Lt. 35'

MH Rt. 31'

82.34	83.34	85.14	86.14	86.64	87.23	87.24	87.24	87.84	89.14	90.14
11.0	10.0	8.2	7.2	6.7	6.11	6.1	6.1	5.5	4.2	3.20
80	56	34	25	14		11	14	28	58	77

conc
slab

PK 15+50

82.35	83.65	86.45	86.95	87.40	87.45	87.75	88.25	89.25
10.0	8.7	5.9	5.4	4.95	4.9	4.6	4.1	3.1
81	51	19	13		12	20	50	88

82.15	83.15	87.05	87.42	87.45	87.95	87.75	88.45	89.85
10.2	9.2	5.3	4.93	4.9	4.4	4.6	3.9	2.5
90	57	11		14	24	31	42	71

82.05	83.25	87.55	87.64	87.45	87.75	87.65	88.75	89.85
10.3	9.1	4.8	4.71	4.9	4.6	4.7	3.6	2.5
75	47	8		18	29	34	44	71

2.2
89

STA

+

PI

-

ELEV

892.35

~~15+28~~

5.00 887.35

+27

+49

+50

+66

+64

16+10

5.24 887.11

+33

5.06 887.29

+15

+17

Ent Lt.

E 7th St. Rt.

+57

+59

Ent. Lt.

17+23

4.78 887.57

ML
BW
MR
JT

Lt.

£

Rt.

12

MH Lt 10'

81.15	82.45	83.15	81.55	81.45	87.58	87.35	81.55	81.45	88.55	89.15
10.6	9.9	8.6	4.8	4.9	4.77	5.0	4.8	4.9	3.8	3.2
82	64	44	16	7		18	27	36	44	80

84.15	86.15	87.45	87.35	87.49	87.35	87.55	87.35	88.65	88.45
7.6	6.2	4.9	5.0	4.86	5.0	4.8	5.0	3.7	3.9
86	32	18	7		17	26	33	43	58

M.H. Rt. 32'

88.65 4.3 4.3
84 65
88.05

MH Lt. 1'

86.45	86.15	86.95	87.15	87.32	87.05	86.85	87.65	88.35	88.45
5.9	5.6	5.4	5.2	5.03	5.3	5.5	4.7	4.0	2.9
72	39	22	8		17	25	69	100	150

86.45	86.65	86.95	86.95	87.09	86.15	86.15	86.65	89.15
5.9	5.7	5.4	5.4	5.26	5.6	5.6	3.7	3.2
78	37	24	9		18	31	37	84

M.H. Rt. 34'

STA + π - ELEV

892.35

T.P. 2.59 891.16 3.72 888.63 (888.57)

~~17+22~~ Conc. Ent. Lt.

+19

Ent. Lt.

+51
~~+54~~

Ent. Rt.

+65
~~+68~~

+85

15.00 876.16

T.P. 5.34 891.65 4.85 886.31

+96
~~18+00~~

M.L.
BW
MR
JT

Lt. ♀ Rt. 13

Hyd. SE. cor. 7th St
 86.26 86.28 86.35 86.36 86.64 86.06 86.26 86.06 86.56 86.76
 5.05 4.88 5.11 4.6 4.52 5.1 4.9 5.1 4.6 4.4
 77 37 32 11 16 22 24 29 31

2.3 2.3
 74.42
 88.86

16.26 16.56 83.46 85.86 86.56 86.47
 14.9 11.6 7.7 5.3 4.6 4.69
 147 100 59 28 10

16.36
 → 14.8

174
 15.96 16.46 83.76 86.36 86.36 86.43 85.96 87.86 88.46
 15.2 14.7 7.4 4.8 4.8 4.73 5.2 3.3 2.7
 100 74 45 25 10 17 47 88
 Bit

MH Lt. 94'

PK ♀ STA 18+00

16.95 16.35 88.95 86.25 86.45 86.31 86.05 86.05 85.65 86.85 87.85
 15.7 15.3 10.7 5.4 5.2 5.34 5.6 5.6 6.0 4.8 3.8
 100 70 47 19 8 17 22 29 42 79

STA + π - ELEV

~~17+96~~

891.65

~~18+00~~

6.05 885.60

+07

5.42 886.23

T.P.

4.10

890.82

4.93

886.72

~~+47~~

~~+52~~

+71

14.47 876.35

~~+83~~

~~+88~~

Ent. Rt.

~~+03~~

~~19+08~~

~~+07~~

~~+12~~

West Rail

ML
BW
MR

LT.

⊕

Rt.

14

MH Rt. 29'

MH ⊕

PK ⊕ STA 19+50

16.62	16.22	16.61	81.92	86.62	86.72	86.60	85.92	86.02	83.19	85.62	86.62	81.62		
14.2	14.6	14.21	8.9	4.2	4.1	4.22	4.9	4.8	7.63	5.2	4.2	3.2		
100	61	41	28	17	7		18	22	25	32	51	74		
Inv.								Inv.						

M.H. Lt. 74'

13.72	12.02	81.32	86.62	86.72	86.77	86.82	86.42	86.42	86.72
17.1	13.8	9.5	4.2	4.1	4.05	4.0	4.4	4.4	4.1
100	52	34	16	9		22	30	59	90

86.42	86.02	85.52	86.32	86.72	86.86	87.12	86.72	87.12
4.4	4.8	5.3	4.5	4.1	3.96	3.7	4.1	3.7
100	76	44	11	4		23	55	100

88.63	86.82	86.82	87.36	88.66#
2.19	4.00	4.00	3.46	2.16
200	50		50	200

STA

+

T

-

ELEV

890.82

~~19+09~~
~~19+75~~

¢ of Rails

~~+11~~~~+17~~

East Rail

~~+44~~~~+50~~

+70

5.07 885.75

+70

5.07 885.75

~~+94~~~~20+00~~

T.P.

3.66

890.04

4.44

886.38

+50

ML
BW
MR

Lt.

£

Rt.

15

86.92	86.52	86.32	86.12	86.84	87.02	86.82	87.12	87.32
3.9	4.3	4.5	4.7	3.98	3.8	4.0	3.7	3.5
100	75	50	25		25	50	75	100

88.66	86.86	86.82	87.31	88.63
2.16	3.96	4.00	3.51	2.19
200	50		50	200

87.82	85.42	86.12	86.72	86.13	86.12	87.12	87.52
7.0	5.4	4.1	4.1	4.09	4.1	3.7	3.3
83	46	10	4		30	68	94

M.H. Lt. 42'

M.H. Lt. 52'

84.02	85.22	86.22	86.32	86.38	86.42	86.72	86.82
6.8	5.6	4.6	4.5	4.44	4.4	4.1	4.0
79	47	19	9		30	62	84

PK £ STA 20+00

82.64	82.94	86.04	85.16	85.92	86.25	86.33
7.4	6.1	4.0	3.88	4.12	3.79	3.71
88	47	17		30	31	41
			Gutter		sidewalk	B/dg.

STA	+	π	-	ELEV	
		890.04			
21+00					
+50					
T.P.	2.80	890.06	2.75	887.29	887.26
+71			5.26	884.80	
+80			∇ 6 th St.		
+83			5.65	884.41	
22+07			6.37	883.69	
+09			6.12	883.94	
+50					

ML
BW
MR

Lt.

C

Rt.

16

71.94	83.04	84.64	85.54	85.81	85.35	85.69	85.72	85.94
12.1	7.0	5.4	4.5	4.23	4.69	4.35	4.32	4.1
119	100	48	18		30	31	41	84

Gutter sidewalk sidewalk

83.94	85.44	85.24	85.45	84.79	85.22	85.22	85.74	85.4
6.1	4.6	4.8	4.59	5.25	4.82	4.82	4.3	4.6
90	3.5	18		30	31	41	43	73

Gutter sidewalk sidewalk

85.64 ← 4.4
100

Top Hyd. 22+46 Lt. 23'

M.H. Rt. 44'

76.66	81.46	83.96	84.26	85.16	85.25	84.26	84.76	84.86	84.86
13.4	8.6	6.1	5.8	4.9	4.81	5.8	5.3	5.2	5.2
128	117	93	60	18		31	52	82	100

M.H. Rt. 42'

C.B. Rt 30'

C.B. Rt 42'

85.06	85.20	84.76	84.92	83.95	84.38	84.44
5.0	4.86	5.3	5.14	6.11	5.68	5.62
40	30	19		30	30	38

Bldg sidewalk gutter sidewalk Bldg.

STA	+	π	-	ELEV.
-----	---	-------	---	-------

890.06

T.P.	4.73	889.55	5.24	884.82
------	------	--------	------	--------

23+00

+50

24+00

T.P.	3.96	888.32	5.19	884.36
------	------	--------	------	--------

+41

+69

ML
BW
MR

Lt.

¢

Rt

17

PK ¢ STA 23+00

12.13	10.55	82.55	84.55	84.82	84.10	84.43	84.59
14.4	11.0	6.0	5.0	4.73	5.45	5.12	4.96
84	53	43	19		30	30	38
				Gutter		sidewalk	Bldg

13.05	16.95	82.65	84.95	84.35	84.74	84.25	84.40	84.29	84.75	87.95
16.5	12.6	6.9	4.6	5.2	4.81	5.30	5.15	5.26	4.8	5.6
100	54	38	25	18		30	30	38	64	100
					Gutter		SW	SW		

13.95	11.75	82.05	84.25	84.25	84.43	84.07	84.42	84.59
15.6	11.8	7.5	5.3	5.3	5.12	5.48	5.13	4.96
85	58	34	23	18		30	30	38
					Gutter		SW	Bldg

PK ¢ STA 25+00

14.72	80.72	83.22	83.85	84.24	83.88	84.33	84.56
13.6	7.6	5.1	4.47	4.08	4.44	3.99	3.76
100	59	42	16		30	30	38
			Gutter		Gutter	SW	Bldg

82.97	82.95	83.74	83.30	84.10	83.90	84.31	84.81	85.06
5.35	5.37	4.58	5.02	4.22	4.42	4.01	3.51	3.26
100	76	25	25		30	30	58	100
SW	SW	TC	Gutter		Gutter	TC	SW	SW

STA	+	π	-	ELEV
-----	---	-------	---	------

		888.32		
--	--	--------	--	--

24+73				
-------	--	--	--	--

			T.C. Lt.	
--	--	--	----------	--

+73				
-----	--	--	--	--

			Gutter Lt.	
--	--	--	------------	--

+71				
-----	--	--	--	--

		5.23	883.09	
--	--	------	--------	--

+72				
-----	--	--	--	--

		5.91	882.41	
--	--	------	--------	--

+78				
-----	--	--	--	--

			T.C. Rt.	
--	--	--	----------	--

+78				
-----	--	--	--	--

			Gutter Rt.	
--	--	--	------------	--

+98				
-----	--	--	--	--

			☒ 5 th Ave.	
--	--	--	------------------------	--

ML
BW
MR

Lt.

①

Rt.

18

85.17 83.47 82.76 82.86 82.52 84.07
3.15 4.85 5.56 5.46 4.80 4.25
200 150 100 82 35

84.72 83.09 82.66 82.52 83.09 84.07
3.60 5.23 5.66 5.80 5.23 4.25
200 150 100 82 35

LT.
CB Rt. 30'

LT.
CB Rt. 82'

84.10 84.47 84.81 85.01 84.87 84.64
4.22 3.85 3.51 3.31 3.45 3.68
36 78 100 150 200

84.10 84.30 84.64 84.73 84.70 84.35
4.22 4.02 3.68 3.59 3.62 3.97
36 78 100 150 200

83.09 83.14 83.60 84.01 84.35 84.66 84.81 85.06 85.16 85.21
5.23 5.18 4.72 4.31 3.97 3.66 3.51 3.26 3.16 3.11
100 75 50 25 35 50 75 100 125
x 83.28 83.90 84.65 85.32 84.87 84.98 85.16 x
5.04 4.42 3.67 3.00 3.45 3.34 3.16
125 150 175 200 200 175 150

STA	+	π	-	ELEV
-----	---	-------	---	------

		888.32		
--	--	--------	--	--

25+24				
-------	--	--	--	--

			Gutter	
--	--	--	--------	--

+25				
-----	--	--	--	--

			T.C.	
--	--	--	------	--

	2.08			
--	------	--	--	--

		888.04		
--	--	--------	--	--

			2.34	
--	--	--	------	--

				885.98
--	--	--	--	--------

				885.96
--	--	--	--	--------

+40				
-----	--	--	--	--

			4.65	
--	--	--	------	--

				883.39
--	--	--	--	--------

+48				
-----	--	--	--	--

			4.48	
--	--	--	------	--

				883.56
--	--	--	--	--------

+54				
-----	--	--	--	--

			ENTRANCE RT (CONC)	
--	--	--	--------------------	--

✓				
---	--	--	--	--

			✓	
--	--	--	---	--

+87				
-----	--	--	--	--

			4.80	
--	--	--	------	--

				883.24
--	--	--	--	--------

T.P.				
------	--	--	--	--

	3.81			
--	------	--	--	--

		886.43		
--	--	--------	--	--

			5.42	
--	--	--	------	--

				882.62
--	--	--	--	--------

MIL
PK
MR
JT

Lt.

2

Rt.

19

84.33	82.96	82.36	82.49	83.45	83.92	84.18	84.49	84.64	84.61
3.99	5.36	5.96	5.83	4.87	4.40	4.14	3.83	3.68	3.71
150	100	69	29			29	71	100	140

84.76	83.42	82.87	82.97	83.64	83.92	84.48	84.75	84.93	84.92
3.56	4.90	5.45	5.35	4.68	4.40	3.84	3.57	3.39	3.40
150	100	69	29			29	71	100	140

Top Hyd NE Cor. 5TH Ave.

M.H. 5' Rt

M.H. 18' Rt

81.54	83.14	83.10	82.75	83.28	83.43	83.96	84.09	84.28
6.5	4.9	4.94	5.29	4.76	4.61	4.08	3.95	3.76
52	40	20	20		22	28	34	74
		T.C.	GUTTER					

18.64	15.84	12.34
9.4	12.2	15.7
78	97	112

M.H. Rt 25'

STA	+	Δ	-	ELEV
-----	---	----------	---	------

		886.43		
--	--	--------	--	--

26+00			-	
-------	--	--	---	--

✓				
---	--	--	--	--

+29				
-----	--	--	--	--

			ENTRANCE RT (CONC.)	
--	--	--	---------------------	--

+50				
-----	--	--	--	--

+70				
-----	--	--	--	--

		4.49		
--	--	------	--	--

			881.94	
--	--	--	--------	--

27+11				
-------	--	--	--	--

			ENTRANCE RT	
--	--	--	-------------	--

ML
PK
MR
JT

Lr

A

RT

20

80.03	83.03	82.69	82.32	82.62	82.59	82.91	83.03	83.61
6.4	3.4	3.74	4.11	3.81	3.84	3.52	3.40	2.82
54	34	21	21		22	22	22	33
		T.C.	GUTTER		GUTTER	T.C.	S.W.	T.C.

18.43
8.0
86

84.69
83.32
1.74
3.11
66
BLOG
33

17.73	80.33	82.53	82.31	81.99	82.33	82.04	82.50	83.96
8.7	6.1	3.9	4.12	4.44	4.10	4.39	3.93	2.47
83	45	26	20	20		23	29	66
			T.C.	GUTTER				

16.73	19.43	81.23	81.68	82.05	81.71	82.09	83.01
9.7	7.0	5.2	4.75	4.38	4.72	4.34	3.42
100	50	41	22		23	29	35
						S.W.	T.C.

M.H. RT. 6'

16.73	17.63	18.93	81.13	81.58	81.49	80.63	81.43	81.73	81.73
9.7	8.8	7.5	5.3	4.85	4.94	5.8	5.0	4.7	4.7
100	75	42	23		10	25	36	70	100

STA

+

T

-

ELEV

886.43

27+50

28+00

T.P.

4.61

884.64

6.40

880.03

+50

+96

ENTRANCE RT (DIRT)

29+33

RW

4.81

879.83

4.81

ML
PK
MR
JT

KT

R

RT

21

16.83	18.03	19.53	20.77	21.19	21.01	21.03	21.73	20.83	20.63
9.6	8.4	6.9	5.66	5.24	5.42	5.4	4.7	5.6	5.8
100	74	38	22		10	16	21	49	70

68.03	67.13	68.33	79.93	80.44	80.79	80.53	80.23	81.23	80.33	79.13
18.4	19.3	18.1	6.5	5.99	5.64	5.90	6.2	5.2	6.1	7.3
100	78	65	44	22		10	11	19	42	64

Ditch

P.K. & STA 29+00

71.44	73.44	79.64	79.93	80.26	79.95	79.64	80.24	78.34	77.54
13.2	11.2	5.0	4.71	4.38	4.69	5.0	4.4	6.3	7.1
100	63	39	22		10	17	23	47	85

70.54	71.44	75.14	78.84	79.74	80.04	79.79	79.14	78.24	77.94
14.1	13.2	9.5	5.8	4.90	4.60	4.85	5.5	6.4	6.7
95	69	50	34	22		11	31	65	100

M.H. RTZ'

STA	+	π	-	ELEV
-----	---	-------	---	------

		884.64		
--	--	--------	--	--

29+50				
-------	--	--	--	--

T.P.	4.84	884.78	4.70	879.94
------	------	--------	------	--------

30+00				
-------	--	--	--	--

+42				
-----	--	--	--	--

ENT. LT				
---------	--	--	--	--

ENTRANCE RT (DIRT)				
--------------------	--	--	--	--

T.P.	10.23	889.90	5.11	879.67
------	-------	--------	------	--------

31+00				
-------	--	--	--	--

M.L.
PK
MR
JT

LT

Q

RT

22

70.54	73.24	76.64	80.16	79.86	80.16	79.94	80.34
14.1	11.4	6.0	4.48	4.78	4.48	4.7	4.3
93	58	37	22		10	40	63 HO.

P.K. Q STA 30+00

75.58	74.38	75.18	74.38	74.70	74.94	74.68	74.18	76.98	76.78
92	10.4	9.6	5.4	5.08	4.84	5.10	5.6	7.8	8.0
92	57	45	31	26		11	21	45	71

78.48	80.08	79.58	79.48	79.66	79.58	78.78	78.48
6.3	4.7	5.2	5.30	5.12	5.20	6.0	6.3
63	47	35	20		13	43	90

P.K. Q 31+00

83.10	82.30	79.50	79.00	79.24	79.36	79.50	84.60	84.40	83.60
6.8	7.6	10.4	10.9	10.66	10.54	10.4	5.3	5.5	6.3
75	35	22	18	14	21	23	36	56	72

83.50
6.4
100

STA

+

T

-

ELEV

MS 889.90

(884.90)

31+58

K

+60

10.55 879.35

T.P.

6.22

886.18

9.94

879.96

0.19

885.99

(885.96)

ML
PK
MR
JT


23


84.40	85.20	79.40	79.10	79.47	79.40	81.25	83.06
5.5	4.7	10.5	10.80	10.43	10.50	8.65	6.84
71	37	25	19		13	56	100

M.H. LT 2'

P.K. & STA 30+00

Top HYD 5TH AVE + 10TH ST NE COR.

 

 



Sta	+	π	-	ELEV
B.M.	4.64	890.60		885.96
23+95			26.29	864.31
			25.60	8650

Top Hyd N.E. Cor of 5th Ave

22.29 Inv 48" RCP to 320'

21.60 Ditch

 

 

STA	+	$\bar{A}$	-	ELEV.
BM	2.29	889.55		887.26

23+75

✓


BM			3.58	885.97	885.96
----	--	--	------	--------	--------

LT

4

69.6	12.5	13.3	14.1	18.8	24.0	34.5	45	84.57
20.6	17.1	16.3	15.5	10.8	5.6	5.1	5.1	4.98
200	150	100	80	50	28	20	12	

69.5	65.9
20.1	23.7
250	300

 

STRUCTURAL DATA TYPE

STORM	☒	ELECTRIC	☐	WATER	☐
SANITARY	☐	TELEPHONE	☐	OTHER	☐

STATION	RIGHT	LEFT	SIZE	CURB BOX
0+96	14'		10"	INCH CASTING

TYPE OF CONST.	COMMENTS
BLOCK	☒
BRICK	☐
SECTIONAL	☒ 1' MEXICAN HAT

ADJUSTING RINGS	TYPE	NO.	DEPTH	COMMENTS
BLOCK				
BRICK				
CONC. RINGS	3	3		

DEPTH FROM BOTTOM OF M.H.	ELEV.
TO TOP OF CASTING	3.0'
DISTANCE FROM HIGHEST FLOW LINE TO TOP OF CASTING	3.0'
ETC.	
INV.	

SIZES OF ALL
PIPES AND
DIRECTION OF
FLOW

DESIGN

ELEVATION - TOP	894.86
FINAL ELEVATION	
DIFFERENCES	

ADJUST

RECONSTRUCT



91.86

STRUCTURAL DATA TYPE

STORM	☒	ELECTRIC	☐	WATER	☐
SANITARY	☐	TELEPHONE	☐	OTHER	☐
STATION	RIGHT	LEFT	SIZE	CURB BOX	
0+96		13'	10'	INCH CASTING	

TYPE OF CONST.	COMMENTS
BLOCK	☒
BRICK	☐
SECTIONAL	☒ 1' MEXICAN NAT

ADJUSTING RINGS	TYPE	NO.	DEPTH	COMMENTS
BLOCK				
BRICK				
CONC. RINGS		3		

DEPTH FROM BOTTOM OF M.H.	ELEV.
TO TOP OF CASTING	3.2'
DISTANCE FROM HIGHEST FLOW LINE TO TOP OF CASTING	3.1'
ETC.	
INV.	891.51

SIZES OF ALL PIPES AND DIRECTION OF FLOW	12" RCP ←  12" CSP ←
---	---

DESIGN	
ELEVATION - TOP	894.79
FINAL ELEVATION	
DIFFERENCES	
ADJUST	
RECONSTRUCT	

STRUCTURAL DATA TYPE

STORM	☒	ELECTRIC		WATER		
SANITARY		TELEPHONE		OTHER		
STATION		RIGHT	LEFT	SIZE	SURFACE DRAIN	
2+66		31'			INCH CASTING	
TYPE OF CONST.		COMMENTS CONC. CONE 2'				
BLOCK						
BRICK						
SECTIONAL						
ADJUSTING RINGS		TYPE	NO.	DEPTH	COMMENTS	
BLOCK						
BRICK						
CONC. RINGS			7			
DEPTH FROM BOTTOM OF M.H. TO TOP OF CASTING DISTANCE FROM HIGHEST FLOW LINE TO TOP OF CASTING ETC. INV.		ELEV.				
		5.1'				
		5.2'				
SIZES OF ALL PIPES AND DIRECTION OF FLOW						
DESIGN ELEVATION - TOP FINAL ELEVATION DIFFERENCES ADJUST RECONSTRUCT						
		887.89				

↑



12" RCP ←

12" RCP ←

STRUCTURAL DATA TYPE

STORM	ELECTRIC	WATER	
SANITARY <i>X</i>	TELEPHONE	OTHER	
STATION	RIGHT	LEFT	SIZE
<i>2+77</i>	<i>57'</i>		<i>11" INCH CASTING</i>

TYPE OF CONST.	COMMENTS
BLOCK	<i>CONC, CONC</i>
BRICK	
SECTIONAL <i>X</i>	

ADJUSTING RINGS	TYPE	NO.	DEPTH	COMMENTS
BLOCK				
BRICK				
CONC. RINGS		<i>4</i>		

DEPTH FROM BOT. OM OF M.H. TO TOP OF CASTING	ELEV.
DISTANCE FROM HIGHEST FLOW LINE TO TOP OF CASTING	
ETC.	
INV.	

SIZES OF ALL
PIPES AND
DIRECTION OF
FLOW



DESIGN

ELEVATION - TOP	<i>888.82</i>
FINAL ELEVATION	
DIFFERENCES	

ADJUST


RECONSTRUCT

24" VCP
→

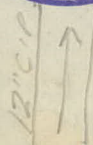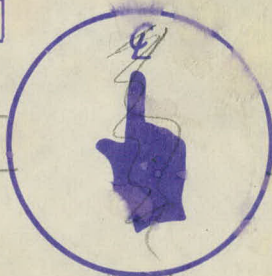

STRUCTURAL DATA TYPE

STORM	ELECTRIC	WATER	
SANITARY ☒	TELEPHONE	OTHER	
STATION	RIGHT	LEFT	SIZE
5+00	R		9" INCH CASTING

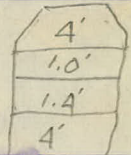
TYPE OF CONST.	COMMENTS
BLOCK	
BRICK	
SECTIONAL ☒	

ADJUSTING RINGS	TYPE	NO.	DEPTH	COMMENTS
BLOCK				
BRICK				
CONC. RINGS	X	3		

DEPTH FROM BOTTOM OF M.H. TO TOP OF CASTING	ELEV.
	13.75
DISTANCE FROM HIGHEST FLOW LINE TO TOP OF CASTING	
	12.90
ETC.	
INV.	

SIZES OF ALL
PIPES AND
DIRECTION OF
FLOW

DESIGN	
ELEVATION - TOP	883.80
FINAL ELEVATION	
DIFFERENCES	
ADJUST	
RECONSTRUCT	

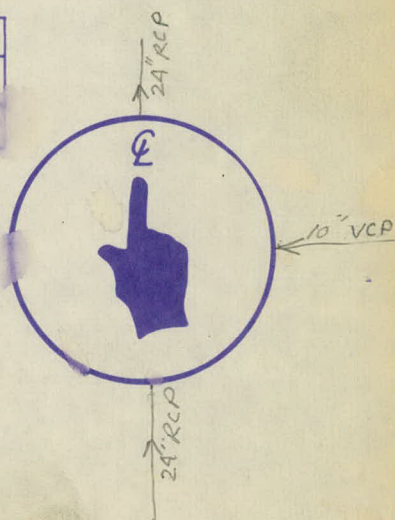

STRUCTURAL DATA TYPE

STORM	ELECTRIC	WATER	
SANITARY ☒	TELEPHONE	OTHER	
STATION 6+35	RIGHT 4	LEFT	SIZE 9" INCH CASTING

TYPE OF CONST.	COMMENTS
BLOCK	4.3' 1.0' 6.3'
BRICK	
SECTIONAL ☒	


ADJUSTING RINGS	TYPE	NO.	DEPTH	COMMENTS
BLOCK				
BRICK				
CONC. RINGS	☒	3		

DEPTH FROM BOTTOM OF M.H.	ELEV.
TO TOP OF CASTING	14/4.3
DISTANCE FROM HIGHEST FLOW LINE TO TOP OF CASTING	
ETC.	
INV.	

SIZES OF ALL-
PIPES AND
DIRECTION OF
FLOW

DESIGN	
ELEVATION - TOP	883.98
FINAL ELEVATION	
DIFFERENCES	

ADJUST
RECONSTRUCT

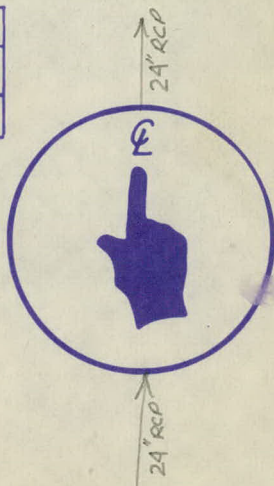

STRUCTURAL DATA TYPE

STORM	ELECTRIC	WATER	
SANITARY <i>X</i>	TELEPHONE	OTHER	
STATION	RIGHT	LEFT	SIZE
<i>9+56</i>		<i>23'</i>	<i>9"</i> INCH CASTING

TYPE OF CONST.	COMMENTS
BLOCK <i>X</i>	
BRICK	
SECTIONAL	


ADJUSTING RINGS	TYPE	NO.	DEPTH	COMMENTS
BLOCK				
BRICK				
CONC. RINGS				

DEPTH FROM BOTTOM OF M.H. TO TOP OF CASTING	ELEV.
	<i>15</i> <i>2</i>
DISTANCE FROM HIGHEST FLOW LINE TO TOP OF CASTING	<i>9.2'</i>
ETC.	
INV.	

SIZES OF ALL PIPES AND DIRECTION OF FLOW	
---	--

DESIGN	
ELEVATION - TOP	<i>885.81</i>
FINAL ELEVATION	
DIFFERENCES	

ADJUST	
RECONSTRUCT	

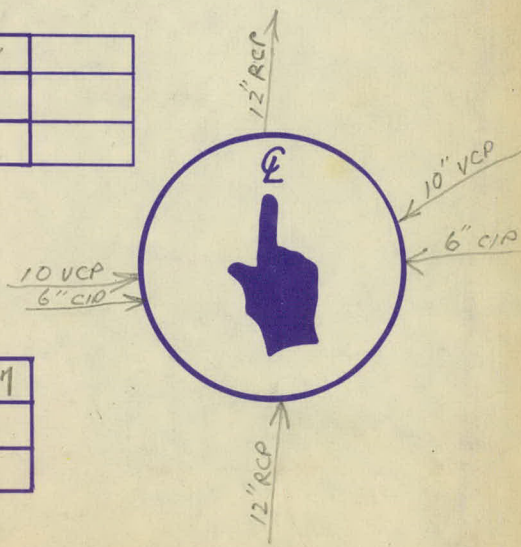

STRUCTURAL DATA TYPE

STORM	ELECTRIC	WATER	
SANITARY <i>X</i>	TELEPHONE	OTHER	
STATION	RIGHT	LEFT	SIZE
<i>9+57</i>	<i>£</i>		<i>9"</i> INCH CASTING

TYPE OF CONST.	COMMENTS
BLOCK	<i>4.5'</i> <i>4.0'</i> <i>6.0'</i>
BRICK	
SECTIONAL	

ADJUSTING RINGS	TYPE	NO.	DEPTH	COMMENTS
BLOCK				
BRICK				
CONC. RINGS	<i>X</i>	<i>3</i>		

DEPTH FROM BOTTOM OF M.H.	ELEV.
TO TOP OF CASTING	<i>17.0</i>
DISTANCE FROM HIGHEST FLOW LINE TO TOP OF CASTING	<i>9.3</i>
ETC.	
INV.	


SIZES OF ALL
PIPES AND
DIRECTION OF
FLOW

DESIGN

ELEVATION - TOP	<i>886.05</i>
FINAL ELEVATION	
DIFFERENCES	

ADJUST

RECONSTRUCT

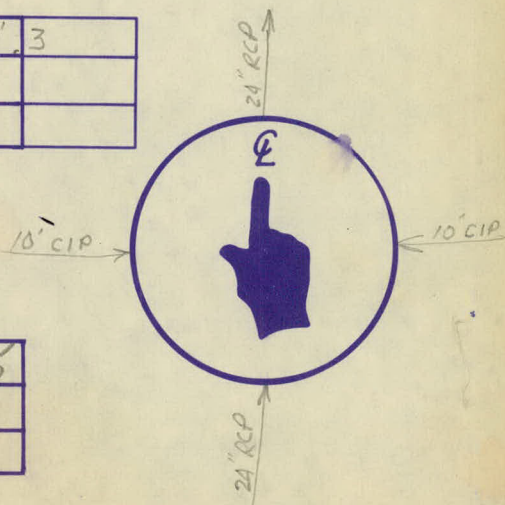

STRUCTURAL DATA TYPE

STORM	ELECTRIC	WATER	
SANITARY ☒	TELEPHONE	OTHER	
STATION <i>11+16</i>	LEFT <i>7</i>	RIGHT	SIZE <i>9"</i> INCH CASTING

TYPE OF CONST.	COMMENTS			
BLOCK				
BRICK ☒				
SECTIONAL				
ADJUSTING RINGS	TYPE	NO.	DEPTH	COMMENTS
BLOCK				
BRICK				
CONC. RINGS				

DEPTH FROM
BOTTOM OF M.H.
TO TOP OF CASTING

DISTANCE
FROM HIGHEST
FLOW LINE TO
TOP OF CASTING

ETC.

INV.

ELEV.

17.2

17.2

SIZES OF ALL
PIPES AND
DIRECTION OF
FLOW


DESIGN

ELEVATION - TOP
FINAL ELEVATION
DIFFERENCES



ADJUST

RECONSTRUCT

8" VCP →

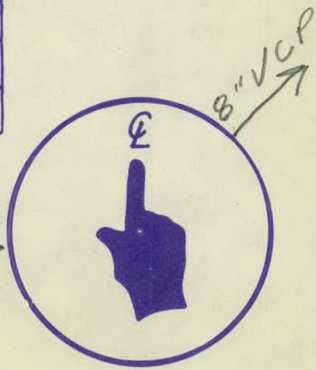

STRUCTURAL DATA TYPE

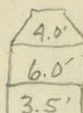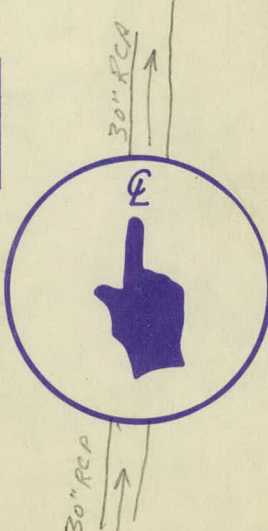STORM		ELECTRIC		WATER	
SANITARY	X	TELEPHONE		OTHER	
STATION		RIGHT	LEFT	SIZE	
1/1+20		2			INCH CASTING
TYPE OF CONST.		COMMENTS			
BLOCK		CONC. CONE 			
BRICK					
SECTIONAL					
ADJUSTING RINGS	TYPE	NO.	DEPTH	COMMENTS	
BLOCK					
BRICK					
CONC. RINGS		4			
DEPTH FROM BOTTOM OF M.H TO TOP OF CASTING DISTANCE FROM HIGHEST FLOW LINE TO TOP OF CASTING ETC. INV.		ELEV.			
		19.3			
		19.3			
SIZES OF ALL PIPES AND DIRECTION OF FLOW		24" RCP			
DESIGN					
ELEVATION - TOP		887.39			
FINAL ELEVATION					
DIFFERENCES					
ADJUST					
RECONSTRUCT					

STRUCTURAL DATA TYPE

STORM	ELECTRIC	WATER	
SANITARY	TELEPHONE	OTHER	NSP
STATION	LEFT	RIGHT	SIZE
11741		24	
			INCH CASTING

TYPE OF CONST.	COMMENTS
BLOCK	VAULT
BRICK	
SECTIONAL	

ADJUSTING RINGS	TYPE	NO.	DEPTH	COMMENTS
BLOCK				2 ROWS BRICK 9" CASTING
BRICK	X			
CONC. RINGS				

DEPTH FROM BOTTOM OF M.H.	ELEV.
TO TOP OF CASTING	
DISTANCE FROM HIGHEST FLOW LINE TO TOP OF CASTING	
ETC.	
INV.	

SIZES OF ALL
PIPES AND
DIRECTION OF
FLOW

DESIGN

ELEVATION - TOP	887.25
FINAL ELEVATION	
DIFFERENCES	

ADJUST
RECONSTRUCT



STRUCTURAL DATA TYPE

STORM	ELECTRIC	WATER	
SANITARY	TELEPHONE	OTHER	
STATION	LEFT	RIGHT	SIZE
13+46	24		INCH CASTING

TYPE OF CONST.	COMMENTS UNABLE to LOCATE J.A. (NOT THERE)
BLOCK	
BRICK	
SECTIONAL	

ADJUSTING RINGS	TYPE	NO.	DEPTH	COMMENTS
BLOCK				
BRICK				
CONC. RINGS				


DEPTH FROM BOTTOM OF M.H.	ELEV.
TO TOP OF CASTING	
DISTANCE FROM HIGHEST FLOW LINE TO TOP OF CASTING	
ETC.	
INV.	

SIZES OF ALL
PIPES AND
DIRECTION OF
FLOW

DESIGN	
ELEVATION - TOP	
FINAL ELEVATION	
DIFFERENCES	

ADJUST

RECONSTRUCT

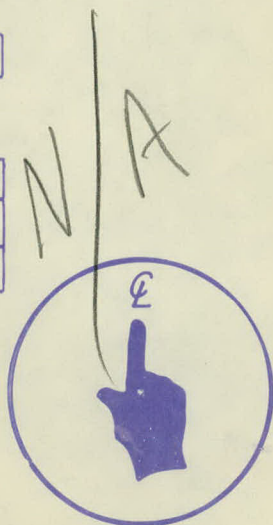

STRUCTURAL DATA TYPE

STORM	ELECTRIC	WATER	
SANITARY X	TELEPHONE	OTHER	
STATION	LEFT	RIGHT	SIZE
13+42		2'	9 INCH CASTING

TYPE OF CONST.	COMMENTS
BLOCK	CONC. CONE
BRICK	
SECTIONAL	

ADJUSTING RINGS	TYPE	NO.	DEPTH	COMMENTS
BLOCK				
BRICK				
CONC. RINGS	6			


DEPTH FROM BOTTOM OF M.H.	ELEV.
TO TOP OF CASTING	
DISTANCE FROM HIGHEST FLOW LINE TO TOP OF CASTING	19.7
ETC.	
INV.	

SIZES OF ALL
PIPES AND
DIRECTION OF
FLOW

DESIGN	
ELEVATION - TOP	
FINAL ELEVATION	
DIFFERENCES	

ADJUST

RECONSTRUCT

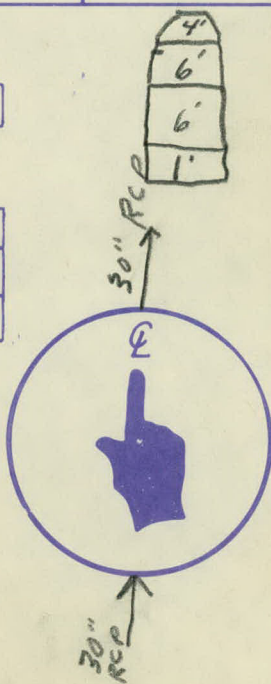

STRUCTURAL DATA TYPE

STORM	ELECTRIC	WATER	
SANITARY ☒	TELEPHONE	OTHER	
STATION <i>13+44</i>	RIGHT ☒	LEFT ☒	SIZE <i>9"</i>
	<i>2 31'</i>		INCH CASTING

TYPE OF CONST.	COMMENTS
BLOCK	<i>CONC. CONE</i> <i>5.0'</i> <i>8.0'</i> <i>4.6'</i>
BRICK	
SECTIONAL ☒	

ADJUSTING RINGS	TYPE	NO.	DEPTH	COMMENTS
BLOCK				
BRICK				
CONC. RINGS		<i>3</i>		


DEPTH FROM BOTTOM OF M.H.	ELEV.
TO TOP OF CASTING	<i>19.7</i>
DISTANCE FROM HIGHEST FLOW LINE TO TOP OF CASTING	<i>11.1</i>
ETC.	
INV.	

SIZES OF ALL
PIPES AND
DIRECTION OF
FLOW

DESIGN	
ELEVATION - TOP	<i>887.16</i>
FINAL ELEVATION	
DIFFERENCES	

ADJUST

RECONSTRUCT

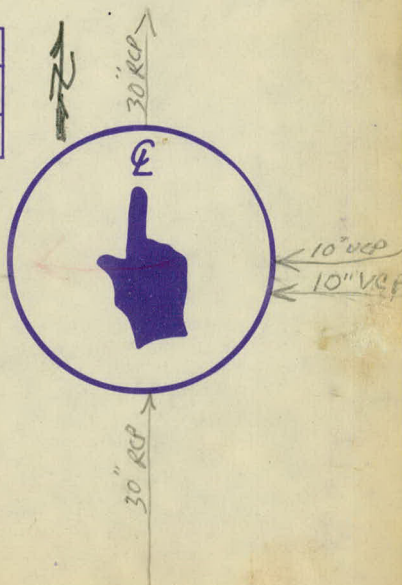

STRUCTURAL DATA TYPE

STORM	ELECTRIC	WATER	
SANITARY ☒	TELEPHONE	OTHER	
STATION	LEFT	RIGHT	SIZE
13+51	36		11" INCH CASTING

TYPE OF CONST.	COMMENTS
BLOCK	ECCENT CONC
BRICK	
SECTIONAL	


ADJUSTING RINGS	TYPE	NO.	DEPTH	COMMENTS
BLOCK				
BRICK				
CONC. RINGS	3			

DEPTH FROM BOTTOM OF M.H. TO TOP OF CASTING	ELEV.	
DISTANCE FROM HIGHEST FLOW LINE TO TOP OF CASTING		
ETC.		
INV.		



SIZES OF ALL PIPES AND DIRECTION OF FLOW	
---	--

12" VCP
→

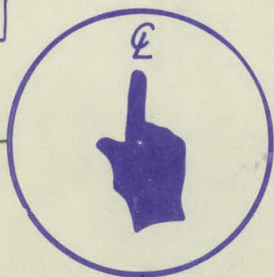

DESIGN	
ELEVATION - TOP	885.83
FINAL ELEVATION	
DIFFERENCES	
ADJUST	
RECONSTRUCT	

12" VCP
↓

STRUCTURAL DATA TYPE *TCAAP*

STORM	ELECTRIC	WATER	
SANITARY	TELEPHONE	OTHER	
STATION	LEFT	RIGHT	SIZE
<i>15 + 28</i>	<i>10</i>		INCH CASTING

TYPE OF CONST.	COMMENTS
BLOCK	
BRICK	
SECTIONAL	

ADJUSTING RINGS	TYPE	NO.	DEPTH	COMMENTS
BLOCK				
BRICK				
CONC. RINGS				

DEPTH FROM BOTTOM OF M.H.	ELEV.
TO TOP OF CASTING	
DISTANCE FROM HIGHEST FLOW LINE TO TOP OF CASTING	
ETC.	
INV.	

SIZES OF ALL
PIPES AND
DIRECTION OF
FLOW

DESIGN	
ELEVATION - TOP	<i>889.35</i>
FINAL ELEVATION	
DIFFERENCES	
ADJUST	
RECONSTRUCT	



STRUCTURAL DATA TYPE

STORM	ELECTRIC	WATER	
SANITARY ☒	TELEPHONE	OTHER	

STATION <i>16+10</i>	LEFT	RIGHT <i>32'</i>	SIZE	<i>9"</i> INCH CASTING
-------------------------	------	---------------------	------	---------------------------

TYPE OF CONST.


BLOCK ☒

BRICK

SECTIONAL

COMMENTS

CONC. CONE

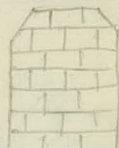

ADJUSTING RINGS

TYPE

NO.

DEPTH

COMMENTS

BLOCK

BRICK

CONC. RINGS

2

DEPTH FROM
BOTTOM OF M.H.
TO TOP OF CASTING

ELEV.

9.6'

DISTANCE
FROM HIGHEST
FLOW LINE TO
TOP OF CASTING

9.6'

ETC.

INV.

SIZES OF ALL
PIPES AND
DIRECTION OF
FLOW

DESIGN

ELEVATION - TOP


887.11

FINAL ELEVATION

DIFFERENCES

ADJUST

RECONSTRUCT

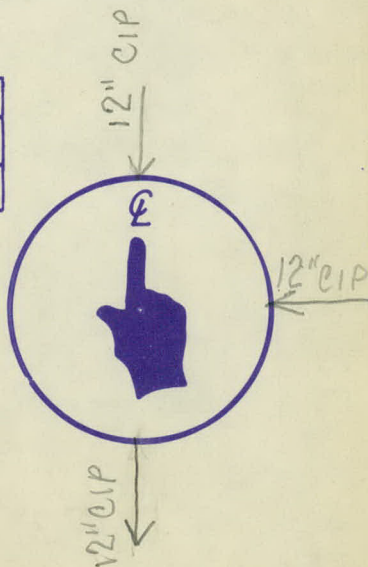

STRUCTURAL DATA TYPE

STORM	ELECTRIC	WATER	
SANITARY ☒	TELEPHONE	OTHER	
STATION 16+33	LEFT 1'	RIGHT	SIZE 9"
			INCH CASTING


TYPE OF CONST.	COMMENTS
BLOCK	CONC. CONE 5.0' 8.0' 4.5'
BRICK	
SECTIONAL ☒	

ADJUSTING RINGS	TYPE	NO.	DEPTH	COMMENTS
BLOCK				
BRICK				
CONC. RINGS 1				

DEPTH FROM BOTTOM OF M.H TO TOP OF CASTING	ELEV.
	20.1
DISTANCE FROM HIGHEST FLOW LINE TO TOP OF CASTING	20.1
ETC.	
INV.	

SIZES OF ALL
PIPES AND
DIRECTION OF
FLOW

DESIGN	
ELEVATION - TOP	887.29
FINAL ELEVATION	
DIFFERENCES	
ADJUST	
RECONSTRUCT	

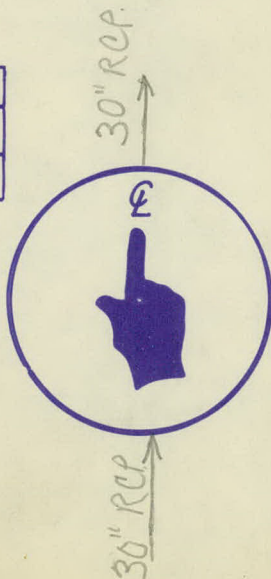

STRUCTURAL DATA TYPE

STORM

ELECTRIC

WATER

SANITARY

X

TELEPHONE

OTHER

STATION

LEFT

RIGHT

SIZE

11"

17+23

34

INCH CASTING

TYPE OF CONST.

COMMENTS

BLOCK

X

BRICK

SECTIONAL

ADJUSTING RINGS

TYPE

NO.

DEPTH

COMMENTS

BLOCK

BRICK

CONC. RINGS

DEPTH FROM
BOTTOM OF M.H.
TO TOP OF CASTING

ELEV.

8.4

DISTANCE
FROM HIGHEST
FLOW LINE TO
TOP OF CASTING

ETC.

INV.

SIZES OF ALL
PIPES AND
DIRECTION OF
FLOW

DESIGN

ELEVATION - TOP


FINAL ELEVATION

DIFFERENCES

ADJUST

RECONSTRUCT

DEAD END

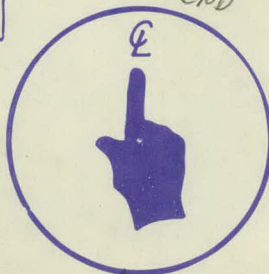

8" VCP

STRUCTURAL DATA TYPE

 STORM ☒

 ELECTRIC ☐

 WATER ☐

 SANITARY ☐

 TELEPHONE ☐

 OTHER ☐

STATION

LEFT

RIGHT

SIZE

17+85

84

9" INCH CASTING


TYPE OF CONST.

COMMENTS

BLOCK

BRICK

SECTIONAL

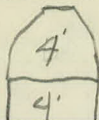☒


CONC.

CONE

ADJUSTING RINGS

TYPE

NO.

DEPTH

COMMENTS

BLOCK

BRICK

CONC. RINGS

/

4

 DEPTH FROM
BOTTOM OF M.H.
TO TOP OF CASTING

ELEV.

9.95

 DISTANCE
FROM HIGHEST
FLOW LINE TO
TOP OF CASTING

ETC.

INV.

 SIZES OF ALL
PIPES AND
DIRECTION OF
FLOW

DESIGN

ELEVATION - TOP

FINAL ELEVATION


DIFFERENCES

ADJUST

RECONSTRUCT

876.16

36" RCP

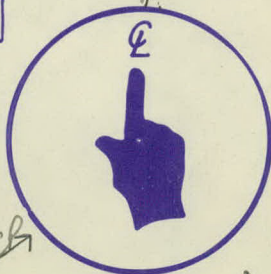

O.K.

STRUCTURAL DATA TYPE

STORM	ELECTRIC	WATER	
SANITARY ☒	TELEPHONE	OTHER	
STATION	LEFT	RIGHT	SIZE
18407	Q		9" INCH CASTING

TYPE OF CONST.	COMMENTS
BLOCK	5.0' 8.0' 4.0'
BRICK	
SECTIONAL	

ADJUSTING RINGS	TYPE	NO.	DEPTH	COMMENTS
BLOCK				
BRICK				
CONC. RINGS	4			

DEPTH FROM BOTTOM OF M.H. TO TOP OF CASTING	ELEV.
	19.7
DISTANCE FROM HIGHEST FLOW LINE TO TOP OF CASTING	19.7
ETC.	
INV.	

SIZES OF ALL
PIPES AND
DIRECTION OF
FLOW

DESIGN	
ELEVATION - TOP	886.23
FINAL ELEVATION	
DIFFERENCES	

ADJUST

RECONSTRUCT



STRUCTURAL DATA TYPE

STORM		ELECTRIC		WATER	
SANITARY	☒	TELEPHONE		OTHER	
STATION	LEFT	RIGHT	SIZE	9"	
18+71	74'			INCH CASTING	

TYPE OF CONST.	COMMENTS
BLOCK	ECCENTRIC CONE
BRICK	
SECTIONAL	

7.0' 

ADJUSTING RINGS	TYPE	NO.	DEPTH	COMMENTS
BLOCK	☒			
BRICK				
CONC. RINGS	1			

DEPTH FROM BOTTOM OF M.H TO TOP OF CASTING	ELEV.
11.6'	
DISTANCE FROM HIGHEST FLOW LINE TO TOP OF CASTING	
11.6'	
ETC.	
INV.	

SIZES OF ALL PIPES AND DIRECTION OF FLOW	30" RCP.		30" RCP.
DESIGN			

ELEVATION - TOP	876.35
FINAL ELEVATION	
DIFFERENCES	
ADJUST	
RECONSTRUCT	

12" CIP

STRUCTURAL DATA TYPE

STORM	ELECTRIC	WATER	
SANITARY	TELEPHONE	OTHER	
STATION	LEFT	RIGHT	SIZE
19+70	LT 42'		11" INCH CASTING

TYPE OF CONST.	COMMENTS
BLOCK	
BRICK	
SECTIONAL	X

ADJUSTING RINGS	TYPE	NO.	DEPTH	COMMENTS
BLOCK				
BRICK				
CONC. RINGS	0			

DEPTH FROM BOTTOM OF M.H TO TOP OF CASTING	ELEV.
DISTANCE FROM HIGHEST FLOW LINE TO TOP OF CASTING	19.6
ETC.	
INV.	


SIZES OF ALL
PIPES AND
DIRECTION OF
FLOW

DESIGN

ELEVATION - TOP	885.15
FINAL ELEVATION	
DIFFERENCES	

ADJUST

RECONSTRUCT

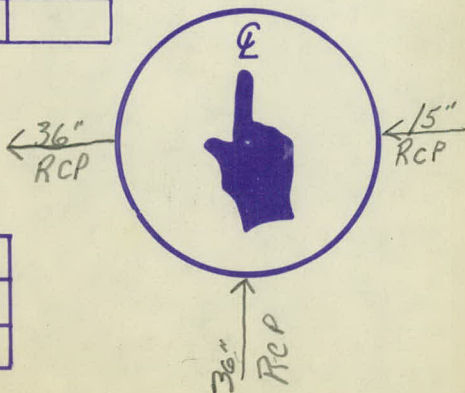

STRUCTURAL DATA TYPE

STORM	ELECTRIC	WATER	
SANITARY	TELEPHONE	OTHER	
STATION	LEFT	RIGHT	SIZE
19+70	52		
			INCH CASTING

TYPE OF CONST.	COMMENTS
BLOCK	
BRICK	
SECTIONAL	X

ADJUSTING RINGS	TYPE	NO.	DEPTH	COMMENTS
BLOCK				
BRICK				
CONC. RINGS	3			

DEPTH FROM BOTTOM OF M.H.	ELEV.
TO TOP OF CASTING	20.0
DISTANCE FROM HIGHEST FLOW LINE TO TOP OF CASTING	
ETC.	
INV.	

SIZES OF ALL PIPES AND DIRECTION OF FLOW	
---	--

DESIGN ELEVATION - TOP	885.75
FINAL ELEVATION	
DIFFERENCES	

ADJUST	
RECONSTRUCT	

STRUCTURAL DATA TYPE

STORM	ELECTRIC	WATER	
SANITARY	TELEPHONE	OTHER	✓ TCAAP
STATION	LEFT	RIGHT	SIZE
20+17	13'		
			INCH CASTING

TYPE OF CONST.	COMMENTS
BLOCK	
BRICK	
SECTIONAL	

ADJUSTING RINGS	TYPE	NO.	DEPTH	COMMENTS
BLOCK				
BRICK				
CONC. RINGS				

DEPTH FROM BOTTOM OF M.H. TO TOP OF CASTING	ELEV.
DISTANCE FROM HIGHEST FLOW LINE TO TOP OF CASTING	
ETC.	
INV.	

SIZES OF ALL PIPES AND DIRECTION OF FLOW	
---	--

DESIGN	
ELEVATION - TOP	
FINAL ELEVATION	
DIFFERENCES	

ADJUST	
RECONSTRUCT	



STRUCTURAL DATA TYPE

STORM	☒	ELECTRIC	☐	WATER	☐
SANITARY	☐	TELEPHONE	☐	OTHER	☐
STATION		LEFT	RIGHT	SIZE	
21+71			44		9" INCH CASTING

TYPE OF CONST.	COMMENTS
BLOCK	
BRICK	
SECTIONAL	

ADJUSTING RINGS	TYPE	NO.	DEPTH	COMMENTS
BLOCK				None
BRICK				
CONC. RINGS				

DEPTH FROM BOTTOM OF M.H TO TOP OF CASTING	ELEV.	
		10.4
DISTANCE FROM HIGHEST FLOW LINE TO TOP OF CASTING		
ETC.		
INV.		874.40
SIZES OF ALL PIPES AND DIRECTION OF FLOW		
DESIGN		
ELEVATION - TOP		
FINAL ELEVATION		
DIFFERENCES		
ADJUST		
RECONSTRUCT		

STRUCTURAL DATA TYPE

STORM	ELECTRIC	WATER	
SANITARY	TELEPHONE	OTHER	
STATION	LEFT	RIGHT	SIZE
21+83		42	9" INCH CASTING

TYPE OF CONST.	COMMENTS
BLOCK	4' 4' 6' ECC. CONE
BRICK	
SECTIONAL	

ADJUSTING RINGS	TYPE	NO.	DEPTH	COMMENTS
BLOCK				
BRICK				
CONC. RINGS	2			

DEPTH FROM BOTTOM OF M.H. TO TOP OF CASTING	ELEV.
DISTANCE FROM HIGHEST FLOW LINE TO TOP OF CASTING	16.7
ETC.	
INV.	

SIZES OF ALL PIPES AND DIRECTION OF FLOW	
DESIGN	
ELEVATION - TOP	
FINAL ELEVATION	
DIFFERENCES	
ADJUST	
RECONSTRUCT	

STRUCTURAL DATA TYPE

STORM	☒	ELECTRIC		WATER	
SANITARY		TELEPHONE		OTHER	
STATION	LEFT	RIGHT	SIZE	9" INCH CASTING	
22+07	"	30			

TYPE OF CONST.		COMMENTS
BLOCK	☒	SURFACE DRAW
BRICK		
SECTIONAL		

ADJUSTING RINGS	TYPE	NO.	DEPTH	COMMENTS
BLOCK				
BRICK	☒			
CONC. RINGS				

DEPTH FROM BOTTOM OF M.H.		ELEV.	
TO TOP OF CASTING			2.8
DISTANCE FROM HIGHEST FLOW LINE TO TOP OF CASTING			
ETC.			
INV.			


SIZES OF ALL
PIPES AND
DIRECTION OF
FLOW

DESIGN

ELEVATION - TOP	883.69
FINAL ELEVATION	
DIFFERENCES	

ADJUST

RECONSTRUCT

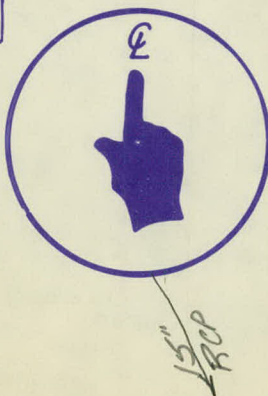

STRUCTURAL DATA TYPE

STORM	☒	ELECTRIC		WATER	
SANITARY		TELEPHONE		OTHER	
STATION		LEFT	RIGHT	SIZE	11"
22+09			42		INCH CASTING

TYPE OF CONST.	COMMENTS
BLOCK	C.B.
BRICK	
SECTIONAL	

ADJUSTING RINGS	TYPE	NO.	DEPTH	COMMENTS
BLOCK				
BRICK				
CONC. RINGS				

DEPTH FROM BOTTOM OF M.H TO TOP OF CASTING	ELEV.
	3.7
DISTANCE FROM HIGHEST FLOW LINE TO TOP OF CASTING	
ETC.	
INV.	


SIZES OF ALL
PIPES AND
DIRECTION OF
FLOW

DESIGN

ELEVATION - TOP	883.94
FINAL ELEVATION	
DIFFERENCES	

ADJUST

RECONSTRUCT

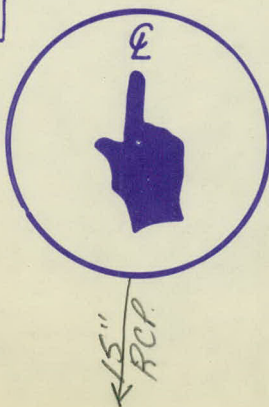

STRUCTURAL DATA TYPE

STORM	ELECTRIC	WATER	
SANITARY	TELEPHONE	OTHER	
STATION	LEFT	RIGHT	SIZE
24+67		29	
			INCH CASTING

TYPE OF CONST.	COMMENTS
BLOCK	C.B.
BRICK	
SECTIONAL	

ADJUSTING RINGS	TYPE	NO.	DEPTH	COMMENTS
BLOCK				
BRICK				
CONC. RINGS				

DEPTH FROM BOTTOM OF M.H TO TOP OF CASTING	ELEV.
	29
DISTANCE FROM HIGHEST FLOW LINE TO TOP OF CASTING	
ETC.	
INV.	


SIZES OF ALL
PIPES AND
DIRECTION OF
FLOW

DESIGN

ELEVATION - TOP	883 09
FINAL ELEVATION	
DIFFERENCES	

ADJUST

RECONSTRUCT

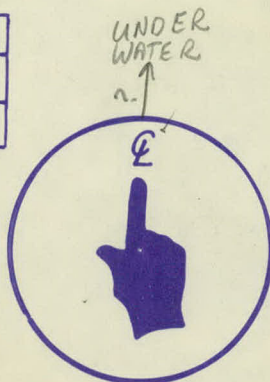

STRUCTURAL DATA TYPE

STORM



ELECTRIC

WATER

SANITARY

TELEPHONE

OTHER

STATION

LEFT

RIGHT

SIZE

24+71

30

INCH CASTING

TYPE OF CONST.

COMMENTS

BLOCK

BRICK

SECTIONAL

G.B.

ADJUSTING RINGS

TYPE

NO.

DEPTH

COMMENTS

BLOCK

BRICK

CONC. RINGS

DEPTH FROM
BOTTOM OF M.H.

ELEV.

TO TOP OF CASTING

2.8

DISTANCE
FROM HIGHEST
FLOW LINE TO
TOP OF CASTING

ETC.

INV.

SIZES OF ALL
PIPES AND
DIRECTION OF
FLOW

DESIGN

ELEVATION - TOP

883.09

FINAL ELEVATION

DIFFERENCES

ADJUST

RECONSTRUCT



STRUCTURAL DATA TYPE

STORM	☒	ELECTRIC		WATER		
SANITARY		TELEPHONE		OTHER		

STATION	LEFT	RIGHT	SIZE	
24+72	82			INCH CASTING

TYPE OF CONST.		COMMENTS
BLOCK	☒	C.B
BRICK		
SECTIONAL		

ADJUSTING RINGS	TYPE	NO.	DEPTH	COMMENTS
BLOCK				
BRICK				
CONC. RINGS				

DEPTH FROM
BOTTOM OF M.H.
TO TOP OF CASTING

DISTANCE
FROM HIGHEST
FLOW LINE TO
TOP OF CASTING

ETC.

INV.

ELEV.

2.9

SIZES OF ALL
PIPES AND
DIRECTION OF
FLOW

DESIGN

ELEVATION - TOP


982.41

INAL ELEVATION

DIFFERENCES

ADJUST

RECONSTRUCT

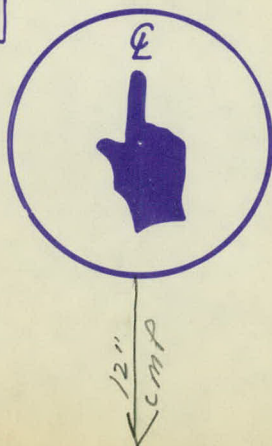

UNABLE TO FIND APPROX

STRUCTURAL DATA TYPE

STORM ☒	ELECTRIC ☐	WATER ☐	
SANITARY ☐	TELEPHONE ☐	OTHER ☐	
STATION	LEFT	RIGHT	SIZE
25+18	82		
			INCH CASTING

TYPE OF CONST.	C.B.
BLOCK ☒	
BRICK ☐	
SECTIONAL ☐	


ADJUSTING RINGS	TYPE	NO.	DEPTH	COMMENTS
BLOCK				
BRICK				
CONC. RINGS				

DEPTH FROM BOTTOM OF M.H. TO TOP OF CASTING DISTANCE FROM HIGHEST FLOW LINE TO TOP OF CASTING ETC. INV.	<table style="width: 100%;"> <tr> <td style="width: 40%;"></td> <td style="width: 60%; text-align: center;">ELEV.</td> </tr> <tr> <td></td> <td style="text-align: center;">1.5</td> </tr> <tr> <td></td> <td></td> </tr> <tr> <td></td> <td></td> </tr> <tr> <td></td> <td></td> </tr>

SIZES OF ALL PIPES AND DIRECTION OF FLOW	
---	--

DESIGN	
ELEVATION - TOP	882.40±
FINAL ELEVATION	
DIFFERENCES	

ADJUST	
RECONSTRUCT	

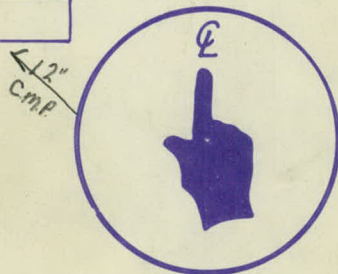

STRUCTURAL DATA TYPE

STORM

ELECTRIC

WATER

SANITARY



TELEPHONE

OTHER

STATION

LEFT

RIGHT

SIZE

25+40

5'

9" INCH CASTING

TYPE OF CONST.

COMMENTS


BLOCK

CONC.

BRICK

CONE

SECTIONAL

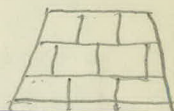

ADJUSTING RINGS

TYPE

NO.

DEPTH

COMMENTS

BLOCK

BRICK

CONC. RINGS

—

DEPTH FROM
BOTTOM OF M.H.
TO TOP OF CASTING

ELEV.

15.9'

DISTANCE
FROM HIGHEST
FLOW LINE TO
TOP OF CASTING

15.9'

ETC.

INV.

SIZES OF ALL
PIPES AND
DIRECTION OF
FLOW

DESIGN

ELEVATION - TOP


883.39

FINAL ELEVATION

DIFFERENCES

ADJUST

RECONSTRUCT

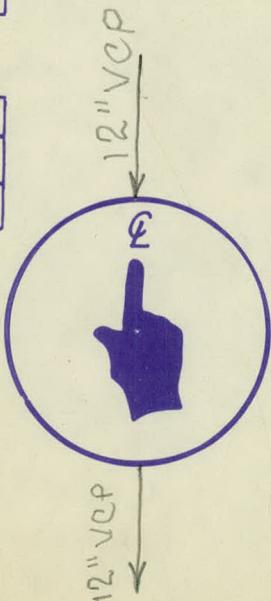

STRUCTURAL DATA TYPE

STORM	ELECTRIC	WATER	
SANITARY	TELEPHONE	OTHER	
STATION	LEFT	RIGHT	SIZE
25+48		18	
			INCH CASTING

TYPE OF CONST.	COMMENTS <i>NSP M.H.</i>
BLOCK	
BRICK	
SECTIONAL	

ADJUSTING RINGS	TYPE	NO.	DEPTH	COMMENTS
BLOCK				
BRICK				
CONC. RINGS				

DEPTH FROM BOTTOM OF M.H. TO TOP OF CASTING		ELEV.	
DISTANCE FROM HIGHEST FLOW LINE TO TOP OF CASTING			
ETC.			
INV.			

SIZES OF ALL
PIPES AND
DIRECTION OF
FLOW

DESIGN

ELEVATION - TOP	883.56
FINAL ELEVATION	
DIFFERENCES	

ADJUST

RECONSTRUCT



STRUCTURAL DATA TYPE

STORM	ELECTRIC	WATER	
SANITARY ✓	TELEPHONE	OTHER	
STATION 26+70	LEFT	RIGHT 6'	SIZE 9" INCH CASTING

TYPE OF CONST.	COMMENTS
BLOCK	ALL BLOCK CONST. 
BRICK	
SECTIONAL	

ADJUSTING RINGS	TYPE	NO.	DEPTH	COMMENTS
BLOCK	✓			
BRICK				
CONC. RINGS	3			


DEPTH FROM BOTTOM OF M.H TO TOP OF CASTING	ELEV.
DISTANCE FROM HIGHEST FLOW LINE TO TOP OF CASTING	
ETC.	
INV.	

SIZES OF ALL
PIPES AND
DIRECTION OF
FLOW

DESIGN

ELEVATION - TOP	881.94
FINAL ELEVATION	
DIFFERENCES	


ADJUST
RECONSTRUCT

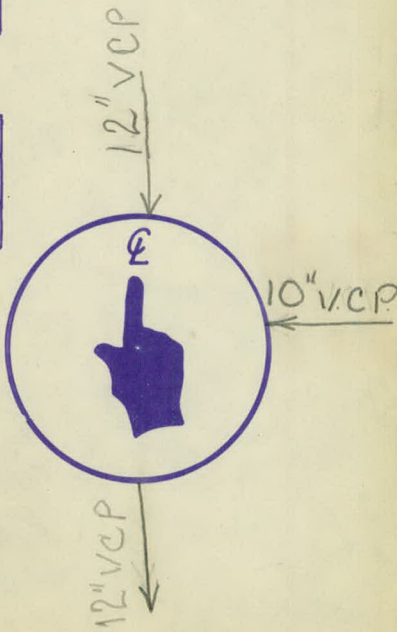

STRUCTURAL DATA TYPE

STORM	☒	ELECTRIC		WATER	
SANITARY		TELEPHONE		OTHER	

STATION	LEFT	RIGHT	SIZE	INCH CASTING
28+25		24	7	

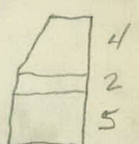TYPE OF CONST.	COMMENTS
BLOCK	
BRICK	
SECTIONAL	

ADJUSTING RINGS	TYPE	NO.	DEPTH	COMMENTS
BLOCK				No Mortar
BRICK				
CONC. RINGS	☒	6	12"	

DEPTH FROM BOTTOM OF M.H. TO TOP OF CASTING	ELEV.
DISTANCE FROM HIGHEST FLOW LINE TO TOP OF CASTING	12.6
ETC.	
INV.	67.59

SIZES OF ALL
PIPES AND
DIRECTION OF
FLOW

DESIGN

ELEVATION - TOP

FINAL ELEVATION

DIFFERENCES

ADJUST

RECONSTRUCT

+ 0.19

- 5.95

15.9



960 25

81 6
5 X 966
13

76

24.876

558

29.446
167

Manhole Elevation


10th St


28+25 R+24'

STA	+	π	-	ELEV
B.M.	0.18	886.14		885.96
			5.95	880.19

Top Hyd 5th N.E. & 10th St N.E. Core

Top MH Storm Sewer.

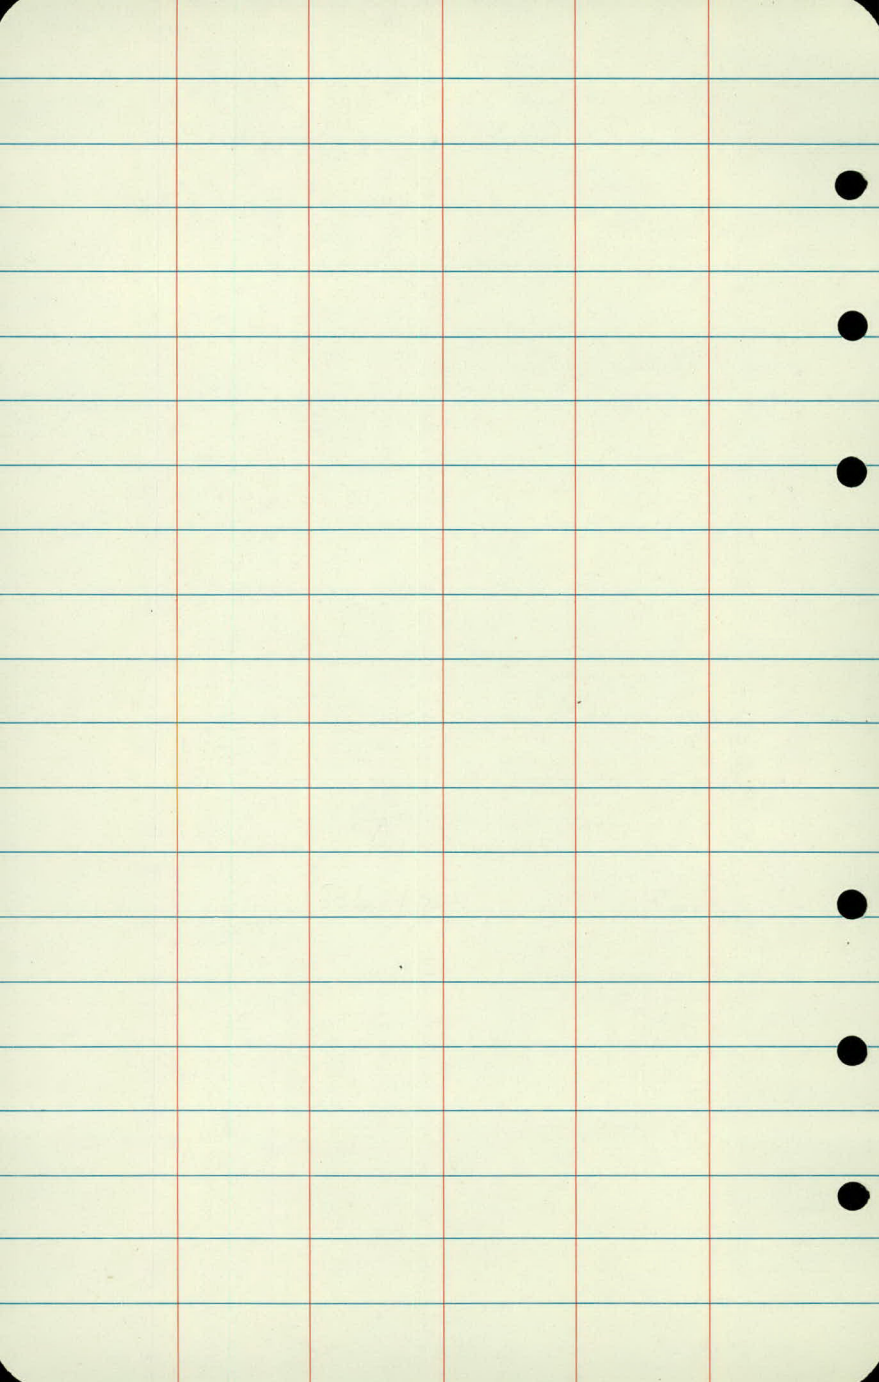

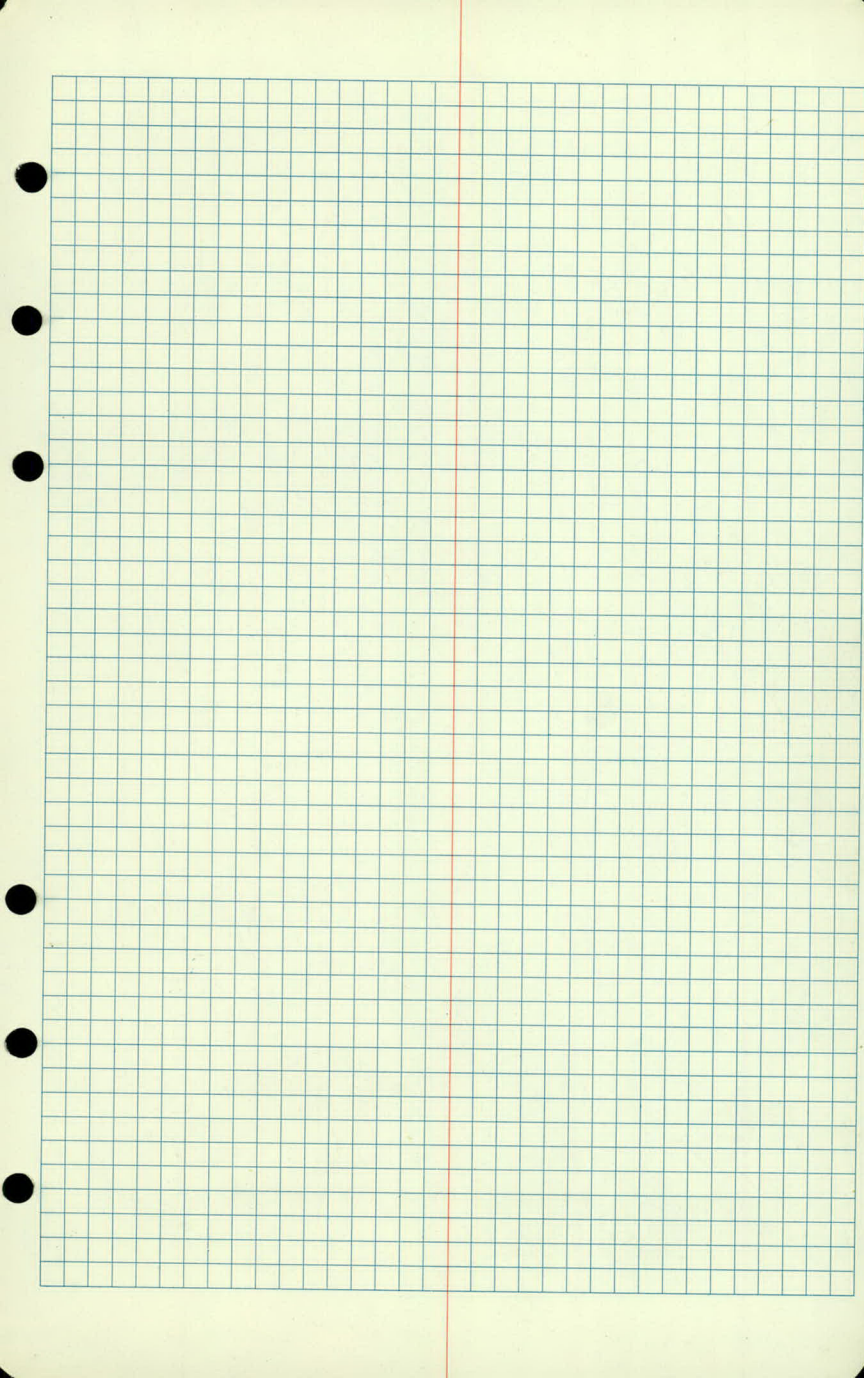

1.5

10TH ST. N.W.

PROPOSED PONDING AREA

BTWN 10TH ST., I.T.H. 694

& SERVICE DRIVE

71°34'35" P.I. to P.T.

CREW: R.M.
P.K.
P.D.

May 20, 1980
75°

Sta.	+ ^{5.2}	H.I.	-	Elev.
		Dist.	Azim.	
B.M.	9.02	892.57		883.55
P.I.:		141.92	0°00'	
± Rd		207	292-10	
fence corner		202	282-42	
± Rd		225	279-25	
"		210	262-29	
"		225	246-42	
"		280	233-53	
"		384	227-47	
fence		383	225-21	
Inv.				
Colvert		275	230-41	
fence		213	243-25	
"		192	264-16	
"		150	294-33	
"		100	314-20	
end fence		55	6-56	
edge ramp. prmt.		50	31-06	

Vert.

Rod.

Elevation

Spike in P.P. 10th St. sta. 4+41 Lt. 27'

4.02 888.55

8.65 83.92

9.75 82.82

9.0 83.57

9.00 83.57

9.10 83.47

9.25 83.32

7.25 85.32

6.9 85.67

9.7 82.87

8.6 83.97

8.7 83.87

11.7 80.87

9.8 82.77

3.9 88.67

2.5 90.07

	Dist	Azm.
edge ramp pvt.	22	90-09
"	29	169-27
"	94	208-31
"	189	215-04
"	280	217-13
"	390	218-22
Beehive C.B.	383	220-48
toe	331	221-47
Inv. 18"		
Culvert	270	223-24
Inv. 12" C.M.P.		
Culvert	267	225-44
East edge ditch	237	228-08
"	202	236-18
Inv. 18" C.M.C.		
Culvert	169	250-55
E. edge ditch	153	261-19
"	160	280-10
Inv. 18" C.M.C.		
Culvert	163	285-16
W. edge ditch	154	278-59
"	145	261-02
"	160	247-58

Rad

Elevation 3 of 4

2.1

890.47

3.0

889.57

5.1

886.87

8.9

883.67

13.0

79.57

16.8

75.77

18.3

74.27

16.6

75.97

Top Culvert

= 18.6

873.97

20.2

72.37

19.2

73.37

19.7

72.87

19.3

73.27

18.8

73.77

18.7

73.87

18.3

74.27

Top Culv.

= 17.1

875.47

18.6

73.97

18.6

73.97

18.8

73.77

18.9

73.67

	<i>Dist.</i>	<i>Azm.</i>	
<i>W.</i>			
edge ditch	206	231-16	
"	240	224-56	
top ditch	180	226-57	
"	137	243-44	
"	123	263-55	
"	135	287-54	
<i>GE.</i>	90	301-58	
<i>Inv. 12"</i>			
Culvert	56	328-21	
top slope	25	309-11	
"	68	246-41	
"	146	230-49	
apple tree	72	271-21	
top slope	311	218-50	
"	268	218-28	
"	180	217-07	
"	94	213-43	
"	21	180-39	
"	29	51-10	
	Σ	-	
<i>B.M.</i>	892.57	9.06	883.51

Rod

Elevation

4 of 4

19.3

873.27

19.5

73.07

14.8

77.77

14.5

78.07

14.8

77.77

14.5

78.07

13.2

79.37

Top Culv.

= 9.6

882.97

10.9

81.67

10.4

82.17

12.5

80.07

13.9

78.67

12.8

79.77

14.3

78.27

12.7

79.87

8.8

83.77

5.4


87.17

2.9

89.67

2.5

90.07

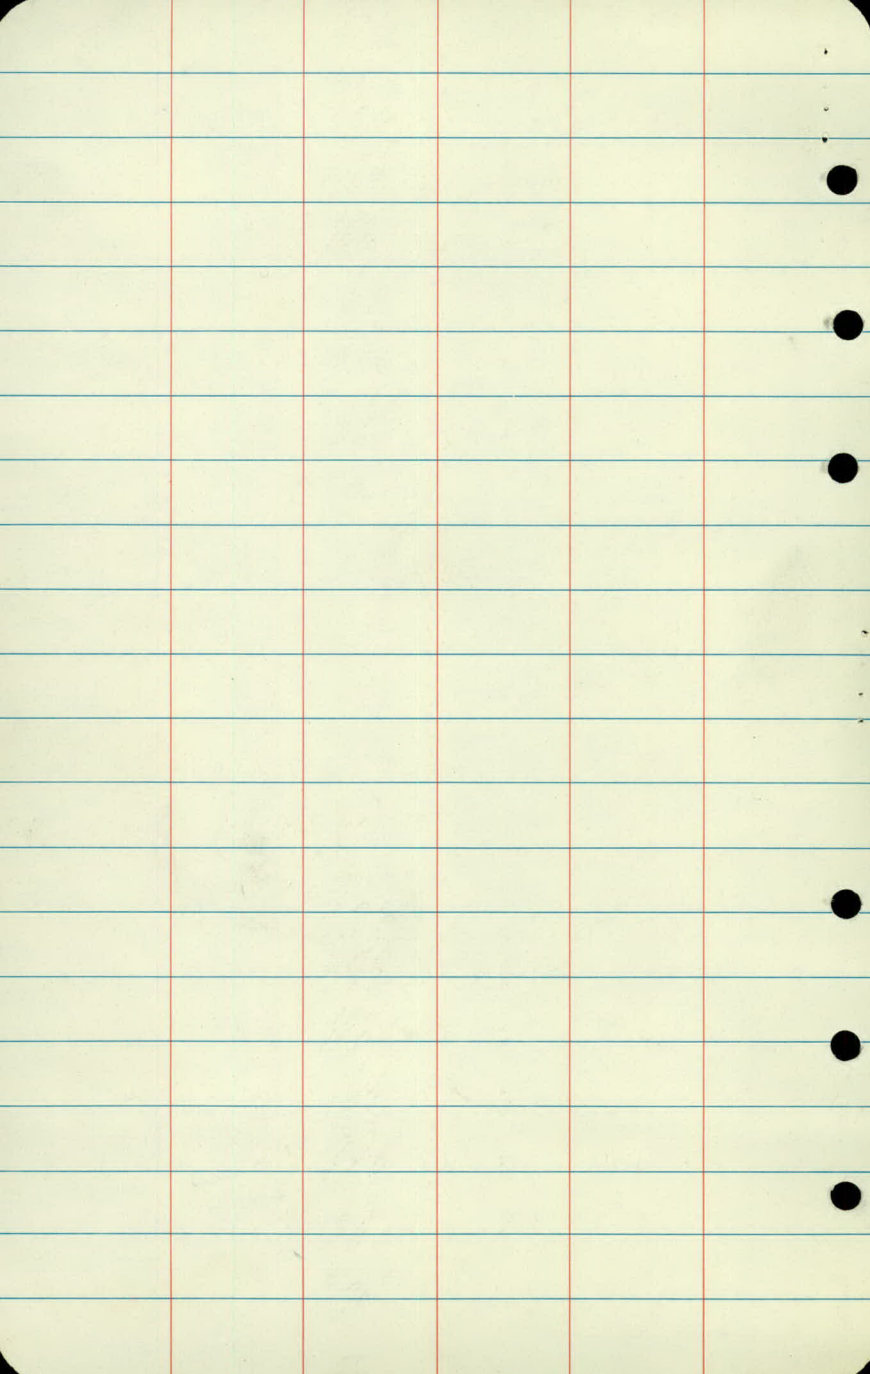

STRUCTURAL DATA TYPE

5044

Beehive

STORM	X	ELECTRIC		WATER	
SANITARY		TELEPHONE		OTHER	
STATION		RIGHT	LEFT	SIZE	
				9	INCH CASTING

TYPE OF CONST.		COMMENTS
BLOCK	X	
BRICK		
SECTIONAL		

ADJUSTING RINGS	TYPE	NO.	DEPTH	COMMENTS
BLOCK				
BRICK				
CONC. RINGS				

DEPTH FROM BOTTOM OF M.H. TO TOP OF CASTING	ELEV.
DISTANCE FROM HIGHEST FLOW LINE TO TOP OF CASTING	
ETC.	2.25
INV.	

LOCATIONS OF ALL PIPES AND DIRECTION OF FLOW

DESIGN
ELEVATION - TOP
FINAL ELEVATION
REFERENCES

ADJUST
RECONSTRUCT

