

Book - 3-A, DC 12  
OFFICE OF  
RAMSEY CO. ENG'R.

# CONSTRUCTION NOTES

CO. RD. "F"

NO. 1  
REB-100  
100A

PROJ. 31-W4

# KEUFFEL & ESSER CO.

## DRAWING MATERIALS

AND

## SURVEYING INSTRUMENTS.

### NEW YORK.

CHICAGO. ST. LOUIS. SAN FRANCISCO. MONTREAL.

### TABLES FOR EXCAVATIONS AND EMBANKMENTS.

DISTANCES FROM CENTER OF ROADWAY FOR CROSS-SECTIONING.

ROADWAY 18 FEET WIDE. SIDE SLOPES 1 TO 1.

FOR SINGLE TRACK EXCAVATION.

*"Copyright, 1895, by Keuffel & Esser Co."*

|    | 0    | .1   | .2   | .3   | .4   | .5   | .6   | .7   | .8   | .9   |    |
|----|------|------|------|------|------|------|------|------|------|------|----|
| 0  | 9.0  | 9.1  | 9.2  | 9.3  | 9.4  | 9.5  | 9.6  | 9.7  | 9.8  | 9.9  | 0  |
| 1  | 10.0 | 10.1 | 10.2 | 10.3 | 10.4 | 10.5 | 10.6 | 10.7 | 10.8 | 10.9 | 1  |
| 2  | 11.0 | 11.1 | 11.2 | 11.3 | 11.4 | 11.5 | 11.6 | 11.7 | 11.8 | 11.9 | 2  |
| 3  | 12.0 | 12.1 | 12.2 | 12.3 | 12.4 | 12.5 | 12.6 | 12.7 | 12.8 | 12.9 | 3  |
| 4  | 13.0 | 13.1 | 13.2 | 13.3 | 13.4 | 13.5 | 13.6 | 13.7 | 13.8 | 13.9 | 4  |
| 5  | 14.0 | 14.1 | 14.2 | 14.3 | 14.4 | 14.5 | 14.6 | 14.7 | 14.8 | 14.9 | 5  |
| 6  | 15.0 | 15.1 | 15.2 | 15.3 | 15.4 | 15.5 | 15.6 | 15.7 | 15.8 | 15.9 | 6  |
| 7  | 16.0 | 16.1 | 16.2 | 16.3 | 16.4 | 16.5 | 16.6 | 16.7 | 16.8 | 16.9 | 7  |
| 8  | 17.0 | 17.1 | 17.2 | 17.3 | 17.4 | 17.5 | 17.6 | 17.7 | 17.8 | 17.9 | 8  |
| 9  | 18.0 | 18.1 | 18.2 | 18.3 | 18.4 | 18.5 | 18.6 | 18.7 | 18.8 | 18.9 | 9  |
| 10 | 19.0 | 19.1 | 19.2 | 19.3 | 19.4 | 19.5 | 19.6 | 19.7 | 19.8 | 19.9 | 10 |
| 11 | 20.0 | 20.1 | 20.2 | 20.3 | 20.4 | 20.5 | 20.6 | 20.7 | 20.8 | 20.9 | 11 |
| 12 | 21.0 | 21.1 | 21.2 | 21.3 | 21.4 | 21.5 | 21.6 | 21.7 | 21.8 | 21.9 | 12 |
| 13 | 22.0 | 22.1 | 22.2 | 22.3 | 22.4 | 22.5 | 22.6 | 22.7 | 22.8 | 22.9 | 13 |
| 14 | 23.0 | 23.1 | 23.2 | 23.3 | 23.4 | 23.5 | 23.6 | 23.7 | 23.8 | 23.9 | 14 |
| 15 | 24.0 | 24.1 | 24.2 | 24.3 | 24.4 | 24.5 | 24.6 | 24.7 | 24.8 | 24.9 | 15 |
| 16 | 25.0 | 25.1 | 25.2 | 25.3 | 25.4 | 25.5 | 25.6 | 25.7 | 25.8 | 25.9 | 16 |
| 17 | 26.0 | 26.1 | 26.2 | 26.3 | 26.4 | 26.5 | 26.6 | 26.7 | 26.8 | 26.9 | 17 |
| 18 | 27.0 | 27.1 | 27.2 | 27.3 | 27.4 | 27.5 | 27.6 | 27.7 | 27.8 | 27.9 | 18 |
| 19 | 28.0 | 28.1 | 28.2 | 28.3 | 28.4 | 28.5 | 28.6 | 28.7 | 28.8 | 28.9 | 19 |
| 20 | 29.0 | 29.1 | 29.2 | 29.3 | 29.4 | 29.5 | 29.6 | 29.7 | 29.8 | 29.9 | 20 |
| 21 | 30.0 | 30.1 | 30.2 | 30.3 | 30.4 | 30.5 | 30.6 | 30.7 | 30.8 | 30.9 | 21 |
| 22 | 31.0 | 31.1 | 31.2 | 31.3 | 31.4 | 31.5 | 31.6 | 31.7 | 31.8 | 31.9 | 22 |
| 23 | 32.0 | 32.1 | 32.2 | 32.3 | 32.4 | 32.5 | 32.6 | 32.7 | 32.8 | 32.9 | 23 |
| 24 | 33.0 | 33.1 | 33.2 | 33.3 | 33.4 | 33.5 | 33.6 | 33.7 | 33.8 | 33.9 | 24 |
| 25 | 34.0 | 34.1 | 34.2 | 34.3 | 34.4 | 34.5 | 34.6 | 34.7 | 34.8 | 34.9 | 25 |
| 26 | 35.0 | 35.1 | 35.2 | 35.3 | 35.4 | 35.5 | 35.6 | 35.7 | 35.8 | 35.9 | 26 |
| 27 | 36.0 | 36.1 | 36.2 | 36.3 | 36.4 | 36.5 | 36.6 | 36.7 | 36.8 | 36.9 | 27 |
| 28 | 37.0 | 37.1 | 37.2 | 37.3 | 37.4 | 37.5 | 37.6 | 37.7 | 37.8 | 37.9 | 28 |
| 29 | 38.0 | 38.1 | 38.2 | 38.3 | 38.4 | 38.5 | 38.6 | 38.7 | 38.8 | 38.9 | 29 |
| 30 | 39.0 | 39.1 | 39.2 | 39.3 | 39.4 | 39.5 | 39.6 | 39.7 | 39.8 | 39.9 | 30 |
| 31 | 40.0 | 40.1 | 40.2 | 40.3 | 40.4 | 40.5 | 40.6 | 40.7 | 40.8 | 40.9 | 31 |
| 32 | 41.0 | 41.1 | 41.2 | 41.3 | 41.4 | 41.5 | 41.6 | 41.7 | 41.8 | 41.9 | 32 |
| 33 | 42.0 | 42.1 | 42.2 | 42.3 | 42.4 | 42.5 | 42.6 | 42.7 | 42.8 | 42.9 | 33 |
| 34 | 43.0 | 43.1 | 43.2 | 43.3 | 43.4 | 43.5 | 43.6 | 43.7 | 43.8 | 43.9 | 34 |
| 35 | 44.0 | 44.1 | 44.2 | 44.3 | 44.4 | 44.5 | 44.6 | 44.7 | 44.8 | 44.9 | 35 |
| 36 | 45.0 | 45.1 | 45.2 | 45.3 | 45.4 | 45.5 | 45.6 | 45.7 | 45.8 | 45.9 | 36 |

Calculated by Julien A. Hall, M. Am. Soc. C. E.


For Keith's Railroad Curve Tables see end of book.



# EXTRA FINE ENGINEERS' TRANSIT


## No. 5060 S

### KEUFFEL & ESSER CO., N.Y.

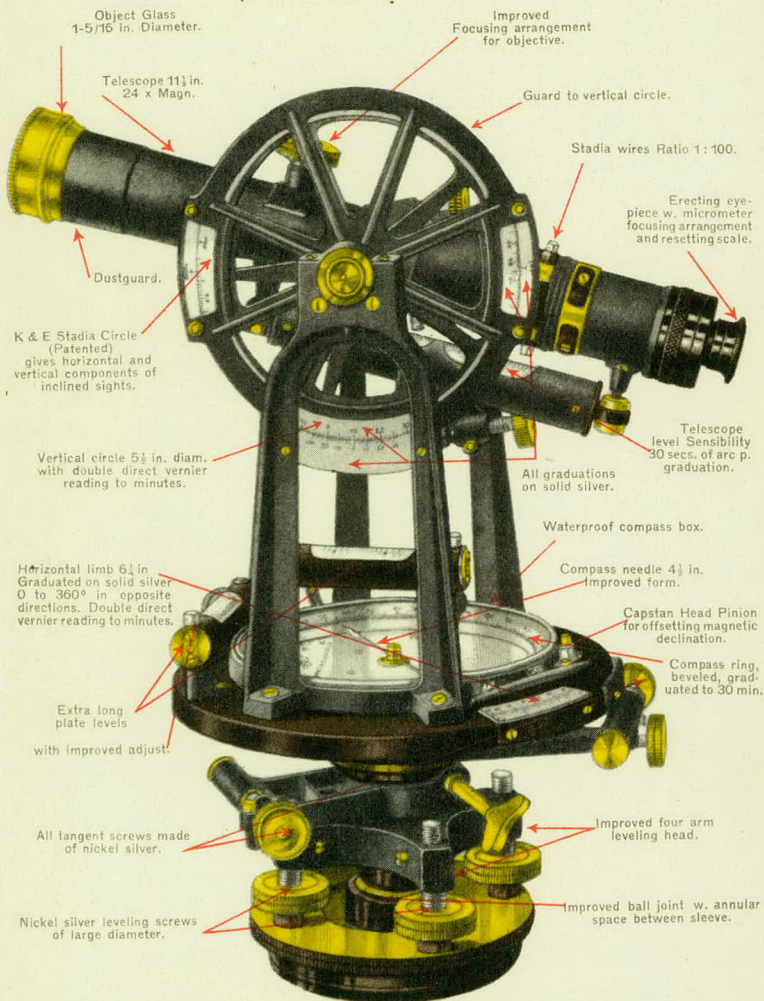


ALSO MADE WITH

INTERNAL FOCUSING TELESCOPE  
PRACTICALLY DUST AND MOISTURE PROOF.

 



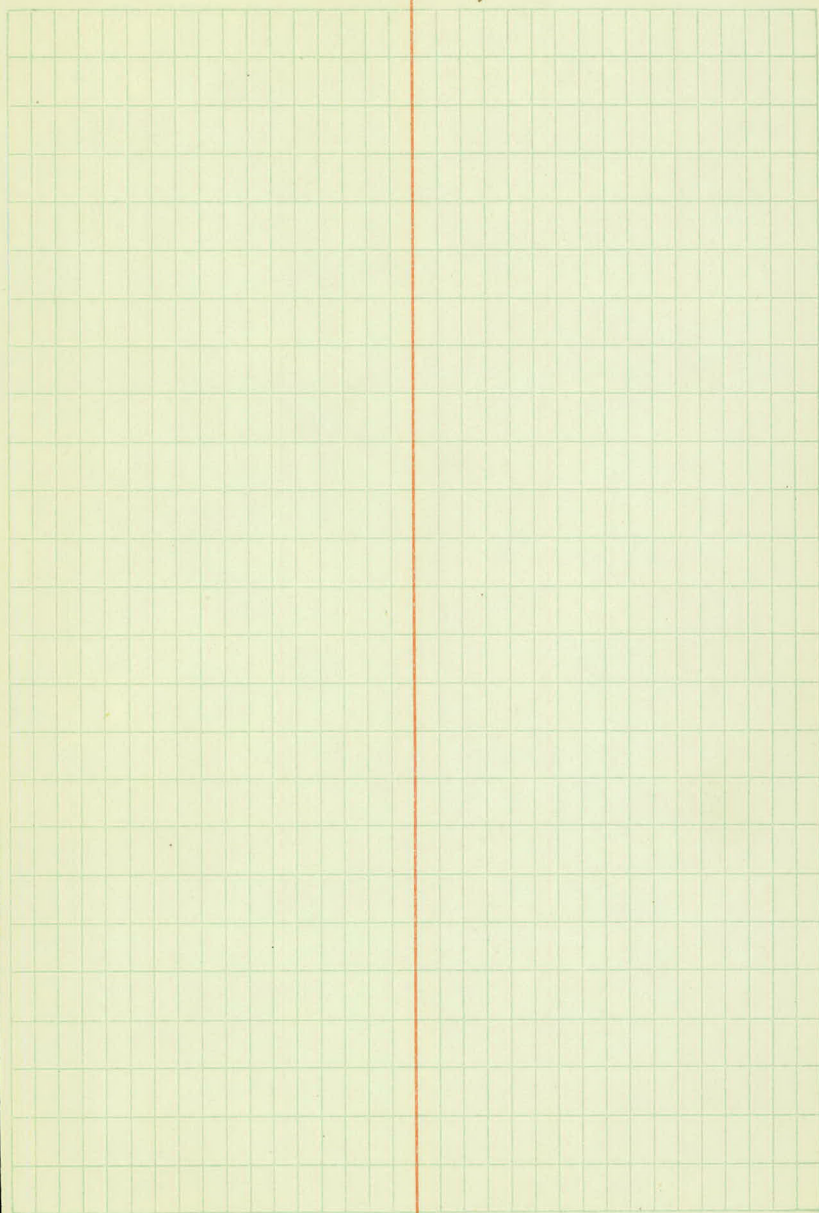

| Sta. | +          | H.I. ✓   | -    | Elev.        | G.P.       |
|------|------------|----------|------|--------------|------------|
| B.M. | 4.12       | 945.47   |      | 941.35       |            |
| B.M. |            |          | 4.28 | 941.19 ✓     |            |
| 0+00 | E W.B. Ave |          |      | 941.0        |            |
| +10  |            |          |      | 41.2         |            |
| +14  |            |          |      | 41.3         |            |
| +19  |            |          |      | 41.2         |            |
| +27  |            |          |      | 41.2         |            |
| +32  |            |          |      | 41.2         |            |
| +50  |            |          |      | 40.9<br>41.1 | 4.6<br>4.4 |
| 1    |            |          |      | 40.9<br>41.1 | 4.6<br>4.4 |
| +50  |            |          |      | 41.0<br>41.2 | 4.5<br>4.3 |
| T.P. | 4.13       | 945.48 ✓ | 4.12 | 941.35 ✓     |            |
| 2    |            |          |      | 41.0<br>41.2 | 4.5<br>4.3 |
| +50  |            |          |      | 41.1<br>41.3 | 4.4<br>4.2 |



4-11-32

Spk in P.P. 19 Rt. Sta. 1+25

Top of Iron Mont Sta. 9+00

$$\frac{4.13}{33} \quad 4.28 \quad \frac{4.4}{33}$$

$$\frac{4.2}{33} \quad 4.3 \quad \frac{4.4}{33}$$

$$\frac{4.1}{33} \quad 4.2 \quad \frac{4.4}{33}$$

$$\frac{5.6}{33} \quad \frac{5.7}{24} \quad \frac{4.7}{18} \quad 4.3 \quad \frac{4.8}{15} \quad \frac{4.5}{16} \quad \frac{5.2}{27} \quad \frac{6.1}{33}$$

$$\frac{5.7}{33} \quad \frac{5.7}{18} \quad \frac{4.6}{15} \quad 4.3 \quad \frac{4.7}{9} \quad \frac{5.1}{13} \quad \frac{4.8}{14} \quad \frac{5.3}{27} \quad \frac{6.0}{33}$$

$$\frac{3.6}{33} \quad \frac{4.1}{14} \quad \frac{4.7}{13} \quad 4.3 \quad \frac{4.6}{8} \quad \frac{5.1}{12} \quad \frac{4.8}{13} \quad \frac{4.3}{26} \quad \frac{4.3}{33}$$

$$\frac{CO2}{21.1} \quad \frac{4.0}{33} \quad \frac{4.4}{21.1} \quad \frac{4.5}{13} \quad \frac{4.8}{12} \quad \frac{4.6}{9} \quad \frac{4.4}{102} \quad \frac{4.7}{7} \quad \frac{5.0}{10} \quad \frac{4.8}{11} \quad \frac{5.1}{12} \quad \frac{5.1}{20.8} \quad \frac{5.0}{33} \quad \frac{DC.15}{20.8}$$

$$\frac{DC.13}{20.7} \quad \frac{4.8}{33} \quad \frac{5.3}{20.7} \quad \frac{5.0}{12} \quad \frac{5.5}{11} \quad \frac{4.8}{9} \quad \frac{4.7}{-0.1} \quad \frac{5.2}{7} \quad \frac{5.6}{8} \quad \frac{5.2}{9} \quad \frac{5.8}{14} \quad \frac{6.0}{20.3} \quad \frac{5.9}{33} \quad \frac{DC.06}{20.3}$$

$$\frac{DC.13}{20.7} \quad \frac{4.9}{33} \quad \frac{5.2}{20.7} \quad \frac{5.2}{12} \quad \frac{5.5}{12} \quad \frac{4.7}{9} \quad \frac{4.5}{00} \quad \frac{5.4}{8} \quad \frac{5.1}{9} \quad \frac{5.7}{18} \quad \frac{6.1}{20} \quad \frac{6.1}{20.2} \quad \frac{5.8}{33} \quad \frac{DC.04}{20.2}$$

$$\frac{DC.16}{20.8} \quad \frac{4.5}{33} \quad \frac{4.9}{20.8} \quad \frac{5.3}{13} \quad \frac{5.6}{12} \quad \frac{4.9}{9} \quad \frac{4.8}{-0.3} \quad \frac{5.6}{5} \quad \frac{6.1}{7} \quad \frac{5.6}{8} \quad \frac{6.2}{17} \quad \frac{6.5}{20} \quad \frac{6.0}{23} \quad \frac{6.3}{33} \quad \frac{DC.00}{20.0}$$

$$\frac{DC.10}{20.5} \quad \frac{5.0}{33} \quad \frac{5.4}{20.5} \quad \frac{5.6}{13} \quad \frac{5.9}{12} \quad \frac{5.3}{9} \quad \frac{5.1}{-0.7} \quad \frac{5.9}{7} \quad \frac{5.6}{8} \quad \frac{6.0}{11} \quad \frac{6.2}{16.4} \quad \frac{6.3}{18} \quad \frac{6.6}{20} \quad \frac{6.0}{23} \quad \frac{6.2}{33} \quad \frac{F.1.8}{16.4}$$

| Sta  | +    | H.I.     | -    | Elev.                    | G.R.                  |
|------|------|----------|------|--------------------------|-----------------------|
|      |      | 945.48 ✓ |      |                          |                       |
| 3    |      |          |      | <sup>41.1</sup><br>941.3 | <sup>4.4</sup><br>4.2 |
| +50  |      |          |      | <sup>41.2</sup><br>41.4  | <sup>4.3</sup><br>4.1 |
| 4    |      |          |      | <sup>41.2</sup><br>41.4  | <sup>4.3</sup><br>4.1 |
| +50  |      |          |      | <sup>41.3</sup><br>41.5  | <sup>4.2</sup><br>4.0 |
| 5    |      |          |      | <sup>41.4</sup><br>41.6  | <sup>4.1</sup><br>3.9 |
| +50  |      |          |      | <sup>41.7</sup><br>41.9  | <sup>3.8</sup><br>3.6 |
| 6    |      |          |      | <sup>41.9</sup><br>42.1  | <sup>3.6</sup><br>3.4 |
| +50  |      |          |      | <sup>42.2</sup><br>42.4  | <sup>3.3</sup><br>3.1 |
| B.M. | 6.74 | 949.37 ✓ | 2.85 | 942.63                   | 942.63                |
| 7    |      |          |      | <sup>42.5</sup><br>42.7  | <sup>6.9</sup><br>6.7 |
| +50  |      |          |      | <sup>42.8</sup><br>43.0  | <sup>6.6</sup><br>6.4 |
| 8    |      |          |      | <sup>43.1</sup><br>43.3  | <sup>6.3</sup><br>6.1 |

D.C.09       $\frac{5.2}{33}$     $\frac{5.5}{20.5}$     $\frac{5.4}{14}$     $\frac{5.9}{13}$     $\frac{5.3}{11}$     $\frac{4.9}{-0.5}$     $\frac{5.3}{5}$     $\frac{5.8}{6}$     $\frac{5.2}{7}$     $\frac{5.7}{12}$     $\frac{5.7}{19}$     $\frac{6.2}{20.1}$     $\frac{5.6}{23}$     $\frac{5.6}{33}$    D.C.02  
20.5      20.1

D.C.09       $\frac{4.9}{33}$     $\frac{5.4}{20.5}$     $\frac{5.2}{14}$     $\frac{5.8}{13}$     $\frac{5.2}{11}$     $\frac{4.9}{-0.6}$     $\frac{5.3}{5}$     $\frac{5.7}{6}$     $\frac{5.3}{7}$     $\frac{5.8}{11}$     $\frac{6.0}{17}$     $\frac{6.4}{19}$     $\frac{6.3}{20}$     $\frac{5.8}{33}$    D.C.00  
20.5      20.0

D.C.1.0       $\frac{5.0}{33}$     $\frac{5.3}{20.5}$     $\frac{5.3}{14}$     $\frac{5.8}{13}$     $\frac{5.2}{11}$     $\frac{4.9}{-0.6}$     $\frac{5.3}{5}$     $\frac{5.7}{6}$     $\frac{5.3}{7}$     $\frac{6.1}{16}$     $\frac{6.3}{17.0}$     $\frac{6.5}{19}$     $\frac{6.0}{23}$     $\frac{6.2}{33}$    F2.0  
20.5      17.0

D.C.09       $\frac{4.9}{33}$     $\frac{5.3}{20.5}$     $\frac{5.2}{14}$     $\frac{5.7}{13}$     $\frac{5.1}{11}$     $\frac{4.7}{-0.5}$     $\frac{5.0}{4}$     $\frac{5.5}{6}$     $\frac{5.2}{7}$     $\frac{6.0}{15}$     $\frac{6.3}{17.2}$     $\frac{6.3}{19}$     $\frac{5.8}{22}$     $\frac{6.2}{33}$    F2.1  
20.5      17.2

D.C.1.4       $\frac{4.1}{33}$     $\frac{4.7}{20.7}$     $\frac{4.7}{15}$     $\frac{5.0}{14}$     $\frac{4.6}{12}$     $\frac{4.3}{-0.2}$     $\frac{4.9}{6}$     $\frac{5.3}{7}$     $\frac{4.9}{8}$     $\frac{5.4}{10}$     $\frac{5.9}{17}$     $\frac{6.2}{19}$     $\frac{6.0}{20.1}$     $\frac{6.0}{33}$    D.C.0.1  
20.7      20.1

D.C.1.9       $\frac{3.6}{33}$     $\frac{3.9}{21.0}$     $\frac{3.8}{15}$     $\frac{4.4}{14}$     $\frac{4.0}{12}$     $\frac{3.7}{+0.1}$     $\frac{4.2}{5}$     $\frac{4.6}{7}$     $\frac{4.1}{8}$     $\frac{4.8}{12}$     $\frac{5.2}{17}$     $\frac{5.6}{19}$     $\frac{5.5}{20.2}$     $\frac{5.5}{33}$    D.C.03  
21.0      20.2

C.00       $\frac{3.3}{33}$     $\frac{3.6}{21.0}$     $\frac{3.5}{15}$     $\frac{3.9}{14}$     $\frac{3.5}{13}$     $\frac{3.2}{+0.4}$     $\frac{3.8}{6}$     $\frac{4.2}{7}$     $\frac{4.0}{8}$     $\frac{4.5}{12}$     $\frac{4.6}{16}$     $\frac{5.1}{19}$     $\frac{4.9}{20.4}$     $\frac{4.8}{33}$    D.C.0.7  
21.0      20.4

C.0.3       $\frac{2.6}{33}$     $\frac{3.0}{21.2}$     $\frac{2.9}{15}$     $\frac{3.4}{14}$     $\frac{2.8}{12}$     $\frac{2.7}{+0.6}$     $\frac{3.0}{5}$     $\frac{3.3}{6}$     $\frac{3.0}{7}$     $\frac{4.2}{19}$     $\frac{4.4}{20.5}$     $\frac{4.4}{33}$    D.C.0.9  
21.2      20.5

N.W. Cor Bottom Step 75' Pt. Sta. 7+25  
C.0.4       $\frac{6.2}{33}$     $\frac{6.5}{21.2}$     $\frac{6.6}{15}$     $\frac{6.9}{14}$     $\frac{6.4}{12}$     $\frac{6.2}{+0.7}$     $\frac{6.8}{6}$     $\frac{6.6}{7}$     $\frac{7.7}{20.6}$     $\frac{8.1}{33}$    D.C.1.2  
21.2      20.6

C.0.6       $\frac{5.8}{33}$     $\frac{6.0}{21.3}$     $\frac{6.1}{15}$     $\frac{6.5}{14}$     $\frac{5.9}{11}$     $\frac{5.8}{+0.8}$     $\frac{6.7}{9}$     $\frac{6.8}{20.6}$     $\frac{7.0}{33}$    D.C.1.8  
21.3      20.6

C.0.4       $\frac{5.7}{33}$     $\frac{5.9}{21.2}$     $\frac{5.9}{15}$     $\frac{6.3}{14}$     $\frac{5.8}{12}$     $\frac{5.6}{+0.7}$     $\frac{5.8}{3}$     $\frac{6.6}{9}$     $\frac{6.9}{20.7}$     $\frac{7.2}{33}$    D.C.1.4  
21.2      20.7



| Sta  | +    | H.I. ✓                     | -    | Elev.                    | G.R.                    |
|------|------|----------------------------|------|--------------------------|-------------------------|
|      |      | 949.37                     |      |                          |                         |
| 8+50 |      |                            |      | <sup>43.4</sup><br>943.6 | <sup>6.0</sup><br>5.8 - |
| 9    |      |                            |      | <sup>43.6</sup><br>43.8  | <sup>5.8</sup><br>5.6 - |
| +50  |      |                            |      | <sup>43.8</sup><br>44.0  | <sup>5.6</sup><br>5.4 - |
| 10   |      | 23.3<br><u>20.8</u><br>2.5 |      | <sup>44.0</sup><br>44.1  | <sup>5.4</sup><br>5.3 - |
| +50  |      | 1.2<br><u>22.0</u>         |      | 44.2                     | 5.2 -                   |
| 11   |      |                            |      | 44.3                     | 5.1 -                   |
| +50  |      |                            |      | 44.4                     | 5.0 -                   |
| T.P. | 3.68 | 948.55 ✓                   | 4.50 | 944.87 ✓                 |                         |
| 12   |      |                            |      | 44.5                     | 4.1 -                   |
| +50  |      |                            |      | 44.6                     | 4.0 -                   |
| 13   |      |                            |      | 44.7                     | 3.9 -                   |
| +50  |      |                            |      | 44.8                     | 3.8 -                   |

$$\frac{C0.1}{21.1} \quad \frac{5.9}{33} \quad \frac{5.9}{21.1} \quad \frac{6.0}{14} \quad \frac{6.3}{13} \quad \frac{5.6}{11} \quad \frac{5.4}{+0.6} \quad \frac{5.8}{4} \quad \frac{6.4}{11} \quad \frac{6.5}{20.8} \quad \frac{6.6}{33} \quad \frac{DC1.5}{20.8}$$

$$\frac{C00}{21.0} \quad \frac{5.4}{33} \quad \frac{5.8}{21.0} \quad \frac{5.8}{14} \quad \frac{6.3}{13} \quad \frac{5.7}{11} \quad \frac{5.4}{+0.4} \quad \frac{5.9}{4} \quad \frac{6.6}{10} \quad \frac{6.4}{20.7} \quad \frac{6.5}{33} \quad \frac{DC1.4}{20.7}$$

$$\frac{DC1.7}{20.9} \quad \frac{5.7}{33} \quad \frac{5.9}{20.9} \quad \frac{5.9}{15} \quad \frac{6.3}{14} \quad \frac{5.7}{12} \quad \frac{5.3}{+0.3} \quad \frac{5.6}{4} \quad \frac{6.2}{9} \quad \frac{6.2}{20.7} \quad \frac{6.3}{33} \quad \frac{DC1.4}{20.7}$$

$$\frac{DC1.6}{20.8} \quad \frac{5.7}{33} \quad \frac{5.8}{20.8} \quad \frac{5.7}{15} \quad \frac{6.0}{14} \quad \frac{5.5}{13} \quad \frac{4.8}{4} \quad \frac{4.9}{+0.5} \quad \frac{5.5}{13} \quad \frac{5.7}{20.9} \quad \frac{6.0}{33} \quad \frac{DC1.7}{20.9}$$

$$\frac{DC1.4}{20.7} \quad \frac{5.8}{33} \quad \frac{5.3}{24} \quad \frac{5.8}{20.7} \quad \frac{5.4}{15} \quad \frac{5.6}{14} \quad \frac{5.3}{13} \quad \frac{4.7}{4} \quad \frac{4.8}{+0.4} \quad \frac{5.0}{3} \quad \frac{5.7}{10} \quad \frac{5.6}{20.8} \quad \frac{5.6}{33} \quad \frac{DC1.6}{20.8}$$

$$\frac{DC1.5}{22.0} \quad \frac{5.4}{33} \quad \frac{5.2}{26} \quad \frac{5.6}{22.0} \quad \frac{5.6}{16} \quad \frac{5.8}{15} \quad \frac{5.4}{13} \quad \frac{4.4}{5} \quad \frac{5.0}{+0.1} \quad \frac{5.9}{14} \quad \frac{6.0}{20.6} \quad \frac{6.2}{33} \quad \frac{DC1.1}{20.6}$$

$$\frac{DC1.4}{23.1} \quad \frac{5.2}{33} \quad \frac{4.9}{27} \quad \frac{5.6}{23.1} \quad \frac{5.8}{15} \quad \frac{6.0}{14} \quad \frac{5.4}{13} \quad \frac{4.9}{5} \quad \frac{5.0}{00} \quad \frac{5.4}{7} \quad \frac{6.0}{11} \quad \frac{6.0}{20.5} \quad \frac{6.4}{33} \quad \frac{DC1.0}{20.5}$$

$$\frac{DC0.9}{22.4} \quad \frac{4.7}{33} \quad \frac{4.4}{27} \quad \frac{5.2}{22.4} \quad \frac{4.9}{15} \quad \frac{5.2}{14} \quad \frac{4.6}{12} \quad \frac{4.2}{5} \quad \frac{4.5}{-0.4} \quad \frac{4.9}{7} \quad \frac{5.7}{12} \quad \frac{5.8}{20.2} \quad \frac{6.0}{33} \quad \frac{DC0.3}{20.2}$$

$$\frac{DC1.0}{22.5} \quad \frac{4.2}{33} \quad \frac{4.1}{27} \quad \frac{5.0}{22.5} \quad \frac{5.0}{16} \quad \frac{5.3}{15} \quad \frac{4.9}{13} \quad \frac{4.4}{5} \quad \frac{4.6}{-0.6} \quad \frac{5.1}{6} \quad \frac{5.9}{12} \quad \frac{6.0}{17} \quad \frac{5.9}{33} \quad \frac{F2.0}{17.0}$$

$$\frac{DC0.8}{22.2} \quad \frac{4.7}{33} \quad \frac{5.1}{22.2} \quad \frac{5.3}{15} \quad \frac{5.0}{13} \quad \frac{4.8}{5} \quad \frac{4.9}{-1.0} \quad \frac{5.3}{7} \quad \frac{5.8}{13} \quad \frac{5.7}{20.1} \quad \frac{5.2}{33} \quad \frac{DC0.2}{20.1}$$

$$\frac{DC0.9}{22.4} \quad \frac{4.2}{33} \quad \frac{4.1}{29} \quad \frac{4.9}{22.4} \quad \frac{5.0}{16} \quad \frac{5.4}{15} \quad \frac{5.0}{13} \quad \frac{4.7}{5} \quad \frac{4.9}{-1.1} \quad \frac{5.2}{9} \quad \frac{5.5}{14} \quad \frac{5.0}{20} \quad \frac{5.0}{22.2} \quad \frac{4.8}{33} \quad \frac{DC0.8}{22.2}$$

| Sta. | +    | H.I.     | -    | Elev.    | G.P.  |
|------|------|----------|------|----------|-------|
|      |      | 948.55 ✓ |      |          |       |
| 14   |      |          |      | 44.9     | 3.7 - |
| +50  |      |          |      | 45.0     | 3.6 - |
| 15   |      |          |      | 45.1     | 3.5 - |
| +50  |      |          |      | 45.2     | 3.4 - |
| 16   |      |          |      | 45.3     | 3.3 - |
| +50  |      |          |      | 45.4     | 3.2 - |
| T.P. | 5.54 | 950.74 ✓ | 3.33 | 945.22 ✓ |       |
| 17   |      |          |      | 45.5     | 5.3 - |
| +50  |      |          |      | 45.6     | 5.2 - |
| 18   |      |          |      | 45.7     | 5.1 - |
| +50  |      |          |      | 45.8     | 5.0 - |
| 19   |      |          |      | 46.0     | 4.8 - |



4-12-32

|       |                  |                  |                    |                  |                  |                  |                 |                    |                 |                 |                 |                    |                  |                  |       |      |
|-------|------------------|------------------|--------------------|------------------|------------------|------------------|-----------------|--------------------|-----------------|-----------------|-----------------|--------------------|------------------|------------------|-------|------|
| DC.08 | $\frac{4.3}{33}$ | $\frac{4.1}{28}$ | $\frac{4.9}{22.2}$ | $\frac{5.0}{16}$ | $\frac{5.6}{15}$ | $\frac{5.0}{13}$ | $\frac{4.7}{6}$ | $\frac{4.9}{-1.2}$ | $\frac{5.1}{3}$ | $\frac{5.6}{5}$ | $\frac{5.1}{4}$ | $\frac{5.0}{22.1}$ | $\frac{4.3}{30}$ | $\frac{4.3}{33}$ | DC.07 |      |
|       | 22.2             | 33               | 28                 | 22.2             | 16               | 15               | 13              | 6                  | -1.2            | 3               | 5               | 4                  | 22.1             | 30               | 33    | 22.1 |

|       |     |     |      |     |     |     |     |      |     |     |     |      |     |     |       |
|-------|-----|-----|------|-----|-----|-----|-----|------|-----|-----|-----|------|-----|-----|-------|
| DC.08 | 4/6 | 4/3 | 4/8  | 4/9 | 5/3 | 4/9 | 4/5 | 4/9  | 5/1 | 5/5 | 5/0 | 5/0  | 4/5 | 4/5 | DC.06 |
| 22.2  | 33  | 27  | 22.2 | 18  | 16  | 15  | 7   | -1.3 | 3   | 5   | 6   | 21.9 | 30  | 33  | 21.9  |

|       |    |    |     |    |    |    |    |      |    |    |      |    |    |       |
|-------|----|----|-----|----|----|----|----|------|----|----|------|----|----|-------|
| DC.06 | 47 | 46 | 49  | 50 | 55 | 49 | 46 | 50   | 55 | 51 | 52   | 43 | 43 | DC.03 |
| 219   | 33 | 27 | 219 | 18 | 17 | 15 | 7  | -1.5 | 5  | 4  | 21.5 | 30 | 33 | 21.5  |

|       |     |     |      |     |     |     |     |     |     |     |     |      |     |     |       |
|-------|-----|-----|------|-----|-----|-----|-----|-----|-----|-----|-----|------|-----|-----|-------|
| DC.06 | 4.5 | 4.3 | 4.8  | 4.7 | 5.2 | 4.8 | 4.5 | 4.7 | 5.1 | 5.4 | 4.9 | 4.9  | 4.0 | 4.0 | DC.05 |
| 21.9  | 33  | 29  | 21.9 | 19  | 18  | 15  | 8   | -13 | 3   | 4   | 5   | 21.8 | 30  | 33  | 21.8  |

|      |    |    |      |    |    |    |    |     |    |    |    |      |    |    |      |
|------|----|----|------|----|----|----|----|-----|----|----|----|------|----|----|------|
| DC10 | 40 | 39 | 43   | 44 | 49 | 44 | 42 | 46  | 47 | 52 | 47 | 47   | 39 | 39 | DC06 |
| 22.5 | 33 | 29 | 22.5 | 18 | 17 | 15 | 8  | -13 | 3  | 5  | 6  | 21.9 | 30 | 33 | 21.9 |

|       |     |     |      |     |     |     |     |      |     |     |     |      |     |     |      |
|-------|-----|-----|------|-----|-----|-----|-----|------|-----|-----|-----|------|-----|-----|------|
| DC1.4 | 3.4 | 3.3 | 3.8  | 4.0 | 4.6 | 4.2 | 3.9 | 4.3  | 4.7 | 4.2 | 4.9 | 4.8  | 4.4 | 4.4 | DC04 |
| 23.1  | 33  | 30  | 23.1 | 18  | 16  | 14  | 6   | -1.1 | 4   | 6   | 12  | 21.6 | 30  | 33  | 21.6 |

$$\begin{array}{r} \text{DC.1.6} \\ 234 \end{array} \qquad \begin{array}{r} 5.7 \quad 5.7 \quad 5.9 \quad 5.7 \quad 6.5 \quad 6.3 \\ \hline 33 \quad 23.4 \quad 15 \quad -0.4 \quad 22.2 \quad 33 \end{array} \qquad \begin{array}{r} \text{DC.08} \\ 22.2 \end{array}$$

|     |     |     |     |     |     |                    |     |      |     |        |
|-----|-----|-----|-----|-----|-----|--------------------|-----|------|-----|--------|
| COO | 5.2 | 5.2 | 5.1 | 5.3 | 5.4 | 5.7 <sup>5.2</sup> | 5.7 | 6.2  | 6.0 | DC 1.0 |
| 240 | 33  | 240 | 17  | 15  | 3   | -0.5               | 4   | 22.5 | 33  | 22.5   |

|     |     |     |     |     |     |      |     |      |        |
|-----|-----|-----|-----|-----|-----|------|-----|------|--------|
| COO | 5.1 | 5.1 | 4.9 | 5.2 | 5.1 | 5.6  | 6.1 | 5.9  | DC. 10 |
| 240 | 33  | 240 | 17  | 15  | 7   | -0.5 | 6   | 22.5 | 22.5   |

|       |     |      |     |     |     |      |     |      |     |       |
|-------|-----|------|-----|-----|-----|------|-----|------|-----|-------|
| DC1.8 | 5.2 | 5.2  | 4.9 | 5.2 | 5.1 | 5.3  | 5.2 | 5.6  | 5.2 | DC1.4 |
| 23.7  | 33  | 23.7 | 18  | 15  | 5   | -0.3 | 7   | 23.1 | 33  | 23.1  |

$$\frac{DC17}{23.6} \quad \frac{5.2}{33} \quad \frac{5.1}{23.5} \quad \frac{4.7}{17} \quad \frac{5.0}{14} \quad \frac{4.7}{4} \quad \overset{4.8}{\frac{5.0}{-02}} \quad \frac{5.0}{12} \quad \frac{5.0}{23.7} \quad \frac{4.7}{33} \quad \frac{DC18}{23.7}$$

| Sta  | +    | H.I. ✓<br>950.76 | -    | Elev.    | G.R.        |
|------|------|------------------|------|----------|-------------|
| 19   | +50  |                  |      | 946.1    | 4.7 -       |
| 20   |      |                  |      | 46.3     | 4.5 -       |
|      | +50  |                  |      | 46.5     | 4.3 -       |
| 21   |      |                  |      | 46.7     | 4.1 -       |
|      | +50  |                  |      | 46.9     | 3.9 -       |
| 22   |      |                  |      | 47.1 ✓   | 3.7 -       |
| B.M. | 4.11 | 950.85 ✓         | 4.11 | 946.65 = | 946.74 N.G. |
|      | +50  |                  |      | 47.3     | 3.5 -       |
| T.P. | 5.48 | 952.13           | 1.99 | 948.84 ✓ |             |
| 23   |      |                  |      | 47.5     | 4.6         |
|      | +50  |                  |      | 47.8     | 4.3         |
| 24   |      |                  |      | 48.1     | 4.0         |
|      | +50  |                  |      | 48.5     | 3.6         |

$$\begin{array}{r}
 DC1.7 \\
 \hline
 23.6
 \end{array}
 \begin{array}{r}
 5.2 \\
 \hline
 33
 \end{array}
 \begin{array}{r}
 5.0 \\
 \hline
 23.6
 \end{array}
 \begin{array}{r}
 4.5 \\
 \hline
 17
 \end{array}
 \begin{array}{r}
 4.7 \\
 \hline
 14
 \end{array}
 \begin{array}{r}
 4.3 \\
 \hline
 9
 \end{array}
 \begin{array}{r}
 4.3 \\
 \hline
 3
 \end{array}
 \begin{array}{r}
 4.6 \\
 \hline
 +0.1
 \end{array}
 \begin{array}{r}
 4.4 \\
 \hline
 9
 \end{array}
 \begin{array}{r}
 4.2 \\
 \hline
 24.8
 \end{array}
 \begin{array}{r}
 3.9 \\
 \hline
 33
 \end{array}
 \begin{array}{r}
 CO.5 \\
 \hline
 24.8
 \end{array}$$

$$\begin{array}{r}
 DC1.6 \\
 \hline
 23.4
 \end{array}
 \begin{array}{r}
 4.8 \\
 \hline
 33
 \end{array}
 \begin{array}{r}
 4.9 \\
 \hline
 23.4
 \end{array}
 \begin{array}{r}
 4.3 \\
 \hline
 12
 \end{array}
 \begin{array}{r}
 4.0 \\
 \hline
 3
 \end{array}
 \begin{array}{r}
 4.3 \\
 \hline
 +0.2
 \end{array}
 \begin{array}{r}
 4.1 \\
 \hline
 11
 \end{array}
 \begin{array}{r}
 4.0 \\
 \hline
 24.8
 \end{array}
 \begin{array}{r}
 3.5 \\
 \hline
 33
 \end{array}
 \begin{array}{r}
 CO.5 \\
 \hline
 24.8
 \end{array}$$

$$\begin{array}{r}
 DC1.9 \\
 \hline
 23.9
 \end{array}
 \begin{array}{r}
 4.5 \\
 \hline
 33
 \end{array}
 \begin{array}{r}
 4.4 \\
 \hline
 23.9
 \end{array}
 \begin{array}{r}
 4.2 \\
 \hline
 11
 \end{array}
 \begin{array}{r}
 4.0 \\
 \hline
 3
 \end{array}
 \begin{array}{r}
 4.2 \\
 \hline
 +0.1
 \end{array}
 \begin{array}{r}
 4.1 \\
 \hline
 9
 \end{array}
 \begin{array}{r}
 4.1 \\
 \hline
 24.3
 \end{array}
 \begin{array}{r}
 3.6 \\
 \hline
 33
 \end{array}
 \begin{array}{r}
 CO.2 \\
 \hline
 24.3
 \end{array}$$

$$\begin{array}{r}
 CO.2 \\
 \hline
 24.3
 \end{array}
 \begin{array}{r}
 3.8 \\
 \hline
 33
 \end{array}
 \begin{array}{r}
 3.9 \\
 \hline
 24.3
 \end{array}
 \begin{array}{r}
 3.9 \\
 \hline
 11
 \end{array}
 \begin{array}{r}
 3.9 \\
 \hline
 4
 \end{array}
 \begin{array}{r}
 4.4 \\
 \hline
 -0.3
 \end{array}
 \begin{array}{r}
 4.5 \\
 \hline
 10
 \end{array}
 \begin{array}{r}
 4.7 \\
 \hline
 23.1
 \end{array}
 \begin{array}{r}
 3.9 \\
 \hline
 33
 \end{array}
 \begin{array}{r}
 DC1.4 \\
 \hline
 23.1
 \end{array}$$

$$\begin{array}{r}
 CO.8 \\
 \hline
 25.2
 \end{array}
 \begin{array}{r}
 3.1 \\
 \hline
 33
 \end{array}
 \begin{array}{r}
 3.1 \\
 \hline
 25.2
 \end{array}
 \begin{array}{r}
 3.1 \\
 \hline
 9
 \end{array}
 \begin{array}{r}
 3.4 \\
 \hline
 4
 \end{array}
 \begin{array}{r}
 4.0 \\
 \hline
 -0.1
 \end{array}
 \begin{array}{r}
 4.2 \\
 \hline
 9
 \end{array}
 \begin{array}{r}
 4.6 \\
 \hline
 23.0
 \end{array}
 \begin{array}{r}
 4.3 \\
 \hline
 33
 \end{array}
 \begin{array}{r}
 DC1.3 \\
 \hline
 23.0
 \end{array}$$

$$\begin{array}{r}
 C1.3 \\
 \hline
 26.0
 \end{array}
 \begin{array}{r}
 2.5 \\
 \hline
 33
 \end{array}
 \begin{array}{r}
 2.4 \\
 \hline
 26.0
 \end{array}
 \begin{array}{r}
 2.4 \\
 \hline
 9
 \end{array}
 \begin{array}{r}
 2.9 \\
 \hline
 +0.8
 \end{array}
 \begin{array}{r}
 3.0 \\
 \hline
 5
 \end{array}
 \begin{array}{r}
 4.2 \\
 \hline
 15
 \end{array}
 \begin{array}{r}
 4.3 \\
 \hline
 23.1
 \end{array}
 \begin{array}{r}
 4.6 \\
 \hline
 33
 \end{array}
 \begin{array}{r}
 DC1.4 \\
 \hline
 23.1
 \end{array}$$

Spk in 15" B.O. 45' Rt. Sta. 22+64

$$\begin{array}{r}
 CO.7 \\
 \hline
 25.1
 \end{array}
 \begin{array}{r}
 2.8 \\
 \hline
 25.1
 \end{array}
 \begin{array}{r}
 2.8 \\
 \hline
 11
 \end{array}
 \begin{array}{r}
 2.7 \\
 \hline
 +0.8
 \end{array}
 \begin{array}{r}
 2.9 \\
 \hline
 9
 \end{array}
 \begin{array}{r}
 3.9 \\
 \hline
 15
 \end{array}
 \begin{array}{r}
 3.9 \\
 \hline
 23.4
 \end{array}
 \begin{array}{r}
 4.4 \\
 \hline
 33
 \end{array}
 \begin{array}{r}
 DC1.6 \\
 \hline
 23.4
 \end{array}$$

Nail in F.P. 10' Lt. 22+70

$$\begin{array}{r}
 CO.3 \\
 \hline
 24.2
 \end{array}
 \begin{array}{r}
 4.2 \\
 \hline
 33
 \end{array}
 \begin{array}{r}
 4.3 \\
 \hline
 24.5
 \end{array}
 \begin{array}{r}
 4.9 \\
 \hline
 10
 \end{array}
 \begin{array}{r}
 4.6 \\
 \hline
 0.0
 \end{array}
 \begin{array}{r}
 5.0 \\
 \hline
 9
 \end{array}
 \begin{array}{r}
 5.9 \\
 \hline
 14
 \end{array}
 \begin{array}{r}
 5.2 \\
 \hline
 19
 \end{array}
 \begin{array}{r}
 5.4 \\
 \hline
 22.8
 \end{array}
 \begin{array}{r}
 5.4 \\
 \hline
 33
 \end{array}
 \begin{array}{r}
 DC1.2 \\
 \hline
 22.8
 \end{array}$$

$$\begin{array}{r}
 PC1.0 \\
 \hline
 22.5
 \end{array}
 \begin{array}{r}
 5.2 \\
 \hline
 33
 \end{array}
 \begin{array}{r}
 5.3 \\
 \hline
 20.0
 \end{array}
 \begin{array}{r}
 5.9 \\
 \hline
 10
 \end{array}
 \begin{array}{r}
 5.4 \\
 \hline
 -1.4
 \end{array}
 \begin{array}{r}
 5.5 \\
 \hline
 8
 \end{array}
 \begin{array}{r}
 6.4 \\
 \hline
 14
 \end{array}
 \begin{array}{r}
 6.4 \\
 \hline
 17.2
 \end{array}
 \begin{array}{r}
 6.4 \\
 \hline
 20
 \end{array}
 \begin{array}{r}
 5.5 \\
 \hline
 22
 \end{array}
 \begin{array}{r}
 5.4 \\
 \hline
 33
 \end{array}
 \begin{array}{r}
 F2.1 \\
 \hline
 17.2
 \end{array}$$

$$\begin{array}{r}
 F3.8 \\
 \hline
 20.6
 \end{array}
 \begin{array}{r}
 7.5 \\
 \hline
 33
 \end{array}
 \begin{array}{r}
 7.8 \\
 \hline
 20.6
 \end{array}
 \begin{array}{r}
 7.8 \\
 \hline
 13
 \end{array}
 \begin{array}{r}
 7.3 \\
 \hline
 9
 \end{array}
 \begin{array}{r}
 7.2 \\
 \hline
 -3.2
 \end{array}
 \begin{array}{r}
 7.2 \\
 \hline
 17
 \end{array}
 \begin{array}{r}
 8.1 \\
 \hline
 13
 \end{array}
 \begin{array}{r}
 4.8 \\
 \hline
 18
 \end{array}
 \begin{array}{r}
 4.8 \\
 \hline
 20.4
 \end{array}
 \begin{array}{r}
 7.9 \\
 \hline
 33
 \end{array}
 \begin{array}{r}
 F3.7 \\
 \hline
 20.4
 \end{array}$$

$$\begin{array}{r}
 F5.2 \\
 \hline
 23.4
 \end{array}
 \begin{array}{r}
 8.8 \\
 \hline
 33
 \end{array}
 \begin{array}{r}
 8.8 \\
 \hline
 23.4
 \end{array}
 \begin{array}{r}
 8.3 \\
 \hline
 10
 \end{array}
 \begin{array}{r}
 7.7 \\
 \hline
 9
 \end{array}
 \begin{array}{r}
 7.3 \\
 \hline
 -3.7
 \end{array}
 \begin{array}{r}
 7.8 \\
 \hline
 18
 \end{array}
 \begin{array}{r}
 8.8 \\
 \hline
 8
 \end{array}
 \begin{array}{r}
 10.6 \\
 \hline
 23
 \end{array}
 \begin{array}{r}
 10.7 \\
 \hline
 27.2
 \end{array}
 \begin{array}{r}
 9.8 \\
 \hline
 33
 \end{array}
 \begin{array}{r}
 F7.1 \\
 \hline
 27.2
 \end{array}$$

| Sta. | +    | H.I.   | -    | Elev.  | G.R.  |
|------|------|--------|------|--------|-------|
| 25   |      |        |      | 949.0  | 3.1   |
| T.P. | 5.94 | 954.82 |      | 948.86 |       |
| +50  |      |        |      | 49.6   | 5.2 - |
| 26   |      |        |      | 50.4   | 4.4 - |
| +50  |      |        |      | 51.1   | 3.7 - |
| 27   |      |        |      | 51.8   | 3.0 - |
| +50  |      |        |      | 52.6   | 2.2 - |
| T.P. | 8.81 | 961.41 | 2.22 | 952.60 |       |
| 28   |      |        |      | 53.4   | 8.0 - |
| +50  |      |        |      | 54.1   | 7.3 - |
| 29   |      |        |      | 54.8   | 6.6 - |
| +50  |      |        |      | 55.6   | 5.8 - |
| 30   |      |        |      | 56.3   | 5.1 - |



$$\frac{F4.0}{21.0}$$

$$\frac{7.2}{33} \quad \frac{7.1}{21.0} \quad \frac{6.9}{11} \quad \frac{6.3}{-3.2} \quad \frac{6.4}{9} \quad \frac{7.4}{14} \quad \frac{6.3}{17} \quad \frac{6.5}{19.8} \quad \frac{6.0}{33} \quad \frac{F3.4}{19.8}$$

4-13-31

$$\frac{DC.00}{21.0}$$

$$\frac{7.2}{33} \quad \frac{7.2}{21.0} \quad \frac{7.0}{4} \quad \frac{7.3}{-2.1} \quad \frac{6.9}{10} \quad \frac{7.4}{14} \quad \frac{6.3}{17} \quad \frac{6.5}{22.1} \quad \frac{6.1}{33}$$

$$\frac{DC.07}{22.1}$$

$$\frac{DC05}{21.8}$$

$$\frac{5.7}{33} \quad \frac{5.9}{21.8} \quad \frac{5.6}{13} \quad \frac{5.6}{-1.2} \quad \frac{5.9}{12} \quad \frac{6.3}{15} \quad \frac{5.3}{19} \quad \frac{5.1}{23.0} \quad \frac{4.9}{33}$$

$$\frac{DC1.3}{23.0}$$

$$\frac{DC1.4}{23.1}$$

$$\frac{4.5}{33} \quad \frac{4.3}{23.1} \quad \frac{4.2}{14} \quad \frac{4.3}{-0.6} \quad \frac{4.6}{3} \quad \frac{4.6}{22.7} \quad \frac{4.5}{33}$$

$$\frac{DC1.1}{22.7}$$

$$\frac{DC0.4}{21.6}$$

$$\frac{4.8}{33} \quad \frac{4.6}{21.6} \quad \frac{4.4}{6} \quad \frac{3.7}{-0.7} \quad \frac{4.4}{10} \quad \frac{4.2}{22.2} \quad \frac{4.1}{33}$$

$$\frac{DC0.8}{22.2}$$

$$\frac{DC03}{21.5}$$

$$\frac{4.3}{33} \quad \frac{3.9}{21.5} \quad \frac{3.8}{14} \quad \frac{4.2}{7} \quad \frac{3.2}{-1.0} \quad \frac{3.1}{4} \quad \frac{4.0}{14} \quad \frac{3.9}{21.5} \quad \frac{3.8}{33}$$

$$\frac{DC0.3}{21.5}$$

$$\frac{F2.0}{17.0}$$

$$\frac{10.3}{33} \quad \frac{10.0}{17.0} \quad \frac{10.3}{7} \quad \frac{9.2}{-1.2} \quad \frac{9.7}{14} \quad \frac{9.8}{21.3} \quad \frac{9.5}{33}$$

$$\frac{DC0.2}{21.3}$$

$$\frac{DC02}{21.3}$$

$$\frac{9.6}{33} \quad \frac{9.1}{21.3} \quad \frac{8.6}{4} \quad \frac{8.1}{-0.8} \quad \frac{7.3}{2} \quad \frac{7.7}{15} \quad \frac{6.9}{24.6} \quad \frac{7.0}{33}$$

$$\frac{C04}{24.6}$$

$$\frac{C00}{24.0}$$

$$\frac{7.2}{33} \quad \frac{6.6}{24.0} \quad \frac{5.5}{5} \quad \frac{5.4}{+1.2} \quad \frac{4.4}{4} \quad \frac{5.3}{15} \quad \frac{4.6}{24} \quad \frac{4.7}{24.9} \quad \frac{4.6}{33}$$

$$\frac{C1.9}{24.9}$$

$$\frac{DC1.9}{23.9}$$

$$\frac{6.1}{33} \quad \frac{5.9}{23.9} \quad \frac{4.9}{1} \quad \frac{4.5}{+0.3} \quad \frac{4.0}{2} \quad \frac{4.6}{5} \quad \frac{4.7}{25.7} \quad \frac{4.7}{33}$$

$$\frac{C1.1}{25.7}$$

$$\frac{DC09}{22.4}$$

$$\frac{6.5}{33} \quad \frac{6.2}{22.4} \quad \frac{5.7}{5} \quad \frac{4.8}{+0.3} \quad \frac{5.0}{18} \quad \frac{4.6}{24.8} \quad \frac{4.9}{33}$$

$$\frac{C0.5}{24.8}$$

| Sta.  | +     | H.I. ✓   | -    | Elev.    | G.R.   |
|-------|-------|----------|------|----------|--------|
|       |       | 961.41   |      |          |        |
| 30+50 |       |          |      | 57.1     | 4.3 -  |
| 31    |       |          |      | 57.8     | 3.6 -  |
| T.P.  | 12.67 | 971.16 ✓ | 2.92 | 958.49 ✓ |        |
| +50   |       |          |      | 58.6     | 12.6 - |
| 32    |       |          |      | 59.4     | 11.8 - |
| +50   |       |          |      | 59.9     | 11.3 - |
| 33    |       |          |      | 60.0 ✓   | 11.2 - |
| B.M.  | 0.90  | 969.36 ✓ | 2.58 | 948.58   | 968.46 |
| +50   |       |          |      | 59.6     | 9.8 -  |
| 34    |       |          |      | 58.8     | 10.6 - |
| +50   |       |          |      | 57.6     | 11.8 - |
| 35    |       |          |      | 55.9     | 13.5 - |
| +50   |       |          |      | 54.0     | 15.4 - |

$$\begin{array}{r}
 DC0.2 \\
 \hline
 23.3
 \end{array}
 \qquad
 \begin{array}{r}
 6.1 \\
 \hline
 33
 \end{array}
 \begin{array}{r}
 6.1 \\
 \hline
 21.3
 \end{array}
 \begin{array}{r}
 5.6 \\
 \hline
 4
 \end{array}
 \begin{array}{r}
 5.2 \\
 \hline
 -0.9
 \end{array}
 \begin{array}{r}
 4.7 \\
 \hline
 1
 \end{array}
 \begin{array}{r}
 5.3 \\
 \hline
 15
 \end{array}
 \begin{array}{r}
 5.0 \\
 \hline
 23.0
 \end{array}
 \begin{array}{r}
 4.6 \\
 \hline
 33
 \end{array}
 \qquad
 \begin{array}{r}
 DC1.3 \\
 \hline
 23.0
 \end{array}$$

$$\begin{array}{r}
 DC0.8 \\
 \hline
 22.2
 \end{array}
 \qquad
 \begin{array}{r}
 4.8 \\
 \hline
 33
 \end{array}
 \begin{array}{r}
 4.8 \\
 \hline
 22.2
 \end{array}
 \begin{array}{r}
 5.1 \\
 \hline
 3
 \end{array}
 \begin{array}{r}
 4.5 \\
 \hline
 -0.9
 \end{array}
 \begin{array}{r}
 3.7 \\
 \hline
 3
 \end{array}
 \begin{array}{r}
 4.2 \\
 \hline
 6
 \end{array}
 \begin{array}{r}
 4.5 \\
 \hline
 21
 \end{array}
 \begin{array}{r}
 4.3 \\
 \hline
 23.0
 \end{array}
 \begin{array}{r}
 4.0 \\
 \hline
 33
 \end{array}
 \qquad
 \begin{array}{r}
 DC1.3 \\
 \hline
 23.0
 \end{array}$$

$$\begin{array}{r}
 DC1.4 \\
 \hline
 23.1
 \end{array}
 \qquad
 \begin{array}{r}
 13.1 \\
 \hline
 33
 \end{array}
 \begin{array}{r}
 13.2 \\
 \hline
 23.1
 \end{array}
 \begin{array}{r}
 12.4 \\
 \hline
 10
 \end{array}
 \begin{array}{r}
 13.0 \\
 \hline
 3
 \end{array}
 \begin{array}{r}
 12.3 \\
 \hline
 +0.3
 \end{array}
 \begin{array}{r}
 12.3 \\
 \hline
 2
 \end{array}
 \begin{array}{r}
 11.7 \\
 \hline
 4
 \end{array}
 \begin{array}{r}
 12.5 \\
 \hline
 13
 \end{array}
 \begin{array}{r}
 12.1 \\
 \hline
 24.8
 \end{array}
 \begin{array}{r}
 12.4 \\
 \hline
 33
 \end{array}
 \qquad
 \begin{array}{r}
 C0.5 \\
 \hline
 24.8
 \end{array}$$

$$\begin{array}{r}
 DC1.1 \\
 \hline
 22.7
 \end{array}
 \qquad
 \begin{array}{r}
 13.1 \\
 \hline
 33
 \end{array}
 \begin{array}{r}
 12.2 \\
 \hline
 22.7
 \end{array}
 \begin{array}{r}
 11.4 \\
 \hline
 11
 \end{array}
 \begin{array}{r}
 11.2 \\
 \hline
 +0.8
 \end{array}
 \begin{array}{r}
 10.2 \\
 \hline
 4
 \end{array}
 \begin{array}{r}
 10.2 \\
 \hline
 12
 \end{array}
 \begin{array}{r}
 10.4 \\
 \hline
 21
 \end{array}
 \begin{array}{r}
 9.5 \\
 \hline
 24
 \end{array}
 \begin{array}{r}
 9.0 \\
 \hline
 28.2
 \end{array}
 \begin{array}{r}
 9.5 \\
 \hline
 33
 \end{array}
 \qquad
 \begin{array}{r}
 C2.8 \\
 \hline
 28.2
 \end{array}$$

$$\begin{array}{r}
 DC1.7 \\
 \hline
 23.6
 \end{array}
 \qquad
 \begin{array}{r}
 12.4 \\
 \hline
 33
 \end{array}
 \begin{array}{r}
 11.6 \\
 \hline
 23.6
 \end{array}
 \begin{array}{r}
 10.1 \\
 \hline
 12
 \end{array}
 \begin{array}{r}
 9.0 \\
 \hline
 +2.3
 \end{array}
 \begin{array}{r}
 8.3 \\
 \hline
 5
 \end{array}
 \begin{array}{r}
 8.4 \\
 \hline
 19
 \end{array}
 \begin{array}{r}
 6.9 \\
 \hline
 23
 \end{array}
 \begin{array}{r}
 6.6 \\
 \hline
 31.1
 \end{array}
 \begin{array}{r}
 6.2 \\
 \hline
 33
 \end{array}
 \qquad
 \begin{array}{r}
 C4.7 \\
 \hline
 31.1
 \end{array}$$

$$\begin{array}{r}
 C0.5 \\
 \hline
 24.8
 \end{array}
 \qquad
 \begin{array}{r}
 11.6 \\
 \hline
 33
 \end{array}
 \begin{array}{r}
 10.7 \\
 \hline
 24.8
 \end{array}
 \begin{array}{r}
 8.4 \\
 \hline
 10
 \end{array}
 \begin{array}{r}
 8.0 \\
 \hline
 +3.2
 \end{array}
 \begin{array}{r}
 7.4 \\
 \hline
 1
 \end{array}
 \begin{array}{r}
 6.6 \\
 \hline
 4
 \end{array}
 \begin{array}{r}
 6.6 \\
 \hline
 20
 \end{array}
 \begin{array}{r}
 5.2 \\
 \hline
 24
 \end{array}
 \begin{array}{r}
 4.6 \\
 \hline
 33
 \end{array}
 \begin{array}{r}
 3.9 \\
 \hline
 40
 \end{array}
 \qquad
 \begin{array}{r}
 C6.6 \\
 \hline
 33
 \end{array}$$

$$\begin{array}{r}
 C0.1 \\
 \hline
 24.2
 \end{array}
 \qquad
 \begin{array}{r}
 10.6 \\
 \hline
 33
 \end{array}
 \begin{array}{r}
 9.7 \\
 \hline
 24.2
 \end{array}
 \begin{array}{r}
 7.3 \\
 \hline
 6
 \end{array}
 \begin{array}{r}
 7.2 \\
 \hline
 1
 \end{array}
 \begin{array}{r}
 6.1 \\
 \hline
 +3.7
 \end{array}
 \begin{array}{r}
 5.2 \\
 \hline
 10
 \end{array}
 \begin{array}{r}
 5.1 \\
 \hline
 21
 \end{array}
 \begin{array}{r}
 3.3 \\
 \hline
 25
 \end{array}
 \begin{array}{r}
 2.3 \\
 \hline
 33
 \end{array}
 \begin{array}{r}
 1.3 \\
 \hline
 40
 \end{array}
 \qquad
 \begin{array}{r}
 C7.5 \\
 \hline
 33
 \end{array}$$

$$\begin{array}{r}
 DC1.4 \\
 \hline
 23.1
 \end{array}
 \qquad
 \begin{array}{r}
 11.7 \\
 \hline
 33
 \end{array}
 \begin{array}{r}
 11.2 \\
 \hline
 23.1
 \end{array}
 \begin{array}{r}
 9.7 \\
 \hline
 9
 \end{array}
 \begin{array}{r}
 9.2 \\
 \hline
 +1.4
 \end{array}
 \begin{array}{r}
 7.5 \\
 \hline
 10
 \end{array}
 \begin{array}{r}
 7.0 \\
 \hline
 20
 \end{array}
 \begin{array}{r}
 3.5 \\
 \hline
 27
 \end{array}
 \begin{array}{r}
 2.4 \\
 \hline
 33
 \end{array}
 \begin{array}{r}
 0.1 \\
 \hline
 40
 \end{array}
 \qquad
 \begin{array}{r}
 C8.2 \\
 \hline
 33
 \end{array}$$

$$\begin{array}{r}
 DC1.2 \\
 \hline
 22.8
 \end{array}
 \qquad
 \begin{array}{r}
 12.9 \\
 \hline
 33
 \end{array}
 \begin{array}{r}
 12.6 \\
 \hline
 22.8
 \end{array}
 \begin{array}{r}
 11.6 \\
 \hline
 11
 \end{array}
 \begin{array}{r}
 11.0 \\
 \hline
 +0.8
 \end{array}
 \begin{array}{r}
 8.7 \\
 \hline
 10
 \end{array}
 \begin{array}{r}
 8.7 \\
 \hline
 19
 \end{array}
 \begin{array}{r}
 3.4 \\
 \hline
 28
 \end{array}
 \begin{array}{r}
 1.9 \\
 \hline
 33
 \end{array}
 \begin{array}{r}
 0.1 \\
 \hline
 40
 \end{array}
 \qquad
 \begin{array}{r}
 C9.9 \\
 \hline
 33
 \end{array}$$

$$\begin{array}{r}
 C0.0 \\
 \hline
 24.0
 \end{array}
 \qquad
 \begin{array}{r}
 13.7 \\
 \hline
 33
 \end{array}
 \begin{array}{r}
 13.5 \\
 \hline
 24.0
 \end{array}
 \begin{array}{r}
 12.5 \\
 \hline
 10
 \end{array}
 \begin{array}{r}
 11.9 \\
 \hline
 +1.6
 \end{array}
 \begin{array}{r}
 10.3 \\
 \hline
 9
 \end{array}
 \begin{array}{r}
 10.2 \\
 \hline
 21
 \end{array}
 \begin{array}{r}
 7.7 \\
 \hline
 26
 \end{array}
 \begin{array}{r}
 6.0 \\
 \hline
 33
 \end{array}
 \begin{array}{r}
 4.8 \\
 \hline
 40
 \end{array}
 \qquad
 \begin{array}{r}
 C7.5 \\
 \hline
 33
 \end{array}$$

$$\begin{array}{r}
 C1.0 \\
 \hline
 25.5
 \end{array}
 \qquad
 \begin{array}{r}
 14.8 \\
 \hline
 33
 \end{array}
 \begin{array}{r}
 14.4 \\
 \hline
 25.5
 \end{array}
 \begin{array}{r}
 13.3 \\
 \hline
 12
 \end{array}
 \begin{array}{r}
 12.9 \\
 \hline
 2
 \end{array}
 \begin{array}{r}
 12.2 \\
 \hline
 +3.2
 \end{array}
 \begin{array}{r}
 11.1 \\
 \hline
 3
 \end{array}
 \begin{array}{r}
 11.1 \\
 \hline
 10
 \end{array}
 \begin{array}{r}
 11.7 \\
 \hline
 21
 \end{array}
 \begin{array}{r}
 10.2 \\
 \hline
 24
 \end{array}
 \begin{array}{r}
 8.5 \\
 \hline
 33
 \end{array}
 \begin{array}{r}
 7.7 \\
 \hline
 40
 \end{array}
 \qquad
 \begin{array}{r}
 C6.9 \\
 \hline
 33
 \end{array}$$

| Sta. | +     | H.I.     | -     | Elev.    | G.R.   |
|------|-------|----------|-------|----------|--------|
|      |       | 969.36 ✓ |       |          |        |
| T.P. | 0.31  | 958.60 ✓ | 11.07 | 958.29 ✓ |        |
| 36   |       |          |       | 52.1     | 6.5 -  |
| +50  |       |          |       | 50.2     | 8.4 -  |
| T.P. | 3.57  | 950.00 ✓ | 12.17 | 944.43 ✓ |        |
| 37   |       |          |       | 48.6     | 1.4 -  |
| +50  |       |          |       | 47.5     | 2.5 -  |
| 38   |       |          |       | 47.1     | 2.9 -  |
| +50  |       |          |       | 47.1     | 2.9 -  |
| 39   |       |          |       | 47.8     | 2.2 -  |
| +50  |       |          |       | 49.0 ✓   | 1.0 -  |
| B.M. | 11.40 | 958.91 ✓ | 2.50  | 947.50 ✓ | 947.51 |
| +78  |       |          |       | 49.8     | 9.1 -  |
| 40   |       |          |       | 50.5     | 8.4 -  |
| +50  |       |          |       | 51.9     | 7.0 -  |



4-14-32

$$\begin{array}{r} DC1.5 \\ \hline 23.3 \end{array} \quad \begin{array}{r} 7.6 \\ \hline 33 \end{array} \quad \begin{array}{r} 2.0 \\ \hline 233 \end{array} \quad \begin{array}{r} 5.5 \\ \hline 11 \end{array} \quad \begin{array}{r} 5.0 \\ \hline 2 \end{array} \quad \begin{array}{r} 4.2 \\ \hline +23 \end{array} \quad \begin{array}{r} 2.9 \\ \hline 10 \end{array} \quad \begin{array}{r} 3.3 \\ \hline 22 \end{array} \quad \begin{array}{r} 1.6 \\ \hline 26 \end{array} \quad \begin{array}{r} 0.6 \\ \hline 329 \end{array} \quad \begin{array}{r} 0.0 \\ \hline 38 \end{array} \quad \begin{array}{r} C5.9 \\ \hline 32.9 \end{array}$$

$$\begin{array}{r} F2.0 \\ \hline 17 \end{array} \quad \begin{array}{r} 11.8 \\ \hline 33 \end{array} \quad \begin{array}{r} 10.4 \\ \hline 17.0 \end{array} \quad \begin{array}{r} 9.8 \\ \hline 14 \end{array} \quad \begin{array}{r} 8.9 \\ \hline 3 \end{array} \quad \begin{array}{r} 7.3 \\ \hline +11 \end{array} \quad \begin{array}{r} 6.5 \\ \hline 7 \end{array} \quad \begin{array}{r} 7.3 \\ \hline 10 \end{array} \quad \begin{array}{r} 6.8 \\ \hline 22 \end{array} \quad \begin{array}{r} 4.0 \\ \hline 26 \end{array} \quad \begin{array}{r} 3.1 \\ \hline 32.0 \end{array} \quad \begin{array}{r} 3.0 \\ \hline 33 \end{array} \quad \begin{array}{r} C5.3 \\ \hline 32.0 \end{array}$$

$$\begin{array}{r} F5.2 \\ \hline 23.4 \end{array} \quad \begin{array}{r} 7.2 \\ \hline 33 \end{array} \quad \begin{array}{r} 6.6 \\ \hline 23.4 \end{array} \quad \begin{array}{r} 5.5 \\ \hline 11 \end{array} \quad \begin{array}{r} 5.4 \\ \hline 4 \end{array} \quad \begin{array}{r} 4.2 \\ \hline -28 \end{array} \quad \begin{array}{r} 3.4 \\ \hline 8 \end{array} \quad \begin{array}{r} 3.8 \\ \hline 10 \end{array} \quad \begin{array}{r} 3.8 \\ \hline 19 \end{array} \quad \begin{array}{r} 2.9 \\ \hline 21.8 \end{array} \quad \begin{array}{r} 1.7 \\ \hline 26 \end{array} \quad \begin{array}{r} 0.4 \\ \hline 33 \end{array} \quad \begin{array}{r} DC0.5 \\ \hline 21.8 \end{array}$$

$$\begin{array}{r} F7.2 \\ \hline 27.4 \end{array} \quad \begin{array}{r} 9.7 \\ \hline 33 \end{array} \quad \begin{array}{r} 9.7 \\ \hline 27.4 \end{array} \quad \begin{array}{r} 8.9 \\ \hline 4 \end{array} \quad \begin{array}{r} 8.0 \\ \hline -5.5 \end{array} \quad \begin{array}{r} 7.8 \\ \hline 19 \end{array} \quad \begin{array}{r} 8.0 \\ \hline 24.0 \end{array} \quad \begin{array}{r} 8.2 \\ \hline 33 \end{array} \quad \begin{array}{r} F5.5 \\ \hline 24.0 \end{array}$$

$$\begin{array}{r} F8.1 \\ \hline 29.2 \end{array} \quad \begin{array}{r} 10.9 \\ \hline 33 \end{array} \quad \begin{array}{r} 11.0 \\ \hline 29.2 \end{array} \quad \begin{array}{r} 11.4 \\ \hline 14 \end{array} \quad \begin{array}{r} 11.4 \\ \hline 8.5 \end{array} \quad \begin{array}{r} 10.4 \\ \hline 8 \end{array} \quad \begin{array}{r} 9.8 \\ \hline 17 \end{array} \quad \begin{array}{r} 11.2 \\ \hline 29.6 \end{array} \quad \begin{array}{r} 11.3 \\ \hline 33 \end{array} \quad \begin{array}{r} F8.3 \\ \hline 29.6 \end{array}$$

$$\begin{array}{r} F6.8 \\ \hline 26.6 \end{array} \quad \begin{array}{r} 9.1 \\ \hline 33 \end{array} \quad \begin{array}{r} 9.7 \\ \hline 26.6 \end{array} \quad \begin{array}{r} 9.9 \\ \hline 9 \end{array} \quad \begin{array}{r} 10.2 \\ \hline -7.3 \end{array} \quad \begin{array}{r} 10.2 \\ \hline 17 \end{array} \quad \begin{array}{r} 12.0 \\ \hline 24 \end{array} \quad \begin{array}{r} 12.3 \\ \hline 31.8 \end{array} \quad \begin{array}{r} 12.4 \\ \hline 33 \end{array} \quad \begin{array}{r} F9.4 \\ \hline 31.8 \end{array}$$

$$\begin{array}{r} F3.8 \\ \hline 20.6 \end{array} \quad \begin{array}{r} 5.3 \\ \hline 33 \end{array} \quad \begin{array}{r} 6.0 \\ \hline 20.6 \end{array} \quad \begin{array}{r} 6.5 \\ \hline 16 \end{array} \quad \begin{array}{r} 5.9 \\ \hline -3.7 \end{array} \quad \begin{array}{r} 6.1 \\ \hline 7 \end{array} \quad \begin{array}{r} 6.8 \\ \hline 20 \end{array} \quad \begin{array}{r} 7.7 \\ \hline 24.0 \end{array} \quad \begin{array}{r} 9.3 \\ \hline 33 \end{array} \quad \begin{array}{r} F5.5 \\ \hline 24.0 \end{array}$$

$$\begin{array}{r} DC1.0 \\ \hline 22.5 \end{array} \quad \begin{array}{r} 1.5 \\ \hline 33 \end{array} \quad \begin{array}{r} 2.0 \\ \hline 22.5 \end{array} \quad \begin{array}{r} 2.0 \\ \hline 4 \end{array} \quad \begin{array}{r} 2.4 \\ \hline -1.4 \end{array} \quad \begin{array}{r} 3.1 \\ \hline 16 \end{array} \quad \begin{array}{r} 3.5 \\ \hline 18.0 \end{array} \quad \begin{array}{r} 5.3 \\ \hline 33 \end{array} \quad \begin{array}{r} F2.5 \\ \hline 18.0 \end{array}$$

Spk in 20" Oak 75' RA Sta. 39+78

$$\begin{array}{r} C1.8 \\ \hline 26.7 \end{array} \quad \begin{array}{r} 7.1 \\ \hline 33 \end{array} \quad \begin{array}{r} 7.3 \\ \hline 26.7 \end{array} \quad \begin{array}{r} 9.0 \\ \hline 10 \end{array} \quad \begin{array}{r} 9.5 \\ \hline -0.4 \end{array} \quad \begin{array}{r} 10.0 \\ \hline 18 \end{array} \quad \begin{array}{r} 10.2 \\ \hline 22.4 \end{array} \quad \begin{array}{r} 10.2 \\ \hline 33 \end{array} \quad \begin{array}{r} DC0.9 \\ \hline 22.4 \end{array}$$

$$\begin{array}{r} C1.4 \\ \hline 26.1 \end{array} \quad \begin{array}{r} 6.7 \\ \hline 33 \end{array} \quad \begin{array}{r} 7.0 \\ \hline 26.1 \end{array} \quad \begin{array}{r} 7.6 \\ \hline 11 \end{array} \quad \begin{array}{r} 7.7 \\ \hline +0.7 \end{array} \quad \begin{array}{r} 8.3 \\ \hline 12 \end{array} \quad \begin{array}{r} 9.3 \\ \hline 22.7 \end{array} \quad \begin{array}{r} 9.8 \\ \hline 33 \end{array} \quad \begin{array}{r} DC1.1 \\ \hline 22.7 \end{array}$$

$$\begin{array}{r} C3.4 \\ \hline 29.1 \end{array} \quad \begin{array}{r} 3.5 \\ \hline 33 \end{array} \quad \begin{array}{r} 3.6 \\ \hline 29.1 \end{array} \quad \begin{array}{r} 4.3 \\ \hline 12 \end{array} \quad \begin{array}{r} 4.1 \\ \hline +2.9 \end{array} \quad \begin{array}{r} 4.5 \\ \hline 12 \end{array} \quad \begin{array}{r} 6.2 \\ \hline 25.2 \end{array} \quad \begin{array}{r} 6.6 \\ \hline 33 \end{array} \quad \begin{array}{r} C0.8 \\ \hline 25.2 \end{array}$$

| Sta. | +    | H.I.     | -    | Elev.  | G.R.  |
|------|------|----------|------|--------|-------|
|      |      | 958.91 ✓ |      |        |       |
| 41   |      |          |      | 53.1   | 5.8 - |
| +50  |      |          |      | 54.1   | 4.8 - |
| 42   |      |          |      | 55.0 ✓ | 3.9 - |
| T.P. | 2.53 | 959.08 ✓ | 2.36 | 956.55 |       |
| +50  |      |          |      | 55.6   | 3.5 - |
| 43   |      |          |      | 56.1   | 3.0 - |
| +50  |      |          |      | 56.4   | 2.7 - |
| 44   |      |          |      | 56.7   | 2.4 - |
| +50  |      |          |      | 57.1   | 2.0 - |
| 45   |      |          |      | 57.5   | 1.6 - |
| +50  |      |          |      | 57.8   | 1.3 - |
| 46   |      |          |      | 58.2   | 0.9 - |

5.4

|             |            |            |            |            |            |            |            |             |
|-------------|------------|------------|------------|------------|------------|------------|------------|-------------|
| <u>C3.5</u> | <u>2.3</u> | <u>2.3</u> | <u>2.7</u> | <u>1.7</u> | <u>1.9</u> | <u>3.5</u> | <u>3.5</u> | <u>C2.3</u> |
| 29.3        | 33         | 29.3       | 11         | 4.1        | 12         | 27.5       | 33         | 27.5        |

4.8

|             |            |            |            |            |            |            |            |             |
|-------------|------------|------------|------------|------------|------------|------------|------------|-------------|
| <u>C1.8</u> | <u>3.1</u> | <u>3.0</u> | <u>3.0</u> | <u>1.7</u> | <u>1.6</u> | <u>2.8</u> | <u>2.8</u> | <u>C2.0</u> |
| 26.7        | 33         | 26.7       | 14         | 4.1        | 11         | 23         | 27.0       | 27.0        |

3.9

|             |            |            |            |            |            |            |            |             |
|-------------|------------|------------|------------|------------|------------|------------|------------|-------------|
| <u>C0.4</u> | <u>3.6</u> | <u>3.5</u> | <u>3.0</u> | <u>2.3</u> | <u>2.1</u> | <u>3.4</u> | <u>3.3</u> | <u>C0.5</u> |
| 24.6        | 33         | 24.6       | 16         | 4.6        | 12         | 24.8       | 33         | 24.8        |

3.5

4-15-32

|             |            |            |            |            |            |            |            |            |            |              |
|-------------|------------|------------|------------|------------|------------|------------|------------|------------|------------|--------------|
| <u>C0.1</u> | <u>3.4</u> | <u>3.4</u> | <u>3.5</u> | <u>3.6</u> | <u>2.9</u> | <u>3.0</u> | <u>2.8</u> | <u>4.3</u> | <u>4.2</u> | <u>DC1.2</u> |
| 24.2        | 33         | 24.2       | 17         | 13         | 7          | 40.5       | 11         | 22.8       | 33         | 22.8         |

3.0

|              |            |            |            |            |            |            |            |            |            |            |              |
|--------------|------------|------------|------------|------------|------------|------------|------------|------------|------------|------------|--------------|
| <u>DC1.3</u> | <u>3.8</u> | <u>3.7</u> | <u>3.5</u> | <u>4.1</u> | <u>3.3</u> | <u>3.1</u> | <u>3.1</u> | <u>4.1</u> | <u>4.4</u> | <u>4.6</u> | <u>DC0.4</u> |
| 23.0         | 33         | 23.0       | 18         | 13         | 8          | -0.1       | 11         | 18         | 21.9       | 33         | 21.9         |

2.1

|              |            |            |            |            |            |            |            |            |            |              |
|--------------|------------|------------|------------|------------|------------|------------|------------|------------|------------|--------------|
| <u>DC0.9</u> | <u>4.1</u> | <u>3.8</u> | <u>3.6</u> | <u>4.4</u> | <u>3.8</u> | <u>3.6</u> | <u>3.5</u> | <u>4.7</u> | <u>4.8</u> | <u>DC0.0</u> |
| 22.4         | 33         | 22.4       | 19         | 14         | 8          | -0.9       | 9          | 21.0       | 33         | 21.0         |

2.4

|              |            |            |            |            |            |            |            |            |            |              |
|--------------|------------|------------|------------|------------|------------|------------|------------|------------|------------|--------------|
| <u>DC0.3</u> | <u>4.0</u> | <u>4.1</u> | <u>3.8</u> | <u>4.4</u> | <u>3.7</u> | <u>3.4</u> | <u>3.3</u> | <u>4.4</u> | <u>4.5</u> | <u>DC0.0</u> |
| 21.5         | 33         | 21.5       | 18         | 15         | 11         | -1.0       | 9          | 21.0       | 33         | 21.0         |

2.0

|              |            |            |            |            |            |            |            |            |            |             |
|--------------|------------|------------|------------|------------|------------|------------|------------|------------|------------|-------------|
| <u>DC0.7</u> | <u>3.2</u> | <u>3.3</u> | <u>3.1</u> | <u>3.9</u> | <u>3.3</u> | <u>3.3</u> | <u>3.5</u> | <u>4.4</u> | <u>4.6</u> | <u>F2.4</u> |
| 22.1         | 33         | 22.1       | 19         | 15         | 11         | -1.3       | 11         | 17.8       | 33         | 17.8        |

1.6

|              |            |            |            |            |            |            |            |            |            |             |
|--------------|------------|------------|------------|------------|------------|------------|------------|------------|------------|-------------|
| <u>DC0.7</u> | <u>2.7</u> | <u>2.9</u> | <u>2.7</u> | <u>3.7</u> | <u>3.1</u> | <u>3.1</u> | <u>3.2</u> | <u>3.9</u> | <u>4.3</u> | <u>F2.3</u> |
| 22.1         | 33         | 22.1       | 19         | 14         | 9          | -1.5       | 12         | 17.6       | 33         | 17.6        |

1.3

|              |            |            |            |            |            |            |            |            |            |              |
|--------------|------------|------------|------------|------------|------------|------------|------------|------------|------------|--------------|
| <u>DC0.7</u> | <u>2.4</u> | <u>2.6</u> | <u>2.7</u> | <u>3.6</u> | <u>2.7</u> | <u>2.7</u> | <u>2.3</u> | <u>3.3</u> | <u>3.5</u> | <u>DC0.0</u> |
| 22.1         | 33         | 22.1       | 19         | 14         | 9          | -1.4       | 13         | 21.0       | 33         | 21.0         |

0.9

|              |            |            |            |            |            |            |            |            |            |              |
|--------------|------------|------------|------------|------------|------------|------------|------------|------------|------------|--------------|
| <u>DC0.9</u> | <u>1.6</u> | <u>2.0</u> | <u>2.1</u> | <u>3.1</u> | <u>1.7</u> | <u>1.8</u> | <u>1.3</u> | <u>2.3</u> | <u>2.5</u> | <u>DC0.6</u> |
| 22.4         | 33         | 22.4       | 19         | 14         | 6          | -0.9       | 11         | 21.9       | 33         | 21.9         |

| Sta   | +    | H.I. ✓   | -    | Elev.    | G.P.  |
|-------|------|----------|------|----------|-------|
|       |      | 959.08   |      |          |       |
| 46+50 |      |          |      | 58.5 ✓   | 0.6 - |
| T.P.  | 6.08 | 964.95 ✓ | 0.21 | 958.87   |       |
| 47    |      |          |      | 58.8     | 6.2 - |
| +50   |      |          |      | 59.2     | 5.8 - |
| 48    |      |          |      | 59.5     | 5.5 - |
| +50   |      |          |      | 59.8     | 5.2 - |
| 49    |      |          |      | 59.7     | 5.3 - |
| +50   |      |          |      | 59.4     | 5.6 - |
| 50    |      |          |      | 58.8     | 6.2 - |
| +50   |      |          |      | 57.9 ✓   | 7.1 - |
| T.P.  | 4.79 | 960.09 ✓ | 9.65 | 955.30 ✓ |       |
| 51    |      |          |      | 56.7     | 3.4 - |
| +50   |      |          |      | 55.6     | 4.5 - |



$$\begin{array}{r} \text{DC0.8} \\ \hline 22.2 \end{array} \quad \begin{array}{r} 1.8 \\ 33 \end{array} \quad \begin{array}{r} 1.8 \\ 22.2 \end{array} \quad \begin{array}{r} 1.3 \\ 21 \end{array} \quad \begin{array}{r} 2.0 \\ 17 \end{array} \quad \begin{array}{r} 0.5 \\ 9 \end{array} \quad \begin{array}{r} 0.6 \\ 00 \end{array} \quad \begin{array}{r} 0.7 \\ 13 \end{array} \quad \begin{array}{r} 1.6 \\ 18 \end{array} \quad \begin{array}{r} 1.7 \\ 22.4 \end{array} \quad \begin{array}{r} 1.7 \\ 33 \end{array} \quad \begin{array}{r} \text{DC0.9} \\ \hline 22.4 \end{array}$$

$$\begin{array}{r} \text{DC1.5} \\ \hline 23.3 \end{array} \quad \begin{array}{r} 6.9 \\ 33 \end{array} \quad \begin{array}{r} 6.7 \\ 23.3 \end{array} \quad \begin{array}{r} 6.4 \\ 12 \end{array} \quad \begin{array}{r} 7.4 \\ 14 \end{array} \quad \begin{array}{r} 6.3 \\ 8 \end{array} \quad \begin{array}{r} 6.0 \\ 10.2 \end{array} \quad \begin{array}{r} 6.0 \\ 12 \end{array} \quad \begin{array}{r} 6.8 \\ 23.1 \end{array} \quad \begin{array}{r} 6.8 \\ 33 \end{array} \quad \begin{array}{r} \text{DC1.4} \\ \hline 23.1 \end{array}$$

$$\begin{array}{r} \text{C01} \\ \hline 24.2 \end{array} \quad \begin{array}{r} 5.9 \\ 33 \end{array} \quad \begin{array}{r} 5.7 \\ 24.2 \end{array} \quad \begin{array}{r} 5.2 \\ 21 \end{array} \quad \begin{array}{r} 6.2 \\ 17 \end{array} \quad \begin{array}{r} 5.1 \\ 9 \end{array} \quad \begin{array}{r} 4.9 \\ 10.9 \end{array} \quad \begin{array}{r} 5.2 \\ 13 \end{array} \quad \begin{array}{r} 5.9 \\ 23.4 \end{array} \quad \begin{array}{r} 6.1 \\ 33 \end{array} \quad \begin{array}{r} \text{DC1.9} \\ \hline 23.9 \end{array}$$

$$\begin{array}{r} \text{C02} \\ \hline 24.3 \end{array} \quad \begin{array}{r} 5.6 \\ 33 \end{array} \quad \begin{array}{r} 5.3 \\ 24.3 \end{array} \quad \begin{array}{r} 6.0 \\ 18 \end{array} \quad \begin{array}{r} 5.3 \\ 11 \end{array} \quad \begin{array}{r} 4.7 \\ 10.8 \end{array} \quad \begin{array}{r} 4.6 \\ 13 \end{array} \quad \begin{array}{r} 5.3 \\ 24.3 \end{array} \quad \begin{array}{r} 5.4 \\ 33 \end{array} \quad \begin{array}{r} \text{C02} \\ \hline 24.3 \end{array}$$

$$\begin{array}{r} \text{DC1.5} \\ \hline 23.3 \end{array} \quad \begin{array}{r} 6.3 \\ 33 \end{array} \quad \begin{array}{r} 5.7 \\ 23.3 \end{array} \quad \begin{array}{r} 5.6 \\ 22 \end{array} \quad \begin{array}{r} 6.2 \\ 18 \end{array} \quad \begin{array}{r} 5.1 \\ 11 \end{array} \quad \begin{array}{r} 4.7 \\ 10.5 \end{array} \quad \begin{array}{r} 4.3 \\ 12 \end{array} \quad \begin{array}{r} 4.9 \\ 24.5 \end{array} \quad \begin{array}{r} 4.8 \\ 33 \end{array} \quad \begin{array}{r} \text{C03} \\ \hline 24.5 \end{array}$$

$$\begin{array}{r} \text{C00} \\ \hline 24.0 \end{array} \quad \begin{array}{r} 5.5 \\ 33 \end{array} \quad \begin{array}{r} 5.3 \\ 24.0 \end{array} \quad \begin{array}{r} 5.1 \\ 22 \end{array} \quad \begin{array}{r} 5.8 \\ 17 \end{array} \quad \begin{array}{r} 4.6 \\ 9 \end{array} \quad \begin{array}{r} 4.5 \\ 10.8 \end{array} \quad \begin{array}{r} 4.2 \\ 12 \end{array} \quad \begin{array}{r} 4.9 \\ 24.6 \end{array} \quad \begin{array}{r} 4.7 \\ 33 \end{array} \quad \begin{array}{r} \text{C04} \\ \hline 24.6 \end{array}$$

$$\begin{array}{r} \text{C02} \\ \hline 24.3 \end{array} \quad \begin{array}{r} 5.3 \\ 33 \end{array} \quad \begin{array}{r} 5.4 \\ 24.3 \end{array} \quad \begin{array}{r} 5.1 \\ 21 \end{array} \quad \begin{array}{r} 6.0 \\ 17 \end{array} \quad \begin{array}{r} 4.5 \\ 2 \end{array} \quad \begin{array}{r} 4.5 \\ 11.1 \end{array} \quad \begin{array}{r} 4.6 \\ 11 \end{array} \quad \begin{array}{r} 5.3 \\ 24.5 \end{array} \quad \begin{array}{r} 5.1 \\ 33 \end{array} \quad \begin{array}{r} \text{C0.3} \\ \hline 24.5 \end{array}$$

$$\begin{array}{r} \text{C1.1} \\ \hline 25.7 \end{array} \quad \begin{array}{r} 5.2 \\ 33 \end{array} \quad \begin{array}{r} 5.1 \\ 25.7 \end{array} \quad \begin{array}{r} 6.5 \\ 16 \end{array} \quad \begin{array}{r} 5.0 \\ 6 \end{array} \quad \begin{array}{r} 5.0 \\ 11.2 \end{array} \quad \begin{array}{r} 5.1 \\ 10 \end{array} \quad \begin{array}{r} 5.4 \\ 25.2 \end{array} \quad \begin{array}{r} 5.1 \\ 33 \end{array} \quad \begin{array}{r} \text{C08} \\ \hline 25.2 \end{array}$$

$$\begin{array}{r} \text{C2.4} \\ \hline 27.6 \end{array} \quad \begin{array}{r} 4.9 \\ 33 \end{array} \quad \begin{array}{r} 4.7 \\ 27.6 \end{array} \quad \begin{array}{r} 4.5 \\ 25 \end{array} \quad \begin{array}{r} 7.9 \\ 15 \end{array} \quad \begin{array}{r} 6.5 \\ 5 \end{array} \quad \begin{array}{r} 6.9 \\ 10.2 \end{array} \quad \begin{array}{r} 7.0 \\ 10 \end{array} \quad \begin{array}{r} 7.5 \\ 23.4 \end{array} \quad \begin{array}{r} 7.2 \\ 33 \end{array} \quad \begin{array}{r} \text{DC1.6} \\ \hline 23.4 \end{array}$$

$$\begin{array}{r} \text{DC02} \\ \hline 21.3 \end{array} \quad \begin{array}{r} 5.0 \\ 33 \end{array} \quad \begin{array}{r} 5.2 \\ 21.3 \end{array} \quad \begin{array}{r} 5.4 \\ 20 \end{array} \quad \begin{array}{r} 6.4 \\ 16 \end{array} \quad \begin{array}{r} 5.0 \\ 7 \end{array} \quad \begin{array}{r} 4.9 \\ 11.5 \end{array} \quad \begin{array}{r} 4.9 \\ 9 \end{array} \quad \begin{array}{r} 6.1 \\ 18.4 \end{array} \quad \begin{array}{r} 6.9 \\ 33 \end{array} \quad \begin{array}{r} \text{F2.7} \\ \hline 18.4 \end{array}$$

$$\begin{array}{r} \text{F4.3} \\ \hline 21.6 \end{array} \quad \begin{array}{r} 9.1 \\ 33 \end{array} \quad \begin{array}{r} 8.8 \\ 21.6 \end{array} \quad \begin{array}{r} 8.5 \\ 15 \end{array} \quad \begin{array}{r} 7.0 \\ 5 \end{array} \quad \begin{array}{r} 6.9 \\ 12.4 \end{array} \quad \begin{array}{r} 7.4 \\ 9 \end{array} \quad \begin{array}{r} 8.3 \\ 20.6 \end{array} \quad \begin{array}{r} 9.0 \\ 33 \end{array} \quad \begin{array}{r} \text{F3.8} \\ \hline 20.6 \end{array}$$

| Sta.              | + | H.I. / - | Elev.  | G.R.   |
|-------------------|---|----------|--------|--------|
|                   |   | 960.09   |        |        |
| 52                |   |          | 55.0   | 5.1-   |
| +61               |   |          | 53.9   |        |
| +67               |   |          | 54.4   |        |
| +80 <sup>50</sup> |   |          | 55.1   |        |
| B.M.              |   | 5.38     | 954.71 | 954.73 |

$$\frac{F3.3}{19.6}$$

$$\frac{8.2}{33}$$

$$\frac{8.4}{19.6}$$

$$\frac{8.5}{14}$$

$$\frac{7.6}{2.5}$$

51

$$\frac{7.9}{10}$$

$$\frac{8.7}{20.2}$$

$$\frac{9.5}{33}$$

$$\frac{F3.6}{20.2}$$

$$\frac{8.2}{50}$$

$$\frac{8.2}{23}$$

$$\frac{7.5}{12}$$

$$\frac{6.7}{9}$$

$$6.2$$

$$\frac{6.4}{19}$$

$$\frac{7.8}{23}$$

$$\frac{8.4}{50}$$

$$\frac{6.6}{50}$$

$$\frac{6.3}{25}$$

$$5.7$$

$$\frac{5.5}{25}$$


$$\frac{5.3}{50}$$

$$\frac{5.8}{50}$$


$$5.0$$

$$\frac{4.3}{50}$$

Spt. in 20" Oak S.E. Cor. Bellaire & 'F'

 



 


|       |              |        |        |       |
|-------|--------------|--------|--------|-------|
| B.M.  | 5.22         | 951.87 | 946.65 |       |
| 14+50 |              |        | 45.0   | 6.87✓ |
| 15    |              |        | 45.1   | 6.77✓ |
| +50   |              |        | 45.2   | 6.67✓ |
| 16    |              |        | 45.3   | 6.57✓ |
| +50   |              |        | 45.4   | 6.47✓ |
| 17    |              |        | 45.5   | 6.37- |
| +50   |              |        | 45.6   | 6.27✓ |
| 18    |              |        | 45.7   | 6.17✓ |
| +50   |              |        | 45.8   | 6.07✓ |
| 19    |              |        | 46.0   | 5.87✓ |
| +50   |              |        | 46.1   | 5.77✓ |
| 20    |              |        | 46.3   | 5.57✓ |
| +50   |              |        | 46.5   | 5.37✓ |
| 21    |              |        | 46.7   | 5.17✓ |
| +50   |              |        | 46.9   | 4.97✓ |
| 22    |              |        | 47.1   | 4.77✓ |
| +50   |              |        | 47.3   | 4.57✓ |
| 23    |              |        | 47.5   | 4.37✓ |
| +50   |              |        | 47.8   | 4.07✓ |
| 24    |              |        | 48.1   | 3.77✓ |
| +50   |              |        | 48.5   | 3.37✓ |
| 25    |              |        | 49.0   | 2.87✓ |
| +50   |              |        | 49.6   | 2.27✓ |
| 26    |              |        | 50.4   | 1.47✓ |
| +50   |              |        | 51.1   | 0.77  |
| T.P.  | Top of Mont. | 1.42   | 950.45 |       |

|             |            |
|-------------|------------|
| 950.45      | 6.0        |
| <u>4.25</u> | <u>4.5</u> |
| 954.70      | 1.7        |
| <u>51.1</u> |            |
| 3.6         | 1014       |
| <u>5.6</u>  | <u>20</u>  |
|             | 280        |

|       |      |        |       |        |        |
|-------|------|--------|-------|--------|--------|
| B.M.  | 7.34 | 962.07 |       | 954.73 |        |
| 52+00 |      |        |       | 55.0   | 2.07 ✓ |
| +50   |      |        |       | 55.6   | 6.47 ✓ |
| 51    |      |        |       | 56.7   | 5.37 ✓ |
| +50   |      |        |       | 57.9   | 4.17 ✓ |
| 50    |      |        |       | 58.8   | 3.27 ✓ |
| +50   |      |        |       | 59.4   | 2.67 ✓ |
| 49    |      |        |       | 59.7   | 2.37 ✓ |
| +50   |      |        |       | 59.8   | 2.27 ✓ |
| 48    |      |        |       | 59.5   | 2.57 ✓ |
| +50   |      |        |       | 59.2   | 2.87 ✓ |
| 47    |      |        |       | 58.8   | 3.27 ✓ |
| +50   |      |        |       | 58.5   | 3.57 ✓ |
| T.P.  | 0.21 | 958.71 | 3.57  | 958.50 |        |
| 46    |      |        |       | 58.2   | 0.51 ✓ |
| +50   |      |        |       | 57.8   | .91 ✓  |
| 45    |      |        |       | 57.5   | 1.21 ✓ |
| +50   |      |        |       | 57.1   | 1.61 ✓ |
| 44    |      |        |       | 56.7   | 2.01 ✓ |
| +50   |      |        |       | 56.4   | 2.31 ✓ |
| 43    |      |        |       | 56.1   | 2.61 ✓ |
| +50   |      |        |       | 55.6   | 3.11 ✓ |
| 42    |      |        |       | 55.0   | 3.71 ✓ |
| +50   |      |        |       | 54.1   | 4.61 ✓ |
| 41    |      |        |       | 53.1   | 5.61 ✓ |
| B.M.  |      |        | 11.20 | 947.51 | 947.51 |



 

|      |       |        |      |                   |       |
|------|-------|--------|------|-------------------|-------|
| B.M. | 6.22  | 952.87 |      | 946.65            |       |
| 23   |       |        |      | 47.5              | 5.37✓ |
| +50  |       |        |      | 47.8              | 5.07✓ |
| 24   |       |        |      | 48.1              | 4.77✓ |
| +50  |       |        |      | 48.5              | 4.37✓ |
| 25   |       |        |      | 49.0              | 3.87✓ |
| +50  |       |        |      | 49.6              | 3.27✓ |
| 26   |       |        |      | 50.4              | 2.47✓ |
| +50  |       |        |      | 51.1              | 1.77✓ |
| 27   |       |        |      | 51.8              | 1.07✓ |
| +50  |       |        |      | 52.6              | 0.27✓ |
| T.P. | 11.45 | 962.92 | 1.40 | <del>961.47</del> |       |
| 28   |       |        |      | 53.4              | 9.52✓ |
| +50  |       |        |      | 54.1              | 8.82✓ |
| 29   |       |        |      | 54.8              | 8.12✓ |
| +50  |       |        |      | 55.6              | 7.32✓ |
| 30   |       |        |      | 56.3              | 6.62✓ |
| +50  |       |        |      | 57.1              | 5.82✓ |
| 31   |       |        |      | 57.8              | 5.12✓ |
| +50  |       |        |      | 58.6              | 4.32✓ |
| 32   |       |        |      | 59.2              | 3.72✓ |
| +50  |       |        |      | 59.5              | 3.42✓ |
| 33   |       |        |      | 59.4              | 3.52✓ |
| +50  |       |        |      | 58.9              | 4.02✓ |
| 34   |       |        |      | 58.3              | 4.62✓ |
| +50  |       |        |      | 57.1              | 5.82✓ |

$$\begin{array}{r} 15 \\ 206 \\ \hline 300 \end{array}$$


10.32

10.02

962.92

|      |       |        |       |        |         |
|------|-------|--------|-------|--------|---------|
| 35   |       |        |       | 55.8   | 7.12 ✓  |
| +50  |       |        |       | 54.0   | 8.92 ✓  |
| 36   | 2.72  | 954.20 | 11.44 | 52.1   | 10.82 ✓ |
| +50  |       |        |       | 951.48 |         |
|      |       |        |       | 50.2   | 4.0 ✓   |
| 37   |       |        |       | 48.6   | 5.6 ✓   |
| +50  |       |        |       | 47.5   | 6.7 ✓   |
| 38   |       |        |       | 47.1   | 7.1 ✓   |
| +50  |       |        |       | 47.1   | 7.1 ✓   |
| 39   |       |        |       | 47.8   | 6.4 ✓   |
| +50  |       |        |       | 49.0   | 5.2 ✓   |
| 40   |       |        |       | 50.5   | 3.7 ✓   |
| +50  |       |        |       | 51.9   | 2.3 ✓   |
| 41   |       |        |       | 53.1   | 1.1 ✓   |
| B.M. | 10.32 | 957.83 |       | 947.51 |         |
| 36   |       |        |       | 52.1   | 5.73 -  |
| +50  |       |        |       | 53.9   | 3.93 ✓  |
| 35   |       |        |       | 55.4   | 2.43 ✓  |
| +50  |       |        |       | 56.6   | 1.23 ✓  |
| 34   | 4.24  | 962.85 | 1.22  | 956.61 |         |
| +50  |       |        |       | 57.8   | 5.05 ✓  |
|      |       |        |       | 58.3   | 4.55 ✓  |
| 33   |       |        |       | 58.8   | 4.05 ✓  |
| +50  |       |        |       | 58.9   | 3.95 ✓  |
| 32   |       |        |       | 58.8   | 4.05 ✓  |
| +50  |       |        |       | 58.5   | 4.35 ✓  |
| 31   |       |        |       | 57.8   | 5.05 ✓  |



 


|       |      |        |        |        |
|-------|------|--------|--------|--------|
| B.M.  | 3.99 | 951.50 | 947.51 |        |
| 39+50 |      |        | 49.0   | 2.50 ✓ |
| 39    |      |        | 47.8   | 3.7 ✓  |
| +50   |      |        | 47.1   | 4.4 ✓  |
| 38    |      |        | 47.1   | 4.4 ✓  |
| +50   |      |        | 47.5   | 4.0 ✓  |
| 37    |      |        | 48.6   | 2.9 ✓  |
| +50   |      |        | 50.2   | 1.3 ✓  |

947.51

2.99

951.50

 



Final  
X-Sections

B.M.

5.24

946.43

941.19

0+0

+10

+14

+19

+27

+32

+50

1

+50

2

+50

$$\frac{5.02}{50} \quad \frac{5.12}{25} \quad 5.24 \quad \frac{5.32}{25} \quad \frac{5.43}{50}$$

$$\frac{5.07}{50} \quad \frac{5.20}{25} \quad 5.28 \quad \frac{5.37}{25} \quad \frac{5.51}{50}$$

$$\frac{5.1}{40} \quad \frac{5.3}{20} \quad 5.2 \quad \frac{5.3}{20} \quad \frac{5.6}{40}$$

$$\frac{6.5}{40} \quad \frac{6.6}{36} \quad \frac{5.1}{28} \quad 5.2 \quad \frac{5.7}{35} \quad \frac{7.3}{41} \quad \frac{7.3}{45}$$

$$\frac{6.4}{40} \quad \frac{7.0}{22} \quad \frac{5.5}{18} \quad 5.2 \quad \frac{5.5}{22} \quad \frac{7.3}{29} \quad \frac{7.3}{40}$$

$$\frac{4.7}{33} \quad \frac{4.8}{28} \quad \frac{7.1}{21} \quad \frac{7.1}{19} \quad \frac{5.3}{15} \quad 5.2 \quad \frac{5.5}{18} \quad \frac{7.2}{23} \quad \frac{7.2}{25} \quad \frac{5.2}{28} \quad \frac{5.0}{33}$$

$$\frac{5.2}{33} \quad \frac{5.4}{21} \quad \frac{7.3}{19} \quad \frac{7.3}{17} \quad \frac{5.5}{13} \quad 5.4 \quad \frac{5.5}{13} \quad \frac{7.3}{17} \quad \frac{7.3}{19} \quad \frac{6.0}{21} \quad \frac{6.0}{33}$$

$$\frac{5.8}{33} \quad \frac{6.2}{20} \quad \frac{7.4}{19} \quad \frac{7.3}{17} \quad \frac{5.6}{13} \quad 5.5 \quad \frac{5.5}{13} \quad \frac{7.3}{16} \quad \frac{7.4}{19} \quad \frac{7.0}{20} \quad \frac{6.8}{33}$$

$$\frac{5.8}{33} \quad \frac{6.1}{21} \quad \frac{7.4}{20} \quad \frac{7.4}{17} \quad \frac{5.4}{13} \quad 5.4 \quad \frac{5.4}{13} \quad \frac{7.4}{16} \quad \frac{7.4}{19} \quad \frac{7.0}{20} \quad \frac{6.4}{23}$$

$$\frac{5.4}{33} \quad \frac{5.8}{21} \quad \frac{7.4}{19} \quad \frac{7.4}{17} \quad \frac{5.4}{13} \quad 5.3 \quad \frac{5.4}{13} \quad \frac{7.4}{16} \quad \frac{7.4}{20} \quad \frac{6.9}{24}$$

$$\frac{5.9}{33} \quad \frac{6.4}{20} \quad \frac{7.4}{19} \quad \frac{7.4}{17} \quad \frac{5.3}{13} \quad 5.1 \quad \frac{5.3}{13} \quad \frac{7.1}{16} \quad \frac{7.5}{21} \quad \frac{7.0}{23}$$

✓  
946.43

3

+50

4

+50

5

+50

6

+50

7

B.M.

+50

3.80

✓  
942.63

942.63

8



$$\frac{6.0}{33} \quad \frac{6.4}{20} \quad \frac{7.4}{19} \quad \frac{7.4}{17} \quad \frac{5.2}{13} \quad \frac{5.3}{13} \quad \frac{7.1}{16} \quad \frac{7.1}{20} \quad \frac{6.6}{23}$$

$$\frac{5.8}{33} \quad \frac{6.3}{21} \quad \frac{7.4}{20} \quad \frac{7.3}{17} \quad \frac{5.2}{13} \quad \frac{5.2}{13} \quad \frac{7.4}{17} \quad \frac{7.3}{20} \quad \frac{6.8}{23}$$

$$\frac{5.8}{33} \quad \frac{4.2}{21} \quad \frac{7.5}{20} \quad \frac{7.5}{17} \quad \frac{5.2}{13} \quad \frac{5.2}{13} \quad \frac{7.3}{17} \quad \frac{7.4}{20} \quad \frac{6.8}{23}$$

$$\frac{5.7}{33} \quad \frac{6.3}{21} \quad \frac{7.3}{20} \quad \frac{7.2}{17} \quad \frac{5.2}{13} \quad \frac{5.2}{13} \quad \frac{7.2}{17} \quad \frac{7.2}{20} \quad \frac{6.8}{22}$$

$$\frac{5.0}{33} \quad \frac{5.6}{21} \quad \frac{7.3}{20} \quad \frac{7.1}{17} \quad \frac{5.0}{13} \quad \frac{5.1}{13} \quad \frac{7.2}{17} \quad \frac{7.3}{19} \quad \frac{6.9}{20} \quad \frac{6.6}{23}$$

$$\frac{4.2}{33} \quad \frac{4.7}{21} \quad \frac{6.7}{20} \quad \frac{4.7}{17} \quad \frac{4.7}{13} \quad \frac{4.7}{13} \quad \frac{6.7}{17} \quad \frac{6.9}{20} \quad \frac{6.3}{21} \quad \frac{6.2}{23}$$

$$\frac{4.0}{33} \quad \frac{4.5}{21} \quad \frac{6.4}{20} \quad \frac{6.4}{17} \quad \frac{4.2}{13} \quad \frac{4.5}{13} \quad \frac{6.1}{17} \quad \frac{6.4}{20} \quad \frac{5.7}{21} \quad \frac{5.5}{24}$$

$$\frac{3.5}{33} \quad \frac{3.9}{21} \quad \frac{6.0}{20} \quad \frac{6.0}{17} \quad \frac{4.2}{13} \quad \frac{4.2}{13} \quad \frac{5.9}{17} \quad \frac{6.1}{20} \quad \frac{5.2}{21} \quad \frac{5.5}{33}$$

$$\frac{3.3}{33} \quad \frac{3.7}{21} \quad \frac{5.7}{20} \quad \frac{5.7}{17} \quad \frac{3.9}{13} \quad \frac{3.9}{13} \quad \frac{5.7}{17} \quad \frac{5.7}{20} \quad \frac{4.7}{21} \quad \frac{5.0}{33}$$

$$\frac{2.5}{25} \quad \frac{3.1}{21} \quad \frac{5.3}{20} \quad \frac{5.3}{17} \quad \frac{3.4}{13} \quad \frac{3.5}{13} \quad \frac{5.2}{17} \quad \frac{5.4}{20} \quad \frac{3.9}{21} \quad \frac{4.0}{33}$$

$$\frac{2.4}{33} \quad \frac{3.0}{21} \quad \frac{5.0}{20} \quad \frac{5.0}{17} \quad \frac{1.2}{13} \quad \frac{3.3}{13} \quad \frac{5.1}{17} \quad \frac{5.3}{20} \quad \frac{4.0}{21} \quad \frac{4.1}{33}$$

946.43 ✓

8+50

9

+50

10

T.P.

4.96

949.56 ✓

1.83

944.60 ✓

+50

11

+50

12

+50

13

+50

$$\frac{2.9}{33} \quad \frac{2.9}{21} \quad \frac{4.9}{20} \quad \frac{4.9}{17} \quad \frac{3.0}{13} \quad 3.0 \quad \frac{3.1}{13} \quad \frac{5.2}{17} \quad \frac{5.2}{20} \quad \frac{3.7}{21} \quad \frac{3.7}{33}$$

$$\frac{2.4}{33} \quad \frac{2.9}{21} \quad \frac{4.6}{20} \quad \frac{4.6}{17} \quad \frac{2.8}{13} \quad 2.8 \quad \frac{2.9}{13} \quad \frac{5.2}{17} \quad \frac{5.2}{20} \quad \frac{3.5}{21} \quad \frac{3.6}{33}$$

$$\frac{2.8}{33} \quad \frac{3.0}{21} \quad \frac{4.5}{20} \quad \frac{4.5}{17} \quad \frac{2.5}{13} \quad 2.6 \quad \frac{2.7}{13} \quad \frac{4.9}{17} \quad \frac{4.9}{20} \quad \frac{3.3}{21} \quad \frac{3.3}{33}$$

$$\frac{2.5}{33} \quad \frac{2.9}{21} \quad \frac{4.3}{20} \quad \frac{4.3}{17} \quad \frac{2.5}{13} \quad 2.4 \quad \frac{2.5}{13} \quad \frac{4.5}{17} \quad \frac{4.6}{20} \quad \frac{3.0}{21} \quad \frac{3.0}{33}$$

$$\frac{5.5}{26} \quad \frac{6.1}{21} \quad \frac{7.5}{20} \quad \frac{7.5}{17} \quad \frac{5.5}{13} \quad 5.4 \quad \frac{5.5}{13} \quad \frac{7.5}{17} \quad \frac{7.5}{20} \quad \frac{5.8}{21} \quad \frac{5.9}{33}$$

$$\frac{5.4}{26} \quad \frac{5.9}{21} \quad \frac{7.4}{20} \quad \frac{7.3}{17} \quad \frac{5.3}{13} \quad 5.3 \quad \frac{5.3}{13} \quad \frac{7.2}{17} \quad \frac{7.3}{20} \quad \frac{6.3}{21} \quad \frac{6.5}{33}$$

$$\frac{5.1}{26} \quad \frac{5.8}{22} \quad \frac{7.3}{21} \quad \frac{7.3}{17} \quad \frac{5.2}{13} \quad 5.2 \quad \frac{5.2}{13} \quad \frac{7.2}{17} \quad \frac{7.2}{20} \quad \frac{6.3}{21} \quad \frac{6.6}{33}$$

$$\frac{5.5}{26} \quad \frac{6.3}{22} \quad \frac{7.2}{21} \quad \frac{7.0}{17} \quad \frac{5.0}{13} \quad 5.1 \quad \frac{5.1}{13} \quad \frac{7.3}{17} \quad \frac{7.3}{20} \quad \frac{6.8}{21} \quad \frac{7.2}{33}$$

$$\frac{5.2}{26} \quad \frac{6.0}{22} \quad \frac{7.0}{21} \quad \frac{7.0}{17} \quad \frac{5.0}{13} \quad 5.0 \quad \frac{5.1}{13} \quad \frac{7.0}{17} \quad \frac{6.8}{33}$$

$$\frac{5.6}{33} \quad \frac{6.1}{22} \quad \frac{7.1}{21} \quad \frac{7.1}{17} \quad \frac{4.9}{13} \quad 4.9 \quad \frac{5.0}{13} \quad \frac{7.1}{17} \quad \frac{7.1}{20} \quad \frac{6.7}{21} \quad \frac{6.3}{33}$$

$$\frac{5.4}{33} \quad \frac{5.9}{22} \quad \frac{6.9}{21} \quad \frac{6.7}{17} \quad \frac{4.7}{13} \quad 4.8 \quad \frac{4.8}{13} \quad \frac{7.2}{17} \quad \frac{7.2}{20} \quad \frac{6.1}{22} \quad \frac{5.8}{33}$$

✓  
949.56

14

+50

T.P.

6.08

✓  
950.56

5.08

✓  
944.48

15

+50

16

+50

17

+50

18

+50

19



$$\begin{array}{ccccc} \frac{5.0}{27} & \frac{5.9}{22} & \frac{6.8}{21} & \frac{6.8}{17} & \frac{4.6}{13} \\ \frac{4.7}{13} & \frac{6.8}{17} & \frac{7.0}{21} & \frac{6.0}{22} & \frac{5.4}{30} \end{array}$$

$$\begin{array}{ccccc} \frac{5.2}{27} & \frac{5.8}{22} & \frac{7.1}{21} & \frac{7.0}{17} & \frac{4.6}{13} \\ \frac{4.7}{13} & \frac{6.9}{17} & \frac{7.0}{21} & \frac{6.0}{22} & \frac{5.3}{30} \end{array}$$

$$\begin{array}{ccccc} \frac{6.6}{27} & \frac{6.8}{22} & \frac{7.8}{21} & \frac{7.8}{17} & \frac{5.6}{13} \\ \frac{5.5}{13} & \frac{7.7}{17} & \frac{7.8}{21} & \frac{7.3}{22} & \frac{6.5}{30} \end{array}$$

$$\begin{array}{ccccc} \frac{6.3}{28} & \frac{6.7}{22} & \frac{7.6}{21} & \frac{7.7}{17} & \frac{5.4}{13} \\ \frac{5.4}{13} & \frac{7.8}{17} & \frac{8.0}{21} & \frac{7.0}{22} & \frac{6.0}{30} \end{array}$$

$$\begin{array}{ccccc} \frac{5.9}{29} & \frac{6.3}{22} & \frac{7.4}{21} & \frac{7.4}{18} & \frac{5.3}{13} \\ \frac{5.4}{13} & \frac{7.6}{17} & \frac{7.6}{21} & \frac{6.6}{22} & \frac{5.8}{30} \end{array}$$

$$\begin{array}{ccccc} \frac{5.2}{29} & \frac{5.8}{23} & \frac{7.4}{21} & \frac{7.4}{17} & \frac{5.1}{13} \\ \frac{5.2}{13} & \frac{7.4}{17} & \frac{7.7}{20} & \frac{6.8}{22} & \frac{6.4}{30} \end{array}$$

$$\begin{array}{ccccc} \frac{5.5}{33} & \frac{5.5}{23} & \frac{7.1}{21} & \frac{7.1}{17} & \frac{5.1}{13} \\ \frac{5.1}{13} & \frac{7.4}{17} & \frac{7.4}{21} & \frac{6.3}{22} & \frac{6.1}{23} \end{array}$$

$$\begin{array}{ccccc} \frac{5.0}{33} & \frac{5.0}{24} & \frac{6.8}{21} & \frac{6.8}{17} & \frac{5.0}{13} \\ \frac{5.0}{13} & \frac{7.2}{17} & \frac{7.2}{20} & \frac{6.0}{22} & \frac{5.8}{30} \end{array}$$

$$\begin{array}{ccccc} \frac{4.9}{33} & \frac{4.8}{24} & \frac{7.0}{21} & \frac{6.8}{17} & \frac{4.9}{13} \\ \frac{4.9}{13} & \frac{7.1}{17} & \frac{7.1}{21} & \frac{6.0}{23} & \frac{5.6}{30} \end{array}$$

$$\begin{array}{ccccc} \frac{5.0}{33} & \frac{5.0}{24} & \frac{6.8}{21} & \frac{6.8}{17} & \frac{4.8}{13} \\ \frac{4.8}{13} & \frac{7.0}{17} & \frac{7.0}{21} & \frac{5.4}{23} & \frac{5.0}{33} \end{array}$$

$$\begin{array}{ccccc} \frac{5.1}{33} & \frac{4.9}{24} & \frac{6.7}{22} & \frac{6.7}{17} & \frac{4.6}{13} \\ \frac{4.6}{13} & \frac{6.8}{17} & \frac{6.8}{21} & \frac{4.8}{23} & \frac{4.4}{30} \end{array}$$

950.56 ✓

19+50

20

+50

21

+50

22

+50

B.M.

3.94

946.62

23

+50

T.P.

8.23

955.87 ✓

2.92

947.64 ✓

24

+19

X-Drain 24" X 42' P<sup>3</sup>

20' Lt. 22' Rt.

+50

$$\frac{5.0}{33} \quad \frac{4.8}{24} \quad \frac{6.5}{22} \quad \frac{6.4}{17} \quad \frac{4.5}{13} \quad 4.5 \quad \frac{4.5}{13} \quad \frac{6.4}{17} \quad \frac{6.4}{21} \quad \frac{4.0}{25} \quad \frac{3.6}{31}$$

$$\frac{4.7}{33} \quad \frac{4.7}{24} \quad \frac{6.4}{21} \quad \frac{6.3}{17} \quad \frac{4.3}{13} \quad 4.3 \quad \frac{4.4}{13} \quad \frac{6.2}{17} \quad \frac{6.2}{21} \quad \frac{3.8}{25} \quad \frac{3.4}{31}$$

$$\frac{4.4}{33} \quad \frac{4.3}{24} \quad \frac{6.3}{22} \quad \frac{6.3}{17} \quad \frac{4.1}{13} \quad 4.1 \quad \frac{4.1}{13} \quad \frac{6.3}{17} \quad \frac{6.3}{21} \quad \frac{3.9}{24} \quad \frac{3.4}{31}$$

$$\frac{3.6}{33} \quad \frac{3.7}{24} \quad \frac{5.9}{22} \quad \frac{5.9}{17} \quad \frac{4.0}{13} \quad 3.9 \quad \frac{4.0}{13} \quad \frac{6.2}{17} \quad \frac{6.2}{21} \quad \frac{4.5}{23} \quad \frac{3.7}{31}$$

$$\frac{2.9}{33} \quad \frac{2.9}{25} \quad \frac{5.6}{22} \quad \frac{5.6}{17} \quad \frac{3.7}{13} \quad 3.7 \quad \frac{3.8}{13} \quad \frac{6.2}{17} \quad \frac{6.2}{21} \quad \frac{4.5}{23} \quad \frac{4.0}{31}$$

$$\frac{2.3}{33} \quad \frac{2.3}{26} \quad \frac{5.4}{23} \quad \frac{5.3}{17} \quad \frac{3.4}{13} \quad 3.4 \quad \frac{3.4}{13} \quad \frac{5.5}{17} \quad \frac{5.5}{21} \quad \frac{4.4}{23} \quad \frac{4.3}{33}$$

$$\frac{2.3}{33} \quad \frac{2.5}{25} \quad \frac{5.2}{22} \quad \frac{5.2}{17} \quad \frac{3.2}{13} \quad 3.3 \quad \frac{3.4}{13} \quad \frac{5.5}{17} \quad \frac{5.5}{21} \quad \frac{3.6}{23} \quad \frac{4.0}{33}$$

$$\frac{2.6}{33} \quad \frac{2.8}{24} \quad \frac{5.2}{22} \quad \frac{5.1}{17} \quad \frac{3.2}{13} \quad 3.1 \quad \frac{3.3}{13} \quad \frac{5.3}{17} \quad \frac{5.4}{21} \quad \frac{3.8}{23} \quad \frac{3.8}{33}$$

10.75  
2.39  
13 08

$$\frac{3.4}{33} \quad \frac{4.0}{24} \quad \frac{5.2}{21} \quad \frac{4.9}{17} \quad \frac{3.0}{13} \quad 2.8 \quad \frac{3.0}{13} \quad \frac{5.2}{18} \quad \frac{5.1}{21} \quad \frac{4.2}{22} \quad \frac{3.8}{33}$$

$$\frac{11.4}{33} \quad \frac{11.5}{20} \quad \frac{7.8}{13} \quad 8.0 \quad \frac{8.0}{13} \quad \frac{11.5}{20} \quad \frac{11.6}{33}$$

$$\frac{12.6}{33} \quad \frac{12.6}{22} \quad \frac{7.7}{13} \quad 7.6 \quad \frac{7.6}{13} \quad \frac{13.4}{27} \quad \frac{13.5}{33}$$

955.87 ✓

25

+50

26

+50

27

+50

28

+50

T.P.

12.50

966.42 ✓

1.95

953.92 ✓

29

+50

30



$$\begin{array}{ccccccccc} 11.1 & 10.8 & 7.1 & 6.9 & 7.1 & 10.2 & 10.3 & 11.1 & 9.8 \\ 33 & 21 & 13 & 7.1 & 13 & 19 & 22 & 23 & 33 \end{array}$$

$$\begin{array}{ccccccccc} 8.5 & 8.5 & 6.4 & 6.3 & 6.3 & 8.6 & 8.7 & 7.6 & 7.2 \\ 33 & 17 & 13 & 6.4 & 13 & 17 & 21 & 22 & 33 \end{array}$$

$$\begin{array}{ccccccccc} 7.0 & 7.0 & 7.8 & 7.7 & 5.6 & 5.5 & 7.5 & 7.5 & 6.2 & 6.2 \\ 33 & 22 & 21 & 17 & 13 & 13 & 17 & 22 & 23 & 33 \end{array}$$

$$\begin{array}{ccccccccc} 5.5 & 5.4 & 7.0 & 7.0 & 4.8 & 4.8 & 6.6 & 6.8 & 5.8 & 5.6 \\ 33 & 23 & 21 & 17 & 13 & 13 & 17 & 22 & 23 & 33 \end{array}$$

$$\begin{array}{ccccccccc} 6.0 & 5.8 & 6.6 & 6.5 & 4.2 & 4.2 & 6.3 & 6.4 & 5.4 & 5.3 \\ 33 & 22 & 21 & 17 & 13 & 13 & 18 & 21 & 22 & 33 \end{array}$$

$$\begin{array}{ccccccccc} 5.4 & 5.3 & 5.6 & 5.4 & 3.3 & 3.3 & 5.5 & 5.6 & 5.1 & 5.1 \\ 33 & 21 & 19 & 17 & 13 & 13 & 17 & 21 & 22 & 33 \end{array}$$

$$\begin{array}{ccccccccc} 5.0 & 4.8 & 5.1 & 5.0 & 2.5 & 2.7 & 4.8 & 4.8 & 4.3 & 4.1 \\ 33 & 21 & 20 & 17 & 13 & 13 & 17 & 21 & 22 & 33 \end{array}$$

$$\begin{array}{ccccccccc} 4.0 & 3.9 & 4.2 & 4.1 & 1.9 & 2.0 & 4.0 & 4.0 & 1.3 & 1.7 \\ 33 & 21 & 20 & 17 & 13 & 13 & 17 & 21 & 25 & 33 \end{array}$$

$$\begin{array}{ccccccccc} 12.4 & 11.7 & 14.0 & 14.0 & 11.7 & 11.6 & 13.3 & 13.4 & 9.8 & 9.8 \\ 33 & 24 & 21 & 17 & 13 & 11.6 & 13 & 17 & 25 & 33 \end{array}$$

$$\begin{array}{ccccccccc} 11.4 & 11.0 & 13.2 & 13.2 & 10.8 & 10.8 & 10.9 & 13.1 & 13.2 & 9.8 & 9.8 \\ 33 & 24 & 21 & 17 & 13 & 10.8 & 13 & 17 & 22 & 25 & 33 \end{array}$$

$$\begin{array}{ccccccccc} 11.7 & 11.4 & 12.9 & 13.0 & 10.6 & 10.1 & 10.3 & 12.6 & 12.8 & 10.0 & 10.0 \\ 33 & 23 & 20 & 17 & 13 & 10.3 & 13 & 17 & 22 & 25 & 33 \end{array}$$

966.42 ✓

30 +50

31

+50

32

+50

T.P.

10.58

969.19 ✓

7.81

958.61 ✓

33

+50

34

B.M.

0.74

968.45 ✓

+50

T.P.

0.51

964.48 ✓

5.22

963.97 ✓

35

+50

$$\begin{array}{ccccccccc} 11.3 & 11.3 & 12.1 & 12.1 & 9.8 & 9.3 & 9.7 & 11.7 & 12.0 & 10.2 & 9.8 \\ 33 & 22 & 21 & 17 & 13 & 9.7 & 13 & 17 & 21 & 24 & 33 \end{array}$$

$$\begin{array}{ccccccccc} 10.0 & 10.1 & 11.3 & 11.2 & 8.9 & 8.6 & 8.9 & 11.0 & 11.0 & 9.5 & 9.2 \\ 33 & 22 & 21 & 17 & 13 & 8.8 & 13 & 17 & 21 & 23 & 33 \end{array}$$

$$\begin{array}{ccccccccc} 8.5 & 8.5 & 10.1 & 10.0 & 8.0 & 8.4 & 8.3 & 10.0 & 10.0 & 7.6 & 7.8 \\ 33 & 23 & 21 & 17 & 13 & 8.3 & 13 & 17 & 21 & 25 & 33 \end{array}$$

$$\begin{array}{ccccccccc} 8.5 & 8.1 & 9.7 & 9.7 & 7.7 & 1.0 & 7.7 & 9.2 & 9.4 & 4.7 & 5.3 \\ 33 & 23 & 21 & 17 & 13 & 7.7 & 13 & 17 & 22 & 28 & 33 \end{array}$$

$$\begin{array}{ccccccccc} 7.9 & 7.2 & 9.6 & 9.5 & 7.7 & 6.5 & 7.5 & 9.5 & 9.4 & 2.0 & 1.9 \\ 33 & 24 & 21 & 17 & 13 & 7.5 & 13 & 17 & 22 & 31 & 33 \end{array}$$

$$\begin{array}{ccccccccc} 9.8 & 8.9 & 12.3 & 12.3 & 10.6 & 9.2 & 10.6 & 12.3 & 12.2 & 2.7 & 2.0 \\ 33 & 25 & 21 & 17 & 13 & 10.6 & 13 & 17 & 22 & 33 & 40 \end{array}$$

$$\begin{array}{ccccccccc} 10.6 & 9.6 & 13.1 & 13.1 & 11.0 & 9.6 & 10.9 & 12.6 & 12.7 & 2.2 & 1.1 \\ 33 & 24 & 20 & 16 & 13 & 10.9 & 13 & 17 & 20 & 33 & 40 \end{array}$$

$$\begin{array}{ccccccccc} 11.8 & 11.3 & 14.1 & 13.8 & 11.4 & 10.4 & 11.6 & 13.6 & 13.7 & 2.2 & 0.4 \\ 33 & 24 & 21 & 17 & 13 & 11.6 & 13 & 17 & 20 & 33 & 40 \end{array}$$

$$\begin{array}{ccccccccc} 12.8 & 12.7 & 14.9 & 14.9 & 12.6 & 11.6 & 12.8 & 14.8 & 14.8 & 1.9 & 0.8 \\ 33 & 24 & 21 & 17 & 13 & 12.7 & 13 & 17 & 20 & 33 & 37 \end{array}$$

$$\begin{array}{ccccccccc} 8.8 & 8.8 & 11.4 & 11.3 & 9.2 & 8.6 & 9.3 & 11.2 & 11.2 & 1.0 & 0.0 \\ 33 & 25 & 22 & 17 & 13 & 9.3 & 13 & 17 & 21 & 33 & 40 \end{array}$$

$$\begin{array}{ccccccccc} 10.0 & 9.8 & 12.6 & 12.6 & 10.7 & 10.7 & 10.6 & 12.5 & 12.7 & 3.6 & 2.8 \\ 33 & 26 & 22 & 17 & 13 & 10.6 & 13 & 17 & 21 & 33 & 40 \end{array}$$

964.48 ✓

36

0.72

952.77 ✓

12.43

952.05 ✓

+50

37

+50

38

+185

X-Drain 24"X60' P3

285 Lt. 315 Rt.

+50

39

B.M.

8.06

955.57 ✓

5.26

947.51 ✓

+50

+78

40

+50



55.5  
52.8  
2.7

$$\frac{13.5}{33} \quad \frac{13.0}{25} \quad \frac{14.6}{23} \quad \frac{14.6}{17} \quad \frac{12.4}{13} \quad \frac{12.4}{23} \quad \frac{12.4}{13} \quad \frac{14.1}{17} \quad \frac{14.1}{22} \quad \frac{6.5}{33} \quad \frac{5.6}{40}$$

$$\frac{6.1}{33} \quad \frac{5.4}{23} \quad \frac{5.4}{18} \quad \frac{2.7}{13} \quad \frac{2.6}{25} \quad \frac{2.6}{13} \quad \frac{4.3}{17} \quad \frac{4.4}{23} \quad \frac{+2.7}{32} \quad \frac{+2.8}{33}$$

$$\frac{9.7}{33} \quad \frac{9.1}{22} \quad \frac{4.3}{13} \quad \frac{4.2}{13} \quad \frac{4.2}{13} \quad \frac{6.7}{18} \quad \frac{6.1}{24} \quad \frac{4.1}{27} \quad \frac{3.5}{33}$$

$$\frac{12.6}{33} \quad \frac{12.4}{26} \quad \frac{5.4}{13} \quad \frac{5.3}{5.2} \quad \frac{5.3}{13} \quad \frac{11.0}{24} \quad \frac{10.8}{33}$$

$$\frac{13.7}{33} \quad \frac{13.7}{29} \quad \frac{5.8}{13} \quad \frac{5.7}{5.8} \quad \frac{5.7}{13} \quad \frac{13.8}{30} \quad \frac{14.0}{33}$$

$$11.7 + 2.3 =$$

$$14.0$$

$$14.65 + 2.35 + 2.3 =$$

$$\frac{12.0}{33} \quad \frac{12.3}{25} \quad \frac{5.9}{13} \quad \frac{5.7}{5.8} \quad \frac{5.8}{13} \quad \frac{15.1}{32} \quad \frac{15.2}{40}$$

$$\frac{8.0}{33} \quad \frac{8.6}{21} \quad \frac{5.1}{13} \quad \frac{5.0}{5.3} \quad \frac{5.3}{13} \quad \frac{10.6}{23} \quad \frac{12.1}{33}$$

$$\frac{2.0}{33} \quad \frac{2.5}{23} \quad \frac{8.8}{21} \quad \frac{8.8}{17} \quad \frac{6.8}{13} \quad \frac{6.8}{6.8} \quad \frac{7.0}{13} \quad \frac{9.0}{17} \quad \frac{10.8}{33}$$

$$\frac{3.7}{33} \quad \frac{4.0}{27} \quad \frac{7.6}{21} \quad \frac{7.6}{17} \quad \frac{5.9}{13} \quad \frac{5.8}{5.8} \quad \frac{5.9}{13} \quad \frac{7.7}{17} \quad \frac{8.0}{22} \quad \frac{7.2}{23} \quad \frac{7.1}{33}$$

$$\frac{3.2}{33} \quad \frac{3.5}{27} \quad \frac{7.0}{21} \quad \frac{7.0}{17} \quad \frac{5.2}{13} \quad \frac{5.1}{5.2} \quad \frac{5.2}{13} \quad \frac{7.0}{17} \quad \frac{7.1}{21} \quad \frac{6.1}{22} \quad \frac{6.7}{33}$$

$$\frac{0.2}{33} \quad \frac{0.3}{29} \quad \frac{6.0}{21} \quad \frac{6.0}{17} \quad \frac{3.6}{13} \quad \frac{3.7}{3.5} \quad \frac{3.7}{13} \quad \frac{6.1}{17} \quad \frac{6.0}{21} \quad \frac{2.8}{26} \quad \frac{3.3}{33}$$

955.57 ✓

T.P.

10.20

962.19 ✓

3.58

951.99 ✓

41

+50

42

+50

43

+50

44

+50

45

+50

46

5-4-32

$$\frac{5.5}{33} \quad \frac{5.5}{29} \quad \frac{11.0}{21} \quad \frac{11.0}{17} \quad \frac{9.1}{13} \quad 9.2 \quad \frac{9.0}{88} \quad \frac{11.4}{13} \quad \frac{11.4}{17} \quad \frac{6.8}{21} \quad \frac{6.7}{27} \quad \frac{6.7}{33}$$

$$\frac{6.2}{33} \quad \frac{6.2}{27} \quad \frac{10.0}{21} \quad \frac{10.0}{17} \quad \frac{8.1}{13} \quad 8.1 \quad \frac{8.0}{78} \quad \frac{10.0}{13} \quad \frac{10.0}{17} \quad \frac{6.0}{21} \quad \frac{6.0}{27} \quad \frac{6.2}{33}$$

$$\frac{6.8}{33} \quad \frac{6.7}{24} \quad \frac{9.2}{21} \quad \frac{9.2}{17} \quad \frac{7.2}{13} \quad 7.2 \quad \frac{7.1}{70} \quad \frac{9.2}{13} \quad \frac{9.2}{17} \quad \frac{9.4}{21} \quad \frac{6.6}{25} \quad \frac{6.7}{33}$$

$$\frac{6.6}{33} \quad \frac{6.6}{24} \quad \frac{8.6}{21} \quad \frac{8.6}{17} \quad \frac{6.6}{13} \quad 6.6 \quad \frac{6.6}{66} \quad \frac{8.8}{13} \quad \frac{8.8}{17} \quad \frac{7.5}{21} \quad \frac{7.3}{24} \quad \frac{7.3}{33}$$

$$\frac{7.0}{33} \quad \frac{6.8}{24} \quad \frac{8.4}{21} \quad \frac{8.2}{17} \quad \frac{6.1}{13} \quad 6.2 \quad \frac{6.1}{60} \quad \frac{8.0}{13} \quad \frac{8.0}{17} \quad \frac{8.0}{21} \quad \frac{7.5}{22} \quad \frac{7.7}{33}$$

$$\frac{7.3}{33} \quad \frac{6.8}{22} \quad \frac{8.0}{21} \quad \frac{8.0}{17} \quad \frac{5.9}{13} \quad 5.8 \quad \frac{5.8}{59} \quad \frac{7.6}{13} \quad \frac{8.0}{17} \quad \frac{8.0}{33}$$

$$\frac{7.0}{33} \quad \frac{7.2}{22} \quad \frac{7.8}{21} \quad \frac{7.7}{17} \quad \frac{5.6}{13} \quad 5.5 \quad \frac{5.5}{56} \quad \frac{5.5}{13} \quad \frac{7.2}{17} \quad \frac{7.8}{33}$$

$$\frac{6.4}{33} \quad \frac{6.4}{22} \quad \frac{7.4}{21} \quad \frac{7.3}{17} \quad \frac{5.2}{13} \quad 5.1 \quad \frac{5.1}{52} \quad \frac{5.2}{13} \quad \frac{7.4}{18} \quad \frac{7.8}{33}$$

$$\frac{5.8}{33} \quad \frac{6.0}{22} \quad \frac{7.0}{21} \quad \frac{7.0}{17} \quad \frac{4.8}{13} \quad 4.1 \quad \frac{4.1}{47} \quad \frac{4.8}{13} \quad \frac{7.1}{17} \quad \frac{7.3}{33}$$

$$\frac{5.4}{33} \quad \frac{5.6}{22} \quad \frac{6.8}{21} \quad \frac{6.8}{17} \quad \frac{4.4}{13} \quad 4.4 \quad \frac{4.4}{44} \quad \frac{6.5}{13} \quad \frac{6.6}{17} \quad \frac{6.3}{20} \quad \frac{6.3}{21} \quad \frac{6.5}{33}$$

$$\frac{4.8}{33} \quad \frac{5.1}{22} \quad \frac{6.1}{21} \quad \frac{6.1}{17} \quad \frac{4.0}{13} \quad 4.0 \quad \frac{4.0}{42} \quad \frac{6.1}{13} \quad \frac{6.2}{17} \quad \frac{5.4}{22} \quad \frac{5.6}{22} \quad \frac{5.6}{33}$$

962.19 ✓

46+50

47

+50

48

+50

49

+50

T.P.

2.00

960.78 ✓

3.41

958.78 ✓

50

+50

51

+50



$$\frac{4.8}{33} \quad \frac{5.0}{22} \quad \frac{4.0}{21} \quad \frac{6.0}{17} \quad \frac{3.7}{13} \quad 3.7 \quad \frac{3.7}{13} \quad \frac{5.6}{17} \quad \frac{5.7}{21} \quad \frac{4.8}{22} \quad \frac{4.8}{33}$$

$$\frac{4.0}{33} \quad \frac{4.0}{23} \quad \frac{5.5}{21} \quad \frac{5.4}{17} \quad \frac{3.3}{13} \quad 3.4 \quad \frac{3.4}{13} \quad \frac{5.4}{17} \quad \frac{5.7}{21} \quad \frac{4.1}{24} \quad \frac{4.0}{33}$$

$$\frac{3.2}{33} \quad \frac{3.0}{24} \quad \frac{4.9}{21} \quad \frac{4.9}{17} \quad \frac{3.0}{13} \quad 3.0 \quad \frac{3.0}{13} \quad \frac{5.3}{17} \quad \frac{5.5}{21} \quad \frac{3.2}{24} \quad \frac{3.4}{33}$$

$$\frac{3.2}{33} \quad \frac{2.7}{25} \quad \frac{5.0}{21} \quad \frac{5.0}{17} \quad \frac{2.7}{13} \quad 2.7 \quad \frac{2.9}{13} \quad \frac{4.9}{17} \quad \frac{4.9}{21} \quad \frac{2.4}{24} \quad \frac{2.5}{33}$$

$$\frac{3.5}{33} \quad \frac{2.9}{24} \quad \frac{4.8}{21} \quad \frac{4.6}{17} \quad \frac{2.4}{13} \quad 2.4 \quad \frac{2.5}{13} \quad \frac{4.4}{17} \quad \frac{4.6}{21} \quad \frac{2.1}{25} \quad \frac{2.1}{33}$$

$$\frac{2.7}{33} \quad \frac{2.5}{24} \quad \frac{4.7}{21} \quad \frac{4.7}{17} \quad \frac{2.5}{13} \quad 2.5 \quad \frac{2.6}{13} \quad \frac{4.6}{17} \quad \frac{4.8}{21} \quad \frac{2.1}{25} \quad \frac{1.9}{33}$$

$$\frac{2.6}{33} \quad \frac{2.6}{24} \quad \frac{5.2}{21} \quad \frac{5.0}{17} \quad \frac{2.9}{13} \quad 2.8 \quad \frac{2.8}{13} \quad \frac{5.0}{17} \quad \frac{5.0}{21} \quad \frac{2.5}{25} \quad \frac{2.5}{33}$$

$$\frac{1.0}{33} \quad \frac{1.0}{26} \quad \frac{3.8}{21} \quad \frac{4.0}{17} \quad \frac{2.1}{13} \quad 2.0 \quad \frac{2.0}{13} \quad \frac{4.0}{17} \quad \frac{4.2}{21} \quad \frac{1.2}{25} \quad \frac{1.0}{33}$$

$$\frac{0.8}{33} \quad \frac{0.5}{27} \quad \frac{4.6}{21} \quad \frac{4.7}{17} \quad \frac{3.0}{13} \quad 2.9 \quad \frac{3.0}{13} \quad \frac{4.8}{17} \quad \frac{4.9}{22} \quad \frac{2.4}{25} \quad \frac{2.2}{33}$$

$$\frac{5.6}{33} \quad \frac{5.8}{21} \quad \frac{6.2}{21} \quad \frac{6.2}{17} \quad \frac{4.2}{13} \quad 4.1 \quad \frac{4.2}{13} \quad \frac{7.1}{19} \quad \frac{7.7}{33}$$

$$\frac{9.8}{33} \quad \frac{9.5}{21} \quad \frac{5.2}{13} \quad 5.2 \quad \frac{5.3}{13} \quad \frac{9.1}{20} \quad \frac{9.8}{33}$$

960.78 ✓

52

+44.5 X-Drain 24" X 42' P<sup>3</sup> 21' Lt. 21' Rt.

+61

+67

+80.5

B.M.

6.07

954.71 ✓

Special Ditch @ End of X-Drain

0+00

+25

+50

+75

1

+25

+50

End

$$\begin{array}{r} 9.4 \\ 33 \end{array} \quad \begin{array}{r} 9.0 \\ 20 \end{array} \quad \begin{array}{r} 5.9 \\ 13 \end{array} \quad \begin{array}{r} 5.8 \\ 13 \end{array} \quad \begin{array}{r} 9.4 \\ 20 \end{array} \quad \begin{array}{r} 10.0 \\ 33 \end{array}$$

$$8.0 + 2.3 = 10.3$$

$$7.6 + 2.3 = 9.9$$

$$\begin{array}{r} 8.7 \\ 40 \end{array} \quad \begin{array}{r} 8.7 \\ 32 \end{array} \quad \begin{array}{r} 6.7 \\ 26 \end{array} \quad \begin{array}{r} 6.0 \\ 10 \end{array} \quad \begin{array}{r} 5.8 \\ 25 \end{array} \quad \begin{array}{r} 8.5 \\ 32 \end{array} \quad \begin{array}{r} 8.2 \\ 40 \end{array}$$

$$\begin{array}{r} 7.1 \\ 50 \end{array} \quad \begin{array}{r} 6.8 \\ 32 \end{array} \quad \begin{array}{r} 6.1 \\ 8 \end{array} \quad \begin{array}{r} 6.1 \\ 4.1 \end{array} \quad \begin{array}{r} 5.6 \\ 33 \end{array} \quad \begin{array}{r} 5.5 \\ 50 \end{array}$$

$$\begin{array}{r} 6.5 \\ 50 \end{array} \quad \begin{array}{r} 6.1 \\ 25 \end{array} \quad \begin{array}{r} 5.6 \\ 25 \end{array} \quad \begin{array}{r} 5.3 \\ 25 \end{array} \quad \begin{array}{r} 5.0 \\ 50 \end{array}$$

$$\begin{array}{r} 9.0 \\ 0 \end{array} \quad \begin{array}{r} 10.5 \\ 3 \end{array} \quad \begin{array}{r} 10.5 \\ 6 \end{array} \quad \begin{array}{r} 9.0 \\ 9 \end{array}$$

$$\begin{array}{r} 9.0 \\ 0 \end{array} \quad \begin{array}{r} 10.5 \\ 3 \end{array} \quad \begin{array}{r} 10.5 \\ 6 \end{array} \quad \begin{array}{r} 9.0 \\ 9 \end{array}$$

$$\begin{array}{r} 9.8 \\ 0 \end{array} \quad \begin{array}{r} 11.0 \\ 3 \end{array} \quad \begin{array}{r} 11.0 \\ 6 \end{array} \quad \begin{array}{r} 9.8 \\ 9 \end{array}$$

$$\begin{array}{r} 10.4 \\ 0 \end{array} \quad \begin{array}{r} 11.4 \\ 2 \end{array} \quad \begin{array}{r} 11.4 \\ 5 \end{array} \quad \begin{array}{r} 10.7 \\ 7 \end{array}$$

$$\begin{array}{r} 11.2 \\ 0 \end{array} \quad \begin{array}{r} 12.0 \\ 2 \end{array} \quad \begin{array}{r} 12.0 \\ 5 \end{array} \quad \begin{array}{r} 11.4 \\ 7 \end{array}$$

$$\begin{array}{r} 12.0 \\ 0 \end{array} \quad \begin{array}{r} 12.3 \\ 1 \end{array} \quad \begin{array}{r} 12.3 \\ 3 \end{array} \quad \begin{array}{r} 12.0 \\ 5 \end{array}$$

23+85 Begin G.R. Rt. } 120' 2 Anchors ✓  
24+05 End " " " }  
25

23+85 Begin G.R. Lt. } 144' 2 Anchors ? ✓  
24+29 End " " " }  
22

36+50 Begin G.R. Lt. } 276' 2 Anchors ✓  
39+26 End " " " }


37+10 Begin G.R. Rt. } 216' 2 Anchors ✓  
39+26 End " " " }

50+96 Begin G.R. Rt. } 144' 2 Anchors - 8 Dummies ✓  
52+40 End " " " }

51+08 Begin G.R. Lt. } 132' 2 Anchors - 8 Dummies ✓  
52+40 End " " " }

Total - 1032' G. Rail - 12 Anchors - 16 Dummies



 

B.M. 5.94 952.56 946.62

23+85 47.8 4.76 ✓

24 47.9 4.66 ✓

+25 48.1 4.46 ✓

+50 48.3 4.26 ✓

+75 48.55 4.01

25 48.8 3.76 ✓

+05 48.9 3.66 ✓

+29 49.1 3.46 ✓

$$\begin{array}{r} 946.62 \\ 5.94 \\ \hline 952.56 \end{array}$$

B.M. 5.96 953.47 947.51

36+50 50.2 3.27✓

+75

37 48.5 4.87✓

+10

~~4.97~~

+50

48.1

5.27✓

+75

5.37

38 47.3 6.07✓

~~6.17~~

+25

6.57✓

+50

6.67✓

+75

39 46.8 47.5 5.97✓

+26

48.0

5.47✓

+50

+75

40



$$\begin{array}{r} 947.51 \\ 5.96 \\ \hline 953.47 \end{array}$$

B. M.

5.42

960.13

954.71

50+96

51+00

51+08

+50

52

+40

56.8

56.7

56.5

55.6

55.0

54.9

3.33 ✓

3.43 ✓


3.63

4.53 ✓

5.13 ✓

5.23 ✓

3.73 ✓

 

# KEITH'S RAILROAD CURVE TABLES.

Published by KEUFFEL & ESSER CO., New York.

Entered according to Act of Congress in the year 1883,  
by W. Keuffel & H. Esser, in the office of the Librarian of Congress,  
in Washington, D.C.

Copyright, 1902, by Keuffel & Esser Co.

## HOW TO USE KEITH'S TABLES.

### EXAMPLE.

Wanted a Curve with an Ext. of about 12 ft. Angle  
of Intersection or I. P.= $23^{\circ} 20'$  to the R. at Station  
542+72.

Ext. in Tab. IV opposite  $23^{\circ} 20' = 120.87$   
 $120.87 \div 12 = 10.07$ . Say a  $10^{\circ}$  Curve.

Tan. in Tab. IV opp.  $23^{\circ} 20' = 1183.1$   
 $1183.1 \div 10 = 118.31$ .

Tab. V. correction for A.  $23^{\circ} 20'$  for a  $10^{\circ}$  Cur.=0.16  
 $118.31 + 0.16 = 118.47 = \text{corrected Tangent}$ .

(If corrected Ext. is required find in same way)

Ang.  $23^{\circ} 20' = 23.33^{\circ} \div 10 = 2.3333 = \text{L. C.}$

|                                                   |       |            |           |
|---------------------------------------------------|-------|------------|-----------|
| $2^{\circ} 19\frac{1}{2}' = \text{def. for sta.}$ | 542   | I. P.=sta. | 542+72    |
| $4^{\circ} 49\frac{1}{2}' = \text{" " "}$         | +50   | Tan.=      | 1.18.47   |
| $7^{\circ} 19\frac{1}{2}' = \text{" " "}$         | 543   | B. C.=sta. | 541+53.53 |
| $9^{\circ} 49\frac{1}{2}' = \text{" " "}$         | +50   | L. C.=     | 2.33.33   |
| $11^{\circ} 40' = \text{" " "}$                   | 543+  | E. C.=sta. | 543+86.86 |
|                                                   | 86.86 |            |           |

$100 - 53.53 = 46.47 \times 3' (\text{def. for 1 ft. of } 10^{\circ} \text{ Cur.}) = 139.41' =$   
 $2^{\circ} 19\frac{1}{2}' = \text{def. for sta. 542.}$

Def. for 50 ft.= $2^{\circ} 30'$  for a  $10^{\circ}$  Curve.

Def. for 36.86 ft.= $1^{\circ} 50\frac{1}{2}'$  for a  $10^{\circ}$  Curve

(These tables are published in Field Books of  
KEUFFEL & ESSER Co., New York, N. Y.)

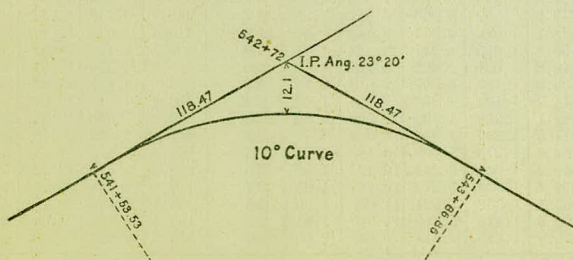




TABLE I. — Minutes in Decimals of a Degree.

|    |       |    |       |    |       |    |       |    |       |    |        |
|----|-------|----|-------|----|-------|----|-------|----|-------|----|--------|
| 1  | .0167 | 11 | .1833 | 21 | .3500 | 31 | .5167 | 41 | .6833 | 51 | .8500  |
| 2  | .0333 | 12 | .2000 | 22 | .3667 | 32 | .5333 | 42 | .7000 | 52 | .8667  |
| 3  | .0500 | 13 | .2167 | 23 | .3833 | 33 | .5500 | 43 | .7167 | 53 | .8833  |
| 4  | .0667 | 14 | .2333 | 24 | .4000 | 34 | .5667 | 44 | .7333 | 54 | .9000  |
| 5  | .0833 | 15 | .2500 | 25 | .4167 | 35 | .5833 | 45 | .7500 | 55 | .9167  |
| 6  | .1000 | 16 | .2667 | 26 | .4333 | 36 | .6000 | 46 | .7667 | 56 | .9333  |
| 7  | .1167 | 17 | .2833 | 27 | .4500 | 37 | .6167 | 47 | .7833 | 57 | .9500  |
| 8  | .1333 | 18 | .3000 | 28 | .4667 | 38 | .6333 | 48 | .8000 | 58 | .9667  |
| 9  | .1500 | 19 | .3167 | 29 | .4833 | 39 | .6500 | 49 | .8167 | 59 | .9833  |
| 10 | .1667 | 20 | .3333 | 30 | .5000 | 40 | .6667 | 50 | .8333 | 60 | 1.0000 |

TABLE II. — Inches in Decimals of a Foot.

|       |       |               |       |               |       |               |               |               |               |               |
|-------|-------|---------------|-------|---------------|-------|---------------|---------------|---------------|---------------|---------------|
| 1-16  | 3-32  | $\frac{1}{8}$ | 3-16  | $\frac{1}{4}$ | 5-16  | $\frac{3}{8}$ | $\frac{1}{2}$ | $\frac{5}{8}$ | $\frac{3}{4}$ | $\frac{7}{8}$ |
| .0052 | .0078 | .0104         | .0156 | .0208         | .0260 | .0313         | .0417         | .0521         | .0625         | .0729         |
| 1     | 2     | 3             | 4     | 5             | 6     | 7             | 8             | 9             | 10            | 11            |
| .0833 | .1667 | .2500         | .3333 | .4167         | .5000 | .5833         | .6667         | .7500         | .8333         | .9167         |

TABLE III. — Radii, Ordinates and Deflections.

| Deg.   | Radius | Mid. Ord. | Tan. Def. | Chd. Def. | Def. for 1 Foot | Deg. | Radius | Mid. Ord. | Tan. Def. | Chd. Def. | Def. for 1 Foot |
|--------|--------|-----------|-----------|-----------|-----------------|------|--------|-----------|-----------|-----------|-----------------|
| 0° 10' | 34377. | .036      | .145      | .291      | 0.05'           | 7°   | 819.0  | 1.528     | 6.105     | 12.21     | 2.10'           |
| 20     | 17189. | .073      | .291      | .582      | 0.10            | 20'  | 781.8  | 1.600     | 6.395     | 12.79     | 2.20            |
| 30     | 11459. | .109      | .436      | .873      | 0.15            | 30   | 764.5  | 1.637     | 6.540     | 13.08     | 2.25            |
| 40     | 8594.4 | .145      | .582      | 1.164     | 0.20            | 40   | 747.9  | 1.673     | 6.685     | 13.37     | 2.30            |
| 50     | 6875.5 | .182      | .727      | 1.454     | 0.25            | 8    | 716.8  | 1.746     | 6.976     | 13.95     | 2.40            |
| 1      | 5729.6 | .218      | .873      | 1.745     | 0.30            | 20   | 688.2  | 1.819     | 7.266     | 14.53     | 2.50            |
| 10     | 4911.2 | .255      | 1.018     | 2.036     | 0.35            | 30   | 674.7  | 1.855     | 7.411     | 14.82     | 2.55            |
| 20     | 4297.3 | .291      | 1.164     | 2.327     | 0.40            | 40   | 661.7  | 1.892     | 7.556     | 15.11     | 2.60            |
| 30     | 3819.8 | .327      | 1.309     | 2.618     | 0.45            | 9    | 637.3  | 1.965     | 7.846     | 15.69     | 2.70            |
| 40     | 3437.9 | .364      | 1.454     | 2.909     | 0.50            | 20   | 614.6  | 2.037     | 8.136     | 16.27     | 2.80            |
| 50     | 3125.4 | .400      | 1.600     | 3.200     | 0.55            | 30   | 603.8  | 2.074     | 8.281     | 16.56     | 2.85            |
| 2      | 2864.9 | .436      | 1.745     | 3.490     | 0.60            | 40   | 593.4  | 2.110     | 8.426     | 16.85     | 2.90            |
| 10     | 2644.6 | .473      | 1.891     | 3.781     | 0.65            | 10   | 573.7  | 2.183     | 8.716     | 17.43     | 3.00            |
| 20     | 2455.7 | .509      | 2.036     | 4.072     | 0.70            | 30   | 546.4  | 2.292     | 9.150     | 18.30     | 3.15            |
| 30     | 2292.0 | .545      | 2.181     | 4.363     | 0.75            | 11   | 521.7  | 2.402     | 9.585     | 19.16     | 3.30            |
| 40     | 2148.8 | .582      | 2.327     | 4.654     | 0.80            | 30   | 499.1  | 2.511     | 10.02     | 20.04     | 3.45            |
| 50     | 2022.4 | .618      | 2.472     | 4.945     | 0.85            | 12   | 478.3  | 2.620     | 10.45     | 20.91     | 3.60            |
| 3      | 1910.1 | .655      | 2.618     | 5.235     | 0.90            | 30   | 459.3  | 2.730     | 10.89     | 21.77     | 3.75            |
| 10     | 1809.6 | .691      | 2.763     | 5.526     | 0.95            | 13   | 441.7  | 2.839     | 11.32     | 22.64     | 3.90            |
| 20     | 1719.1 | .727      | 2.908     | 5.817     | 1.00            | 30   | 425.4  | 2.949     | 11.75     | 23.51     | 4.05            |
| 30     | 1637.3 | .764      | 3.054     | 6.108     | 1.05            | 14   | 410.3  | 3.058     | 12.18     | 24.37     | 4.20            |
| 40     | 1562.9 | .800      | 3.199     | 6.398     | 1.10            | 30   | 396.2  | 3.168     | 12.62     | 25.24     | 4.35            |
| 50     | 1495.0 | .836      | 3.345     | 6.689     | 1.15            | 15   | 383.1  | 3.277     | 13.05     | 26.11     | 4.50            |
| 4      | 1432.7 | .873      | 3.490     | 6.980     | 1.20            | 30   | 370.8  | 3.387     | 13.49     | 26.97     | 4.65            |
| 10     | 1375.4 | .909      | 3.635     | 7.271     | 1.25            | 16   | 359.3  | 3.496     | 13.92     | 27.84     | 4.80            |
| 20     | 1322.5 | .945      | 3.781     | 7.561     | 1.30            | 30   | 348.5  | 3.606     | 14.35     | 28.70     | 4.95            |
| 30     | 1273.6 | .982      | 3.926     | 7.852     | 1.35            | 17   | 338.3  | 3.716     | 14.78     | 29.56     | 5.10            |
| 40     | 1228.1 | 1.018     | 4.071     | 8.143     | 1.40            | 18   | 319.6  | 3.935     | 15.64     | 31.29     | 5.40            |
| 50     | 1185.8 | 1.055     | 4.217     | 8.433     | 1.45            | 19   | 302.9  | 4.155     | 16.51     | 33.01     | 5.70            |
| 5      | 1146.3 | 1.091     | 4.362     | 8.724     | 1.50            | 20   | 287.9  | 4.374     | 17.37     | 34.73     | 6.00            |
| 10     | 1109.3 | 1.127     | 4.507     | 9.014     | 1.55            | 21   | 274.4  | 4.594     | 18.22     | 36.44     | 6.30            |
| 20     | 1074.7 | 1.164     | 4.653     | 9.305     | 1.60            | 22   | 262.0  | 4.814     | 19.08     | 38.16     | 6.60            |
| 30     | 1042.1 | 1.200     | 4.798     | 9.596     | 1.65            | 23   | 250.8  | 5.035     | 19.94     | 39.87     | 6.90            |
| 40     | 1011.5 | 1.237     | 4.943     | 9.886     | 1.70            | 24   | 240.5  | 5.255     | 20.79     | 41.58     | 7.20            |
| 50     | 982.6  | 1.273     | 5.088     | 10.18     | 1.75            | 25   | 231.0  | 5.476     | 21.64     | 43.28     | 7.50            |
| 6      | 955.4  | 1.309     | 5.234     | 10.47     | 1.80            | 26   | 222.3  | 5.697     | 22.50     | 44.99     | 7.80            |
| 10     | 929.6  | 1.346     | 5.379     | 10.76     | 1.85            | 27   | 214.2  | 5.918     | 23.35     | 46.69     | 8.10            |
| 20     | 905.1  | 1.382     | 5.524     | 11.05     | 1.90            | 28   | 206.7  | 6.139     | 24.19     | 48.38     | 8.40            |
| 30     | 881.9  | 1.418     | 5.669     | 11.34     | 1.95            | 29   | 199.7  | 6.360     | 25.04     | 50.07     | 8.70            |
| 40     | 859.9  | 1.455     | 5.814     | 11.63     | 2.00            | 30   | 193.2  | 6.583     | 25.88     | 51.76     | 9.00            |

TABLE IV. — Tangents and Externals to a 1° Curve.

| Angle     | Tangent | External | Angle      | Tangent | External | Angle      | Tangent | External |
|-----------|---------|----------|------------|---------|----------|------------|---------|----------|
| <b>1°</b> | 50.00   | .22      | <b>11°</b> | 551.70  | 26.50    | <b>21°</b> | 1061.9  | 97.57    |
| 10'       | 58.34   | .30      | 10'        | 560.11  | 27.31    | 10'        | 1070.6  | 99.16    |
| 20        | 66.67   | .39      | 20         | 568.53  | 28.14    | 20         | 1079.2  | 100.75   |
| 30        | 75.01   | .49      | 30         | 576.95  | 28.97    | 30         | 1087.8  | 102.35   |
| 40        | 83.34   | .61      | 40         | 585.36  | 29.82    | 40         | 1096.4  | 103.97   |
| 50        | 91.68   | .73      | 50         | 593.79  | 30.68    | 50         | 1105.1  | 105.60   |
| <b>2</b>  | 100.01  | .87      | <b>12</b>  | 602.21  | 31.56    | <b>22</b>  | 1113.7  | 107.24   |
| 10        | 108.35  | 1.02     | 10         | 610.64  | 32.45    | 10         | 1122.4  | 108.90   |
| 20        | 116.68  | 1.19     | 20         | 619.07  | 33.35    | 20         | 1131.0  | 110.57   |
| 30        | 125.02  | 1.36     | 30         | 627.50  | 34.26    | 30         | 1139.7  | 112.25   |
| 40        | 133.36  | 1.55     | 40         | 635.93  | 35.18    | 40         | 1148.4  | 113.95   |
| 50        | 141.70  | 1.75     | 50         | 644.37  | 36.12    | 50         | 1157.0  | 115.66   |
| <b>3</b>  | 150.04  | 1.96     | <b>13</b>  | 652.81  | 37.07    | <b>23</b>  | 1165.7  | 117.38   |
| 10        | 158.38  | 2.19     | 10         | 661.25  | 38.03    | 10         | 1174.4  | 119.12   |
| 20        | 166.72  | 2.43     | 20         | 669.70  | 39.01    | 20         | 1183.1  | 120.87   |
| 30        | 175.06  | 2.67     | 30         | 678.15  | 39.99    | 30         | 1191.8  | 122.63   |
| 40        | 183.40  | 2.93     | 40         | 686.60  | 40.99    | 40         | 1200.5  | 124.41   |
| 50        | 191.74  | 3.21     | 50         | 695.06  | 42.00    | 50         | 1209.2  | 126.20   |
| <b>4</b>  | 200.08  | 3.49     | <b>14</b>  | 703.51  | 43.03    | <b>24</b>  | 1217.9  | 128.00   |
| 10        | 208.43  | 3.79     | 10         | 711.97  | 44.07    | 10         | 1226.6  | 129.82   |
| 20        | 216.77  | 4.10     | 20         | 720.44  | 45.12    | 20         | 1235.3  | 131.65   |
| 30        | 225.12  | 4.42     | 30         | 728.90  | 46.18    | 30         | 1244.0  | 133.50   |
| 40        | 233.47  | 4.76     | 40         | 737.37  | 47.25    | 40         | 1252.8  | 135.35   |
| 50        | 241.81  | 5.10     | 50         | 745.85  | 48.34    | 50         | 1261.5  | 137.23   |
| <b>5</b>  | 250.16  | 5.46     | <b>15</b>  | 754.32  | 49.44    | <b>25</b>  | 1270.2  | 139.11   |
| 10        | 258.51  | 5.83     | 10         | 762.80  | 50.55    | 10         | 1279.0  | 141.01   |
| 20        | 266.86  | 6.21     | 20         | 771.29  | 51.68    | 20         | 1287.7  | 142.93   |
| 30        | 275.21  | 6.61     | 30         | 779.77  | 52.89    | 30         | 1296.5  | 144.85   |
| 40        | 283.57  | 7.01     | 40         | 788.26  | 53.97    | 40         | 1305.3  | 146.79   |
| 50        | 291.92  | 7.43     | 50         | 796.75  | 55.13    | 50         | 1314.0  | 148.75   |
| <b>6</b>  | 300.28  | 7.86     | <b>16</b>  | 805.25  | 56.31    | <b>26</b>  | 1322.8  | 150.71   |
| 10        | 308.64  | 8.31     | 10         | 813.75  | 57.50    | 10         | 1331.6  | 152.69   |
| 20        | 316.99  | 8.76     | 20         | 822.25  | 58.70    | 20         | 1340.4  | 154.69   |
| 30        | 325.35  | 9.23     | 30         | 830.76  | 59.91    | 30         | 1349.2  | 156.70   |
| 40        | 333.71  | 9.71     | 40         | 839.27  | 61.14    | 40         | 1358.0  | 158.72   |
| 50        | 342.08  | 10.20    | 50         | 847.78  | 62.38    | 50         | 1366.8  | 160.76   |
| <b>7</b>  | 350.44  | 10.71    | <b>17</b>  | 856.30  | 63.63    | <b>27</b>  | 1375.6  | 162.81   |
| 10        | 358.81  | 11.22    | 10         | 864.82  | 64.90    | 10         | 1384.4  | 164.86   |
| 20        | 367.17  | 11.75    | 20         | 873.35  | 66.18    | 20         | 1393.2  | 166.95   |
| 30        | 375.54  | 12.29    | 30         | 881.88  | 67.47    | 30         | 1402.0  | 169.04   |
| 40        | 383.91  | 12.85    | 40         | 890.41  | 68.77    | 40         | 1410.9  | 171.15   |
| 50        | 392.28  | 13.41    | 50         | 898.95  | 70.09    | 50         | 1419.7  | 173.27   |
| <b>8</b>  | 400.66  | 13.99    | <b>18</b>  | 907.49  | 71.42    | <b>28</b>  | 1428.6  | 175.41   |
| 10        | 409.03  | 14.58    | 10         | 916.03  | 72.76    | 10         | 1437.4  | 177.55   |
| 20        | 417.41  | 15.18    | 20         | 924.58  | 74.12    | 20         | 1446.3  | 179.72   |
| 30        | 425.79  | 15.80    | 30         | 933.13  | 75.49    | 30         | 1455.1  | 181.89   |
| 40        | 434.17  | 16.43    | 40         | 941.69  | 76.86    | 40         | 1464.0  | 184.08   |
| 50        | 442.55  | 17.07    | 50         | 950.25  | 78.26    | 50         | 1472.9  | 186.29   |
| <b>9</b>  | 450.93  | 17.72    | <b>19</b>  | 958.81  | 79.67    | <b>29</b>  | 1481.8  | 188.51   |
| 10        | 459.32  | 18.38    | 10         | 967.38  | 81.09    | 10         | 1490.7  | 190.74   |
| 20        | 467.71  | 19.06    | 20         | 975.96  | 82.53    | 20         | 1499.6  | 192.99   |
| 30        | 476.10  | 19.75    | 30         | 984.53  | 83.97    | 30         | 1508.5  | 195.25   |
| 40        | 484.49  | 20.45    | 40         | 993.12  | 85.43    | 40         | 1517.4  | 197.53   |
| 50        | 492.88  | 21.16    | 50         | 1001.7  | 86.90    | 50         | 1526.3  | 199.82   |
| <b>10</b> | 501.28  | 21.89    | <b>20</b>  | 1010.3  | 88.39    | <b>30</b>  | 1535.3  | 202.12   |
| 10        | 509.68  | 22.62    | 10         | 1018.9  | 89.89    | 10         | 1544.2  | 204.44   |
| 20        | 518.08  | 23.38    | 20         | 1027.5  | 91.40    | 20         | 1553.1  | 206.77   |
| 30        | 526.48  | 24.14    | 30         | 1036.1  | 92.92    | 30         | 1562.1  | 209.12   |
| 40        | 534.89  | 24.91    | 40         | 1044.7  | 94.46    | 40         | 1571.0  | 211.48   |
| 50        | 543.29  | 25.70    | 50         | 1053.3  | 96.01    | 50         | 1580.0  | 213.86   |



TABLE IV. — Tangents and Externals to a 1° Curve.

| Angle      | Tangent | External | Angle      | Tangent | External | Angle      | Tangent | External |
|------------|---------|----------|------------|---------|----------|------------|---------|----------|
| <b>31°</b> | 1589.0  | 216.3    | <b>41°</b> | 2142.2  | 387.4    | <b>51°</b> | 2732.9  | 618.4    |
| 10'        | 1598.0  | 218.7    | 10'        | 2151.7  | 390.7    | 10'        | 2743.1  | 622.8    |
| 20         | 1606.9  | 221.1    | 20         | 2161.2  | 394.1    | 20         | 2753.4  | 627.2    |
| 30         | 1615.9  | 223.5    | 30         | 2170.8  | 397.4    | 30         | 2763.7  | 631.7    |
| 40         | 1624.9  | 226.0    | 40         | 2180.3  | 400.8    | 40         | 2773.9  | 636.2    |
| 50         | 1633.9  | 228.4    | 50         | 2189.9  | 404.2    | 50         | 2784.2  | 640.7    |
| <b>32</b>  | 1643.0  | 230.9    | <b>42</b>  | 2199.4  | 407.6    | <b>52</b>  | 2794.5  | 645.2    |
| 10         | 1652.0  | 233.4    | 10         | 2209.0  | 411.1    | 10         | 2804.9  | 649.7    |
| 20         | 1661.0  | 235.9    | 20         | 2218.6  | 414.5    | 20         | 2815.2  | 654.3    |
| 30         | 1670.0  | 238.4    | 30         | 2228.1  | 418.0    | 30         | 2825.6  | 658.8    |
| 40         | 1679.1  | 241.0    | 40         | 2237.7  | 421.4    | 40         | 2835.9  | 663.4    |
| 50         | 1688.1  | 243.5    | 50         | 2247.3  | 425.0    | 50         | 2846.3  | 668.0    |
| <b>33</b>  | 1697.2  | 246.1    | <b>43</b>  | 2257.0  | 428.5    | <b>53</b>  | 2856.7  | 672.7    |
| 10         | 1706.3  | 248.7    | 10         | 2266.6  | 432.0    | 10         | 2867.1  | 677.3    |
| 20         | 1715.3  | 251.3    | 20         | 2276.2  | 435.6    | 20         | 2877.5  | 682.0    |
| 30         | 1724.4  | 253.9    | 30         | 2285.9  | 439.2    | 30         | 2888.0  | 686.7    |
| 40         | 1733.5  | 256.5    | 40         | 2295.6  | 442.8    | 40         | 2898.4  | 691.4    |
| 50         | 1742.6  | 259.1    | 50         | 2305.2  | 446.4    | 50         | 2908.9  | 696.1    |
| <b>34</b>  | 1751.7  | 261.8    | <b>44</b>  | 2314.9  | 450.0    | <b>54</b>  | 2919.4  | 700.9    |
| 10         | 1760.8  | 264.5    | 10         | 2324.6  | 453.6    | 10         | 2929.9  | 705.7    |
| 20         | 1770.0  | 267.2    | 20         | 2334.3  | 457.3    | 20         | 2940.4  | 710.5    |
| 30         | 1779.1  | 269.9    | 30         | 2344.1  | 461.0    | 30         | 2951.0  | 715.3    |
| 40         | 1788.2  | 272.6    | 40         | 2353.8  | 464.6    | 40         | 2961.5  | 720.1    |
| 50         | 1797.4  | 275.3    | 50         | 2363.5  | 468.4    | 50         | 2972.1  | 725.0    |
| <b>35</b>  | 1806.6  | 278.1    | <b>45</b>  | 2373.3  | 472.1    | <b>55</b>  | 2982.7  | 729.9    |
| 10         | 1815.7  | 280.8    | 10         | 2383.1  | 475.8    | 10         | 2993.3  | 734.8    |
| 20         | 1824.9  | 283.6    | 20         | 2392.8  | 479.6    | 20         | 3003.9  | 739.7    |
| 30         | 1834.1  | 286.4    | 30         | 2402.6  | 483.4    | 30         | 3014.5  | 744.6    |
| 40         | 1843.3  | 289.2    | 40         | 2412.4  | 487.2    | 40         | 3025.2  | 749.6    |
| 50         | 1852.5  | 292.0    | 50         | 2422.3  | 491.0    | 50         | 3035.8  | 754.6    |
| <b>36</b>  | 1861.7  | 294.9    | <b>46</b>  | 2432.1  | 494.8    | <b>56</b>  | 3046.5  | 759.6    |
| 10         | 1870.9  | 297.7    | 10         | 2441.9  | 498.7    | 10         | 3057.2  | 764.6    |
| 20         | 1880.1  | 300.6    | 20         | 2451.8  | 502.5    | 20         | 3067.9  | 769.7    |
| 30         | 1889.4  | 303.5    | 30         | 2461.7  | 506.4    | 30         | 3078.7  | 774.7    |
| 40         | 1898.6  | 306.4    | 40         | 2471.5  | 510.3    | 40         | 3089.4  | 779.8    |
| 50         | 1907.9  | 309.3    | 50         | 2481.4  | 514.3    | 50         | 3100.2  | 784.9    |
| <b>37</b>  | 1917.1  | 312.2    | <b>47</b>  | 2491.3  | 518.2    | <b>57</b>  | 3110.9  | 790.1    |
| 10         | 1926.4  | 315.2    | 10         | 2501.2  | 522.2    | 10         | 3121.7  | 795.2    |
| 20         | 1935.7  | 318.1    | 20         | 2511.2  | 526.1    | 20         | 3132.6  | 800.4    |
| 30         | 1945.0  | 321.1    | 30         | 2521.1  | 530.1    | 30         | 3143.4  | 805.6    |
| 40         | 1954.3  | 324.1    | 40         | 2531.1  | 534.2    | 40         | 3154.2  | 810.9    |
| 50         | 1963.6  | 327.1    | 50         | 2541.0  | 538.2    | 50         | 3165.1  | 816.1    |
| <b>38</b>  | 1972.9  | 330.2    | <b>48</b>  | 2551.0  | 542.2    | <b>58</b>  | 3176.0  | 821.4    |
| 10         | 1982.2  | 333.2    | 10         | 2561.0  | 546.3    | 10         | 3186.9  | 826.7    |
| 20         | 1991.5  | 336.3    | 20         | 2571.0  | 550.4    | 20         | 3197.8  | 832.0    |
| 30         | 2000.9  | 339.3    | 30         | 2581.0  | 554.5    | 30         | 3208.8  | 837.3    |
| 40         | 2010.2  | 342.4    | 40         | 2591.0  | 558.6    | 40         | 3219.7  | 842.7    |
| 50         | 2019.6  | 345.5    | 50         | 2601.1  | 562.8    | 50         | 3230.7  | 848.1    |
| <b>39</b>  | 2029.0  | 348.6    | <b>49</b>  | 2611.2  | 566.9    | <b>59</b>  | 3241.7  | 853.5    |
| 10         | 2038.4  | 351.8    | 10         | 2621.2  | 571.1    | 10         | 3252.7  | 858.9    |
| 20         | 2047.8  | 354.9    | 20         | 2631.3  | 575.3    | 20         | 3263.7  | 864.3    |
| 30         | 2057.2  | 358.1    | 30         | 2641.4  | 579.5    | 30         | 3274.8  | 869.8    |
| 40         | 2066.6  | 361.3    | 40         | 2651.5  | 583.8    | 40         | 3285.8  | 875.3    |
| 50         | 2076.0  | 364.5    | 50         | 2661.6  | 588.0    | 50         | 3296.9  | 880.8    |
| <b>40</b>  | 2085.4  | 367.7    | <b>50</b>  | 2671.8  | 592.3    | <b>60</b>  | 3308.0  | 886.4    |
| 10         | 2094.9  | 371.0    | 10         | 2681.9  | 596.6    | 10         | 3319.1  | 892.0    |
| 20         | 2104.3  | 374.2    | 20         | 2692.1  | 600.9    | 20         | 3330.3  | 897.5    |
| 30         | 2113.8  | 377.5    | 30         | 2702.3  | 605.3    | 30         | 3341.4  | 903.2    |
| 40         | 2123.3  | 380.8    | 40         | 2712.5  | 609.6    | 40         | 3352.6  | 908.8    |
| 50         | 2132.7  | 384.1    | 50         | 2722.7  | 614.0    | 50         | 3363.8  | 914.5    |

TABLE IV. — Tangents and Externals to a 1° Curve.

| Angle      | Tangent | External | Angle      | Tangent | External | Angle      | Tangent | External |
|------------|---------|----------|------------|---------|----------|------------|---------|----------|
| <b>61°</b> | 3375.0  | 920.2    | <b>71°</b> | 4086.9  | 1308.2   | <b>81°</b> | 4893.6  | 1805.3   |
| 10'        | 3386.3  | 925.9    | 10'        | 4099.5  | 1315.6   | 10'        | 4908.0  | 1814.7   |
| 20         | 3397.5  | 931.6    | 20         | 4112.1  | 1322.9   | 20         | 4922.5  | 1824.1   |
| 30         | 3408.8  | 937.3    | 30         | 4124.8  | 1330.3   | 30         | 4937.0  | 1833.6   |
| 40         | 3420.1  | 943.1    | 40         | 4137.4  | 1337.7   | 40         | 4951.5  | 1843.1   |
| 50         | 3431.4  | 948.9    | 50         | 4150.1  | 1345.1   | 50         | 4966.1  | 1852.6   |
| <b>62</b>  | 3442.7  | 954.8    | <b>72</b>  | 4162.8  | 1352.6   | <b>82</b>  | 4980.7  | 1862.2   |
| 10         | 3454.1  | 960.6    | 10         | 4175.6  | 1360.1   | 10         | 4995.4  | 1871.8   |
| 20         | 3465.4  | 966.5    | 20         | 4188.5  | 1367.6   | 20         | 5010.0  | 1881.5   |
| 30         | 3476.8  | 972.4    | 30         | 4201.2  | 1375.2   | 30         | 5024.8  | 1891.2   |
| 40         | 3488.3  | 978.3    | 40         | 4214.0  | 1382.8   | 40         | 5039.5  | 1900.9   |
| 50         | 3499.7  | 984.3    | 50         | 4226.8  | 1390.4   | 50         | 5054.3  | 1910.7   |
| <b>63</b>  | 3511.1  | 990.2    | <b>73</b>  | 4239.7  | 1398.0   | <b>83</b>  | 5069.2  | 1920.5   |
| 10         | 3522.6  | 996.2    | 10         | 4252.6  | 1405.7   | 10         | 5084.0  | 1930.4   |
| 20         | 3534.1  | 1002.3   | 20         | 4265.6  | 1413.5   | 20         | 5099.0  | 1940.3   |
| 30         | 3545.6  | 1008.3   | 30         | 4278.5  | 1421.2   | 30         | 5113.9  | 1950.3   |
| 40         | 3557.2  | 1014.4   | 40         | 4291.5  | 1429.0   | 40         | 5128.9  | 1960.2   |
| 50         | 3568.7  | 1020.5   | 50         | 4304.6  | 1436.8   | 50         | 5143.9  | 1970.3   |
| <b>64</b>  | 3580.3  | 1026.6   | <b>74</b>  | 4317.6  | 1444.6   | <b>84</b>  | 5159.0  | 1980.4   |
| 10         | 3591.9  | 1032.8   | 10         | 4330.7  | 1452.5   | 10         | 5174.1  | 1990.5   |
| 20         | 3603.5  | 1039.0   | 20         | 4343.8  | 1460.4   | 20         | 5189.3  | 2000.6   |
| 30         | 3615.1  | 1045.2   | 30         | 4356.9  | 1468.4   | 30         | 5204.4  | 2010.8   |
| 40         | 3626.8  | 1051.4   | 40         | 4370.1  | 1476.4   | 40         | 5219.7  | 2021.1   |
| 50         | 3638.5  | 1057.7   | 50         | 4383.3  | 1484.4   | 50         | 5234.9  | 2031.4   |
| <b>65</b>  | 3650.2  | 1063.9   | <b>75</b>  | 4396.5  | 1492.4   | <b>85</b>  | 5250.3  | 2041.7   |
| 10         | 3661.9  | 1070.2   | 10         | 4409.8  | 1500.5   | 10         | 5265.6  | 2052.1   |
| 20         | 3673.7  | 1076.6   | 20         | 4423.1  | 1508.6   | 20         | 5281.0  | 2062.5   |
| 30         | 3685.4  | 1082.9   | 30         | 4436.4  | 1516.7   | 30         | 5296.4  | 2073.0   |
| 40         | 3697.2  | 1089.3   | 40         | 4449.7  | 1524.9   | 40         | 5311.9  | 2083.5   |
| 50         | 3709.0  | 1095.7   | 50         | 4463.1  | 1533.1   | 50         | 5327.4  | 2094.1   |
| <b>66</b>  | 3720.9  | 1102.2   | <b>76</b>  | 4476.5  | 1541.4   | <b>86</b>  | 5343.0  | 2104.7   |
| 10         | 3732.7  | 1108.6   | 10         | 4489.9  | 1549.7   | 10         | 5358.6  | 2115.3   |
| 20         | 3744.6  | 1115.1   | 20         | 4503.4  | 1558.0   | 20         | 5374.2  | 2126.0   |
| 30         | 3756.5  | 1121.7   | 30         | 4516.9  | 1566.3   | 30         | 5389.9  | 2136.7   |
| 40         | 3768.5  | 1128.2   | 40         | 4530.4  | 1574.7   | 40         | 5405.6  | 2147.5   |
| 50         | 3780.4  | 1134.8   | 50         | 4544.0  | 1583.1   | 50         | 5421.4  | 2158.4   |
| <b>67</b>  | 3792.4  | 1141.4   | <b>77</b>  | 4557.6  | 1591.6   | <b>87</b>  | 5437.2  | 2169.2   |
| 10         | 3804.4  | 1148.0   | 10         | 4571.2  | 1600.1   | 10         | 5453.1  | 2180.2   |
| 20         | 3816.4  | 1154.7   | 20         | 4584.8  | 1608.6   | 20         | 5469.0  | 2191.1   |
| 30         | 3828.4  | 1161.3   | 30         | 4598.5  | 1617.1   | 30         | 5484.9  | 2202.2   |
| 40         | 3840.5  | 1168.1   | 40         | 4612.2  | 1625.7   | 40         | 5500.9  | 2213.2   |
| 50         | 3852.6  | 1174.8   | 50         | 4626.0  | 1634.4   | 50         | 5517.0  | 2224.3   |
| <b>68</b>  | 3864.7  | 1181.6   | <b>78</b>  | 4639.8  | 1643.0   | <b>88</b>  | 5533.1  | 2235.5   |
| 10         | 3876.8  | 1188.4   | 10         | 4653.6  | 1651.7   | 10         | 5549.2  | 2246.7   |
| 20         | 3889.0  | 1195.2   | 20         | 4667.4  | 1660.5   | 20         | 5565.4  | 2258.0   |
| 30         | 3901.2  | 1202.0   | 30         | 4681.3  | 1669.2   | 30         | 5581.6  | 2269.3   |
| 40         | 3913.4  | 1208.9   | 40         | 4695.2  | 1678.1   | 40         | 5597.8  | 2280.6   |
| 50         | 3925.6  | 1215.8   | 50         | 4709.2  | 1686.9   | 50         | 5614.2  | 2292.0   |
| <b>69</b>  | 3937.9  | 1222.7   | <b>79</b>  | 4723.2  | 1695.8   | <b>89</b>  | 5630.5  | 2303.5   |
| 10         | 3950.2  | 1229.7   | 10         | 4737.2  | 1704.7   | 10         | 5646.9  | 2315.0   |
| 20         | 3962.5  | 1236.7   | 20         | 4751.2  | 1713.7   | 20         | 5663.4  | 2326.6   |
| 30         | 3974.8  | 1243.7   | 30         | 4765.3  | 1722.7   | 30         | 5679.9  | 2338.2   |
| 40         | 3987.2  | 1250.8   | 40         | 4779.4  | 1731.7   | 40         | 5696.4  | 2349.8   |
| 50         | 3999.5  | 1257.9   | 50         | 4793.6  | 1740.8   | 50         | 5713.0  | 2361.5   |
| <b>70</b>  | 4011.9  | 1265.0   | <b>80</b>  | 4807.7  | 1749.9   | <b>90</b>  | 5729.7  | 2373.3   |
| 10         | 4024.4  | 1272.1   | 10         | 4822.0  | 1759.0   | 10         | 5746.3  | 2385.1   |
| 20         | 4036.8  | 1279.3   | 20         | 4836.2  | 1768.2   | 20         | 5763.1  | 2397.0   |
| 30         | 4049.3  | 1286.5   | 30         | 4850.5  | 1777.4   | 30         | 5779.9  | 2408.9   |
| 40         | 4061.8  | 1293.6   | 40         | 4864.8  | 1786.7   | 40         | 5796.7  | 2420.9   |
| 50         | 4074.4  | 1300.9   | 50         | 4879.2  | 1796.0   | 50         | 5813.6  | 2432.9   |



TABLE IV. — Tangents and External to a 1° Curve.

| Angle      | Tangent | External | Angle       | Tangent | External | Angle       | Tangent | External |
|------------|---------|----------|-------------|---------|----------|-------------|---------|----------|
| <b>91°</b> | 5830.5  | 2444.9   | <b>101°</b> | 6950.6  | 3278.1   | <b>111°</b> | 8336.7  | 4386.1   |
| 10'        | 5847.5  | 2457.1   | 10'         | 6971.3  | 3294.1   | 10'         | 8362.7  | 4407.6   |
| 20         | 5864.6  | 2469.3   | 20          | 6992.0  | 3310.1   | 20          | 8388.9  | 4429.2   |
| 30         | 5881.7  | 2481.5   | 30          | 7012.7  | 3326.1   | 30          | 8415.1  | 4450.9   |
| 40         | 5898.8  | 2493.8   | 40          | 7033.6  | 3342.3   | 40          | 8441.5  | 4472.7   |
| 50         | 5916.0  | 2506.1   | 50          | 7054.5  | 3358.5   | 50          | 8468.0  | 4494.6   |
| <b>92</b>  | 5933.2  | 2518.5   | <b>102</b>  | 7075.5  | 3374.9   | <b>112</b>  | 8494.6  | 4516.6   |
| 10         | 5950.5  | 2531.0   | 10          | 7096.6  | 3391.2   | 10          | 8521.3  | 4538.8   |
| 20         | 5967.9  | 2543.5   | 20          | 7117.8  | 3407.7   | 20          | 8548.1  | 4561.1   |
| 30         | 5985.3  | 2556.0   | 30          | 7139.0  | 3424.3   | 30          | 8575.0  | 4583.4   |
| 40         | 6002.7  | 2568.6   | 40          | 7160.3  | 3440.9   | 40          | 8602.1  | 4606.0   |
| 50         | 6020.2  | 2581.3   | 50          | 7181.7  | 3457.6   | 50          | 8629.3  | 4628.6   |
| <b>93</b>  | 6037.8  | 2594.0   | <b>103</b>  | 7203.2  | 3474.4   | <b>113</b>  | 8656.6  | 4651.3   |
| 10         | 6055.4  | 2606.8   | 10          | 7224.7  | 3491.3   | 10          | 8684.0  | 4674.2   |
| 20         | 6073.1  | 2619.7   | 20          | 7246.3  | 3508.2   | 20          | 8711.5  | 4697.2   |
| 30         | 6090.8  | 2632.6   | 30          | 7268.0  | 3525.2   | 30          | 8739.2  | 4720.3   |
| 40         | 6108.6  | 2645.5   | 40          | 7289.8  | 3542.4   | 40          | 8767.0  | 4743.6   |
| 50         | 6126.4  | 2658.5   | 50          | 7311.7  | 3559.6   | 50          | 8794.9  | 4766.9   |
| <b>94</b>  | 6144.3  | 2671.6   | <b>104</b>  | 7333.6  | 3576.8   | <b>114</b>  | 8822.9  | 4790.4   |
| 10         | 6162.6  | 2684.7   | 10          | 7355.6  | 3594.2   | 10          | 8851.0  | 4814.1   |
| 20         | 6180.2  | 2697.9   | 20          | 7377.8  | 3611.7   | 20          | 8879.3  | 4837.8   |
| 30         | 6198.3  | 2711.2   | 30          | 7399.9  | 3629.2   | 30          | 8907.7  | 4861.7   |
| 40         | 6216.4  | 2724.5   | 40          | 7422.2  | 3646.8   | 40          | 8936.3  | 4885.7   |
| 50         | 6234.6  | 2737.9   | 50          | 7444.6  | 3664.5   | 50          | 8965.0  | 4909.9   |
| <b>95</b>  | 6252.8  | 2751.3   | <b>105</b>  | 7467.0  | 3682.3   | <b>115</b>  | 8993.8  | 4934.1   |
| 10         | 6271.1  | 2764.8   | 10          | 7489.6  | 3700.2   | 10          | 9022.7  | 4958.6   |
| 20         | 6289.4  | 2778.3   | 20          | 7512.2  | 3718.2   | 20          | 9051.7  | 4983.1   |
| 30         | 6307.9  | 2792.0   | 30          | 7534.9  | 3736.2   | 30          | 9080.9  | 5007.8   |
| 40         | 6326.3  | 2805.6   | 40          | 7557.7  | 3754.4   | 40          | 9110.3  | 5032.6   |
| 50         | 6344.8  | 2819.4   | 50          | 7580.5  | 3772.6   | 50          | 9139.8  | 5057.6   |
| <b>96</b>  | 6363.4  | 2833.2   | <b>106</b>  | 7603.5  | 3791.0   | <b>116</b>  | 9169.4  | 5082.7   |
| 10         | 6382.1  | 2847.0   | 10          | 7626.6  | 3809.4   | 10          | 9199.1  | 5107.9   |
| 20         | 6400.8  | 2861.0   | 20          | 7649.7  | 3827.9   | 20          | 9229.0  | 5133.3   |
| 30         | 6419.5  | 2875.0   | 30          | 7672.9  | 3846.5   | 30          | 9259.0  | 5158.8   |
| 40         | 6438.4  | 2889.0   | 40          | 7696.3  | 3865.2   | 40          | 9289.2  | 5184.5   |
| 50         | 6457.3  | 2903.1   | 50          | 7719.7  | 3884.0   | 50          | 9319.5  | 5210.3   |
| <b>97</b>  | 6476.2  | 2917.3   | <b>107</b>  | 7743.2  | 3902.9   | <b>117</b>  | 9349.9  | 5236.2   |
| 10         | 6495.2  | 2931.6   | 10          | 7766.8  | 3921.9   | 10          | 9380.5  | 5262.3   |
| 20         | 6514.3  | 2945.9   | 20          | 7790.5  | 3940.9   | 20          | 9411.3  | 5288.6   |
| 30         | 6533.4  | 2960.3   | 30          | 7814.3  | 3960.1   | 30          | 9442.2  | 5315.0   |
| 40         | 6552.6  | 2974.7   | 40          | 7838.1  | 3979.4   | 40          | 9473.2  | 5341.5   |
| 50         | 6571.9  | 2989.2   | 50          | 7862.1  | 3998.7   | 50          | 9504.4  | 5368.2   |
| <b>98</b>  | 6591.2  | 3003.8   | <b>108</b>  | 7886.2  | 4018.2   | <b>118</b>  | 9535.7  | 5395.1   |
| 10         | 6610.6  | 3018.4   | 10          | 7910.4  | 4037.8   | 10          | 9567.2  | 5422.1   |
| 20         | 6630.1  | 3033.1   | 20          | 7934.6  | 4057.4   | 20          | 9598.9  | 5449.2   |
| 30         | 6649.6  | 3047.9   | 30          | 7959.0  | 4077.2   | 30          | 9630.7  | 5476.5   |
| 40         | 6669.2  | 3062.8   | 40          | 7983.5  | 4097.1   | 40          | 9662.6  | 5504.0   |
| 50         | 6688.8  | 3077.7   | 50          | 8008.0  | 4117.0   | 50          | 9694.7  | 5531.7   |
| <b>99</b>  | 6708.6  | 3092.7   | <b>109</b>  | 8032.7  | 4137.1   | <b>119</b>  | 9727.0  | 5559.4   |
| 10         | 6728.4  | 3107.7   | 10          | 8057.4  | 4157.3   | 10          | 9759.4  | 5587.4   |
| 20         | 6748.2  | 3122.9   | 20          | 8082.3  | 4177.5   | 20          | 9792.0  | 5615.5   |
| 30         | 6768.1  | 3138.1   | 30          | 8107.3  | 4197.9   | 30          | 9824.8  | 5643.8   |
| 40         | 6788.1  | 3153.3   | 40          | 8132.3  | 4218.4   | 40          | 9857.7  | 5672.3   |
| 50         | 6808.2  | 3168.7   | 50          | 8157.5  | 4239.0   | 50          | 9890.8  | 5700.9   |
| <b>100</b> | 6828.3  | 3184.1   | <b>110</b>  | 8182.8  | 4259.7   | <b>120</b>  | 9924.0  | 5729.7   |
| 10         | 6848.5  | 3199.6   | 10          | 8208.2  | 4280.5   | 10          | 9957.5  | 5758.6   |
| 20         | 6868.8  | 3215.1   | 20          | 8233.7  | 4301.4   | 20          | 9991.0  | 5787.7   |
| 30         | 6889.2  | 3230.8   | 30          | 8259.3  | 4322.4   | 30          | 10025.0 | 5817.0   |
| 40         | 6909.6  | 3246.5   | 40          | 8285.0  | 4343.6   | 40          | 10059.0 | 5846.5   |
| 50         | 6930.1  | 3262.3   | 50          | 8310.8  | 4364.8   | 50          | 10093.0 | 5876.1   |



Table V. Corrections for use with table IV,

COPYRIGHT, 1902, BY KEUFFEL &amp; ESSER CO.

|       |       | For Tangents Add |      |      |      |      |      |      |      |      |      |      |      |      |     |
|-------|-------|------------------|------|------|------|------|------|------|------|------|------|------|------|------|-----|
| ANGLE | CURVE | 5°               | 10°  | 15°  | 20°  | 25°  | 30°  | 35°  | 40°  | 45°  | 50°  | 55°  | 60°  | 65°  | 70° |
| 10°   | .03   | .06              | .09  | .13  | .16  | .19  | .22  | .25  | .28  | .31  | .34  | .38  | .42  | .46  |     |
| 15°   | .04   | .10              | .14  | .19  | .24  | .29  | .34  | .39  | .45  | .51  | .53  | .58  | .63  | .68  |     |
| 20°   | .06   | .13              | .19  | .26  | .32  | .39  | .45  | .51  | .58  | .65  | .72  | .79  | .84  | .90  |     |
| 25°   | .08   | .16              | .24  | .33  | .40  | .49  | .58  | .67  | .75  | .83  | .90  | .99  | 1.06 | 1.14 |     |
| 30°   | .10   | .19              | .29  | .39  | .49  | .59  | .69  | .79  | .89  | .99  | 1.09 | 1.20 | 1.29 | 1.39 |     |
| 35°   | .11   | .22              | .34  | .47  | .58  | .69  | .70  | .81  | .92  | 1.04 | 1.29 | 1.42 | 1.54 | 1.66 |     |
| 40°   | .13   | .26              | .40  | .53  | .67  | .80  | .93  | 1.06 | 1.20 | 1.34 | 1.49 | 1.64 | 1.79 | 1.94 |     |
| 45°   | .15   | .30              | .44  | .60  | .76  | .91  | 1.06 | 1.21 | 1.37 | 1.52 | 1.70 | 1.87 | 2.04 | 2.21 |     |
| 50°   | .17   | .34              | .51  | .68  | .85  | 1.02 | 1.19 | 1.36 | 1.54 | 1.72 | 1.91 | 2.10 | 2.29 | 2.48 |     |
| 55°   | .19   | .38              | .57  | .76  | .95  | 1.14 | 1.32 | 1.52 | 1.72 | 1.92 | 2.14 | 2.35 | 2.56 | 2.77 |     |
| 60°   | .21   | .42              | .63  | .84  | 1.05 | 1.27 | 1.49 | 1.71 | 1.94 | 2.17 | 2.38 | 2.60 | 2.83 | 3.07 |     |
| 65°   | .23   | .46              | .69  | .93  | 1.16 | 1.40 | 1.64 | 1.88 | 2.13 | 2.38 | 2.63 | 2.88 | 3.13 | 3.39 |     |
| 70°   | .25   | .51              | .76  | 1.02 | 1.28 | 1.54 | 1.80 | 2.06 | 2.33 | 2.60 | 2.88 | 3.16 | 3.44 | 3.72 |     |
| 75°   | .27   | .56              | .83  | 1.12 | 1.40 | 1.69 | 1.98 | 2.27 | 2.57 | 2.87 | 3.16 | 3.47 | 3.78 | 4.09 |     |
| 80°   | .30   | .61              | .91  | 1.22 | 1.53 | 1.84 | 2.15 | 2.46 | 2.78 | 3.10 | 3.44 | 3.78 | 4.12 | 4.46 |     |
| 85°   | .33   | .66              | 1.00 | 1.33 | 1.68 | 2.02 | 2.36 | 2.70 | 3.05 | 3.40 | 3.77 | 4.14 | 4.55 | 4.89 |     |
| 90°   | .36   | .72              | 1.09 | 1.45 | 1.83 | 2.20 | 2.57 | 2.94 | 3.32 | 3.70 | 4.10 | 4.50 | 4.91 | 5.32 |     |
| 95°   | .39   | .79              | 1.19 | 1.55 | 2.00 | 2.40 | 2.80 | 3.20 | 3.61 | 4.02 | 4.49 | 4.98 | 5.38 | 5.83 |     |
| 100°  | .43   | .86              | 1.30 | 1.74 | 2.18 | 2.62 | 3.06 | 3.50 | 3.95 | 4.40 | 4.88 | 5.37 | 5.85 | 6.34 |     |

## For Externals Add

| ANGLE | CURVE | 5°   | 10°  | 15°  | 20°  | 25°  | 30°  | 35°  | 40°  | 45°  | 50°  | 55°  | 60°  | 65°  | 70° |
|-------|-------|------|------|------|------|------|------|------|------|------|------|------|------|------|-----|
| 10°   | .001  | .003 | .004 | .006 | .007 | .008 | .009 | .011 | .012 | .014 | .015 | .017 | .018 | .020 |     |
| 15°   | .003  | .007 | .010 | .014 | .018 | .023 | .027 | .029 | .032 | .035 | .039 | .043 | .047 | .051 |     |
| 20°   | .006  | .011 | .017 | .022 | .028 | .034 | .038 | .045 | .051 | .057 | .063 | .070 | .076 | .083 |     |
| 25°   | .009  | .018 | .027 | .036 | .046 | .056 | .065 | .074 | .083 | .093 | .106 | .120 | .127 | .135 |     |
| 30°   | .013  | .025 | .038 | .051 | .065 | .078 | .090 | .103 | .116 | .129 | .149 | .170 | .179 | .188 |     |
| 35°   | .018  | .035 | .054 | .072 | .086 | .109 | .131 | .153 | .175 | .197 | .213 | .230 | .247 | .264 |     |
| 40°   | .023  | .046 | .070 | .093 | .117 | .141 | .172 | .203 | .234 | .265 | .277 | .290 | .315 | .341 |     |
| 45°   | .030  | .060 | .093 | .119 | .153 | .184 | .216 | .254 | .289 | .325 | .351 | .378 | .411 | .445 |     |
| 50°   | .037  | .075 | .116 | .151 | .189 | .227 | .266 | .305 | .345 | .384 | .425 | .467 | .508 | .550 |     |
| 55°   | .046  | .093 | .142 | .188 | .236 | .283 | .332 | .381 | .420 | .479 | .530 | .582 | .641 | .700 |     |
| 60°   | .056  | .112 | .168 | .225 | .283 | .340 | .398 | .457 | .516 | .575 | .636 | .697 | .774 | .851 |     |
| 65°   | .067  | .135 | .204 | .273 | .343 | .412 | .483 | .554 | .625 | .697 | .771 | .845 | .922 | 1.01 |     |
| 70°   | .080  | .159 | .240 | .321 | .403 | .485 | .568 | .652 | .735 | .819 | .906 | .994 | 1.08 | 1.17 |     |
| 75°   | .095  | .182 | .266 | .353 | .440 | .528 | .617 | .707 | .797 | .877 | .977 | 1.07 | 1.18 | 1.29 |     |
| 80°   | .110  | .220 | .332 | .445 | .558 | .671 | .787 | .903 | 1.02 | 1.13 | 1.25 | 1.38 | 1.50 | 1.62 |     |
| 85°   | .128  | .259 | .391 | .524 | .657 | .790 | .926 | 1.06 | 1.20 | 1.34 | 1.47 | 1.62 | 1.76 | 1.91 |     |
| 90°   | .149  | .299 | .450 | .603 | .756 | .910 | 1.07 | 1.22 | 1.38 | 1.54 | 1.70 | 1.87 | 2.03 | 2.20 |     |
| 95°   | .174  | .350 | .522 | .706 | .885 | 1.06 | 1.25 | 1.43 | 1.62 | 1.80 | 1.99 | 2.18 | 2.38 | 2.58 |     |
| 100°  | .200  | .401 | .604 | .809 | 1.01 | 1.22 | 1.43 | 1.64 | 1.85 | 2.06 | 2.28 | 2.50 | 2.73 | 2.96 |     |

Table VI. Deflections for Sub Chords for Short Radius Curves.

| Degree<br>of<br>Curve | Radius<br>50<br>sin. def. ang. | $\frac{1}{2}$ sub chord<br>R = sin of def. angle |        |        |        | Length<br>of arc<br>for 100 ft. |
|-----------------------|--------------------------------|--------------------------------------------------|--------|--------|--------|---------------------------------|
|                       |                                | 12.5 Ft.                                         | 15 Ft. | 20 Ft. | 25 Ft. |                                 |
| 30°                   | 193.18                         | 1° 51'                                           | 2° 17' | 2° 58' | 3° 43' | 101.15                          |
| 32°                   | 181.39                         | 1° 59'                                           | 2° 25' | 3° 10' | 3° 58' | 101.33                          |
| 34°                   | 171.01                         | 2° 06'                                           | 2° 33' | 3° 21' | 4° 12' | 101.48                          |
| 36°                   | 161.80                         | 2° 13'                                           | 2° 41' | 3° 33' | 4° 26' | 101.66                          |
| 38°                   | 153.58                         | 2° 20'                                           | 2° 49' | 3° 44' | 4° 40' | 101.85                          |
| 40°                   | 146.19                         | 2° 27'                                           | 2° 57' | 3° 55' | 4° 54' | 102.06                          |
| 42°                   | 139.52                         | 2° 34'                                           | 3° 05' | 4° 07' | 5° 08' | 102.29                          |
| 44°                   | 133.47                         | 2° 41'                                           | 3° 13' | 4° 18' | 5° 22' | 102.53                          |
| 46°                   | 127.97                         | 2° 48'                                           | 3° 21' | 4° 29' | 5° 36' | 102.76                          |
| 48°                   | 122.92                         | 2° 55'                                           | 3° 29' | 4° 40' | 5° 50' | 103.00                          |
| 50°                   | 118.31                         | 3° 02'                                           | 3° 38' | 4° 51' | 6° 04' | 103.24                          |
| 52°                   | 114.06                         | 3° 09'                                           | 3° 46' | 5° 02' | 6° 17' | 103.54                          |
| 54°                   | 110.11                         | 3° 16'                                           | 3° 54' | 5° 13' | 6° 31' | 103.84                          |
| 56°                   | 106.50                         | 3° 22'                                           | 4° 02' | 5° 23' | 6° 44' | 104.14                          |
| 58°                   | 103.14                         | 3° 29'                                           | 4° 10' | 5° 34' | 6° 57' | 104.43                          |
| 60°                   | 100.00                         | 3° 35'                                           | 4° 18' | 5° 44' | 7° 11' | 104.72                          |

## CURVE FORMULAS.

$$T = R \tan \frac{1}{2} I$$

$$T = \frac{50 \tan \frac{1}{2} I}{\sin. D}$$

$$\sin. D = \frac{50}{R}$$

$$\sin. D = \frac{50 \tan \frac{1}{2} I}{T}$$

$$R = T \cot. \frac{1}{2} I$$

$$R = \frac{50}{\sin. D}$$

$$E = R \text{ ex. sec. } \frac{1}{2} I$$

$$E = T \tan \frac{1}{4} I$$

$$\text{Chord def.} = \frac{\text{chord}^2}{R}$$

$$\text{No. chords} = \frac{\frac{1}{2} I}{D}$$

$$\text{Tan. def.} = \frac{1}{2} \text{ chord def.}$$

The square of any distance, divided by twice the radius, will equal the distance from tangent to curve, very nearly.

Table IV. contains Tangents and Externals to a 1° curve. Tan. and Ext. to any other radius may be found nearly enough, by dividing the Tan. or Ext. opposite the given Central Angle by the given degree of curve.

To find Deg. of Curve, having the Central Angle and Tangent: Divide Tan. opposite the given Central Angle by the given Tangent.

To find Deg. of Curve, having the Central Angle and Tangent: Divide Ext. opposite the given Central Angle by the given External.

To find Nat. Tan. and Nat. Ex. Sec. for any angle by Table IV.: Tan. or Ext. of twice the given angle divided by the radius of a 1° curve will be the Nat. Tan. or Nat. Ex. Sec.

To find angle for a given distance and deflection.

Rule 1. Multiply the given distance by .01745 (def. for 1° for 1 ft.), and divide given deflection by the product.

Rule 2. Multiply given deflection by 57.3, and divide the product by the given distance.

To find deflection for a given angle and distance: Multiply the angle by .01745, and the product by the distance.

RIGHT ANGLE TRIANGLES.— Square the altitude, divide by twice the base. Add quotient to base for hypotenuse.

Given Base 100, Alt 10.  $10^2 \div 200 = .5$ .  $100 + .5 = 100.5$  hyp.

Given Hyp. 100, Alt. 25.  $25^2 \div 200 = 3.125$ .  $100 - 3.125 = 96.875 = \text{Base}$ .

Error in first example, .002; in last, .045.

To find Tons of Rail in one mile of track: multiply weight per yard by 11, and divide by 7.



## Natural Sines

| DEG. | 0'   | 10'  | 20'  | 30'  | 40'  | 50'  | DEG. | DEG. | 0'   | 10'  | 20'  | 30'  | 40'  | 50'  | DEG. |
|------|------|------|------|------|------|------|------|------|------|------|------|------|------|------|------|
| 0    | 0000 | 0029 | 0058 | 0087 | 0116 | 0145 | 89   | 40   | 6428 | 6450 | 6472 | 6494 | 6517 | 6539 | 49   |
| 1    | 0175 | 0204 | 0233 | 0262 | 0291 | 0320 | 88   | 41   | 6561 | 6583 | 6604 | 6626 | 6648 | 6670 | 48   |
| 2    | 0349 | 0378 | 0407 | 0436 | 0465 | 0494 | 87   | 42   | 6691 | 6713 | 6734 | 6756 | 6777 | 6799 | 47   |
| 3    | 0523 | 0552 | 0581 | 0610 | 0640 | 0669 | 86   | 43   | 6820 | 6841 | 6862 | 6884 | 6905 | 6926 | 46   |
| 4    | 0698 | 0727 | 0756 | 0785 | 0814 | 0843 | 85   | 44   | 6947 | 6967 | 6988 | 7009 | 7030 | 7050 | 45   |
| 5    | 0872 | 0901 | 0929 | 0958 | 0987 | 1016 | 84   | 45   | 7071 | 7092 | 7112 | 7133 | 7153 | 7173 | 44   |
| 6    | 1045 | 1074 | 1103 | 1132 | 1161 | 1190 | 83   | 46   | 7193 | 7214 | 7234 | 7254 | 7274 | 7294 | 43   |
| 7    | 1219 | 1248 | 1276 | 1305 | 1334 | 1363 | 82   | 47   | 7314 | 7333 | 7353 | 7373 | 7392 | 7412 | 42   |
| 8    | 1392 | 1421 | 1449 | 1478 | 1507 | 1536 | 81   | 48   | 7431 | 7451 | 7470 | 7490 | 7509 | 7528 | 41   |
| 9    | 1564 | 1593 | 1622 | 1650 | 1679 | 1708 | 80   | 49   | 7547 | 7566 | 7585 | 7604 | 7623 | 7642 | 40   |
| 10   | 1736 | 1765 | 1794 | 1822 | 1851 | 1880 | 79   | 50   | 7660 | 7679 | 7698 | 7716 | 7735 | 7753 | 39   |
| 11   | 1908 | 1937 | 1965 | 1994 | 2022 | 2051 | 78   | 51   | 7771 | 7790 | 7808 | 7826 | 7844 | 7862 | 38   |
| 12   | 2079 | 2108 | 2136 | 2164 | 2193 | 2221 | 77   | 52   | 7880 | 7898 | 7916 | 7934 | 7951 | 7969 | 37   |
| 13   | 2250 | 2278 | 2306 | 2334 | 2363 | 2391 | 76   | 53   | 7986 | 8004 | 8021 | 8039 | 8056 | 8073 | 36   |
| 14   | 2419 | 2447 | 2476 | 2504 | 2532 | 2560 | 75   | 54   | 8090 | 8107 | 8124 | 8141 | 8158 | 8175 | 35   |
| 15   | 2588 | 2616 | 2644 | 2672 | 2700 | 2728 | 74   | 55   | 8192 | 8208 | 8225 | 8241 | 8258 | 8274 | 34   |
| 16   | 2756 | 2784 | 2812 | 2840 | 2868 | 2896 | 73   | 56   | 8290 | 8307 | 8323 | 8339 | 8355 | 8371 | 33   |
| 17   | 2924 | 2952 | 2979 | 3007 | 3035 | 3062 | 72   | 57   | 8387 | 8403 | 8418 | 8434 | 8450 | 8465 | 32   |
| 18   | 3090 | 3118 | 3145 | 3173 | 3201 | 3228 | 71   | 58   | 8480 | 8496 | 8511 | 8526 | 8542 | 8557 | 31   |
| 19   | 3256 | 3283 | 3311 | 3338 | 3365 | 3393 | 70   | 59   | 8572 | 8587 | 8601 | 8616 | 8631 | 8646 | 30   |
| 20   | 3420 | 3448 | 3475 | 3502 | 3529 | 3557 | 69   | 60   | 8660 | 8675 | 8689 | 8704 | 8718 | 8732 | 29   |
| 21   | 3584 | 3611 | 3638 | 3665 | 3692 | 3719 | 68   | 61   | 8746 | 8760 | 8774 | 8788 | 8802 | 8816 | 28   |
| 22   | 3746 | 3773 | 3800 | 3827 | 3854 | 3881 | 67   | 62   | 8829 | 8843 | 8857 | 8870 | 8884 | 8897 | 27   |
| 23   | 3907 | 3934 | 3961 | 3987 | 4014 | 4041 | 66   | 63   | 8910 | 8923 | 8936 | 8949 | 8962 | 8975 | 26   |
| 24   | 4067 | 4094 | 4120 | 4147 | 4173 | 4200 | 65   | 64   | 8988 | 9001 | 9013 | 9026 | 9038 | 9051 | 25   |
| 25   | 4226 | 4253 | 4279 | 4305 | 4331 | 4358 | 64   | 65   | 9063 | 9075 | 9088 | 9100 | 9112 | 9124 | 24   |
| 26   | 4384 | 4410 | 4436 | 4462 | 4488 | 4514 | 63   | 66   | 9135 | 9147 | 9159 | 9171 | 9182 | 9194 | 23   |
| 27   | 4540 | 4566 | 4592 | 4617 | 4643 | 4669 | 62   | 67   | 9205 | 9216 | 9228 | 9239 | 9250 | 9261 | 22   |
| 28   | 4695 | 4720 | 4746 | 4772 | 4797 | 4823 | 61   | 68   | 9272 | 9283 | 9293 | 9304 | 9315 | 9325 | 21   |
| 29   | 4848 | 4874 | 4899 | 4924 | 4950 | 4975 | 60   | 69   | 9336 | 9346 | 9356 | 9367 | 9377 | 9387 | 20   |
| 30   | 5000 | 5025 | 5050 | 5075 | 5100 | 5125 | 59   | 70   | 9397 | 9407 | 9417 | 9426 | 9436 | 9446 | 19   |
| 31   | 5150 | 5175 | 5200 | 5225 | 5250 | 5275 | 58   | 71   | 9455 | 9465 | 9474 | 9483 | 9492 | 9502 | 18   |
| 32   | 5299 | 5324 | 5348 | 5373 | 5398 | 5422 | 57   | 72   | 9511 | 9520 | 9528 | 9537 | 9546 | 9555 | 17   |
| 33   | 5446 | 5471 | 5495 | 5519 | 5544 | 5568 | 56   | 73   | 9563 | 9572 | 9580 | 9588 | 9596 | 9605 | 16   |
| 34   | 5592 | 5616 | 5640 | 5664 | 5688 | 5712 | 55   | 74   | 9613 | 9621 | 9628 | 9636 | 9644 | 9652 | 15   |
| 35   | 5736 | 5760 | 5783 | 5807 | 5831 | 5854 | 54   | 75   | 9659 | 9667 | 9674 | 9681 | 9689 | 9696 | 14   |
| 36   | 5878 | 5901 | 5925 | 5948 | 5972 | 5995 | 53   | 76   | 9703 | 9710 | 9717 | 9724 | 9730 | 9737 | 13   |
| 37   | 6018 | 6041 | 6065 | 6088 | 6111 | 6134 | 52   | 77   | 9744 | 9750 | 9757 | 9763 | 9769 | 9775 | 12   |
| 38   | 6157 | 6180 | 6202 | 6225 | 6248 | 6271 | 51   | 78   | 9781 | 9787 | 9793 | 9799 | 9805 | 9811 | 11   |
| 39   | 6293 | 6316 | 6338 | 6361 | 6383 | 6406 | 50   | 79   | 9816 | 9822 | 9827 | 9833 | 9838 | 9843 | 10   |
| DEG. | 60'  | 50'  | 40'  | 30'  | 20'  | 10'  | DEG. | DEG. | 60'  | 50'  | 40'  | 30'  | 20'  | 10'  | DEG. |

| DEG. | 0'    | 10'   | 20'   | 30'   | 40'    | 50'    | DEG. |
|------|-------|-------|-------|-------|--------|--------|------|
| 80   | 98.18 | 98.53 | 98.88 | 98.63 | 98.68  | 98.72  | 9    |
| 81   | 98.77 | 98.81 | 98.86 | 98.90 | 98.94  | 98.99  | 8    |
| 82   | 99.03 | 99.07 | 99.11 | 99.14 | 99.18  | 99.22  | 7    |
| 83   | 99.25 | 99.29 | 99.32 | 99.36 | 99.39  | 99.42  | 6    |
| 84   | 99.45 | 99.48 | 99.51 | 99.54 | 99.57  | 99.59  | 5    |
| 85   | 99.62 | 99.64 | 99.67 | 99.69 | 99.71  | 99.74  | 4    |
| 86   | 99.76 | 99.78 | 99.80 | 99.81 | 99.83  | 99.85  | 3    |
| 87   | 99.86 | 99.88 | 99.89 | 99.90 | 99.92  | 99.93  | 2    |
| 88   | 99.94 | 99.95 | 99.96 | 99.97 | 99.97  | 99.98  | 1    |
| 89   | 99.98 | 99.99 | 99.99 | 99.99 | 1.0000 | 1.0000 | 0    |
| DEG. | 60'   | 50'   | 40'   | 30'   | 20'    | 10'    | DEG. |

## Natural Cosines

## Natural Tangents

| deg. | 0'   | 10'  | 20'  | 30'  | 40'  | 50'  | deg. | 0'  | 10'    | 20'    | 30'    | 40'    | 50'    | deg.   |    |
|------|------|------|------|------|------|------|------|-----|--------|--------|--------|--------|--------|--------|----|
| 0    | 0000 | 0029 | 0058 | 0087 | 0116 | 0145 | 89   | 40  | 8391   | 8441   | 8491   | 8541   | 8591   | 8642   | 49 |
| 1    | 0175 | 0204 | 0233 | 0262 | 0291 | 0320 | 88   | 41  | 8693   | 8744   | 8796   | 8847   | 8899   | 8952   | 48 |
| 2    | 0349 | 0378 | 0407 | 0437 | 0466 | 0495 | 87   | 42  | 9004   | 9057   | 9110   | 9163   | 9217   | 9271   | 47 |
| 3    | 0524 | 0553 | 0582 | 0612 | 0641 | 0670 | 86   | 43  | 9325   | 9380   | 9435   | 9490   | 9545   | 9601   | 46 |
| 4    | 0699 | 0729 | 0758 | 0787 | 0816 | 0846 | 85   | 44  | 9657   | 9713   | 9770   | 9827   | 9884   | 9942   | 45 |
| 5    | 0875 | 0904 | 0934 | 0963 | 0992 | 1022 | 84   | 45  | 1.0000 | 1.0058 | 1.0117 | 1.0176 | 1.0235 | 1.0295 | 44 |
| 6    | 1051 | 1080 | 1110 | 1139 | 1169 | 1198 | 83   | 46  | 1.0355 | 1.0416 | 1.0477 | 1.0533 | 1.0599 | 1.0661 | 43 |
| 7    | 1228 | 1257 | 1287 | 1317 | 1346 | 1376 | 82   | 47  | 1.0724 | 1.0786 | 1.0850 | 1.0913 | 1.0977 | 1.1041 | 42 |
| 8    | 1405 | 1435 | 1465 | 1495 | 1524 | 1554 | 81   | 48  | 1.1106 | 1.1171 | 1.1237 | 1.1303 | 1.1369 | 1.1436 | 41 |
| 9    | 1584 | 1614 | 1644 | 1673 | 1703 | 1733 | 80   | 49  | 1.1504 | 1.1571 | 1.1640 | 1.1708 | 1.1778 | 1.1847 | 40 |
| 10   | 1763 | 1793 | 1823 | 1853 | 1883 | 1914 | 79   | 50  | 1.1918 | 1.1988 | 1.2059 | 1.2131 | 1.2203 | 1.2276 | 39 |
| 11   | 1944 | 1974 | 2004 | 2035 | 2065 | 2095 | 78   | 51  | 1.2349 | 1.2423 | 1.2497 | 1.2572 | 1.2647 | 1.2723 | 38 |
| 12   | 2126 | 2156 | 2186 | 2217 | 2247 | 2278 | 77   | 52  | 1.2799 | 1.2876 | 1.2954 | 1.3032 | 1.3111 | 1.3190 | 37 |
| 13   | 2309 | 2339 | 2370 | 2401 | 2432 | 2462 | 76   | 53  | 1.3270 | 1.3351 | 1.3432 | 1.3514 | 1.3597 | 1.3680 | 36 |
| 14   | 2493 | 2524 | 2555 | 2586 | 2617 | 2648 | 75   | 54  | 1.3764 | 1.3848 | 1.3934 | 1.4019 | 1.4106 | 1.4193 | 35 |
| 15   | 2679 | 2711 | 2742 | 2773 | 2805 | 2836 | 74   | 55  | 1.4281 | 1.4370 | 1.4460 | 1.4550 | 1.4641 | 1.4733 | 34 |
| 16   | 2867 | 2899 | 2931 | 2962 | 2994 | 3026 | 73   | 56  | 1.4826 | 1.4919 | 1.5013 | 1.5108 | 1.5204 | 1.5301 | 33 |
| 17   | 3057 | 3089 | 3121 | 3153 | 3185 | 3217 | 72   | 57  | 1.5399 | 1.5497 | 1.5597 | 1.5697 | 1.5798 | 1.5900 | 32 |
| 18   | 3249 | 3281 | 3314 | 3346 | 3378 | 3411 | 71   | 58  | 1.6003 | 1.6107 | 1.6212 | 1.6319 | 1.6426 | 1.6534 | 31 |
| 19   | 3443 | 3476 | 3508 | 3541 | 3574 | 3607 | 70   | 59  | 1.6643 | 1.6753 | 1.6864 | 1.6977 | 1.7090 | 1.7205 | 30 |
| 20   | 3640 | 3673 | 3706 | 3739 | 3772 | 3805 | 69   | 60  | 1.7321 | 1.7437 | 1.7556 | 1.7675 | 1.7797 | 1.7917 | 29 |
| 21   | 3839 | 3872 | 3906 | 3939 | 3973 | 4006 | 68   | 61  | 1.8040 | 1.8165 | 1.8291 | 1.8418 | 1.8546 | 1.8676 | 28 |
| 22   | 4040 | 4074 | 4108 | 4142 | 4176 | 4210 | 67   | 62  | 1.8807 | 1.8940 | 1.9074 | 1.9210 | 1.9347 | 1.9486 | 27 |
| 23   | 4245 | 4279 | 4314 | 4348 | 4383 | 4417 | 66   | 63  | 1.9626 | 1.9768 | 1.9912 | 2.0057 | 2.0204 | 2.0353 | 26 |
| 24   | 4452 | 4487 | 4522 | 4557 | 4592 | 4628 | 65   | 64  | 2.0503 | 2.0655 | 2.0809 | 2.0965 | 2.1123 | 2.1283 | 25 |
| 25   | 4663 | 4699 | 4734 | 4770 | 4806 | 4841 | 64   | 65  | 2.1445 | 2.1609 | 2.1775 | 2.1943 | 2.2113 | 2.2286 | 24 |
| 26   | 4877 | 4913 | 4950 | 4986 | 5022 | 5059 | 63   | 66  | 2.2460 | 2.2637 | 2.2817 | 2.2998 | 2.3183 | 2.3369 | 23 |
| 27   | 5095 | 5132 | 5169 | 5206 | 5243 | 5280 | 62   | 67  | 2.3559 | 2.3750 | 2.3945 | 2.4142 | 2.4342 | 2.4545 | 22 |
| 28   | 5317 | 5354 | 5392 | 5430 | 5467 | 5505 | 61   | 68  | 2.4751 | 2.4960 | 2.5172 | 2.5386 | 2.5605 | 2.5826 | 21 |
| 29   | 5543 | 5581 | 5619 | 5658 | 5696 | 5735 | 60   | 69  | 2.6051 | 2.6279 | 2.6511 | 2.6746 | 2.6985 | 2.7228 | 20 |
| 30   | 5774 | 5812 | 5851 | 5890 | 5930 | 5969 | 59   | 70  | 2.7475 | 2.7725 | 2.7980 | 2.8239 | 2.8502 | 2.8770 | 19 |
| 31   | 6009 | 6048 | 6088 | 6128 | 6168 | 6208 | 58   | 71  | 2.9042 | 2.9319 | 2.9600 | 2.9887 | 3.0178 | 3.0475 | 18 |
| 32   | 6249 | 6289 | 6330 | 6371 | 6412 | 6453 | 57   | 72  | 3.0777 | 3.1084 | 3.1397 | 3.1716 | 3.2041 | 3.2371 | 17 |
| 33   | 6494 | 6536 | 6577 | 6619 | 6661 | 6703 | 56   | 73  | 3.2709 | 3.3052 | 3.3402 | 3.3759 | 3.4124 | 3.4495 | 16 |
| 34   | 6745 | 6787 | 6830 | 6873 | 6916 | 6959 | 55   | 74  | 3.4874 | 3.5261 | 3.5656 | 3.6059 | 3.6470 | 3.6891 | 15 |
| 35   | 7002 | 7046 | 7089 | 7133 | 7177 | 7221 | 54   | 75  | 3.7321 | 3.7760 | 3.8208 | 3.8667 | 3.9136 | 3.9617 | 14 |
| 36   | 7265 | 7310 | 7355 | 7400 | 7445 | 7490 | 53   | 76  | 4.0108 | 4.0611 | 4.1126 | 4.1653 | 4.2193 | 4.2747 | 13 |
| 37   | 7536 | 7581 | 7627 | 7673 | 7720 | 7766 | 52   | 77  | 4.3315 | 4.3897 | 4.4494 | 4.5107 | 4.5736 | 4.6382 | 12 |
| 38   | 7813 | 7860 | 7907 | 7954 | 8002 | 8050 | 51   | 78  | 4.7046 | 4.7729 | 4.8430 | 4.9152 | 4.9894 | 5.0658 | 11 |
| 39   | 8098 | 8146 | 8195 | 8243 | 8292 | 8342 | 50   | 79  | 5.1446 | 5.2257 | 5.3093 | 5.3955 | 5.4845 | 5.5764 | 10 |
| deg. | 60'  | 50'  | 40'  | 30'  | 20'  | 10'  | deg. | 60' | 50'    | 40'    | 30'    | 20'    | 10'    | deg.   |    |

| deg. | 0'     | 10'    | 20'    | 30'     | 40'     | 50'     | deg. |
|------|--------|--------|--------|---------|---------|---------|------|
| 80   | 5.6713 | 5.7694 | 5.8708 | 5.9758  | 6.0844  | 6.1970  | 9    |
| 81   | 6.3138 | 6.4348 | 6.5606 | 6.6912  | 6.8269  | 6.9682  | 8    |
| 82   | 7.1154 | 7.2687 | 7.4287 | 7.5958  | 7.7704  | 7.9530  | 7    |
| 83   | 8.1443 | 8.3450 | 8.5555 | 8.7769  | 9.0098  | 9.2553  | 6    |
| 84   | 9.5144 | 9.7882 | 10.078 | 10.385  | 10.711  | 11.059  | 5    |
| 85   | 11.430 | 11.826 | 12.250 | 12.706  | 13.197  | 13.727  | 4    |
| 86   | 14.300 | 14.924 | 15.605 | 16.350  | 17.169  | 18.075  | 3    |
| 87   | 19.081 | 20.206 | 21.470 | 22.903  | 24.542  | 26.432  | 2    |
| 88   | 28.636 | 31.242 | 34.368 | 38.189  | 42.964  | 49.104  | 1    |
| 89   | 57.290 | 68.750 | 85.940 | 114.588 | 171.885 | 343.770 | 0    |

| deg. | 60' | 50' | 40' | 30' | 20' | 10' | deg. |
|------|-----|-----|-----|-----|-----|-----|------|
|------|-----|-----|-----|-----|-----|-----|------|

## Natural Cotangents



# DISTANCES FROM CENTER OF ROADWAY FOR CROSS-SECTIONING.

ROADWAY 14 FEET WIDE. SIDE SLOPES  $1\frac{1}{2}$  TO 1.

FOR SINGLE TRACK EMBANKMENT.

|    | 0    | .1   | .2   | .3   | .4   | .5   | .6   | .7   | .8   | .9   |    |
|----|------|------|------|------|------|------|------|------|------|------|----|
| 0  | 7.0  | 7.2  | 7.3  | 7.5  | 7.6  | 7.8  | 7.9  | 8.1  | 8.2  | 8.4  | 0  |
| 1  | 8.5  | 8.7  | 8.8  | 9.0  | 9.1  | 9.3  | 9.4  | 9.6  | 9.7  | 9.9  | 1  |
| 2  | 10.0 | 10.2 | 10.3 | 10.5 | 10.6 | 10.8 | 10.9 | 11.1 | 11.2 | 11.4 | 2  |
| 3  | 11.5 | 11.7 | 11.8 | 12.0 | 12.1 | 12.3 | 12.4 | 12.6 | 12.7 | 12.9 | 3  |
| 4  | 13.0 | 13.2 | 13.3 | 13.5 | 13.6 | 13.8 | 13.9 | 14.1 | 14.2 | 14.4 | 4  |
| 5  | 14.5 | 14.7 | 14.8 | 15.0 | 15.1 | 15.3 | 15.4 | 15.6 | 15.7 | 15.9 | 5  |
| 6  | 16.0 | 16.2 | 16.3 | 16.5 | 16.6 | 16.8 | 16.9 | 17.1 | 17.2 | 17.4 | 6  |
| 7  | 17.5 | 17.7 | 17.8 | 18.0 | 18.1 | 18.3 | 18.4 | 18.6 | 18.7 | 18.9 | 7  |
| 8  | 19.0 | 19.2 | 19.3 | 19.5 | 19.6 | 19.8 | 19.9 | 20.1 | 20.2 | 20.4 | 8  |
| 9  | 20.5 | 20.7 | 20.8 | 21.0 | 21.1 | 21.3 | 21.4 | 21.6 | 21.7 | 21.9 | 9  |
| 10 | 22.0 | 22.2 | 22.3 | 22.5 | 22.6 | 22.8 | 22.9 | 23.1 | 23.2 | 23.4 | 10 |
| 11 | 23.5 | 23.7 | 23.8 | 24.0 | 24.1 | 24.3 | 24.4 | 24.6 | 24.7 | 24.9 | 11 |
| 12 | 25.0 | 25.2 | 25.3 | 25.5 | 25.6 | 25.8 | 25.9 | 26.1 | 26.2 | 26.4 | 12 |
| 13 | 26.5 | 26.7 | 26.8 | 27.0 | 27.1 | 27.3 | 27.4 | 27.6 | 27.7 | 27.9 | 13 |
| 14 | 28.0 | 28.2 | 28.3 | 28.5 | 28.6 | 28.8 | 28.9 | 29.1 | 29.2 | 29.4 | 14 |
| 15 | 29.5 | 29.7 | 29.8 | 30.0 | 30.1 | 30.3 | 30.4 | 30.6 | 30.7 | 30.9 | 15 |
| 16 | 31.0 | 31.2 | 31.3 | 31.5 | 31.6 | 31.8 | 31.9 | 32.1 | 32.2 | 32.4 | 16 |
| 17 | 32.5 | 32.7 | 32.8 | 33.0 | 33.1 | 33.3 | 33.4 | 33.6 | 33.7 | 33.9 | 17 |
| 18 | 34.0 | 34.2 | 34.3 | 34.5 | 34.6 | 34.8 | 34.9 | 35.1 | 35.2 | 35.4 | 18 |
| 19 | 35.5 | 35.7 | 35.8 | 36.0 | 36.1 | 36.3 | 36.4 | 36.6 | 36.7 | 36.9 | 19 |
| 20 | 37.0 | 37.2 | 37.3 | 37.5 | 37.6 | 37.8 | 37.9 | 38.1 | 38.2 | 38.4 | 20 |
| 21 | 38.5 | 38.7 | 38.8 | 39.0 | 39.1 | 39.3 | 39.4 | 39.6 | 39.7 | 39.9 | 21 |
| 22 | 40.0 | 40.2 | 40.3 | 40.5 | 40.6 | 40.8 | 40.9 | 41.1 | 41.2 | 41.4 | 22 |
| 23 | 41.5 | 41.7 | 41.8 | 42.0 | 42.1 | 42.3 | 42.4 | 42.6 | 42.7 | 42.9 | 23 |
| 24 | 43.0 | 43.2 | 43.3 | 43.5 | 43.6 | 43.8 | 43.9 | 44.1 | 44.2 | 44.4 | 24 |
| 25 | 44.5 | 44.7 | 44.8 | 45.0 | 45.1 | 45.3 | 45.4 | 45.6 | 45.7 | 45.9 | 25 |
| 26 | 46.0 | 46.2 | 46.3 | 46.5 | 46.6 | 46.8 | 46.9 | 47.1 | 47.2 | 47.4 | 26 |
| 27 | 47.5 | 47.7 | 47.8 | 48.0 | 48.1 | 48.3 | 48.4 | 48.6 | 48.7 | 48.9 | 27 |
| 28 | 49.0 | 49.2 | 49.3 | 49.5 | 49.6 | 49.8 | 49.9 | 50.1 | 50.2 | 50.4 | 28 |
| 29 | 50.5 | 50.7 | 50.8 | 51.0 | 51.1 | 51.3 | 51.4 | 51.6 | 51.7 | 51.9 | 29 |
| 30 | 52.0 | 52.2 | 52.3 | 52.5 | 52.6 | 52.8 | 52.9 | 53.1 | 53.2 | 53.4 | 30 |
| 31 | 53.5 | 53.7 | 53.8 | 54.0 | 54.1 | 54.3 | 54.4 | 54.6 | 54.7 | 54.9 | 31 |
| 32 | 55.0 | 55.2 | 55.3 | 55.5 | 55.6 | 55.8 | 55.9 | 56.1 | 56.2 | 56.4 | 32 |
| 33 | 56.5 | 56.7 | 56.8 | 57.0 | 57.1 | 57.3 | 57.4 | 57.6 | 57.7 | 57.9 | 33 |
| 34 | 58.0 | 58.2 | 58.3 | 58.5 | 58.6 | 58.8 | 58.9 | 59.1 | 59.2 | 59.4 | 34 |
| 35 | 59.5 | 59.7 | 59.8 | 60.0 | 60.1 | 60.3 | 60.4 | 60.6 | 60.7 | 60.9 | 35 |
| 36 | 61.0 | 61.2 | 61.3 | 61.5 | 61.6 | 61.8 | 61.9 | 62.1 | 62.2 | 62.4 | 36 |

Calculated by Julien A. Hall, M. Am. Soc. C. E.

MADE IN GERMANY.

22682