

BK. 20 DR. 13

OFFICE OF COUNTY ENGINEER

RAMSEY CO. MINN.

ALIGNMENT

Base Line Survey

Locations of Catch Basins

From 4th St. To New Brighton

Road Acc't. No.

Date Filed 2-11-46

File

Align

Base Line

Location of Catch Basins
Fourth St New Brighton


Index	Pages	
Align	1 to 3	11/1/45 HAW
Levels	3 to 5	AM
Topog	5 to 6	C.F.
		Clondy


Drawn up
11/1/45 WB

Sta

2+00 POT

0+00 = 3+38 ALLEY Betw 4th & Third

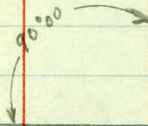

 

Profile Levels

Sta	+	Δ	-	Elev
B.M	0.67	925.68		925.01
	2.64	917.72	10.60	915.08
0+00				914.9
+50				13.8
/				13.4
+47		Catch Basin Lt.		12.3
+50		Top Curb		12.22
+63		R Fourth		12.0
+76		Top Curb		12.24
+79		Catch Basin Lt		12.4

£

Top Hyd N E Cor Third + Sixth

2.8


3.9

08.54	12.17	43
7.18	Top CB	
	5555	
Invent	19	54
Plugged		

5.50

5.7

06.72	08.00	07.30	12.27	5.48
C.B. out		C.B. In	Top CB	
11.00	7.18	10.45	5145	53
Plugged	10.54	Plugged	19	

 

Location of
Catch Basins
on Fourth St

2

+75 C. Basin

+76 West Curb Line

+50 East Curb Line

+47 C. Basin 19'

+40 W Edge Walk

+36 E Edge 41

1

+63 N.E. Cor No 4'

3+38 = 0+00

