

Dr. 14 - Bk. 19

X

OFFICE OF COUNTY ENGINEER
RAMSEY CO. MINN.

----- MAINT ----- Survey

----- Black Top Patching in -----
----- White Bear -----

From ----- To -----

Road Acc't. No. -----

Date Filed. 1936 -----

File -----

City of White Bear Black Top Paving

Street.	From	To
Fourth	Bald Eagle Ave.	Lake Ave.
Banning Ave	3 rd St.	7 th St.
Long Ave	7 th St.	in city limits.
Clark Ave	Lake Ave	2 nd St.

May 21, 1936

W. N. Carlson
5/21/36

S. H.

9

6

14

4

72

8

6

16

9

9/144

16.0

21

2

2

4

2

24

2

12

2

1

8

1

24

4

9/1090

12.11

Miller

3'x3'

Ave.

2'x3'



2'x7'

2'x2'

6'x12'

2'x4'



8'x3'

4'x4'



3'x3'

Murray

Ave.

3'x7'

2'x1'

2'x2'

2'x1'

2'x1'

3'x8'

2'x1'



2'x1'

1'x2'

1'x1'

1'x1'

1'x1'

1'x1'

1'x1'

1'x1'

1'x1'

1'x1'

1'x1'

1'x1'

2'x4'

Bald

Eagle Ave.

8. H.

$$\begin{array}{r} 12. \\ 4. \\ 4. \\ \hline 4. \end{array} \begin{array}{l} 20 \\ 2.22 \end{array}$$

15.

9.

8.

6.

12.

6.

4.

4.

4.

9.

$$\begin{array}{r} 36. \\ \hline 117 \\ 13 \end{array}$$

131

N
P

P.P.

Division St.

3'x4'



2'x2'




2'x2'

White Bear

2'x2'
3'x5'
3'x3'

4'x2'

2'x2'
3'x4'
2'x3'
2'x2'

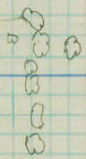

2'x2'



2'x2'



3'x3'



15
4
P



3'x12'

Miller

29 ft.

8.

2.

4.

15.

50. 179.00

12. 8.77

21.

4.

4.

6.

8.

4.

8.

2.

2. 971.00

18. 7.88

16.

4. 1385
4.22

188

Cook Ave

4

3'x5'

5'x10'

1'x3'
1'x2'
2'x2'

Banning

3'x7'

Ave 2'x6'

2'x3'

2'x2'

2'x4'

2'x2'

1'x8'

1'x2'

1'x2'

2'x2'

1'x6'

4th St.

3'x6'

2'x8'

2'x2'

Wash.

Sq. Ft.

$$\begin{array}{r} 4. \\ \hline 4.0 \\ .44 \end{array}$$

8.

20.

9.

12.

1.

9.

2.

2.

2.

$$\begin{array}{r} 16. \\ \hline 161 \\ 9 \end{array}$$

~~85~~

Moorhead

Ave

2'x2



Stewart

Ave

2'x4'



4'x5'

3'x3'

2'x6'

1'x1'

3'x3'

1'x2'

1'x3'

1'x3'



4'x7'

Cook

Ave




4'x4'

8. H.

$$\begin{array}{r} 1. \\ 4. \\ 12. \\ 15. \\ \hline 3. \\ 2. \\ \hline \end{array} \begin{array}{r} 3200 \\ 356 \\ \hline 5.00 \\ 55 \end{array}$$

37

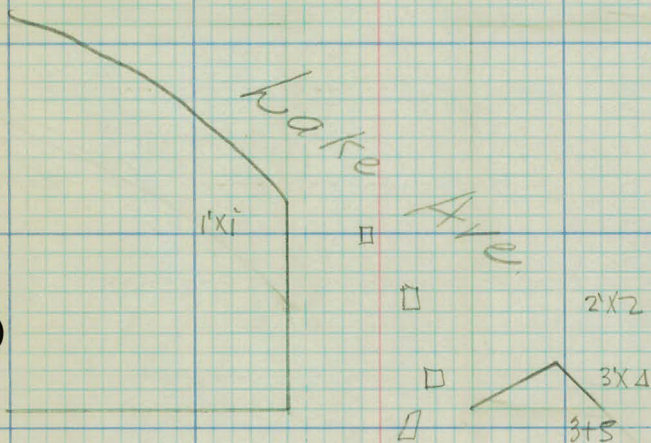

Johnson

1'x3'

Ave

1'x2'

Moorhead

Ave

Sq. Ft.

$$\begin{array}{r} 44. \\ 32. \\ \hline 24. \end{array} \bigg/ \begin{array}{r} 100.00 \\ 11.11 \end{array}$$

100

4th St

7

4x11



4x8



3x8



3rd St

Banning Ave

2nd St

1st St

Lake Ave

Sq. Ft.

6.

4.

18.

46. / 68.00

100. 7.56

8.

2.

4.

5.

2.

6.

2.

2.

2.

2. / 135

3. 15.

1.

4.

6. / 14.00

1.56

211

7th St

2x3



1x4

3x6



5x8

10x10

6th St

1x8



1x2



1x2



Banning St

1x4

1x5

2x3

1x2

1x2

1x2

1x2

5th St



1x3



1x1

4th St



1x4



2x3

Sq. Ft.

1.

1.

4.

2.

48.

4.

1.

4.

9.

2.

4.

1.

16.

10.

~~1107~~ .8
11.89

Long Ave.

N. City Limits

1'x1'

□

1'x1'

□

2'x2'

1'x2'

□

4'x12'

□

2'x2'

□

□

1'x1'

2'x2'

□

□ 3'x3'

1'x2'

□

□ 2'x2'

1'x1' □

2'x8'

1'x10' near R.R. Xing.

87 #.

18
5
90

90 .

1 .

1 .

1 .

6 .

1 .

100

11.11

1 .

1 .

27 .

29

3.22

129

9/1253 4d
140

