

Bk. 57 Dr. 16

CARVER AVE.

Topog. & Final X-Sec.,

Sub-grade X-Sec.,

City limits to East Ave.,

S.A.B. 62-544-2)

50-43A

1950

U & E

LEVEL BOOK


313A

Topog. & Final
X-Sec.

DISTANCES FROM SIDE STAKES FOR CROSS-SECTIONING

Roadway of any Width. Side Slopes 1½ to 1.

In the figure below: opposite 7 under "Cut or Fill" and under .3 read 11.0, the distance out from the side stake at left. Also, opposite 11 under "Cut or Fill" and under .1 read 16.7, the distance out from the side stake at right.

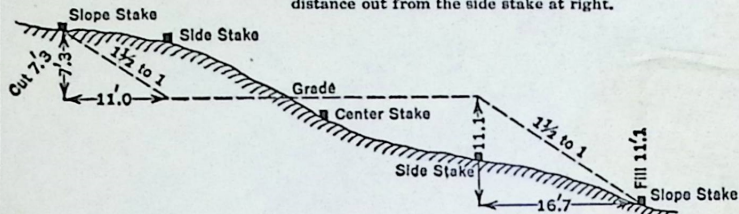

Cut or Fill	0	.1	.2	.3	.4	.5	.6	.7	.8	.9	Cut or Fill
	Distance out from Side or Shoulder Stake										
0	0.0	0.2	0.3	0.5	0.6	0.8	0.9	1.1	1.2	1.4	0
1	1.5	1.7	1.8	2.0	2.1	2.3	2.4	2.6	2.7	2.9	1
2	3.0	3.2	3.3	3.5	3.6	3.8	3.9	4.1	4.2	4.4	2
3	4.5	4.7	4.8	5.0	5.1	5.3	5.4	5.6	5.7	5.9	3
4	6.0	6.2	6.3	6.5	6.6	6.8	6.9	7.1	7.2	7.4	4
5	7.5	7.7	7.8	8.0	8.1	8.3	8.4	8.6	8.7	8.9	5
6	9.0	9.2	9.3	9.5	9.6	9.8	9.9	10.1	10.2	10.4	6
7	10.5	10.7	10.8	11.0	11.1	11.3	11.4	11.6	11.7	11.9	7
8	12.0	12.2	12.3	12.5	12.6	12.8	12.9	13.1	13.2	13.4	8
9	13.5	13.7	13.8	14.0	14.1	14.3	14.4	14.6	14.7	14.9	9
10	15.0	15.2	15.3	15.5	15.6	15.8	15.9	16.1	16.2	16.4	10
11	16.5	16.7	16.8	17.0	17.1	17.3	17.4	17.6	17.7	17.9	11
12	18.0	18.2	18.3	18.5	18.6	18.8	18.9	19.1	19.2	19.4	12
13	19.5	19.7	19.8	20.0	20.1	20.3	20.4	20.6	20.7	20.9	13
14	21.0	21.2	21.3	21.5	21.6	21.8	21.9	22.1	22.2	22.4	14
15	22.5	22.7	22.8	23.0	23.1	23.3	23.4	23.6	23.7	23.9	15
16	24.0	24.2	24.3	24.5	24.6	24.8	24.9	25.1	25.2	25.4	16
17	25.5	25.7	25.8	26.0	26.1	26.3	26.4	26.6	26.7	26.9	17
18	27.0	27.2	27.3	27.5	27.6	27.8	27.9	28.1	28.2	28.4	18
19	28.5	28.7	28.8	29.0	29.1	29.3	29.4	29.6	29.7	29.9	19
20	30.0	30.2	30.3	30.5	30.6	30.8	30.9	31.1	31.2	31.4	20
21	31.5	31.7	31.8	32.0	32.1	32.3	32.4	32.6	32.7	32.9	21
22	33.0	33.2	33.3	33.5	33.6	33.8	33.9	34.1	34.2	34.4	22
23	34.5	34.7	34.8	35.0	35.1	35.3	35.4	35.6	35.7	35.9	23
24	36.0	36.2	36.3	36.5	36.6	36.8	36.9	37.1	37.2	37.4	24
25	37.5	37.7	37.8	38.0	38.1	38.3	38.4	38.6	38.7	38.9	25
26	39.0	39.2	39.3	39.5	39.6	39.8	39.9	40.1	40.2	40.4	26
27	40.5	40.7	40.8	41.0	41.1	41.3	41.4	41.6	41.7	41.9	27
28	42.0	42.2	42.3	42.5	42.6	42.8	42.9	43.1	43.2	43.4	28
29	43.5	43.7	43.8	44.0	44.1	44.3	44.4	44.6	44.7	44.9	29
30	45.0	45.2	45.3	45.5	45.6	45.8	45.9	46.1	46.2	46.4	30
31	46.5	46.7	46.8	47.0	47.1	47.3	47.4	47.6	47.7	47.9	31
32	48.0	48.2	48.3	48.5	48.6	48.8	48.9	49.1	49.2	49.4	32
33	49.5	49.7	49.8	50.0	50.1	50.3	50.4	50.6	50.7	50.9	33
34	51.0	51.2	51.3	51.5	51.6	51.8	51.9	52.1	52.2	52.4	34
35	52.5	52.7	52.8	53.0	53.1	53.3	53.4	53.6	53.7	53.9	35
36	54.0	54.2	54.3	54.5	54.6	54.8	54.9	55.1	55.2	55.4	36
37	55.5	55.7	55.8	56.0	56.1	56.3	56.4	56.6	56.7	56.9	37
38	57.0	57.2	57.3	57.5	57.6	57.8	57.9	58.1	58.2	58.4	38
39	58.5	58.7	58.8	59.0	59.1	59.3	59.4	59.6	59.7	59.9	39
40	60.0	60.2	60.3	60.5	60.6	60.8	60.9	61.1	61.2	61.4	40

INDEX


Page

Final X-Sections

1 to 16

Final Topography

20-24

 

Carver Ave.

73.9 =

22 ft. below

top of present C.B. Ct
of Sta. 0+47

Final X-Sections

Sta	+	π	-	Elev
BM	10.38	868.41		858.03

0+00

+26

+44

+57

1

+50

TP	11.43	879.52	0.32	868.09
----	-------	--------	------	--------

7-31-50
GB MB
AM XR

LT

E

RL 29

Spk in 30" Elm @ 0-35'

56.38
12.03

57.41	57.8	57.46	57.14	57.24	56.71
11.0	10.6	10.95	11.27	11.17	11.70
20	13.8	11	22		28
58.3	58.6	58.4	57.9	57.97	57.8
10.1	9.8	10.02	10.52	10.44	10.63
20	19	11	10.1	10.5	11
58.3	59.6	59.0	58.5	58.52	58.4
10.1	8.8	9.43	9.93	9.89	9.99
23	18	11	10.2	10.5	11
59.8	61.8	61.4	60.9	60.91	60.8
8.6	6.6	7.03	7.52	7.45	7.57
28	16	11	10.3		10.5
64.3	65.6	65.4	64.9	64.90	64.8
4.1	3.8	3.04	3.53	3.51	3.58
19	15	11.0	10.3		10.6
65.3	65.3	65.4	59.6		
3.0	3.1	3.0	3.8		
11	11	15	31		

Sta	+	Δ	-	Elev
-----	---	----------	---	------

		879.52		
--	--	--------	--	--

2+00				
------	--	--	--	--

+50				
-----	--	--	--	--

3				
---	--	--	--	--

I.P.	9.94	889.08	0.38	879.14
------	------	--------	------	--------

3+50				
------	--	--	--	--

BM	6.06	892.79	2.36	886.72	886.73
----	------	--------	------	--------	--------

BM					
---------------	--	--	--	--	--

+75					
-----	--	--	--	--	--

4					
---	--	--	--	--	--

L+

D

R+

3

66.7	69.5	69.5	69.0	69.19	69.1	69.5	69.8	60.5
12.8	10.0	9.99	10.49	10.33	10.46	9.99	9.7	19.0
20	16	11	10.3		10.4	11.1	16	36

70.6	74.0	73.9	73.4	73.7	73.4	73.9	73.9	62.8
8.9	5.5	5.62	6.12	6.05	6.16	5.63	5.1	16.7
19	50	110	10.3		10.4	11.1	16	37

67.5	78.3	78.2	77.7	77.89	77.8	78.3	78.3	65.9
12.0	1.2	12.7	17.7	16.3	17.3	12.5	12	13.6
33	15	11	10.3		10.3	11	15	39

72.0	83.0	83.1	82.6	82.68	82.6	83.1	83.1	70.1
17.1	6.1	5.97	6.48	6.40	6.48	6.00	6.0	19.0
34	16	11	10.3		10.4	11.2	16	41

Spt in 30" Elm Rt @ 4/468

8-2-50

75.4	85.7	85.6	85.1	85.17	85.2	85.7	85.7	73.0
17.4	7.1	6.21	7.70	7.62	7.6	7.10	7.1	19.8
31	16	11	10.3		10.4	11	16	41

81.3	88.7	88.5	88.0	87.99	87.9	88.5	88.4	76.3
11.5	4.1	4.27	4.80	4.80	4.85	4.25	4.4	16.5
30	17	11.0	10.2		10.4	11	15	39

Sta	+	π	-	Elev
-----	---	-------	---	------

		892.79		
--	--	--------	--	--

4 + 25				
--------	--	--	--	--

		905.27		
--	--	--------	--	--

T.P.	12.75	904.29	0.27	892.52
------	-------	--------	------	--------

+ 40				
------	--	--	--	--

+ 70				
------	--	--	--	--

+ 79.21				
---------	--	--	--	--

+ 90				
------	--	--	--	--

+ 98.2				
--------	--	--	--	--

Lt

92.25 ✓

0.6
22

91.4 ✓

1.40
11

90.9 ✓

1.89
10.2

90.94 ✓

1.85

90.8 ✓

1.97
10.4

91.3 ✓

1.45
11

91.5 ✓

1.3
15

81.0 ✓

16.8
35

Rt

4

94.5 ✓

10.8
23

93.9 ✓

11.4
20

93.3 ✓

11.97
11

92.8 ✓

12.51
10.3

92.73 ✓

12.54

92.6 ✓

12.63
10.3

93.1 ✓

12.13
11

93.2 ✓

12.1
15

86.6 ✓

18.7
26

99.8 ✓

5.5
24

97.4 ✓

7.9
14

97.1 ✓

8.17
11

96.6 ✓

8.72
10.2

96.52 ✓

8.75

96.41 ✓

8.86
10.2

96.9 ✓

8.38
11.0

97.2 ✓

8.1
19

91.2 ✓

4.1
25

91.6 ✓

3.7
19

98.5 ✓

6.8
14

98.1 ✓

7.18
10.9

97.6 ✓

7.52
10.2

97.7 ✓

7.56
10.3

97.6 ✓

7.65
10.3

98.1 ✓

7.15
11

98.1 ✓

7.2
23

*

99.8 ✓

5.5

99.6 ✓

5.72
11

99.0 ✓

6.23
10.2

99.08 ✓

6.19

99.0 ✓

6.31
10.4

99.5 ✓

5.80
11

99.5 ✓

5.8
25

*

91.0 ✓

4.3
14

90.7 ✓

4.61
11

90.1 ✓

5.18
10.2

90.09 ✓

5.18

90.0 ✓

5.26
10.2

90.5 ✓

4.77
11.0

90.5 ✓

4.8
27

90.8 ✓

4.5
29

Sta	+	π	-	Elev
-----	---	-------	---	------

905.27

904.27

5+03.7

+18.2

+30

T.P.

12.45

917.38

0.34

904.93

~~903.93~~

+43

+54

+73

L+

R+

5

* 3.7 404 453 450
14 11 10.2

4.59 4.11 4.2 3.7
10.4 11.0 28 32

* 03.9 ✓
1.9 2.11 2.60
14 11 10

02.68 ✓
2.59
7.75

02.6 ✓
2.71
10.4

03.1 ✓
2.22 2.5
11 33

05.0 ✓
0.3 0.59 1.07 1.06
14 11 10.2

04.0 ✓
1.23 0.75 0.7 1.2 1.7
10.4 11 21 35 37

17.8.
+0.4 10.9 11. 11.71 11.41
38 14 10.8 10

05.7 ✓
05.77 ✓
11.28 11.27 11.2 11.5
10.3 11 20 37

07.9.
* 9.5 9.8 10.32 10.27
14 10.8 10

07.0 ✓
07.5 ✓
10.42 9.93 9.9 10.1
10.3 11 20 37

09.9 ✓
7.5 7.64 8.15
15 10.8 10

09.41 ✓
7.97 8.13
10.3

09.7 ✓
7.65 7.4
11 20

10.0 ✓
7.5
36

09.9 ✓
7.5
36

Sta

+

π

-

Elev

917.38

6+00

5+90

6+18

6+36.24

4.490

+98.2

5+03.7

8.08.5
27
28

07.7.✓
27
21

11.9
18

05.5.✓

05.4.✓
21

13.4
23

04.0.✓

17.4.✓
0.0
14

17.2.✓
0.23
10.8

16.7.✓
0.73
9.9

16.73.✓
0.65

16.7.✓
0.69
10.3

17.3.✓
0.13
11

17.2.✓
0.2
16

16.7.✓
0.7
21

* 2.1
16

2.28
10.8

2.75
9.9

2.63
14.75.✓

2.62
10.3

2.17
11

1.8
19

1.8
25

15.3.✓
16

15.1.✓
10.8

14.6.✓
9.9

14.75.✓

14.8.✓
10.3

15.2.✓
11

15.6.✓
19

15.6.✓
25

* 4.2
19

5.4
14

5.61
11

6.15
10

5.84
10.3

5.44
11

5.2
21

5.3
32

13.2.✓
19

12.0.✓
14

11.8.✓
11

11.2.✓
10

11.5.✓
10.3

11.9.✓
11

12.2.✓
21

12.1.✓
32

* 4.1
17

4.24
10.8

4.76
10.1

4.69
12.69.✓

4.76
10.3

4.31
11

4.1
21

4.3
28

4.1
13.3.✓

4.24
13.2.✓

4.76
13.6.✓

4.69
12.69.✓

4.76
12.6.✓

4.31
13.1.✓

4.1
13.3.✓

4.3
13.1.✓

RT

6

Sta	+	π	-	Elev
-----	---	-------	---	------

917.38

5 + 18.2

+ 30

T P	11.32	928.29	0.41	916.97
-----	-------	--------	------	--------

BM	NE Cor $\rightarrow$	3.56	24.73	924.82
	NW Cor $\rightarrow$	3.61	24.68	924.62

6 + 43.24

T. P	13.61	940.29	16.1	926.68
------	-------	--------	------	--------

5 + 54

+ 73

+ 90

6

✓
13.6

3.8

31

✓
16.0

1.4

34

NE cor

✓
18.2

10.1

15

✓
17.9

10.37

10.9

✓
17.4

10.87

10.1

✓
17.47

10.82

✓
17.4

10.87

10.4

✓
17.9

10.38

11

✓
18.2

10.1

14

✓
17.8

10.5

19

✓
24.3

16.0

50

✓
28.0

12.3

56

✓
30.4

9.9

56

✓
33.8

6.5

56

Sta + T - Elev

940.29

6 + 18

TP 13.50 948.34 5.45 934.84

6 + 25

+36.25

+43.24



BM

5.63

942.71

~~952.71~~

942.71

Lt

E

Rt.

8

35.0 ✓

5.3
5.3

42.0 ✓
6.3

44.1 ✓
4.2
63

64
38.4 ✓
9.9
50

44.7 ✓
3.6
63

39.3 ✓
2.0
45

Spk in P.P.

Sta	+	$\bar{x}$	-	Elev
		925.61		924.72
BM	0.89	925.69		924.70

+24.7

+43

+54

+73

+90

6

+25

+57.48

8-4-50

Lt

E

Rt

9

Top NE cor. Conc. Door Sill #2204 Carver

15.98
15.8

24

13.2
12.4

26

15.0
10.6

29

17.8
7.8

32

20.3
5.3

33

20.5
5.1

31

22.0
16.1

3.6

24

16.0
15.5

9.5

15

10.07
15.54

9.61

10.9

10.12
11

9.9

11

16.0
16.4

9.2

23

16.1
16.1

9.5

38



















21.9
19.7

37

19

19.4
19.0

6.19

10.8

19.4
19.0

6.6

10




Sta	+	π	-	Elev
-----	---	-------	---	------

		925.61		
		925.69		

6+75				
------	--	--	--	--

7				
---	--	--	--	--

		937.90		925.21
T.P.	12.69	934.98	0.40	925.29

+25				
-----	--	--	--	--

+50				
-----	--	--	--	--

+75				
-----	--	--	--	--

8				
---	--	--	--	--

34.9 ✓	5.2	7.6	28.9 ✓	0.10	20.5 ✓	22.8 ✓	2+
18	19	17	17	18	18	18	18
33.9 ✓	6.4	8.7	26.7 ✓	1.6	24.0 ✓	21.4 ✓	1+
16	17	14	15	15	15	15	15
33.5 ✓	6.81	9.13	26.3 ✓	1.90	23.7 ✓	21.2 ✓	1+
11	10.9	11	11	10.9	10.9	11	11
33.0 ✓	7.30	9.62	25.8 ✓	2.40	23.2 ✓	20.7 ✓	1+
10	10	10	10	10	10	10	10
32.98 ✓	7.19	9.58	25.83 ✓	2.31	23.30 ✓	20.78 ✓	1+
10	10.4	10	11	10	10	10	10
32.9 ✓	6.86	9.23	25.7 ✓	2.45	23.2 ✓	20.6 ✓	1+
10.3	11	11	11	10	10	10	10
33.4 ✓	6.6	8.9	26.3 ✓	1.98	23.6 ✓	21.1 ✓	1+
11	14	14	15.5	11	11	11	11
33.8 ✓	6.5	9.0	26.1 ✓	1.7	23.9 ✓	21.2 ✓	1+
15	18	18	22	18	18	15	15
		10.5	27.4 ✓	1.7	23.9 ✓	21.2 ✓	1+
		23	27	18	18	19	19

Sta	+	π	-	Elev
-----	---	-------	---	------

		937.90 937.98		
--	--	------------------	--	--

8+12				
------	--	--	--	--

+16				
-----	--	--	--	--

+34				
-----	--	--	--	--

T.P.				
------	--	--	--	--

	11.10			
--	-------	--	--	--

		948.92		
--	--	--------	--	--

		948.90		
--	--	--------	--	--

			0.18	
--	--	--	------	--

				937.72
--	--	--	--	--------

				937.80
--	--	--	--	--------

+4585				
-------	--	--	--	--

+50				
-----	--	--	--	--

+54				
-----	--	--	--	--

Reverse
Section

Reverse
Sec.

38.4. ✓ 10.4 17	38.2. ✓ 10.6 14	37.9. ✓ 10.92 11	37.5. ✓ 11.35 10.3	37.2. ✓ 11.60 10.2	36.9. ✓ 11.92 10.1	36.8. ✓ 12.01 10.1	37.3. ✓ 11.49 11	37.7. ✓ 11.1 14	37.8. ✓ 11.0 16
39.1. ✓ 97 19	38.7. ✓ 10.1 16	38.0. ✓ 10.8 14	37.7. ✓ 11.12 11	37.2. ✓ 11.61 10.2	37.2. ✓ 11.60 10	37.1. ✓ 11.68 10	37.7. ✓ 11.16 11	37.9. ✓ 10.9 14	38.2. ✓ 10.6 16
39.5. ✓ 93 19	38.8. ✓ 10.0 17	37.6. ✓ 11.2 14	37.4. ✓ 11.44 11	36.9. ✓ 11.96 10	36.9. ✓ 11.92 10.1	36.8. ✓ 12.01 10.1	37.3. ✓ 11.49 11	37.7. ✓ 11.1 14	37.8. ✓ 11.0 16
36.3. ✓ 1.6 29	36.1. ✓ 1.8 22	36.4. ✓ 1.45 15	36.0. ✓ 1.92 11	36.0. ✓ 1.87 10	36.0. ✓ 1.93 10	36.0. ✓ 1.46 11	36.4. ✓ 1.1 14	36.8. ✓ 1.1 14	36.3. ✓ 1.0.4 16.0
36.0. ✓ 1.9 34	35.3. ✓ 2.6 18	35.1. ✓ 2.8 14	34.9. ✓ 3.01 11	34.4. ✓ 3.49 10	34.7. ✓ 3.43 10.2	34.4. ✓ 2.50 11	34.9. ✓ 2.99 11	35.2. ✓ 2.7 14	36.7. ✓ 1.2 16
35.4. ✓ 2.5 18	34.9. ✓ 3.0 16	34.5. ✓ 3.40 11	34.0. ✓ 3.88 10	34.0. ✓ 3.81 10	34.0. ✓ 3.91 10	34.5. ✓ 3.43 11	34.9. ✓ 3.0 14	36.8. ✓ 1.1 17	

Sta	+	π	-	Elev
-----	---	-------	---	------

		948.82 948.90		
--	--	------------------	--	--

+63				
-----	--	--	--	--

+75				
-----	--	--	--	--

8 +67				
-------	--	--	--	--

9				
---	--	--	--	--

+25				
-----	--	--	--	--

+50				
-----	--	--	--	--

1	2	3	4	5	6	7	8	9	10
43.3 ✓	43.6 ✓	43.8 ✓	43.7 ✓	43.2 ✓	43.1 ✓	43.7 ✓	43.7 ✓	43.7 ✓	43.7 ✓
5.5	5.2	5.0	5.15	5.66	5.69	5.69	5.69	5.69	5.69
28	25	17	11	10.2	10.2	11	15	18	
44.8 ✓	44.6 ✓	42.8 ✓	42.6 ✓	42.1 ✓	42.1 ✓	42.6 ✓	42.6 ✓	42.5 ✓	
40	42	60	6.22	6.72	6.61	6.72	6.23	6.3	
20	18	13	11	10.3	10.3	11	17	24	
42.5 ✓	41.5 ✓	41.2 ✓	39.4 ✓	38.1 ✓	38.6 ✓	38.5 ✓	39.0 ✓	39.2 ✓	
7.3	7.6	9.4	10.74	10.26	10.21	10.32	9.80	9.6	
21	18	15	160	10.3	10.4	11.0	14	17	
42.6 ✓	42.3 ✓	39.9 ✓	39.7 ✓	39.1 ✓	39.1 ✓	39.1 ✓	39.5 ✓	39.8 ✓	
6.2	6.5	8.9	9.16	9.68	9.63	9.75	9.26	9.0	
21	18	14	11	10.4	10.5	11	14	17	
41.8 ✓	40.5 ✓	40.4 ✓	38.9 ✓	38.7 ✓	38.2 ✓	38.7 ✓	38.9 ✓	39.1 ✓	
7.0	8.3	8.4	9.9	10.08	10.59	10.65	9.9	9.7	
22	21	17	14	11	10.3	10.4	15	17	

? should this be reversed
Reversed Section

Reversed Section

Sta	+	π	-	Elev
-----	---	-------	---	------

948.82

948.90

9+75

10

BM

4.72

952.07

1.45

947.37 947.35

947.45

+10

+33

+39

+50

Sta	+	π	-	Elev
-----	---	-------	---	------

		952.07		
--	--	--------	--	--

10 +54				
--------	--	--	--	--

11				
----	--	--	--	--

			?	+20 from H.I. above
--	--	--	---	---------------------

+20				
-----	--	--	--	--

	5.30			
--	------	--	--	--

		957.24		
--	--	--------	--	--

			0.13	
--	--	--	------	--

				951.94
--	--	--	--	--------

87-50
GB MB
AM KR

+50				
-----	--	--	--	--

+80				
-----	--	--	--	--

12				
----	--	--	--	--


Sta	+	π	-	Elev
-----	---	-------	---	------

957.24

12 + 30

+ 63

13

+ 25

+ 50

+ 66

PI @ City Limits

41	2.8	54.9.✓	49	53.3.✓	18	4.8	52.4.	18	4.8	52.2.✓	16	5.0	52.5.✓	20	4.7	52.5.✓	23	3.7	53.5.✓
32	3.3	53.9.✓	16	53.1.✓	16	4.8	52.4.	18	4.8	52.2.✓	16	5.0	52.5.✓	18	4.8	52.5.✓	21	3.9	53.3.✓
13	3.4	53.8.✓	14	52.9.✓	15	4.9	52.3.	15	4.9	51.6.✓	14	5.6	50.6.✓	14	4.6	50.6.✓	15	2.4	49.8.✓
8	3.2	54.0.✓	9	53.4.✓	8	4.6	52.6.	8	4.6	51.8.✓	9	5.4	51.8.✓	9	4.6	50.6.✓	9	2.5	49.7.✓
0	3.0	54.2.✓	3	53.9.✓	4	4.4	52.8.✓	4	4.4	52.0.✓	5	5.2	52.0.✓	6	4.3	50.9.✓	23	2.3	49.9.✓
					6	4.4	52.8.✓	6	4.4	52.0.✓									
					14	4.7	52.5.✓	14	4.7	52.1.✓	6	5.1	52.1.✓	5	4.9	50.7.✓			
					16.5	3.9	53.3.	16.5	3.9	51.8.✓	14.3	5.4	51.8.✓	18	4.9	51.7.✓			
					6	3.4	53.8.✓	6	3.4	52.8.✓							15	2.7	49.5.✓
					15	3.5	53.7.✓	15	3.5	52.8.✓	17	4.4	52.8.✓				18	6.9	50.3.✓

Sta	+	π	-	Elev
-----	---	-------	---	------

		957.24		
--	--	--------	--	--

14				
----	--	--	--	--

	+50			
--	-----	--	--	--

15				
----	--	--	--	--

BM				
----	--	--	--	--

		2.60	954.64	
--	--	------	--------	--


				954.61
--	--	--	--	--------

Lt			P	Rt.
53.3.	54.7.	54.4.	54.7.	
3.9	2.5	2.8	2.5	✓
17	15	11		

54.5.	55.3.	55.2.	55.6.	✓
2.7	1.9	2.0	1.6	
17	15	12		

55.3.	56.4.	56.8.	✓
1.9	0.8	0.4	
16	12		

Sph in PP Lt @ City Limits

 

Final Topography

8-17-50


G.B.

M.B.

K.R.

Sta	Lt.	£	Rt
4+80			Sod-11, 14-21'
0+77			£ Ent. 11-15.5
0+46			ctr. C.Bas. -12'
0+43			end Rad. -10.4-11
0+36			Beg Curb - 12.9, Beg Sod
0+30			ctr. New C.Bas. -11.7
0+29			Begin new pave - 21
0+26			A.Pt. new pave - 21 -15
0+24			{ Begin Sod Begin Curb -10.3 Begin New Pavem. 10.3
0+23.5			Begin New Pave 0'±5'
			ctr. MH 4.5

2

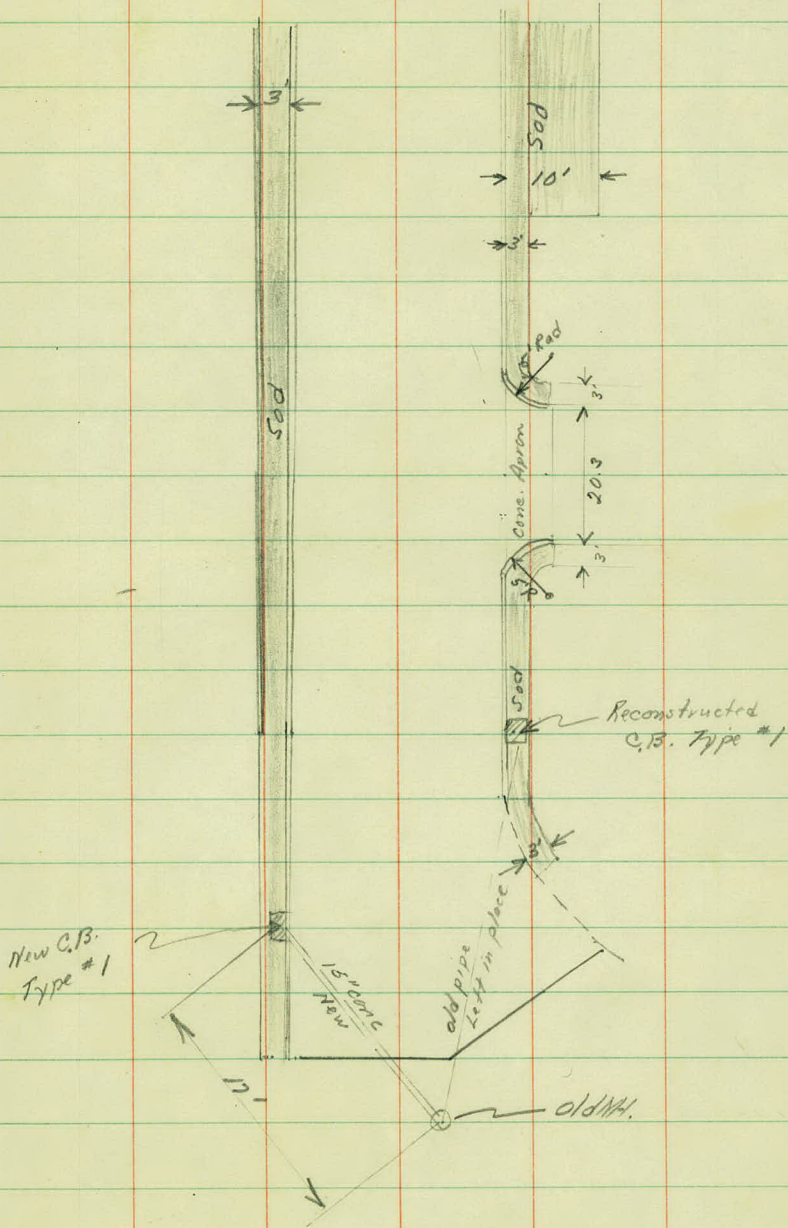

Sta

Lt

St

Pl.

8128 ♀ Ent 11-13.5




7+28.5

6+29

6+23

~~6+28~~

40

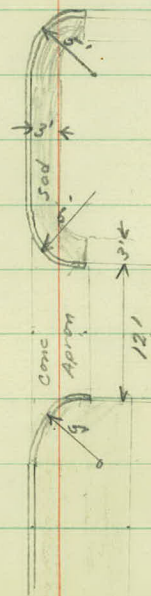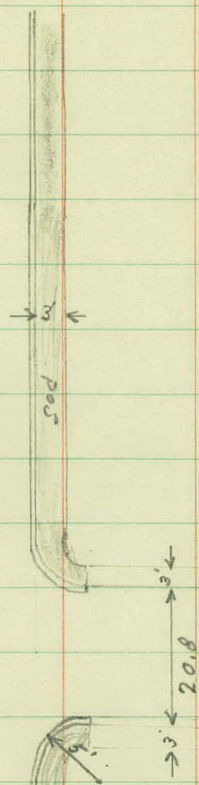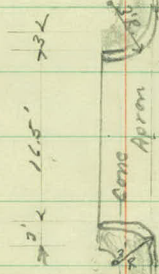

Sta

Lt

¢

Rt.

10+10

C Bas. - 14.8

C. Bas - 15.2

10+06

Beg. Rubble Spillway
end Storm Sewer - 89

10+02

end Header.



Beg. Header

10+00

end curb & Sod


end curb & Sod

8+93.5

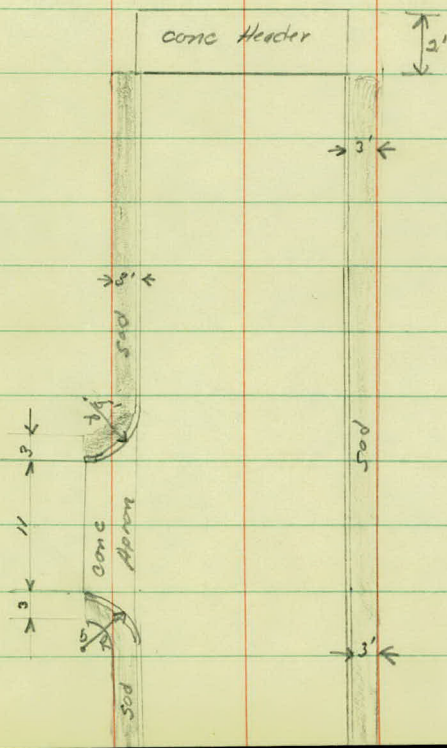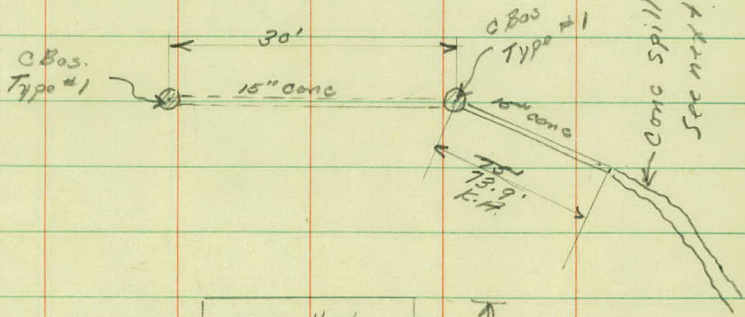


Spillway Rt @ Sta 10+00


Typical Section
 Conc. Spillway

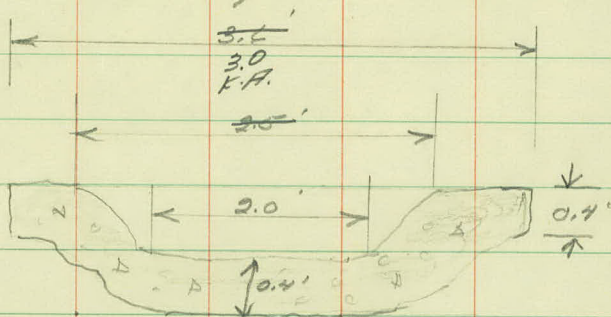

Total Length = 72'

 


Center @ 10+10

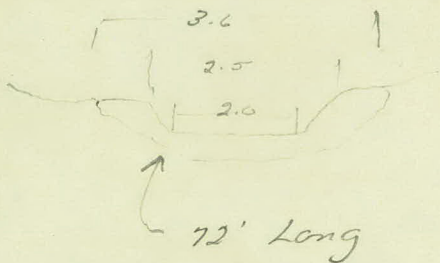


LT

RT

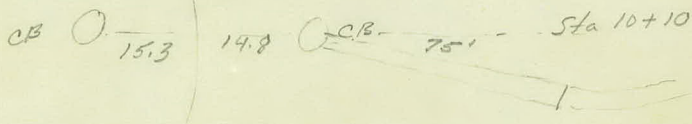

10+46 - 12'

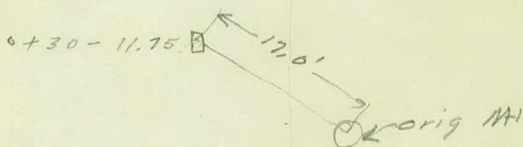

$$\begin{array}{r} 29.24 \\ 4.16 \\ \hline 25.08 \end{array}$$

$$\begin{array}{r} 64.63 \\ 58.25 \\ \hline 122.88 \end{array}$$

$$\begin{array}{r} 05.27 \\ 1.06 \\ \hline 4.21 \\ 4.09 \\ \hline 11 \end{array}$$


$$\begin{array}{r} 29.24 \\ 4.62 \\ \hline 24.62 \end{array}$$

$$\begin{array}{r} 17.38 \\ 13.21 \\ \hline 4.17 \end{array}$$

$$\begin{array}{r} 16.97 \\ 11.32 \\ \hline 28.29 \\ 3.61 \\ \hline 24.68 \end{array}$$



TRIGONOMETRIC FORMULÆ

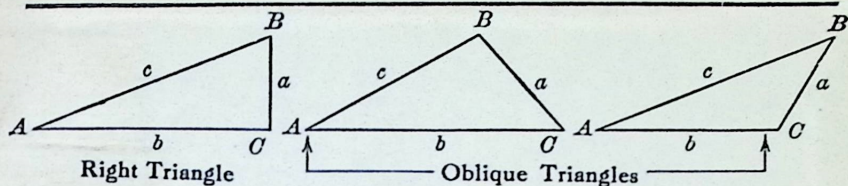

Solution of Right Triangles

For Angle A. $\sin = \frac{a}{c}$, $\cos = \frac{b}{c}$, $\tan = \frac{a}{b}$, $\cot = \frac{b}{a}$, $\sec = \frac{c}{b}$, $\operatorname{cosec} = \frac{c}{a}$

Given
 a, b

Required
 A, B, c

$$\tan A = \frac{a}{b} = \cot B, c = \sqrt{a^2 + b^2} = a \sqrt{1 + \frac{b^2}{a^2}}$$

a, c

A, B, b

$$\sin A = \frac{a}{c} = \cos B, b = \sqrt{(c+a)(c-a)} = c \sqrt{1 - \frac{a^2}{c^2}}$$

A, a

B, b, c

$$B = 90^\circ - A, b = a \cot A, c = \frac{a}{\sin A}$$

A, b

B, a, c

$$B = 90^\circ - A, a = b \tan A, c = \frac{b}{\cos A}$$

A, c

B, a, b

$$B = 90^\circ - A, a = c \sin A, b = c \cos A$$

Solution of Oblique Triangles

Given
 A, B, a

Required
 b, c, C

$$b = \frac{a \sin B}{\sin A}, C = 180^\circ - (A + B), c = \frac{a \sin C}{\sin A}$$

A, a, b

B, c, C

$$\sin B = \frac{b \sin A}{a}, C = 180^\circ - (A + B), c = \frac{a \sin C}{\sin A}$$

a, b, C

A, B, c

$$A + B = 180^\circ - C, \tan \frac{1}{2}(A - B) = \frac{(a - b) \tan \frac{1}{2}(A + B)}{a + b}$$

$$c = \frac{a \sin C}{\sin A}$$

a, b, c

A, B, C

$$s = \frac{a + b + c}{2}, \sin \frac{1}{2}A = \sqrt{\frac{(s - b)(s - c)}{bc}}$$

$$\sin \frac{1}{2}B = \sqrt{\frac{(s - a)(s - c)}{ac}}, C = 180^\circ - (A + B)$$

a, b, c

Area

$$s = \frac{a + b + c}{2}, \text{area} = \sqrt{s(s - a)(s - b)(s - c)}$$

A, b, c

Area


$$\text{area} = \frac{bc \sin A}{2}$$

A, B, C, a

Area

$$\text{area} = \frac{a^2 \sin B \sin C}{2 \sin A}$$

REDUCTION TO HORIZONTAL

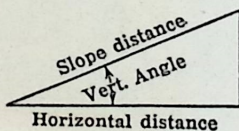

Horizontal distance = Slope distance multiplied by the cosine of the vertical angle. Thus: slope distance = 319.4 ft. Vert. angle = $5^\circ 10'$. From Table, Page IX. $\cos 5^\circ 10' = .9959$. Horizontal distance = $319.4 \times .9959 = 318.09$ ft. Horizontal distance also = Slope distance minus slope distance times (1 - cosine of vertical angle) With the same figures as in the preceding example, the following result is obtained. $\cos 5^\circ 10' = .9959$. $1 - .9959 = .0041$. $319.4 \times .0041 = 1.31$. $319.4 - 1.31 = 318.09$ ft.

When the rise is known, the horizontal distance is approximately:—the slope distance less the square of the rise divided by twice the slope distance. Thus: rise = 14 ft., slope distance = 302.6 ft. Horizontal distance = $302.6 - \frac{14 \times 14}{2 \times 302.6} = 302.6 - 0.32 = 302.28$ ft.