

Book 93 Dr16

OFFICE OF COUNTY ENGINEER
RAMSEY CO. MINN.

Location.....Survey
Fence

Vadnais Boulevard

From Sta 57+00 To Sta 63

Road Acc't. No. 6

Date Filed. 1-30-43

File.....

Pansey County Engineer

Align

Vadnais Blvd

Sta 57+40.25 To Sta 63+00

HAW

AM

LC

LL

12-15-42

Sta	Pt	ΔL	ΔR
-----	----	------------	------------

+30.67	P.T		
--------	-----	--	--

+25			
-----	--	--	--

59			
----	--	--	--

58+77.30	P.I		
----------	-----	--	--

		38°24'	
--	--	--------	--

+75			
-----	--	--	--

+50			
-----	--	--	--

+25			
-----	--	--	--

58+17.70	P.C		
----------	-----	--	--

57+40.25	P.O.T		
----------	-------	--	--

			A 38°24' L
--	--	--	------------



			D 34
--	--	--	------

			T 57.57
--	--	--	---------

			L 112.94
--	--	--	----------

			R
--	--	--	---

Description

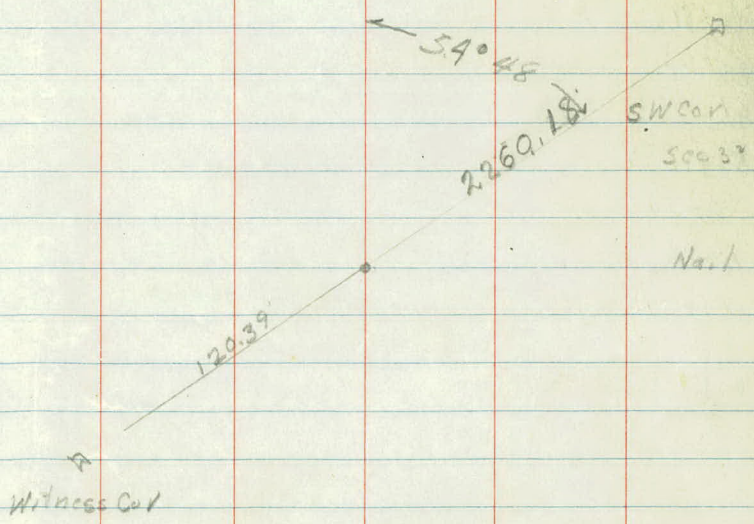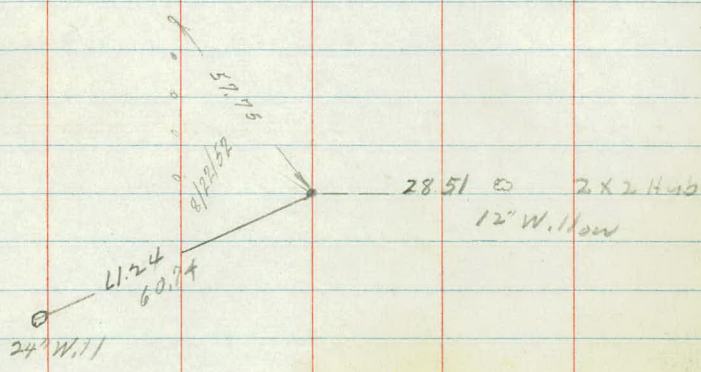


Sta	Pt	ΔL+	ΔR+
-----	----	-----	-----


65+33.60	P.1		
----------	-----	--	--


+8182	P.T	14°48'30"	
+50		12°16	
61		8°16	
60+91.67	P.1	29°37	Δ 29°37
+50		4°16	D 16
60		0°16	T 94.96
59+96.71	P.C	0°00	L 125.11

Description

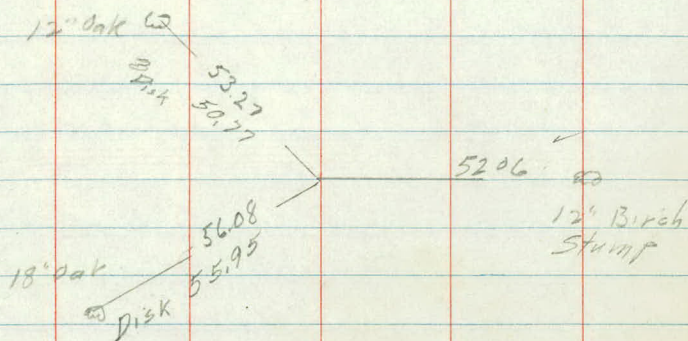

24" Willow 3tn

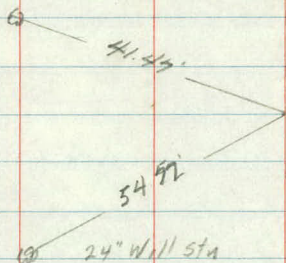

 

Ramsey County Engineer

4

Topography

Vadnais Blvd

Sta 57+40.25 To 63+00

6.3 2982 12 0 G Rail

+50	40	12'	10'	
62	47	13'	10	
+75	51	15'	10'	
+50	53	15	10'	
+25	56	14'	10'	
61	60	14'	11'	
+75	59'	14	11'	
+50	58'	13'	11'	
+25	55	12'	11'	+25 End GR 14
60	52	13'	11'	14'
+50	49'	12'	10'	14'
+25	50'	13'	8'	13
59	49'	14'	7	11'
+75	47'	15'	7'	11'
+50	47'	15'	7'	11'
+25	49'	15'	10'	13'
58	51'	11'	11	14
+75	52'			
+40.25		13	13	14


57
56 (7)
14

+10 End Fe 25.8
 +00 Fe 26.6
 +75 Fe 28.1
 +50 Fe 30.1
 +25 Fe 30.5
 +00 Fe 30.3
 +75 Fe 29.7
 +50 Fe 28.3
 +25 Fe 25.7
 +00 Fe 24
 PC +94 23.8
 +50 Fe 24.2
 PT +21 Fe 25.9
 +25 Fe 26.3
 +00 Fe 26.8
 +75 Fe 25.4
 +50 Fe 25
 +28 15" CM 24' x 44'
 +17 Fe 27.6
 +00 Fe 29
 +97 J.E. Cor Shed 44
 +79 S.W. Cor Shed 41
 +64.25 Bag Fe 33

Vadnais Lake

+90 End Fe 25.5
 +50 Fe 24.0
 62 +00 Fe 21.6
 +75 Fe 21.1
 +50 Fe 21.0
 +25 Fe 22.7
 61 +00 Fe 26.4
 +75 Fe 28.6
 +50 Fe 27.6
 +25 Fe 25.5
 60 Fe 24
 +94 Fe 24
 +50 Fe 23.2
 +31 Fe 21.9
 +25 Fe 21.9
 59 +00 Fe 22.1
 +75 Fe 23.2
 +50 Fe 25.3
 58 +17 Fe 31.6
 Fe 30.8
 +40.25 Bag Fe 29.9

Woods

 

Field Notes

Est. W¹/₄ Cor. Sec. 32

T 30 R 29

Measured

Mon
21000 M

2637.40 M

Meander Cor
Mon

473.42

472.6 R

2622.75 M

Can
Sec 32

257.57

Witness Cor

2380.57 M

Record

7

S W Cor Sec 29

210.00 R

Witness Cor

30

Meander Cor #30

2398

Cor
Sec
32

Meander Cor

Sec 31

472.6

W 1/4 Sec 32

262+47 R

23085 R


Meander Cor

2715 R

Witness Cor

2380.00 R

S. W Cor Sec 32

 

A Traverse
Notes

South Property line
for Road Easement

Sta	Pt	Dist	Alt	Δ Rt	True Bearing
-----	----	------	-----	------	--------------

66.27'

S 46° 43' E

C	P.I.		15° 39'		
---	------	--	---------	--	--

46.38

S 31° 04' E

B	P.I.		31° 04'		
---	------	--	---------	--	--

142.65'

S 0° 00' E

A	P.I.		0° 00'		
---	------	--	--------	--	--

Description

Nail

Nail

142.65
West Line Sec. 32

Meander Cor

Sta	Pt	Dist	ΔL	ΔR	True Bearing
-----	----	------	------------	------------	--------------

28.79'

N 76° 14' E

G

10° 21'

72.00

N 86° 35' E

F

P.1

3° 18'

87.83

N 89° 53' E

E

P.1

14° 41'

70.94

S 75° 26' E

D

P.1

28° 43'

Description

Hub

Sta	Pt.	Dist	ΔL	ΔR	True Bearing
-----	-----	------	------------	------------	--------------

H

93.08

N 87° 45' W

I

P.I

147° 41'

195.61'

N 59° 54' E

H


P.I

16° 20'

(closure to
B Traverse)

No. 1

No. 1

 

North Easement
Line

B Traverse

Sta	Pt	Dist	Alt	AR	True Bearings
-----	----	------	-----	----	---------------

D

25°34'

45.94

S 34°47' E

C

2°37'

102.95

S 32°10' E

B

32°10'

45.10

S 00°00' E

A

Description

IV

Meander Cor

Sta	Pt	Dist	ΔL	ΔR	True Bearing
-----	----	------	------------	------------	--------------

H

$29^{\circ}30'$

40.79

N $62^{\circ}46'15''$

G

$8^{\circ}11'$

133.41

N $70^{\circ}57'15''$

F

$21^{\circ}08'$

125.17

S $87^{\circ}55'15''$

E

$27^{\circ}34'$

42.16

S $10^{\circ}21'15''$

Description


Sta	Pt	Dist	ΔL	ΔR	True Bearings
-----	----	------	------------	------------	---------------

93.08

87045-E

Description

Closure to
A Traverse

 

Water Dept
Irons
At Vadnais Blvd

As Locate From Est Prop Line

