

Book 98 Dr 16

OFFICE OF COUNTY ENGINEER
RAMSEY CO. MINN.

Align Survey

Minn Home for Blind
In City of St. Paul
From To

Road Acc't. No.


Date Filed 1-30-43


File


Align
For Road.
Min Home For Blind

6-66-42
HAW

Drawn up.
June 20-1942

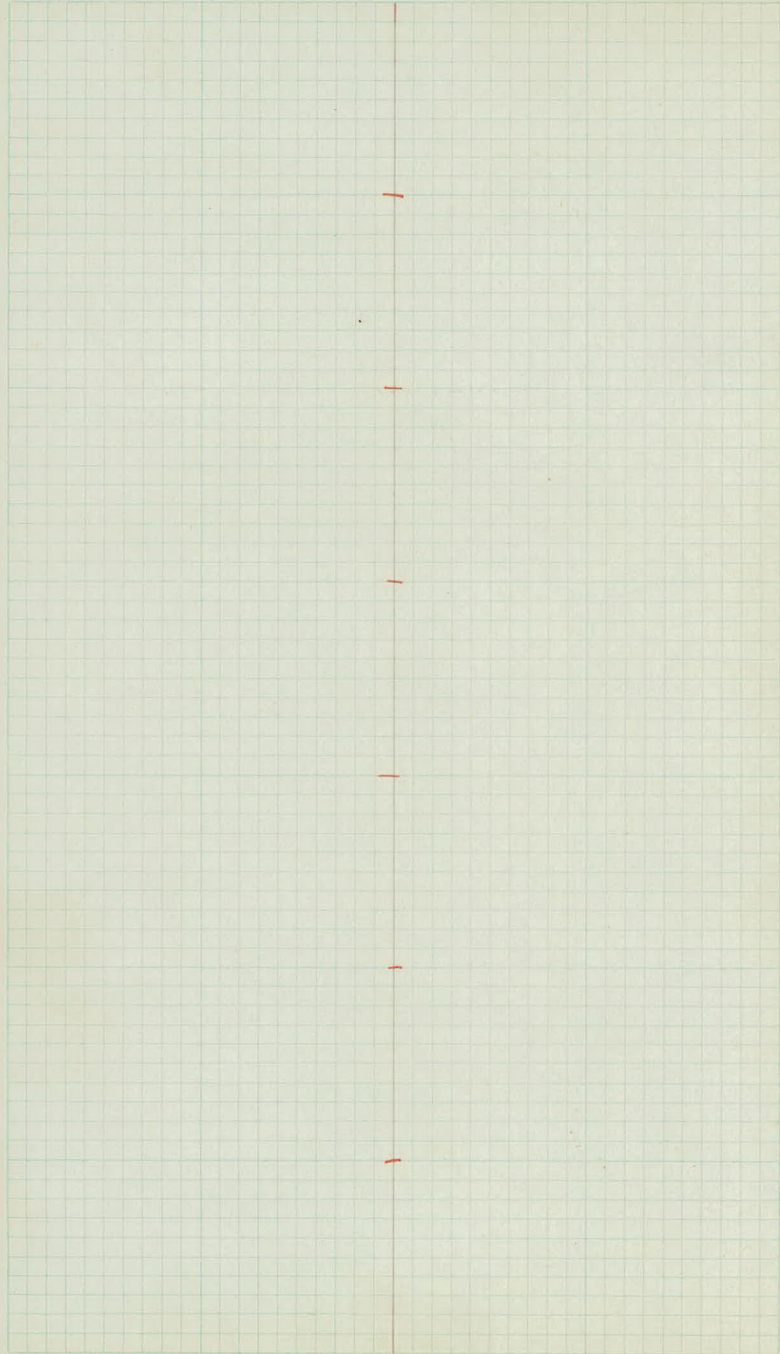

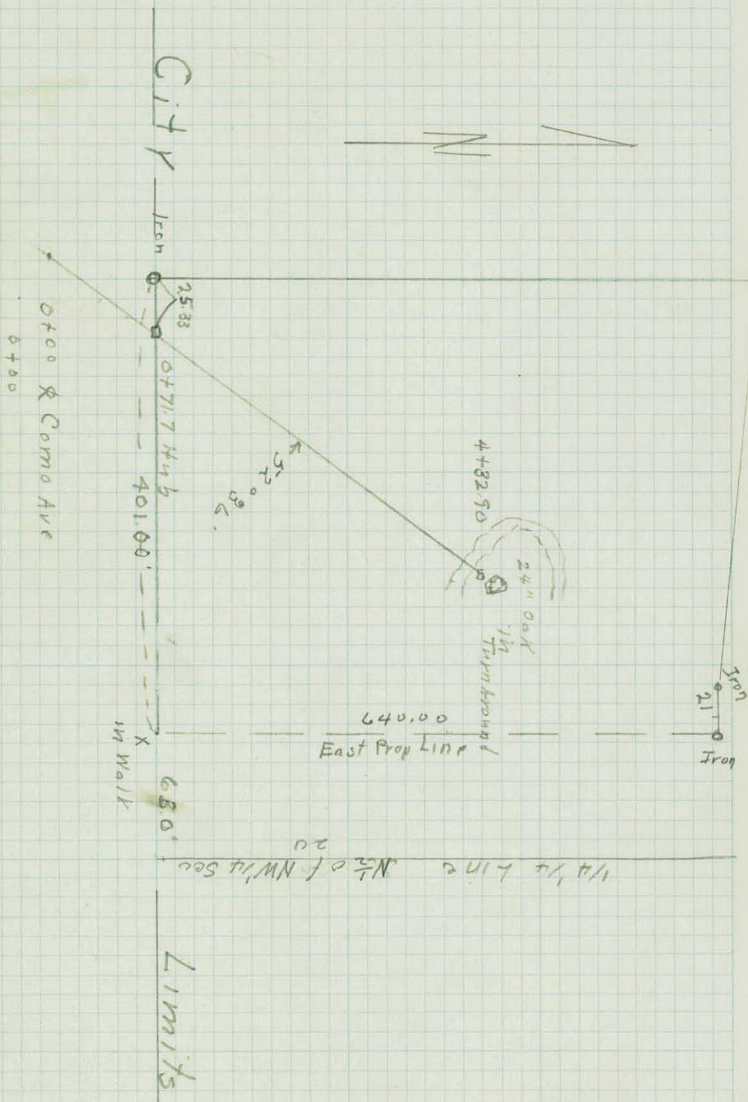

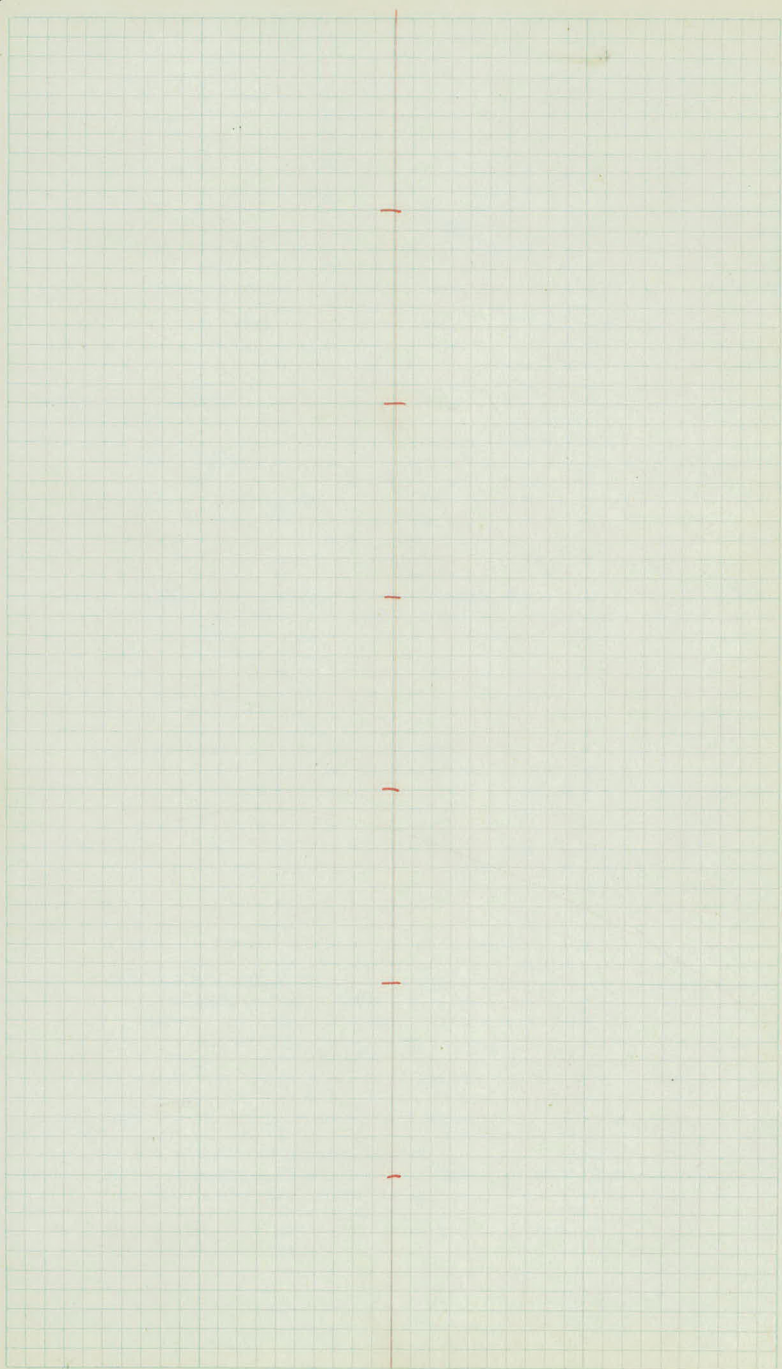

Topography

Minn Home For Blind

Corn & Eastis Ave
ST. Paul

6-16-42
HAW
LC
AM
CF

+64 Edge Turn Around

+51 " " "

+38 20" Oak

+32 Edge Turn Around

+18 W. Edge Turn Around

4

3

2

1


+38 2' Ditch X

+24.6 Curb X

0+00

± 8° Curve
Como Ave

(4)

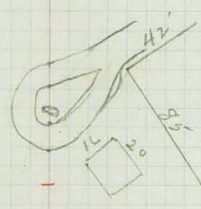

+60 Main Bldg 37'
+24 N.E. Gar 32'
+12 N.W. Gar 19'
+70 S.W. Cor Bldg 85'

+54 10" Pop 1'


10

+24 5th 6'

17 0

+26 30" Oak 4'
+03 24" Oak 25'

+28 Ditch 19'
+20 G Pole 26'
+00 Curb 71'

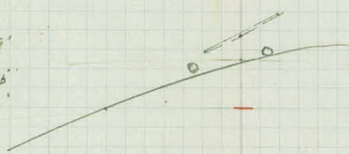

+47 Ditch 19'
+37 36" Maple 26'
+30 G Pole 13'
+ Como Ave

