

OFFICE OF
RAMSEY COUNTY ENGINEER
CONSTRUCTION NOTES
PRESCOTT CONNECTION

CO. PROJECT 23-60
FILE No. 4

ENGINEERS'
FIELD BOOK
No. 10403

EUGENE DIETZGEN CO.

DRAWING MATERIALS, MATHEMATICAL and
SURVEYING INSTRUMENTS

Chicago New York San Francisco New Orleans Pittsburg Toronto

Distances from Center of Roadway for Cross-Sectioning
Roadway 16 feet wide. Side Slopes 1 on 1.
For Single Track Embankment.

H	0	.1	.2	.3	.4	.5	.6	.7	.8	.9	H
0	8.0	8.1	8.2	8.3	8.4	8.5	8.6	8.7	8.8	8.9	0
1	9.0	9.1	9.2	9.3	9.4	9.5	9.6	9.7	9.8	9.9	1
2	10.0	10.1	10.2	10.3	10.4	10.5	10.6	10.7	10.8	10.9	2
3	11.0	11.1	11.2	11.3	11.4	11.5	11.6	11.7	11.8	11.9	3
4	12.0	12.1	12.2	12.3	12.4	12.5	12.6	12.7	12.8	12.9	4
5	13.0	13.1	13.2	13.3	13.4	13.5	13.6	13.7	13.8	13.9	5
6	14.0	14.1	14.2	14.3	14.4	14.5	14.6	14.7	14.8	14.9	6
7	15.0	15.1	15.2	15.3	15.4	15.5	15.6	15.7	15.8	15.9	7
8	16.0	16.1	16.2	16.3	16.4	16.5	16.6	16.7	16.8	16.9	8
9	17.0	17.1	17.2	17.3	17.4	17.5	17.6	17.7	17.8	17.9	9
10	18.0	18.1	18.2	18.3	18.4	18.5	18.6	18.7	18.8	18.9	10
11	19.0	19.1	19.2	19.3	19.4	19.5	19.6	19.7	19.8	19.9	11
12	20.0	20.1	20.2	20.3	20.4	20.5	20.6	20.7	20.8	20.9	12
13	21.0	21.1	21.2	21.3	21.4	21.5	21.6	21.7	21.8	21.9	13
14	22.0	22.1	22.2	22.3	22.4	22.5	22.6	22.7	22.8	22.9	14
15	23.0	23.1	23.2	23.3	23.4	23.5	23.6	23.7	23.8	23.9	15
16	24.0	24.1	24.2	24.3	24.4	24.5	24.6	24.7	24.8	24.9	16
17	25.0	25.1	25.2	25.3	25.4	25.5	25.6	25.7	25.8	25.9	17
18	26.0	26.1	26.2	26.3	26.4	26.5	26.6	26.7	26.8	26.9	18
19	27.0	27.1	27.2	27.3	27.4	27.5	27.6	27.7	27.8	27.9	19
20	28.0	28.1	28.2	28.3	28.4	28.5	28.6	28.7	28.8	28.9	20
21	29.0	29.1	29.2	29.3	29.4	29.5	29.6	29.7	29.8	29.9	21
22	30.0	30.1	30.2	30.3	30.4	30.5	30.6	30.7	30.8	30.9	22
23	31.0	31.1	31.2	31.3	31.4	31.5	31.6	31.7	31.8	31.9	23
24	32.0	32.1	32.2	32.3	32.4	32.5	32.6	32.7	32.8	32.9	24
25	33.0	33.1	33.2	33.3	33.4	33.5	33.6	33.7	33.8	33.9	25
26	34.0	34.1	34.2	34.3	34.4	34.5	34.6	34.7	34.8	34.9	26
27	35.0	35.1	35.2	35.3	35.4	35.5	35.6	35.7	35.8	35.9	27
28	36.0	36.1	36.2	36.3	36.4	36.5	36.6	36.7	36.8	36.9	28
29	37.0	37.1	37.2	37.3	37.4	37.5	37.6	37.7	37.8	37.9	29
30	38.0	38.1	38.2	38.3	38.4	38.5	38.6	38.7	38.8	38.9	30
31	39.0	39.1	39.2	39.3	39.4	39.5	39.6	39.7	39.8	39.9	31
32	40.0	40.1	40.2	40.3	40.4	40.5	40.6	40.7	40.8	40.9	32
33	41.0	41.1	41.2	41.3	41.4	41.5	41.6	41.7	41.8	41.9	33
34	42.0	42.1	42.2	42.3	42.4	42.5	42.6	42.7	42.8	42.9	34
35	43.0	43.1	43.2	43.3	43.4	43.5	43.6	43.7	43.8	43.9	35
36	44.0	44.1	44.2	44.3	44.4	44.5	44.6	44.7	44.8	44.9	36
37	45.0	45.1	45.2	45.3	45.4	45.5	45.6	45.7	45.8	45.9	37
38	46.0	46.1	46.2	46.3	46.4	46.5	46.6	46.7	46.8	46.9	38
39	47.0	47.1	47.2	47.3	47.4	47.5	47.6	47.7	47.8	47.9	39
40	48.0	48.1	48.2	48.3	48.4	48.5	48.6	48.7	48.8	48.9	40

Example—If point is 22.6 ft. above grade, how far should it be from center line to be a slope stake point? Ans. from Table 30.6. For same slopes but other widths of roadbed, correct above figures by one-half difference in width of roadbed; thus in example above, for 20 ft. roadbed distance will be $30.6 + (20 - 16) \div 2$ or 2 ft. added to $30.6 = 32.6$. For slopes of 1 on 1½ see inside of back cover.

Copyright, 1914, by Eugene Dietzgen Co.


Book

Book No 3

Pooj. 223-60


10-11-24

to 56+00 full
55+50 10 sub.

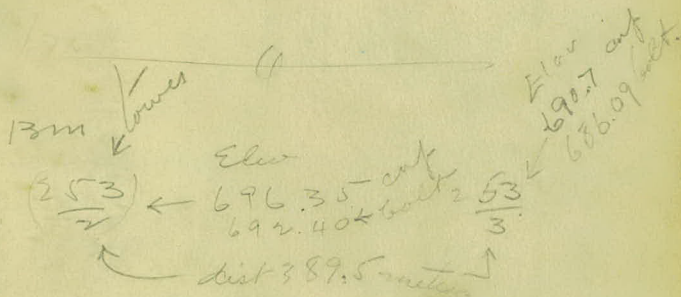

$\frac{253}{4}$ { 706.48 cup back of cemetery
702.51 bolt.

Date 1889

 

Index

Sta to Sta.	Description	Page to Page
	Levels - June Est.	2 5
1410 2+75	X-Levels for Class.	6
120± 122±	" " "	7 8
	Levels June Est.	9
	" May Est.	10
116± 130±	" Proposed Grade Change	11 14
	" for Class.	15
27+90 28+62	" " "	15
	Notes MFB on App. 110+50 Lt	16 17
39± 48±	Levels on Rock	18 19
3	" July Est.	20
104	F.E. Lt. Final	54.
58+60-60+00	Lt. Original X Levels borrow pit	55 ✓
29 30+30	Ramsey Co. Borrow Pit Lt.	61 ✓
63 66+	Orig. X sect. borrow pit Rt.	62 ✓ ✓
64 66+	✓ ✓ ✓ ✓ ✓ Lt.	63 ✓
59 60+50	✓ ✓ ✓ ✓ ✓ Rt.	69 ✓
27 28	Classified Material	70

Cross Sections

Sta.

B. S.

H. I.

F. S.

Grade

Gr. R.

X-Levels - June Est. #2
Leaves

Sections

Sta.	B. S.	H. I.	F. S.	Grade	Gr. R.
------	-------	-------	-------	-------	--------

BM.	058	883.67		883.09	
-----	-----	--------	--	--------	--

93+75			8.0	875.7	
-------	--	--	-----	-------	--

94			4.8	878.9	
----	--	--	-----	-------	--

94+50			6.6	877.1	
-------	--	--	-----	-------	--

95			8.2	875.5	
----	--	--	-----	-------	--

95+50			6.5	877.2	
-------	--	--	-----	-------	--

96			7.4	876.3	
----	--	--	-----	-------	--

96+35			7.8		
-------	--	--	-----	--	--

+56 = End Exc.

Inst.

Rod.

Chain.

6 1/2 ft Rain

2

Left

d L

Right

$$\frac{8.7}{23}$$

80

$$\frac{7.3}{18}$$

$$\frac{8.7}{21}$$

$$\frac{8.8}{27}$$

$$\frac{\text{Old Ground}}{3}$$

4.8

$$\frac{7.6}{6}$$

$$\frac{8.7}{26}$$

$$\frac{\text{O. Ground}}{4}$$

6.6

$$\frac{7.4}{8}$$

$$\frac{7.5}{16}$$

$$\frac{8.3}{20}$$

$$\frac{8.3}{25}$$

$$\frac{\text{O. Ground}}{5}$$

8.2

$$\frac{7.5}{13}$$

$$\frac{9.0}{18}$$

$$\frac{8.4}{24}$$

6.5

$$\frac{6.6}{15}$$

$$\frac{7.5}{17}$$

$$\frac{8.0}{25}$$

7.4

$$\frac{2.7}{16}$$

$$\frac{9.3}{21}$$

$$\frac{9.4}{26}$$

7.8

$$\frac{7.7}{15}$$

$$\frac{9.5}{20}$$

$$\frac{9.6}{23}$$

X-Levels June Est. #2

Sta.	B. S.	H. I.	F. S.	Grade	Gr. R.
------	-------	-------	-------	-------	--------

Cross Sections

B.17	12.68	861.09		848.41	
------	-------	--------	--	--------	--

105+50

105+25

105

TP	12.22	872.29	1.02	860.07	
----	-------	--------	------	--------	--

104+75

104+50

104

103+50

103

102+50

102

101+50

101+30: End Excav. Abruptly.

Inst. Nesbitt
 Rod Abilberg
 Chain Nelson - Down

6/24/24

1 left

G L

Right

Spike 15" Oak 50' L-105+75

$$\begin{array}{r} 72 \\ \underline{74} \end{array} \quad \begin{array}{r} 853.8 \\ \underline{7.3} \end{array} \quad \text{old ground}$$

$$\begin{array}{r} 3.0 \\ \underline{2.5} \end{array} \quad \begin{array}{r} 3.2 \\ \underline{7} \end{array} \quad \begin{array}{r} 5.4 \\ \underline{3} \end{array} \quad \begin{array}{r} 855.7 \\ \underline{5.4} \end{array} \quad \begin{array}{r} 40 \\ \underline{19} \end{array} \quad \begin{array}{r} \text{old ground} \\ \underline{26} \end{array}$$

$$\begin{array}{r} 858.9 \\ \underline{0.6} \\ \underline{6} \end{array} \quad \begin{array}{r} 2.2 \\ \underline{6} \end{array} \quad \begin{array}{r} 1.2 \\ \underline{30} \end{array}$$

$$\begin{array}{r} 861.6 \\ \underline{0.6} \\ \underline{8} \end{array} \quad \begin{array}{r} 1.3 \\ \underline{8} \end{array} \quad \begin{array}{r} 10.8 \\ \underline{29} \end{array}$$

$$\begin{array}{r} 863.4 \\ \underline{0.6} \\ \underline{5} \end{array} \quad \begin{array}{r} 8.9 \\ \underline{8} \end{array} \quad \begin{array}{r} 8.5 \\ \underline{30} \end{array}$$

$$\begin{array}{r} 866.0 \\ \underline{0.6} \\ \underline{8} \end{array} \quad \begin{array}{r} 6.3 \\ \underline{17} \end{array} \quad \begin{array}{r} 6.3 \\ \underline{31} \end{array}$$

$$\begin{array}{r} 867.7 \\ \underline{0.6} \\ \underline{4} \end{array} \quad \begin{array}{r} 4.6 \\ \underline{7} \end{array} \quad \begin{array}{r} 4.7 \\ \underline{28} \end{array}$$

$$\begin{array}{r} 868.8 \\ \underline{0.6} \\ \underline{5} \end{array} \quad \begin{array}{r} 3.5 \\ \underline{8} \end{array} \quad \begin{array}{r} 3.5 \\ \underline{29} \end{array}$$

$$\begin{array}{r} 870.2 \\ \underline{0.6} \\ \underline{2} \end{array} \quad \begin{array}{r} 2.1 \\ \underline{5} \end{array} \quad \begin{array}{r} 1.8 \\ \underline{29} \end{array}$$

$$\begin{array}{r} 870.9 \\ \underline{0.6} \\ \underline{3} \end{array} \quad \begin{array}{r} 1.4 \\ \underline{3} \end{array} \quad \begin{array}{r} 1.0 \\ \underline{26} \end{array}$$

$$\begin{array}{r} 871.4 \\ \underline{0.6} \\ \underline{4} \end{array} \quad \begin{array}{r} 0.9 \\ \underline{2} \end{array} \quad \begin{array}{r} 0.8 \\ \underline{24} \end{array}$$

*Levels for June Est. #2
 Gross Sections.

Sta. B. S. I I F S. Grade Gr. R.

TP 11.36 844.46 833.10
 TP 11.50 855.02 0.94 843.52

123 8.1 846.9

122+75 4.3 850.7

TP 2.10 854.21 2.91 852.11

122+40 0.8 853.4

122+20 0.9 853.2

121+85 2.3 851.9

121+65 3.0 851.2

121+35 3.9 850.3

120+80 6.5 847.7

120+50 8.9 845.3

120+25 9.8 844.4

Rod.
Chain.

Left C L Right

→ 8.1 $\frac{64}{8}$ $\frac{39}{14}$ $\frac{48}{18}$ $\frac{42}{32}$ toe ←

→ $\frac{100}{21}$ $\frac{66}{7}$ $\frac{43}{2}$ 4.3 $\frac{38}{10}$ $\frac{49}{12}$ $\frac{47}{30}$ toe ←

→ $\frac{0.6 \text{ Ground}}{15}$ 0.8 $\frac{0.4}{7}$ $\frac{47}{11}$ $\frac{47}{29}$ toe ←

→ $\frac{0.6 \text{ Ground}}{16}$ $\frac{3.8}{16}$ $\frac{2.2}{9}$ 0.9 $\frac{0.9}{6}$ $\frac{50}{12}$ $\frac{5.7}{29}$ toe ←

→ $\frac{0.6 \text{ Ground}}{19}$ $\frac{2.2}{16}$ $\frac{2.1}{14}$ $\frac{28}{10}$ 2.3 $\frac{2.3}{5}$ $\frac{5.4}{11}$ $\frac{5.6}{30}$ toe ←

→ $\frac{3.4}{18}$ 3.0 $\frac{3.2}{5}$ $\frac{5.9}{11}$ $\frac{5.7}{31}$ toe ←

→ $\frac{0.6 \text{ Ground}}{18}$ $\frac{5.2}{14}$ 3.9 $\frac{3.7}{3}$ $\frac{7.1}{8}$ $\frac{6.6}{28}$ toe ←

→ $\frac{0.6 \text{ Ground}}{24}$ $\frac{7.3}{17}$ 6.5 $\frac{2.7}{7}$ $\frac{2.3}{30}$ toe ←

→ $\frac{0.6 \text{ Ground}}{25}$ $\frac{8.5}{19}$ 8.9 $\frac{10.8}{6}$ $\frac{10.0}{31}$ toe ←

→ $\frac{0.6 \text{ Ground}}{20}$ $\frac{10.4}{19}$ 9.8 $\frac{11.9}{6}$ $\frac{11.4}{30}$ toe ←

..... Cross Sections

Sta.	B. S.	H. I.	F. S.	Grade	Gr. R.
------	-------	-------	-------	-------	--------

854.21

IP	0.45	845.55	9.11	845.10	
----	------	--------	------	--------	--

120			2.6	843.0	
-----	--	--	-----	-------	--

119+70			3.8	841.8	
--------	--	--	-----	-------	--

119+50			4.9	840.7	
--------	--	--	-----	-------	--

119+25			7.0	838.6	
--------	--	--	-----	-------	--

119			8.7	836.9	
-----	--	--	-----	-------	--

118+50			11.6	834.0	
--------	--	--	------	-------	--

IP			11.03	834.52	
----	--	--	-------	--------	--

118+20					
--------	--	--	--	--	--

Balance Complete.

Inst. Nesbitt
 Rod. Ahlberg
 Chain. Nelson-Dow

6/25/24

5

Left

C L

Right

$\frac{52}{18}$ 2.6 $\frac{49}{7}$ $\frac{44}{29}$ toe

$\frac{64}{20}$ 3.8 $\frac{38}{6}$ $\frac{52}{9}$ $\frac{55}{26}$ toe

$\frac{81}{22}$ 4.9 $\frac{49}{4}$ $\frac{75}{10}$ $\frac{70}{26}$ toe

$\frac{101}{21}$ $\frac{77}{12}$ 7.0 $\frac{70}{5}$ $\frac{82}{15}$ $\frac{83}{25}$ toe

$\frac{120}{20}$ $\frac{94}{11}$ 8.7 $\frac{87}{5}$ $\frac{93}{6}$ $\frac{94}{26}$ toe

$\frac{152}{20}$ $\frac{128}{2}$ 11.6 $\frac{114}{28}$ toe

X-Levels for Classification ^{Borris St.}
 Cross Sections

Sta.	B. S.	H. I.	F. S.	Grade	Gr. R.
B.M.	11.51	755.30		743.79	
1+16 = 00 of Rock					
1+25					
1+50			7.0	748.3	
1+75			5.0	750.3	
2+00			5.0	750.3	
2+25			6.0	749.3	
2+50			7.0	749.3	
+75 = 00 Rock					

Inst.
 Rod.
 Chain.

6/26/26

6

Left

C L

Right

Spk 36" Tree - L-35+30,
 8

$\frac{8.0}{19}$	$\frac{74.67}{8.6}$ $\frac{6}{6}$		$\frac{11.0}{14}$	$\frac{9.5}{1}$
------------------	--------------------------------------	--	-------------------	-----------------

	$\frac{2.9}{22}$	7.0	$\frac{7.7}{17}$	$\frac{8.5}{1}$
--	------------------	-----	------------------	-----------------

	$\frac{0.0}{18}$	5.0	$\frac{6.0}{8}$	$\frac{7.1}{1}$
--	------------------	-----	-----------------	-----------------

	$\frac{0.0}{19}$	5.0	$\frac{5.5}{8}$	$\frac{7.1}{1}$
--	------------------	-----	-----------------	-----------------

	$\frac{1.4}{23}$	6.0	$\frac{6.5}{7}$	$\frac{6.6}{1}$
--	------------------	-----	-----------------	-----------------

	$\frac{3.9}{22}$	7.0		$\frac{5.3}{1}$
--	------------------	-----	--	-----------------

Levels for Class

Sta.	B. S.	H. I.	Gross F. S.	Sections Grade	Gr. R.
TP	11.03	844.13		833.10	
TP	12.73	856.30	0.56	843.57	
B.M.			0.29	856.01 (856.33)	
TP	12.55	866.09	2.76	853.54	

122+20 00 of Rock.

121+85

121+65

121+35

120+80

120+60

120+25

TP	0.41	855.48	11.02	855.07	
----	------	--------	-------	--------	--

120+80

120+64

Inst.
Rod.
Chain.

Left

C L

Right

Hub.

Nail 6" - in oak. 75' R - 123 + 50

$$\begin{array}{r}
 851.1 \\
 \underline{15.0} \\
 7 \\
 868.6 \\
 \underline{17.5} \\
 16 \\
 847.6 \\
 \underline{18.5} \\
 12
 \end{array}$$

$$\begin{array}{r}
 857.9 \\
 \underline{8.2} \\
 42 \\
 853.1 \\
 \underline{8.0} \\
 444 \\
 857.5 \\
 \underline{8.6} \\
 440
 \end{array}$$

26.6

26.9

27.5

$$\begin{array}{r}
 860.6 \\
 \underline{15.5} \\
 4.7 \\
 862.6 \\
 \underline{3.5} \\
 48 \\
 841 \\
 \underline{12.0} \\
 440
 \end{array}$$

28.5

29.7

46.5

$\frac{90}{5}$ Present Elev. Rock
 Tree " " old
 Ground at 4.

(7.2)

Present Elev. Rock
 Tree Elev Rock old Ground

Cont from Page 7

Sta.	B. S.	H. I.	F. S.	Cross Sections	Gr. R.
		855.48			
120+50					
120+25					
126+00	00 Rock Excav.				

Inst.
Rod.
Chain.

Left

C L

Right

$\frac{843.8}{11.7}$ Point Elev
Rock.
Trug Elev
old Ground

$\frac{36.9}{18.6}$

$\frac{54.5}{1.0}$
 $\frac{3.6}{}$

$\frac{18.6}{}$

$\frac{19.1}{}$

Levels June Est. #2

Sta.	B. S.	H. I.	Gross Sections		Gr. R.
			F. S.	Grade	
B.M.	4.90	861.23		856.33	
			1		
126+50			10.0	851.2	
126+75			8.5	852.7	
127			7.0	854.2	
127+50 = 00 for Classification			0.2	861.0	
TP	12.85	873.07	1.01	860.22	
128			76	65.5	
+25			60	67.1	
+50			41	69.0	
129			34	69.7	
+50			17	71.4	
130 = 00 for Classification			0.5	72.6	
+50			0.0	73.1	

Inst.
 Rod.
 Chain.

6/27/24

9

Left

C L

Right

$\frac{0.6 \text{ ground}}{22} \quad \frac{7.2}{20} \quad 10.0$

$\frac{0.6 \text{ ground}}{24} \quad \frac{4.8}{21} \quad 8.5$

$\frac{0.6 \text{ ground}}{27} \quad \frac{3.5}{22} \quad 7.0$

$\frac{0.1}{29} \quad 0.2 \quad \frac{1.1}{25}$

$\frac{7.0}{31} \quad \frac{6.5}{24} \quad \frac{8.1}{7} \quad 7.6 \quad \frac{8.2}{3.5} \quad \frac{13.2}{}$
 ← top rock →

$\frac{4.9}{32} \quad \frac{5.8}{15} \quad \frac{6.8}{8} \quad 6.0 \quad \frac{7.0}{35} \quad \frac{12.0}{}$
 ← top rock →

$\frac{3.0}{33} \quad \frac{4.0}{32} \quad 4.1 \quad \frac{6.2}{33} \quad \frac{10.6}{}$
 top rock

$\frac{1.7}{32} \quad \frac{3.4}{30} \quad \frac{3.4}{21} \quad 3.4 \quad \frac{4.7}{28} \quad \frac{8.2}{}$
 top rock

$\frac{1.3}{29} \quad \frac{2.5}{28} \quad \frac{2.2}{21} \quad 1.7 \quad \frac{3.1}{26} \quad \frac{5.1}{}$
 top rock

$\frac{1.7}{26} \quad 0.5 \quad \frac{1.7}{27}$

$\frac{0.8}{26} \quad 0.0 \quad \frac{0.0}{24}$

Levels for May Est. #1

Sta.	B. S.	H. I.	Gross F. S.	Sections Grade	Gr. R.
		873.07			
TP	11.08	883.70	0.45	872.62	
131+00	Profile Grade.				
	Balance Cut Complete to 136+00				
TP	11.53	894.07	1.16	882.54	
136+50			6.5	887.6	
137			4.5	889.6	
+50			3.8	890.3	
138			4.4	889.7	
+50			5.2	888.9	
139			6.5	887.6	
			5.37	888.70	
	Balance to end project complete				

Inst. Nasbit
Rod. Aspera
Chain. Volkert Dow.

10

6/27/25

Left

C L

Right

$$\frac{8.6}{24}$$

6.5

$$\frac{6.5}{29}$$

$$\frac{6.2}{27}$$

4.5

$$\frac{3.2}{31}$$

$$\frac{5.2}{26}$$

3.8

$$\frac{3.0}{30}$$

$$\frac{5.7}{27}$$

4.4

$$\frac{2.6}{30}$$

$$\frac{7.0}{26}$$

5.2

$$\frac{5.1}{27}$$

$$\frac{7.7}{26}$$

6.5

$$\frac{5.8}{26}$$

(888.89) Elev. Spika 10" Box Elder 75' R-142+75

Levels for Proposed Grade Change

Gross Sections

Sta.	B. S.	H. I.	F. S.	Grade	Gr. R.
BM.	0.38	883.71			
130+50				872.36	11.3
130				869.86	13.8
TP	2.31	874.37	1165	872.06	
129+50				867.36	7.0
129				864.86	9.5
128+50				862.36	12.0
128+25				861.11	13.3
128				859.86	14.5
TP	1.90	867.33	894	865.43	
-127+75				858.61	8.7
127+50	End Rock Excav.			857.36	10.0
127				854.86	12.4
126+75				853.64	13.7
	4.59		20.59		

Cross Sections

Sta.	B. S.	H. I. 867.33 ✓	F. S.	Grade	Gr. R.
TP	2.15	856.46	13.02	854.31	
126+50				852.46	4.0
126+25				851.34	5.1
B.M.			465	851.81	
126				850.27	6.2
125+75				849.25	7.21
125+50				848.29	8.17
125+25				847.37	9.09
125				846.51	9.95
TP	0.15	844.56	1205	844.41	
124+75				843.70	-1.1
124+50				844.94	-0.4
124+41				844.60	-0.04
124+25				844.23	0.33
124+07				843.70	

Cross Sections

Sta.	B. S.	H. I.	E. S.	Grade	Gr. R.
TP	10.34	844.56 854.07	0.83	843.73	
123+75				842.97	11.1
123+50				842.41	11.7
B.M.	2.11	858.44		836.33	
123				841.46	
TP	1.33	851.53	8.24	850.20	
122+75				841.02	
122+40				840.78	
122+20				840.10	
121+85				839.51	
121+65				839.17	
121+35				838.60	
120+80				837.60	
120+50				836.94	
120+25				836.40	

Levels for sub grade etc.

Inst.
 Rod.
 Chain.

Left

C L

Right

$\frac{15.9}{26}$ $\frac{15.5}{9}$ $\frac{842.3}{11.8}$ $\frac{10.3}{3}$ $\frac{10.1}{18}$ $\frac{13.3}{23}$ $\frac{13.4}{31}$ $\frac{\text{old ground}}{32}$

$\frac{138}{20}$ $\frac{841.4}{12.7}$ $\frac{10.4}{7}$ $\frac{9.8}{255}$

Nail Oak 75' R-123+50

$\frac{16.0}{20}$ $\frac{426}{158}$ $\frac{15.8}{3}$ $\frac{9.1}{7}$ $\frac{8.0}{31}$

$\frac{6.4}{20}$ $\frac{8.1}{17}$ $\frac{43.8}{80}$ $\frac{8.0}{3}$ $\frac{1.0}{10}$ $\frac{1.0}{31}$

$\frac{8.5}{23}$ $\frac{439}{7.6}$ $\frac{7.6}{3}$ $\frac{1.0}{8}$ $\frac{1.7}{29}$

$\frac{9.0}{23}$ $\frac{428}{8.7}$ $\frac{0.6}{10}$ $\frac{2.4}{20}$ $\frac{2.2}{29}$

$\frac{9.3}{25}$ $\frac{423}{9.2}$ $\frac{1.4}{9}$ $\frac{2.4}{30}$

$\frac{9.4}{26}$ $\frac{418}{9.7}$ $\frac{1.9}{7}$ $\frac{2.9}{29}$

$\frac{10.5}{22}$ $\frac{10.7}{8}$ $\frac{440}{7.5}$ $\frac{4.5}{8}$ $\frac{3.8}{27}$

$\frac{10.8}{19}$ $\frac{410}{10.5}$ $\frac{5.0}{5}$ $\frac{4.5}{26}$

$\frac{11.7}{18}$ $\frac{406}{10.9}$ $\frac{7.5}{7}$ $\frac{2.3}{29}$

$\frac{15.0}{22}$ $\frac{15.2}{17}$ $\frac{14.7}{15}$ $\frac{374}{14.1}$ $\frac{8.3}{5}$ $\frac{9.2}{29}$

Cross Sections

Levels for Subgrade Etc.

Sta.	B.S.	HI	I.S.	Grade	Gr. R.
		851.53			
IP	2.95	841.82	1266	838.87	
120				835.76	
119+70				835.10	
119+50				834.44	
119+25				833.80	
119				832.99	
118+50				831.41	
IP	2.51	834.22	10.11	831.71	
118+20				830.41	
118				829.75	
117+80				829.20	
117+50				828.20	
117+35				827.60	
117+20				827.10	
116+86 ⁸				826.00	

X-Levels for Rock Classification

~~Cross Sections~~

Sta.	B. S.	H. I.	E. S.	Grade	Gr. R.
BM	0.70	738.74		738.04	
TP	1.55	727.29	13.00	725.74	
27+90					
28+15					
+38					
+62					

Inst. Nesbit
 Rod: Galena Nelson
 Chain: 200

7/15/24

15

Left

C L

Right

Nail Cotton wood 45' R-30 + 30

top Rock \swarrow \searrow \swarrow 17.3
 $\frac{8.0}{3}$ $\frac{19.3}{8.0}$ $\frac{6.6}{36}$

top Rock \swarrow \searrow \swarrow 16.6
 $\frac{7.3}{4}$ $\frac{20.6}{7.3}$ $\frac{4.3}{33}$

top Rock \swarrow \searrow \swarrow 15.9
 $\frac{7.2}{10}$ $\frac{21.1}{6.2}$ $\frac{4.2}{32}$

Levels for M^sBth App. 110+50 L

..... Cross Sections

Sta.	B. S.	H. I.	F. S.	Grade	Gr. R.
		833.91			
0+00					Point 15' L 110+50
0+25			2.4	831.5	
0+50			5.7	828.2	
0+75			7.7	826.2	
1+00			10.4	823.3	
IP	2.11	826.52	9.50	824.41	
1+25			6.1	820.4	
1+50			8.0	818.5	
1+75			9.0	817.5	
1+95			9.4	817.1	
2+15			10.3	816.2	
2+40			11.5	815.0	

Inst.
Rod.
Chain.

Left

C L

Right

McBeth App. Left 110+50

Cross Sections

Sta.	B. S.	H. I.	F. S.	Grade	Gr. R.
		834.07			
0+00				831.9	2.2
0+10				831.9	2.2
0+25				831.9	2.2
0+50	<u>Void</u>			829.93	4.2
0+75				827.97	6.1
	2.40	826.57	9.95	826.12	
1				826.00	0.5
1+25	See page 25			824.04	7.5
1+50				822.07	4.4
1+75				820.11	6.4
1+95				818.54	8.0
2+15				816.97	9.5
2+40				815.00	11.5

7.86%

Inst.
 Rod.
 Chain.

Left

C L

Right

$\left(\frac{-1.5}{10.3}\right)$	$\frac{3.7}{10.3}$	4.4	$\frac{24.9}{12.1}$	$\left(\frac{-2.7}{12.1}\right)$
$\left(\frac{0.0}{8.0}\right)$	$\frac{2.2}{8}$	2.5	$\frac{3.4}{9.8}$	$\left(\frac{-1.2}{9.8}\right)$
$\left(\frac{-1.2}{9.8}\right)$	$\frac{5.4}{9.8}$	5.9	$\frac{6.1}{10.4}$	$\left(\frac{-1.9}{10.9}\right)$
$\left(\frac{-1.5}{10.3}\right)$	$\frac{7.6}{10.3}$	7.8	$\frac{7.9}{10.7}$	$\left(\frac{-1.8}{10.7}\right)$
$\left(\frac{-3.3}{13.0}\right)$	$\frac{3.8}{13.0}$	3.0	$\frac{3.3}{12.2}$	$\left(\frac{-2.8}{12.2}\right)$
$\left(\frac{-3.7}{13.6}\right)$	$\frac{6.2}{13.6}$	6.1	$\frac{5.9}{13.1}$	$\left(\frac{-3.4}{13.1}\right)$
$\left(\frac{-3.8}{13.7}\right)$	$\frac{8.2}{13.7}$	8.0	$\frac{7.9}{13.3}$	$\left(\frac{-3.5}{13.3}\right)$
$\left(\frac{-2.8}{12.2}\right)$	$\frac{9.4}{12.2}$	9.0	$\frac{9.0}{11.9}$	$\left(\frac{-2.6}{11.9}\right)$
$\left(\frac{-1.5}{10.3}\right)$	$\frac{9.5}{10.3}$	9.4	$\frac{9.5}{10.3}$	$\left(\frac{-1.5}{10.3}\right)$
$\left(\frac{-0.5}{8.8}\right)$	$\frac{10.0}{8.8}$	10.3	$\frac{10.0}{8.8}$	$\left(\frac{-0.5}{8.8}\right)$
$\left(\frac{0.0}{8}\right)$	$\frac{11.2}{8}$	11.5	$\frac{11.2}{8}$	$\left(\frac{0.0}{8}\right)$

7/22-24

Rock Levels

39 - 48

Cross Sections

Sta.	B. S.	H. I.	F. S.	Grade	Gr. R.
------	-------	-------	-------	-------	--------

48

47+50

47

46+50

46

45+50

45

44+50

44

43+50

43

42

Inst.
Rod.
Chain.

Left

C L

Right

3.3 Rod

3.5

3.6

3.6

6.0

4.4

4.6

5.5 - 1.5 0.15

4.3 - 2.2

3.5 0.5

7.0 - 5.3

5.0

4/22-29

Rock Levels

39-48

Cross Sections

Sta.

B. S.

H. I.

F. S.

Grade

Gr. R.

41+50

39+70

39+25

39

Inst.
Rod.
Chain.

Left

C L

Right

5.6 - 4.5

5.0 - 3.0

6.0 - 1.5

5.5 - 1.0

Levels for July Est. Borrow Pit

Sta.	B. S.	Cross		Sections	Gr. R.
		H. I.	F. S.	Grade	
B.M.	108	851.89		850.81	
TP	103	843.66	9.26	842.63	
120+15	Beginning Dolite on Lt.				
120+25					
120+80					
121+35					
121+65					
122+20					
122+40					
122+75					
+80	End Dolite on Lt				

Inst.
Rod.
Chain.

Left

C L

Right

Top Coll Coping.

0.67

$\frac{98}{37}$	$\frac{6.6}{32}$	$\frac{6.4}{18}$
-----------------	------------------	------------------

0.67

$\frac{8.0}{40}$	$\frac{6.0}{37}$	$\frac{5.8}{17}$
------------------	------------------	------------------

0.67

$\frac{5.3}{114}$	$\frac{5.1}{22}$
-------------------	------------------

0.67

$\frac{5.9}{52}$	$\frac{4.8}{51}$	$\frac{4.8}{46}$	$\frac{4.3}{23}$
------------------	------------------	------------------	------------------

0.6.

$\frac{3.4}{43}$	$\frac{3.1}{22}$
------------------	------------------

0.67

$\frac{2.7}{47}$	$\frac{2.5}{23}$
------------------	------------------

0.67

$\frac{2.1}{36}$	$\frac{0.9}{16}$
------------------	------------------

X-Levels for July Est # 3

Cross Sections

Sta.	B. S.	H I.	F. S.	Grade	Gr. R.
B.M.	0.28	738.32		738.04	
	0.20	726.53	11.99	726.33	
27+50 = Beginning Excav. July Est.					
27+79					
+90					
28					
+15					
+38					
+62					
+67					
29					
+60					
TP	8.31	728.64	6.20	720.33	
30 to	32				
32 to	39+70				

Inst. Nesbitt
 Rod. Nelson
 Chain. Ahlborg-Dow

71

21

Left

C L

Right

toe slope

$$\begin{array}{r} 7189 \\ \underline{8.5} \end{array}$$

toe

$$\begin{array}{r} 76 \\ \underline{33} \end{array}$$

toe slope

$$\begin{array}{r} 722 \\ \underline{8} \end{array}$$

$$\begin{array}{r} 719.2 \\ \underline{7.3} \end{array}$$

toe

$$\begin{array}{r} 80 \\ \underline{33} \end{array}$$

toe

$$\begin{array}{r} 76 \\ \underline{10} \end{array}$$

$$\begin{array}{r} 719.4 \\ \underline{7.1} \end{array}$$

toe

$$\begin{array}{r} 75 \\ \underline{30} \end{array}$$

toe

$$\begin{array}{r} 71 \\ \underline{23} \end{array}$$

$$\begin{array}{r} 719.6 \\ \underline{6.9} \end{array}$$

toe

$$\begin{array}{r} 67 \\ \underline{31} \end{array}$$

Rock to Surface

$$\begin{array}{r} 64 \\ \underline{33} \end{array}$$

$$\begin{array}{r} 720.3 \\ \underline{6.2} \end{array}$$

toe

$$\begin{array}{r} 80 \\ \underline{21} \end{array}$$

toe

$$\begin{array}{r} 80 \\ \underline{31} \end{array}$$

$$\begin{array}{r} 67 \\ \underline{4} \end{array}$$

$$\begin{array}{r} 716.7 \\ \underline{9.8} \end{array}$$

toe

$$\begin{array}{r} 90 \\ \underline{34} \end{array}$$

toe

$$\begin{array}{r} 50 \\ \underline{32} \end{array}$$

$$\begin{array}{r} 4.7 \\ \underline{4} \end{array}$$

$$\begin{array}{r} 716.7 \\ \underline{9.8} \end{array}$$

toe

$$\begin{array}{r} 90 \\ \underline{34} \end{array}$$

(45.3)

$$\begin{array}{r} 30 \end{array}$$

$$\begin{array}{r} 5.6 \\ \underline{3} \end{array}$$

$$\begin{array}{r} 716.8 \\ \underline{10.2} \end{array}$$

toe

$$\begin{array}{r} 95 \\ \underline{33} \end{array}$$

toe

$$\begin{array}{r} 89 \\ \underline{29} \end{array}$$

$$\begin{array}{r} 716.0 \\ \underline{10.5} \end{array}$$

toe

$$\begin{array}{r} 103 \\ \underline{29} \end{array}$$

Cut 10 to Grade

" 00 to Grade

X-Leads App. South Hertzell St 322 for July Est

Sta.	B. S.	Cross		Sections	Gr. R.
		H. I.	F. S.	Grade	
TP	6.65	728.64 735.11	0.18	728.46	

0+17

+37

+67


+77

Inst.
 Rod.
 Chain.

Left

C L

Right

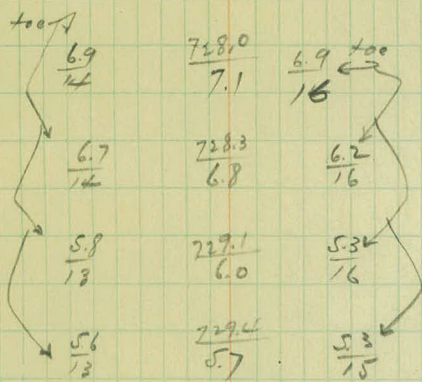

July Est.

1/25/24 x Levels Rock. 27+79 - 33

Cross Sections

Sta.	B. S.	H. I.	F. S.	Grade	Gr. R.
B.M.	2.51	740.55		738.04	
27+79					
28+62					
28+67					
29					
29+50					
30					
30+25					
30+50					
31					
31	5.61	743.65		738.04	
31+50					
32					

Inst.
 Rod.
 Chain.

Left

G L

Right

30.8

17.3
39

28.3

12.4
41

28.1

12.4
40

26.6

9.6

24.1

8.3
39

21.6

11.2
25

20.3

10.2
39

19.1

10.9
34

16.6

9.0
34

17.2

9.7
29

14.7

8.5
22

28.2
12.2
39

x Levels Rock

27+79. 33

Cross Sections

Sta.	B. S.	H. I.	F. S.	Grade	Gr. R.
------	-------	-------	-------	-------	--------

32+50

33

Inst.
Rod.
Chain.

Left

C L

Right

12.2

$\frac{85}{74}$

7.7

$\frac{73}{26}$

Levels for (M)^SBTH Approach

Sta.	B. S.	H. I.	Cross Sections		Gr. R.
			F. S.	^{Elev} Grade	
BM.	0.49	826.20		825.71	
0+25				821.5	
0+50				828.2	
0+75			0.0	826.2	
1			3.2	823.0	
+25			5.5	820.7	
+50			7.3	818.9	
+75			8.3	817.9	
2			8.7	817.5	
+25			10.0	816.2	
+50			11.7	814.5	
+75			13.3	812.9	
3			14.6	811.6	
+25			14.6	811.6	
+50			14.5	811.7	

BM.

Elev: 832.98

Inst.
Rod.
Chain.

7/28/24

20

Left

C L

Right

Tie point Nail 24" oak 50' L - 110 + 50

M^s Beth App. 110-50

Cross Sections

Sta.	B. S.	H. I.	F. S.	Grade	Gr. R.
BM	3.50	829.21		825.71	
0+00				31.9	
0+25				31.9	
0+50				30.15	-10
0+75				28.40	0.8
1				26.65	2.56
				23.15	6.06
2				19.65	9.56
P	0.60	818.81	11.00	818.21	
+25				17.90	0.9
+75				14.80	4.0
3				13.26	5.55
+25				11.72	7.1
+50					

Void

+50%
-7.00%

See page 29

In. t.
 Rod.
 Chain.

7/28/24

26

Left

C L

Right

16' top.

$$\frac{0.0}{8}$$

-0.3

$$\frac{-1.2}{9.8}$$

$$\frac{-1.6}{10.4}$$

-2.0

$$\frac{-2.2}{11.3}$$

$$\frac{-1.7}{10.6}$$

-2.2

$$\frac{-2.6}{11.9}$$

$$\frac{-3.2}{12.8}$$

-3.7

$$\frac{-3.4}{13.1}$$

$$\frac{-4.3}{14.5}$$

-4.3

$$\frac{-4.4}{14.6}$$

$$\frac{-2.4}{11.6}$$

-2.1

$$\frac{-2.9}{12.4}$$

$$\frac{-1.8}{10.7}$$

-1.7

$$\frac{-2.1}{11.2}$$

$$\frac{-2.7}{12.1}$$

-2.0

$$\frac{-1.7}{10.6}$$

$$\frac{-2.4}{11.6}$$

-1.6

$$\frac{-1.2}{9.8}$$

$$\frac{-0.6}{8.9}$$

-0.1

$$\frac{0.0}{8.0}$$

X-sec. for New Alignment

88 to 95

Cross Sections

Sta.	B. S.	H. I.	F. S.	Grade	Gr. R.
	766	882.40		874.74	
89				77.50	
+50				77.60	4.8
90				77.40	5.0
+50				76.90	5.5
91				76.10	6.3
+25				75.62	
+50				75.15	7.2
TP	0.26	870.42	12.23	870.17	
92				74.20	8.2
+25				73.72	
+50				73.37	-3.00
+75				73.23	
93				73.40	3.0
TP	11.67	881.10	1.00	869.43	
+25				73.75	

200' V.C. - 17 = 0.60

X=195

200' V.C.

..... Cross Sections

Sta.	B. S.	H. I.	F. S.	Grade	Gr. R.
93+25				73.75	
+50				74.47	
+75				75.30	
94				76.17	
+25				76.80	
+50				77.17	
+75				77.30	
95				77.17	
+25				76.80	

↗

+4.6%

150' V.C.

↘

-2.4%

Inst.
Rod.
Chain.

Left

C L

Right

-0.4
2.2

-0.6
2.2

-1.1
2.2

-1.1
2.4

-1.0
2.0

-0.8
2.0

-0.7
1.2

-0.4

X-500. 17⁵ Both App L+110+50

Cross Sections

Sta.	B. S.	H. I.	F. S.	Grade	Gr. R.
	0.43	833.41			
0+00				831.90	1.5
+16					
+25				830.10	3.3
+50				828.30	5.1
+75				826.50	6.9
				824.70	8.7
TP	1.30	822.40	12.31	821.10	
+25				822.90	
+50				821.10	1.3
+75				819.30	
2+00				817.50	4.9
+25				816.5	5.9
+75				812.9	9.5
3				811.5	10.9
+25				811.7	10.7

-7.2 %

Inst.
 Rod.
 Chain.

Arroyos
 2-Mormons

29

8/5/24

Left

G L

Right

832.98

$$\begin{array}{r} +100 \\ -12 \\ \hline +1.8 \\ 138 \end{array}$$

$$\begin{array}{r} +1.9 \\ -8 \end{array}$$

$$\begin{array}{r} +0.0 \\ +1.5 \end{array}$$

$$\begin{array}{r} +100 \\ -12 \\ \hline +0.2 \\ 122 \end{array}$$

$$\begin{array}{r} +0.4 \\ -12.4 \end{array}$$

$$0.0$$

$$\begin{array}{r} +0.0 \\ -12 \end{array}$$

$$\begin{array}{r} +0.3 \\ -12.3 \end{array}$$

$$-0.4$$

$$\begin{array}{r} -0.5 \\ -8.8 \end{array}$$

$$\begin{array}{r} -1.4 \\ -10.1 \end{array}$$

$$-1.7$$

$$\begin{array}{r} -1.3 \\ -10.0 \end{array}$$

$$\begin{array}{r} -2.4 \\ -11.6 \end{array}$$

$$-2.8$$

$$\begin{array}{r} -2.2 \\ -11.3 \end{array}$$

$$\begin{array}{r} -0.5 \\ -8.8 \end{array}$$

$$0.0$$

$$\begin{array}{r} -0.6 \\ -8.9 \end{array}$$

$$\begin{array}{r} -0.2 \\ -8.3 \end{array}$$

$$-0.3$$

$$\begin{array}{r} -0.6 \\ -8.9 \end{array}$$

$$\begin{array}{r} -0.6 \\ -8.9 \end{array}$$

$$0.0$$

$$\begin{array}{r} 0.0 \\ -8 \end{array}$$

$$\begin{array}{r} -0.4 \\ -8.6 \end{array}$$

$$0.0$$

$$\begin{array}{r} +0.5 \\ -8 \end{array}$$

$$\begin{array}{r} -0.6 \\ -8.9 \end{array}$$

$$0.0$$

$$\begin{array}{r} 0.0 \\ -8 \end{array}$$

Levels for Classification

Sta.	Cross			Sections	
	B. S.	H. I.	F. S.	Grade	Gr. R.
B.M.	7.47	855.88		848.41.	
105+50					
105+25					
TP	13.22	867.42	168	854.20	
105					
104+75					
104+50					
104					

Inst.
Rod.
Chain.

Left

C L

Right

$\frac{18}{26}$

4.0

$\frac{40}{25}$

$\frac{on\ slope}{0.0}$

0.6

$\frac{on\ slope}{0.0}$

$\frac{10.8}{on\ slope}$

$\frac{10.8}{on\ slope}$

$\frac{7.2}{on\ slope}$

$\frac{9.0}{on\ slope}$

$\frac{4.5}{on\ slope}$

4.2

$\frac{3.1}{on\ slope}$

2.9

8/11 - 24 Levels for Classification

		Cross Sections			
Sta.	B. S.	H. I.	F. S.	Grade	Gr. R.
	10150	858.91		848.41	
105+60 =	00	Rock			
105+50					
105+25					
105					
TP	10.54	868.84	0.61	858.30	
104+75					
104+50					
104+25					
104					
103+50					
103+20 =	00	Rock			

Note: 101+80 to 103+00 Ditch on RT. is Rock,

Inst.

Rod.

Chain.

Left

C L

Right

$$\frac{3.8}{24}$$

7.6

$$8.1$$

$$\frac{3.0}{26}$$

$$\frac{3.2}{29}$$

$$6.9$$

$$\frac{1.3}{30}$$

$$\frac{2.6}{27}$$

$$5.6$$

$$\frac{9.5}{28}$$

$$\frac{9.4}{29}$$

$$14.2$$

$$\frac{5.5}{29}$$

5.9

$$\frac{4.7}{29}$$

$$13.0$$

$$\frac{4.0}{30}$$

5.0

$$\frac{3.5}{29}$$

$$\frac{4.0}{30}$$

4.0

$$\frac{3.0}{30}$$

$$10.5$$

$$\frac{4.7}{27}$$

$$\frac{4.2}{28}$$

$$8.0$$

Add. X-506. Notes for Borrow Pit.

99+50-..... Cross Sections

Sta.	B. S.	H. I.	F. S.	Grade	Gr. R.
	7.48	880.18		872.70	
99+25-	00 of Borrow				
99+50:				7630	3.9
100				7517 -	5.0
100+50				7380	6.4
101				7217	8.0
TP.	1.34	874.04	748	872.70	
101+50				7030	3.7
102				6817	5.8
102+50				6580	8.2
103				6330	10.7
103+50				6080	
104				5830	
+25				5705	
+50				5580	

Inst. Nesbitt

Rod. Nelson

Chain 4010009 - Done

8/12/24

32

Left

C L

Right

$$\begin{array}{r} -3.0 \\ 68.9 \end{array} + \begin{array}{r} 2.1 \\ 64 \end{array} + \begin{array}{r} 0.6 \\ 45 \end{array} + \begin{array}{r} 1.9 \\ 26.9 \end{array}$$

$$\begin{array}{r} -3.0 \\ 71 \end{array} + \begin{array}{r} -1.5 \\ 65 \end{array} + \begin{array}{r} 4.4 \\ 37 \end{array} + \begin{array}{r} 4.9 \\ 29.8 \end{array}$$

$$\begin{array}{r} -2.6 \\ 63 \end{array} + \begin{array}{r} -1.6 \\ 61 \end{array} + \begin{array}{r} 0.2 \\ 26 \end{array} + \begin{array}{r} 2.7 \\ 42 \end{array} + \begin{array}{r} 4.7 \\ 29.7 \end{array} + \begin{array}{r} 1.5 \\ 29.7 \end{array}$$

$$\begin{array}{r} -2.3 \\ 37.5 \end{array} + \begin{array}{r} 0.2 \\ 30 \end{array} + \begin{array}{r} 1.0 \\ 26.0 \end{array} + \begin{array}{r} 1.7 \\ 26.0 \end{array}$$

$$\begin{array}{r} -2.2 \\ 42.5 \end{array} + \begin{array}{r} 0.6 \\ 35 \end{array} + \begin{array}{r} 2.0 \\ 27.0 \end{array} + \begin{array}{r} 2.5 \\ 27.0 \end{array}$$

$$\begin{array}{r} -2.2 \\ 43.7 \end{array} + \begin{array}{r} -0.9 \\ 44 \end{array} + \begin{array}{r} 2.4 \\ 34 \end{array} + \begin{array}{r} 3.7 \\ 28.7 \end{array} + \begin{array}{r} 1.5 \\ 28.7 \end{array}$$

$$\begin{array}{r} -2.2 \\ 59 \end{array} + \begin{array}{r} 0.5 \\ 53 \end{array} + \begin{array}{r} 3.3 \\ 47 \end{array} + \begin{array}{r} 6.2 \\ 37 \end{array} + \begin{array}{r} 6.7 \\ 31.7 \end{array} + \begin{array}{r} 1.5 \\ 31.7 \end{array}$$

$$\begin{array}{r} -2.2 \\ 64.2 \end{array} + \begin{array}{r} 1.7 \\ 57 \end{array} + \begin{array}{r} 4.9 \\ 50 \end{array} + \begin{array}{r} 0.7 \\ 44 \end{array} + \begin{array}{r} 8.8 \\ 33.8 \end{array} + \begin{array}{r} 9.6 \\ 33.8 \end{array}$$

$$\begin{array}{r} 4.87 \\ 38.7 \end{array} + \begin{array}{r} 1.42 \\ 38.7 \end{array}$$

$$\begin{array}{r} 4.63 \\ 41.2 \end{array} + \begin{array}{r} 1.44 \\ 41.3 \end{array}$$

..... Cross Sections

Sta.	B. S.	H. I.	F. S.	Grade	Gr. R.
BM.	4.67	893.56		888.89	
140 +50				87.65	5.91
141 ✓				87.54	6.02
+50				86.90	6.66
+70				86.58	6.98
142 ✓				86.28	7.33
+25				86.06	7.50
150 ✓				86.00	7.60
+76				86.07	
+83				86.14	
143 ✓				86.33	7.23
+20				86.63	
+50				87.30	6.26

100' V.C.
+0.3%

100' V.C.
-1.8%

100' V.C.

100' V.C.
0.2%

100' V.C.

100' V.C.
+2.6%

Inst.

Rod.

Chain.

Left

C L

Right

+0.9

$$\frac{00}{17.2}$$

$$\frac{00}{15}$$

$$\frac{00}{20}$$

$$\frac{00}{27}$$

$$\frac{00}{28}$$

$$\frac{00}{18}$$

$$\frac{00}{31}$$

$$\frac{1.6}{37}$$

$$\frac{+3.6}{28}$$

$$\frac{+3.6}{30}$$

$$\frac{00}{20}$$

$$\frac{00}{17}$$

Cross Sections

Sta.	B. S.	H. I.	F. S.	Grade	Gr. R.
144	100' V.C	893.86		88.30	5.26
+50	+0.25%			88.70	

Inst.
Rod.
Chain.

34

Left

C L

Right

20.9

Levels for Est. Dirt Moved for Cattle Pass
outlet 79+40 (Davis)

Cross Sections

Sta.	B. S.	H. I.	F. S.	Grade	Gr. P
0+00 = End Apron Jo. End Pass.					
0+44 ^S : End Grading					
B.M.	6.37	878.36		871.99	
0+00					
0+05					
0+15					
0+25					
0+44 ^S					

Inst.
 Rod.
 Chain.

8/19/24

35

Left

C L

Right

Ko 36' Tree 65' L. 79+50

Top Floor End Apron

$\frac{1.6}{17}$	$\frac{1.6}{8}$	$\frac{8.2}{8}$	8.18	$\frac{7.6}{7}$	$\frac{2.6}{7}$	$\frac{2.0}{17}$
$\frac{2.1}{15}$	$\frac{2.0}{8}$	$\frac{3.5}{6}$	$\frac{5.7}{5}$	6.7	$\frac{5.3}{4}$	$\frac{3.4}{5}$
					$\frac{2.2}{9}$	$\frac{2.1}{15}$

$\frac{3.0}{14}$	$\frac{2.7}{9}$	$\frac{4.8}{4}$	4.3	$\frac{4.2}{5}$	$\frac{3.1}{8}$	$\frac{3.0}{15}$
------------------	-----------------	-----------------	-----	-----------------	-----------------	------------------

$\frac{4.0}{15}$	$\frac{4.2}{8}$	$\frac{6.5}{5}$	6.6	$\frac{3.8}{12}$	$\frac{4.1}{21}$
------------------	-----------------	-----------------	-----	------------------	------------------

$\frac{6.6}{10}$	$\frac{9.0}{6}$	8.6	$\frac{7.9}{10}$
------------------	-----------------	-----	------------------

Levels for Ent to Cattle Pass 48+50

Sta.	Cross Sections				Gr. F
	B. S.	H. I.	F. S.	Grade	
BM.	0.67	817.54		816.87	
TP	0.57	808.38	9.73	807.81	
0+00	Point 25' N. of N end Cattle Pass.				
0+20					
0+40					
TP	4.76	812.57	0.57	807.81	
0+60					
0+70					
BM.	6.00	798.33		792.33	
0+00					
0+20					
0+40					
0+60					
0+76					

Inst.
 Rod.
 Chain.

8/30/24

36

Left

C L

Right

801.6

$\frac{10.2}{73}$

$\frac{6.8}{7}$

Abrupt 2

$\frac{7.0}{30}$

04.9

$\frac{3.5}{8}$

Abrupt.

$\frac{3.5}{25}$
 $\frac{0.9}{9}$

07.5

$\frac{0.9}{5}$

$\frac{6.8}{10}$

$\frac{06.0}{6.6}$
 4

$\frac{14.7}{15}$

$\frac{14.6}{5}$

05.4
 $\frac{7.2}{4}$

$\frac{11.1}{20.5}$

$\frac{11.1}{18}$

89.6
 $\frac{8.7}{14}$

$\frac{8.0}{29}$

$\frac{8.3}{17.5}$

$\frac{7.1}{17}$

92.9
 $\frac{5.4}{17}$

$\frac{6.9}{31.5}$

$\frac{6.5}{21}$

96.4
 $\frac{1.9}{10}$

$\frac{6.7}{20}$

$\frac{4.3}{17.5}$

$\frac{3.0}{13.5}$

$\frac{2.1}{13}$

$\frac{1.6}{11}$

$\frac{0.0}{10}$

98.9
 $\frac{0.0}{6}$

Same

Slope stakes Hanson App 26+00 Lt

..... Cross Sections

Sta.	B. S.	H. I.	F. S.	Grade	Gr. R.
BM.	494	782.01		777.07	
46+00 Begin App.				782.1	-0.1
+50				777.1	
47				772.1	

Inst.
Rod.
Chain.

Left

C L

Right

$$\begin{array}{r} F 12.2 \\ \hline 50.2 \end{array}$$

$$\begin{array}{r} F 8.4 \\ \hline 60 \end{array}$$

$$\begin{array}{r} F 00 \\ \hline 51.8 \end{array}$$

Levels to Est Amount Left at Under Xing 27+60

..... Cross Sections

Sta.	B. S.	H. I.	F. S.	Grade	Gr. R.
B.M.	3.84	741.88		738.04	
TP	1.86	731.08	12.66	729.22	
0+00-27+68 ³ -			4.4	726.7	
			4-		
0+05-5			4.7	726.4	
0+10-5			5.2	725.9	
0+20-5			3.0	728.1	
0+30-5			2.9	728.2	
0+50-5			2.8	728.2	
0+60-5			2.7	728.4	
0+09-H			5.1	726.0	
0+20-H			3.3	727.8	
0+30-H			3.3	727.8	
0+38-H			3.4	727.7	
0+45-H			3.3	727.8	
0+60-H			3.2	727.9	

In-t.
 Rod.
 Chain.

9/2/22

Left

C L

Right

Spike Cottonwood AS R-30+30

$\frac{100}{20}$ $\frac{12.9}{8}$ $\frac{4.4}{4.6}$ 4.4 $\frac{2.4}{2}$ $\frac{13.0}{9}$ $\frac{100}{17}$

$\frac{100}{20}$ $\frac{12.4}{10}$ $\frac{5.0}{7}$ 4.7 $\frac{4.7}{4}$ $\frac{12.2}{6}$ $\frac{100}{16}$

$\frac{100}{22}$ $\frac{9.7}{10}$ $\frac{3.2}{6}$ $\frac{5.4}{5}$ 5.2 $\frac{5.9}{5}$ $\frac{10.4}{8}$ $\frac{100}{17}$

$\frac{100}{21}$ $\frac{2.8}{13}$ $\frac{3.8}{10}$ 3.0 $\frac{3.3}{4}$ $\frac{7.8}{9}$ $\frac{100}{19}$

Back Slope

$\frac{3.5}{23}$ $\frac{5.0}{15}$ $\frac{3.0}{5}$ 2.9 $\frac{3.7}{5}$ $\frac{10.0}{10}$ $\frac{100}{19}$

B. Slope

$\frac{3.0}{7}$ $\frac{3.5}{5}$ 2.8 $\frac{3.2}{5}$ $\frac{10.4}{12}$ $\frac{100}{22}$

2.7 $\frac{2.1 \text{ on Slope}}{8}$ $\frac{10.1 \text{ on Slope to 300}}{18}$ 3.6

$\frac{100}{25}$ $\frac{12.4}{10}$ $\frac{5.6}{5}$ 5.1 $\frac{5.5}{5}$ $\frac{100}{21}$

on Slope

$\frac{12.3}{30}$ $\frac{11.8}{13}$ $\frac{3.7}{5}$ 3.3 $\frac{3.2}{6}$ $\frac{12.0}{11}$ $\frac{100}{25}$

on Slope

$\frac{10.0}{22}$ $\frac{9.6}{12}$ $\frac{3.4}{5}$ 3.3 $\frac{3.1}{6}$ $\frac{9.3}{10}$ $\frac{100}{25}$

$\frac{6.3}{18}$ $\frac{7.6}{15}$ $\frac{3.0}{11}$ $\frac{3.3}{5}$ 3.4 $\frac{3.3}{7}$ $\frac{8.6}{10}$ $\frac{100}{25}$

Back Slope

$\frac{5.1}{12}$ $\frac{3.3}{4}$ 3.3 $\frac{3.5}{8}$ $\frac{2.4}{10}$ $\frac{100}{21}$

3.2 $\frac{2.5 \text{ Back Slope}}{8.5}$ $\frac{10.4 \text{ on Slope}}{8.5}$

Lever to Est. Sub Grade Etc.

28 to 34 Cross Sections

Sta.	B. S.	H. I.	F. S.	Grade	Gr. R.
B.M.	0.25	744.04		743.79	
3400					
+50					
33+00 TP	1.10	732.64	12.50	731.54	
150					
32+00					
+50					
31+00					
+50					
TP	2.09	722.59	12.14	720.50	
25					
30+00					
+50					
29+00					

Levels for Est. Sub-Grade EX.

Cross Sections

Sta.	B.S.	H. I.	F. S.	Grade	Gr. R
------	------	-------	-------	-------	-------

+67

+62

a? +50

+38

+15

78+00

Inst. Nelson
 Rod. 17 n 1 b e r 2
 Chain 2

9/8/24

40

Left

C L

Right

$\frac{00}{34}$	$\frac{15}{24}$	$\frac{94}{16}$	$\frac{93}{-}$	$\frac{87}{19}$	$\frac{102}{27.2}$	$\frac{107}{26}$	$\frac{00}{36}$			
$\frac{18}{34}$	$\frac{10}{24}$	$\frac{104}{20}$	$\frac{94}{16}$	$\frac{94}{-}$	$\frac{93}{19}$	$\frac{10}{21}$	$\frac{151}{26.6}$	$\frac{00}{37}$		
$\frac{41}{34}$	$\frac{103}{24}$	$\frac{103}{18}$	$\frac{99}{15}$	$\frac{104}{-}$	$\frac{10}{18}$	$\frac{11}{27}$	$\frac{105}{28.8}$	$\frac{00}{21}$		
$\frac{00}{36}$	$\frac{116}{25.5}$	$\frac{114}{21}$	$\frac{107}{16}$	$\frac{10.6}{-}$			$\frac{102}{19.5}$	$\frac{11}{22}$	$\frac{96}{31}$	$\frac{00}{37}$
	$\frac{00}{25.5}$		$\frac{107}{14}$	11.7	$\frac{111}{7.8}$		$\frac{00}{37}$			
	$\frac{00}{12.5}$	$\frac{108}{5}$		11.8	$\frac{113}{26.5}$		$\frac{00}{37}$			

Elevations to figure P₃-Grade-55+45

Cross Sections

Sta.	B. S.	H. I.	F. S.	Grade	Gr. R.
BM.	7.10	775.64		768.54	
0+00	South end 24' P ₃ -55+45	8.8		766.8	
0+11			9.6	766.0	
0+30			13.4	762.2	
0+50			9.2	766.4	
0+70			3.4	772.2	
TP	10.90	786.11	0.43	775.21	
0+85			7.4	778.7	
1+00			2.0	784.1	
TP	12.70	798.61	0.20	785.91	
1+20			8.7	789.9	
1+45			5.0	793.6	
1+68			1.1	797.5	

For Estimate on B Line

Cross Sections

Sta. B. S. H. I. F. S. Grade Gr. R.

56+25

56+50

56+75

57

57+25

57+50

57+75

58

58+25

58+60

59+85

void

Inst.

Rod.

Chain.

9/13/24

42

Left

C L

Right

~~18.3~~

45.3

(2.0')

~~9.3~~~~2.1~~
~~19.6~~~~-3.8~~

21.7

+0.8

~~-6.4~~~~-25.6~~

(5.2')

~~-2.5~~~~28~~
20~~18.3~~
33~~+8.3~~
32.5+1.4
27.2

(9.3')

+7.8

+11.3
14+13.8
25+19.1
41+22.3
46.5+1.1
26.9

(12.0')

+11.1

+16.1
12+24.0
33+26.3
25+26.2
50.4~~-6.5~~
25.8+0.7
14

(14.6')

+6.5

+12.9
14+15.1
28+21.3
36+26.7
51.7~~-23.3~~
55.3~~-17.4~~
38~~-8.5~~
16

(16.7')

-0.7

+6.6
17+13.1
32+19.3
46+18.0
4351.0 -27.3 -21.3 -17.4 -14.0
66.5 50 29 19 11

(19.0')

-9.0

+2.1
12+8.3
29+14.1
42+12.9
37.9~~-24.0~~
36.0~~-21.7~~
42~~-11.0~~
14

(18.0')

-3.2

+5.8
18+13.5
34+19.0
45~~-10.0~~
33.0~~+15.5~~
41.5~~-12.2~~
32~~-7.2~~
16

(16.8')

+1.5

+4.7
6+12.0
20+23.2
42.2+4.4
29.4+8.1
18

(17.0')

+14.4

+19.9
17+23.6
28+28.6
44+29.4
54.4+11.2
36.2+14.2
24

(15.0')

+21.7

+25.8
18+28.7
26+30.0
55.0

..... Cross Sections

Sta.	B. S.	H. I.	F. S.	Grade	Gr. R
------	-------	-------	-------	-------	-------

59+05

59+25

59+50

60

60+40 same



Inst.
 Rod.
 Chain.

Left				CL	Right			
$\frac{+40}{90}$	$\frac{+70}{77}$	$\frac{+90}{50}$	$\frac{+132}{38.2}$	+25.2	$\frac{+280}{74}$	$\frac{+294}{54.4}$		
$\frac{+40}{81}$	$\frac{+70}{50}$	$\frac{+125}{37.8}$	$\frac{+165}{27}$	+24.1	$\frac{+261}{14}$	$\frac{+261}{51.1}$		
$\frac{+47}{100}$	$\frac{+63}{66}$	$\frac{+50.0}{35.0}$	$\frac{+12.8}{25}$	$\frac{+70}{76}$	$\frac{+70}{5}$	$\frac{+124}{16}$	$\frac{+24.4}{22}$	$\frac{+230}{48.0}$
	$\frac{+23}{27.2}$	$\frac{+43}{21}$	$\frac{+23}{72}$	(9.0) +3.3	$\frac{+31}{13}$	$\frac{+10.8}{24}$	$\frac{+10.8}{35.8}$	

Levels for Form App Lt 1042

Cross Sections

Sta.	B. S.	H. I.	F. S.	Grade	Gr. R
B.M.	7.7	856.11	848.41		
TP	12.13	867.89	0.35	855.76	
TP	7.76		2.02	865.87	
0+00	00 of Excav.				
0+08	/				
0+25					
0+50					
0+62					
0+70	= 00 of Excav				

Levels for Form App Lt 1042
to Est. Ydg.

TP	7.76			865.87	
0+08					
0+25					
0+50					
0+62					
0+70	00 Excav				

See page 54- This Book

Inst.
 Rod.
 Chain.

9/15/24

44

Left

C L

Right

$$\begin{array}{r} 110 \\ 6 \\ \hline 88 \\ 6 \\ \hline 60 \\ 10 \\ \hline 42 \\ 8 \end{array}$$

34
 33
 3.0
 2.1

$$\begin{array}{r} 14 \\ 20 \\ 21 \\ \hline 15 \\ 8.6 \\ 8 \\ \hline 0.2 \\ 7 \end{array}$$

Hub

$$\begin{array}{r} 110 \\ 6 \\ \hline 89 \\ 6 \\ \hline 60 \\ 10 \\ \hline 42 \\ 8 \end{array}$$

106
 87
 57
 40

$$\begin{array}{r} 103 \\ 7 \\ \hline 85 \\ 8 \\ \hline 57 \\ 4 \\ \hline 59 \\ 4 \end{array}$$

Old Ground

$$\begin{array}{r} 20 \\ 126 \\ 15 \\ \hline 8 \\ 106 \\ 8 \\ \hline 7 \end{array}$$

New Grade - 55+00 to 63+08

55 to 63

Cross Sections

Sta.	B. S.	H. I.	F. S.	Grade	Gr. F
B.M.	400	819.72		815.72	
56+00				823.70	-4.0
+25				824.87	-5.2
TP	12.19	831.73	0.18	819.54	
+50				826.05	5.6
+75				827.22	4.5
57				828.40	3.3
+25				829.57	2.1
TP	0.67	821.23	11.17	820.56	
+50				830.75	-9.5
+75				831.92	-10.7
58				833.10	-11.9
TP	11.38	831.94	0.67	820.56	
+20				834.51	-2.6
TP	11.23	843.00	0.17	831.77	
+60				835.91	7.1
TP	12.73	855.58	0.15	842.85	

Inst. Nasbitt
 Rod. Nelson
 Chain. Alberg-Dow

9/17/24

Left

C L

Right

Spike Oak 10 R-3475

1.1 $-\frac{28.5}{60.7}$ (1.4 SHK) (1.0 SHK) -24.7 $-\frac{12.9}{36.5}$ (0.6 SHK) +0.9

1.1 $-\frac{19.4}{46.8}$ (0.9 SHK) (0.5 SHK) -10.6 $-\frac{8.6}{23.8}$ (0.8 SHK) +0.9

1.1 $-\frac{2.1}{25.8}$ (0.6 SHK) (0.3 SHK) -3.3 $\frac{19.4}{31.1}$ +0.9

56+88.00
 $\frac{25}{25}$

-0.9 $+\frac{2.3}{27.2}$ +0.8

-0.8 $+\frac{3.3}{28.8}$

+0.8 $\frac{00}{25}$

-0.8 $-\frac{10.3}{32.9}$ (0.9 SHK)


-0.8 $-\frac{25.1}{58.9}$ (1.7 SHK)

-0.8 $-\frac{23.4}{53.5}$ (1.1 SHK)

0.5 $-\frac{11.0}{34.0}$ (1.0 SHK)

+44 = 20
 $\frac{25}{25}$
 $+\frac{5.2}{30.2}$

-0.3 $+\frac{5.2}{30.2}$

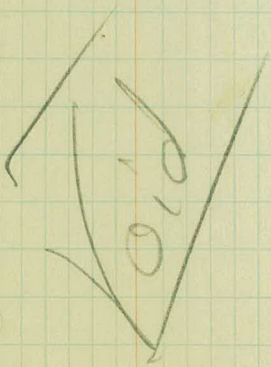

..... Cross Sections

Sta.	B. S.	H. I.	F. S.	Grade	Gr. R
		855.58			
58+85				+4.7%	18.5
59				83710	
59+05				37.80	
				838.03	17.6
59+25				838.92	16.7
59+50				839.97	15.6
+75				840.84	14.8
TP	2.81	848.85	12.54	843.04	
60				841.77	4.1
+50				843.20	2.7
61.				844.26	1.6
+50				845.14	0.7
62				846.02	-0.1
B.M.			8.14	837.71	
TP	12.01	856.44	14.2	844.43	
60+00				841.77	14.6

Inst.
 Rod.
 Chain.

	Left	C L	Right	
-0.2	$\frac{+11.7}{36.7}$			
0.4	$\frac{+13.6}{38.6}$			
0.4	$\frac{+12.0}{41.5}$ (old grade changed had to use some dist.)			
0.4	$\frac{+8.9}{38.3}$	"		
0.6	$\frac{+4.8}{34.2}$	"		
0.7	$\frac{+0.4}{29.8}$ $\frac{-1.4}{18.0}$	"		
0.7	$\frac{+7.5}{38.1}$ (0.8) 20' up (Shk)		$\frac{(0.8) - 8.8}{27.0}$	+0.7
0.7	$\frac{-3.9}{21.0}$		$\frac{-4.9}{16.5}$	+0.7
0.7	$\frac{-2.5}{17.0}$		$\frac{-3.7}{19}$	+0.7
	$\frac{-1.0}{16}$		$\frac{-1.3}{18.0}$	
Nail 10" Butternut 60' R-60+60				
			$\frac{+5.5}{30.5}$	+0.7

Cross Sections

Sta.	B. S.	H. I.	F. S.	Grade	Gr. R
		856.44			
59+75				840.84	15.6
TP	11.06	866.84	0.66	855.78	
59+50				839.97	26.9
59+25				838.92	27.9
59+05				838.03	28.8
58+85				837.10	29.7
58+60				835.91	30.9
58+30				834.51	32.3
58+00				833.10	33.7
57+75				831.92	34.9
TP	4.10	860.54	10.40	856.44	
57+50				830.75	29.7
57+25				829.57	31.0
57+00				828.40	32.1

Inst.
 Rod.
 Chain.

Left

C L

Right

$$\begin{array}{r} +10.7 \\ \hline 38.7 \end{array} \quad +0.6$$

$$\begin{array}{r} +18.1 \\ \hline 48.1 \end{array} \quad +0.4$$

$$\begin{array}{r} +22.9 \\ \hline 47.9 \end{array} \quad +0.2$$

$$\begin{array}{r} +25.0 \\ \hline 50.0 \end{array} \quad 00$$

$$\begin{array}{r} +26.1 \\ \hline 50.0 \end{array} \quad +0.2$$

$$\begin{array}{r} +26.5 \\ \hline 50.0 \end{array} \quad +0.3$$

$$\begin{array}{r} +25.1 \\ \hline 50.1 \end{array} \quad +0.5$$

$$\begin{array}{r} +24.7 \\ \hline 49.7 \end{array} \quad +0.8$$

$$\begin{array}{r} +20.7 \\ \hline 40.7 \end{array} \quad +0.8$$

$$\begin{array}{r} +23.8 \\ \hline 48.8 \end{array} \quad +0.8$$

$$\begin{array}{r} +26.2 \\ \hline 50.0 \end{array} \quad +0.8$$

$$\begin{array}{r} +23.2 \\ \hline 48.2 \end{array} \quad +0.8$$

Cross Sections

Sta.	P. B. S.	H. I.	F. S.	Grade	Gr. I
		860.54			
56+75				827.22	33.3
56+50				826.05	

Inst.
Rod.
Chain.

48

Left

C L

Right

+33.2
+8.2

+0.8

Levels for Classification

Sta.	Cross Sections				Gr. R.
	B. S.	H. I.	F. S.	Grade	
BM.	1274	82846		81572	
P	422	83203	065	827.81	
53+75					
53+50					
53+25					
53					
52+85					
52+75					
52+60					
52+50	Begin Solid Rock Ledge				
P	234	82657	784	82419	
52+15	Loose Rock				
52					
51+75					
51+75					
51+50	total loose				
51+25	total solid				

Nesbitt

Red: Nelson

Chair: Ed. George Lewis

9/8/24

49

Left

C L

Right

Parallel, ~~to~~ Old Ground to N.W.

$\frac{77}{310}$

$\frac{17.6}{}$

✓

"

$\frac{103}{25.5}$

$\frac{18.6}{}$

✓

"

$\frac{68}{34}$

$\frac{19.5}{}$

✓

"

$\frac{54}{35}$

$\frac{20.4}{}$

✓

"

$\frac{60}{37}$

✓

"

$\frac{98}{34.5}$

$\frac{21.3}{}$

$\frac{126}{32}$

$\frac{21.8}{}$

$\frac{100}{35}$

$\frac{100}{34}$

$\frac{94}{36}$

Levels for Est. of Sub-Grade Excav.

Sta.	Cross Sections				Gr. P
	B. S.	I. I.	F. S.	Grade	
BM.	6.21	783.28		777.07	
45				777.3	6.0
44.50				74.9	8.4
44				72.5	10.8
43.50				70.1	13.2
IP	2.0	772.68	12.60	770.68	
43				767.9	4.8
42.50				765.7	7.0
42				763.6	9.1
41.50				761.5	11.2
BM.	6.21	783.28		777.07	
IP	10.80	792.38	1.70	781.68	
45.50				799.7	12.7
46				782.1	10.3
45				784.5	7.9
47				786.9	5.5
45.0				789.3	3.1
48				791.7	0.7

Inst.
Rod.
Chain.

Left

C L

Right

$\frac{68}{54}$ (0.8 low)

$\frac{93}{54}$ (0.9 low)

$\frac{114}{54}$ (0.6 low)

132 (Grade)

$\frac{48}{54}$ (Grade)

$\frac{66}{54}$ (0.4 high)

$\frac{101}{54}$ (1.0 low)

$\frac{119}{54}$ (0.7 low)

$\frac{137}{54}$ (1.0 low)

$\frac{116}{54}$ (1.3 low)

$\frac{92}{54}$ (1.5 low)

$\frac{66}{54}$ (1.1 low)

$\frac{39}{54}$ (0.8 low)

$\frac{20}{54}$ (1.3 low)

X-Levels For Sept. Est. on Under Pass 27 \pm

Cross Sections

Sta.	B. S.	H. I.	F. S.	Grade	Gr. R.
BM.	343	741.45		738.04	
FP	2.28	730.88	12.85	728.60	
0+60-S			2.4	28.5	
0+50-S			2.5	28.4	
0+30-S			2.8	28.1	
0+20-S			11.5	19.4	
0+38-N	- Same				
			3.9	27.0	
0+30-N					
			11.7	19.2	
0+20-N					
0+09-N			7.1		
FP	2.03	720.60	12.31	718.57	
0+10-S			7.1	13.5	
			8.6		
0+05-S			8.6	12.0	
0+00			10.7	09.9	

Inst.
 Rod.
 Chain.

9/31

57

Left

C L

Right

0.67 0.67
 $\frac{68}{20}$ $\frac{5.1}{11.5}$ $\frac{25}{9.0}$ 2.4 $\frac{2.9}{8.0}$ $\frac{88}{105}$ $\frac{88}{12.5}$

$\frac{6.7}{20.0}$ $\frac{7.2}{19.0}$ $\frac{5.8}{12.5}$ $\frac{4.3}{10.0}$ $\frac{3.6}{7.5}$ $\frac{2.4}{4.0}$ 2.5 $\frac{2.9}{4.0}$ $\frac{63}{9.0}$ $\frac{106}{100}$ $\frac{106}{12.0}$

$\frac{8.4}{21}$ $\frac{11.6}{18.0}$ $\frac{12.6}{9.5}$ $\frac{8.5}{8.0}$ $\frac{6.2}{5.5}$ $\frac{2.6}{5.0}$ 2.8 $\frac{2.9}{2.0}$ $\frac{11.7}{6.0}$ $\frac{11.7}{12.0}$

$\frac{10.5}{26}$ $\frac{12.7}{24}$ $\frac{12.7}{19}$ $\frac{11.7}{5.0}$ 11.5 $\frac{11.9}{5.0}$ $\frac{120}{12.0}$

~~27~~

$\frac{90}{12}$ $\frac{5.7}{7}$ 39 $\frac{105}{3}$ $\frac{10.5}{12}$

$\frac{7.7}{7.5}$ $\frac{10.1}{5}$ 12.7 $\frac{13.5}{13}$

$\frac{9.3}{8}$

$\frac{9.3}{26}$ $\frac{80}{14}$ $\frac{4.4}{7.0}$ $\frac{5.2}{1.0}$ 7.1 $\frac{6.5}{13}$ $\frac{90}{18}$ ($\frac{R2}{41}$)

$\frac{11.2}{37.0}$ $\frac{9.9}{18}$ $\frac{8.7}{6}$ 8.6 $\frac{10.1}{5.0}$ $\frac{101}{10.0}$ $\frac{8.7}{12}$ $\frac{7.3}{13}$ $\frac{9.2}{2.0}$

$\frac{11.5}{35}$ $\frac{98}{19}$ $\frac{103}{14}$ 10.7 $\frac{10.6}{8}$ $\frac{8.5}{9}$ $\frac{7.5}{15}$ $\frac{90}{20}$

..... Cross Sections

Sta.	B. S.	H. I.	F. S.	Grade	Gr. R.
		72060			
0+09-H			7.5	13.1	
0+20-H					

Inst.
Rod.
Chain.

5-2

Left

C L

Right

$$\frac{9.1}{24}$$

$$\frac{6.0}{13}$$

$$7.5 \left(\overset{R\downarrow}{\frac{35}{}} \right)$$

$$\frac{11.9}{36}$$

$$\frac{9.4}{20} \quad \frac{11.3}{26}$$

Levels Sept Est,

				Cross Sections	
Sta.	B. S.	H. L.	F. S.	Grade	Gr. R.
59+75					
59+50					
59+05					
58+85					
58+60					
58+30					
58					
57+75					
57+50					
57+25					
57					
56+75					
56+50					
56+25					
56					

Grade 1 1/2' on R

Inst.
Rod.
Chain.

9/3/25

53

Left

C L

Right

$$\frac{+52}{29}$$

$$\frac{+32}{5} (1:1)$$

$$\frac{+60}{30}$$

$$\frac{+60}{5} (1:1)$$

$$\frac{+70}{29}$$

$$\frac{+65}{13}$$

$$\frac{+60}{5} (1:1)$$

$$\frac{+45}{30}$$

$$\frac{+45}{20}$$

$$(1:1)$$

$$\frac{+80}{30}$$

$$\frac{-20}{27}$$

$$-30 (1:1)$$

Level (1:1)

$$\frac{+120}{20}$$

Level (1:1)

$$\frac{+120}{23}$$

Level (1:1)

$$\frac{+120}{20}$$

Finals

Cross Sections

Sta.	B. S.	H. I.	F. S.	Grade	Gr. R.
------	-------	-------	-------	-------	--------

Levels to Est. Excav. Form Xing

LT 104±1

BM.	2.69	876.90		874.21	
TP.	8.35	874.94	10.21	866.59	

0+00 00 of Excav.

0+07

0+25

0+50

0+75

1+00

1+15 00 of Excav.

Inst. Nesbitt
 Rod. Galvin
 Chain. Fibberg

9-30-24

54

Left

C L

Right

Spl. 12" Oak 33' Lt. 99 + 15

0.62

$$\frac{12.5}{8}$$

12.1

$$\frac{12.4}{6}$$

$$\frac{2.1}{19} \xrightarrow{0.6}$$

0.67

$$\frac{10.4}{6}$$

10.8

$$\frac{10.9}{6}$$

$$\frac{2.9}{18} \xrightarrow{0.6}$$

0.67

$$\frac{7.7}{8}$$

7.7

$$\frac{7.7}{6} \frac{8.8}{8}$$

$$\frac{1.6}{15} \xrightarrow{0.6}$$

0.67

$$4.7 \frac{4.7}{6} \frac{5.6}{8}$$

$$\frac{1.0}{14} \xrightarrow{0.6}$$

0.62

3.4

$$\frac{3.5}{8}$$

$$\frac{1.0}{10} \xrightarrow{0.6}$$

X Levels for Barron Pit. Sta 58+50-60+00

Sta.	B. S.	Cross Sections			Gr. R.
		H. I.	F. S.	Grade	
B.M.	10.70	848.41		837.71	
T.P.	6.03	845.69	8.75	839.66	
58+60	834.3				13.4
+85	833.2				12.5
59+05	834.0				11.7
+25	834.7				11.0
+50	835.6				10.1
+75	836.5				9.2
60+00	837.5				8.2
T.P.	4.83	844.52	6.00	839.69	
B.M.			6.80	837.72	O.K.

old grades used for platting on X sect.

Inst. Cooke

Rod. Staeger

Chain. Falborg - Falvin

10/6/24

55

Left

C L

Right

Nail in Tree 60 + 60 50' St.

14.2	127	114	114	10.5	✓
100.0	91.	70.	570	47.4	

7.5	5.3	3.7	1.2	✓
100.0	91.0	65.0	56.0	

68	2.7	0.6	✓
100.0	70.0	59.0	

7.2	2.9	0.0	✓
100.0	71.0	56.0	

13.0	9.6	6.1	1.5	✓
100.0	79.0	64.0	50.0	

13.00	4.6	0.5	✓
73.7	50.0	34.2	

12.7
51.0

X Levels for Weekly Est. 10-11-24

Cross Sections

Sta.	B. S.	H. I.	F. S.	Grade	Gr. R.
B M	9.35	842.06		837.71	
60+00				837.5	96
59+50				835.6	11.5
+25				834.7	12.4
+05				834.0	13.0
59+85				833.2	13.9
+60				832.3	14.8
58+00					appears to be zero Rock.

Inst. Skoia
 Rod. Galvanometer
 Chain. Fritz

	Left	C L		Right			
							← 0.6
+10	6.7	6.4	6.0	6.0	8.2	9.1	11.5
15.0	4.0	0.0	12.0	16.0	24.0	41.0	46.0
	0.6	7.7	7.7	7.7	9.0	9.0	7.8
	23.0	5.0	0.0	18.0	29.0	57.0	65.0
							← 0.6
0.6	+6.2	8.4	8.4		8.4	8.3	3.0
27.0	20.0	3.0	0.0		3.0	55.0	64.0
							← 0.6
0.6	+4.0	9.0	9.0	8.5	10.5	10.5	1.7
30.0	20.0	10.0	0.0	27.0	32.0	40.0	30.0
							← 0.6
0.6	2.0	8.4		9.0	11.0	11.0	5.3
23	10.0	0.0		21.0	24.0	57.0	65.0
							← 0.6
0.6	2.0	9.4		9.4	11.0	12.0	12.7
25	13.0	0.0		16.0	19.0	47.0	57.0

cut approx exc. to here

(R indicates top of Rock)

X Levels for Weekly Est.

Cross Sections

Sta.	B. S.	H. I.	F. S.	Grade	Gr. R.
From	1.68	739.72		738.04	
T.P.	5.83	732.91	12.64	727.08	
0+00-27	+68.3			726.7	
0+05 S				726.4	
0+10				725.9	
0+20				728.1	
0+30				728.2	4.7
0+50				728.3	4.6
0+60 S				728.4	4.5
0+09 N				726.0	6.9
0+20				727.9	5.1
0+30				727.9	5.1
0+38				727.7	5.2
0+45				727.8	5.1
0+60 N				727.9	5.0

Original X sect.
 Holmes & Johnson
 Page 38

Inst.
 Rod.
 Chain.

10/11/24

57

Left

C L

Right

6.6 8.4 14.9 12.5
 00 5.3 13.6 20.0

13.5 6.5 4.6 6.1 8.4 9.0
 10.4 6.9 9.0 7.0 12.8 21.6
 10.8 5.0 4.4 4.6 7.2 8.4
 10.4 7.8 9.0 9.0 12.0 20.0

W

E

8.7 11.9 11.3 7.1 6.2 ✓
 12.2 13.4 12.0 4.4 9.0

0.6 8.0 9.3 7.0 5.5 5.2 ✓
 1.0 14.3 5.0 4.7 00 5.9

RE 7.2 5.4 5.3 5.2 5.0 ✓
 12.4 11.3 5.3 00 5.6

Sum

5.0 4.7 5.4
 00 5.3 8.6 ✓

X Levels for Weekly Est. Cross Sections

Sta.	B. S.	H. I.	F. S.	Grade	Gr. R.
		732.91			
0+00	139	726.67	1263	720.28 726.7	(-5.0)
+09 N				726.0	(-4.3)
+20				727.8	(-6.1)
+30				727.8	(-6.1)
+38				727.7	(-6.0)
+45				727.8	(-6.1)
+60				727.9	(-6.2)
+70	Zero Exc.				

Inst.
 Rod.
 Chain.

10/11/24

58

Left

C L

Right

(E)

(W)

11.8 11.7 11.5 11.9 11.5 10.5
 32.2 19.4 10.8 11.9 7.2 16.2 21.0

12.8 11.6 12.2 11.7 11.6 9.4
 38.4 21.2 13.2 00 12.4 22.6

13.1 12.4 12.7 13.0 10.9 9.6 3.5 SR 3.2 3.2
 40.8 25.2 14.2 6.2 00 4.0 6.4 15.0 27.6

13.5 12.6 12.0
 33.3 25.0 13.0

13.9 12.9 4.3
 41.8 19.4 13.0

13.4 11.4 4.5
 45.4 13.0 13.0

14.0 14.0 9.3 1.4 SR
 41.0 28.8 18.0 13.0

X Levels for Weekly Est. Cross Sections

Sta.	B. S.	H. I.	F. S.	Grade	Gr. R.
		721.67			
0+05 S				726.4	-4.7
0+10				725.9	-4.2
+20				728.1	-6.4
T.P.	13.05	724.82	9.90	711.77	
+20				728.1	-3.3
+30				728.2	-3.4
+50				728.3	-3.5
+60				728.4	-3.6

Inst.
 Rod.
 Chain.

10/11/24

59

Left

C L

Right

44 105 116 120 118 114 105
 376 276 106 00 104 18.2 20.4

(W) -

40 103 111 119 115 104
 344 276 234 00 186 21.2

28 63 60 115 119
 272 242 49 49 00

15.1 139
 20.2 24.0

14.8 136
 13.0 22.0

134
 24.0

13.2
 26.2

..... Cross Sections

Sta.	B. S.	H. I.	F. S.	Grade	Gr. R.
------	-------	-------	-------	-------	--------

Inst.
Rod.
Chain.

Left

CL

Right

MTH

110.3

to Hastings →

T.P. (C)

T.P. (C)

T.P. (C)

to Hastings
O M 2 5 P P P



B.M. $\frac{253}{3}$

cap EL 696.30
bolt EL 692.40

sign station
one mile



Mississippi River

$\frac{253}{3}$

B.M.

(C)

cap. 690.70
bolt. 676.09

TOWER



X sect for borrow pit Ramsey Co property

Original Cross Sections

Sta.	B. S.	H. I.	F. S.	Grade	Gr. R
BM	174	739.78		738.04	
T.P.	6.2v	734.06	11.94	727.80	
29+00					

29+50

30

R/R ROW
 10.9 9.0
 101.5 90.0

30+30[±] on prop. line.

R/R ROW
 9.4 7.9 8.5
 110.5 107.1 90.0

T.P.	11.17	739.83	5.40	728.66	
BM			1.77	738.06	

Original Xsect. for borrow pit.

Cross Sections

Sta.	B. S.	H. I.	F. S.	Grade	Gr. R.
Bm	11.02	871.48		860.46	
66+30.7	P.T.			859.48	12.0
66				858.68	12.8
65+50				856.98	14.5
T.P.	4.45	870.93	5.00	866.48	
65				855.28	15.6
64+50				853.58	17.3
64				852.22	18.7
T.P.	0.78	859.74	11.97	858.96	
63+50				850.18	9.5
63				848.20	11.5
T.P.			6.78	852.96	

Inst. Galvin
 Rod. Skegton
 Chain. Filitz

10-18-24 AM.

62

Left

C L

Right

6.4 30.6	6.2 37.7	3.4 43.2	3.5 50.0	(+25)
6.4 31.0	6.0 36.8	4.8 50.0		(+90)
5.1 33.2	4.1 44.1	3.5 50.0		✓
5.0 35.3	4.5 39.2	3.5 50.0		✓
4.3 36.6	3.6 44.4	3.5 50.0		✓
7.2 34.3	6.1 40.8	5.6 50.0		(+10)
6.1 27.1	2.6 40.7	0.4 50.0		✓
13.5 28.8	10.8 41.1	8.8 50.0		✓

copy stake 5/16/100

Original X sections for borrow Pit.

Cross Sections

Sta.	B. S.	H I.	F S.	Grade	Gr. F
T.P.	6.61	859.57		852.96	
64+00				851.88	7.7
+25					
+50				853.58	6.0
+75					
T.P.	6.44	863.26	2.75	856.82	
65				855.28	8.0
+25					
+50				856.96	6.3
+75					
+90				858.00	5.3
66				859.68	4.6
+30.7 PT		4.1		859.48	3.8
B.M.			2.80	860.46	


Copper 10-18-24

Left

G L

Right

Top of stake Sta 64+00

113.2	12.2	9.3	7.9	7.4
50.5	32.6	23.8		

11.8	6.5	3.8
50.0	36.6	28.3

10.1	6.2	3.2
50.0	38.0	28.1

12.0	8.6	4.5
45.0	36.0	27.1

13.3	11.9	10.0	7.2
50.0	43.0	38.8	24.5

9.4	7.2	5.9	5.0
50.0	42.7	33.6	27.0

9.1	6.9	4.4
50.0	36.5	26.8

12.6	10.3	8.3	6.1
50.0	39.1	30.5	25.3

8.4	7.0	5.7	5.1	2.9
50.0	44.5	33.4	25.3	

11.2	7.5	5.1	2.9	+2.5
50.0	41.4	33.9	25.2	

Grade Change 31+50 to 37+50

Cross Sections

Sta.	B. S.	H. I.	F. S.	Grade	Gr. R.
BM	16.8	739.72		738.04	
31+50				726.50	13.2
32	(see page 71)			728.10 728.90	10.8
+50				731.10	5.6
33				733.20	6.5
+50				735.10	4.6
T-P.	12.79	750.03	2.47		
34				736.90	13.1
+50	(lower end of 11.3 Rd. upon end of pipe 10.5)			738.70	11.3
35	(30+49 lower end 10.0) Burnt Con. (35+33 upper end 8.9)			740.50	9.5
+50	+50 lower end 8.65 +50 upper - - - 8.3			742.30	7.8
36	(see page 71)			744.00 743.10	6.9
+50				745.60 745.50	4.5
37				747.10 746.80	3.2
BM	Cont. on P. 71		6.19	743.54	(743.79)
+50				749.0 748.50	2.0

+50%

200' VC.

+3.575%

200' VC.

Inst.
 Rod.
 Chain.

Left

C L

Right

430 + 00 *Pl. splk. stump*

00
15.0

00
15.0

X 00
15.0

00 X
15.0

00
15.0

00.4
15.0

00
15.0

00.2
15.0

F on last slope

- 0.4
00

+ 1.4

(+0.9)	3.7	4.8	3.7	+0.8	3.2	4.4	4.2	(+4.6)
(23.6)	23.6	18.8	16.2	00	16.6	20	25.4	(29.7)

W. (10.5)	12.6	11.4	11.7	+1.4	+1.8	13.5	12.8	(10.5)
(12.6)	21.2	15.2	00	14.4	20.6	25.0	(12.6)	(25.3)

(+2.5)	8.8	10.9	11.1	9.2	9.3	9.0	11.3	11.3	8.0	(+3.6)
(27.5)	25.8	23.0	19.6	15.8	00	16.8	21.2	23.4	26.2	(28.6)

(+1.6)	7.9	8.0	9.7	9.8	7.5	7.4	7.5	(+1.7)	7.8	26.7	341115 St. Connect.
(26.8)	20.4	21.8	19.0	14.6	00	15.5	(26.7)				

(+0.7)	7.1	8.3	8.3	6.5	6.4	6.2	7.9	(00)	7.8	(22.8)	back slope
(7.1)	24.2	22.0	20.2	16.0	00	11.6	17.8				Camp yard

(+0.5)	6.4	6.3	7.7	7.2	5.4	5.3	5.6	7.2	7.4	(+2.2)	4.7
(25.5)	24.0	22.0	19.0	14.8	00	12.0	16.6	19.0	(22.8)	X	

X	00	15.0	+0.4	00	15.0	X
			0.6			

X	00	15.0	+0.5	00.7	15.0	X
---	----	------	------	------	------	---

24 35 + 20

X	00	15.0	+0.2	00	15.0	X
---	----	------	------	----	------	---

..... Cross Sections

Sta.	B. S.	H. I.	F. S.	Grade	Gr. R.
------	-------	-------	-------	-------	--------

733.16

27+79

27+90

Percentage/loose Rim
Top also.

28

Balance to 28+67 = 15' Dirt on Surface 28+62+28+47 Total Rock

27+68

27+50 = 00 Excav.

East side of Track.

27 Full Sec to Grade Ex. Ditch

125

150

168

179 = 00 Excav.

..... Cross Sections
Sta. B. S. H. I. F. S. Grade Gr. R.

Inst.
Rod.
Chain.


Left

C L

Right

Grand Hill Town Road
Sta 142 + 50

56
56
80
1.76
1.52
<hr/>
520

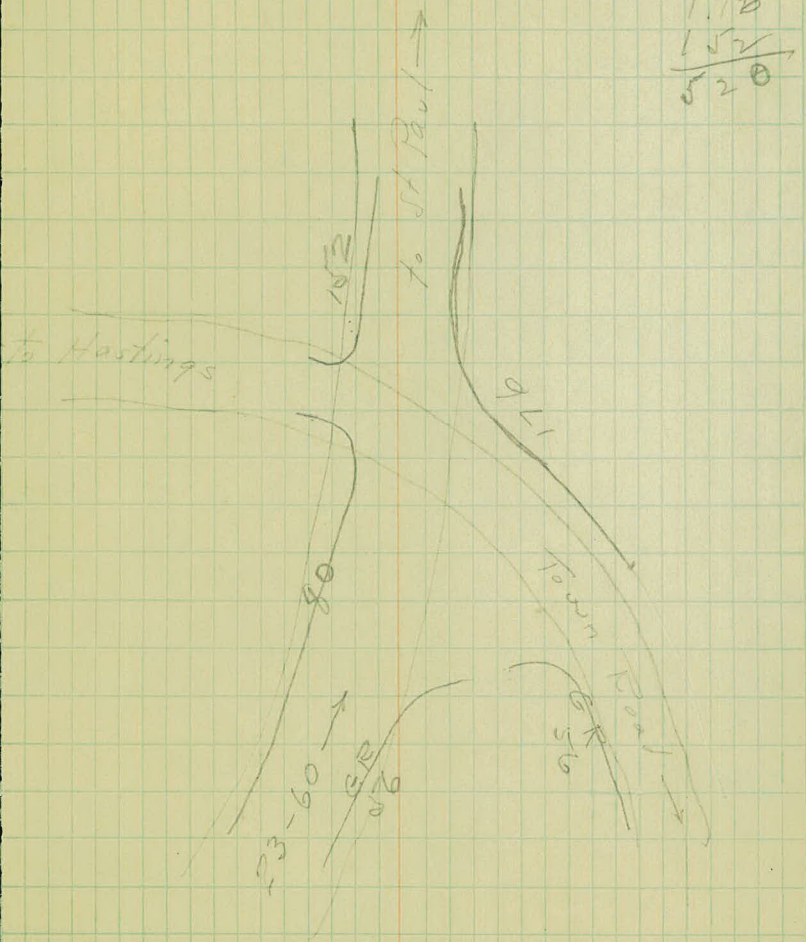

Sta. Cross			Sections	
	B. S.	H. I.	F. S.	Grade	Gr. R

Guord Rail.

123+39 ^o	to	127+15	Rt.	304'	8/22
122+64 ^o	to	126+64	Lt.	344'	8/22
91+82 ^o	to	93+50	Lt.	168'	8/23
92+22 ^o	to	93+50	Rt.	128'	8/23
113+00	to	117+45	Rt.		8/23-28
113+00	to	117+45	Lt.		8/23-28
0+84	to	18+50	Rt+Lt.		
118+00	to	120+24	Lt.		8/28
133+20	to	136+24	Lt.		8/29
87+00	to	88+76	Lt.		8/29
83+25	to	85+41	Lt.		8/29
83+75	to	84+39	Rt.		8/29
77+75	to	79+75	Rt.		8/30
77+75	to	79+75	Lt.		8/30

Inst.

Rod.

Chain.

30

22

67

Left

C L

Right

Sta.	B. S.	Cross		Grade	Sections
		H. I.	F. S.		
105+50	to 110+50		R+		9/3/24
105+50	to 116+50		L+		9/3/24
93+50	to 94+50		L+		9/3/24
91+00	to 92+22		R+		9/3/24
95+28	to 96+88		L+		9/30/24
97+69	to 99+45		L+		"
95+88	to 96+20		R+		"

Orig X Sect. for side Borrow Tct.

Cross Sections

Sta.	B. S.	H I.	F. S.	Grade	Gr. R.
B. M.	9.52	847.23		837.71	
60+50				839.40	2.8
T. P.	11.84	858.79	0.28	846.95	
60+00				837.50	21.3
59+75				836.60	v.v.v
59+50				835.70	v.v.v
T. P.	9.37	867.45	0.71	858.08	
59+25				834.70	32.7
59+05				834.00	33.4
58+85				833.20	34.4

Inst. Galvin
Rod. S. Ferguson
Chain. Fritz

Conner.

10-30-24

69

Left

C L

Right

$$\begin{array}{r} 10.0 \\ 241 \\ \hline \end{array} \quad \begin{array}{r} 9.3 \\ 573 \\ \hline \end{array} \quad \begin{array}{r} 7.8 \\ 50.0 \\ \hline \end{array}$$

$$\begin{array}{r} \checkmark \\ 10.6 \\ 29.0 \\ \hline \end{array} \quad \begin{array}{r} \checkmark \\ 10.4 \\ 40.0 \\ \hline \end{array} \quad \begin{array}{r} \checkmark \\ 10.6 \\ 50.0 \\ \hline \end{array}$$

$$\begin{array}{r} \checkmark \\ 6.5 \\ 35.7 \\ \hline \end{array} \quad \begin{array}{r} \checkmark \\ 4.1 \\ 50 \\ \hline \end{array}$$

$$\begin{array}{r} \checkmark \\ 0.3 \\ 39.0 \\ \hline \end{array} \quad \begin{array}{r} \checkmark \\ 0.0 \\ 50.0 \\ \hline \end{array}$$

$$\begin{array}{r} \checkmark \\ 5.4 \\ 42.0 \\ \hline \end{array} \quad \begin{array}{r} \checkmark \\ 5.3 \\ 50.0 \\ \hline \end{array}$$

$$\begin{array}{r} \checkmark \\ 4.3 \\ 44.0 \\ \hline \end{array} \quad \begin{array}{r} \checkmark \\ 4.3 \\ 50.0 \\ \hline \end{array}$$

$$\begin{array}{r} \checkmark \\ 4.2 \\ 45.0 \\ \hline \end{array} \quad \begin{array}{r} \checkmark \\ 4.0 \\ 50.0 \\ \hline \end{array}$$

classified Material
for No. 24

11-3-24

Sta.	B. S.	H. I.	F. S.	Cross Grade	Sections Gr. F
BM.	10.65	721.53		710.88	
27+25				709.10	12.4
+50				709.30	12.2
+79				709.80	11.7
+90				710.00	11.5
28				710.25	11.2

Inst. Calvin
 Rod. Skoglum
 Chain. Fritz

Left

C L

Right

Nail w. end bottom sill center piece Sta 27+80

top of	9.3 ✓	12.9	(12.7)	1.3 top of rock
	24.0	19.0	25.0	32.0 ←

top of	5.8 ✓	11.2	12.2	(+0.7) top of R
	31.0	25.0	15.0	33.0 ←

top of	4.8	11.2	10.6	(+2.0) top of R
	29.0	25.0	27.0	42.0 ←

top of R	2.4	11.2	9.8	1.7 top of R
	31.0	25.0	26.0	38.0 ←

top of	2.2	11.0	9.6	0.0 top of R
	28.0	25.0	26.0	39.0 ←

Grade Chg & Corrections from P. 64

Cross Sections

Sta.	B. S.	H. I.	F. S.	Grade	Gr. R.
T.P. 32	1.06 4.40	744.85	12.65	743.79 732.20 728.10	8.5
	6.30	750.09		743.79	
36				744.00	6.1
+50				745.60	4.5
37				747.10	3.0
+50				748.50	1.6
38	8 8.42	758.3	0.19	749.90 749.19	0.2
+50				751.30	2.0
39				752.70	5.6
+50				754.00	4.3
40				755.60	2.7
+50				757.45	0.8

Inst.
Rod.
Chain.

Spike Leftin 36" line C 50
00
15.0

Right
00
19

00 00
25.0

00
14.2

00
15.0

00
10.0

00
15.0

00
15.0

00
15.0

00
15.0

Inst.
Rod.
Chain.

Left

C L

Right

..... Cross Sections

Sta

D. S.

H. I.

F. S.

Grade

Gr. R.

Inst.
Rod.
Chain.

Left

C L

Right

..... Cross Sections
Sta. B. S. H. I. F. S. Grade Gr. R

Inst.
Rod.
Chain.

Left

C L

Right

Cross Sections

Sta. B. S. H. I. F. S. Grade Gr. R.

Inst.
Rod.
Chain.

Left

C L

Right

..... Cross Sections

Sta.

B. S.

H. I.

F. S.

Grade


Gr. R

Inst.
Rod.
Chain.

Left


C L

Right

 

DIETZGEN'S RAILROAD CURVE AND REDUCTION TABLES

Copyright, 1914, by Eugene Dietzgen Co., New York City

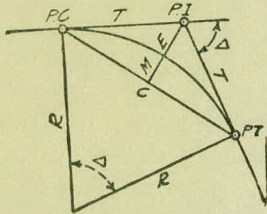

CURVE FORMULAS

Radius= $R = \frac{50}{\sin. D/2}$ (1) Degree of Curve= D and $\sin. \frac{D}{2} = \frac{50}{R}$ (2)

Tangent= $T = R \tan \frac{\Delta}{2}$ (3) Length of Curve= $L = 100 \frac{\Delta}{D}$ (4)

Middle ordinate= $M = R(1 - \cos. \frac{\Delta}{2})$ (5) $= R \text{vers} \frac{\Delta}{2}$ (6)

External= $E = T \tan \frac{\Delta}{4}$ (7) $= R \div \cos. \frac{\Delta}{2} - R$ (8) $= R \text{exsec} \frac{\Delta}{2}$ (9)

Long Chord= $C = 2 R \sin. \frac{\Delta}{2}$ (10) $\Delta =$ Central Angle

EXPLANATION AND USE OF TABLES

Stations.—Given P. I.—Sta. 161 + 60.35 to find Sta. of P. C. and P. T. $\Delta = 62^\circ 10'$ $D = 8^\circ 20'$. From Table IV for 1° curve $T = 3454.1$ and $\div 8\frac{1}{3} = 414.49$ ft. From Table V correction = .36 or $T = 414.85$ ft. P. C. = Sta. P. I. — $T = 157 + 45.50$. Also from (4) $L = 746.00$ and P. T. = Sta. P. C. + $L = 164 + 91.50$.

Offsets.—Tangent offsets vary (approximately) directly with D and with square of the distance. Thus tangent offset for Sta. 158 on above curve is 2.16 ft. found as follows. From Table III tangent offset for 100 ft. = 7.27 ft. Distance = 158 — Sta. P. C. = 54.50, hence offset = $7.27 (54.50 \div 100)^2 = 2.16$ ft. Also square of any distance divided by twice the radius equals (approximately) the distance from tangent to curve. Thus $(54.50)^2 \div (2 \times 688.26) = 2.16$ ft.

Deflections.—Deflection angle = $\frac{1}{2} D$ for 100 ft., $\frac{1}{4} D$ for 50 ft., etc. For c ft. = (in minutes) $.3 \times C \times D^\circ$ or = defl. for 1 ft. from Table III $\times C$. For Sta. 158 of above curve = $.3 \times 54.5 \times 8\frac{1}{3} = 136.2'$ or $2^\circ 16.2'$, or = $2.50 \times 54.5 = 136.2'$ from Table III. For Sta. 159 deflection angle = $2^\circ 16.2' + 8^\circ 20' \div 2 = 6^\circ 26.2'$, etc.

Externals.—May be found in similar manner to tangents. Thus E for curve above is 91.37. For from Table IV for 1° curve $E = 960.6$ for $8^\circ 20' = 960.6 \div 8\frac{1}{3} = 91.27$ and from Table V correction = .10 or $E = 91.37$ ft. Or suppose $\Delta = 32^\circ$ and E is measured and found to be 42 ft. What is D ? From Table IV $E = 230.9$ and $\div 42 = 5.5$ or $D = 5^\circ 30'$.

TABLE I.—MINUTES IN DECIMALS OF A DEGREE.

1'	.0167	11'	.1833	21'	.3500	31'	.5167	41'	.6833	51'	.8500
2	.0333	12	.2000	22	.3667	32	.5333	42	.7000	52	.8667
3	.0500	13	.2167	23	.3833	33	.5500	43	.7167	53	.8833
4	.0667	14	.2333	24	.4000	34	.5667	44	.7333	54	.9000
5	.0833	15	.2500	25	.4167	35	.5833	45	.7500	55	.9167
6	.1000	16	.2667	26	.4333	36	.6000	46	.7667	56	.9333
7	.1167	17	.2833	27	.4500	37	.6167	47	.7833	57	.9500
8	.1333	18	.3000	28	.4667	38	.6333	48	.8000	58	.9667
9	.1500	19	.3167	29	.4833	39	.6500	49	.8167	59	.9833
10	.1667	20	.3333	30	.5000	40	.6667	50	.8333	60	1.0000

TABLE II.—INCHES IN DECIMALS OF A FOOT.

1-16	3-32	¼	3-16	¼	5-16	⅜	½	⅝	¾	⅞
.0052	.0078	.0104	.0156	.0208	.0260	.0313	.0417	.0521	.0625	.0729
1	2	3	4	5	6	7	8	9	10	11
.0833	.1667	.2500	.3333	.4167	.5000	.5833	.6667	.7500	.8333	.9167

TABLE III.—RADII, ORDINATES AND DEFLECTIONS.

Deg.	Radius	Mid. Ord.	Tan. Offset	Def. for 1 Foot	Deg.	Radius	Mid. Ord.	Tan. Offset	Def. for 1 Foot
0° 10'	34377.5	.036	.145	0.05	7°	819.02	1.528	6.105	2.10'
20	17188.8	.073	.291	0.10	20'	781.84	1.600	6.395	2.20
30	11459.2	.109	.436	0.15	30	764.49	1.637	6.540	2.25
40	8594.42	.145	.582	0.20	40	747.89	1.673	6.685	2.30
50	6875.55	.182	.727	0.25					
1	5729.65	.218	.873	0.30	8	716.78	1.746	6.976	2.40
10	4911.15	.255	1.018	0.35	20	688.16	1.819	7.266	2.50
20	4297.28	.291	1.164	0.40	30	674.69	1.855	7.411	2.55
30	3819.83	.327	1.309	0.45	40	661.74	1.892	7.556	2.60
40	3437.87	.364	1.454	0.50					
50	3125.36	.400	1.600	0.55	9	637.28	1.965	7.846	2.70
					20	614.56	2.037	8.136	2.80
					30	603.80	2.074	8.281	2.85
					40	593.42	2.110	8.426	2.90
2	2864.93	.436	1.745	0.60					
10	2644.58	.473	1.891	0.65	10	573.69	2.183	8.716	3.00
20	2455.70	.509	2.036	0.70	30	546.44	2.292	9.150	3.15
30	2292.01	.545	2.181	0.75	11	521.67	2.402	9.585	3.30
40	2148.79	.582	2.327	0.80	30	499.06	2.511	10.02	3.45
50	2022.41	.618	2.472	0.85	12	478.34	2.620	10.45	3.60
					30	459.28	2.730	10.89	3.75
3	1910.08	.655	2.618	0.90	13	441.68	2.839	11.32	3.90
10	1809.57	.691	2.763	0.95	30	425.40	2.949	11.75	4.05
20	1719.12	.727	2.908	1.00	14	410.28	3.058	12.18	4.20
30	1637.28	.764	3.054	1.05	30	396.20	3.168	12.62	4.35
40	1562.88	.800	3.199	1.10					
50	1494.95	.836	3.345	1.15	15	383.07	3.277	13.05	4.50
					30	370.78	3.387	13.49	4.65
4	1432.69	.873	3.490	1.20	16	359.27	3.496	13.92	4.80
10	1375.40	.909	3.635	1.25	30	348.45	3.606	14.35	4.95
20	1322.53	.945	3.718	1.30	17	338.27	3.716	14.78	5.10
30	1273.57	.982	3.926	1.35	18	319.62	3.935	15.64	5.40
40	1228.11	1.018	4.071	1.40	19	302.94	4.155	16.51	5.70
50	1185.78	1.055	4.217	1.45					
					20	287.94	4.374	17.37	6.00
5	1146.28	1.091	4.362	1.50	21	274.37	4.594	18.22	6.30
10	1109.33	1.127	4.507	1.55	22	262.04	4.814	19.08	6.60
20	1074.68	1.164	4.653	1.60	23	250.79	5.035	19.94	6.90
30	1042.14	1.200	4.798	1.65	24	240.49	5.255	20.79	7.20
40	1011.51	1.237	4.943	1.70					
50	982.64	1.273	5.088	1.75	25	231.01	5.476	21.64	7.50
					26	222.27	5.697	22.50	7.80
6	955.37	1.309	5.234	1.80	27	214.18	5.918	23.35	8.10
10	929.57	1.346	5.379	1.85	28	206.68	6.139	24.19	8.40
20	905.13	1.382	5.524	1.90	29	199.70	6.360	25.04	8.70
30	881.95	1.418	5.669	1.95	30	193.18	6.583	25.88	9.00
40	859.92	1.455	5.814	2.00					

Note. Chord Deflection=2 times tangent deflection.

TABLE IV.—TANGENTS AND EXTERNALS TO A 1° CURVE.

Central Angle	Tangent	External	Central Angle	Tangent	External	Central Angle	Tangent	External
1°	50.00	.22	11°	551.70	26.50	21°	1061.9	97.57
10'	58.34	.30	10'	560.11	27.31	10'	1070.6	99.16
20'	66.67	.39	20	568.53	28.14	20	1079.2	100.75
30'	75.01	.49	30	576.95	28.97	30	1087.8	102.35
40'	83.34	.61	40	585.36	29.82	40	1096.4	103.97
50'	91.68	.73	50	593.79	30.68	50	1105.1	105.60
2	100.01	.87	12	602.21	31.56	22	1113.7	107.24
10	108.35	1.02	10	610.64	32.45	10	1122.4	108.90
20	116.68	1.19	20	619.07	33.35	20	1131.0	110.57
30	125.02	1.36	30	627.50	34.26	30	1139.7	112.25
40	133.36	1.55	40	635.93	35.18	40	1148.4	113.95
50	141.70	1.75	50	644.37	36.12	50	1157.0	115.66
3	150.04	1.96	13	652.81	37.07	23	1165.7	117.38
10	158.38	2.19	10	661.25	38.03	10	1174.4	119.12
20	166.72	2.43	20	669.70	39.01	20	1183.1	120.87
30	175.06	2.67	30	678.15	39.99	30	1191.8	122.63
40	183.40	2.93	40	686.60	40.99	40	1200.5	124.41
50	191.74	3.21	50	695.06	42.00	50	1209.2	126.20
4	200.08	3.49	14	703.51	43.03	24	1217.9	128.00
10	208.43	3.79	10	711.97	44.07	10	1226.6	129.82
20	216.77	4.10	20	720.44	45.12	20	1235.3	131.65
30	225.12	4.42	30	728.90	46.18	30	1244.0	133.50
40	233.47	4.76	40	737.37	47.25	40	1252.8	135.35
50	241.81	5.10	50	745.85	48.34	50	1261.5	137.23
5	250.16	5.46	15	754.32	49.44	25	1270.2	139.11
10	258.51	5.83	10	762.80	50.55	10	1279.0	141.01
20	266.86	6.21	20	771.29	51.68	20	1287.7	142.93
30	275.21	6.61	30	779.77	52.89	30	1296.5	144.85
40	283.57	7.01	40	788.26	53.97	40	1305.3	146.79
50	291.92	7.43	50	796.75	55.13	50	1314.0	148.75
6	300.28	7.86	16	805.25	56.31	26	1322.8	150.71
10	308.64	8.31	10	813.75	57.50	10	1331.6	152.69
20	316.99	8.76	20	822.25	58.70	20	1340.4	154.69
30	325.35	9.23	30	830.76	59.91	30	1349.2	156.70
40	333.71	9.71	40	839.27	61.14	40	1358.0	158.72
50	342.08	10.20	50	847.78	62.38	50	1366.8	160.76
7	350.44	10.71	17	856.30	63.63	27	1375.6	162.81
10	358.81	11.22	10	864.82	64.90	10	1384.4	164.86
20	367.17	11.75	20	873.35	66.18	20	1393.2	166.95
30	375.54	12.29	30	881.88	67.47	30	1402.0	169.04
40	383.91	12.85	40	890.41	68.77	40	1410.9	171.15
50	392.28	13.41	50	898.95	70.09	50	1419.7	173.27
8	400.66	13.99	18	907.49	71.42	28	1428.6	175.41
10	409.03	14.58	10	916.03	72.76	10	1437.4	177.55
20	417.41	15.18	20	924.58	74.12	20	1446.3	179.72
30	425.79	15.80	30	933.13	75.49	30	1455.1	181.89
40	434.17	16.43	40	941.69	76.86	40	1464.0	184.08
50	442.55	17.07	50	950.25	78.26	50	1472.9	186.29
9	450.93	17.72	19	958.81	79.67	29	1481.8	188.51
10	459.32	18.38	10	967.38	81.09	10	1490.7	190.74
20	467.71	19.06	20	975.96	82.53	20	1499.6	192.99
30	476.10	19.75	30	984.53	83.97	30	1508.5	195.25
40	484.49	20.45	40	993.12	85.43	40	1517.4	197.53
50	492.88	21.16	50	1001.7	86.90	50	1526.3	199.82
10	501.28	21.89	20	1010.3	88.39	30	1535.3	202.12
10	509.68	22.62	10	1018.9	89.89	10	1544.2	204.44
20	518.08	23.38	20	1027.5	91.40	20	1553.1	206.77
30	526.48	24.14	30	1036.1	92.92	30	1562.1	209.12
40	534.89	24.91	40	1044.7	94.46	40	1571.0	211.48
50	543.29	25.70	50	1053.3	96.01	50	1580.0	213.86

TABLE IV.—TANGENTS AND EXTERNALS TO A 1° CURVE.

Central Angle	Tangent	External	Central Angle	Tangent	External	Central Angle	Tangent	External
31°	1589.0	216.3	41°	2142.2	387.4	51°	2732.9	618.4
10'	1598.0	218.7	10'	2151.7	390.7	10'	2743.1	622.8
20	1606.9	221.1	20	2161.2	394.1	20	2753.4	627.2
30	1615.9	223.5	30	2170.8	397.4	30	2763.7	631.7
40	1624.9	226.0	40	2180.3	400.8	40	2773.9	636.2
50	1633.9	228.4	50	2189.9	404.2	50	2784.2	640.7
32	1643.0	230.9	42	2199.4	407.6	52	2794.5	645.2
10	1652.0	233.4	10	2209.0	411.1	10	2804.9	649.7
20	1661.0	235.9	20	2218.6	414.5	20	2815.2	654.3
30	1670.0	238.4	30	2228.1	418.0	30	2825.6	658.8
40	1679.1	241.0	40	2237.7	421.4	40	2835.9	663.4
50	1688.1	243.5	50	2247.3	425.0	50	2846.3	668.0
33	1697.2	246.1	43	2257.0	428.5	53	2856.7	672.7
10	1706.3	248.7	10	2266.6	432.0	10	2867.1	677.3
20	1715.3	251.3	20	2276.2	435.6	20	2877.5	682.0
30	1724.4	253.9	30	2285.9	439.2	30	2888.0	686.7
40	1733.5	256.5	40	2295.6	442.8	40	2898.4	691.4
50	1742.6	259.1	50	2305.2	446.4	50	2908.9	696.1
34	1751.7	261.8	44	2314.9	450.0	54	2919.4	700.9
10	1760.8	264.5	10	2324.6	453.6	10	2929.9	705.7
20	1770.0	267.2	20	2334.3	457.3	20	2940.4	710.5
30	1779.1	269.9	30	2344.1	461.0	30	2951.0	715.3
40	1788.2	272.6	40	2353.8	464.6	40	2961.5	720.1
50	1797.4	275.3	50	2363.5	468.4	50	2972.1	725.0
35	1806.6	278.1	45	2373.3	472.1	55	2982.7	729.9
10	1815.7	280.8	10	2383.1	475.8	10	2993.3	734.8
20	1824.9	283.6	20	2392.8	479.6	20	3003.9	739.7
30	1834.1	286.4	30	2402.6	483.8	30	3014.5	744.6
40	1843.3	289.2	40	2412.4	487.2	40	3025.2	749.6
50	1852.5	292.0	50	2422.3	491.0	50	3035.8	754.6
36	1861.7	294.9	46	2432.1	494.8	56	3046.5	759.6
10	1870.9	297.7	10	2441.9	498.7	10	3057.2	764.6
20	1880.1	300.6	20	2451.8	502.5	20	3067.9	769.7
30	1889.4	303.5	30	2461.7	506.4	30	3078.7	774.7
40	1898.6	306.4	40	2471.5	510.3	40	3089.4	779.8
50	1907.9	309.3	50	2481.4	514.3	50	3100.2	784.9
37	1917.1	312.2	47	2491.3	518.2	57	3110.9	790.1
10	1926.4	315.2	10	2501.2	522.2	10	3121.7	795.2
20	1935.7	318.1	20	2511.2	526.1	20	3132.6	800.4
30	1945.0	321.1	30	2521.1	530.1	30	3143.4	805.6
40	1954.3	324.1	40	2531.1	534.2	40	3154.2	810.9
50	1963.6	327.1	50	2541.0	538.2	50	3165.1	816.1
38	1972.9	330.2	48	2551.0	542.2	58	3176.0	821.4
10	1982.2	333.2	10	2561.0	546.3	10	3186.9	826.7
20	1991.5	336.3	20	2571.0	550.4	20	3197.8	832.0
30	2000.9	339.3	30	2581.0	554.5	30	3208.8	837.3
40	2010.2	342.4	40	2591.0	558.6	40	3219.7	842.7
50	2019.6	345.5	50	2601.1	562.8	50	3230.7	848.1
39	2029.0	348.6	49	2611.2	566.9	59	3241.7	853.5
10	2038.4	351.8	10	2621.2	571.1	10	3252.7	858.9
20	2047.8	354.9	20	2631.3	575.3	20	3263.7	864.3
30	2057.2	358.1	30	2641.4	579.5	30	3274.8	869.8
40	2066.6	361.3	40	2651.5	583.8	40	3285.8	875.3
50	2076.0	364.5	50	2661.6	588.0	50	3296.9	880.8
40	2085.4	367.7	50	2671.8	592.3	60	3308.0	886.4
10	2094.9	371.0	10	2681.9	596.6	10	3319.1	892.0
20	2104.3	374.2	20	2692.1	600.9	20	3330.3	897.5
30	2113.8	377.5	30	2702.3	605.3	30	3341.4	903.2
40	2123.3	380.8	40	2712.5	609.6	40	3352.6	908.8
50	2132.7	384.1	50	2722.7	614.0	50	3363.8	914.5

TABLE IV.—TANGENTS AND EXTERNALS TO A 1° CURVE.

Central Angle	Tangent	External	Central Angle	Tangent	External	Central Angle	Tangent	External
61°	3375.0	920.2	71°	4088.9	1308.2	81°	4893.6	1805.3
10'	3386.3	925.9	10'	4099.5	1315.6	10'	4908.0	1814.7
20	3397.5	931.6	20	4112.1	1322.9	20	4922.5	1824.1
30	3408.8	937.3	30	4124.8	1330.3	30	4937.0	1833.6
40	3420.1	943.1	40	4137.4	1337.7	40	4951.5	1843.1
50	3431.4	948.9	50	4150.1	1345.1	50	4966.1	1852.6
62	3442.7	954.8	72	4162.8	1352.6	82	4980.7	1862.3
10	3454.1	960.6	10	4175.6	1360.1	10	4995.4	1871.8
20	3465.4	966.5	20	4188.5	1367.6	20	5010.0	1881.5
30	3476.8	972.4	30	4201.2	1375.2	30	5024.8	1891.2
40	3488.3	978.3	40	4214.0	1382.8	40	5039.5	1900.9
50	3499.7	984.3	50	4226.8	1390.4	50	5054.3	1910.7
63	3511.1	990.2	73	4239.7	1398.0	83	5069.2	1920.5
10	3522.6	996.2	10	4252.6	1405.7	10	5084.0	1930.4
20	3534.1	1002.3	20	4265.6	1413.5	20	5099.0	1940.3
30	3545.6	1008.3	30	4278.5	1421.2	30	5113.9	1950.3
40	3557.2	1014.4	40	4291.5	1429.0	40	5128.9	1960.2
50	3568.7	1020.5	50	4304.6	1436.8	50	5143.9	1970.3
64	3580.3	1026.6	74	4317.6	1444.6	84	5159.0	1980.4
10	3591.9	1032.8	10	4330.7	1452.5	10	5174.1	1990.5
20	3603.5	1039.0	20	4343.8	1460.4	20	5189.3	2000.6
30	3615.1	1045.2	30	4356.9	1468.4	30	5204.4	2010.8
40	3626.8	1051.4	40	4370.1	1476.4	40	5219.7	2021.1
50	3638.5	1057.7	50	4383.3	1484.4	50	5234.9	2031.4
65	3650.2	1063.9	75	4396.5	1492.4	85	5250.3	2041.7
10	3661.9	1070.2	10	4409.8	1500.5	10	5265.6	2052.1
20	3673.7	1076.6	20	4423.1	1508.6	20	5281.0	2062.5
30	3685.4	1082.9	30	4436.4	1516.7	30	5296.4	2073.0
40	3697.2	1089.3	40	4449.7	1524.9	40	5311.9	2083.5
50	3709.0	1095.7	50	4463.1	1533.1	50	5327.4	2094.1
66	3720.9	1102.2	76	4476.5	1541.4	86	5343.0	2104.7
10	3732.7	1108.6	10	4489.9	1549.7	10	5358.6	2115.3
20	3744.6	1115.1	20	4503.4	1558.0	20	5374.2	2126.0
30	3756.5	1121.7	30	4516.9	1566.3	30	5389.9	2136.7
40	3768.5	1128.2	40	4530.4	1574.7	40	5405.6	2147.5
50	3780.4	1134.8	50	4544.0	1583.1	50	5421.4	2158.4
67	3792.4	1141.4	77	4557.6	1591.6	87	5437.2	2169.2
10	3804.4	1148.0	10	4571.2	1600.1	10	5453.1	2180.2
20	3816.4	1154.7	20	4584.8	1608.6	20	5469.0	2191.1
30	3828.4	1161.3	30	4598.5	1617.1	30	5484.9	2202.2
40	3840.5	1168.1	40	4612.2	1625.7	40	5500.9	2213.2
50	3852.6	1174.8	50	4626.0	1634.4	50	5517.0	2224.3
68	3864.7	1181.6	78	4639.8	1643.0	88	5533.1	2235.5
10	3876.8	1188.4	10	4653.6	1651.7	10	5549.2	2246.7
20	3889.0	1195.2	20	4667.4	1660.5	20	5565.4	2258.0
30	3901.2	1202.0	30	4681.3	1669.2	30	5581.6	2269.3
40	3913.4	1208.9	40	4695.2	1678.1	40	5597.8	2280.6
50	3925.6	1215.8	50	4709.2	1686.9	50	5614.2	2292.0
69	3937.9	1222.7	79	4723.2	1695.8	89	5630.5	2303.5
10	3950.2	1229.7	10	4737.2	1704.7	10	5646.9	2315.0
20	3962.5	1236.7	20	4751.2	1713.7	20	5663.4	2326.6
30	3974.8	1243.7	30	4765.3	1722.7	30	5679.9	2338.2
40	3987.2	1250.8	40	4779.4	1731.7	40	5696.4	2349.8
50	3999.5	1257.9	50	4793.6	1740.8	50	5713.0	2361.5
70	4011.9	1265.0	80	4807.7	1749.9	90	5729.7	2373.3
10	4024.4	1272.1	10	4822.0	1759.0	10	5746.3	2385.1
20	4036.8	1279.3	20	4836.2	1768.2	20	5763.1	2397.0
30	4049.3	1286.5	30	4850.5	1777.4	30	5779.9	2408.9
40	4061.8	1293.6	40	4864.8	1786.7	40	5796.7	2420.9
50	4074.4	1300.9	50	4879.2	1796.0	50	5813.6	2432.9

TABLE IV.—TANGENTS AND EXTERNALS TO A 1° CURVE.

Central Angle	Tangent	External	Central Angle	Tangent	External	Central Angle	Tangent	External
91°	5830.5	2444.9	101°	6950.6	3278.1	111°	8336.7	4386.1
10'	5847.5	2457.1	10'	6971.3	3294.1	10'	8362.7	4407.6
20	5864.6	2469.3	20	6992.0	3310.1	20	8388.9	4429.2
30	5881.7	2481.5	30	7012.7	3326.1	30	8415.1	4450.9
40	5898.8	2493.8	40	7033.6	3342.3	40	8441.5	4472.7
50	5916.0	2506.1	50	7054.5	3358.5	50	8468.0	4494.0
92	5933.2	2518.5	102	7075.5	3374.9	112	8494.6	4516.6
10	5950.5	2531.0	10	7096.6	3391.2	10	8521.3	4538.8
20	5967.9	2543.5	20	7117.8	3407.7	20	8548.1	4561.1
30	5985.3	2556.0	30	7139.0	3424.3	30	8575.0	4583.4
40	6002.7	2568.6	40	7160.3	3440.9	40	8602.1	4606.0
50	6020.2	2581.3	50	7181.7	3457.6	50	8629.3	4628.6
93	6037.8	2594.0	103	7203.2	3474.4	113	8656.6	4651.3
10	6055.4	2606.8	10	7224.7	3491.3	10	8684.0	4674.2
20	6073.1	2619.7	20	7246.3	3508.2	20	8711.5	4697.2
30	6090.8	2632.6	30	7268.0	3525.2	30	8739.2	4720.3
40	6108.6	2645.5	40	7289.8	3542.4	40	8767.0	4743.6
50	6126.4	2658.5	50	7311.7	3559.6	50	8794.9	4766.9
94	6144.3	2671.6	104	7333.6	3576.8	114	8822.9	4790.4
10	6162.6	2684.7	10	7355.6	3594.2	10	8851.0	4814.1
20	6180.2	2697.9	20	7377.8	3611.7	20	8879.3	4837.8
30	6198.3	2711.2	30	7399.9	3629.2	30	8907.7	4861.7
40	6216.4	2724.5	40	7422.2	3646.8	40	8936.3	4885.7
50	6234.6	2737.9	50	7444.6	3664.5	50	8965.0	4909.9
95	6252.8	2751.3	105	7467.0	3682.3	115	8993.8	4934.1
10	6271.1	2764.8	10	7489.6	3700.2	10	9022.7	4958.6
20	6289.4	2778.3	20	7512.2	3718.2	20	9051.7	4983.1
30	6307.9	2792.0	30	7534.9	3736.2	30	9080.9	5007.3
40	6326.3	2805.6	40	7557.7	3754.4	40	9110.3	5032.6
50	6344.8	2819.4	50	7580.5	3772.6	50	9139.8	5057.6
96	6363.4	2833.2	106	7603.5	3791.0	116	9169.4	5082.7
10	6382.1	2847.0	10	7626.6	3809.4	10	9199.1	5107.9
20	6400.8	2861.0	20	7649.7	3827.9	20	9229.0	5133.3
30	6419.5	2875.0	30	7672.9	3846.5	30	9259.0	5158.8
40	6438.4	2889.0	40	7696.3	3865.2	40	9289.2	5184.5
50	6457.3	2903.1	50	7719.7	3884.0	50	9319.5	5210.3
97	6476.2	2917.3	107	7743.2	3902.9	117	9349.9	5236.2
10	6495.2	2931.6	10	7766.8	3921.9	10	9380.5	5262.3
20	6514.3	2945.9	20	7790.5	3940.9	20	9411.3	5288.6
30	6533.4	2960.3	30	7814.3	3960.1	30	9442.2	5315.0
40	6552.6	2974.7	40	7838.1	3979.4	40	9473.2	5341.5
50	6571.9	2989.2	50	7862.1	3998.7	50	9504.4	5368.2
98	6591.2	3003.8	108	7886.2	4018.2	118	9535.7	5395.1
10	6610.6	3018.4	10	7910.4	4037.8	10	9567.2	5422.1
20	6630.1	3033.1	20	7934.6	4057.4	20	9598.9	5449.2
30	6649.6	3047.9	30	7959.0	4077.2	30	9630.7	5476.5
40	6669.2	3062.8	40	7983.5	4097.1	40	9662.6	5504.0
50	6688.8	3077.7	50	8008.0	4117.0	50	9694.7	5531.7
99	6708.6	3092.7	109	8032.7	4137.1	119	9727.0	5559.4
10	6728.4	3107.7	10	8057.4	4157.3	10	9759.4	5587.4
20	6748.2	3122.9	20	8082.3	4177.5	20	9792.0	5615.5
30	6768.1	3138.1	30	8107.3	4197.9	30	9824.8	5643.8
40	6788.1	3153.3	40	8132.3	4218.4	40	9857.7	5672.3
50	5808.2	3168.7	50	8157.5	4239.0	50	9890.8	5700.9
100	6828.3	3184.1	110	8182.8	4259.7	120	9924.0	5729.7
10	6848.5	3199.6	10	8208.2	4280.5	10	9957.5	5758.6
20	6868.8	3215.1	20	8233.7	4301.4	20	9991.0	5787.7
30	6889.2	3230.8	30	8259.3	4322.4	30	10025.0	5817.0
40	6909.6	3246.5	40	8285.0	4343.6	40	10059.0	5846.5
50	6930.1	3262.3	50	8310.8	4364.8	50	10093.0	5876.1

TABLE V.—CORRECTIONS FOR TANGENTS AND EXTERNALS.

These corrections are to be added to the approximate values, found by dividing the tangent, or external, for a 1° curve (Table IV) by the degree of curve, in order to obtain the true tangents, or externals. Intermediate values may be obtained by interpolation.

FOR TANGENTS ADD

Central Angle	DEGREE OF CURVE													
	5°	10°	15°	20°	25°	30°	35°	40°	45°	50°	55°	60°	65°	70°
10°	.03	.06	.09	.13	.16	.19	.22	.25	.28	.31	.34	.38	.42	.46
15°	.04	.10	.14	.19	.24	.29	.34	.39	.45	.51	.53	.58	.63	.68
20°	.06	.13	.19	.26	.32	.39	.45	.51	.58	.65	.72	.79	.84	.90
25°	.08	.16	.24	.33	.40	.49	.58	.67	.75	.83	.90	.99	1.06	1.14
30°	.10	.19	.29	.39	.49	.59	.69	.79	.89	.99	1.09	1.20	1.29	1.39
35°	.11	.22	.34	.47	.58	.69	.79	.81	.92	1.04	1.29	1.42	1.54	1.66
40°	.13	.26	.40	.53	.67	.80	.93	1.06	1.20	1.34	1.49	1.64	1.79	1.94
45°	.15	.30	.44	.60	.76	.91	1.06	1.21	1.37	1.52	1.70	1.87	2.04	2.21
50°	.17	.34	.51	.68	.85	1.02	1.19	1.36	1.54	1.72	1.91	2.10	2.29	2.48
55°	.19	.38	.57	.76	.95	1.14	1.32	1.52	1.72	1.92	2.14	2.35	2.56	2.77
60°	.21	.42	.63	.84	1.05	1.27	1.49	1.71	1.94	2.17	2.38	2.60	2.83	3.07
65°	.23	.46	.69	.93	1.16	1.40	1.64	1.88	2.13	2.38	2.63	2.88	3.13	3.39
70°	.25	.51	.76	1.02	1.28	1.54	1.80	2.06	2.33	2.60	2.88	3.16	3.44	3.72
75°	.27	.56	.83	1.12	1.40	1.69	1.98	2.27	2.57	2.87	3.16	3.47	3.78	4.09
80°	.30	.61	.91	1.22	1.53	1.84	2.15	2.46	2.78	3.10	3.44	3.78	4.12	4.46
85°	.33	.66	1.00	1.33	1.68	2.02	2.36	2.70	3.05	3.40	3.77	4.14	4.55	4.89
90°	.36	.72	1.09	1.45	1.83	2.20	2.57	2.94	3.32	3.70	4.10	4.50	4.91	5.32
95°	.39	.79	1.19	1.55	2.00	2.40	2.80	3.20	3.61	4.02	4.40	4.98	5.38	5.83
100°	.43	.86	1.30	1.74	2.18	2.62	3.06	3.50	3.95	4.40	4.88	5.37	5.85	6.34
110°	.48	1.03	1.56	2.08	2.61	3.14	3.67	4.21	4.76	5.31	5.86	6.43	7.01	7.60
120°	.62	1.25	1.93	2.52	3.16	3.81	4.45	5.11	5.77	6.44	7.12	7.80	8.50	9.22

FOR EXTERNALS ADD

Central Angle.	DEGREE OF CURVE													
	5°	10°	15°	20°	25°	30°	35°	40°	45°	50°	55°	60°	65°	70°
10°	.001	.003	.004	.006	.007	.008	.009	.011	.012	.014	.015	.017	.018	.020
15°	.003	.007	.010	.014	.018	.023	.027	.029	.032	.035	.039	.043	.047	.051
20°	.006	.011	.017	.022	.028	.034	.038	.045	.051	.057	.063	.070	.076	.083
25°	.009	.018	.027	.036	.046	.056	.065	.074	.083	.093	.106	.120	.127	.135
30°	.013	.025	.038	.051	.065	.078	.090	.103	.116	.129	.149	.170	.179	.188
35°	.018	.035	.054	.072	.086	.109	.131	.153	.175	.197	.213	.230	.247	.264
40°	.023	.046	.070	.093	.117	.141	.172	.203	.234	.265	.277	.290	.315	.341
45°	.030	.060	.093	.119	.153	.184	.216	.254	.289	.325	.351	.378	.411	.445
50°	.037	.075	.116	.151	.189	.227	.266	.305	.345	.384	.425	.467	.508	.550
55°	.046	.093	.142	.188	.236	.283	.332	.381	.420	.479	.530	.582	.641	.700
60°	.056	.112	.168	.225	.283	.340	.398	.457	.516	.575	.636	.697	.774	.851
65°	.067	.135	.204	.273	.343	.412	.483	.554	.625	.697	.771	.845	.922	1.01
70°	.080	.159	.240	.321	.403	.485	.568	.652	.735	.819	.906	.994	1.08	1.17
75°	.095	.182	.266	.353	.440	.528	.618	.707	.797	.887	1.07	1.18	1.29	1.39
80°	.110	.220	.332	.445	.558	.671	.787	.903	1.02	1.13	1.25	1.38	1.50	1.62
85°	.128	.259	.391	.524	.657	.790	.926	1.06	1.20	1.34	1.47	1.62	1.76	1.91
90°	.149	.299	.450	.603	.756	.910	1.07	1.22	1.38	1.54	1.70	1.87	2.03	2.20
95°	.174	.350	.522	.706	.885	1.06	1.25	1.43	1.62	1.80	1.99	2.18	2.38	2.58
100°	.200	.401	.604	.809	1.01	1.22	1.43	1.64	1.85	2.06	2.28	2.50	2.73	2.96
110°	.263	.536	.806	1.08	1.35	1.63	1.91	2.20	2.48	2.76	3.05	3.35	3.66	3.96
120°	.360	.721	1.08	1.45	1.82	2.19	2.57	2.95	3.33	3.72	4.11	4.50	4.91	5.32

TABLE VI.—CORRECTIONS FOR SUB-CHORDS AND LONG CHORDS.

FOR SUB-CHORDS ADD										Excess of arc per 100 ft.	LONG CHORDS				
D	10	20	30	40	50	60	70	80	90		D	200	300	400	500
4°	.00	.00	.01	.01	.01	.01	.01	.01	.00	.02	1	199.99	299.97	399.92	499.85
6	.00	.01	.01	.02	.02	.02	.02	.01	.01	.05	2	199.97	299.88	399.70	499.39
8	.01	.02	.02	.03	.03	.03	.03	.02	.01	.08	3	199.93	299.73	399.32	498.63
10	.01	.02	.03	.04	.05	.05	.05	.04	.02	.13	4	199.88	299.51	398.78	497.57
12	.02	.04	.05	.06	.07	.07	.07	.05	.03	.18	5	199.81	299.24	398.10	496.20
14	.02	.05	.07	.08	.09	.10	.09	.07	.04	.25	6	199.73	298.90	397.26	494.53
16	.03	.06	.09	.11	.12	.12	.12	.09	.05	.33	7	199.63	298.51	396.28	492.57
18	.04	.08	.11	.14	.15	.16	.15	.12	.07	.41	8	199.51	298.05	395.14	490.31
20	.05	.10	.14	.17	.19	.20	.18	.15	.09	.51	9	199.38	297.54	393.86	487.75
22	.06	.12	.17	.21	.23	.24	.22	.18	.10	.62	10	199.24	296.96	392.42	484.90
24	.07	.14	.20	.25	.28	.28	.26	.21	.12	.74	12	198.90	295.63	389.12	478.34
26	.09	.17	.24	.29	.32	.33	.31	.25	.15	.86	14	198.51	294.06	385.22	470.65
28	.10	.19	.27	.34	.37	.38	.36	.29	.17	1.00	16	198.05	292.25	380.76	461.86
30	.11	.22	.31	.39	.43	.44	.41	.33	.19	1.15	18	197.54	290.21	375.74	452.02
32	.13	.25	.36	.44	.49	.50	.47	.38	.22	1.31	20	196.96	287.94	370.17	441.15
34	.15	.28	.40	.50	.55	.57	.53	.43	.25	1.48	22	196.32	285.44	364.06	429.30
36	.17	.32	.45	.56	.62	.64	.59	.48	.28	1.66	24	195.63	282.71	357.43	416.53
38	.18	.36	.51	.62	.70	.71	.66	.53	.31	1.86	26	194.87	279.76	350.30	402.89
40	.21	.40	.56	.69	.77	.79	.73	.59	.35	2.06	28	194.06	276.59	342.69	388.43
42	.23	.44	.62	.76	.85	.87	.81	.65	.38	2.28	30	193.18	273.20	334.61	373.20
44	.25	.48	.68	.84	.94	.96	.89	.72	.42	2.50	32	192.25	269.61	326.08	357.28
46	.27	.52	.75	.92	1.02	1.05	.98	.78	.46	2.74	34	191.26	265.81	317.12	340.73
48	.30	.57	.81	1.00	1.12	1.14	1.06	.86	.50	2.99	36	190.21	261.80	307.77	323.61
50	.32	.62	.89	1.09	1.21	1.24	1.15	.93	.55	3.24	38	189.10	257.60	298.03	305.99
52	.35	.67	.96	1.18	1.31	1.35	1.25	1.01	.59	3.52	40	187.94	253.21	287.94	287.94
54	.38	.73	1.04	1.28	1.42	1.46	1.35	1.09	.64	3.80	42	186.72	248.63	277.51	269.54
56	.41	.78	1.12	1.38	1.53	1.57	1.46	1.17	.69	4.09	44	185.44	243.87	266.78	250.85
58	.44	.84	1.20	1.48	1.65	1.69	1.57	1.26	.74	4.40	46	184.10	239.93	255.78	231.95
60	.47	.91	1.29	1.59	1.76	1.81	1.68	1.35	.80	4.72	48	182.71	233.83	244.51	212.92

NOTE.—When a chord of less than 100 ft. is used the corrections given in the above table should be added to the nominal length of chord to get the length which should be used in order that the 100 ft. points will check with those obtained by using the standard 100 ft. chord. Thus in locating a 14° curve by 25 ft. chords measure 25'.06 for each chord. Long chords are useful in passing obstacles.

TABLE VII.—MIDDLE ORDINATES FOR RAILS IN FEET.

Deg. of Curve	LENGTH OF RAILS						Deg. of Curve	LENGTH OF RAILS.							
	32	30	28	26	24	22		20	32	30	28	26	24	22	20
1°	.022	.020	.016	.013	.011	.009	.008	16°	.356	.313	.273	.236	.200	.170	.139
2	.045	.038	.034	.029	.025	.021	.017	17	.378	.333	.290	.252	.213	.180	.148
3	.037	.058	.051	.044	.037	.031	.026	18	.400	.351	.306	.265	.225	.190	.156
4	.089	.079	.069	.060	.050	.042	.035	19	.423	.371	.324	.280	.238	.201	.165
5	.112	.099	.086	.074	.063	.053	.044	20	.445	.392	.341	.296	.250	.212	.174
6	.134	.117	.102	.088	.076	.064	.052	21	.466	.410	.357	.309	.262	.222	.182
7	.156	.137	.120	.104	.088	.074	.061	22	.487	.430	.375	.325	.275	.233	.191
8	.179	.158	.137	.119	.100	.085	.070	23	.509	.450	.390	.338	.287	.243	.199
9	.201	.175	.153	.133	.112	.095	.078	24	.531	.469	.408	.354	.299	.253	.208
10	.223	.196	.171	.148	.125	.106	.087	25	.552	.486	.424	.367	.311	.263	.216
11	.245	.216	.188	.163	.139	.117	.096	26	.573	.506	.441	.382	.323	.274	.225
12	.268	.236	.206	.179	.151	.128	.105	27	.594	.524	.457	.396	.335	.284	.233
13	.290	.254	.222	.192	.163	.138	.113	28	.618	.545	.475	.411	.348	.294	.242
14	.312	.275	.239	.207	.175	.148	.122	29	.638	.564	.491	.424	.361	.303	.250
15	.334	.295	.257	.223	.188	.159	.131	30	.660	.583	.508	.438	.374	.313	.259



SLOPE REDUCTIONS.

When distances are measured on a slope they may be reduced to the equivalent horizontal distance by the following approximate rule:— subtract from the slope distance the square of the rise divided by twice the slope distance. Thus for a slope distance of 250.3 ft. and a rise of 15 ft. correction = $15^2 \div 2 \times 250.3 = .45$ (by slide rule) or horizontal distance = $250.3 - .45 = 249.85$. When vertical angle = V. A. is measured horizontal distance = slope distance — slope distance $(1 - \text{Cos. V. A.})$. Thus for slope distance of 248.7 ft. and V. A. of $4^\circ 20'$ from Table VIII $\text{Cos.} = .99714$ and correction = $1 - .99714 = .00286$ per foot or total of $.286 \times 2\frac{1}{2}$ (near enough) = .57 and horizontal distance = $248.7 - .57 = 248.13$ ft.

See fig. (a).

TRIGONOMETRICAL FORMULAS.

$$\begin{aligned} \sin. & A = \frac{a}{c} \\ \cos. & A = \frac{b}{c} \\ \tan. & A = \frac{a}{b} \\ \cot. & A = \frac{b}{a} \\ \sec. & A = \frac{c}{b} \\ \text{cosec.} & A = \frac{c}{a} \end{aligned}$$

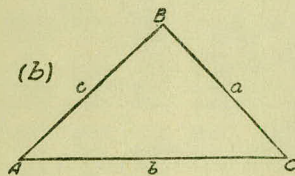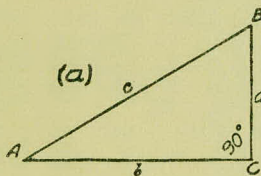

FORMULA FOR SOLVING TRIANGLES.

Given	Sought.	Right triangles. See fig. (a).
a, c	A, B, b	$\sin. A = \frac{a}{c}, \cos. B = \frac{a}{c}, b = \sqrt{(c+a)(c-a)}$
a, b	A, B, c	$\tan. A = \frac{a}{b}, \cot. B = \frac{a}{b}, c = \sqrt{a^2 + b^2}$
A, a	B, b, c	$B = 90^\circ - A, b = a \cot. A, c = \frac{a}{\sin. A}$
A, b	B, a, c	$B = 90^\circ - A, a = b \tan. A, c = \frac{b}{\cos. A}$
A, c	B, a, b	$B = 90^\circ - A, a = c \sin. A, b = c \cos. A$
Given	Sought.	Oblique triangles. See fig. (b).
A, B, a	b	$b = \frac{a \sin. B}{\sin. A}$
A, a, b	B	$\sin. B = \frac{b \sin. A}{a}$
a, b, C	$A - B$	$\tan. \frac{1}{2}(A - B) = \frac{(a - b) \tan. \frac{1}{2}(A + B)}{a + b}$
a, b, c	A	$\left\{ \begin{aligned} &\text{If } s = \frac{1}{2}(a + b + c), \sin. \frac{1}{2}A = \sqrt{\frac{(s-b)(s-c)}{bc}} \\ &\cos. \frac{1}{2}A = \sqrt{\frac{s(s-a)}{bc}}, \tan. \frac{1}{2}A = \sqrt{\frac{(s-b)(s-c)}{s(s-a)}}, \\ &\sin. A = \frac{2\sqrt{s(s-a)(s-b)(s-c)}}{bc} \end{aligned} \right.$
A, B, C, a	area	$\text{area} = \frac{a^2 \sin. B \sin. C}{2 \sin. A}$
A, b, c	area	$\text{area} = \frac{1}{2}bc \sin. A$
a, b, c	area	$s = \frac{1}{2}(a + b + c), \text{area} = \sqrt{s(s-a)(s-b)(s-c)}$

TABLE VIII.—NATURAL TRIGONOMETRICAL FUNCTIONS.

Angle	Sine.	Tan.	Cotg.	Cosin.		Angle	Sine.	Tan.	Cotg.	Cosin.	
0	0	0	∞	1	90	0	0	∞	1	0	
10	.0029	.0029	343.8	I	50	8	.1392	.1405	7.115	.99027	
20	.0058	.0058	171.9	.99998	40	10	.1421	.1435	6.968	.98986	
30	.0087	.0087	114.6	.99996	30	20	.1449	.1465	6.827	.98944	
40	.0116	.0116	85.94	.99993	20	30	.1478	.1495	6.691	.98902	
50	.0145	.0145	68.75	.99989	10	40	.1507	.1524	6.561	.98858	
						50	.1536	.1554	6.435	.98814	
1	.0175	.0175	57.29	.99985	89	9	.1564	.1584	6.314	.98769	
10	.0204	.0204	49.10	.99979	50	10	.1593	.1614	6.197	.98723	
20	.0233	.0233	42.96	.99973	40	20	.1622	.1644	6.084	.98676	
30	.0262	.0262	38.19	.99966	30	30	.1650	.1673	5.976	.98629	
40	.0291	.0291	34.37	.99958	20	40	.1679	.1703	5.871	.98580	
50	.0320	.0320	31.24	.99949	10	50	.1708	.1738	5.769	.98531	
2	.0349	.0349	28.64	.99939	88	10	.1736	.1763	5.671	.98481	
10	.0378	.0378	26.43	.99929	50	10	.1765	.1793	5.576	.98430	
20	.0407	.0407	24.54	.99917	40	20	.1794	.1823	5.485	.98378	
30	.0436	.0437	22.90	.99905	30	30	.1822	.1853	5.396	.98325	
40	.0465	.0466	21.47	.99892	20	40	.1851	.1883	5.309	.98272	
50	.0494	.0495	20.21	.99878	10	50	.1880	.1914	5.226	.98218	
3	.0523	.0524	19.08	.99863	87	11	.1908	.1944	5.145	.98163	
10	.0552	.0553	18.07	.99847	50	10	.1937	.1974	5.066	.98107	
20	.0581	.0582	17.17	.99831	40	20	.1965	.2004	4.989	.98050	
30	.0610	.0612	16.35	.99813	30	30	.1994	.2035	4.915	.97992	
40	.0640	.0641	15.60	.99795	20	40	.2022	.2065	4.843	.97934	
50	.0669	.0670	14.92	.99776	10	50	.2051	.2095	4.773	.97875	
4	.0698	.0699	14.30	.99756	86	12	.2079	.2126	4.705	.97815	
10	.0727	.0729	13.73	.99736	50	10	.2108	.2156	4.638	.97754	
20	.0756	.0758	13.20	.99714	40	20	.2136	.2186	4.574	.97692	
30	.0785	.0787	12.71	.99692	30	30	.2164	.2217	4.511	.97630	
40	.0814	.0816	12.25	.99668	20	40	.2193	.2247	4.449	.97566	
50	.0843	.0846	11.83	.99644	10	50	.2221	.2278	4.390	.97502	
5	.0872	.0875	11.43	.99619	85	13	.2250	.2309	4.331	.97437	
10	.0901	.0904	11.06	.99594	50	10	.2278	.2339	4.275	.97371	
20	.0929	.0934	10.71	.99567	40	20	.2306	.2370	4.219	.97304	
30	.0958	.0963	10.39	.99540	30	30	.2334	.2401	4.165	.97237	
40	.0987	.0992	10.08	.99511	20	40	.2363	.2432	4.113	.97169	
50	.1016	.1022	9.788	.99482	10	50	.2391	.2462	4.061	.97100	
6	.1045	.1051	9.514	.99452	84	14	.2419	.2493	4.011	.97030	
10	.1074	.1080	9.255	.99421	50	10	.2447	.2524	3.962	.96959	
20	.1103	.1110	9.010	.99390	40	20	.2476	.2555	3.914	.96887	
30	.1132	.1139	8.777	.99357	30	30	.2504	.2586	3.867	.96815	
40	.1161	.1169	8.556	.99324	20	40	.2532	.2617	3.821	.96742	
50	.1190	.1198	8.345	.99290	10	50	.2560	.2648	3.776	.96667	
7	.1219	.1228	8.144	.99255	83	15	.2588	.2679	3.732	.96593	
10	.1248	.1257	7.953	.99219	50	10	.2616	.2711	3.689	.96517	
20	.1276	.1287	7.770	.99182	40	20	.2644	.2742	3.647	.96440	
30	.1305	.1317	7.596	.99144	30	30	.2672	.2773	3.606	.96363	
40	.1334	.1346	7.429	.99106	20	40	.2700	.2805	3.566	.96285	
50	.1363	.1376	7.269	.99067	10	50	.2728	.2836	3.526	.96206	
					82					74	
	Cosin.	Cotg.	Tan.	Sine.	Angle.		Cosin.	Cotg.	Tan.	Sine.	Angle.

TABLE VIII.—NATURAL TRIGONOMETRICAL FUNCTIONS.

Angle	Sine.	Tan.	Cotg.	Cosin.		Angle	Sine.	Tan.	Cotg.	Cosin.	
<i>or</i> 16	.2756	.2867	3.487	.96126	74	<i>or</i> 24	.4067	.4452	2.246	.91355	66
10	.2784	.2899	3.450	.96046	50	10	.4094	.4487	2.229	.91236	50
20	.2812	.2931	3.412	.95964	40	20	.4120	.4522	2.211	.91116	40
30	.2840	.2962	3.376	.95882	30	30	.4147	.4557	2.194	.90996	30
40	.2868	.2994	3.340	.95799	20	40	.4173	.4592	2.177	.90875	20
50	.2896	.3026	3.305	.95715	10	50	.4200	.4628	2.161	.90753	10
17	.2924	.3057	3.271	.95615	73	25	.4226	.4663	2.145	.90631	65
10	.2952	.3089	3.237	.95545	50	10	.4253	.4699	2.128	.90507	50
20	.2979	.3121	3.204	.95459	40	20	.4279	.4734	2.112	.90383	40
30	.3007	.3153	3.172	.95372	30	30	.4305	.4770	2.097	.90259	30
40	.3035	.3185	3.140	.95284	20	40	.4331	.4806	2.081	.90133	20
50	.3062	.3217	3.108	.95195	10	50	.4358	.4841	2.066	.90007	10
18	.3090	.3249	3.078	.95106	72	26	.4384	.4877	2.050	.89879	64
10	.3118	.3281	3.048	.95015	50	10	.4410	.4913	2.035	.89752	50
20	.3145	.3314	3.018	.94924	40	20	.4436	.4950	2.020	.89623	40
30	.3173	.3346	2.989	.94832	30	30	.4462	.4986	2.006	.89493	30
40	.3201	.3378	2.960	.94740	20	40	.4488	.5022	1.991	.89363	20
50	.3228	.3411	2.932	.94646	10	50	.4514	.5059	1.977	.89232	10
19	.3256	.3443	2.904	.94552	71	27	.4540	.5095	1.963	.89101	63
10	.3283	.3476	2.877	.94457	50	10	.4566	.5132	1.949	.88968	50
20	.3311	.3508	2.850	.94361	40	20	.4592	.5169	1.935	.88835	40
30	.3338	.3541	2.824	.94264	30	30	.4617	.5206	1.921	.88701	30
40	.3365	.3574	2.798	.94167	20	40	.4643	.5243	1.907	.88566	20
50	.3393	.3607	2.773	.94068	10	50	.4669	.5280	1.894	.88431	10
20	.3420	.3640	2.747	.93969	70	28	.4695	.5317	1.881	.88295	62
10	.3448	.3673	2.723	.93869	50	10	.4720	.5354	1.868	.88158	50
20	.3475	.3706	2.669	.93769	40	20	.4746	.5392	1.855	.88020	40
30	.3502	.3739	2.675	.93667	30	30	.4772	.5430	1.842	.87882	30
40	.3529	.3772	2.651	.93565	20	40	.4797	.5467	1.829	.87743	20
50	.3557	.3805	2.628	.93462	10	50	.4823	.5505	1.816	.87603	10
21	.3584	.3839	2.605	.93358	69	29	.4848	.5543	1.804	.87462	61
10	.3611	.3872	2.583	.93253	50	10	.4874	.5581	1.792	.87321	50
20	.3638	.3906	2.560	.93148	40	20	.4899	.5619	1.780	.87178	40
30	.3665	.3939	2.539	.93042	30	30	.4924	.5658	1.767	.87036	30
40	.3692	.3973	2.517	.92935	20	40	.4950	.5696	1.756	.86892	20
50	.3719	.4006	2.496	.92827	10	50	.4975	.5735	1.744	.86748	10
22	.3746	.4040	2.475	.92718	68	30	.5000	.5774	1.732	.86603	60
10	.3773	.4074	2.455	.92609	50	10	.5025	.5812	1.720	.86457	50
20	.3800	.4108	2.434	.92499	40	20	.5050	.5851	1.709	.86310	40
30	.3827	.4142	2.414	.92388	30	30	.5075	.5890	1.698	.86163	30
40	.3854	.4176	2.394	.92276	20	40	.5100	.5930	1.686	.86015	20
50	.3881	.4210	2.375	.92164	10	50	.5125	.5969	1.675	.85866	10
23	.3907	.4245	2.356	.92050	67	31	.5150	.6009	1.664	.85717	59
10	.3934	.4279	2.337	.91936	50	10	.5175	.6048	1.653	.85567	50
20	.3961	.4314	2.318	.91822	40	20	.5200	.6088	1.643	.85416	40
30	.3987	.4348	2.300	.91706	30	30	.5225	.6128	1.632	.85264	30
40	.4014	.4383	2.282	.91590	20	40	.5250	.6168	1.621	.85112	20
50	.4041	.4417	2.264	.91472	10	50	.5275	.6208	1.611	.84959	10
				66							58
	Cosin.	Cotg.	Tan.	Sine.	Angle.		Cosin.	Cotg.	Tan.	Sine.	Angle.

TABLE VIII.—NATURAL TRIGONOMETRICAL FUNCTIONS.

Angle	Sine.	Tan.	Cotg.	Cosin.	Angle	Sine.	Tan.	Cotg.	Cosin.		
<i>or</i>					<i>or</i>						
32	.5299	.6249	1.600	.84805	58	.30	.6225	.7954	1.257	.78261	30
10	.5324	.6289	1.590	.84650	50	40	.6248	.8002	1.250	.78079	20
20	.5348	.6330	1.580	.84495	40	50	.6271	.8050	1.242	.77897	10
30	.5373	.6371	1.570	.84339	30						
40	.5398	.6412	1.560	.84182	20	39	.6293	.8098	1.235	.77715	51
50	.5422	.6453	1.550	.84025	10	10	.6316	.8146	1.228	.77531	50
					20	20	.6338	.8195	1.220	.77347	40
33	.5446	.6494	1.540	.83867	57	30	.6361	.8243	1.213	.77162	30
10	.5471	.6536	1.530	.83708	50	40	.6383	.8292	1.206	.76977	20
20	.5495	.6577	1.520	.83549	40	50	.6406	.8342	1.199	.76791	10
30	.5519	.6619	1.511	.83389	30						
40	.5544	.6661	1.501	.83228	20	40	.6428	.8391	1.192	.76604	50
50	.5568	.6703	1.492	.83066	10	10	.6450	.8441	1.185	.76417	50
					20	20	.6472	.8491	1.178	.76229	40
34	.5592	.6745	1.483	.82904	56	30	.6494	.8541	1.171	.76041	30
10	.5616	.6787	1.473	.82741	50	40	.6517	.8591	1.164	.75851	20
20	.5640	.6830	1.464	.82577	40	50	.6539	.8642	1.157	.75661	10
30	.5664	.6873	1.455	.82413	30						
40	.5688	.6916	1.446	.82248	20	41	.6561	.8693	1.150	.75471	49
50	.5712	.6959	1.437	.82082	10	10	.6583	.8744	1.144	.75280	50
					20	20	.6604	.8796	1.137	.75088	40
35	.5736	.7002	1.428	.81915	55	30	.6626	.8847	1.130	.74896	30
10	.5760	.7046	1.419	.81748	50	40	.6648	.8899	1.124	.74703	20
20	.5783	.7089	1.411	.81580	40	50	.6670	.8952	1.117	.74509	10
30	.5807	.7133	1.402	.81412	30						
40	.5831	.7177	1.393	.81242	20	42	.6691	.9004	1.111	.74314	48
50	.5854	.7221	1.385	.81072	10	10	.6713	.9057	1.104	.74120	50
					20	20	.6734	.9110	1.098	.73924	40
36	.5878	.7265	1.376	.80902	54	30	.6756	.9163	1.091	.73728	30
10	.5901	.7310	1.368	.80730	50	40	.6777	.9217	1.085	.73531	20
20	.5925	.7355	1.360	.80558	40	50	.6799	.9271	1.079	.73333	10
30	.5948	.7400	1.351	.80386	30						
40	.5972	.7445	1.343	.80212	20	43	.6820	.9325	1.072	.73135	47
50	.5995	.7490	1.335	.80038	10	10	.6841	.9380	1.066	.72937	50
					20	20	.6862	.9435	1.060	.72737	40
37	.6018	.7536	1.327	.79864	53	30	.6884	.9490	1.054	.72537	30
10	.6041	.7581	1.319	.79688	50	40	.6905	.9545	1.048	.72337	20
20	.6065	.7627	1.311	.79512	40	50	.6926	.9601	1.042	.72136	10
30	.6088	.7673	1.303	.79335	30						
40	.6111	.7720	1.295	.79158	20	44	.6947	.9657	1.036	.71934	46
50	.6134	.7766	1.288	.78980	10	10	.6967	.9713	1.030	.71732	50
					20	20	.6988	.9770	1.024	.71529	40
38	.6157	.7813	1.280	.78801	52	30	.7009	.9827	1.018	.71325	30
10	.6180	.7860	1.272	.78622	50	40	.7030	.9884	1.012	.71121	20
20	.6202	.7907	1.265	.78442	40	50	.7050	.9942	1.006	.70916	10
							.7071	1.	1.	.70711	45
											<i>or</i>
	Cosin.	Cotg.	Tan.	Sine.	Angle.		Cosin.	Cotg.	Tan.	Sine.	Angle.

TABLE IX.—CALCULATION OF EARTHWORK.


Width	HEIGHT														
	1	2	3	4	5	6	7	8	9	10	11	12	13	14	15
1	.02	.04	.06	.07	.09	.11	.13	.15	.17	.18	.20	.22	.24	.26	.28
2	.04	.07	.11	.15	.18	.22	.26	.30	.33	.37	.41	.44	.48	.52	.56
3	.06	.11	.17	.22	.28	.33	.39	.44	.50	.56	.61	.67	.72	.78	.83
4	.07	.15	.22	.30	.37	.44	.52	.59	.67	.74	.81	.89	.96	1.04	1.11
5	.09	.19	.28	.37	.46	.56	.65	.74	.83	.93	1.02	1.11	1.20	1.30	1.39
6	.11	.22	.33	.44	.56	.67	.78	.89	1.00	1.11	1.22	1.33	1.44	1.55	1.67
7	.13	.26	.39	.52	.65	.78	.91	1.04	1.16	1.30	1.42	1.55	1.68	1.81	1.94
8	.15	.30	.44	.59	.74	.89	1.04	1.19	1.33	1.48	1.63	1.78	1.92	2.08	2.22
9	.17	.33	.50	.67	.83	1.00	1.17	1.33	1.50	1.67	1.83	2.00	2.17	2.33	2.50
10	.18	.37	.56	.74	.93	1.11	1.30	1.48	1.67	1.85	2.04	2.22	2.41	2.59	2.78
11	.20	.41	.61	.82	1.02	1.22	1.43	1.63	1.83	2.04	2.24	2.44	2.65	2.85	3.06
12	.22	.44	.67	.89	1.11	1.33	1.56	1.78	2.00	2.22	2.44	2.67	2.89	3.11	3.33
13	.24	.48	.72	.96	1.20	1.44	1.68	1.92	2.16	2.41	2.65	2.89	3.13	3.37	3.61
14	.26	.52	.78	1.04	1.30	1.55	1.81	2.08	2.33	2.59	2.85	3.11	3.37	3.63	3.89
15	.28	.56	.83	1.11	1.39	1.67	1.94	2.22	2.50	2.78	3.06	3.33	3.61	3.89	4.17
16	.30	.59	.89	1.18	1.48	1.78	2.07	2.37	2.67	2.96	3.26	3.56	3.85	4.15	4.44
17	.31	.63	.94	1.26	1.57	1.89	2.20	2.52	2.83	3.15	3.46	3.78	4.09	4.41	4.72
18	.33	.67	1.00	1.33	1.67	2.00	2.33	2.67	3.00	3.33	3.67	4.00	4.33	4.67	5.00
19	.35	.70	1.06	1.41	1.76	2.11	2.46	2.82	3.17	3.52	3.87	4.22	4.57	4.92	5.28
20	.37	.74	1.11	1.48	1.85	2.22	2.59	2.96	3.33	3.70	4.07	4.44	4.81	5.18	5.56
21	.39	.78	1.17	1.55	1.94	2.33	2.72	3.11	3.50	3.89	4.28	4.67	5.06	5.44	5.83
22	.41	.81	1.22	1.63	2.04	2.44	2.85	3.26	3.67	4.07	4.48	4.89	5.30	5.70	6.11
23	.43	.85	1.28	1.70	2.13	2.56	2.98	3.41	3.83	4.26	4.68	5.11	5.54	5.96	6.39
24	.44	.89	1.33	1.78	2.22	2.67	3.11	3.56	4.00	4.44	4.89	5.33	5.78	6.22	6.67
25	.46	.92	1.39	1.85	2.31	2.78	3.24	3.70	4.17	4.63	5.09	5.56	6.02	6.48	6.94
26	.48	.96	1.44	1.92	2.41	2.89	3.37	3.85	4.33	4.82	5.30	5.78	6.26	6.74	7.24
27	.50	1.00	1.50	2.00	2.50	3.00	3.50	4.00	4.50	5.00	5.50	6.00	6.50	7.00	7.50
28	.52	1.04	1.55	2.07	2.59	3.11	3.63	4.15	4.67	5.18	5.70	6.22	6.74	7.26	7.78
29	.54	1.07	1.61	2.15	2.68	3.22	3.76	4.30	4.83	5.37	5.91	6.44	6.98	7.52	8.06
30	.56	1.11	1.67	2.22	2.78	3.33	3.89	4.44	5.00	5.55	6.11	6.67	7.22	7.78	8.33
31	.57	1.15	1.72	2.30	2.87	3.44	4.02	4.59	5.17	5.74	6.32	6.89	7.46	8.04	8.61
32	.59	1.18	1.78	2.37	2.96	3.56	4.15	4.74	5.33	5.92	6.52	7.11	7.70	8.30	8.89
33	.61	1.22	1.83	2.44	3.05	3.67	4.28	4.89	5.50	6.11	6.72	7.33	7.94	8.55	9.17
34	.63	1.26	1.89	2.52	3.15	3.78	4.40	5.04	5.67	6.29	6.93	7.56	8.18	8.81	9.44
35	.65	1.30	1.94	2.59	3.24	3.89	4.53	5.18	5.83	6.48	7.13	7.78	8.42	9.08	9.72
36	.67	1.33	2.00	2.67	3.33	4.00	4.66	5.33	6.00	6.67	7.33	8.00	8.67	9.33	10.00
37	.68	1.37	2.06	2.74	3.42	4.11	4.79	5.48	6.17	6.85	7.54	8.22	8.91	9.59	10.28
38	.70	1.41	2.11	2.82	3.52	4.22	4.92	5.63	6.33	7.03	7.74	8.44	9.15	9.85	10.56
39	.72	1.44	2.17	2.89	3.61	4.33	5.05	5.78	6.50	7.22	7.95	8.67	9.39	10.11	10.83
40	.74	1.48	2.22	2.96	3.70	4.44	5.18	5.92	6.67	7.41	8.15	8.89	9.63	10.37	11.11


Table gives cu. yds. in 1 ft. of a triangle of given width and height. Corrections for tenths of width are one tenth the values found under each height considering the widths from 1 to 9 as tenths and similarly the corrections for tenths of height are one tenth the figures opposite width considering the heights from 1 to 9 as tenths. Thus if $w=16.2$ and $h=5.3$, cu. yds. $=1.48 \times .028 + .039 = 1.597$ cu. yds. or practically 160 cu. yds. per 100 ft. If w exceeds 40 ft., use one half and multiply result by 2, if both w and h are large use one half of each and multiply result by 4. Any cross-section may be divided into triangles by the following rule. To the triangle of the sum of the outside cuts (or fills) $=h$, and $\frac{1}{2}$ the roadbed $=w$, add the triangles formed by taking the distance out to each break in turn ($=w$'s) by the difference between the cuts (or fills) on each side of it ($=h$'s) always subtracting the outer from the inner.

DIAGRAM FOR OBTAINING HORIZONTAL AND VERTICAL DISTANCES FROM STADIA READINGS

Enter on the horizontal scale with the value of the stadia reading or interval times the stadia constant (usually taken as 100) and run vertically upward to intersection with line representing the vertical angle. The location of this point with reference to the dotted line marked "ONE," etc., gives the correction to be subtracted from the entering value and to which "f+c" (usually about 1 ft.) must be added to obtain the Horizontal Distance. The reading on vertical scale plus about 0.1 ft. for each 5° of vertical angle [$-(f+c \sin \alpha)$] is the Vertical Distance.


© 194 BY J.K.FINCH.

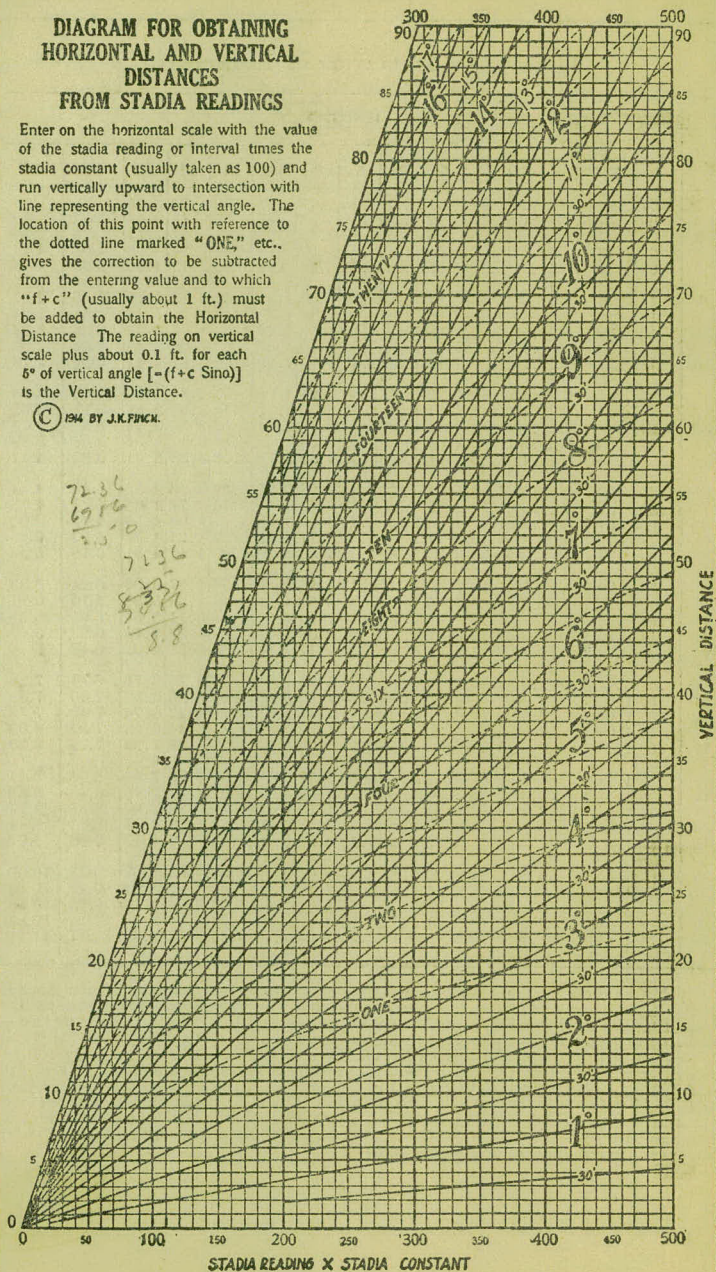


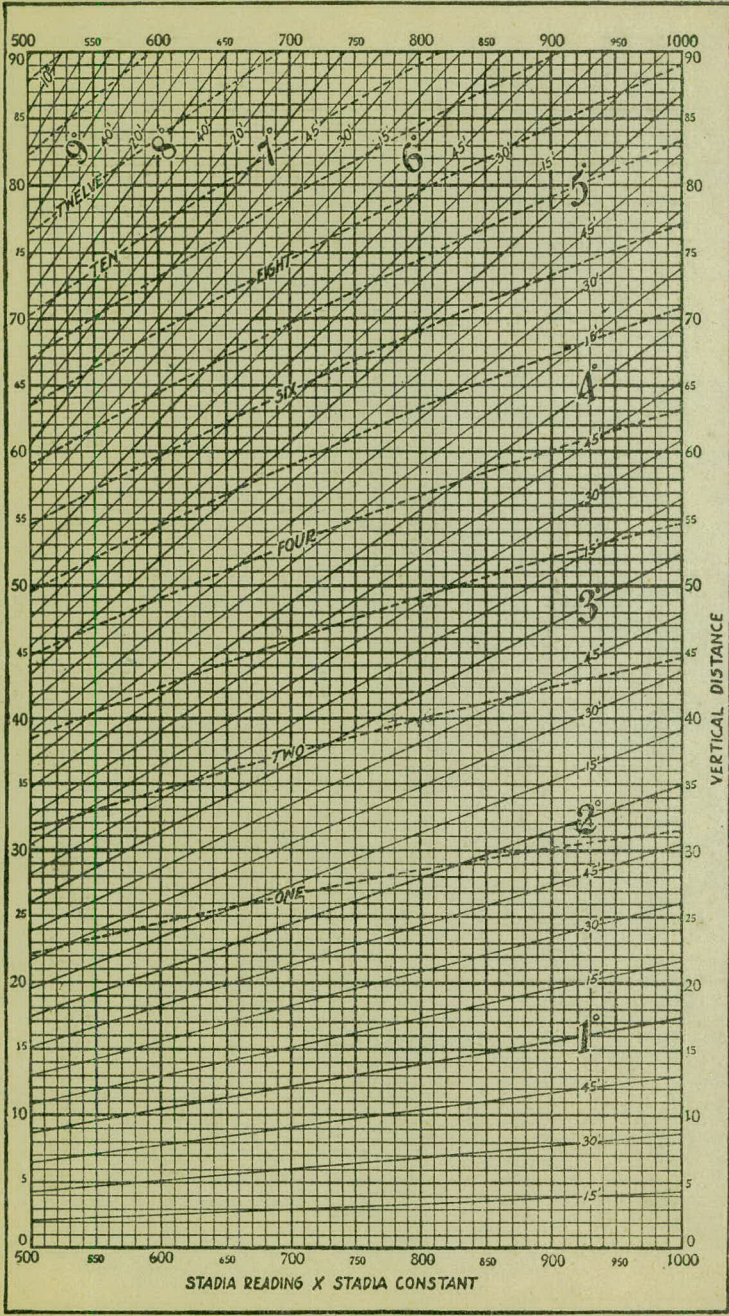

STADIA READING X STADIA CONSTANT

VERTICAL DISTANCE

 

 

~~456
59
407~~

.15
8.28V

8.12
63
1.5

2163.9
117.45
2281.85

501
430
111

50
25
818
8.43
1.8

4.59
215
0.15
1034
17.23

2059
1302
4.65
1205
653
51.14
1223
38.91

2059
459
8371
54.07
29.64

0.38
2.31
1.90
2.15
0.15
1034
17.23

11.65
894
130
465
1205
683
51.14
1723
3391

8333
4373
960

8333
80373
39.60

51.15
465
46.49
1723
29.26

8333
80373
39.65
1035
29.26

11
500
51

DISTANCES FROM CENTER OF ROADWAY FOR
CROSS-SECTIONING.

Roadway 16 feet wide. Side Slopes 1 on 1½.
For Single Track Embankment.

H	0	.1	.2	.3	.4	.5	.6	.7	.8	.9	H
0	8.0	8.2	8.3	8.5	8.6	8.8	8.9	9.1	9.2	9.4	0
1	9.5	9.7	9.8	10.0	10.1	10.3	10.4	10.6	10.7	10.9	1
2	11.0	11.2	11.3	11.5	11.6	11.8	11.9	12.1	12.2	12.4	2
3	12.5	12.7	12.8	13.0	13.1	13.3	13.4	13.6	13.7	13.9	3
4	14.0	14.2	14.3	14.5	14.6	14.8	14.9	15.1	15.2	15.4	4
5	15.5	15.7	15.8	16.0	16.1	16.3	16.4	16.6	16.7	16.9	5
6	17.0	17.2	17.3	17.5	17.6	17.8	17.9	18.1	18.2	18.4	6
7	18.5	18.7	18.8	19.0	19.1	19.3	19.4	19.6	19.7	19.9	7
8	20.0	20.2	20.3	20.5	20.6	20.8	20.9	21.1	21.2	21.4	8
9	21.5	21.7	21.8	22.0	22.1	22.3	22.4	22.6	22.7	22.9	9
10	23.0	23.2	23.3	23.5	23.6	23.8	23.9	24.1	24.2	24.4	10
11	24.5	24.7	24.8	25.0	25.1	25.3	25.4	25.6	25.7	25.9	11
12	26.0	26.2	26.3	26.5	26.6	26.8	26.9	27.1	27.2	27.4	12
13	27.5	27.7	27.8	28.0	28.1	28.3	28.4	28.6	28.7	28.9	13
14	29.0	29.2	29.3	29.5	29.6	29.8	29.9	30.1	30.2	30.4	14
15	30.5	30.7	30.8	31.0	31.1	31.3	31.4	31.6	31.7	31.9	15
16	32.0	32.2	32.3	32.5	32.6	32.8	32.9	33.1	33.2	33.4	16
17	33.5	33.7	33.8	34.0	34.1	34.3	34.4	34.6	34.7	34.9	17
18	35.0	35.2	35.3	35.5	35.6	35.8	35.9	36.1	36.2	36.4	18
19	36.5	36.7	36.8	37.0	37.1	37.3	37.4	37.6	37.7	37.9	19
20	38.0	38.2	38.3	38.5	38.6	38.8	38.9	39.1	39.2	39.4	20
21	39.5	39.7	39.8	40.0	40.1	40.3	40.4	40.6	40.7	40.9	21
22	41.0	41.2	41.3	41.5	41.6	41.8	41.9	42.1	42.2	42.4	22
23	42.5	42.7	42.8	43.0	43.1	43.3	43.4	43.6	43.7	43.9	23
24	44.0	44.2	44.3	44.5	44.6	44.8	44.9	45.1	45.2	45.4	24
25	45.5	45.7	45.8	46.0	46.1	46.3	46.4	46.6	46.7	46.9	25
26	47.0	47.2	47.3	47.5	47.6	47.8	47.9	48.1	48.2	48.4	26
27	48.5	48.7	48.8	49.0	49.1	49.3	49.4	49.6	49.7	49.9	27
28	50.0	50.2	50.3	50.5	50.6	50.8	50.9	51.1	51.2	51.4	28
29	51.5	51.7	51.8	52.0	52.1	52.3	52.4	52.6	52.7	52.9	29
30	53.0	53.2	53.3	53.5	53.6	53.8	53.9	54.1	54.2	54.4	30
31	54.5	54.7	54.8	55.0	55.1	55.3	55.4	55.6	55.7	55.9	31
32	56.0	56.2	56.3	56.5	56.6	56.8	56.9	57.1	57.2	57.4	32
33	57.5	57.7	57.8	58.0	58.1	58.3	58.4	58.6	58.7	58.9	33
34	59.0	59.2	59.3	59.5	59.6	59.8	59.9	60.1	60.2	60.4	34
35	60.5	60.7	60.8	61.0	61.1	61.3	61.4	61.6	61.7	61.9	35
36	62.0	62.2	62.3	62.5	62.6	62.8	62.9	63.1	63.2	63.4	36
37	63.5	63.7	63.8	64.0	64.1	64.3	64.4	64.6	64.7	64.9	37
38	65.0	65.2	65.3	65.5	65.6	65.8	65.9	66.1	66.2	66.4	38
39	66.5	66.7	66.8	67.0	67.1	67.3	67.4	67.6	67.7	67.9	39
40	68.0	68.2	68.3	68.5	68.6	68.8	68.9	69.1	69.2	69.4	40

Example—If point is 22.6 ft. above grade, how far should it be from center line to be a slope stake point? Ans. from Table 41.9. For same slopes but other widths of roadbed correct above figures by one-half difference in width of roadbed; thus in example above for 20 ft. roadbed distance will be $41.9 + (20 - 16) \div 2$ or 2 ft. added to 41.9 = 43.9. For slopes of 1 on 1 see inside of front cover.

Made in Germany.

U2452