

PLANS SURVEY  
NEW BRIGHTON ROAD

From Co. Rd. "D"

To Cleveland Avenue

CO. PROJ. N<sup>o</sup> 23-63

S.T.H. No. 62

Office of Ramsey Co. Engineer  
ST. PAUL, MINN.

Filed 10-30-23


File No. "3" (23-63)

# INDEX

New Brighton Rd.

Page	Title	Sta.
1-5	Alignment	0+00 - 108+26.2
6-18	± Elevations	0+00 - 108+26.2
19-35	X sections	0+00 - 108+26.2
36-54	Art. Topog.	0+00 - 108+26.2
55	Culverts	

Job 23-65

 

# NEW Brighton Rd.

G. Reifler	Inst.
F. Tierney	Level
A. Persons	Rod
W. Wikhusen	Hd. Chain
J. Mahoney	Br. "
J. Carr	Stakes
M. Galvin	Flag

New Brighton Rd.

3-16-23

Sta.

Point Left & Right

Calc. Mag.

Beary

N00°-39'E N2°-30'W

28+38.17 P.T.

$\Delta$  25°-57'

28

12°-58'

C 15°

27+53.4 P.I.

S.T. 88.26 ✓

L.C. 173' ✓

+50

10°-07'

50'c

27

6°-22'

26+65.14 P.C.



2°-31'

N25°-18'W N29°-30'W

0+00 end of Paving

N00°-00'W

N4°-30'W

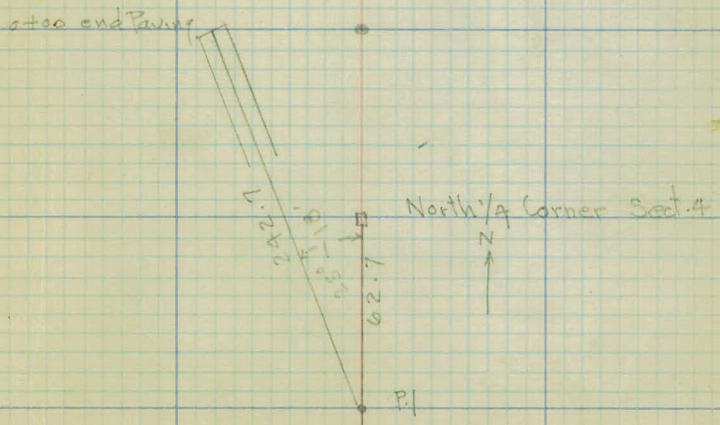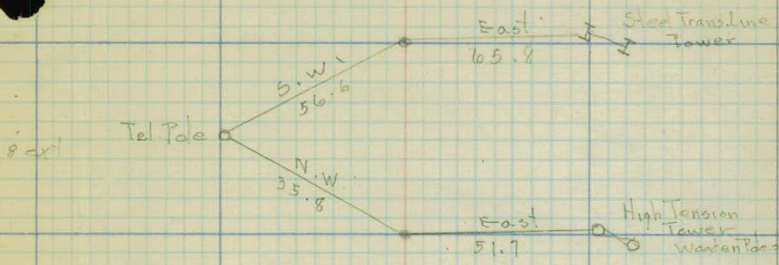

station Point Left & Right

Calc. Mag. Bearing

N89°-12'W ✓

81+30.9 P.T

81

44°-38'

+50

40°-10'

80

32°-55'

Δ 89°-16'

C 29°-0'

80+20.2 P.I

S.T. 197.10 ✓

+50

25°-40'

L.C. 307.80 ✓

79

18°-25'

+50

11°-10'

78+23.1 P.C.

3°-55'

66+63.6 P.O.T.

N00-04'E ✓

N43°0'W


53+87.4

P.I.

0°-35'

41+13.5 P.O.T.

N00-39'E

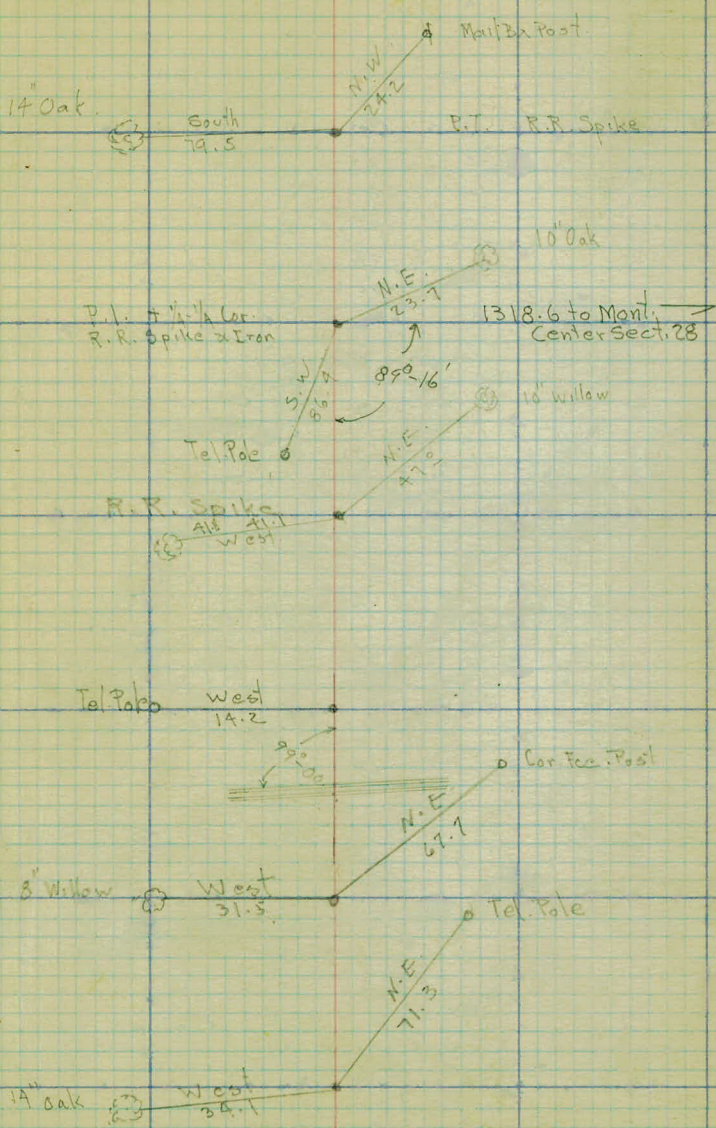

3-20-23

07 Brighton Rd

Station Point Left Right Calc. Mag Bearing

99+00.30 =>

N88-58W

99+00.3 P.T.

99 23°-53'

98+50 23°-48'

Δ 47-46

98 15°-48'

C 20°-00 127.49

97+88.9 P.I.

S.T. (116.92)

+50 13°-48'

L.C. 238.85 ✓

97 8°-48'

96+61.98 <sup>61.4</sup> P.C. 3°-48'

92+51.5 Mont. on back Tangent Produced

N41-12W ✓

90+25.7 P.T.

90 24°-00

Δ-48°-00.

+50 21°-24

C 20-0

89+13.9 P.I.

S.T. 128.2 ✓

89 16°-24

L.C. 240 ✓

+50 11°-24


88 6°-24

87+85.7 P.C.

1°-24


N89-12W

P.T.  
R.R. Spike

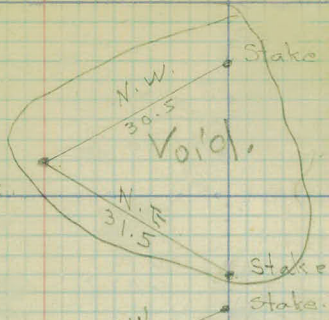

P.L. R.R. Spike

Stake

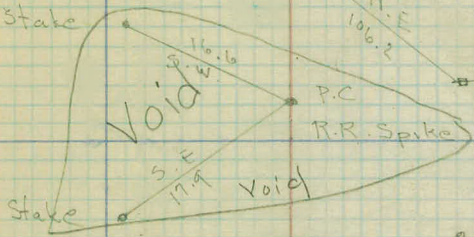


Wood Sign Post

N.W.  
17.0

N.E.  
106.2

P.T. R.R. Spike

3rd F.P. 3rd.

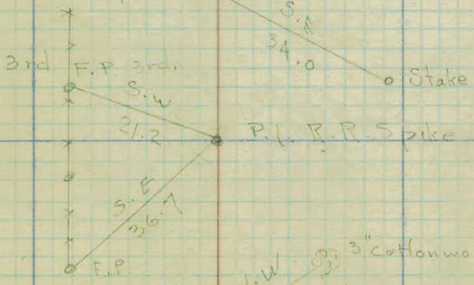

N.E.  
24.5

S.W.  
34.0

3rd F.P. Stake  
37.0

N.W.  
28.6

3" Cottonwood  
P.C R.R. Spike

Station Point Left Right

Calc. Mag.  
Bearing


108+26<sup>9</sup> End Location

N 88° 50' W


3-21-23


(4)

27-24

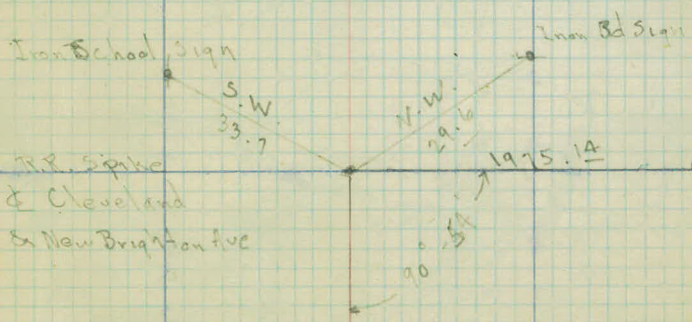

320  
000  
000  
000  
370

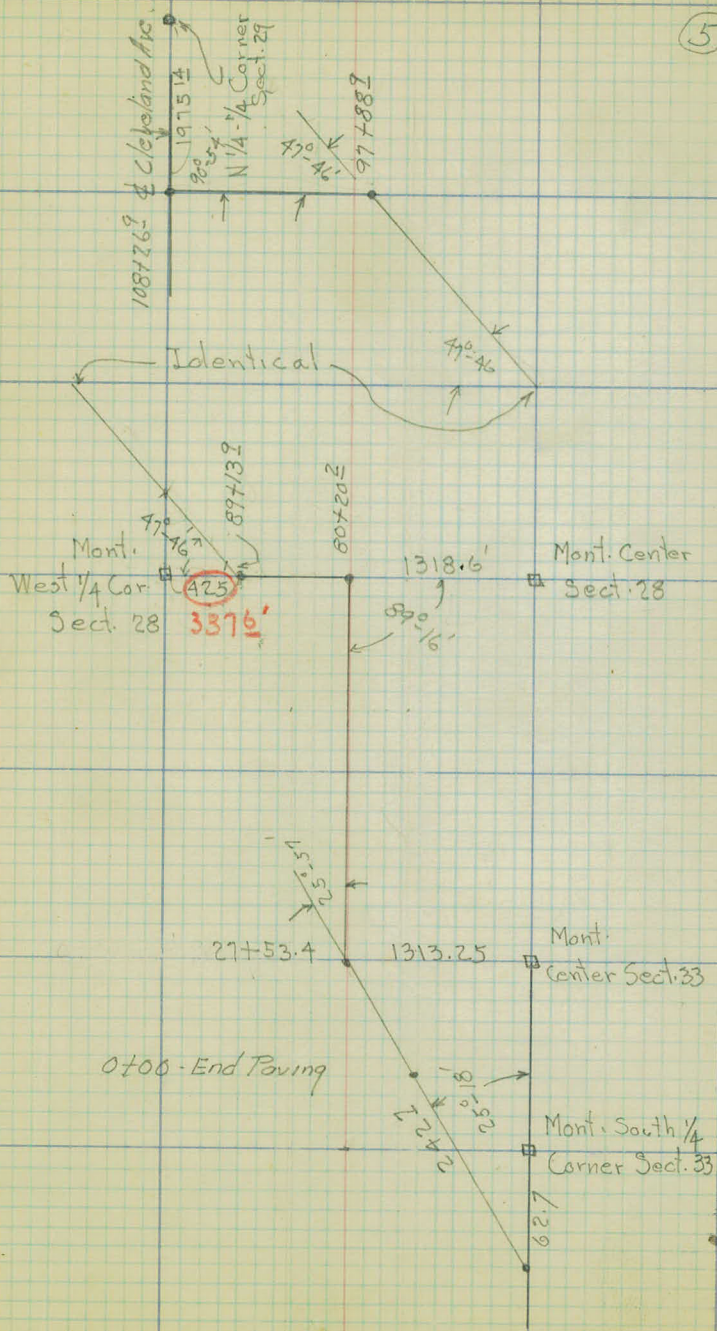

 

E Levels -

(6)

New Brighton Road

B.M. Sp. 105 Spiling of first bent E side  
of Road - El. 196.17

3/16/23

£ Levels New Brighton Rd.

B.M.	8.33	235.78		227.45
-4+00			3.9	31.9
-3			3.5	32.3
-	5.55	237.83	3.50	232.28
-2			5.2	32.6
B.M			5.87	231.96
-1			5.0	32.8
0+00			4.9	32.9
+50			4.6	33.2
1			4.5	33.3
+50			4.4	33.4
2			4.4	33.4
+50			4.4	33.4
3			4.4	33.4
+50			4.4	33.4
4			4.1	33.7
	6.37	240.02	4.18	233.65
+50			5.8	34.2
5			5.6	34.4
+50	13.22		5.4	34.6
6			5.2	34.8
+50			4.8	35.2
7			4.8	35.2
+50			4.8	35.2
8			4.7	35.3

F.P.T.  
R.P. }

3/16/23

(7)

Nail in T.P. L Sta. <sup>old survey</sup> 129+00A - 540' S  
of Cor. (Int. Cty Rd D + N.B. Rd.)

Nail in 12" Oak S.W. Cor. Cty Rd D + N.B. Rd.

End pavement - beginning of job

3/16/23

240.02

8+50		4.8	235.2
9		5.5	34.5
+50		6.2	33.8
10	6.37	6.8	33.2
B.M	4.32	235.63	8.71
+50		2.5	33.1
11		3.0	32.6
+50		3.4	32.2
12		4.0	31.6
+50		4.2	31.4
13		4.6	31.0
+50		4.8	30.8
14		4.8	30.8
+50		4.8	30.8
15		4.7	30.9
+50		4.9	30.7
16		5.0	30.6
	4.45	235.01	5.07
+50		4.5	30.5
17	223.45 124.50 10.69	4.6	30.4
+50		4.5	30.5
18	10.69	4.7	30.3
+50	13.78 10.69 3.09	4.8	30.2
B.M		5.99	229.02
19		5.0	30.6
+50		5.1	29.9

3/16/23

F.P.T. }  
R.P. }

(8)

Nail in 15" Oak 25' R 9+90

Nail in 20" Oak L 18+75

3/16/23

235.01

20 5.1 229.9

+50 5.2 29.8

21 5.7 29.3

+50 5.8 29.2

22 4.45 5.9 29.1

6.15 235.40 5.76 229.25

+50 6.2 29.2

23 5.8 29.6

+50 5.4 30.0

24 5.0 30.4

+50 4.7 30.7

25 4.4 31.0

+50 4.3 31.1

26 4.2 31.2

+50 4.1 31.3

B.M 4.63 236.36 3.67 231.73

27 5.2 31.2

+50 5.1 31.3

28 5.0 31.4

+50 5.1 31.3

29 10.60 9.43 4.9 31.5

+50 5.0 31.4

30 5.0 31.4

+50 5.0 31.4

31 5.0 31.4

+50 4.9 31.5

231.73  
230.56  
1.17

9.43

10.60  
9.43  
1.17

3/16/23

(9)

F.P.T. }  
R.P. }

Sp. in T.P

L Sta 27+85

3/16/23

236.36

32

5.0

31.4

+50

5.1

31.3

33

5.2

31.2

+50

5.2

31.2

34

5.2

31.2

5.10

236.40

5.06

231.30

+50

5.1

31.3

35

5.1

31.3

+50

4.9

31.5

36

5.0

31.4

+50

4.9

31.5

37

4.9

31.5

+50

4.9

31.5

38

5.1

31.3

+50

5.1

31.3

39

5.0

31.4

+50

5.0

31.4

40

5.1

31.3

B.M

1.56

233.73

4.23

232.17

+50

2.6

31.1

41

Pr. Rd. R

232.17  
231.73  
44

2.6

31.1

3.0

30.7

+50

9.73  
9.29  
44

231.

9.29

3.8

29.9

42

4.5

29.2

+50

Priv. Ent.

R

5.6

28.1

43

6.9

26.8

+50

8.3

25.4

3/16/23

(10)

F.P.T. }  
R.P. }

Sp. in T.P. L 39+50

3/10/23

233.73

44

1.56

10.1 223.6

+ 50

12.1 221.6

0.32 222.35 11.70

222.03

45

2.5 19.9

+ 50

4.4 18.0

46

6.4 16.0

+ 50

8.0 14.4

47

10.0 12.4

+ 30

Priv. Ent. L

11.1 11.3

B.M

9.31

213.04

1.88

232.17

21.01

19.13

1.88

19.13

201

3/16/23

(11)

F.T. }  
R.P. }

Spin T.P L 47+00

3/17/23

B.M

1.24 214.28

213.04  
210.5

47+50

3.8

211.9

48

5.9

208.4

+50

8.4

205.9

49

10.0

204.3

+50

11.5

202.8

1.44 204.24 11.48

202.80

50

2.4

201.8

+50

3.3

200.9

51

3.9

200.3

+50

4.5

199.7

52

4.7

199.5

+50

5.1

199.1

53

5.6

198.6

+50

6.1

198.1

54

6.3

197.9

+50

6.5

197.7

55

7.0

197.2

4.11 201.07 7.28

196.96

+ 11.47

212.54

+50

4.6

196.4

56

5.0

196.0

B.M

4.41

196.66

16.38

6.79

23.17

6.79

16.38

196.5

196.1

3/17/23

Sp. in T.P. L 47+00

(12)

El. bottom of girder at bridge  
& bridge. (See R.R.)

Sp T.P. L 56+15

3/22/23

B.M.

4.25 200.91.

176.66.

B.M.

3.75

197.16.







3-22-23

Sta.

56+15  
~~196+66~~

B.M.

196.66

Sta.

B.S.

H.I.

F.S.

Rod

Elev.

8.38 205.04.

56+50

8.9 196.1.

57

8.4 196.6.

+50

7.1 197.9.

58

5.5 199.5.

+50

3.6 201.4.

59

1.6 203.4.

T.P.

0.87

204.17.

11.15 215.32.

59+50

10.1 205.2.

60

8.2 207.1.

+50

6.4 208.9.

61

4.5 210.8.

+50

2.4 212.9.

62

0.9 214.4.

T.P.

0.77

214.55.

11.62 226.17.

+50

9.8 216.4.

63

8.1 218.1.

B.M.

5.83

220.34.

+50

6.5 219.7.

64

4.9 221.3.

+50

3.4 222.8.

Spiken Tel. Pole on Left.

R.R. Spike in 14" oak Sta. 63+10 ~~left~~ Right

Sta.	B.S.	H. I.	F.S.	Rod	Elev.
		226.17			
65				2.2	224.0
+50				1.2	225.0
T.P.			1.32		224.85
	5.65	230.50			
66				4.7	225.8
+50				3.9	226.6
67				3.8	226.7
+50				4.0	226.5
68				4.5	226.0
+50				5.5	225.0
69				6.7	<u>224.8</u> 223.8
+50				8.0	222.5
70				9.6	220.9
+50				10.4	220.1
71				10.6	219.9
T.P.			10.57		219.93
	6.40	226.33			
+50				6.8	219.5
72				6.3	220.0
+50				5.3	221.0
73				5.0	221.3
+50				4.8	221.5
74				4.7	221.6
+50				5.0	221.3
75				5.2	221.1

3-22-23

(15)

N. Brighton Rd

Sta.	B.S	H I	F.S	Rod	Elev
		226.33			
75+50				5.3	221.0
76				5.7	220.6
+50				6.6	219.1
77				7.9	218.4
T.P.			7.74		218.59
	0.55	219.14			
+50				1.65	217.5
78				3.3	215.8
+50				5.1	214.0
79				7.1	212.0
+50				9.5	209.6
80				11.2	207.9
B.M.			11.63		207.51
	0.10	208.21			
+50				2.2	206.0
81				4.5	203.7
+50				6.3	201.9
82				8.5	199.7
+50				9.8	198.4
83				10.1	198.1
T.P.			9.47		198.74
	6.80	205.54			
+50				7.5	198.0
84				7.6	197.9
+50				6.6	198.9

3-22-23

(16)

New Brighton Rd

On R.R. Spike in 8" oak to left sta. 80+00

Sta.	B.S.	I.I.	F.S.	Rod	Elev.
		205.54			
85				5.8	199.7
B.M.			0.93		204.61
+50				4.7	200.8
86				3.5	202.0
+50				2.4	203.1
87				1.3	204.2
T.P.			0.30		205.24
	8.52	213.76			
+50				8.7	205.1
88				7.6	206.2
+50				6.7	207.1
89				6.1	207.7
+50				4.9	208.9
90				3.8	210.0
+50				2.8	211.0
91				1.8	212.0
T.P.			1.50		212.26
	11.29	223.55			
+50				10.1	213.4
92				8.6	215.0
+50				7.4	216.1
93				6.3	217.3
+50				4.2	219.3
94				3.3	220.3
+17				2.3	221.3

3-23-23

(17)


On 10" Oak. R.R. spike 35+75 Left

Sta.	B.S.	I.I.	F.S.	Rod	Elev.
		223.55			
94+30				1.0	222.5
T.P.			1.19		222.36
	10.91	233.27			
+50				9.1	224.2
95				8.1	225.2
+50				7.4	225.9
96				7.4	225.9
+50				6.5	226.8
97				5.6	227.1
+50				5.4	227.9
98				3.6	229.7
+50				3.9	229.4
99				3.7	229.6
	3.57	233.36	3.48		229.79
100				4.3	229.1
101				4.9	228.5
+80				5.4	228.0
102				5.4	228.0
103				6.2	227.2
104				6.9	226.5
	1.80	229.50	5.66		227.70
105				3.8	225.7
106				4.9	224.7
107				5.7	223.8
108				6.6	222.9
+262				6.5	223.0
B.M			5.35		223.15

224<sup>15</sup>

Priv. Ent. L.

Int. Cleva. Ave. End Line  
Sp. in T.P. S.E. Cor lot. Clerc + N.B. Rd.

 

X sections New Brighton Rd.

Beginning at End Pave  
(Int. Cty Rd. D. + N.B. Rd.)

3/19/23

+50 235.2

6 34.8

{ Tierney  
Mahoney  
Persons

+50 34.6

5 34.2

+50 34.2

4 33.7

+50 33.4

3 33.4

+50 33.4

2 33.4

+50 33.4

1 33.3

+50 33.2

0+00 232.9

3/19/23

(20)

+0.8	+0.5	-0.0	-1.0	0.0	-0.4	-1.0	-1.5	-0.5	2.0
33	25	22	18	13	15	20	24	28	

+0.5	0.0	-1.1	-1.1	-0.1	0.0	-0.5	0.0	-0.6
33	25	22	16	12	9	20	27	33

-0.6	-1.0	-2.1	-2.0	-0.4	-0.7	-2.0	-2.0	-0.7	0.0	-0.8
33	26	23	18	13	15	19	21	23	28	33

2.0	-1.5	-2.0	-2.0	-0.7	-0.5	-1.5	-2.0
	29	24	18	13	15	25	33

-1.2	-2.2	-2.1	-0.6	-0.5	-1.5	-0.7	2.0
29	26	17	13	15	21	26	

2.0	-1.0	-2.0	-2.1	-0.4	-0.5	-1.5	-1.0	2.0
	30	25	19	13	15	19	23	

-2.0	-2.0	-1.8	-0.5	-0.5	-1.5	-1.5	2.0
33	24	18	13	15	18	23	

-2.4	-1.0	-1.7	-1.3	-0.3	-0.5	-1.0	-1.0	-1.4
33	23	22	16	13	15	21	27	33

2.0	-0.5	-0.5	-2.1	-2.1	-0.3	-0.8	-1.5	-2.0	-0.6	2.0
	30	22	20	15	12	15	18	23	24	

2.0	+1.0	+0.5	-1.1	-1.1	-0.4	0.0	-1.0	-1.0	0.0	2.0
	28	21	19	16	12	15	18	22	23	

2.0	+1.4	+0.5	-0.8	-1.1	-0.2	-0.7	-0.8	-0.8	+0.5	2.0
	28	21	19	15	12	15	15	22	23	

+1.0	-0.9	-0.9	-0.1	-0.2	-0.6	+0.8	2.0
21	20	15	12	15	22	23	

2.0	+1.0	+0.4	-0.7	-0.4	-0.5	0.0	2.0
	26	21	12	9	19	22	

2.0	+0.5	-1.0	-0.8	-0.3	-0.4	-0.4	+0.4	+0.4
	32	19	12	6	11	22	26	33

3/19/23

+50 230.8

13 31.0

+50 31.4

12 31.6

+50 32.2

11 32.6

+50 33.1

10 33.2

+50 33.8

9 34.5

+50 35.2

8 35.3

+50 35.2

7 230.2

3/19/33

(21)

-1.3	-0.3	-0.5	-0.8	-1.0	-2.0	-3.5
/18	/14	/9	/10	/17	/23	/33

+0.4	00	-1.2	-1.0	-0.3	-0.3	-0.6	-0.7	-3.7	-4.5
/33	/27	/23	/16	/11	/9	/9	/16	/23	/33

+1.5	+1.0	-1.0	-1.0	00	-0.5	-0.6	-2.0	-2.5	-2.5	-4.0
/33	/27	/22	/16	/14	/9	/16	/21	/23	/26	/33

+2.5	+1.5	-0.5	-1.0	00	-0.7	-2.5	-2.5	-1.5	-2.5
/33	/25	/22	/18	/15	/16	/21	/24	/26	/33

L18	+2.0	-1.0	-1.0	00	-0.4	-2.2	-2.2	-0.7	-2.0
	/27	/22	/18	/15	/15	/20	/24	/27	/33

+1.5	+1.0	-1.0	-1.0	00	-0.1	-2.2	-2.3	-0.5	-2.0
/33	/25	/21	/17	/13	/15	/20	/25	/28	/33

00	00	-1.5	-1.5	-0.5	-0.5	-2.0	-0.7	-2.5
/33	/24	/21	/16	/13	/15	/21	/24	/33

+0.5	00	-1.8	-1.8	-0.3	-0.5	-2.2	-2.5
/33	/23	/21	/17	/10	/15	/23	/35

L10	-1.0	-2.0	-2.0	-0.5	-0.5	-2.0	-3.0	-3.7
	/25	/23	/18	/13	/15	/19	/26	/33

L20	-0.5	-1.6	-1.6	-0.3	-0.5	-2.1	-2.1
	/25	/24	/19	/14	/15	/23	/26

L10	-0.5	-1.4	-1.5	-0.5	-0.5	-1.9	-1.1	-1.6
	/30	/23	/19	/15	/15	/23	/25	/33

L10	-1.0	-2.0	-2.0	-0.5	-0.5	-1.0	-2.0	-1.0
	/29	/25	/19	/13	/15	/20	/24	/28

-1.5	-2.0	-2.0	-0.7	-0.4	-1.5	-1.5	-1.0
/33	/22	/17	/13	/15	/20	/24	/28

00	00	-1.1	-1.1	-0.4	-0.3	-1.0	00
/33	/22	/21	/18	/13	/15	/22	/30

3/19/23

+50	29.8
20	29.9-
+50	29.9'
19	30.0-
+50	30.2
18	30.3
+50	30.5.
17	30.4.
+50	30.5.
16	30.6.
+50	30.7.
15	30.9.
+50	30.8.
14	30.8.
+74	P. Ent. R 230.8.

3/19/23

(22)

+1.5 / -3.0 / -2.0 / -0.5 / -0.3 / 00 / -2.5 / +5.0  
39 / 24 / 20 / 15 / 9 / 17 / 26 / 40

+5.0 / -3.5 / -0.5 / +5.0 / 0.0 / +0.2 / -2.0 / +1.5  
41 / 21 / 15 / 41 / 9 / 19 / 25 / 37

+1.0 / -2.0 / -0.4 / -0.2 / 00 / -1.1 / -2.0  
38 / 19 / 13 / 9 / 17 / 22 / 33

L.O. / -2.5 / -0.5 / -0.3 / 00 / -2.0 / -2.5 / L.O.  
19 / 13 / 9 / 18 / 23 / 28

L.O. / -3.0 / -0.6 / -0.3 / -0.5 / -2.0 / -2.0 / -1.2 / L.O.  
20 / 12 / 9 / 16 / 21 / 25 / 30

5.5 / -2.5 / -2.0 / -2.4 / -0.5 / -0.4 / -0.4 / -1.1 / -2.0 / -0.5 / 0.0  
29 / 24 / 20 / 12 / 9 / 17 / 21 / 27 / 28 / 34

-0.9 / -0.5 / -2.1 / -2.1 / -0.5 / -0.5 / 00 / -1.1 / -2.0 / 00 / +0.5  
33 / 25 / 22 / 17 / 12 / 8 / 16 / 19 / 24 / 28 / 36

L.O. / -1.0 / -2.0 / -2.0 / -0.5 / -0.4 / -0.5 / -2.0 / -2.5 / 00 / L.O.  
23 / 21 / 17 / 12 / 8 / 17 / 21 / 25 / 28

L.O. / -2.5 / -2.0 / -1.0 / -0.5 / -0.5 / -0.5 / -2.0 / -2.0 / -1.0 / L.O.  
25 / 18 / 12 / 10 / 15 / 21 / 25 / 28

-1.0 / -2.0 / -2.5 / -2.4 / -0.5 / -0.3 / -0.5 / -0.5 / -2.5 / -2.5 / -2.0 / -1.2  
33 / 23 / 20 / 17 / 12 / 7 / 10 / 17 / 22 / 25 / 28 / 33

+0.5 / -0.5 / -1.5 / -1.5 / -0.3 / -0.3 / -0.7 / -0.7 / -2.5 / -2.5 / -1.5 / L.O.  
35 / 23 / 21 / 16 / 13 / 7 / 16 / 17 / 20 / 24 / 28

L.O. / 0.0 / -1.5 / -1.5 / -0.5 / -0.7 / -2.1 / -2.0 / -0.5 / L.O.  
27 / 20 / 16 / 11 / 19 / 21 / 25 / 29

L.O. / 0.0 / -1.7 / -1.5 / -0.5 / -0.4 / -1.0 / -2.5 / -2.5 / -1.1 / L.O.  
25 / 21 / 18 / 15 / 8 / 17 / 21 / 24 / 28

L.O. / -0.5 / -1.0 / -1.0 / -0.5 / -0.3 / -0.3 / -1.2 / -2.5 / -3.0 / -2.1 / L.O.  
24 / 22 / 18 / 16 / 9 / 9 / 16 / 20 / 25 / 30

L.O. / -1.0 / -1.0 / -1.2 / -0.15 / -0.3 / -3.0  
25 / 21 / 18 / 14 / 17 / 35

3/19/23

+50      old driveway L <sup>23/13</sup>

27      31.2

+50      31.3

26      31.2

+50      31.1

25      31.0

+50      30.7

24      30.4

+50      30.0

23      12"      29.6

+50      29.2

22      29.1

+50      29.2

21      229.3

3/19/23

(23)

$$\begin{array}{cccccccc} -1.5 & -1.5 & 00 & -0.2 & -1.5 & -2.0 & & 2.0 \\ /45 & /34 & /15 & \sqrt{12} & /22 & /30 & & \end{array}$$

$$2.0 \quad \begin{array}{cccccccc} -0.5 & 00 & -0.5 & -1.0 & -1.3 & & & 2.0 \\ /18 & /14 & /14 & /21 & /27 & & & \end{array}$$

$$2.0 \quad \begin{array}{cccccccc} +0.5 & -1.0 & -1.0 & +0.2 & -0.3 & -1.6 & -1.6 & 00 \\ /24 & /22 & /16 & /12 & \sqrt{16} & /18 & /22 & /24 \end{array} \quad 2.0$$

$$2.5 \quad \begin{array}{cccccccc} +1.5 & -1.0 & -1.5 & 00 & -0.3 & -1.5 & -1.5 & +2.0 \\ /28 & /23 & /16 & /12 & \sqrt{15} & /20 & /22 & /25 \end{array} \quad 2.0$$

$$2.0 \quad \begin{array}{cccccccc} +2.5 & -2.0 & -1.5 & -0.2 & -0.2 & -1.0 & +3.0 & 2.0 \\ /28 & /21 & /17 & /12 & \sqrt{15} & /20 & /26 & \end{array}$$

$$2.0 \quad \begin{array}{cccccccc} +2.0 & -2.5 & -0.2 & -0.5 & -1.0 & -3.5 & & \\ /28 & /19 & /12 & \sqrt{15} & /21 & /28 & & \end{array}$$

$$2.0 \quad \begin{array}{cccccccc} +2.0 & -2.2 & -0.5 & -0.2 & -1.5 & +4.9 & & 2.0 \\ /28 & /18 & /11 & \sqrt{17} & /20 & /30 & & \end{array}$$

$$2.0 \quad \begin{array}{cccccccc} +2.7 & -2.2 & 00 & -0.2 & -2.5 & -1.5 & -1.5 & \\ /30 & /18 & /11 & \sqrt{16} & /24 & /30 & /35 & \end{array}$$

$$2.0 \quad \begin{array}{cccccccc} +1.5 & -2.0 & 00 & +0.2 & +2.5 & +2.5 & -1.5 & \\ /28 & /17 & /10 & \sqrt{17} & /25 & /30 & /38 & \end{array}$$

$$\begin{array}{cccccccc} -3.0 & -3.5 & -0.5 & 00 & -4.5 & -3.0 & +0.5 & \\ /33 & /19 & /12 & \sqrt{16} & /26 & /32 & /40 & \end{array}$$

$$2.0 \quad \begin{array}{cccccccc} -1.3 & -0.5 & 00 & -4.5 & & & & \\ /35 & /11 & /17 & /33 & & & & \end{array}$$

$$\begin{array}{cccccccc} -16.5 & -15.0 & -0.4 & 00 & 00 & -4.5 & & \\ /45 & /36 & /18 & \sqrt{8} & /18 & /34 & & \end{array}$$

$$\begin{array}{cccccccc} -16.0 & -15.0 & -0.5 & ~~11.5~~ & & 00 & -3.0 & -1.5 \\ /45 & /35 & /13 & ~~30~~ & & /15 & /27 & /33 \end{array}$$

$$\begin{array}{cccccccc} -6.0 & -4.0 & 00 & - & +0.2 & 00 & -2.0 & +4.5 \\ /33 & /20 & /13 & & \sqrt{9} & /17 & /23 & /38 \end{array}$$

3/21/23

+50	231.3	} Tierney Persons Mahoney Carr
34	31.2	
+50	31.2	
33	31.2	
+50	31.3	
32	31.4	
+50	31.5	
31	31.4	
+50	31.4	
30	31.4	
+50	31.4	
29	31.5	
+50	31.3	
28	231.4	

2.0 00 / -1.0 / -1.0 / -0.2 / 00 / -1.1 / -1.4 / -0.5 / -1.3 /  
 24 / 22 / 19 / 16 / 15 / 20 / 23 / 25 / 33

-0.2 / -1.3 / -1.2 / 00 / -0.2 / -1.0 / -1.2 / 0.1 / -1.0 /  
 2.0 22 / 22 / 19 / 17 / 16 / 19 / 22 / 24 / 33

2.0 -0.2 / -1.3 / -1.5 / -0.2 / -0.2 / -1.2 / -1.5 / -0.2 / -1.0 /  
 27 / 23 / 19 / 14 / 15 / 19 / 21 / 24 / 33

2.0 00 / -1.0 / -1.0 / -0.2 / 00 / -1.0 / -1.5 / -1.0 / -1.5 /  
 25 / 22 / 18 / 14 / 15 / 20 / 24 / 27 / 33

2.0 -0.2 / -1.5 / -1.5 / -0.2 / -1.5 / -1.8 / -1.2 / -2.0 /  
 28 / 25 / 20 / 15 / 17 / 22 / 24 / 33

-1.0 / -1.0 / -1.5 / -1.5 / -0.2 / 00 / -1.2 / -1.2 / -0.2 / -1.0 /  
 32 / 27 / 22 / 15 / 14 / 16 / 20 / 23 / 27 / 33

-1.0 / -1.0 / -1.5 / -1.5 / -0.2 / -1.2 / -1.4 / -1.6 / -1.2 / -1.2 /  
 33 / 29 / 24 / 19 / 13 / 14 / 20 / 24 / 26 / 33

2.0 00 / -0.5 / -1.2 / -1.0 / 00 / 00 / -1.2 / -1.3 / 00 / -1.0 /  
 28 / 24 / 21 / 19 / 13 / 16 / 20 / 22 / 26 / 33

-0.2 / 00 / -1.5 / -1.5 / +0.1 / 00 / -1.2 / -1.3 / 00 / -0.5 /  
 33 / 29 / 27 / 19 / 13 / 15 / 20 / 23 / 27 / 25

2.0 -0.5 / -1.5 / -1.2 / 00 / 00 / -1.5 / -1.5 / +0.5 / -1.0 /  
 27 / 21 / 18 / 12 / 17 / 20 / 24 / 28 / 33

2.0 -0.5 / -1.0 / -1.1 / 00 / 00 / -1.0 / -1.0 / 00 / -0.2 /  
 26 / 22 / 19 / 14 / 15 / 20 / 24 / 27 / 33

-0.2 / -0.5 / -1.0 / -1.0 / 00 / -0.2 / -1.5 / -1.5 / 00 / 2.0 /  
 33 / 25 / 22 / 18 / 12 / 16 / 21 / 25 / 28

2.0 -0.8 / -1.2 / -1.2 / 00 / -0.2 / -1.2 / -1.2 / 00 / -0.6 /  
 26 / 23 / 19 / 13 / 18 / 19 / 24 / 26 / 33

-2.0 / -1.2 / -2.0 / -2.0 / 00 / 00 / -1.3 / -1.3 / -0.5 / -1.5 /  
 33 / 28 / 25 / 19 / 14 / 13 / 18 / 22 / 25 / 33

3/21/23

41	230.7
+70	31.1 Relax R
+50	31.1
40	31.3
+50	31.4
39	31.4
+50	31.3
38	31.3
+50	31.5
37	31.5
+50	31.5
36	31.4
+50	31.5
35	231.3

L. 6	+3.5	-1.5	-1.5	+8.2	00	-1.3	-1.3	+3.7	L.O.
	/33	/26	/20	/16	/15	/19	/25	/36	

+2.7	-1.0	-1.0	00	00	+1.0
/35	/29	/22	/18	/15	/46

L.O.	+1.0	-1.0	-1.0	00	00	-1.0	-1.0	+2.5	+2.0
	/33	/29	/20	/17	/15	/15	/24	/29	/35

-1.0	+0.5	+0.2	-1.0	-1.0	+0.2	00	-1.0	-1.0	+1.0	L.O.
/35	/31	/27	/24	/21	/17	/15	/20	/24	/28	

-2.5	-1.0	-1.7	-1.7	00	00	-2.0	-2.0	-0.8	L.O.
/35	/28	/26	/22	/17	/15	/20	/24	/26	

-0.7	-2.5	-2.5	00	00	-1.5	-1.5	-1.0	-2.0
/33	/25	/21	/15	/16	/30	/23	/25	/33

-4.0	-3.0	-2.1	-2.1	00	00	-1.7	L.O.
/33	/27	/25	/20	/16	/15	/21	

-3.0	-2.0	-2.0	-0.5	00	-1.3	-1.3	-0.5	-1.5
/33	/26	/22	/14	/15	/19	/22	/24	/33

-2.0	-1.4	-1.4	-1.6	-0.5	00	00	-1.0	-1.0	+0.2	L.O.
/33	/26	/25	/20	/14	/14	/15	/20	/24	/26	

-1.0	-0.5	-1.2	-1.2	-0.2	00	+0.2	-0.5	-0.4	+0.4	L.O.
/23	/25	/21	/20	/16	/13	/15	/18	/22	/26	

-1.2	+0.5	-0.8	-0.8	00	00	-0.3	00	+1.2	+1.0
/33	/24	/23	/20	/15	/14	/18	/21	/25	/33

-0.7	00	-1.0	-1.0	00	00	-0.6	-0.6	+1.0	L.O.
/33	/26	/22	/22	/16	/14	/19	/22	/24	

-1.0	-0.6	-1.3	-0.2	00	-1.0	-0.8	00	L.O.
/33	/26	/21	/15	/15	/18	/21	/25	

-1.0	-0.5	-1.2	-1.2	-0.2	00	-1.0	-1.0	00	-0.7
/33	/25	/21	/19	/15	/13	/18	/21	/25	/33

3/21/23

48 208.4

+50 10.5

+30 11.3  
Rdwy L (12" Cor. I Culv. 11 to Rd)

47 12.4

+50 14.4

46 16.0

+50 18.0

45 19.9

+50 21.6

44 23.6

+50 25.4

43 26.8

+50 28.1  
PR. E - R

42 29.2

41+50 229.9

-1.5 / -1.0 / -0.5 / 00 / +0.2 / -0.8 / -1.5 / L.O.  
33 / 24 / 17 / 15 / 16 / 20 / 28

-0.5 / -0.3 / -0.2 / 00 / 00 / -0.9 / -2.5 /  
33 / 27 / 21 / 16 / 16 / 18 / 35

+1.0 / +0.3 / 00 / -1.5 / -2.5 / L.O.  
45 / 20 / 16 / 20 / 33

L.O. +0.8 / +0.5 / -1.5 / -1.5 / 00 / 00 / -1.5 / -3.0 / L.O.  
33 / 30 / 26 / 20 / 16 / 17 / 23 / 33

L.O. +0.5 / -1.0 / -0.8 / +0.4 / -0.5 / -2.0 / L.O.  
31 / 27 / 21 / 17 / 17 / 23

L.O. 00 / -1.5 / -1.0 / +0.4 / 00 / -2.5 / L.O.  
27 / 26 / 20 / 16 / 16 / 21

00 / +1.0 / -1.2 / -1.2 / 00 / 00 / -1.5 / L.O.  
34 / 26 / 23 / 18 / 15 / 17 / 21

L.O. +0.4 / -1.3 / -1.3 / +0.4 / 00 / -2.0 / -2.0 / -0.7 / -0.7 / L.O.  
26 / 25 / 20 / 16 / 18 / 23 / 27 / 29 / 34

L.O. +2.5 / -1.3 / -1.3 / 00 / 00 / -1.6 / -1.0 / +1.0 / L.O.  
34 / 27 / 21 / 18 / 18 / 22 / 29 / 32

L.O. +3.5 / +4.0 / 2.10 / -1.0 / +0.5 / +0.2 / -1.5 / -1.5 / +2.5 / L.O.  
43 / 35 / 26 / 21 / 15 / 18 / 22 / 28 / 33

L.O. +4.0 / -1.0 / -1.0 / +0.2 / +0.3 / -1.2 / -1.2 / +2.0 / L.O.  
36 / 26 / 21 / 18 / 15 / 19 / 23 / 29

L.O. +3.5 / -0.8 / -0.2 / +0.6 / +0.2 / -1.2 / -1.2 / +2.2 / L.O.  
34 / 26 / 21 / 18 / 16 / 20 / 25 / 29

L.O. +5.0 / -1.3 / -1.3 / +0.3 / 00 / +0.2 / +2.0 / L.O.  
34 / 26 / 21 / 18 / 15 / 25 / 46

+5.0 / -1.5 / -1.5 / +0.3 / +0.2 / -1.0 / -1.0 / +4.1 / L.O.  
33 / 25 / 21 / 17 / 15 / 20 / 24 / 32

+5.0 / -1.4 / -1.4 / 00 / +0.2 / -1.3 / -1.3 / +4.4 / L.O.  
34 / 25 / 20 / 17 / 15 / 20 / 25 / 32

3/21/23

+50 198.1

53 98.6

+50 99.1

52 99.5

+50 199.7

51 200.3

+50 200.9

50 01.8

+50 02.8

49 04.3

+50 205.9

3/21/23

(27)

+1.0/ 39	-2.0/ 30	-1.5/ 22	0.0/ 18	-0.4/ 18	-1.2/ 26	-2.0/ 35
-------------	-------------	-------------	------------	-------------	-------------	-------------

L.O.	-2.0/ 22	0.0/ 16	0.0/ 18	-1.0/ 21	-2.0/ 33
------	-------------	------------	------------	-------------	-------------

L.O.	-2.5/ 26	+0.2/ 16	-0.5/ 17	-3.0/ 22	L.O.
------	-------------	-------------	-------------	-------------	------

L.O.	-3.0/ 26	0.0/ 16	-0.4/ 16	-3.0/ 25	L.O.
------	-------------	------------	-------------	-------------	------

L.O.	-3.2/ 25	0.0/ 16	-0.2/ 18	-2.5/ 22	L.O.
------	-------------	------------	-------------	-------------	------

L.O.	-3.5/ 25	+0.3/ 17	-0.1/ 17	-2.5/ 23	-2.5/ 29	-2.0/ 33
------	-------------	-------------	-------------	-------------	-------------	-------------

L.O.	-4.0/ 25	0.0/ 16	0.0/ 17	-2.5/ 24	L.O.
------	-------------	------------	------------	-------------	------

L.O.	-4.0/ 23	0.0/ 15	0.0/ 17	-2.5/ 24	L.O.
------	-------------	------------	------------	-------------	------

L.O.	-4.5/ 24	-0.2/ 16	+0.1/ 17	-2.5/ 27	L.O.
------	-------------	-------------	-------------	-------------	------

L.O.	-3.7/ 25	0.0/ 16	0.0/ 16	-3.0/ 26	L.O.
------	-------------	------------	------------	-------------	------

-3.0/ 37	-2.5/ 27	-2.0/ 21	0.0/ 16	0.0/ 15	-0.5/ 17	-1.0/ 23	-1.5/ 26	L.O.
-------------	-------------	-------------	------------	------------	-------------	-------------	-------------	------

59		203.4
+50		201.4
58		199.5
+50		97.9
57		96.6
+50		96.1
56		96.1
+80		96.3
+70	Along N Edge Br. Emb	96.4
+50	E Bridge	96.5
+30	Along S Edge Br. Emb	96.8
+20		97.0
55		97.2
+50		97.7
54		197.9

L.O.  $\frac{-9.5}{30}$   $\frac{+0.2}{14}$   $\frac{+0.5}{15}$   $\frac{-7.8}{26}$  L.O.

L.O.  $\frac{-7.5}{28}$   $\frac{00}{14}$   $\frac{+0.2}{15}$   $\frac{-7.0}{26}$  L.O.

L.O.  $\frac{-5.0}{24}$   $\frac{00}{14}$   $\frac{00}{15}$   $\frac{-6.0}{24}$  h.6

L.O.  $\frac{-4.0}{20}$   $\frac{00}{14}$   $\frac{-0.2}{16}$   $\frac{-4.0}{24}$  L.O.

L.O.  $\frac{-2.5}{18}$   $\frac{00}{14}$   $\frac{-0.4}{16}$   $\frac{-2.5}{22}$  L.O.

L.O.  $\frac{-2.1}{18}$   $\frac{00}{14}$   $\frac{-0.5}{16}$   $\frac{-2.2}{20}$  L.O.

$\frac{-1.5}{18}$   $\frac{00}{14}$   $\frac{00}{16}$   $\frac{-1.8}{19}$   $\frac{-1.5}{27}$  L.O.

$\frac{+1.3}{33}$   $\frac{00}{24}$   $\frac{+0.5}{15}$   $\frac{00}{16}$   $\frac{-1.9}{19}$   $\frac{-0.5}{23}$  S.S.

$\frac{+1.0}{33}$   $\frac{00}{25}$   $\frac{+0.5}{15}$   $\frac{+0.1}{10}$   $\frac{+1.0}{19}$   $\frac{+3.0}{28}$  S.S.

$\frac{+2.5}{33}$   $\frac{+1.0}{28}$   $\frac{00}{21}$   $\frac{+0.2}{10}$   $\frac{-0.5}{16}$   $\frac{+1.0}{20}$   $\frac{+3.0}{26}$   $\frac{+5.0}{29}$   $\frac{+7.0}{33}$

S.S.  $\frac{+6.0}{37}$   $\frac{+4.0}{33}$   $\frac{+2.0}{26}$   $\frac{+0.5}{17}$   $\frac{+8.1}{18}$   $\frac{00}{21}$   $\frac{+4.2}{29}$   $\frac{+6.0}{33}$  S.S.

$\frac{-2.0}{33}$   $\frac{-2.0}{21}$   $\frac{00}{15}$   $\frac{-0.1}{19}$   $\frac{-2.4}{23}$  L.O.  
 $\frac{-2.1}{33}$   $\frac{-2.0}{20}$   $\frac{00}{15}$   $\frac{-0.2}{19}$   $\frac{-2.5}{24}$  L.O.

$\frac{-2.0}{33}$   $\frac{-2.0}{24}$   $\frac{+0.3}{18}$   $\frac{-0.5}{20}$   $\frac{-3.0}{25}$  L.O.

$\frac{00}{34}$   $\frac{-2.0}{30}$   $\frac{-2.0}{23}$   $\frac{+0.5}{17}$   $\frac{-0.4}{17}$   $\frac{-3.5}{25}$  L.O.

Marsh

Marsh

66. 225.8

+50 25.0

65 24.0

+50 22.8

64 21.3

+50 19.7

63 18.1

+50 16.4

62 14.4

+50 12.9

61 10.8

+50 08.9

60 07.1

+50 205.2

$$\begin{array}{cccc|cccc} +1.5 & -1.8 & -2.0 & 0.0 & -0.2 & -1.2 & -1.2 & +11.5 \\ \hline 35 & 28 & 27 & 16 & \checkmark & 15 & 20 & 20 & 38 \end{array} \quad (29)$$

$$\begin{array}{cccc|cccc} +4.8 & 0.0 & -2.0 & -0.1 & +0.1 & -1.5 & -1.2 & +2.5 \\ \hline 36 & 32 & 22 & 17 & \checkmark & 14 & 18 & 21 & 33 \end{array} \quad (55.4)$$

$$\begin{array}{cccc|cccc} +1.8 & -1.1 & -1.1 & +0.2 & 0.0 & -1.0 & -1.0 & -0.7 & +3.5 \\ \hline 37 & 26 & 21 & 16 & \checkmark & 14 & 17 & 24 & 33 & 38 \end{array}$$

$$\begin{array}{ccc|ccc} -6.5 & -5.0 & +0.2 & +0.5 & -3.5 & -4.2 & -4.4 \\ \hline 36 & 29 & 15 & \checkmark & 14 & 22 & 36 & 33 \end{array}$$

$$L.O. \quad \begin{array}{cc|cc} -10.0 & -0.1 & +0.2 & -5.0 \\ \hline 36 & 15 & \checkmark & 15 & 25 & L.O. \end{array}$$

$$L.O. \quad \begin{array}{cc|cc} -7.5 & -0.3 & +0.5 & -1.5 & -1.7 \\ \hline 31 & 15 & \checkmark & 15 & 21 & 36 \end{array}$$

$$\begin{array}{ccc|ccc} -5.0 & -4.0 & 0.0 & +0.3 & +1.3 & +2.5 & +2.6 \\ \hline 33 & 24 & 15 & \checkmark & 15 & 22 & 28 & 27 \end{array}$$

$$\begin{array}{ccc|ccc} +1.0 & -0.5 & 0.0 & +0.1 & -0.7 & +6.5 \\ \hline 37 & 29 & 16 & \checkmark & 15 & 19 & 34 \end{array}$$

$$\begin{array}{ccc|ccc} +1.5 & -1.5 & -1.4 & +0.4 & -1.0 & +5.0 & +9.5 \\ \hline 42 & 33 & 21 & 15 & \checkmark & 15 & 17 & 28 & 36 \end{array}$$

$$\begin{array}{ccc|ccc} +9.0 & -1.5 & -0.7 & +0.2 & +0.5 & -1.0 & -1.0 & +8.0 \\ \hline 40 & 25 & 18 & 16 & \checkmark & 16 & 17 & 20 & 33 \end{array}$$

$$\begin{array}{ccc|ccc} +5.0 & -1.2 & -1.2 & +0.2 & +0.2 & -0.4 & +1.5 & +1.5 & +0.5 \\ \hline 33 & 25 & 19 & 17 & \checkmark & 14 & 16 & 23 & 29 & 33 \end{array}$$

$$\begin{array}{ccc|ccc} +0.5 & -2.0 & -2.0 & 0.0 & +0.4 & -4.0 & L.O. \\ \hline 37 & 25 & 19 & 15 & \checkmark & 15 & 23 & L.O. \end{array}$$

$$L.O. \quad \begin{array}{cc|cc} -5.0 & +0.0 & +0.5 & -7.5 \\ \hline 24 & 15 & \checkmark & 15 & 27 & L.O. \end{array}$$

$$L.O. \quad \begin{array}{cc|cc} -8.5 & +0.7 & +0.5 & 7.5 \\ \hline 30 & 15 & \checkmark & 15 & 29 & L.O. \end{array}$$

73

221.3

+50

21.0

72

20.0

+50

19.5

71

19.9

+50

20.1

70

20.9

+50

22.5

69

23.8

+50

25.0

68

26.0

+50

26.5

67

27.6

+50

226.6

-0.5 / 36 -2.0 / 24 -0.2 / 15 ✓ -0.1 / 15 -8.0 / 29 L.O.

-5.0 / 33 -5.0 / 29 0.0 / 15 ✓ -0.4 / 14 -9.0 / 28 L.O.

-7.0 / 34 -0.5 / 29 +0.3 / 17 ✓ +0.1 / 14 -8.0 / 29 L.O.

-5.0 / 35 -5.0 / 27 +0.5 / 16 0.0 / 14 -6.5 / 25 L.O.

-5.5 / 36 -5.5 / 27 +0.2 / 15 ✓ -0.2 / 14 -8.2 / 28 L.O.

-5.7 / 33 -5.7 / 28 +0.3 / 16 +0.3 / 16 ✓ +0.1 / 15 -8.5 / 29 L.O.

-6.1 / 33 -6.1 / 30 +0.2 / 16 0.0 / 14 -9.5 / 27 L.O.

-1.6 / 33 -1.6 / 29 -2.0 / 27 -1.6 / 21 0.0 / 16 ✓ 0.0 / 14 -9.0 / 26 L.O.

+3.5 / 34 -1.0 / 34 -1.3 / 20 -0.2 / 16 0.0 / 15 -3.2 / 21 -5.1 / 27 -6.1 / 33

+9.5 / 33 0.0 / 22 -1.0 / 17 0.0 / 15 ✓ +0.3 / 15 -0.9 / 19 -0.1 / 22 +5.3 / 29

+12.0 / 33 +0.5 / 22 -0.6 / 18 +0.3 / 14 ✓ +0.3 / 15 -0.8 / 18 -0.6 / 21 +12.0 / 34

+12.5 / 33 -0.6 / 18 +0.2 / 15 ✓ +0.3 / 15 -0.3 / 18 +0.1 / 21 +14.5 / 36

+11.5 / 36 -1.1 / 23 -1.5 / 19 +0.2 / 15 ✓ +0.3 / 15 -0.5 / 18 0.0 / 23 +13.5 / 38

+9.0 / 38 -1.2 / 25 -2.0 / 20 +0.3 / 15 0.0 / 15 ✓ -1.0 / 18 +12.5 / 40

3/23/23

Tierney  
Mahoney  
Perrino's  
Cart

80 07.9

+50 09.6

79 12.0

+50 14.0

78 15.8

+50 17.5

77 18.4

+50 19.7

76 20.6

+50 21.0

75 21.1

+50 21.3

74 21.6

93 +50 22.5

-4.0 / 48 -3.5 / 40 -1.7 / 36 -1.8 / 26 -0.8 / 22 +0.2 / 16 -1.7 / 23 L.O.

L.O. -9.5 / 50 -8.0 / 40 -1.5 / 21 +0.5 / 17 -1.0 / 22 -1.0 / 34

L.O. -10.5 / 35 -1.2 / 19 +0.5 / 16 -4.5 / 38

S.S. -8.5 / 50 -9.0 / 38 -1.0 / 21 -0.2 / 14 -6.0 / 28 L.O.

L.O. +1.2 / 32 -1.4 / 26 -1.5 / 22 +0.4 / 18 +0.1 / 15 -1.2 / 20 -0.7 / 24 +0.5 / 26 L.O.

L.O. +5.0 / 34 -0.5 / 26 -0.6 / 21 +0.1 / 16 0.0 / 15 -0.8 / 18 -0.4 / 22 +1.7 / 26 L.O.

+10.2 / 32 -0.7 / 26 -0.6 / 21 +0.2 / 17 +0.1 / 16 -0.8 / 19 -0.2 / 23 +1.3 / 27 L.O.

+7.4 / 35 -1.1 / 25 -1.0 / 21 +0.1 / 16 0.0 / 15 -0.3 / 20 -0.7 / 25 +0.8 / 28 +0.2 / 33

+2.3 / 34 +2.3 / 32 -1.1 / 25 -1.0 / 20 0.0 / 16 +0.2 / 15 -0.8 / 20 -0.9 / 24 +1.2 / 28 +0.8 / 33

-0.7 / 23 +0.1 / 28 -0.8 / 20 +0.2 / 17 -0.3 / 15 -1.3 / 21 -1.2 / 34

+5.0 / 35 +3.5 / 30 -0.7 / 22 -0.6 / 20 +0.1 / 17 -0.3 / 15 -2.2 / 21 -2.7 / 33

+10.5 / 37 -0.5 / 24 -0.5 / 20 +0.2 / 17 0.0 / 16 -1.9 / 21 -1.3 / 25 +1.7 / 30 +1.9 / 33

+9.5 / 38 -0.5 / 23 -0.5 / 19 0.0 / 16 -0.3 / 16 -1.2 / 20 -1.2 / 29 +1.5 / 31 +1.8 / 33

+3.0 / 34 +1.9 / 29 -1.0 / 24 -1.0 / 20 -0.7 / 16 +0.2 / 15 -2.6 / 25 -2.7 / 33

+ 50 203.1

86. 02.0

+ 50 200.8

85 199.7

+ 50 98.9

84 30" <sup>97.9</sup> Corr. T Culv. in place

+ 50 98.0

83 98.1

+ 50 98.4

82 199.7

+ 42 202.3

+ 36 <sup>02.7</sup> Pr. Kpt. R

81 03.7

80 + 50 206.0

$$\begin{array}{cccccccc} +16.0 & +2.3 & -0.7 & -0.8 & 0.0 & -0.5 & -1.5 & -1.2 & +2.3 & L.O. \\ \hline 45 & 24 & 21 & 17 & 15 & 15 & 19 & 24 & 31 & \end{array}$$

$$\begin{array}{cccccccc} +11.5 & +0.7 & -1.3 & -1.2 & 0.0 & 0.0 & -1.5 & -1.5 & +2.3 & L.O. \\ \hline 41 & 25 & 23 & 18 & 14 & 15 & 20 & 25 & 30 & \end{array}$$

$$\begin{array}{cccccccc} L.O. & -1.8 & -2.0 & -0.2 & -0.3 & -6.0 & -9.0 & & & S.S. \\ \hline & 28 & 20 & 14 & 15 & 27 & 40 & & & \end{array}$$

$$\begin{array}{cccccccc} L.O. & -12.0 & 0.0 & & -0.2 & & -15.0 & -16 & & \\ \hline & 34 & 13 & & 14 & & 43 & 50 & & \end{array}$$

$$\begin{array}{cccccccc} L.O. & -16.0 & -0.2 & & -0.3 & & & -17.0 & & L.O. \\ \hline & 42 & 15 & & 15 & & & 44 & & \end{array}$$

$$\begin{array}{cccccccc} L.O. & -14.5 & -0.3 & & -0.7 & & & -12.5 & & L.O. \\ \hline & 39 & 15 & & 15 & & & 44 & & \end{array}$$

$$\begin{array}{cccccccc} L.O. & -13.5 & -0.7 & & -0.7 & & & -17.5 & & L.O. \\ \hline & 39 & 16 & & 14 & & & 43 & & \end{array}$$

$$\begin{array}{cccccccc} L.O. & -14.0 & -0.6 & & -0.6 & & & -17.5 & & L.O. \\ \hline & 39 & 15 & & 14 & & & 43 & & \end{array}$$

$$\begin{array}{cccccccc} L.O. & -14.5 & -0.5 & & -0.4 & & & -15.5 & & L.O. \\ \hline & 38 & 14 & & 14 & & & 41 & & \end{array}$$

$$\begin{array}{cccccccc} L.O. & -12.5 & 0.0 & & -0.1 & & & -13.0 & & L.O. \\ \hline & 37 & 12 & & 14 & & & 33 & & \end{array}$$

$$\begin{array}{cccccccc} -8.0 & -7.0 & -2.0 & -0.8 & -0.6 & -1.0 & -1.0 & & & \\ \hline 39 & 32 & 32 & 17 & 18 & 40 & 50 & & & \end{array}$$

$$\begin{array}{cccccccc} -4.8 & -4.0 & -0.7 & -0.5 & -1.0 & -1.0 & & & & \\ \hline 39 & 30 & 18 & 18 & 39 & 50 & & & & \end{array}$$

$$\begin{array}{cccccccc} S.S. & -1.0 & -0.5 & -1.3 & -1.0 & -0.7 & -0.1 & -0.5 & -2.0 & L.O. \\ \hline 37 & 27 & 26 & 21 & 18 & 15 & 24 & 33 & & \end{array}$$

$$\begin{array}{cccccccc} S.S. & -1.2 & 0.0 & -1.5 & -1.0 & +0.4 & -1.3 & -1.3 & & \\ \hline 43 & 32 & 28 & 23 & 19 & 26 & 31 & & & \end{array}$$

97 227.7

96 25.9

95 25.2

+30 } xsections omitted here - See last sheet xsections  
+17 }

94 20.3

93 17.3

92 15.0

91 12.0

90 210.0

+50 208.9

89 07.7

+50 07.1

88 06.2

+50 05.1

87 204.2

~~00~~ / ~~33~~      ~~00~~ / ~~33~~

~~+0.3~~ / ~~33~~      ~~-0.3~~ / ~~33~~

~~-0.5~~ / ~~33~~      ~~00~~ / ~~33~~

~~+1.0~~ / ~~36~~    ~~+0.5~~ / ~~25~~    ~~+2.0~~ / ~~17~~    ~~-0.2~~ / ~~7~~     $\sqrt{\text{ERd.}}$  ~~+0.5~~ / ~~11~~    ~~-0.5~~ / ~~21~~    ~~+2.0~~ / ~~26~~    L.O.

~~+0.1~~ / ~~34~~    ~~-0.1~~ / ~~25~~    ~~-1.0~~ / ~~21~~    ~~-0.8~~ / ~~15~~    ~~-0.5~~ / ~~12~~    ~~-0.5~~ / ~~18~~    ~~+1.5~~ / ~~25~~    L.O.  
(E Ditch Drains)

~~-2.0~~ / ~~38~~    ~~-5.0~~ / ~~34~~    ~~-3.0~~ / ~~26~~    ~~-0.7~~ / ~~12~~    ~~-0.5~~ / ~~12~~    ~~-1.2~~ / ~~18~~    ~~-1.0~~ / ~~22~~    L.O.

~~-7.0~~ / ~~36~~    ~~-7.0~~ / ~~24~~    ~~-1.0~~ / ~~14~~     $\sqrt{\text{S.S.}}$  ~~-0.7~~ / ~~12~~    ~~-1.5~~ / ~~19~~    ~~-0.8~~ / ~~31~~

~~-11.0~~ / ~~40~~    ~~-3.5~~ / ~~26~~    ~~-1.2~~ / ~~12~~    ~~-1.0~~ / ~~10~~    ~~-1.3~~ / ~~15~~    ~~-0.5~~ / ~~18~~    ~~+1.0~~ / ~~38~~    S.S.  
ER.

~~-2.0~~ / ~~32~~    ~~-0.8~~ / ~~21~~    ~~-0.2~~ / ~~18~~    ~~+0.5~~ / ~~8~~    ~~-0.5~~ / ~~10~~    ~~00~~ / ~~15~~    ~~+1.0~~ / ~~33~~    S.S.

ER  
~~00~~ / ~~37~~    ~~+0.5~~ / ~~24~~    ~~+0.8~~ / ~~15~~    ~~-0.3~~ / ~~10~~    ~~+3.0~~ / ~~15~~    ~~+3.8~~ / ~~33~~    S.S.

~~+2.6~~ / ~~34~~    ~~+2.5~~ / ~~32~~    ~~-1.2~~ / ~~23~~    ~~-0.5~~ / ~~21~~    ~~-0.7~~ / ~~10~~    ~~-0.1~~ / ~~11~~    ~~-0.5~~ / ~~18~~    ~~+2.5~~ / ~~29~~

~~+8.0~~ / ~~40~~    ~~-0.6~~ / ~~25~~    ~~-1.5~~ / ~~20~~    ~~-0.3~~ / ~~17~~    ~~00~~ / ~~14~~    ~~-1.0~~ / ~~18~~    ~~+10.0~~ / ~~34~~

~~+13.0~~ / ~~38~~    ~~+3.0~~ / ~~26~~    ~~-0.2~~ / ~~20~~    ~~00~~ / ~~15~~    ~~00~~ / ~~17~~    ~~-1.3~~ / ~~21~~    ~~+10.0~~ / ~~34~~

~~+17.0~~ / ~~45~~    ~~-0.5~~ / ~~20~~    ~~-0.6~~ / ~~18~~    ~~-0.1~~ / ~~12~~    ~~-0.1~~ / ~~17~~    ~~-1.2~~ / ~~21~~    ~~-1.2~~ / ~~23~~    ~~+3.7~~ / ~~30~~    L.O.

107	223.8
+ 70	<del>24.1</del> Alley Ent. R.
106	24.7
105+04	<del>25.7</del> Int. Street.
104	26.5
+ 40	<del>26.9</del> Alley Ent. R.
103	27.2
102	28.0
+ 80	<del>28.0</del> PR. Ent. L
101	28.5
100	29.1
99	(Short Sta. = 99.0)
	29.6
+ 50	29.4
98	229.7

+3.3	+0.5	+0.7	-0.4	-0.3	+0.5	+1.3	+2.5	L.O.
35	22	13	9	14	15	22	26	
+2.5	+0.3	+0.7	-0.4	-0.4	00	00		
34	22	13	9	15	39	100		
+3.0	+0.4	+0.2	-0.5	-0.8	-0.2	-1.7	-3.0	-3.2
36	24	13	9	13	15	26	30	33

+3.0	+2.0	+0.5	-0.2	-2.8	-3.1	-4.3	-5.3
100	50	15	9	35	50	100	150

L.O.	+1.5	+0.1	-0.2	-0.9	-2.0	-2.5
	26	21	10	11	22	33

00				-1.3	-2.6	-2.9
33				16	34	44

+1.0	+0.7	00	00	-0.4	-0.7	-0.7	-1.7
33	24	22	15	8	12	22	33

+0.5	00	-0.5	-0.7	-0.4	-2.0	-2.2
28	18	14	12	19	27	33

+0.7	00	-0.7	-2.3	-2.5
41	15	14	28	33

L.O.	-0.7	-0.7	-0.9	-1.6	-2.5
	16	9	15	23	34

L.O.	-0.9	+0.2	-0.8	-1.0	-0.3	-1.6	-2.6
	26	20	12	15	20	26	34

+1.0	+2.0	-0.7	-1.0	-0.2	+1.0	00
33	22	11	12	15	25	35
			ER			

+1.0	+1.8	+2.5	-0.1	+0.3	-0.1	+1.1	+0.8
33	23	19	9	6	17	29	35
					ERd		

35.	00	+0.6	0.2	-0.7	-1.5
	33	8	7	19	34

94+30

222.5

94+17

221.3

+26.9

223.0

Int. Cleve. Ave End Line

+10

222.9

10.8

222.9

$\frac{+0.2}{34}$     $\frac{+0.4}{24}$     $\frac{-1.4}{9}$     $\frac{-0.8}{23}$     $\frac{-1.5}{33}$     $\frac{-1.6}{38}$

⊕ R.d.


$\frac{+1.6}{34}$     $\frac{+1.6}{32}$     $\frac{+0.9}{20}$     $\frac{+0.6}{5}$     $\frac{+1.0}{13}$     $\frac{-0.1}{23}$     $\frac{-0.3}{28}$     $\frac{+2.0}{30}$     $\frac{+3.6}{36}$    L.O.

⊕ R.d.

$\frac{-1.8}{150}$     $\frac{-1.3}{100}$     $\frac{-0.5}{50}$     $\frac{-1.0}{50}$     $\frac{-3.0}{100}$     $\frac{-5.0}{150}$

$\frac{-1.5}{50}$     $\frac{-1.0}{30}$     $\frac{-0.5}{17}$     $\frac{-0.6}{22}$     $\frac{-0.7}{35}$     $\frac{-0.5}{43}$

$\frac{+5.8}{39}$     $\frac{+5.5}{34}$     $\frac{+3.0}{29}$     $\frac{+0.5}{25}$     $\frac{+0.6}{18}$     $\frac{-0.5}{14}$     $\frac{-0.5}{15}$     $\frac{-0.7}{20}$     $\frac{0.0}{23}$     $\frac{+3.0}{31}$     $\frac{+8.0}{38}$

 

Calf yield

A

@00-20' Fce

@+30-33 L Fce Corr.  
@+19-22 L Iron Cut. Syn.

@+41-19 R 6" oak + Fce

3

@00-24' 5" oak  
@+43-24 R Fce Cor  
@+74-20 R 7 1/2 oak  
@+56-25-24 R 2 3/4 oak  
@+53-21 R 6" oak  
@+51-26 R 8 oak  
@+43-25 R 10 oak  
@+32-24 R 10 oak

2

@00-31' Fce

@00-25' 10" oak  
@+14-24 R 6 oak  
@+19-24 R 8 oak

1


@+90-33 R 11" oak  
@+85-20 R 10 oak  
@+12-28 R oak  
@+60-31 R 8 oak  
@+40-18 R 8 oak  
@+38-19 R 8 oak  
@+27-23 R 10 oak  
@+32-26 R 8 oak  
@+28-27 R oak  
@+35-27 R Cor  
@+21-20 R Cor. Barn  
Frame Barn

0-100

@00-29' Fce

70  
50  
Stumpage

20' wide  
Concrete Slab

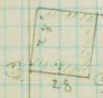

@00-11-29 R  
Frame Ho. Cor

@00-42-35 R Ho. Cor

3-17-23

Cult. field

Stump

10

x x x  
@+48-25'R Fcc Cor.

9

x x  
@+26-35'R 20" oak

x x  
@00-25'R Fcc ✓

oak timber

8

x  
@+41-31'R 18" oak ✓

x  
@00-25'R Fcc

x  
@+16-25'R-8" oak ✓

x  
@+35-24'R-8" oak ✓

x  
@+42-25'R 18" oak ✓

7

x  
@00-25'R Fcc

x  
@+13-33'R-2-16" oak ✓

x  
@+53-24'R 16" oak ✓

x  
@+56-22'R Fcc ✓

6

x  
@+13-26'R 14" oak ✓

x  
@+80-25'R 16" oak ✓

x  
@+61-22'R 6" oak ✓

x  
@+42-22'R 8" oak ✓

5

x  
@+10-25'R 8" oak ✓

Cult. field

Cult. field

oak  
timber

A

3-17-23

L

E

R

16

Cult. field

Cult. field

15

Cult. field

Cult. field

14


13

@ +61 & Drive L.  
Need 20' Culv.

@ +12 - Drive R.  
Need 20' Culv.

12

Cult. field

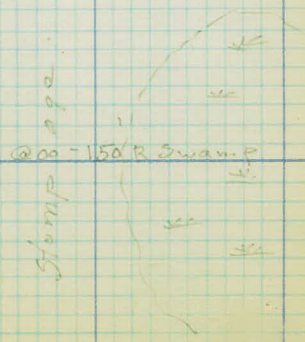

11

10

3-17-23



3-17-23

New Brighton Roll

25

@+83-10 L T. Pole  
2w

@+43-20 L Fee Cor.

@+20-20 L Iron Post

@00-22 L Fee

@+99-30 L T. Pole  
@+99 & Drive L  
Needed Culv

@+42- Stee Tower R

Culv. field

@+53-40+45 R Trans. Pole

@+60- Trans. Line R

@+24-25 R Fee Cor

@+18- Trans. Line R

27

@+13-27 R 12" oak  
@+15-25 R 16" oak

26

@+12-20 R 8" oak

@+08-32 R 5" oak

@00-26 R 4" oak + Fee

@+87-25 R 12" oak

@+64-25 R 4" oak

@+13-26 R 3" oak

@+52-25 R 4" oak

25

@+05-31 R 6" oak

@+00-30 R 12" oak

@+20-28 R 6" oak

@+16-25 R 3" oak + Fee

24

@00-18 L Fee

@00-19 R Fee

23

Oak Brush

Oak Timber

22

N. Br. Rd.

3-17-23

L

E

R

(41)

32

@+26-16L T.Pole  
2w

o

33

@+17-15L T.Pole

o

32

@+61-15L T.Pole  
2w

o

31

Cult  
field

Cult field

30

@+58-14L T.Pole

o

29

@+13-13L T.Pole  
2w

o

Cult  
field

Cult  
field

28

3-17-23

N. Br. Rd



L # R

AD

@+41-16 L Tol. Pole  
2w

3A

@+13-17 L Tel. Pole

36

Cult. field

Cult. field

37

@+54-11 L T. Pole  
2w

36

@+54-11 L T. Pole

35

Cult. field

Cult. field

3A

3-17-23

@+90-11 R.T. Pole  
2w

@+59-22 L T. Pole

@+45-44

@+25-26 R T. Pole

A6

@+11-11 L T. Pole

@+50-21 R.T. Pole  
2w

~~@+11-11 L T. Pole~~  
2w

A5

@+57-11 L T. Pole

@+930-25 R T. Pole

A4

~~@+66-42 V.F. & Cst~~

@+33-11 L T. Pole  
2w

@+37-25 R T. Pole  
5w

A3

@+70-34 L - 10" Oak

@+72-33 R - 10" Tree

@+53-23 R 5 Trees  
75' 16x16  
Need 20 Culv

@+49-11 R Cap. 10. 3w

@+45-11 Drive R

@+34-15 R Mail Bx

@+31-22 R 8" Trees

A2

@+10-11 L T. Pole

@+91-24 R height Tel.  
20' 10"

A1

@+10-32 14" Oak

@+60-11 R

Need 20 Culv

@+38-36 L Fcc Car

A0

3-22-23

L E R

112  
 9 B 12  
 @ +50 - 14' L T. Pole  
 ←  
 ←  
 ←

@ +21 - 19 R 3' Tree  
 Co. Ditch

52

Marsh  
 eye  
 hill

51 @ +05 - 14' L T. Pole

50

@ +59 - 14' L T. Pole

Willow  
 Drain

Meadow

49

@ +45 - 15' L T. Pole  
 2w

48

@ +44 - 1 - 35' T. Pole  
 @ +42 - 11' Ecc. Cor.  
 @ +31 - 1' T. Pole  
 @ +05 - 14' L T. Pole

47

Cult. field

46


3-22-23

N. Brighton Rd.

Clearance from present grade

15.67 ft to underside of Girder

North Trestle Same  
as south trestle but  
has 10 bents

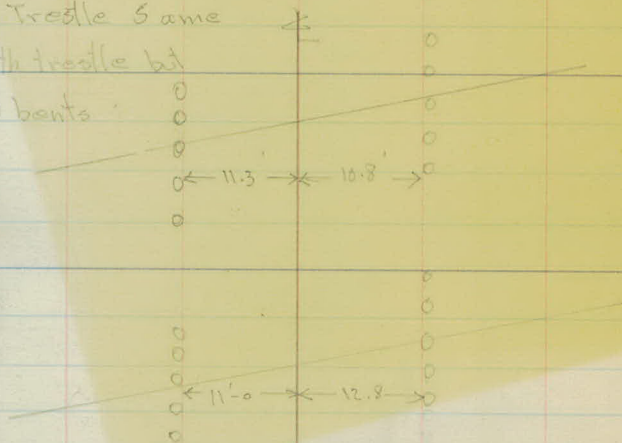

5 Pile to each Bent.

9 Bents in So. Bridge.

10 - 6x16" Timber Girders

6x8 sawed Ties

2 - 6x12 Timber Girders

(2 - (4-16" Steel I beams) in span over Road

59 @+15-17 L 8 Tree  
March @ edge  
fill


@+22-24 R. begin Timber


61 @+16-18 L T. Pole

March @ edge fill

56 @+15-13 L T. Pole  
fill

@+34-17 R Cor. R.o.W. Fee

55 @+38 ± Treed  
@+32 ± Treed

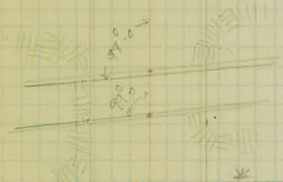

@+50 -13 L T. Pole  
@+70 -20 L Cor. R.o.W. Fee

@+34-36 R Cor. R.o.W. Fee

Oak Timber

5A @+20-22 L 10 Tree

@+12-22 L 6 Tree

@+11-14 L T. Pole

Meadow

57

57

New Brighton Rd

3-17-23

~~0+00~~ End of Paving

~~0+00~~

L E R

oak  
Pine  
oak  
oak

64

@+40-36 L 14 Oak & Cedar

@+62-15 L T. Pole

@+36-26 L-16 Tree

oak Timber

63

@+11-17 L Mail Bx

@+69-32 L-14 Oak

@+61 & Drive  
Wood & Cul.

62

@+13-16 L T. Pole  
2 w

oak  
Pine  
oak  
oak

61

@+64-14 X - T. Pole

60

@+14-14 L T. Pole  
oak Timber

59

oak  
Pine  
oak

58

@+62-25 R 1 Tree  
@+60-25 R Fee  
Timber

@+50-21 R 12 Tree

@+27-20 R Cor. Fee  
Wood & Cul.

@+14 & Drive  
@+07-20 R 16 Tree

@+01-20 R Cor. Fee  
@00-20 R Fee

Timber

@00-20 R-6 Fee

@+41-29 R Bean Brush

@00-26 R Fee

@+80-23 Redgum and  
Timber

@00-26 R Fee

Cult.

3-22-23

Oak  
Brush  
Timber

10

@+58-13L T. Pole

@+35-31L 2" oak

@+09-31L beam fcc

@+13-29L 4" oak

@+12-14L T. Pole

@+63-15L T. Pole

66

@+13-14L T. Pole

65

Oak  
Brush

64

@+10-25' R 8" Willow  
@00-25 R Fcc

@00-37 R Fcc

@00-37 R Fcc

cutt. 1/10/61

cutt. 1/10/61

3-21-23

New Brighton Rd

L E R

3 5

16

Timber  
@+53-14L T. Pole

15

3 5 3 3

Oak 5

14

@+54-13L T. Pole 2w

13

3 3 3

@00-21' end ice.

@+51-13L T. Pole  
@+50-25' end Timber

12

3 3

@+57-13L T. Pole

11

@+10-13L T. Pole 2w

Timber  
Oak  
@+24-20L begin Timber

10

Cult. field  
Cult. field  
Cult. field  
@+65- 27' R Fcan Cor  
@+51- 16' R 2-8 Tree

3-22-23

New Brighton Rd

Tapog. Measured off Curve

L L E R

3, 3, 3

@+24-30 R 2-16 Trees

52

oak Timber

@+40-300 R 4 Ho.

3 3 3

+ @+55-18 R Mail Bx

51

@+25 Drive

@+51-30 L-100 oak

@+26 2 32 L 5" Tree  
@+20 2 32 L 6 oak  
@+15 2 1 L 6 oak  
@00-21 L 5 0 oak

50

@+40-36 L 12" Tree  
@+34-33 L 6 Tree L

@00-150 R T. Pole

@+76 110 R Face L

79

@+30-15 R T. Pole 2w

@00-36 R Face

@+90-30 R 6-9 willows

@+60-29 R begin face

@+56-26 R 6-6 willows

Located from Curve

@+20-13 L C/T Pole

76

oak Timber

Cult. Field

77

@00-15 L T. Pole 2w

76

N. Br. Rd.

3-22-23

16" - Corr. Iron Culvert

L A R

located  
from  
curve

54

2+46.31' L Fcc.

57

000-421 Fcc

Cult. field

56

@ 60-40 L Fcc  
@ +48-40 L Fcc  
@ +52-31 L Fcc begins

Cult. field

55

@ +64-25 1/2" oak  
@ +65-30 L 8"

54

18' 5A' @ 00-100R edge Lake  
Ditch to Lake

53

Dak Timber  
& Brush

@ +12-32 Road Timber

52

@ +12-32 begin Timber

N. B. Rd

3-22-23

93

@ + 13 - 30 L Corn Sight

92

Cult. field

91



90

@ + 30 - 66 L Fce

89

@ + 14 - 35 L Fce

88

@ + 10 - 40 L Fce

Cult. field

87

← Located from Curve →

Cult. field

Cult. field

Cult. field

3-22-23

New Brighton Rd.

L E R

94

Cult. field

98

@00-19 R to Old Road

Cult. field

91

Cult. field

← Located from Curve

@00-52 R to Old Rd

96

@00-14 R to Old Road

95

Cult. field

Truncated Rd

@00-69 R Old Rd

field

92

Cult. field

@00-11 R Old Rd

Cult. field

93

3-22-23

New Brighton Rd.

L E R

105  
 @+32-29 L - 1 1/2" oak  
 @+32-16 L - T. Pole  
 @+24-18 L - 4" Tile walk

@+32-27 R - Fire Cor  
 @+06 - 4" street

104  
 @+54 - 31 L 8" oak  
 @+49 - 24 L - 11" oak  
 @+71 - 26 L - 10 oak

@+22-21 L - 30 oak  
 @+50 - 24 L 11" oak.  
 @+43 - 25 L T. Pole  
 @+22 - 21 L - 11" oak

@+38 - 4 20" Alley R  
 @+32 - 46" R. Pow. Pole

103  
 @+42-33 L 10 oak  
 @+79-29 L - 16 oak

102  
 @+41 - 4 Ho  
 @+35 - 44 L 10 oak  
 @+15 - 32 L 16 oak  
 @+45 - 4 10 drive  
 @+19 - 19 L Fire Cor

101

Cult. field

Cult. field

100


99

3-22-23

New Brighton Road.

109

- @ + 66 - 17 L Fce Cor
- @ + 63 - 17 L - T. Pole
- @ + 61 - 24 L Tee Cor
- @ + 50 - 31 L - ~~School~~ end walk
- @ + 50 end walk

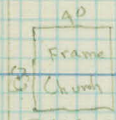

- @ + 50 - N.E. Cor. Church 47R
- @ + 69 - 15 R Guy Pole
- @ + 53 - 26 R

108 + 26.9 ± Cleveland

108

- 107 + 99 - 15 L Iron Rd sign
- @ + 92 - 15 L Pow Pole
- @ + 50 - 33 L 4" Tree
- @ + 60 - 33 L 4" Tree
- @ + 48 + 52 - 32 L 6 oak trees
- @ + 49 ± Ho. 52 L No. Tile
- @ + 37 - 32 L 4" Tree
- @ + 21 - 32 L 4" Tree
- @ + 05 - 32 L 4 Tree
- @ 00 - 18 L - edge Tile walk
- @ + 21 - 14 L Pow. Pole
- @ + 86 - 32 L 4" Tree

- @ + 10 - 96 R water hydr.
- @ 00 - 24 R Pole
- @ 00 - 40 R T. Pole
- 3 Oak Trees
- @ + 23 - 27 R 10 oak

107

- @ + 22 - 31 L 30 oak

- @ + 40 - 40 R T. Pole
- @ + 70 ± 20 Alley R.
- @ + 63 - 24 R Pow. Pole
- @ + 61 - 25 R Fce Cor.

106


- @ + 45 Cor. Ho.
- @ + 54 - 35 L 10 Tree
- @ + 54 - 16 L Cor. Ho.
- @ + 49 - 35 L 12 Tree


- @ + 05 - 20 R 14 oak

105

- @ + 50 - 21 R Fce
- @ + 45 - 21 R 10 oak

104

 

 

3-22-23

New Brighton Rd

- 12+75 Need 38' - 18" Culv. under Rd
- 22+70 Need 55' - 18" Culv. " "
- 52+20 Need 45' - 18" Culv. " "
- 57+00 Need 42' - 18" Culv. " "
- 51+25 12" - 40' Cor. Iron Culver d under drive  
to Right Replace with 18" Culv.
- 84+00 20" - 102' lg. Culv. in place  
Can't Grad
- 91+00 Need 44' - 18" Culv. under Road


To drain side ditch on left

To drain side ditch on right

To drain marsh on left into ditch on right

@ equalizer

elev. invert. low side. Right. ~ 20' lower than  
d @ sta. 84+00 flows right.

 

Check hauls

New Brighton Road.

3/22/23

3/27/23

Check Levels N. B. Rd.

B.M.	8.79	236.24	<del>3.39</del>	227.45
	5.47	238.32	3.39	232.85
B.M.				6.37 231.95
	2.67	237.80	3.19	235.13
B.M.				6.47 231.38
	4.17	234.95	7.02	230.78
B.M.				5.93 229.02
B.M.	4.36	236.09	3.22	231.73
B.M.	2.18	234.34	3.93	232.16
	1.34	223.82	11.86	222.48
B.M.	0.00	213.03	10.79	213.03
	1.57	202.75	11.85	201.18
B.M.				5.55 197.20
B.M.				6.03 196.72
	11.46	214.06	0.15	202.60
	11.59	225.47	0.18	213.88
B.M.				5.04 220.43
	4.56	229.72	8.31	225.16
	0.03	222.50	7.25	222.47
	1.27	213.42	10.29	212.21
B.M.			±	5.87 207.55
	0.73	203.85	10.30	203.12
	10.01	213.09	0.77	203.02
B.M.				8.48 204.61
	11.05	223.78	0.36	212.73
	10.81	233.93	0.66	223.12
	3.64	231.65	5.92	228.01

3/27/23

{ Tierney  
Persons

Nail in T.P. 500' S End pave

Nail in 12" Oak SW Cor Cty R/D + N.B.R.

Nail in 15" Oak 25' R 97+90

Nail in 15" Oak L 18+75

Sp. in T.P. L 27+85

Sp. in T.P. L 39+50

Sp. in T.P. L 47+00

Spin Spiling first bent on E. side R.R. Br.

Sp. in T.P. L 56+15

Sp. in 14" Oak R 63+10

Sp. in 12" Oak L 80+00

Sp. in 1

Sp. in 10" Oak L 85+75

		231.65		2
	2.66	228.61	5.70	225.95
B.M.			4.42	224.19

Note: - Differs by 1.04' from levels as carried on  $\pm$ . (22315)

Check levels from B.M. Sp. in T.P. Cleve. + N.B. Rd to B.M. Sp. in 10" Oak L 85+75.


B.M.	4.42	228.61		224.19
	5.94	231.89	2.66	225.95
	6.62	234.63	3.88	228.01
	1.25	224.37	11.51	223.12
	2.22	215.25	11.34	213.03
	4.76	212.90	7.11	228.14
			8.32	284.58

Note.  $\therefore$  1.0' Error in  $\pm$  levels between these benches.

Sp in T.P. S.E. Cor. Int N.B. Rd + Cleve Ave  
St

Sp in T.P. Cleve. Ave + N.B. Rd - End of Line.

Sp in 10" Oak L 85+75

 

New Brighton Road. R.J.W.  
✓ Field Inspection

5-19-23

✓ 10+25 P. 24" P3

Put out all drain tile

✓ 10+00 — 12+00  
Gr. 3 stamps

✓ 12+61 End R & L  
P. 12" x 25" L

✓ No culv. region R.

✓ 18+88 End R & L

✓ No culv. region L.  
P. 12" x 25" R.

✓ Start G.R. L 20+70

End " L 23+30

✓ Start G.R. R 21+50

End " R 23+30

22+00 P. 24" P3

✓ 26+89 End L  
P. 12" x 25"

40+68 Ent L  
P. 12" x 24"

42+43 Ent L

↑ P. 12" x 24 C.M.  
Haul from 47+31

47+31

Road Int. L

12" x 24" C.M. imp removed

↓ P. 18" x 30  
removed at 42+43

52+20 P. 24" P.3

↓ Inv. Elev. 3.5' below  
± elevation

55+00 P. 24" P.3

↓ Inv Elev 3' below ± elev

56+10 P. 24" P.3

62+60 Ent L

↓ No culv. req

63+25 Ent R

↓ No culv. req

9.

81 + 25 Cont R

12" x 38' C. X 7. Cond, OK.

84400

in p - 24" x 100' C.M  
Cond OK,

P.G.R. L: 80 + 50 - 85 + 75

P.G.R. R: 81 + 50 - 85 + 75

107+97

all property line on E  
side of road

105704 P. 18" x 40' ?

477/5.1 = 91 - 15

Final Xsections

23-63

Carley - Level

Briggs - Tape

Eck - Rod.

10/29/23

clay - cold sta 0 to sta 39

G.R. - L - 48+44 - 297'

Sta + H.I. - E/lev

B.M. 6.01 237.97 ✓ 231.96

0 5.0 33.0 32.4

+25

+50 4.8 33.2 32.55

1 4.6 33.4 32.7

+50 4.4 33.6 32.85

2 4.3 33.7 33.0

+50 4.2 33.8 33.15

3 4.0 34.0 33.3

+50 3.9 34.1 33.45

4 3.7 34.3 33.6

T.P. 5.30 239.50 ✓ 3.77 234.20 ✓

+50 5.1 34.4 33.75

5 4.9 34.6 33.9

Final Xsections Party  
23-63

Carley  
B-1795  
E-K

10-29-23  
Cloudy & cold,  
(2)

LT      E      RT

Nail in 12" oak S.W. Cor. of Xroads

4.3	7.6	6.7	5.2	5.2	5.6	5.1	4.5	
26	22	19	15	10	10	10	33	Driveway

18" C.M. pipe X drain      Invert 230.1      Outlet 229.8

3.7	6.8	6.4	5.1	4.7	5.4	4.9	4.8	6.5	6.7	4.9	4.7
26	23	20	15	10	10	10	15	21	25	28	31

3.3	5.8	6.4	5.8	4.7	4.7	5.3	4.7	4.8	6.8	7.2	3.7
26	24	23	20	15	10	10	10	15	22	24	30

3.2	6.3	6.0	4.4	4.5	5.1	4.5	4.6	6.7	6.1	4.4
27	24	21	15	10	10	10	16	24	27	28

3.3	6.3	6.1	4.2	4.4	5.0	4.4	4.7	6.4	6.5	4.0
28	24	21	15	10	10	10	17	21	20	29

4.7	7.0	6.6	4.1	4.3	4.8	4.3	4.5	6.5	7.0	5.1
27	24	21	15	10	10	10	15	20	23	27

5.5	7.1	6.6	4.0	4.1	4.7	4.1	4.4	6.6	6.8	5.5
27	24	21	15	10	10	10	15	21	22	24

6.3	6.9	6.4	4.1	4.0	4.5	4.0	4.0	5.7	6.1
28	25	21	15	10	10	10	15	19	28

5.2	7.1	6.9	3.6	3.8	4.4	3.8	4.0	5.7	6.1
29	26	22	15	10	10	10	15	19	24

7.5	6.6	8.3	8.0	5.1	5.2	5.8	5.1	5.1	7.3	7.3	6.9
28	31	28	22	15	10	10	10	15	21	22	24

6.0	8.3	7.7	5.0	5.0	5.6	4.9	4.9	7.3	7.4
31	27	22	15	10	10	10	15	22	25

Sta	+	H.I	-	Elev
	5.30	239.50		
5+50			4.7	34.8 34.05
6			4.5	35.0 34.20
+50			4.4	35.1 34.35
7			4.3	35.2 34.50
8			4.3	35.2 34.5
+50			4.5	35.0 34.3
9			4.8	34.7 34.0
+50			5.2	34.3 33.6
B.M.	4.65	236.00 ✓	8.16	33.135 ✓
10			5.6	33.9 33.2
+50			2.4	33.6 32.8
11			2.8	33.2 32.4
+50			3.2	36.8 32.0
12			3.7	32.3 31.6

5.3    7.9    7.3    4.7    4.8    5.3    4.8    5.1    6.7    6.7    5.0  
 $\frac{31}{31}$      $\frac{26}{26}$      $\frac{22}{22}$      $\frac{15}{15}$      $\frac{10}{10}$      $\frac{10}{10}$      $\frac{10}{10}$      $\frac{15}{15}$      $\frac{20}{20}$      $\frac{23}{23}$      $\frac{26}{26}$

4.0    6.8    6.4    4.4    4.6    5.3    4.6    4.9    7.1    7.4    5.1  
 $\frac{30}{30}$      $\frac{27}{27}$      $\frac{21}{21}$      $\frac{15}{15}$      $\frac{10}{10}$      $\frac{10}{10}$      $\frac{10}{10}$      $\frac{15}{15}$      $\frac{20}{20}$      $\frac{23}{23}$      $\frac{26}{26}$

3.4    6.6    6.4    4.6    4.6    5.2    4.5    4.6    6.9    7.0    4.6  
 $\frac{30}{30}$      $\frac{26}{26}$      $\frac{20}{20}$      $\frac{15}{15}$      $\frac{10}{10}$      $\frac{10}{10}$      $\frac{15}{15}$      $\frac{20}{20}$      $\frac{20}{20}$      $\frac{23}{23}$      $\frac{26}{26}$

4.3    6.3    6.8    4.2    4.4    5.0    4.4    4.5    7.1    5.1  
 $\frac{30}{30}$      $\frac{28}{28}$      $\frac{25}{25}$      $\frac{15}{15}$      $\frac{10}{10}$      $\frac{10}{10}$      $\frac{16}{16}$      $\frac{23}{23}$      $\frac{27}{27}$

4.7    7.2    4.4    4.4    4.4    5.0    4.4    4.4    6.4    6.4    4.9  
 $\frac{31}{31}$      $\frac{26}{26}$      $\frac{15}{15}$      $\frac{16}{16}$      $\frac{10}{10}$      $\frac{10}{10}$      $\frac{16}{16}$      $\frac{22}{22}$      $\frac{25}{25}$      $\frac{27}{27}$

4.9    6.6    4.4    4.6    4.6    5.2    4.6    4.6    7.1    5.5  
 $\frac{29}{29}$      $\frac{25}{25}$      $\frac{15}{15}$      $\frac{10}{10}$      $\frac{10}{10}$      $\frac{10}{10}$      $\frac{16}{16}$      $\frac{25}{25}$      $\frac{27}{27}$

5.0    7.4    4.9    4.9    4.9    5.3    4.9    5.1    7.3    7.4  
 $\frac{30}{30}$      $\frac{25}{25}$      $\frac{16}{16}$      $\frac{10}{10}$      $\frac{10}{10}$      $\frac{10}{10}$      $\frac{17}{17}$      $\frac{23}{23}$      $\frac{27}{27}$

6.1    7.9    7.5    5.4    5.3    5.9    5.3    5.5    8.5    8.3  
 $\frac{30}{30}$      $\frac{25}{25}$      $\frac{21}{21}$      $\frac{15}{15}$      $\frac{10}{10}$      $\frac{10}{10}$      $\frac{16}{16}$      $\frac{23}{23}$      $\frac{26}{26}$

Nail in 14" oak 25' Lt 5 to 9 + 90  
 5.8    8.4    7.9    5.8    5.7    6.3    5.7    5.9    9.0    9.1    8.3  
 $\frac{29}{29}$      $\frac{25}{25}$      $\frac{20}{20}$      $\frac{15}{15}$      $\frac{10}{10}$      $\frac{10}{10}$      $\frac{16}{16}$      $\frac{23}{23}$      $\frac{25}{25}$      $\frac{26}{26}$

2.1    4.9    4.6    2.8    2.5    5.2    2.5    2.6    5.3    5.4    3.4  
 $\frac{30}{30}$      $\frac{25}{25}$      $\frac{19}{19}$      $\frac{15}{15}$      $\frac{10}{10}$      $\frac{10}{10}$      $\frac{16}{16}$      $\frac{15}{15}$      $\frac{22}{22}$      $\frac{25}{25}$      $\frac{27}{27}$

1.6    5.2    4.7    2.8    2.9    3.6    2.9    3.2    5.9    5.5    4.1  
 $\frac{30}{30}$      $\frac{25}{25}$      $\frac{20}{20}$      $\frac{15}{15}$      $\frac{10}{10}$      $\frac{10}{10}$      $\frac{10}{10}$      $\frac{16}{16}$      $\frac{22}{22}$      $\frac{25}{25}$      $\frac{27}{27}$

1.5    5.1    4.7    3.1    3.3    4.0    3.4    3.5    6.0    6.4    4.5  
 $\frac{30}{30}$      $\frac{25}{25}$      $\frac{20}{20}$      $\frac{15}{15}$      $\frac{10}{10}$      $\frac{10}{10}$      $\frac{10}{10}$      $\frac{16}{16}$      $\frac{21}{21}$      $\frac{24}{24}$      $\frac{26}{26}$

2.1    5.7    5.0    3.6    3.8    4.4    3.8    4.1    6.4    7.2    5.9  
 $\frac{32}{32}$      $\frac{25}{25}$      $\frac{19}{19}$      $\frac{15}{15}$      $\frac{10}{10}$      $\frac{10}{10}$      $\frac{10}{10}$      $\frac{15}{15}$      $\frac{19}{19}$      $\frac{24}{24}$      $\frac{26}{26}$

Sta	+ H.I.	-	Elev	
	465	236.60		
12 +50			4.1	31.9 31.2
13			4.3	31.7 31.0
+50			4.5	31.5 30.8
+60			4.6	31.4 30.8
+71			4.6	31.4 30.7
14			4.6	31.4 30.7
+50			4.6	31.4 30.7
15			4.7	31.3 30.6
+50			4.7	31.3 30.6
16			4.8	31.2 30.5
+50			5.0	31.0 30.4
17			5.0	31.0 30.3
+50			5.1	30.9 30.2

$$\frac{3.2}{31} \quad \frac{6.5}{25} \quad \frac{6.0}{19} \quad \frac{4.1}{15} \quad \frac{4.2}{16} \quad \textcircled{4.8} \quad \frac{4.2}{10} \quad \frac{4.3}{15} \quad \frac{8.2}{23} \quad \frac{8.4}{25} \quad \frac{7.2}{25}$$

$$\frac{5.0}{31} \quad \frac{7.0}{25} \quad \frac{6.4}{19} \quad \frac{4.5}{16} \quad \frac{4.3}{10} \quad \textcircled{5.0} \quad \frac{4.4}{10} \quad \frac{4.7}{14} \quad \frac{8.8}{23} \quad \frac{9.2}{26}$$

$$\frac{5.9}{30} \quad \frac{6.7}{25} \quad \frac{6.7}{21} \quad \frac{4.8}{16} \quad \frac{4.7}{10} \quad \textcircled{5.2} \quad \frac{4.6}{10} \quad \frac{4.7}{15} \quad \frac{7.6}{21} \quad \frac{8.0}{25}$$

$$\frac{5.8}{32} \quad \frac{4.9}{17} \quad \frac{4.7}{10} \quad \textcircled{5.2} \quad \frac{4.6}{10} \quad \frac{4.9}{15} \quad \frac{7.9}{31}$$

$$\frac{5.5}{32} \quad \frac{6.1}{30} \quad \frac{4.8}{16} \quad \frac{4.7}{10} \quad \textcircled{5.3} \quad \frac{4.7}{10} \quad \frac{7.8}{14} \quad \frac{7.4}{32}$$

$$\frac{5.3}{33} \quad \frac{7.6}{27} \quad \frac{7.2}{22} \quad \frac{4.9}{15} \quad \frac{4.7}{10} \quad \textcircled{5.3} \quad \frac{4.7}{10} \quad \frac{4.8}{14} \quad \frac{8.1}{21} \quad \frac{8.2}{25} \quad \frac{6.9}{29}$$

$$\frac{5.0}{30} \quad \frac{7.0}{25} \quad \frac{7.0}{22} \quad \frac{4.6}{15} \quad \frac{4.7}{10} \quad \textcircled{5.3} \quad \frac{4.7}{10} \quad \frac{4.6}{14} \quad \frac{7.9}{23} \quad \frac{7.7}{26} \quad \frac{5.8}{30}$$

$$\frac{4.2}{33} \quad \frac{7.6}{26} \quad \frac{7.6}{22} \quad \frac{4.9}{15} \quad \frac{4.8}{10} \quad \textcircled{5.4} \quad \frac{4.8}{10} \quad \frac{4.6}{16} \quad \frac{7.7}{24} \quad \frac{7.6}{27} \quad \frac{5.5}{31}$$

$$\frac{4.7}{33} \quad \frac{7.4}{27} \quad \frac{7.2}{23} \quad \frac{4.9}{15} \quad \frac{4.9}{10} \quad \textcircled{5.4} \quad \frac{4.8}{10} \quad \frac{5.0}{16} \quad \frac{8.2}{25} \quad \frac{8.2}{28} \quad \frac{6.6}{30}$$

$$\frac{6.8}{32} \quad \frac{7.6}{29} \quad \frac{7.7}{23} \quad \frac{5.0}{15} \quad \frac{4.9}{16} \quad \textcircled{5.5} \quad \frac{4.9}{10} \quad \frac{5.1}{15} \quad \frac{8.4}{25} \quad \frac{8.4}{27} \quad \frac{6.9}{29}$$

$$\frac{8.8}{30} \quad \frac{8.4}{23} \quad \frac{5.2}{15} \quad \frac{5.1}{10} \quad \textcircled{5.6} \quad \frac{5.1}{10} \quad \frac{5.4}{15} \quad \frac{7.9}{24} \quad \frac{8.4}{28} \quad \frac{6.4}{30}$$

$$\frac{7.0}{32} \quad \frac{8.1}{27} \quad \frac{7.8}{22} \quad \frac{5.3}{15} \quad \frac{5.1}{10} \quad \textcircled{5.7} \quad \frac{5.1}{10} \quad \frac{5.2}{14} \quad \frac{8.6}{25} \quad \frac{8.7}{28} \quad \frac{5.3}{32}$$

$$\frac{6.5}{32} \quad \frac{8.3}{29} \quad \frac{8.3}{23} \quad \frac{5.1}{16} \quad \frac{5.2}{10} \quad \textcircled{5.8} \quad \frac{5.2}{10} \quad \frac{5.3}{16} \quad \frac{8.5}{25} \quad \frac{8.4}{29} \quad \frac{5.0}{33}$$

	5to	+ H.I.	-	Elev	
		4.65	236.00		
18			5.2	30.8	30.1
	+50		5.3	30.7	29.9
	B.M.				
19			5.4	30.6	29.8
	T.P.	4.04	234.50 ✓	5.54	230.46 ✓
	+50		4.1	30.4	29.7
20			4.2	30.3	29.5
	+50		4.4	30.1	29.4
	+88		4.5	30.0	29.3
21			4.5	30.0	29.2
	+50		4.6	29.9	29.1
22			4.6	29.9	29.1
	+00				
	+50		4.4	30.1	29.3
23			4.2	30.3	29.5
	+50		3.9	30.6	29.8
24			3.6	30.9	30.1
	T.P.	4.68	236.08 ✓	3.10	231.40 ✓

5.9

8.2	8.0	5.4	5.2	5.2	5.4	9.1	9.2	5.7
28	22	10	10	10	15	26	29	33

6.1

8.5	8.2	5.6	5.4	5.4	5.3	9.3	9.1	6.8
26	21	15	10	10	15	26	29	32

Spike in 20" oak LT 5 to 15 + 75 (Removed)

6.2

8.7	9.2	8.6	5.6	5.5	5.5	8.2	8.0
30	28	21	15	10	10	25	28

4.8

5.2	7.9	7.7	4.3	4.2	4.2	7.2	7.4	6.4
32	30	22	15	10	10	17	23	29

5.0

4.3	8.4	8.5	4.3	4.3	4.3	7.1	7.5	2.6
32	29	24	15	10	10	17	24	34

5.1

4.4	9.0	8.7	4.4	4.5	4.5	7.4	7.1	(275.1)
34	32	24	15	10	10	29	29	41

5.2

10.4	10.8	8.8	4.8	4.6	4.6	7.7	7.8	0.4
37	35	26	16	10	10	24	27	39

5.3

	11.9	4.8	4.6	4.6	4.7	7.6	7.6	1.4
	31	16	10	10	16	24	27	37

5.4

(213.0)	(214.9)	4.7	4.7	4.7	4.8	8.6	7.3
47	40	17	10	10	16	27	31

5.4

(211.0)	(212.3)	4.8	4.7	4.7	4.7	9.9	10.3	9.5
49	43	15	10	10	15	29	34	38

24" conc. culvert

Outlet Inlet

(217.1)	4.8	4.5	4.5	4.7	9.7	9.6
34	15	10	10	15	28	34

LT 212.5 RT 223.8

5.0

8.7	9.1	5.5	4.7	4.3	4.3	8.0	8.8	7.9
28	27	21	15	10	10	23	29	32

4.7

3.1	7.2	7.1	4.0	4.0	4.0	7.3	7.9	7.1
28	26	21	15	10	10	23	28	30

4.4

1.5	6.8	6.4	3.9	3.7	3.7	6.7	7.3	5.6	5.3
2.9	24	20	15	10	10	16	22	31	35

Sta	+	H.I.	-	Elev	
		236.08			
24+20			5.1	31.0	30.2
24+50			5.0	31.1	30.3

25			4.7	31.4	30.6
+50			4.6	31.5	30.7

26			4.6	31.5	30.8
----	--	--	-----	------	------

} Note:  
 Equation  $26+63.2 = 26+65.4 = 30.8$   
 $26+00$  to  $27+00 = 50$  at sta  $97.86'$

27			4.7	31.4	30.9
B.M.	6.13	236.53	5.62	230.46	230.40

27+50			5.0	31.5	30.95
-------	--	--	-----	------	-------

28			5.0	31.5	31.0
+50			4.9	31.6	31.05

29			4.7	31.8	31.1
----	--	--	-----	------	------

+50			4.7	31.8	31.15
-----	--	--	-----	------	-------

30			4.6	31.9	31.2
----	--	--	-----	------	------

+50			4.6	31.9	31.25
-----	--	--	-----	------	-------

$$\frac{3.1}{29} \quad \frac{8.1}{24} \quad \frac{7.8}{19} \quad \frac{5.5}{15} \quad \frac{5.2}{16} \quad \frac{5.9}{10} \quad \frac{5.5}{15} \quad \frac{8.6}{24} \quad \frac{8.9}{27} \quad \frac{6.7}{31} \quad \frac{2.9}{36} \quad \checkmark$$

$$\frac{3.7}{27} \quad \frac{7.9}{24} \quad \frac{7.4}{19} \quad \frac{5.1}{15} \quad \frac{5.1}{10} \quad \frac{5.8}{10} \quad \frac{5.1}{14} \quad \frac{8.2}{23} \quad \frac{8.2}{27} \quad \frac{1.5}{35}$$

$$\frac{2.8}{28} \quad \frac{7.7}{24} \quad \frac{7.3}{20} \quad \frac{5.1}{15} \quad \frac{4.9}{10} \quad \frac{5.5}{10} \quad \frac{4.8}{16} \quad \frac{7.2}{21} \quad \frac{7.3}{24} \quad \frac{1.2}{29}$$

$$\frac{2.8}{28} \quad \frac{7.5}{24} \quad \frac{7.0}{22} \quad \frac{4.7}{16} \quad \frac{4.7}{10} \quad \frac{5.4}{10} \quad \frac{4.8}{15} \quad \frac{7.2}{20} \quad \frac{7.5}{23} \quad \frac{1.7}{28}$$

$$\frac{3.2}{29} \quad \frac{7.7}{26} \quad \frac{7.2}{21} \quad \frac{4.4}{15} \quad \frac{4.4}{10} \quad \frac{5.3}{10} \quad \frac{4.7}{9} \quad \frac{4.5}{17} \quad \frac{4.8}{14} \quad \frac{7.3}{26} \quad \frac{7.7}{24} \quad \frac{3.3}{28}$$

$$\frac{4.5}{30} \quad \frac{7.9}{27} \quad \frac{7.4}{24} \quad \frac{4.0}{14} \quad \frac{4.1}{10} \quad \frac{5.3}{10} \quad \frac{5.0}{14} \quad \frac{4.7}{16} \quad \frac{4.7}{23} \quad \frac{7.6}{26} \quad \frac{7.8}{26} \quad \frac{4.6}{29}$$

$$\frac{5.3}{32} \quad \frac{7.7}{30} \quad \frac{7.6}{27} \quad \frac{3.7}{18} \quad \frac{4.0}{16} \quad \frac{5.2}{16} \quad \frac{5.0}{14} \quad \frac{4.9}{19} \quad \frac{7.3}{25} \quad \frac{7.7}{28} \quad \frac{7.1}{30}$$

Spike in elec. pole pt of str 27 + 50

$$\frac{6.7}{36} \quad \frac{8.2}{34} \quad \frac{8.0}{30} \quad \frac{4.5}{21} \quad \frac{4.9}{10} \quad \frac{5.9}{12} \quad \frac{5.5}{13} \quad \frac{5.7}{23} \quad \frac{8.2}{27} \quad \frac{8.5}{32} \quad \frac{7.5}{34}$$

$$\frac{6.5}{27} \quad \frac{8.0}{27} \quad \frac{4.1}{16} \quad \frac{4.4}{10} \quad \frac{5.5}{12} \quad \frac{5.4}{13} \quad \frac{5.4}{20} \quad \frac{7.9}{26} \quad \frac{8.5}{30} \quad \frac{7.0}{32}$$

$$\frac{6.4}{27} \quad \frac{7.6}{26} \quad \frac{7.1}{22} \quad \frac{4.3}{16} \quad \frac{4.5}{10} \quad \frac{5.4}{10} \quad \frac{5.1}{11} \quad \frac{5.1}{17} \quad \frac{7.9}{26} \quad \frac{5.4}{29}$$

$$\frac{5.4}{27} \quad \frac{7.0}{25} \quad \frac{6.7}{22} \quad \frac{4.4}{16} \quad \frac{4.6}{10} \quad \frac{5.4}{9} \quad \frac{5.0}{10} \quad \frac{4.8}{17} \quad \frac{5.7}{23} \quad \frac{7.0}{27} \quad \frac{7.8}{27} \quad \frac{5.3}{29}$$

$$\frac{5.7}{27} \quad \frac{6.9}{23} \quad \frac{4.6}{17} \quad \frac{4.7}{10} \quad \frac{5.3}{10} \quad \frac{4.9}{10} \quad \frac{4.9}{17} \quad \frac{7.0}{22} \quad \frac{7.5}{27} \quad \frac{5.4}{29}$$

$$\frac{5.8}{28} \quad \frac{7.5}{26} \quad \frac{7.0}{23} \quad \frac{4.6}{17} \quad \frac{4.8}{10} \quad \frac{5.3}{10} \quad \frac{4.7}{16} \quad \frac{4.5}{17} \quad \frac{7.3}{23} \quad \frac{7.8}{27} \quad \frac{5.1}{29}$$

$$\frac{5.1}{28} \quad \frac{7.6}{26} \quad \frac{7.4}{23} \quad \frac{4.8}{16} \quad \frac{4.7}{10} \quad \frac{5.2}{10} \quad \frac{4.7}{15} \quad \frac{4.8}{23} \quad \frac{7.3}{26} \quad \frac{8.1}{26} \quad \frac{5.5}{29}$$

Sta	+	H.I.	-	Elev	
	6.13	236.53			
31			4.5	32.0	31.3
	+50		4.5	32.0	31.3
32			4.5	32.0	31.4
	+50		4.5	32.0	31.4
33			4.5	32.0	31.4
	+50		4.5	32.0	31.4
34			4.5	32.0	31.4
	TP	4.90	236.93	4.50	232.03
	+50		4.8	32.1	31.4
35			4.9	32.0	31.4
	+50		4.9	32.0	31.4
36			4.8	32.1	31.4
	+50		4.8	32.1	31.4
37			4.8	32.1	31.4

$$\frac{5.4}{29} \quad \frac{7.4}{26} \quad \frac{7.1}{23} \quad \frac{4.7}{15} \quad \frac{4.6}{10} \quad \textcircled{5.2} \quad \frac{4.6}{10} \quad \frac{5.0}{15} \quad \frac{7.5}{23} \quad \frac{8.1}{26} \quad \frac{5.6}{28}$$

$$\frac{6.0}{29} \quad \frac{8.1}{26} \quad \frac{7.7}{23} \quad \frac{4.7}{15} \quad \frac{4.6}{10} \quad \textcircled{5.2} \quad \frac{4.6}{10} \quad \frac{4.9}{15} \quad \frac{7.5}{22} \quad \frac{8.3}{26} \quad \frac{6.5}{28}$$

$$\frac{6.1}{30} \quad \frac{8.2}{26} \quad \frac{7.9}{23} \quad \frac{4.5}{16} \quad \frac{4.6}{10} \quad \textcircled{5.1} \quad \frac{4.6}{10} \quad \frac{4.7}{16} \quad \frac{7.5}{23} \quad \frac{8.4}{27} \quad \frac{6.4}{29}$$

$$\frac{6.2}{29} \quad \frac{8.7}{26} \quad \frac{8.0}{23} \quad \frac{4.7}{15} \quad \frac{4.6}{10} \quad \textcircled{5.1} \quad \frac{4.6}{10} \quad \frac{4.8}{16} \quad \frac{7.9}{23} \quad \frac{8.6}{27} \quad \frac{6.9}{29}$$

$$\frac{5.8}{27} \quad \frac{8.3}{24} \quad \frac{8.0}{22} \quad \frac{4.6}{15} \quad \frac{4.6}{10} \quad \textcircled{5.1} \quad \frac{4.5}{10} \quad \frac{4.8}{15} \quad \frac{7.7}{23} \quad \frac{8.6}{28} \quad \frac{6.9}{30}$$

$$\frac{6.1}{28} \quad \frac{8.2}{25} \quad \frac{7.7}{21} \quad \frac{4.8}{15} \quad \frac{4.6}{10} \quad \textcircled{5.1} \quad \frac{4.6}{10} \quad \frac{4.8}{15} \quad \frac{7.4}{22} \quad \frac{8.4}{27} \quad \frac{6.3}{30}$$

$$\frac{5.4}{29} \quad \frac{8.1}{25} \quad \frac{7.6}{22} \quad \frac{4.5}{15} \quad \frac{4.6}{10} \quad \textcircled{5.1} \quad \frac{4.6}{10} \quad \frac{4.8}{15} \quad \frac{7.1}{22} \quad \frac{7.9}{28} \quad \frac{6.6}{30}$$

$$\frac{6.1}{29} \quad \frac{8.2}{25} \quad \frac{7.8}{21} \quad \frac{4.9}{15} \quad \frac{4.9}{10} \quad \textcircled{5.5} \quad \frac{4.9}{10} \quad \frac{7.9}{15} \quad \frac{7.4}{22} \quad \frac{8.3}{27} \quad \frac{6.7}{30}$$

$$\frac{6.2}{28} \quad \frac{8.4}{25} \quad \frac{8.1}{22} \quad \frac{5.0}{16} \quad \frac{5.0}{10} \quad \textcircled{5.5} \quad \frac{4.9}{10} \quad \frac{4.9}{16} \quad \frac{7.2}{23} \quad \frac{7.7}{26} \quad \frac{5.9}{28}$$

$$\frac{6.3}{27} \quad \frac{7.7}{25} \quad \frac{7.1}{21} \quad \frac{5.1}{16} \quad \frac{5.0}{10} \quad \textcircled{5.5} \quad \frac{5.0}{10} \quad \frac{4.8}{16} \quad \frac{6.9}{23} \quad \frac{7.4}{27} \quad \frac{5.4}{29}$$

$$\frac{5.6}{28} \quad \frac{7.7}{25} \quad \frac{7.2}{22} \quad \frac{5.0}{16} \quad \frac{4.9}{10} \quad \textcircled{5.5} \quad \frac{4.9}{10} \quad \frac{5.0}{16} \quad \frac{7.0}{22} \quad \frac{7.5}{26} \quad \frac{4.7}{28}$$

$$\frac{5.7}{29} \quad \frac{7.7}{25} \quad \frac{7.2}{21} \quad \frac{5.1}{15} \quad \frac{4.9}{10} \quad \textcircled{5.5} \quad \frac{4.9}{10} \quad \frac{5.1}{17} \quad \frac{6.8}{22} \quad \frac{7.1}{25} \quad \frac{4.7}{28}$$

$$\frac{6.0}{29} \quad \frac{8.2}{25} \quad \frac{7.7}{21} \quad \frac{5.0}{15} \quad \frac{4.9}{10} \quad \textcircled{5.5} \quad \frac{4.9}{10} \quad \frac{5.1}{16} \quad \frac{7.0}{22} \quad \frac{7.0}{26} \quad \frac{5.3}{27}$$

Sta	+	H.I.	-	Elev
37+50	4.90	236.93		
37+50			4.9	32.0 31.4
38			4.9	32.0 31.4
+50			4.8	32.1 31.4
39			4.9	32.0 31.4
B.M.			6.21	230.72 ✓ 230.72 ✓
B.M.	4140	235.12 ✓		230.72 ✓
39+50			3.0	32.1 31.4
40			3.1	32.0 31.3
+50			3.4	31.7 31.0
+62			3.5	31.6 30.9
+77			3.6	31.5 30.8
41			3.9	31.2 30.5

4.  
 $\frac{6.6}{30}$   $\frac{8.2}{26}$   $\frac{7.8}{22}$   $\frac{5.1}{14}$   $\frac{5.0}{10}$   $\frac{5.5}{10}$   $\frac{4.9}{10}$   $\frac{5.0}{15}$   $\frac{6.9}{20}$   $\frac{7.4}{24}$   $\frac{5.6}{26}$

$\frac{7.8}{27}$   $\frac{8.3}{25}$   $\frac{8.0}{22}$   $\frac{5.3}{15}$   $\frac{5.0}{10}$   $\frac{5.5}{10}$   $\frac{4.9}{10}$   $\frac{5.3}{15}$   $\frac{7.0}{19}$   $\frac{8.0}{23}$   $\frac{6.4}{25}$

$\frac{9.2}{28}$   $\frac{8.9}{24}$   $\frac{5.1}{16}$   $\frac{4.9}{10}$   $\frac{5.5}{10}$   $\frac{4.9}{10}$   $\frac{5.3}{15}$   $\frac{7.5}{20}$   $\frac{8.2}{23}$   $\frac{7.6}{24}$

$\frac{8.6}{28}$   $\frac{8.1}{22}$   $\frac{5.3}{16}$   $\frac{5.0}{10}$   $\frac{5.5}{10}$   $\frac{4.9}{10}$   $\frac{4.9}{14}$   $\frac{7.5}{19}$   $\frac{8.2}{23}$   $\frac{7.1}{25}$

Spike in tele pole 4 + sta 39 + 40 } moved since original  
 X sections were taken  
 used for setting  
 grade stakes.

Started here - 10-30-23  
 Fair - Hot.

$\frac{5.8}{28}$   $\frac{6.4}{26}$   $\frac{5.8}{22}$   $\frac{3.6}{16}$   $\frac{3.2}{10}$   $\frac{3.7}{10}$   $\frac{3.2}{10}$   $\frac{3.2}{15}$   $\frac{5.8}{20}$   $\frac{6.3}{24}$   $\frac{4.6}{26}$

$\frac{3.3}{30}$   $\frac{6.4}{26}$   $\frac{5.7}{22}$   $\frac{3.5}{16}$   $\frac{3.2}{10}$   $\frac{3.8}{10}$   $\frac{3.2}{10}$   $\frac{3.6}{15}$   $\frac{5.5}{20}$   $\frac{5.9}{24}$   $\frac{2.9}{27}$

$\frac{2.5}{34}$   $\frac{5.0}{30}$   $\frac{7.1}{26}$   $\frac{6.4}{24}$   $\frac{3.8}{15}$   $\frac{3.5}{10}$   $\frac{4.1}{10}$   $\frac{3.4}{10}$   $\frac{3.5}{15}$   $\frac{5.7}{21}$   $\frac{5.7}{25}$   $\frac{1.9}{28}$

$\frac{2.3}{34}$   $\frac{5.1}{30}$   $\frac{7.1}{27}$   $\frac{6.4}{23}$   $\frac{3.7}{17}$   $\frac{3.4}{10}$   $\frac{4.2}{10}$   $\frac{3.6}{16}$   $\frac{3.4}{20}$   $\frac{5.4}{25}$   $\frac{5.3}{25}$   $\frac{3.5}{29}$   $\frac{3.3}{32}$  ✓

$\frac{1.7}{35}$   $\frac{5.5}{29}$   $\frac{6.9}{26}$   $\frac{6.4}{22}$   $\frac{4.0}{16}$   $\frac{3.7}{10}$   $\frac{4.3}{10}$   $\frac{3.7}{10}$   $\frac{3.8}{17}$   $\frac{5.6}{20}$   $\frac{4.5}{27}$   $\frac{4.0}{30}$   $\frac{3.7}{35}$  ✓

$\frac{1.2}{34}$   $\frac{6.9}{27}$   $\frac{6.6}{22}$   $\frac{3.9}{16}$   $\frac{4.0}{10}$   $\frac{4.6}{10}$   $\frac{4.3}{15}$   $\frac{5.7}{19}$   $\frac{5.7}{25}$   $\frac{0.8}{29}$

Sta	+	H.I	-	Elev	
	4.40	235.12			
41+50			4.6	30.5	29.9
42			5.4	29.7	29.0
+50			6.5	28.6	28.0
43			7.7	27.4	26.7
T.P.	1.00	228.28	7.84	227.28	227.28
+50			2.3	26.0	25.3
44			3.9	24.4	23.7
+50			5.7	22.6	21.9
45			7.6	20.7	20.0
T.P.	2.51	219.79	11.00	217.28	
+50			1.0	18.8	18.1
B.M.			1.76	218.03	
46			2.9	16.9	16.2
+50			4.8	15.0	14.3
47			6.7	13.1	12.3

0.6 3.2 7.7 7.2 4.8 4.7 5.2 4.6 4.9 6.6 6.6 3.4 1.1  
 34 32 26 21 16 10 10 15 19 23 29 31

0.6 8.5 3.3 5.6 5.5 6.1 5.5 5.7 7.5 7.6 3.8 1.8  
 35 26 22 16 10 10 14 19 24 28 30

2.2 9.6 9.3 6.5 6.6 7.1 6.6 6.4 6.3 4.3  
 35 26 23 16 10 10 17 26 27

5.2 11.8 10.6 7.5 7.8 8.4 7.8 8.0 10.9 11.1 8.2 6.0  
 35 27 23 16 10 10 15 20 24 27 29

Spike in tele pole RT sta 73+35 used for Grade stakes  
 (229.4) 5.2 5.0 2.4 2.4 3.0 2.4 2.4 5.3 2.5 0.8  
 35 27 22 16 10 10 15 20 28 30

0.2 7.2 6.7 4.0 4.0 4.6 4.0 4.1 7.4 7.4 4.7 2.2  
 35 26 21 16 10 10 15 22 26 30 32

4.0 9.1 8.8 6.3 5.8 6.4 5.8 6.0 9.0 9.3 7.3 5.8  
 33 26 21 15 10 10 16 21 27 30 32

8.1 11.0 10.4 8.0 7.7 8.3 7.7 8.0 11.5 11.4 9.6  
 29 26 21 15 10 10 16 21 24 27

1.7 4.0 3.5 1.4 1.1 1.7 1.1 1.2 3.8 4.0 3.4 4.0  
 28 25 20 15 10 10 15 20 23 25 26


Spike in tele pole 29 RT sta 45+50 (45 and for T.P. in original 1882)  
 4.0 5.7 5.4 2.9 3.4 3.6 3.0 3.0 6.2 6.3 7.0  
 27 25 21 15 10 10 14 20 23 26

4.9 5.7 7.4 7.2 5.0 4.9 5.5 4.9 4.9 5.3 5.3 5.5  
 29 28 26 18 15 10 10 14 20 22 25

6.7 7.7 7.3 9.1 6.9 6.9 7.5 6.8 6.9 9.9 9.9 9.1 9.5  
 30 27 25 20 15 10 10 15 19 22 23 25

Sta	+	H.I.	-	Elev	
	2.51	219.79			
47	+20		7.5	12.3	11.5
	+40		8.3	11.6	10.8
	+50		8.7	11.1	10.3
	I.P.	1.24 210.83	10.20	209.59	
48			1.7	09.1	08.4
	+50		3.7	07.1	06.4
49			5.6	05.2	04.5
	+50		7.1	03.7	03.0
	I.P.	3.00 205.35	8.48	202.35	
50			3.00	202.4	01.7
	+50		4.0	201.4	200.7
51			4.7	00.7	199.9
	+50		5.1	00.3	99.5
52			5.4	00.0	99.2
	I.P.	5.25 203.72	6.88	198.71	
	B.M		4.31	199.41	199.35



 

Final Xsections

23-63

Carley  
Persons  
Briggs  
Eck

10-31-23

Sta.	+	H.I.	-	Elev	
B.M.	6.99	231.14			224.15 ✓
108+04			7.6	23.5	
107+97			7.5	23.6	22.9
+50			7.1	24.0	23.3
107			6.7	24.4	23.8
+50			6.1	25.0	24.3
106			5.6	25.5	24.8
+50			5.2	25.9	25.3
105			4.7	26.4	25.8
+50			4.2	26.9	26.3
104			3.8	27.3	26.7
+50			3.4	27.7	27.0
B.M.	6.10	234.26	2.95	228.19	228.16
103			6.2	28.1	27.4
+50			5.8	28.5	27.7

LtRtRt

112

Nail in to be pole Sit com Cleveland + 6<sup>th</sup> bstr

			8.4	8.1	7.7	9.5	8.0		
			19	14	25	31	37		
$\frac{8.0}{18}$	$\frac{8.3}{16}$	$\frac{7.8}{15}$	7.6	7.6	7.6	9.0	9.1	0.7	End of paving
			10	10	2.0	23	28	37	
$\frac{7.4}{18}$	$\frac{7.9}{17}$	$\frac{7.3}{15}$	7.3	7.3	7.2	8.5	8.4	2.6	
			10	10	15	18	20	27	

$\frac{7.0}{18}$	$\frac{7.4}{17}$	$\frac{6.8}{15}$	6.7	6.8	6.8	8.5	8.4	4.8
			10	10	16	18	21	27

$\frac{6.5}{19}$	$\frac{6.9}{18}$	$\frac{6.1}{14}$	6.2	6.3	6.3	7.8	7.6	7.0
			10	10	15	18	19	20

$\frac{5.9}{19}$	$\frac{6.6}{18}$	$\frac{6.5}{17}$	$\frac{5.6}{14}$	5.7	5.8	5.9	7.3	7.9
				10	10	15	18	21

$\frac{5.4}{18}$	$\frac{6.0}{17}$	$\frac{5.9}{16}$	$\frac{5.4}{14}$	5.5	5.3	5.4	7.2	7.1	6.6
				10	10	15	18	23	24

cut nuts out  
105 + 30

$\frac{4.0}{32}$	$\frac{4.6}{17}$	$\frac{4.8}{10}$	$\frac{4.8}{10}$	$\frac{4.8}{10}$	$\frac{4.8}{16}$	$\frac{6.4}{38}$	X-road Rt + Lt
------------------	------------------	------------------	------------------	------------------	------------------	------------------	----------------

$\frac{2.2}{26}$	$\frac{4.0}{23}$	$\frac{4.4}{22}$	$\frac{5.1}{20}$	$\frac{5.1}{17}$	$\frac{4.3}{15}$	$\frac{4.3}{10}$	$\frac{4.3}{15}$	$\frac{5.8}{18}$
------------------	------------------	------------------	------------------	------------------	------------------	------------------	------------------	------------------

$\frac{3.1}{25}$	$\frac{4.3}{23}$	$\frac{4.9}{21}$	$\frac{4.9}{17}$	$\frac{4.0}{15}$	3.9	3.9	4.0	6.7	7.3
					10	10	14	20	24

$\frac{4.0}{21}$	$\frac{4.7}{20}$	$\frac{4.6}{18}$	$\frac{3.7}{16}$	3.5	3.5	3.3	4.5	6.0	6.3
				10	10	17	23	29	34

Nail in oak tree RR - Lt sta 103 + 30

$\frac{6.8}{22}$	$\frac{7.8}{20}$	$\frac{7.8}{19}$	$\frac{6.4}{15}$	6.3	6.3	6.3	7.9	8.5
				10	10	15	18	27

$\frac{6.5}{21}$	$\frac{7.4}{20}$	$\frac{7.4}{18}$	$\frac{6.0}{15}$	6.0	5.9	5.9	7.4	8.0
				10	10	15	18	25

Sta + H.I. - Elev

6.10 234.26

102 5.6 28.7 28.0

+50 5.3 29.0 28.2

101 5.1 29.2 28.5

+50 4.8 29.5 28.7

100 4.6 29.7 29.0

Long Sta. 101.0'

+50  $99+01.3 = 99+00.3$  4.5 29.8 29.1

Equation  $99+002 = 99+013$  Sta  $99+100 = 99+0$

99 4.5 29.8 29.1

+50 4.6 29.7 28.9

T.P. 4.04 232.97 5.33 228.93

98 3.8 29.2 28.6

+50 4.3 28.7 28.1

97 4.9 28.1 27.5

+50 5.7 27.3 26.6

T.P. 7.00 228.74 11.23 221.74

96 2.4 26.3 25.7

(6.3)

$\frac{6.1}{22}$	$\frac{6.9}{20}$	$\frac{6.7}{18}$	$\frac{5.8}{16}$	$\frac{5.6}{10}$	$\frac{5.7}{10}$	$\frac{5.7}{15}$	$\frac{7.3}{18}$	$\frac{8.2}{22}$
------------------	------------------	------------------	------------------	------------------	------------------	------------------	------------------	------------------

(6.1)

$\frac{5.6}{26}$	$\frac{6.1}{22}$	$\frac{6.8}{21}$	$\frac{6.9}{18}$	$\frac{5.4}{15}$	$\frac{5.4}{10}$	$\frac{5.4}{10}$	$\frac{5.6}{15}$	$\frac{7.0}{18}$	$\frac{7.0}{21}$
------------------	------------------	------------------	------------------	------------------	------------------	------------------	------------------	------------------	------------------

(5.8)

$\frac{6.5}{28}$	$\frac{6.4}{23}$	$\frac{7.1}{22}$	$\frac{7.0}{19}$	$\frac{5.1}{15}$	$\frac{5.2}{10}$	$\frac{5.2}{16}$	$\frac{5.3}{15}$	$\frac{7.2}{19}$	$\frac{7.4}{22}$
------------------	------------------	------------------	------------------	------------------	------------------	------------------	------------------	------------------	------------------

(5.6)

$\frac{6.6}{30}$	$\frac{6.5}{24}$	$\frac{7.1}{23}$	$\frac{7.2}{20}$	$\frac{5.2}{16}$	$\frac{4.9}{10}$	$\frac{4.9}{10}$	$\frac{5.0}{15}$	$\frac{7.0}{19}$	$\frac{7.5}{25}$
------------------	------------------	------------------	------------------	------------------	------------------	------------------	------------------	------------------	------------------

(5.3)

$\frac{6.1}{36}$	$\frac{6.1}{25}$	$\frac{7.1}{23}$	$\frac{7.2}{20}$	$\frac{4.7}{15}$	$\frac{4.7}{10}$	$\frac{4.6}{10}$	$\frac{5.0}{15}$	$\frac{6.9}{19}$	$\frac{7.0}{21}$	$\frac{6.4}{24}$	$\frac{6.9}{27}$
------------------	------------------	------------------	------------------	------------------	------------------	------------------	------------------	------------------	------------------	------------------	------------------

(5.2)

$\frac{4.6}{32}$	$\frac{4.2}{28}$	$\frac{7.3}{24}$	$\frac{7.4}{22}$	$\frac{4.4}{15}$	$\frac{4.8}{10}$	$\frac{4.3}{10}$	$\frac{4.4}{15}$	$\frac{6.6}{20}$	$\frac{6.8}{25}$	$\frac{5.0}{27}$
------------------	------------------	------------------	------------------	------------------	------------------	------------------	------------------	------------------	------------------	------------------

(5.2)

$\frac{3.4}{36}$	$\frac{7.0}{32}$	$\frac{7.2}{26}$	$\frac{7.2}{23}$	$\frac{4.7}{18}$	$\frac{4.8}{11.9}$	$\frac{5.0}{11.1}$	$\frac{4.1}{10}$	$\frac{3.9}{15}$	$\frac{6.0}{19}$	$\frac{5.7}{24}$	$\frac{3.8}{26}$
------------------	------------------	------------------	------------------	------------------	--------------------	--------------------	------------------	------------------	------------------	------------------	------------------

(5.4)

$\frac{3.8}{35}$	$\frac{7.5}{28}$	$\frac{7.2}{24}$	$\frac{4.9}{19}$	$\frac{5.2}{13.5}$	$\frac{5.4}{12.8}$	$\frac{4.1}{10}$	$\frac{4.7}{18}$	$\frac{6.0}{21}$	$\frac{5.8}{27}$	$\frac{4.7}{30}$	$\frac{5.2}{36}$
------------------	------------------	------------------	------------------	--------------------	--------------------	------------------	------------------	------------------	------------------	------------------	------------------

(4.4)

$\frac{3.8}{34}$	$\frac{7.1}{29}$	$\frac{7.1}{26}$	$\frac{4.2}{20}$	$\frac{4.3}{14.1}$	$\frac{4.5}{13.3}$	$\frac{3.3}{10}$	$\frac{2.6}{16}$	$\frac{5.3}{22}$	$\frac{5.3}{26}$	$\frac{4.6}{28}$	$\frac{4.7}{33}$
------------------	------------------	------------------	------------------	--------------------	--------------------	------------------	------------------	------------------	------------------	------------------	------------------

(4.9)

$\frac{5.3}{32}$	$\frac{7.2}{28}$	$\frac{7.2}{25}$	$\frac{4.5}{20}$	$\frac{4.8}{13.5}$	$\frac{5.0}{12.6}$	$\frac{3.7}{10}$	$\frac{3.2}{16}$	$\frac{6.2}{22}$	$\frac{4.5}{29}$
------------------	------------------	------------------	------------------	--------------------	--------------------	------------------	------------------	------------------	------------------

(5.5)

$\frac{5.3}{30}$	$\frac{7.6}{26}$	$\frac{7.6}{24}$	$\frac{5.5}{19}$	$\frac{5.4}{13.5}$	$\frac{5.6}{12.7}$	$\frac{4.3}{10}$	$\frac{4.0}{15}$	$\frac{7.2}{20}$	$\frac{7.1}{25}$	$\frac{5.4}{28}$
------------------	------------------	------------------	------------------	--------------------	--------------------	------------------	------------------	------------------	------------------	------------------

(6.4)

$\frac{5.4}{27}$	$\frac{7.7}{23}$	$\frac{7.8}{20}$	$\frac{5.9}{16}$	$\frac{5.9}{11.2}$	$\frac{6.1}{10.3}$	$\frac{5.3}{10}$	$\frac{5.3}{15}$	$\frac{7.2}{19}$	$\frac{7.7}{25}$	$\frac{6.5}{27}$
------------------	------------------	------------------	------------------	--------------------	--------------------	------------------	------------------	------------------	------------------	------------------

(3.0)

$\frac{2.4}{26}$	$\frac{4.8}{22}$	$\frac{4.9}{19}$	$\frac{2.6}{15}$	$\frac{2.4}{10}$	$\frac{2.6}{8.9}$	$\frac{2.3}{10}$	$\frac{2.0}{16}$	$\frac{3.5}{20}$	$\frac{4.3}{26}$	$\frac{3.1}{29}$
------------------	------------------	------------------	------------------	------------------	-------------------	------------------	------------------	------------------	------------------	------------------

Sta	T	H.I.	-	Elev	
	7.00	228.74			
95+50			3.6	25.1	24.5
95			4.8	23.9	23.2
+50			6.2	22.5	21.8
94			7.6	21.1	20.4
+50			9.0	19.7	19.0
T.P.	3.14	221.22 ✓	10.66	218.08 ✓	
93			3.0	18.2	17.6
+50			4.3	16.9	16.2
92			5.7	15.5	14.8
+50			7.0	14.2	13.5
T.P.	5.47	214.83 ✓	11.86	209.36 ✓	
91			1.9	12.9	12.2
+75.7			2.5	12.3	11.7
+50			3.1	11.7	11.0
90			4.3	10.5	10.0

4.2

$\frac{3.1}{26}$	$\frac{5.2}{22}$	$\frac{5.4}{20}$	$\frac{3.7}{15}$	$\frac{3.7}{10}$	$\frac{3.6}{10}$	$\frac{3.5}{16}$	$\frac{4.6}{20}$	$\frac{5.1}{27}$	$\frac{3.0}{30}$
------------------	------------------	------------------	------------------	------------------	------------------	------------------	------------------	------------------	------------------

5.5

$\frac{3.9}{26}$	$\frac{6.4}{22}$	$\frac{6.5}{19}$	$\frac{4.7}{15}$	$\frac{4.9}{10}$	$\frac{4.9}{10}$	$\frac{4.8}{18}$	$\frac{6.5}{23}$	$\frac{6.2}{28}$	$\frac{3.6}{31}$
------------------	------------------	------------------	------------------	------------------	------------------	------------------	------------------	------------------	------------------

6.9

$\frac{5.5}{27}$	$\frac{7.8}{23}$	$\frac{7.7}{20}$	$\frac{6.1}{16}$	$\frac{6.2}{10}$	$\frac{6.3}{10}$	$\frac{6.1}{17}$	$\frac{7.2}{22}$	$\frac{7.7}{25}$	$\frac{6.6}{27}$	$\frac{6.0}{34}$
------------------	------------------	------------------	------------------	------------------	------------------	------------------	------------------	------------------	------------------	------------------

8.3

$\frac{7.5}{28}$	$\frac{9.7}{24}$	$\frac{9.5}{21}$	$\frac{7.6}{16}$	$\frac{7.7}{10}$	$\frac{7.7}{10}$	$\frac{7.7}{17}$	$\frac{9.3}{21}$	$\frac{9.1}{24}$	$\frac{6.0}{29}$
------------------	------------------	------------------	------------------	------------------	------------------	------------------	------------------	------------------	------------------

9.7

$\frac{9.5}{31}$	$\frac{9.3}{27}$	$\frac{11.4}{24}$	$\frac{11.3}{21}$	$\frac{8.8}{16}$	$\frac{7.1}{10}$	$\frac{9.1}{10}$	$\frac{9.0}{15}$	$\frac{10.8}{20}$	$\frac{10.9}{23}$	$\frac{8.2}{27}$
------------------	------------------	-------------------	-------------------	------------------	------------------	------------------	------------------	-------------------	-------------------	------------------

3.6

$\frac{3.6}{26}$	$\frac{5.2}{23}$	$\frac{5.1}{20}$	$\frac{2.9}{16}$	$\frac{3.1}{10}$	$\frac{3.1}{10}$	$\frac{3.2}{15}$	$\frac{5.2}{19}$	$\frac{5.4}{22}$	$\frac{2.6}{26}$
------------------	------------------	------------------	------------------	------------------	------------------	------------------	------------------	------------------	------------------

5.0

$\frac{6.3}{25}$	$\frac{6.8}{23}$	$\frac{6.9}{20}$	$\frac{4.1}{15}$	$\frac{4.4}{10}$	$\frac{4.4}{10}$	$\frac{4.4}{15}$	$\frac{6.8}{20}$	$\frac{6.6}{23}$	$\frac{5.2}{25}$
------------------	------------------	------------------	------------------	------------------	------------------	------------------	------------------	------------------	------------------

6.4

$\frac{8.8}{22}$	$\frac{5.4}{16}$	$\frac{5.8}{10}$	$\frac{5.8}{10}$	$\frac{5.7}{15}$	$\frac{8.3}{20}$	$\frac{8.3}{23}$	$\frac{7.2}{25}$
------------------	------------------	------------------	------------------	------------------	------------------	------------------	------------------

7.7

$\frac{12.3}{24}$	$\frac{6.8}{16}$	$\frac{7.1}{10}$	$\frac{7.1}{10}$	$\frac{7.5}{15}$	$\frac{10.4}{21}$	$\frac{10.7}{24}$	$\frac{9.6}{26}$
-------------------	------------------	------------------	------------------	------------------	-------------------	-------------------	------------------

2.6

$\frac{10.6}{30}$	$\frac{1.4}{16}$	$\frac{1.7}{10}$	$\frac{2.0}{12}$	$\frac{1.8}{10}$	$\frac{1.9}{15}$	$\frac{5.1}{22}$	$\frac{5.4}{25}$	$\frac{4.0}{27}$
-------------------	------------------	------------------	------------------	------------------	------------------	------------------	------------------	------------------

3.1

$\frac{12.1}{31}$	$\frac{2.0}{17}$	$\frac{2.3}{10}$	$\frac{2.7}{9.3}$	$\frac{2.5}{10.2}$	$\frac{2.6}{15}$	$\frac{5.6}{22}$	$\frac{5.7}{26}$	$\frac{3.7}{30}$	✓
-------------------	------------------	------------------	-------------------	--------------------	------------------	------------------	------------------	------------------	---

3.8

$\frac{12.2}{31}$	$\frac{2.4}{17}$	$\frac{2.8}{10}$	$\frac{3.4}{9.5}$	$\frac{3.2}{10.4}$	$\frac{3.5}{16}$	$\frac{5.8}{23}$	$\frac{6.2}{26}$	$\frac{3.5}{31}$
-------------------	------------------	------------------	-------------------	--------------------	------------------	------------------	------------------	------------------

4.8

$\frac{14.0}{30}$	$\frac{3.3}{16}$	$\frac{3.7}{10}$	$\frac{5.0}{12.3}$	$\frac{4.7}{13}$	$\frac{4.7}{19}$	$\frac{6.8}{25}$	$\frac{7.3}{31}$	$\frac{3.8}{36}$
-------------------	------------------	------------------	--------------------	------------------	------------------	------------------	------------------	------------------

Sta	+	H.I.	-	Elev
	5.47	214.83		
89 +75Z			4.8	10.0 09.4
89 +50			5.2	09.6 08.9
89 +25.7			5.8	09.0 08.4
89			6.2	08.6 07.9
+85Z			6.6	08.2 07.6
+50			7.2	07.6 06.9
+35Z			7.6	07.2 06.6
88			8.2	06.6 05.9
TP.	1.44	208.13	8.14	206.69
+85Z			1.9	06.2 05.6
+50			2.6	05.5 04.8
+35Z			2.8	05.3 04.5
87			3.6	04.5 03.8

(5.4)

$$\frac{14.0}{29} \quad \frac{4.9}{16} \quad \frac{4.2}{10} \quad \frac{5.6}{12.8} \quad \frac{5.3}{13.8} \quad \frac{5.4}{19} \quad \frac{7.3}{26} \quad \frac{7.5}{33} \quad \frac{4.3}{37}$$

(5.9)

$$\frac{12.5}{32} \quad \frac{11.7}{29} \quad \frac{4.4}{18} \quad \frac{4.8}{10} \quad \frac{6.1}{12.6} \quad \frac{5.8}{13.5} \quad \frac{6.0}{19} \quad \frac{8.2}{27} \quad \frac{8.2}{32} \quad \frac{5.0}{37}$$

(6.4)

$$\frac{9.8}{37} \quad \frac{10.2}{36} \quad \frac{9.3}{26} \quad \frac{4.4}{18} \quad \frac{5.2}{10} \quad \frac{6.5}{12.6} \quad \frac{6.3}{13.6} \quad \frac{6.3}{19} \quad \frac{8.8}{26} \quad \frac{8.9}{32} \quad \frac{4.7}{38}$$

(6.9)

$$\frac{7.6}{36} \quad \frac{9.0}{34} \quad \frac{8.1}{23} \quad \frac{4.9}{17} \quad \frac{5.6}{10} \quad \frac{7.0}{12.7} \quad \frac{6.8}{13.7} \quad \frac{7.0}{19} \quad \frac{9.2}{25} \quad \frac{9.5}{29} \quad \frac{3.2}{38}$$

(7.2)

$$\frac{7.9}{35} \quad \frac{9.2}{33} \quad \frac{8.1}{22} \quad \frac{5.6}{17} \quad \frac{6.0}{10} \quad \frac{7.4}{12.8} \quad \frac{7.2}{13.6} \quad \frac{7.1}{18} \quad \frac{9.7}{24} \quad \frac{9.8}{28} \quad \left( \frac{212.9}{37.5} \right)$$

(7.9)

$$\frac{5.4}{31} \quad \frac{6.6}{34} \quad \frac{9.0}{28} \quad \frac{10.0}{26} \quad \frac{10.0}{22} \quad \frac{6.6}{16} \quad \frac{6.7}{10} \quad \frac{8.0}{12.5} \quad \frac{7.8}{13.4} \quad \frac{8.0}{19} \quad \frac{10.2}{23} \quad \frac{10.2}{27} \quad \left( \frac{215.3}{38} \right)$$

(8.2)

$$\frac{4.1}{32} \quad \frac{8.0}{28} \quad \frac{10.4}{25} \quad \frac{10.4}{21} \quad \frac{7.0}{15} \quad \frac{7.0}{10} \quad \frac{8.4}{12.8} \quad \frac{8.1}{13.6} \quad \frac{8.1}{19} \quad \frac{10.3}{23} \quad \frac{10.4}{27} \quad \left( \frac{215.4}{38} \right)$$

(8.9)

$$\left( \frac{213.4}{37} \right) \quad \frac{210.9}{34} \quad \frac{210.8}{32} \quad \frac{11.1}{24} \quad \frac{11.1}{20} \quad \frac{7.8}{15} \quad \frac{7.8}{10} \quad \frac{8.9}{11.9} \quad \frac{8.6}{12.8} \quad \frac{8.8}{18} \quad \frac{10.7}{22} \quad \frac{10.8}{26} \quad \left( \frac{215.8}{39} \right)$$

(2.5)

$$\left( \frac{214.7}{35} \right) \quad \frac{4.5}{23} \quad \frac{4.4}{20} \quad \frac{1.2}{15} \quad \frac{1.5}{10} \quad \frac{2.4}{11} \quad \frac{2.2}{11.7} \quad \frac{1.9}{18} \quad \frac{4.4}{23} \quad \frac{4.5}{26} \quad \left( \frac{215.7}{39} \right)$$

(3.3)

$$\left( \frac{217.4}{37} \right) \quad \frac{9.0}{29} \quad \frac{5.0}{23} \quad \frac{5.1}{19} \quad \frac{2.2}{15} \quad \frac{2.3}{10} \quad \frac{2.9}{9.2} \quad \frac{2.6}{10.0} \quad \frac{2.6}{16} \quad \frac{5.1}{23} \quad \frac{5.2}{25} \quad \left( \frac{214.2}{37} \right)$$

(3.6)

$$\left( \frac{218.2}{38} \right) \quad \frac{4.0}{30} \quad \frac{5.5}{23} \quad \frac{5.6}{19} \quad \frac{2.6}{15} \quad \frac{2.7}{10} \quad \frac{3.1}{9} \quad \frac{2.9}{10} \quad \frac{3.0}{15} \quad \frac{5.3}{21} \quad \frac{5.5}{25} \quad \left( \frac{212.6}{36} \right)$$

(4.3)

$$\left( \frac{220.7}{41} \right) \quad \frac{0.0}{31} \quad \frac{6.1}{23} \quad \frac{3.6}{15} \quad \frac{3.6}{10} \quad \frac{3.7}{10} \quad \frac{3.8}{15} \quad \frac{6.1}{21} \quad \frac{6.1}{25} \quad \frac{208.9}{34}$$

Sta	+	HI	-	Elev	
	1.44	208.13			03.4
86 +85.7			3.9	08.2	99.9
86 +50			4.7	07.4	02.8 00.7
86 +00			5.6	06.5	01.8 01.6
TP	5.59	207.46	6.26	201.87	
BM					204.61
TP	0.73	204.22	3.97	203.49	
85 +60			2.5	01.7	
+50			2.7	01.5	200.7
85			3.8	00.4	199.7
+50			4.7	99.5	98.7
84			5.5	98.7	98.0
+50			5.8	98.4	97.7
83			5.6	98.6	97.9
+50			4.8	99.4	98.6
82			3.5	00.7	200.0
TP	7.07	207.16	2.13	202.09	

LT & RT

116

(220.8 / 41) 1.5 / 31 6.3 / 25 6.2 / 20 3.9 / 15 3.9 / 10 (4.7) 4.1 / 10 4.1 / 10 6.4 / 21 6.5 / 25 0.8 / 33 ✓

(219.3 / 41) 0.7 / 34 7.2 / 26 7.2 / 21 4.5 / 15 4.7 / 10 (5.3) 4.8 / 10 4.8 / 15 7.4 / 22 7.8 / 25 7.0 / 27 2.6 / 33

(216.6 / 39) 8.1 / 24 8.2 / 21 5.4 / 15 5.1 / 10 (6.3) 5.7 / 10 5.6 / 15 8.5 / 21 9.1 / 26 4.6 / 34

Nail in 10" oak Lt sta 85+75 removed

Top of bottom plank on G.P.

(21.3 / 31) 6.2 / 27 5.8 / 20 2.5 / 16 2.4 / 10 2.5 / 9.2 (3.5) 2.6 / 9.3 2.5 / 10 2.5 / 16 6.5 / 23 9.0 / 29 8.7 / 31 9.7 / 33 ✓

(5.1 / 31) 7.0 / 28 6.8 / 21 2.7 / 16 2.7 / 10 2.8 / 9 2.8 / 9.4 2.7 / 10.1 2.8 / 18 9.2 / 28 11.6 / 35

(88.3 / 33) 3.6 / 15 3.7 / 10 3.8 / 9.3 (4.5) 3.9 / 11 3.7 / 10 4.1 / 18 (82.6 / 44)

(83.6 / 40) 4.6 / 16 4.6 / 10 4.7 / 9.1 (5.5) 4.8 / 9.4 4.6 / 10.1 4.7 / 17 (80.6 / 44) (79.5 / 47)

(81.6 / 41) 5.4 / 15 5.4 / 10 5.5 / 9.4 (6.2) 5.6 / 9 5.5 / 10 5.5 / 16 (81.5 / 42)

(84.6 / 36) 5.6 / 15 5.8 / 10 5.9 / 9.5 (6.5) 5.9 / 9.3 5.8 / 10 6.3 / 17 (80.1 / 44)

(83.7 / 39) 5.5 / 16 5.5 / 10 5.6 / 9.3 (6.3) 5.7 / 9.3 5.6 / 10 5.9 / 16 (81.4 / 41)

(84.5 / 38) 4.9 / 16 4.7 / 10 4.8 / 9.2 (5.6) 4.9 / 9.3 4.7 / 10 4.8 / 16 (82.8 / 38)

(87.7 / 34) 3.4 / 10 3.5 / 10 3.7 / 9.0 (4.2) 3.4 / 10 3.5 / 15 (87.7 / 37)

Top of c.m. pipe RT 9417 10-31-23

Sta + H.I - Elev

7.07 209.16

$E.C. 81 + 30.9$   
 $= 81 + 33.1$

$81 + 33.1 =$   
 $81 + 30.9$  Long Sta. 102.2

6.0 53.2 02.5

81 4.6 04.6 03.8

+50 2.6 06.6 05.9

I.P. 2.47 216.38 2.25 206.71

80 7.8 08.6 07.9

+50 5.7 10.7 10.0

79 3.7 12.7 12.0

+50 1.7 14.7 13.9

B.M. 7.55 223.53 0.35 216.03 215.98

Error 0.05

78 7.2 16.3 15.6

+50 5.7 17.8 17.1

77 4.5 19.0 18.3

+50 3.5 20.0 19.4

76 2.7 20.8 20.1

Lt

E

Rt

117

started here - 11-5-23

same party Fair-worth

$\frac{11.1}{37}$	$\frac{11.9}{35}$	$\frac{9.7}{24}$	$\frac{6.0}{18}$	$\frac{6.3}{12.3}$	$\frac{6.5}{11.3}$	$\frac{6.7}{10}$	$\frac{5.5}{16}$	$\frac{5.5}{16}$	$\frac{7.4}{37}$	Driveway
-------------------	-------------------	------------------	------------------	--------------------	--------------------	------------------	------------------	------------------	------------------	----------

$\frac{6.2}{36}$	$\frac{9.2}{33}$	$\frac{8.5}{28}$	$\frac{5.2}{20}$	$\frac{5.3}{14.9}$	$\frac{5.5}{14}$	$\frac{5.4}{10}$	$\frac{4.1}{17}$	$\frac{6.6}{23}$	$\frac{7.9}{27}$	$\frac{7.0}{37}$	$\frac{7.1}{73}$
------------------	------------------	------------------	------------------	--------------------	------------------	------------------	------------------	------------------	------------------	------------------	------------------

$\frac{3.4}{34}$	$\frac{6.8}{30}$	$\frac{6.5}{27}$	$\frac{3.4}{21}$	$\frac{3.2}{15.1}$	$\frac{3.7}{14}$	$\frac{3.3}{10}$	$\frac{2.0}{18}$	$\frac{1.9}{25}$	$\frac{5.2}{29}$	$\frac{5.3}{30}$	$\frac{4.6}{33}$	$\frac{4.5}{33}$
------------------	------------------	------------------	------------------	--------------------	------------------	------------------	------------------	------------------	------------------	------------------	------------------	------------------

$\frac{10.1}{31}$	$\frac{11.8}{29}$	$\frac{11.5}{26}$	$\frac{8.6}{21}$	$\frac{8.5}{15.1}$	$\frac{8.7}{14.1}$	$\frac{8.5}{10}$	$\frac{7.1}{17}$	$\frac{6.7}{24}$	$\frac{11.2}{27}$	$\frac{11.2}{28}$	$\frac{10.5}{28}$
-------------------	-------------------	-------------------	------------------	--------------------	--------------------	------------------	------------------	------------------	-------------------	-------------------	-------------------

$\frac{13.6}{30}$	$\frac{6.6}{20}$	$\frac{6.4}{15}$	$\frac{6.4}{14.1}$	$\frac{6.4}{10}$	$\frac{4.8}{16}$	$\frac{8.4}{22}$	$\frac{8.3}{26}$	$\frac{7.6}{28}$
-------------------	------------------	------------------	--------------------	------------------	------------------	------------------	------------------	------------------

$\frac{14.1}{35}$	$\frac{4.5}{20}$	$\frac{4.3}{15.2}$	$\frac{4.6}{14.4}$	$\frac{4.4}{10}$	$\frac{3.1}{17}$	$\frac{2.6}{24}$	$\frac{5.0}{27}$	$\frac{5.5}{28}$	$\frac{5.2}{28}$	$\frac{5.7}{31}$
-------------------	------------------	--------------------	--------------------	------------------	------------------	------------------	------------------	------------------	------------------	------------------

$\frac{9.6}{34}$	$\frac{2.1}{22}$	$\frac{2.1}{14.4}$	$\frac{2.4}{13.6}$	$\frac{2.5}{10}$	$\frac{1.3}{17}$	$\frac{1.2}{25}$
------------------	------------------	--------------------	--------------------	------------------	------------------	------------------

Nail in tree Lt of sta 78+15 used for Grade-stakes.

$\frac{6.5}{31}$	$\frac{7.0}{29}$	$\frac{8.8}{27}$	$\frac{8.8}{22}$	$\frac{6.9}{16}$	$\frac{6.9}{10}$	$\frac{7.6}{9.2}$	$\frac{7.2}{10.1}$	$\frac{7.3}{17}$	$\frac{9.6}{22}$	$\frac{9.8}{25}$	$\frac{5.1}{31}$
------------------	------------------	------------------	------------------	------------------	------------------	-------------------	--------------------	------------------	------------------	------------------	------------------

$\frac{1.3}{33}$	$\frac{8.0}{25}$	$\frac{8.0}{21}$	$\frac{5.6}{16}$	$\frac{5.7}{10}$	$\frac{6.0}{9.1}$	$\frac{6.4}{10}$	$\frac{5.6}{16}$	$\frac{5.8}{20}$	$\frac{7.5}{27}$	$\frac{7.7}{27}$	$\frac{4.4}{31}$
------------------	------------------	------------------	------------------	------------------	-------------------	------------------	------------------	------------------	------------------	------------------	------------------

$\frac{228.5}{35}$	$\frac{6.1}{24}$	$\frac{6.1}{20}$	$\frac{4.6}{15}$	$\frac{4.6}{10}$	$\frac{5.2}{10}$	$\frac{4.6}{15}$	$\frac{4.7}{22}$	$\frac{6.5}{28}$	$\frac{7.0}{28}$	$\frac{3.8}{32}$
--------------------	------------------	------------------	------------------	------------------	------------------	------------------	------------------	------------------	------------------	------------------

$\frac{227.0}{33}$	$\frac{5.5}{24}$	$\frac{5.3}{20}$	$\frac{3.4}{16}$	$\frac{3.6}{10}$	$\frac{4.1}{10}$	$\frac{3.6}{17}$	$\frac{3.5}{23}$	$\frac{5.7}{28}$	$\frac{5.8}{28}$	$\frac{3.4}{32}$
--------------------	------------------	------------------	------------------	------------------	------------------	------------------	------------------	------------------	------------------	------------------

$\frac{1.2}{29}$	$\frac{4.7}{24}$	$\frac{4.7}{20}$	$\frac{2.6}{14}$	$\frac{2.9}{10}$	$\frac{3.4}{10}$	$\frac{2.8}{17}$	$\frac{2.7}{23}$	$\frac{4.8}{29}$	$\frac{5.0}{29}$	$\frac{2.0}{32}$
------------------	------------------	------------------	------------------	------------------	------------------	------------------	------------------	------------------	------------------	------------------

	570	+	H.I	-	Elev.	
			7.55	223.53		
	+50			2.2	21.3	20.7
	T.P.	7.04	229.27	1.30	222.23	
75				7.6	21.7	21.0
	+50			7.4	21.9	21.1
	B.M.					222.37
74				7.4	21.9	21.1
	+50			7.5	21.8	21.0
	T.P.	4.04	225.71	7.60	221.67	
73				4.3	21.4	20.8
	+50			4.6	21.1	20.5
72				4.9	20.8	20.2
	+50			5.0	20.7	20.1
	+50					
71				4.7	21.0	20.3
	+50			4.2	21.5	20.4
70				3.4	22.3	21.7

(2.8)

$\frac{0.8}{29}$	$\frac{2.5}{26}$	$\frac{4.2}{24}$	$\frac{4.0}{20}$	$\frac{2.4}{15}$	$\frac{2.4}{10}$	$\frac{2.2}{16}$	$\frac{2.3}{15}$	$\frac{4.7}{21}$	$\frac{5.1}{28}$	$\frac{4.3}{30}$
------------------	------------------	------------------	------------------	------------------	------------------	------------------	------------------	------------------	------------------	------------------

(8.3)

$\frac{4.6}{29}$	$\frac{9.2}{23}$	$\frac{9.1}{18}$	$\frac{7.6}{14}$	$\frac{7.7}{10}$	$\frac{7.7}{10}$	$\frac{7.8}{15}$	$\frac{10.8}{22}$	$\frac{11.3}{27}$	$\frac{10.5}{29}$
------------------	------------------	------------------	------------------	------------------	------------------	------------------	-------------------	-------------------	-------------------

(8.2)

$\left(\frac{231.8}{36}\right)$	$\frac{0.0}{34}$	$\frac{9.0}{22}$	$\frac{9.1}{19}$	$\frac{7.5}{15}$	$\frac{7.4}{10}$	$\frac{7.4}{10}$	$\frac{8.0}{16}$	$\frac{10.5}{20}$	$\frac{10.7}{25}$	$\frac{5.8}{30}$
---------------------------------	------------------	------------------	------------------	------------------	------------------	------------------	------------------	-------------------	-------------------	------------------

Nail in tele. pole LT of sta 74+05 Removed

(8.2)

$\left(\frac{230.4}{36}\right)$	$\frac{9.6}{23}$	$\frac{9.5}{19}$	$\frac{7.6}{16}$	$\frac{7.5}{10}$	$\frac{7.5}{10}$	$\frac{7.9}{17}$	$\frac{10.4}{20}$	$\frac{10.6}{26}$	$\frac{5.8}{32}$
	$\frac{5.5}{37}$	$\frac{11.3}{29}$	$\frac{10.7}{22}$	$\frac{7.6}{16}$	$\frac{7.6}{10}$	$\frac{7.8}{16}$	$\frac{12.5}{25}$	$\frac{12.6}{28}$	$\frac{10.8}{32}$

(4.9)

$\frac{5.6}{36}$	$\frac{9.2}{32}$	$\frac{8.4}{24}$	$\frac{4.3}{16}$	$\frac{4.3}{10}$	$\frac{4.3}{9.3}$	$\frac{4.2}{9.9}$	$\frac{4.2}{16}$	$\frac{12.3}{27}$
------------------	------------------	------------------	------------------	------------------	-------------------	-------------------	------------------	-------------------

cut begins 73+20

(5.2)

$\frac{10.3}{36}$	$\frac{10.8}{32}$	$\frac{7.7}{24}$	$\frac{4.6}{16}$	$\frac{4.6}{10}$	$\frac{4.6}{9.1}$	$\frac{4.6}{9.5}$	$\frac{4.5}{10}$	$\frac{4.6}{15}$	$\frac{13.8}{28}$
-------------------	-------------------	------------------	------------------	------------------	-------------------	-------------------	------------------	------------------	-------------------

(5.5)

$\frac{11.9}{27}$	$\frac{4.7}{17}$	$\frac{4.8}{10}$	$\frac{5.0}{9.0}$	$\frac{4.9}{9.3}$	$\frac{4.8}{10}$	$\frac{4.9}{15}$	$\frac{14.0}{27}$
-------------------	------------------	------------------	-------------------	-------------------	------------------	------------------	-------------------

(5.6)

$\frac{11.8}{32}$	$\frac{10.6}{25}$	$\frac{5.0}{17}$	$\frac{5.0}{10}$	$\frac{5.1}{9.3}$	$\frac{5.1}{9.2}$	$\frac{5.0}{10}$	$\frac{5.1}{16}$	$\frac{13.6}{28}$
-------------------	-------------------	------------------	------------------	-------------------	-------------------	------------------	------------------	-------------------

24" corr. culvert (5.4) Invert - 213.70 Outlet - 212.50

$\frac{11.2}{25}$	$\frac{4.7}{16}$	$\frac{4.6}{10}$	$\frac{4.8}{9.1}$	$\frac{4.7}{9.3}$	$\frac{4.6}{10}$	$\frac{5.0}{15}$	$\frac{14.5}{29}$
-------------------	------------------	------------------	-------------------	-------------------	------------------	------------------	-------------------

(5.3)

$\frac{11.1}{27}$	$\frac{4.1}{15}$	$\frac{4.2}{10}$	$\frac{4.3}{9.2}$	$\frac{4.3}{9.4}$	$\frac{4.2}{10}$	$\frac{4.3}{15}$	$\frac{14.2}{29}$
-------------------	------------------	------------------	-------------------	-------------------	------------------	------------------	-------------------

(4.0)

$\frac{6.7}{21}$	$\frac{3.6}{16}$	$\frac{3.3}{10}$	$\frac{3.5}{9.4}$	$\frac{3.4}{9.1}$	$\frac{3.3}{10}$	$\frac{3.3}{15}$	$\frac{14.3}{32}$
------------------	------------------	------------------	-------------------	-------------------	------------------	------------------	-------------------

Sta	+	Hi.L.	-	Elev	
	4.04	225.71			
+50			2.3	23.4	21
69			1.2	24.5	23.8
TP	7.23	231.76	1.18	224.53	
+50			6.2	25.6	24.9
68			5.4	26.4	25.7
+50			5.0	26.8	26.2
67			4.9	26.9	26.2
$66 + 60.8 = 66 + 63.6$ <u>Equation <math>66 + 63.6 = 66 + 60.8</math></u> $67 - 66 \text{ short sta } 7.2$					
+50			5.3	26.5	25.9
66			6.0	25.8	25.1
+50			7.1	24.7	24.0
B.M.					228.55
65			8.5	23.3	22.6
TP	2.24	224.82	9.15	222.58	
+50			2.9	21.7	21.2
64			4.3	20.5	19.9

cut ends  
69+75

$\frac{4.8}{29}$   $\frac{6.7}{26}$   $\frac{6.6}{22}$   $\frac{2.5}{16}$   $\frac{2.3}{10}$   $\frac{2.4}{9.2}$   $\frac{2.3}{9.2}$   $\frac{2.2}{10}$   $\frac{2.5}{15}$   $\frac{13.1}{30}$  ✓

(1.9)  
 $\frac{0.0}{29}$   $\frac{4.0}{25}$   $\frac{4.0}{20}$   $\frac{1.3}{15}$   $\frac{1.3}{10}$   $\frac{1.2}{9.3}$   $\frac{1.1}{10}$   $\frac{1.3}{16}$   $\frac{6.1}{25}$   $\frac{8.4}{34}$   $\frac{8.0}{35}$

(6.9)  
( $\frac{2348}{33}$ )  $\frac{4.0}{28}$   $\frac{8.8}{25}$   $\frac{8.6}{20}$   $\frac{6.3}{15}$   $\frac{6.2}{10}$   $\frac{6.3}{10}$   $\frac{6.2}{15}$   $\frac{8.9}{20}$   $\frac{9.2}{25}$   $\frac{2.4}{35}$

(6.1)  
( $\frac{2374}{35}$ )  $\frac{3.2}{29}$   $\frac{8.1}{24}$   $\frac{7.7}{19}$   $\frac{5.8}{15}$   $\frac{5.4}{10}$   $\frac{5.4}{10}$   $\frac{5.5}{18}$   $\frac{8.0}{20}$   $\frac{7.7}{24}$  ( $\frac{236.7}{37}$ )

(5.6)  
( $\frac{238.1}{36}$ )  $\frac{3.4}{28}$   $\frac{8.1}{24}$   $\frac{8.1}{20}$   $\frac{5.4}{15}$   $\frac{5.1}{10}$   $\frac{5.1}{10}$   $\frac{5.2}{15}$   $\frac{7.3}{19}$   $\frac{7.6}{24}$   $\frac{3.6}{29}$  ( $\frac{240.5}{38}$ )

(5.6)  
( $\frac{237.1}{37}$ )  $\frac{8.1}{25}$   $\frac{7.5}{20}$   $\frac{5.2}{15}$   $\frac{5.0}{10}$   $\frac{5.0}{10}$   $\frac{4.9}{15}$   $\frac{7.2}{20}$   $\frac{7.3}{25}$  ( $\frac{239.4}{37}$ )

(5.9)  
( $\frac{235.1}{36}$ )  $\frac{4.9}{29}$   $\frac{8.3}{25}$   $\frac{8.1}{21}$   $\frac{5.5}{16}$   $\frac{5.4}{10}$   $\frac{5.3}{10}$   $\frac{5.4}{15}$   $\frac{7.9}{20}$   $\frac{7.9}{26}$   $\frac{4.6}{28}$  ( $\frac{235.5}{35}$ )

(6.7)  
( $\frac{234.3}{38}$ )  $\frac{5.6}{31}$   $\frac{8.9}{26}$   $\frac{8.6}{20}$   $\frac{6.3}{15}$   $\frac{6.0}{10}$   $\frac{6.0}{10}$   $\frac{6.1}{14}$   $\frac{8.6}{19}$   $\frac{8.8}{24}$   $\frac{5.9}{27}$  ( $\frac{236.9}{40}$ )

(7.8)  
( $\frac{230.7}{35}$ )  $\frac{7.3}{29}$   $\frac{10.4}{27}$   $\frac{10.2}{21}$   $\frac{7.2}{16}$   $\frac{7.2}{10}$   $\frac{7.1}{10}$   $\frac{7.1}{19}$   $\frac{9.5}{21}$   $\frac{9.8}{28}$   $\frac{6.9}{31}$  ( $\frac{233.6}{40}$ )

Spike in T.P. Lt of sta 65+15 Removed

$\frac{7.0}{31}$   $\frac{11.5}{25}$   $\frac{11.6}{22}$   $\frac{9.0}{15}$   $\frac{8.6}{10}$   $\frac{8.6}{10}$   $\frac{8.5}{16}$   $\frac{9.9}{19}$   $\frac{11.3}{23}$   $\frac{11.0}{30}$   $\frac{8.9}{33}$   $\frac{4.4}{38}$

(3.6)  
 $\frac{8.4}{31}$   $\frac{7.5}{26}$   $\frac{4.8}{21}$   $\frac{3.0}{15}$   $\frac{3.0}{10}$   $\frac{3.0}{10}$   $\frac{3.0}{16}$   $\frac{6.1}{23}$   $\frac{7.1}{26}$   $\frac{6.8}{32}$   $\frac{6.8}{34}$

(4.9)  
 $\frac{12.1}{29}$   $\frac{7.0}{21}$   $\frac{4.7}{15}$   $\frac{4.4}{10}$   $\frac{4.3}{10}$   $\frac{4.5}{15}$   $\frac{8.8}{26}$   $\frac{9.2}{30}$  cut ends  
64+100

Sta	+	H.I	-	F/ev
	2.24	224.82		
+50			5.6	19.2 18.5
B.M.				220.34
63		✓	7.1	14.7 ✓ 17.0 ✓
	4.06	217.95	10.98	213.84 213.89
+50			1.8	15.2 15.3
62			3.6	14.4 13.7
+50			5.3	12.7 12.0
61		✓	7.1	10.9 ✓ 10.2
T.P.	1.83	211.86	7.92	210.03
+50			2.7	09.2 08.5
60			4.4	07.5 06.7
+50		✓	6.1	05.8 ✓ 05.1
T.P.	2.20	205.57	8.49	203.37
59			1.3	04.3 03.5
+50			2.7	02.9 02.2
58			3.8	01.8 201.1

(6.3)

11.8	8.1	6.3	5.7	5.7	5.9	9.2	9.3	6.6
<u>28</u>	<u>20</u>	<u>15</u>	<u>10</u>	<u>10</u>	<u>16</u>	<u>24</u>	<u>27</u>	<u>30</u>

Spike in 14" oak Lt sta 63+10

10.8	7.1	7.1	7.8	7.2	7.4	10.4	10.7	3.1
<u>30</u>	<u>16</u>	<u>10</u>	<u>10</u>	<u>10</u>	<u>16</u>	<u>21</u>	<u>25</u>	<u>31</u>

R.R. spike in tele. pole Lt of sta 62+20

11.3	1.8	1.9	2.7	1.7	2.1	4.9	4.8
<u>40</u>	<u>17</u>	<u>10</u>	<u>10</u>	<u>16</u>	<u>21</u>	<u>27</u>	<u>27</u>

used for  
Grade stake  
(224.1)  
(36)

(220.4)	(216.0)	7.2	7.2	3.6	3.6	3.6	3.5	5.8	5.8	(224.2)
<u>45</u>	<u>39</u>	<u>32</u>	<u>21</u>	<u>15</u>	<u>10</u>	<u>10</u>	<u>16</u>	<u>19</u>	<u>23</u>	<u>35</u>

(220.3)	(216.5)	7.9	8.6	8.4	5.6	5.4	5.4	5.5	8.1	8.1	(219.6)
<u>42</u>	<u>37</u>	<u>30</u>	<u>27</u>	<u>21</u>	<u>16</u>	<u>10</u>	<u>10</u>	<u>14</u>	<u>19</u>	<u>23</u>	<u>34</u>

2.6	4.0	10.7	11.0	7.4	7.2	7.2	7.1	9.8	9.7	5.5
<u>37</u>	<u>35</u>	<u>28</u>	<u>21</u>	<u>15</u>	<u>10</u>	<u>10</u>	<u>16</u>	<u>20</u>	<u>26</u>	<u>31</u>

3.3	6.2	6.8	6.8	3.0	2.8	2.8	2.8	6.1	7.0	6.8
<u>32</u>	<u>29</u>	<u>27</u>	<u>22</u>	<u>16</u>	<u>10</u>	<u>10</u>	<u>16</u>	<u>22</u>	<u>29</u>	<u>31</u>

9.7	9.9	4.8	4.8	4.5	4.3	4.6	12.5
<u>35</u>	<u>25</u>	<u>15</u>	<u>10</u>	<u>9.4</u>	<u>10</u>	<u>17</u>	<u>28</u>

14.5	11.7	6.1	6.1	6.2	6.2	6.1	6.3	11.3	16.0
<u>29</u>	<u>23</u>	<u>15</u>	<u>10</u>	<u>9.3</u>	<u>9.4</u>	<u>10</u>	<u>16</u>	<u>22</u>	<u>25</u>

10.6	1.6	1.3	1.4	1.5	1.3	1.5	10.8
<u>29</u>	<u>16</u>	<u>10</u>	<u>9.2</u>	<u>9.4</u>	<u>10</u>	<u>16</u>	<u>26</u>

11.5	2.7	2.6	2.8	2.7	2.6	2.9	10.8
<u>28</u>	<u>16</u>	<u>10</u>	<u>9.2</u>	<u>9.2</u>	<u>10</u>	<u>15</u>	<u>24</u>

11.3	3.7	3.8	3.9	3.9	3.8	4.0	11.9
<u>26</u>	<u>16</u>	<u>10</u>	<u>9.2</u>	<u>9.6</u>	<u>10</u>	<u>15</u>	<u>23</u>

Sta	+	H.I	-	Elev
	2.20	205.57		
+50			4.9	100.7 200.1
57			5.8	99.8 199.3
+50			6.6	99.0 98.6
+12				
56			7.0	98.0 98.2
T.P.	4.50	203.84	6.23	199.34
+50			5.4	98.4 97.9
55			5.5	98.3 97.7
+92				
+50			5.4	98.4 97.8
54			5.1	98.7 98.0
+50			4.9	98.9 98.3
53			4.6	99.2 98.6
+50			4.3	99.5 98.9
B.M.			4.50	199.34 199.35

LT ≠ RT

121

(5.5)

$\frac{11.5}{24}$   $\frac{5.0}{16}$   $\frac{4.9}{10}$   $\frac{5.1}{9.2}$   $\frac{5.0}{9.2}$   $\frac{4.9}{10}$   $\frac{5.3}{16}$   $\frac{11.8}{24}$

(6.3)

$\frac{11.9}{28}$   $\frac{11.0}{22}$   $\frac{6.3}{15}$   $\frac{5.8}{10}$   $\frac{5.9}{9.3}$   $\frac{6.0}{9.2}$   $\frac{5.9}{10}$   $\frac{6.0}{15}$   $\frac{11.0}{21}$

(7.0)

$\frac{11.9}{27}$   $\frac{11.5}{23}$   $\frac{6.6}{16}$   $\frac{6.5}{10}$   $\frac{6.6}{9.5}$   $\frac{6.7}{9.1}$   $\frac{6.6}{10}$   $\frac{6.6}{15}$   $\frac{11.1}{21}$   $\frac{11.8}{25}$

24" conc. culvert

Invert <sup>121</sup> 193.5 Outlet <sup>RT</sup> 193.0

$\frac{11.7}{35}$   $\frac{11.1}{23}$   $\frac{7.1}{16}$   $\frac{7.0}{10}$   $\frac{7.1}{10}$   $\frac{6.9}{15}$   $\frac{11.5}{22}$   $\frac{11.3}{25}$

(7.4)

(5.9)

$\frac{5.7}{26}$   $\frac{7.8}{23}$   $\frac{7.8}{19}$   $\frac{5.7}{15}$   $\frac{5.5}{10}$   $\frac{5.5}{10}$   $\frac{5.4}{15}$   $\frac{9.0}{20}$   $\frac{9.1}{24}$   $\frac{6.6}{27}$

(6.1)

$\frac{7.8}{37}$   $\frac{7.2}{32}$   $\frac{8.6}{28}$   $\frac{7.8}{21}$   $\frac{5.5}{17}$   $\frac{5.5}{10}$   $\frac{5.6}{10}$   $\frac{5.6}{16}$   $\frac{9.4}{22}$   $\frac{9.8}{28}$

24" conc culvert

Invert <sup>LT</sup> 194.0 Outlet <sup>RT</sup> 193.8

$\frac{8.5}{25}$   $\frac{8.3}{21}$   $\frac{5.6}{17}$   $\frac{5.4}{10}$   $\frac{5.4}{10}$   $\frac{5.8}{16}$   $\frac{8.6}{20}$   $\frac{9.6}{29}$

(5.8)

$\frac{7.7}{22}$   $\frac{5.2}{16}$   $\frac{5.2}{10}$   $\frac{5.3}{10}$   $\frac{5.6}{16}$   $\frac{8.7}{22}$   $\frac{9.8}{29}$

(5.5)

$\frac{6.9}{20}$   $\frac{5.6}{18}$   $\frac{4.8}{15}$   $\frac{5.0}{10}$   $\frac{5.0}{10}$   $\frac{5.2}{15}$   $\frac{8.1}{19}$   $\frac{8.6}{28}$   $\frac{7.6}{29}$


(5.2)

$\frac{7.0}{19}$   $\frac{4.8}{17}$   $\frac{4.7}{10}$   $\frac{4.7}{10}$   $\frac{4.9}{16}$   $\frac{8.0}{22}$   $\frac{8.4}{29}$   $\frac{7.0}{30}$

(4.4)

$\frac{5.8}{20}$   $\frac{4.4}{17}$   $\frac{4.4}{10}$   $\frac{4.4}{10}$   $\frac{4.6}{16}$   $\frac{7.7}{22}$   $\frac{8.1}{25}$

R.R. spike in 3rd Bent LT of sta 55+50

 

Topography 23-63

{ Corley  
persons  
Briggs  
KCK

11-3,4.-23

Fair-Warning.

5th.

17+00

16+00

15+00

14+00

13+00

0+00

LT


¢

RT

CS

↓  
 13+63 field ent  
 25" X 12" C.M. pipe 23' LT II

↓  
 II. 13+68 field ent  
 25" X 12" C.M. pipe 22' RT

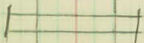

↓  
 0+25 C.M. pipe 18" X 36'  
 Ext. 18.6' LT 17.4' RT

← 20' → Beginning proj 23-63

5+0

23+00

22+00

21+00

20+00

19+00

18+00

Fence 38' R.

✓  
conc culvert - 24' x 72"  
29.7' RT 42.3' LT

Δ G.P. 21+56 - 15' RT  
21+40 beginning  
G.P. - 14.8' RT



Fence 45' LT


Δ in g.m. 20+18 - 14.6 LT  
End of Guard-rail  
20+02 - 16' LT



✓  
18+88 C.M. pipe 26" x 12"  
Field ext.

corner fence  
18+65 32' RT

Fence corner →  
17+45 - 35' LT

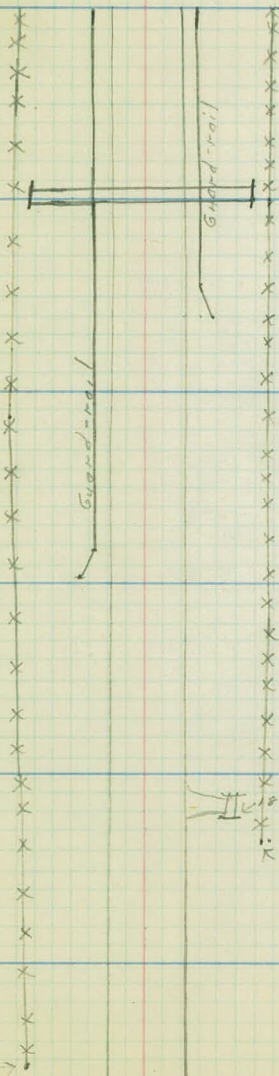

Sta

29

28

27

Width of paving on Curve,

Sta	width
25+75	20'
26+00	20'
26+25	20'
26+50	20.7'
26+75	21.8'
27+00	22.7'
+25	23.0'
+50	22.8'
+75	22.8'
28	22.8'
+25	22.1'
+50	20.8'
+75	20.0'

26+00

25+00

24+00

Lt

±

Rt

Lt

T.P. 28' Lt 27+98

φ

F. cor. 37' Lt 27+40

26+80 C.M. pipe.  
12" x 24" F. Ent.

Fence 31' Lt

Fence 30' Lt

Fence 31' Lt

End G.R. 23+29.5 15' Lt  
Δ G.R. 23+14 15' Lt

27+56 - 20" x 18" - 31' Rt  
F. Ent.

Catch basin  
27+35 10" x 10" pipe  
F. Cor. 40' Rt 27+20

Fence 33' Rt

Beg. of curb Rt 25+71

Fence 37' Rt

Fence 37' Rt

End G.R. 23+48.5 15' Rt

Δ G.R. 23+32 15' Rt

Sta

35+00

34+00

33+00

32+00

31+00

30+00

LT      &      RT

15

T.P. 28' LT 30+55

⊗

T.P. 29' LT 34+39

⊗

T.P. 29' LT 32+97

⊗

T.P. 29' LT 31+65

⊗

T.P. 28' LT 30+39

⊗

T.P. 27' LT 29+13

⊗

✓  
End of curb 29+39.3

5th

41+00

40+00

39+00

38+00

37+00

36+00

LT  $\phi$  RT

16

T.P. 28' LT 40+78

$\phi$



✓  
C.M. pipe 25" x 12"  
21' RT X Road 70+68

T.P. 28' LT 39+40

$\phi$

T.P. 28' LT 38+13

$\phi$

T.P. 28' LT 36+83

$\phi$

5th

47+00

46+00


45+00

44+00

43+00

42+00


G.R. - L. 51 + 41  
48 + 44 x 297  
(297)

 

LT      E      RT

67

↓  
C.M. pipe 34'x18"  
22' LT 47+25

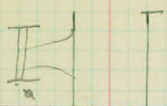

T.P. 28' LT 27+03

T.P. 20' LT 46+59

α

α

T.P. 28' RT 46+24

T.P. 28' LT 45+78

α

T.P. 28' RT 44+91

T.P. 28' LT 44+56

α

T.P. 28' LT 43+31

α

α

T.P. 27' RT 43+35



C.M. pipe 26'x12"  
F. Ent. 42+42 22'R

T.P. 28' LT 42+05

α

Sta

57+00

56+00

55+00

54+00


53+00

52+00

No new topography between  
sta 48 and sta 52

LT & RT

18

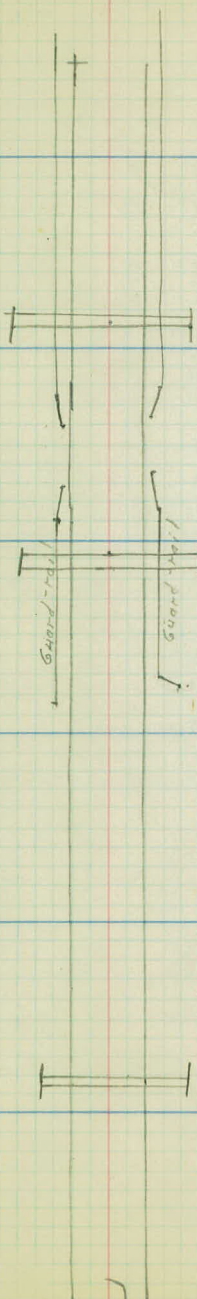

L.G.P. 14.3 LT 55+76  
Beg. G.R. 12' LT 55+60

End of G.R. - 12.5' RT 55+29  
L.G.P. 55+12 - 14.5 LT

Beg. of G.R. 15' R. 54+16

Conc. culvert 24" X 48"  
22' RT 26' LT 54+11

L.G.P. 14' RT 55+79  
Beg. G.R. 11' RT 55+63

End G.R. 13' RT - 55+32

L.G.P. 14.3 RT - 55+16  
Conc. culvert 24" X 48"  
54+91 - 24' LT 24' RT

L 54+29 - 14.5 RT  
Beg. G.R. 19' RT 54+23

Conc. Culvert  
24" X 40" - 52+19  
22' RT 18' LT

570.

63+00

62+00

61+00

60+00

59+00

58+00

L  $\neq$  R

T.P. 28' Lt 63+62

Guard-rail

Guard-rail

L G.R. 14.6' Rt 63+36  
Beg G.R. 19' R 63+29  
C.M. pipe 18" x 20" L  
63+15 - 25' Rt  
Field-ent

L G.R. 14.6' L 63+03

Beg. G.R. 15' Lt 62+56



X X X  
X  
X  
X  
X

F. Cor. 36' R 62+52

T.P. 29' Lt 62+14

⊗

F. Cor. 61+58 - 36' R.



T.P. 60+63 - 29' Lt

End G.R. 14.4' Lt 60+77

L G.R. 14' Lt 60+62

Guard-rail

Guard-rail

End G.R. 14.6' Rt 60+81

L G.R. 14' Rt 60+65

5+01

69+00

68+00

67+00

66+00

65+00

64+00

T.P. 28' R. 69+62

LT

RT

110

✓  
Beg. of curb 69+00

∠ G.R. 145° R 69+07

Beg of G.R. 155° L 68+90

↑

T.P. 28' LT 68+27

G.Rail

Guard-rail

✓  
Beg. of curb 68+77

∠ G.R. 145° RT 68+67

Beg. G.R. 68+51° 15.7° RT

↑

T.P. 28' RT 66+65

T.P. 28' LT 65+15

✓  
End G.R. 15° LT 64+78

∠ G.R. 64+63-144° LT

✓  
End G.R. 15° RT 64+80

∠ G.R. 14.4° RT 64+63

5+01

75+00

74+00

73+00

72+00

71+00

70+00

T.P. 28' L+75+74

T.P. 28' L+75+56

L+  
Q

±

RT

///

T.P. 74+08 28' L+

End G.R. 16' L+74+70

L.G.R. 14.5' L+73+55

73+70

End curb 72+85

End G.R. 16' R+74+77

L.G.R. 14.5' R+73+63

End curb 73+25

Catch-basin 74+32  
10' X 12" C.M. pipe

Conc. Culvert 24" X 36"  
28' R+L 70+54  
Catch-basin 70+32  
10' X 12" C.M. pipe

Sta.

81+00

80+00

79+00

Curve - width

77+75	-20'
78	-20.5'
+25	-22.5'
+50	-24.3'
+75	-25.0'

79

+25	-25.0
+50	-25.0
+75	-25.0

78+00

80

+25	-25.2
+50	-25.1
+75	-25.1

81

+25	-22.8
+50	-20.8
+75	-20.0

77+00

76+00

LT E RT

112

C.M. pipe 29' RT 81+28  
Imp. 40' + 12"

L G.R. 14.5' RT 81+48

Beq. G.R. 26' RT 81+37

End G.R. RT 26' 81+12  
L G.R. 14.5' RT 81+03

Beq. of G.P. 18' LT 81+20

End G.R. 20' LT 80+20

Beq. G.R. 78+14 17' LT

Beq. of G.R. 15' RT 78+21

Beq. Curb 77+24

540

87+00

86+00

Curve - width

87 +50	20.1'
+75	21.1'
88 +00	22.8'
+25	23.6'
+50	23.6'
+75	23.8'

85+00

89	23.8'
+25	23.8'
+50	23.6'
+75	23.6'

90.

+25	21.7
+50	20.4
+75	20.0'

84+00

83+00

82+00


LT

±

RT

113


✓  
Beg of curb 87+04  
87+00 conc spill-way  
14' X 2.5'

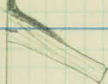


✓  
End curb 85+65  
End G.R. 15' ± 85+54 ✓

✓  
End of curb 85+65  
End G.R. 15' ± 85+54 ✓

✓  
Catch basin  
83+55 C.M.P. 24' X 12'

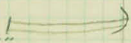

✓  
Catch-basin  
83+55 C.M.P. 12' X 30'

 

✓  
Catch-basin  
82+32  
C.M.P. 12' X 30'



✓  
Beg. curb 82+11

57d

93+00

92+00

91+00

90+00

89+00

88+00

✓

L | ≠ | R

93+54 - 23' 14"  
C.M.p. 18' X 12"  
Field data

II

End G.R. 91+65 ✓

End cutb 91+03 ✓

Box G.R. 15' at 88+70 ✓

5th

100+00

99+00

CURVE WIDTHS

96+25 20'

+50 21.0'

+75 22.7'

97 23.6'

+25 23.6'

+50 23.6'

+75 23.8'

98+00

98 24.3'

+25 23.6'

+50 23.6'

+75 23.0'

99 21.8'

+25 20.3'

+50 20.0'

97+00

96+00

95+00

94+00

4+

E

RT

115

✓  
29+46 End cur b.

✓  
27.


✓  
G.R. 78+45

Guard-rail

✓  
Beg. G.R. 96+93

✓  
95+71 Beg. curb  
conc. spillway  
3' X 12'

✓  
II 74+37-26 RT.  
18' X 12" C.M.P.

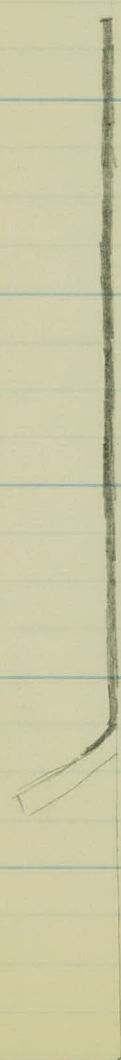

107+00

106+00

105+00

104+00

103+00

102+00


101+00

107496.6

End of paving

✓  
103461 C.M. Pipe  
19' L<sup>x</sup> 18" X 12"

II

 

150

8

---

1200

Woodwood Road

County Road E.

Home Co. Line to first line  
of St Paul Suburban R.R.

U 2456