

23-65

Eustis Street

ENGINEERS'
FIELD BOOK
No. 19403

"5"

EUGENE DIETZGEN CO.

DRAWING MATERIALS, MATHEMATICAL and
SURVEYING INSTRUMENTS

Chicago New York San Francisco New Orleans Pittsburg Toronto


Distances from Center of Roadway for Cross-Sectioning
Roadway 16 feet wide. Side Slopes 1 on 1.
For Single Track Embankment.

H	0	.1	.2	.3	.4	.5	.6	.7	.8	.9	H
0	8.0	8.1	8.2	8.3	8.4	8.5	8.6	8.7	8.8	8.9	0
1	9.0	9.1	9.2	9.3	9.4	9.5	9.6	9.7	9.8	9.9	1
2	10.0	10.1	10.2	10.3	10.4	10.5	10.6	10.7	10.8	10.9	2
3	11.0	11.1	11.2	11.3	11.4	11.5	11.6	11.7	11.8	11.9	3
4	12.0	12.1	12.2	12.3	12.4	12.5	12.6	12.7	12.8	12.9	4
5	13.0	13.1	13.2	13.3	13.4	13.5	13.6	13.7	13.8	13.9	5
6	14.0	14.1	14.2	14.3	14.4	14.5	14.6	14.7	14.8	14.9	6
7	15.0	15.1	15.2	15.3	15.4	15.5	15.6	15.7	15.8	15.9	7
8	16.0	16.1	16.2	16.3	16.4	16.5	16.6	16.7	16.8	16.9	8
9	17.0	17.1	17.2	17.3	17.4	17.5	17.6	17.7	17.8	17.9	9
10	18.0	18.1	18.2	18.3	18.4	18.5	18.6	18.7	18.8	18.9	10
11	19.0	19.1	19.2	19.3	19.4	19.5	19.6	19.7	19.8	19.9	11
12	20.0	20.1	20.2	20.3	20.4	20.5	20.6	20.7	20.8	20.9	12
13	21.0	21.1	21.2	21.3	21.4	21.5	21.6	21.7	21.8	21.9	13
14	22.0	22.1	22.2	22.3	22.4	22.5	22.6	22.7	22.8	22.9	14
15	23.0	23.1	23.2	23.3	23.4	23.5	23.6	23.7	23.8	23.9	15
16	24.0	24.1	24.2	24.3	24.4	24.5	24.6	24.7	24.8	24.9	16
17	25.0	25.1	25.2	25.3	25.4	25.5	25.6	25.7	25.8	25.9	17
18	26.0	26.1	26.2	26.3	26.4	26.5	26.6	26.7	26.8	26.9	18
19	27.0	27.1	27.2	27.3	27.4	27.5	27.6	27.7	27.8	27.9	19
20	28.0	28.1	28.2	28.3	28.4	28.5	28.6	28.7	28.8	28.9	20
21	29.0	29.1	29.2	29.3	29.4	29.5	29.6	29.7	29.8	29.9	21
22	30.0	30.1	30.2	30.3	30.4	30.5	30.6	30.7	30.8	30.9	22
23	31.0	31.1	31.2	31.3	31.4	31.5	31.6	31.7	31.8	31.9	23
24	32.0	32.1	32.2	32.3	32.4	32.5	32.6	32.7	32.8	32.9	24
25	33.0	33.1	33.2	33.3	33.4	33.5	33.6	33.7	33.8	33.9	25
26	34.0	34.1	34.2	34.3	34.4	34.5	34.6	34.7	34.8	34.9	26
27	35.0	35.1	35.2	35.3	35.4	35.5	35.6	35.7	35.8	35.9	27
28	36.0	36.1	36.2	36.3	36.4	36.5	36.6	36.7	36.8	36.9	28
29	37.0	37.1	37.2	37.3	37.4	37.5	37.6	37.7	37.8	37.9	29
30	38.0	38.1	38.2	38.3	38.4	38.5	38.6	38.7	38.8	38.9	30
31	39.0	39.1	39.2	39.3	39.4	39.5	39.6	39.7	39.8	39.9	31
32	40.0	40.1	40.2	40.3	40.4	40.5	40.6	40.7	40.8	40.9	32
33	41.0	41.1	41.2	41.3	41.4	41.5	41.6	41.7	41.8	41.9	33
34	42.0	42.1	42.2	42.3	42.4	42.5	42.6	42.7	42.8	42.9	34
35	43.0	43.1	43.2	43.3	43.4	43.5	43.6	43.7	43.8	43.9	35
36	44.0	44.1	44.2	44.3	44.4	44.5	44.6	44.7	44.8	44.9	36
37	45.0	45.1	45.2	45.3	45.4	45.5	45.6	45.7	45.8	45.9	37
38	46.0	46.1	46.2	46.3	46.4	46.5	46.6	46.7	46.8	46.9	38
39	47.0	47.1	47.2	47.3	47.4	47.5	47.6	47.7	47.8	47.9	39
40	48.0	48.1	48.2	48.3	48.4	48.5	48.6	48.7	48.8	48.9	40

Example—If point is 22.5 ft. above grade, how far should it be from center line to be a slope stake point? Ans. from Table 30.6. For same slopes but other widths of roadbed, correct above figures by one-half difference in width of roadbed; thus in example above, for 20 ft. roadbed distance will be 30.6 + (20—16)÷2 or 2 ft. added to 30.6 = 32.6. For slopes of 1 on 1½ see inside of back cover.

Copyright, 1914, by Eugene Dietzgen Co.


(23-65)

 

INDEX (23-65)

Location Eustis St. Como to Carpenter

Page	Notes	Station
4-6 incl.	Slope Stakes & X-Sec.	0+00 to 16+23 ^B

 

(23-65)

6-27-23

X Sec & Slope Stakes

Sta.	+ S	H.L.	- S	Gr Elev.	Gr. Rod.
B.M.	2.65	197.28		194.63	
0+00				191.37	
0+14					
1+00				193.8	3.5
T.P.	10.36	207.50	0.14	197.14	
2+00				196.3	11.2

VOID

A/c used incorrect shldr 5.9

BM	6.56	201.19		194.63	
0+00				191.37	9.8
1+00				193.8	7.4
2+00				196.3	4.9
3+00				198.7	2.5
T.P.	7.44	208.10	0.53	200.66	
4+00				201.2	6.9
5+00				203.6	-4.5
6+00				206.1	2.0
7+00				208.8	+0.4
T.P.	10.12	217.67	0.55	207.55	
8+00				210.9	6.8
9+00				213.0	4.7
B.M.			1.37	216.30	216.38

These are grade pt

Check Levels - Deutsche

B.M.	1.36	217.74		216.38	
T.P.	0.60	208.21	10.13	207.61	
T.P.	2.26	199.42	11.05	197.16	
			4.78	194.64	194.63

Star track

Top Hydrant		Como Ave & Eustis St.				City Datum			
Slope stk not set	5.7	5.4	Co.5	4.8	8.7	3.5	(C2.4)	3.2	3.2
a/o street	2.6	1.2	0	9.5	13	20.4	(20.4)	2.8	3.3
5.2	5.2	4.8	5.2	5.0	4.7	3.2		2.7	2.7
33	27.5	19	14.5	12	13.5	19		2.8	3.3
3.8	4.5	3.1	3.0	Co.5	2.9	Co.8	3.1	2.7	1.4
33	28.5	22	18.5	(18.5)	16.5	14.5	5.5	14.5	20.1
									(C2.1)
									20.1
									(20.1)
									0.4
									3.3

Sp. Tel. pl. 18'R Sta. 2+40

146.5.1	11.9	11.5	11.3	(Fo.1)	11.3	11.1	11.0	Fo.3	13.1	14.0	13.2	13.0	(F1.8)	12.5	12.5
33	28.5	23.5	21.5	20.0	(17.2)	17.2	13	7	5	11.5	17	20.7	20.7	27	33
															Y

2+ 20'

Star track

Top Hydrant		Como Ave & Eustis St				City datum									
Slope stk not set	9.8	9.3	Co.5	2.4	8.8	7.5	7.3	7.6	(C2.2)	7.1					
a/o street	2.6	1.2	0	2.0	9.5	13.5	20	22.5	(23.2)	3.0					
(DC.0.2)	7.2	7.1	7.0	6.8	6.2	Co.7	7.0	7.0	6.5	5.8	5.0	(4.5)	(C2.9)	7.1	
	23.2	23.2	22.5	20.5	12.5	6	5	11	15	17.5	24	(25.7)	(25.9)	3.0	
(DC.0.5)	7.0	5.4	5.3	5.0	4.8	4.7	Fo.3	6.8	7.6	7.3	6.6	(6.6)	(F1.7)	6.3	6.2
28.5	23.5	26.5	23	21.5	19.5	12.5	0	5	11	14.5	21	20.5	(20.5)	27.5	3.0
3.5	(DC.0.5)	3.1	2.7	2.8	2.7	F1.1	6.0	6.3	5.7	5.6	5.5	(F3.0)	(22.5)	3.5	3.0
3.0	22.5	23.5	19.5	13	5	0	4.5	9.5	14.5	21.5	72.5				

Top rock in road. - (brd)

8.0	8.4	7.6	(Fo.2)	7.6	7.4	7.3	Fo.6	7.8	10.0	10.0	10.2	10.9	(F4.0)	10.9	10.9
33	25.0	22	(19.1)	18.2	12	7	0	3.5	9.5	15	20	2.4	2.4	2.7	3.3
5.9	6.3	(F1.0)	6.2	5.5	5.5	5.5	F1.9	5.4	2.2	1.5	1.5	(C3.0)	(21.0)	3.1	27.5
33	2.8	(19.5)	2.4	1.9	1.2	5	0	3	7.5	20.5	21				
10.0	(F8.7)	7.9	7.2	4.0	4.2	3.9	3.9	F2.1	4.8	8.4	8.3	9.1	9.0	9.0	(F2.7)
33	30.8	30.8	28	17.5	13	10.5	7	0	3	8	7.6	27.5	28.5	29.5	(29.5)
(F10.8)	9.5	8.9	18	18	1.6	1.4	F2.0	2.2	4.1	7.2	7.5	7.6	7.6	(F8.8)	7.4
33.7	33	29	19.5	11	8.5	4	0	6	10.5	18	24.5	29	31	(31)	33

Sp. Tel. pl. 22'L Sta. 7+40

Star track

Slope stk not set	14.1	14.2	10.0	7.9	8.1	7.9	F1.0	8.6	9.7	15.7	16.3	15.3	(F9.4)	15.3
a/o street	3.3	2.9	2.1	1.7	1.0	3.5	0	5.5	9.5	19.0	25	2.8	(31.7)	3.3
6.4	5.8	4.8	(O.D.)	4.3	4.2	Co.5	4.9	6.0	14.0	13.6	13.4	(F9.0)	(32)	13.4
33	25	19.5	(18)	14.5	7	0	6	9	20.0	24	2.8	(32)	3.3	

RR sp. Tel. pl. Left sta 9+90

RR sp. Tel. pl. L sta. 9+70

Sp. Tel. pl. Left sta 7+40

4 or 18R " 2+40

Top hydrant. City datum Car. Como & Eustis -

(23-65) Slope Stakes & X-Sec. 6-29-23

Sta	+ S	H.I.	- S	Gr. Elev.	Gr. Rod.
B.M.	10.58	226.96		216.38	
9+50	Abrupt	Sec. acct contrk		214.0	13.0
10+00	"	"	"	215.2	11.8
10+50				217.9	9.1
B.M.	11.97	228.35		216.38	
11				222.6	5.8
T.P.	12.06	240.19	0.22	228.13	
11+50				227.6	12.6
12+00				232.6	7.6
11+00				222.6	17.6
T.P.	12.06	251.78	0.47	239.72	
11+50				227.6	24.2
12+00				232.6	19.2
12+50				237.6	14.2
13+00				242.1	9.7
13+50				246.2	5.6
T.P.	11.37	260.80	2.35	249.43	
14+00				249.7	11.1
14+50				252.9	7.9
15+00				255.9	4.9
15+50				259.0	1.8
B.M. (B)			3.76	257.04	256.9
T.P.	7.10	267.49	0.41	260.39	
B.M.			3.15	264.34	264.43

T. Wilson
Ch. Mahoney
Rad. Franke
L

Notes. Deutsche
E

5

R

R.R. S. Tel. pl. Left Sta. 9+90

8.5	13.2	10.2	12.5	12.3	0.8	12.3	16.8	18.6	(F6.2)	18.6		
25.5	21.2	18.2	10	10.5	0	8	19	27.5	27.4	33	✓	
9.6	10.5	(C1.2)	11.2	10.2	10.1	10.1	C1.8	10.8	15.7	15.6	(F2.6)	16.4
33	27	19.2	17.5	7.5	10.5	4.5	0	9.5	24	26	24.3	33
+20.0	(C4.2)	5.0	5.2	5.3	5.3	5.3	C4.0	5.1	5.8	4.7	(C3.6)	6.2
30	22.2	21.5	19.5	18.0	11.5	5.5	0	5.5	6.5	10	21.6	25

0.5	2.0	1.5	1.5	C4.4	1.4	2.0	0.8
20.5	18	14	7.5	0	5	8.5	11.5

Top rock 20' L Sta. 11+15

1.3	(C5.1)	5.8	7.9	9.7	8.6	8.5	C4.0	8.6	9.1	8.4	7.6	5.2	4.1	F2 vert. bk
30	23.1	26.5	21.5	19	13	7	0	5	9	15	19	22.5	24.5	✓
20	(C6.9)	1.3	5.3	4.3	4.1	4.2	C3.6	4.3	5.0	4.3	5.4	2.9	0.9	✓
27	24.9	23.5	18.5	16	12	7	0	5	8	10	12	76	17	✓
3.1	(C13.0)	4.5	6.1	8.8	10.6			5.9	4.6	5.4	5.9	(C12.2)		✓
33	31.0	31	29	26.5	24			21	22	30.2	30.5	30.2		✓

Top rock 12' L Sta. 12+40

								10.8	✓	(C13.3)	10.9			
								25.5		31.3	33	✓		
		5.1						7.7	✓	Topbk				
		33						2.9		2.9	(C16.3)	2.9		
								22	27	30	35	(34.3)	4.0	
2.1	4.6	(C6.7)	7.4	9.1	12.0	11.5	11.4	C3.0	11.3	11.6	9.7	7.2	2.9	1.3 bottom
33	30	24.7	25	22.5	17	14.5	8.5	0	4.5	7	11	16.5	23.5	26
+2.7	3.32	5.4	7.1	4.6	6.5	(C2.5)	8.3	7.5	7.3	C2.8	7.0	7.5	6.0	3.0
35	33	29.5	25	21.5	(20.5)	18	15	10.5	0	4	7.5	70.5	17	✓
+2.2	0.2	2.8	(C2.0)	3.6	4.4	3.8	3.6	C2.0	3.6	4.5	2.9	0.2		✓
33	30	25	20	17.5	10.5	8		0	5.5	8.5	11.5	17		✓

Top rock R Road Sta. 13+65

11.4	2.6	7.8	7.7	10.2	11.2	10.6	10.2	10	9.1	10.1	10.8	10	2.7	4.0	2.1	+0.5	+0.6	+0.8
37	33	31	27	22.5	19.5	17.4	11.5	5	0	3.5	7.5	11	16.5	2.3	25.5	26.5	28	33
8.8	7.7	7.7	8.6	(C6.0)	8.6	8.0	7.7	C0.2	7.7	8.0	7.4	(F0.7)	7.2	6.2	6.2			
35	32	25.5	20.5	(18.2)	16.11	8.5		0	6	8	13	(18.7)	19	2.3	3.3			
(F0.9)	5.8	6.2	6.2	5.9	5.4	F0.3	5.7	5.7	5.4	7.6	7.0	8.3	8.3	(F1.9)				
(13.3)	33	26.5	20.5	13.5	6	0	5	7.5	15	20	25	29.5	33-35	(20.8)				
(0.0)	2.0	2.0	2.6	3.1	2.5	2.1	F0.2	2.3	3.0	4.5	3.3	2.1	2.0	2.1	(F1.7)			
(17.5)	37	32	26.5	20	14	11	0	7	13	19	23.5	25.5	28	33-35	(17)			

Top Elec. Manhole

Top cement step - S.E. Cor. Bldg. Cor. Carpenter & Eustis

Sp. Tel. pl. N.W. Cor. Carpenter & Eustis

Sta.	(23-65)		Slope Stokes & X-Sec.		Gr Elev	Gr Rod.
	+ S	H.I.	- S			
		267.58				
16+00					262.0	5.6
16+10					262.6	5.0
16+23 ⁸					264.0	3.6
B.M.	5.91	270.34			(7-2-23) 264.43	
T.P.	8.82	269.45	9.71		260.63	
13+50					246.2	23.3
T.P.	3.08	268.23	4.30		265.15	
14+00					249.7	18.5
T.P.	0.40	265.55			265.15	
12+50					237.6	28.0
13+00					242.1	23.5
B.M.	3.82	268.25			264.43	
16+00					262.0	6.3
16+10					262.6	5.7

7-2-23

Same party etc page 5

6

L

E

R

		Curd	6.0	5.2	0.7	4.9	4.5	6.3	4.2	2.2	2.4	2.8
		base	18.5	7.5	0	6.5	7.4	7.9	2.2	2.4	28.5	30-33
4.7	4.9	5.0	4.9	4.5	4.6	4.6	4.4	5.3	4.3	2.7	2.8	2.8
33	25	18	12.5	8	5	5	8.5	16	20	22.5	18	30.33
		Top cone	3.9		3.6	Top cone	3.25					
			14		7		14					

Sp. Tel. pl. N.W. Cor. Larpentuer & Eastis

Sp. Tel. pl.

11.0	4.6	4.6	(C18.7)	4.6
26	30.5	33	(36.7)	38

Top stk. 50' R Sta 13+50 in plow field

Top	6.9	6.9	(C11.6)	6.9
8k	28	29	(29.6)	33
				35

Same as above Top stk etc. Top 6k

9.7	9.8	(C18.3)	9.7
28	32.5	(36.3)	36.

3.3	3.1	3.3	(C20.2)
30.5	33	38.4	(38.2)

Lilac Hedge
Plow field in smaller green trees

Sp. Tel. pl. N.W. Cor. Larp. & Eastis


(DC0.8)	6.5
(17.8)	18

7.1	(F0.8)
16	16

Hot set a/c in road front of Grocery

(5.2)	(C0.5)
12	12

16.00

 

Proj # 23-65
 Grade stakes from Sta 14+00 to Sta 10+00


Sta.	+	H.I.	-	Elev.	Grade
B.M.	1.10	265.53		264.73	
T.P.	0.54	255.44	10.63	254.90	
13+50					246.2
T.P.	0.29	244.43	11.30	244.14	
13					242.1
12+50					237.6
12					232.6
			12.99		
B.M.	0.54	264.77		264.43	
T.P.	1.50	255.35	10.97	253.85	
14+00					249.82
13+50					246.20
T.P.	0.06	243.42	11.99	243.36	
13+00					242.10
12+50					237.60
12+30					235.63
12+00					232.6
T.P.	0.28	230.73	12.97	230.45	
11+50					227.6
11+00					222.6
10+80					220.63
T.P.	1.68	220.53	11.88	218.85	
10+50					217.9
10+00					215.2
B.M.			3.97	216.54	


7/12/33

sph. in Tel. pole N.W. Cor. of Larp-Eustice.

Crane
Walsh
SIMMONS
Alberg



 

 

7/17/23 A.M.		Grade stakes on prof		23-65	
Sta	+ H.I.	-	Flav	Grade	
R.M.	R.25	266.68			264.43
16			4.6	62.1	262.0
15			10.6	56.1	55.96
T.P.	0.68	256.54	10.82	255.86	
+30			4.6	51.9	51.70
14			6.9	49.6	49.82
+50			10.6	45.9	46.20
+30			12.3	44.2	44.61 45.63
T.P.	0.25	246.44	10.35	246.19	
13			5.0	41.4	42.1
+50			9.2	37.2	37.6
+30			10.5	35.9	35.63
T.P.	1.06	236.35	11.15	235.29	
12			4.0	32.4	32.6
T.P.	0.13.9	224.82	11.92	224.43	
11			3.3	22.15	22.6

Fair - Hot

Carley - Transit

Persons - Level - Rod

Eck - Head-chain

Briggs - Rear chain

spike in tele pole on N. W. Cor. of Carpenter + Justice

Continued


Sta	+	H.I.	-	Elev	Grade
	0.39	224.82			
10 + 80			4.8	20.0	20.63
+50					17.9 ✓
+30			8.6	16.2	15.6 ^{16.6}
10			10.1	14.7	15.2
B.M.	8.35	224.73	8.37	216.45	216.38
+80			10.1	14.6	14.6
9			11.2	13.5	13.0
T.P.	0.07	214.05	10.75	213.98	
+70			1.6	12.5	12.4
+20			3.1	11.0	10.4 ^{11.5}
8			3.1	11.0	10.9
+70			3.8	10.3	10.2
7			5.6	08.5	08.5
6			8.2	05.9	06.1


R.R. spike in tele pole Lt. of sta 9+90

Continued

Sta	+	H.I.	-	Elev	Grade
	0.07	214.05			
5			10.3	203.8	203.6
	T.P.	0.79	204.27	10.57	203.48
4			2.9	201.4	201.2
3			5.6	198.7	198.7
2			8.2	196.1	196.3
1			10.0	194.3	193.8
	T.P.	5.08	198.90	10.45	193.82
0					191.37
			4.18	194.72	194.63

Top of hydrant cor of Como + Justice

 

 

Proj. # 13-65

Pavement Grade Stakes
from Sta. 0+00 to Sta.

Sta.	+	H.I.	-	Elev.	sub. Grade	
B.M.	4.40	201.03		197.63		
0+00					191.37	
	+25				191.781	
	+50				192.592	
	+75				193.203	
1+00					193.514	
	+25				194.425	
	+50				195.034	
	+75				195.647	
2+00					196.258	
	+25				196.869	
	+50				197.480	
	+75				198.091	
3+00					198.702	
	+25				199.313	
I.P.	+50	10.87	211.42	0.48	200.55	199.924
	+75					200.535
I.P.	4+00	3.20	207.41	7.21	104.21	201.146
	+25					201.757
	+50					202.368
	+75					202.979

4/27/23

Crandall
Simmons
Walsh
Anthony

Pave.
Grade

Top of Hyd. at Como & Eastice Ave

191.995

192.606

193.217

193.828

194.439

195.050

195.661

196.272

196.883

197.494

198.105

198.716

199.327

199.938

200.549 v

201.160

8/11/23

Carley
Parsons
Eck
Br-1998

201.771

Sp R. 10 Tol. pole R. Sta. 4+80

202.382

202.993

203.604

Sta.	+	H.I.	-	Elev.	Sub Grade
T.P.		20741			
5+00					205.590
+25					204.201
+50					204.812
I.P. +75	9.27	215.72	0.96	206.45	205.423
6+00					206.034
+25					206.645
+50					207.256
+75					207.867
7+00					208.478
+25					209.089
+50					209.700
+75					210.280
7+75					210.280
8+00					210.846
+25					211.429
+50					211.960
+75					212.53
9+00					213.03

Pavement
GROSS

12.63	13.15
7.55	7.55
<hr/>	<hr/>
20.18	20.60
5.52	5.52
<hr/>	<hr/>
4.66	15.08

- 204.215 ✓
- 204.826
- 205.437
- 206.048
- 206.659 ✓
- 207.270 ✓
- 207.881 ✓
- 208.492 ✓
- 209.103 ✓
- 209.714 ✓
- 210.325 ✓

20.60	
2.05	
<hr/>	
18.55	
10.50	215.18
<hr/>	
29.05	
5.95	
<hr/>	
24.10	

- 210.905 ✓
- 211.471 ✓
- 212.054 ✓
- 212.585 ✓
- 213.155 ✓
- 213.655 ✓

223.75

12.28 ✓
<hr/>
12.28 ✓
<hr/>
11.70 ✓
7
<hr/>
10.10 ✓

Sta	+	H.I.	-	I/CV	Grade
		215.72			
9+25					213.53
T.P.	3.21	218.00	0.93	214.79	
+50					214.06
B.M.	6.56	222.94	1.63	216.37	216.38
+75					214.56
10+00					215.75
+25					216.492
+50					218.379
+75					220.516
T.P.	5.01	229.59	1.86	221.08	
11+00					222.63
+25					225.13
+50					227.63
T.P.	11.38	239.60	1.37	228.22	
+75					230.13
12+00					232.63

Void

Pavement
Grade.

214.155 ✓

23.75

214.685 ✓

9.07 ✓

spike in tele pole Lt of sta 9+90

215.185 ✓

⁸²⁵
215.375 ✓

7.93

217.117 ✓

219.009 ✓

4.75 ✓

221.141 ✓

223.255 ✓


1.56

225.755 ✓

228.255 ✓

230.755 ✓

233.255 ✓

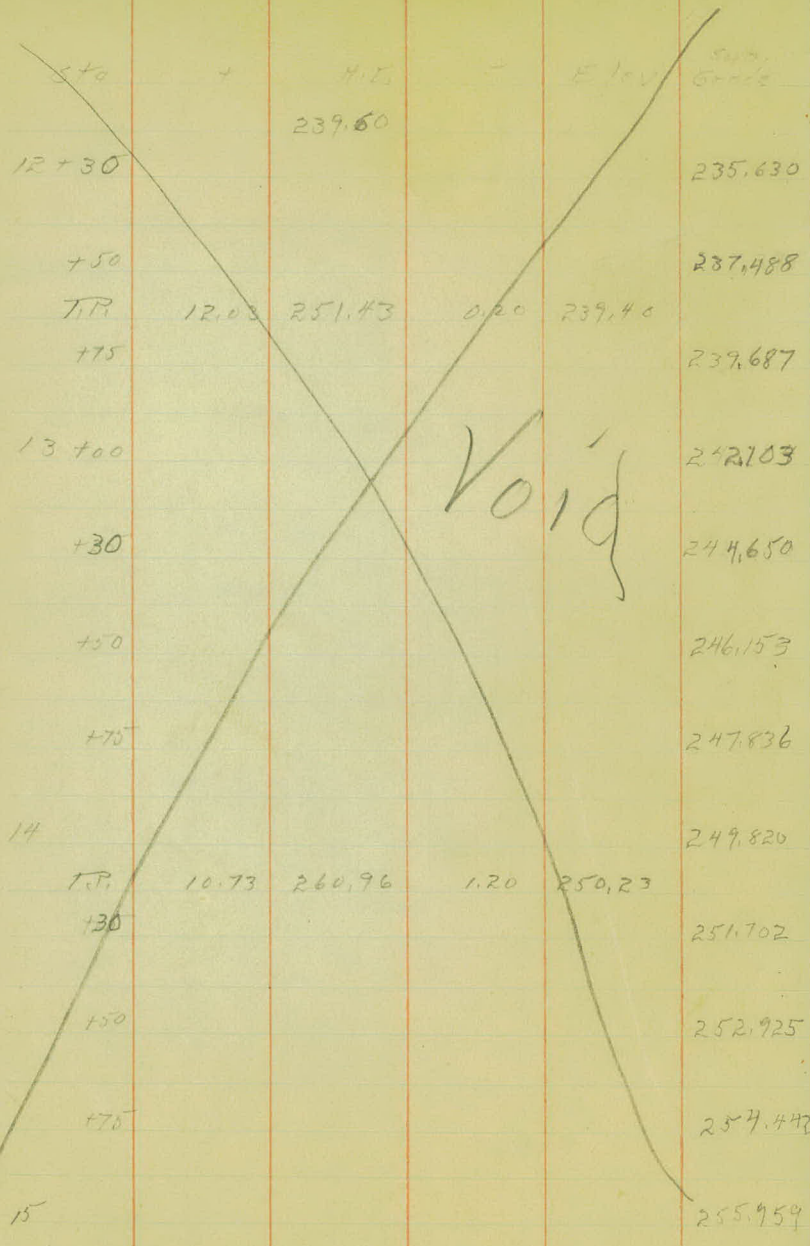

Pavement
Grade

236.255 ✓

238.113 ✓

240.312 ✓

242.728 ✓

245.275 ✓

246.778 ✓

248.461 ✓


250.445 ✓

252.327 ✓

253.550 ✓

255.067 ✓

256.584 ✓

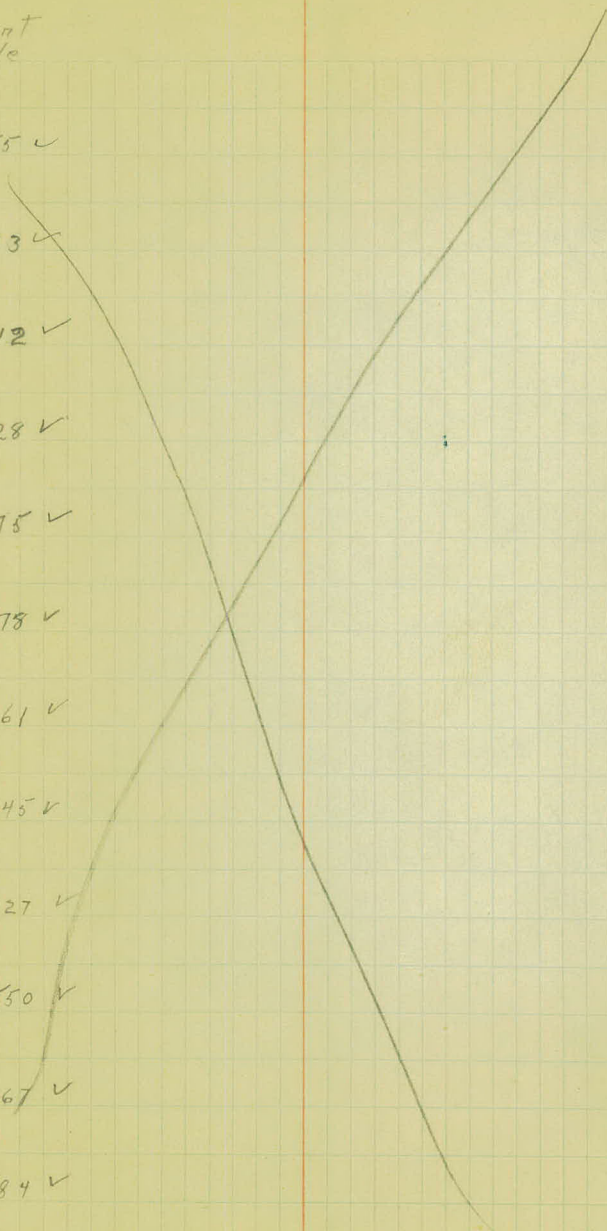

Sta		H.I.		Elev	Sub Grade
	+	260.96			
15+25					257.476
T.P.	9.67	267.84	2.79	268.17	
+50					258.994
+75					260.511
16+00					262.028
B.M.			3.43	264.41	

Void

See following page.

Pavement
Grade,

258.101 ✓

259.619

261.136

262.753

spike in tele pole harpenteur + Eustico

Sta					Sub.
B.M.	7.36	223.74			216.38
9					213.0
+25					213.50
+50					214.00
+80					214.63
10					215.20
+30					216.432
+50					217.9
+80					220.63
					22.6
11					22.6
I.P.	9.70	232.92	0.52	223.22	
+25					25.1
+50					27.6
+75					30.1

213.625

214.125

14.625

15.255

15.845

17.057

18.525

21.255

23.225

25.725

28.225

30.725

$$\begin{array}{r} 23.74 \\ 15.25 \\ \hline 8.49 \end{array}$$

$$\begin{array}{r} 23.74 \\ 15.84 \\ \hline 7.90 \end{array}$$

$$\begin{array}{r} 23.74 \\ 17.01 \\ \hline 6.73 \end{array}$$

$$\begin{array}{r} 23.74 \\ 18.52 \\ \hline 5.22 \end{array}$$

$$\begin{array}{r} 23.74 \\ 21.25 \\ \hline 2.49 \end{array}$$

$$\begin{array}{r} 23.74 \\ 23.22 \\ \hline 5.52 \end{array}$$

$$\begin{array}{r} 30.92 \\ 25.72 \\ \hline 5.20 \end{array}$$

$$\begin{array}{r} 32.92 \\ 28.22 \\ \hline 4.70 \end{array}$$

0932

Sta		32.92			Grade
T.P.	11.15	42.60	1.47	31.95	
12					32.6
+30					35.63
X					
+50					37.34
+75					39.725
T.P.	10.70	50.66	2.64	39.96	
13					42.1
+30					44.65
+50					46.2
+75					47.89
T.P.	10.16	258.53	2.29	248.37	
14					49.580
+30					51.7
+50					52.914
+75					54.428
15					55.96

$$\begin{array}{r} 2517 \\ 1821 \\ \hline 49.879 \\ 3.336 \\ \hline \end{array}$$

$$\begin{array}{r} 10.607 \\ 30 \\ \hline 1.821^0 \end{array}$$

$$\begin{array}{r} 50.1 \\ 1.113 \\ \hline 48.987 \end{array}$$

$$\begin{array}{r} 52.6 \\ 1.418 \\ \hline 51.182 \end{array}$$

33.225

50.7

$$\begin{array}{r} 42.60 \\ 33.22 \\ \hline 9.38 \end{array}$$

$$\begin{array}{r} 37.62 \\ 272 \\ \hline \end{array}$$

36.255

$$\begin{array}{r} 10.607 \\ 415 \\ \hline 30.35 \end{array}$$

$$\begin{array}{r} 10.607 \\ 20 \\ \hline 3035 \end{array}$$

$$\begin{array}{r} 37.892 \\ 37.348 \\ \hline \end{array}$$

37.965

$$\begin{array}{r} 20.28 \\ 51.70 \\ \hline 21.7315 \end{array}$$

$$\begin{array}{r} 1214 \\ 15175 \\ \hline \end{array}$$

$$\begin{array}{r} 40.12 \\ .395 \\ \hline 39.725 \end{array}$$

40.350

$$\begin{array}{r} 48.97 \\ 1416 \\ \hline 48.554 \end{array}$$

$$\begin{array}{r} 10.607 \\ 20 \\ \hline 12140 \end{array}$$

42.725

$$\begin{array}{r} 42.60 \\ 40.35 \\ \hline 2.25 \end{array}$$

$$\begin{array}{r} 42.60 \\ 36.25 \\ \hline 6.35 \end{array}$$

$$\begin{array}{r} 5291 \\ 1518 \\ \hline 54.428 \end{array}$$

45.275

$$\begin{array}{r} 42.60 \\ 37.96 \\ \hline 4.64 \end{array}$$

$$\begin{array}{r} 11518 \\ 55.968 \\ \hline 11518 \end{array}$$

46.825

$$\begin{array}{r} 50.66 \\ 42.72 \\ \hline 7.94 \end{array}$$

$$\begin{array}{r} 11518 \\ 57.478 \end{array}$$

48.515

$$\begin{array}{r} 50.66 \\ 46.82 \\ \hline 3.84 \end{array}$$

$$\begin{array}{r} 50.66 \\ 49.51 \\ \hline 1.15 \end{array}$$

$$\begin{array}{r} 58.53 \\ 48.51 \\ \hline 10.02 \end{array}$$

50.205

$$\begin{array}{r} 50.66 \\ 49.51 \\ \hline 1.15 \end{array}$$

$$\begin{array}{r} 58.53 \\ 56.58 \\ \hline 1.95 \end{array}$$

$$\begin{array}{r} 58.53 \\ 55.05 \\ \hline 3.48 \end{array}$$

52.325

53.639

55.053

56.585

58.53

7.8

11.46

67.12

2.87

55.66

16

62.032

+23.8

63.47

15 + 25

57.478

+50

57.996

+75

59.514

15, 11, 1

2.70

64.42

62,657

$$\begin{array}{r}
 67.12 \\
 62.65 \\
 \hline
 447
 \end{array}$$

$$\begin{array}{r}
 55,996 \\
 2,035 \\
 \hline
 57,995
 \end{array}$$

64,095

$$\begin{array}{r}
 57,478 \\
 1,518 \\
 \hline
 58,996 \\
 1,518 \\
 \hline
 60,514 \\
 1,518 \\
 \hline
 62,032
 \end{array}$$

58,103

58,621

$$\begin{array}{r}
 66.12 \\
 61.13 \\
 \hline
 4.99
 \end{array}$$

$$\begin{array}{r}
 62,032
 \end{array}$$

60,139

$$\begin{array}{r}
 66.12 \\
 58.10 \\
 \hline
 59.62 \\
 6.50 \\
 \hline
 66.12 \\
 61.13 \\
 \hline
 4.99
 \end{array}$$

23-65

Final X-sections

Sta	+	M.I.	-	Final
B.M.	180	266.23 ✓		264.43 ✓
16+738			2.7	64.0
16+10			3.1	63.1
16			3.7	62.5
15+50			6.7	59.5
15			9.7	
14+50				
14				
13+50				
13				
12+50				
12				
	0.01	255.56 ✓	10.68	255.55 ✓
14+50			2.1	53.5

10-24-23
 Fall - Worn
 Lt

conty
 persons
 Briggs
 Eck

Spike in hole pole N.W. corner lamp + Justice
 $\frac{3.1}{26}$ 2.2 $\frac{1.5}{33}$ Edge of paving

$\frac{3.2}{33}$ $\frac{3.2}{16}$ 3.6 $\frac{3.0}{12}$ $\frac{2.6}{18}$ $\frac{1.1}{22}$ $\frac{1.4}{26}$ h

$\frac{3.3}{23}$ $\frac{3.7}{12}$ 4.2 $\frac{3.6}{12}$ $\frac{4.0}{15}$ $\frac{4.0}{17}$ $\frac{3.6}{18}$ $\frac{3.2}{23}$ $\frac{0.9}{25}$ h
 stone

carb. $\frac{6.8}{18}$ $\frac{7.2}{18}$ $\frac{6.8}{12}$ 7.2 $\frac{6.9}{12}$ $\frac{7.5}{15}$ $\frac{7.5}{17}$ $\frac{6.9}{18}$ $\frac{6.8}{27}$ $\frac{5.8}{28}$ h
 stone

stone $\frac{10.6}{23}$ $\frac{10.0}{22}$ $\frac{9.8}{18}$ $\frac{10.5}{17}$ $\frac{10.6}{15}$ $\frac{9.8}{12}$ 10.3 $\frac{10.0}{12}$ $\frac{10.6}{15}$ $\frac{10.6}{17}$ $\frac{9.8}{18}$ $\frac{9.8}{21}$ $\frac{11.0}{22}$ h
 stone

13.3 $\frac{12.8}{24}$ h

16.5 stone $\frac{11.1}{21}$ $\frac{10.6}{24}$ $\frac{6.8}{29}$ h

20.0 stone $\frac{12.6}{24}$ $\frac{11.5}{29}$ $\frac{6.8}{36}$ $\frac{1.1}{41}$ h

24.1 $\frac{3.7}{41}$ h

28.6 $\left(\frac{250.5}{40}\right)$ $\frac{9.1}{42}$ h

33.6 $\left(\frac{248.9}{31}\right)$ h

Average thickness
 of wall = 1.5

stone $\frac{1.9}{28}$ $\frac{2.4}{24}$ $\frac{2.3}{18}$ $\frac{2.8}{16}$ $\frac{2.8}{15}$ $\frac{2.2}{12}$ 2.7 $\frac{2.3}{12}$ $\frac{3.1}{16}$ $\frac{3.1}{17}$ $\frac{2.4}{18}$ $\frac{1.9}{25}$ h
 stone

Sta	T	H.I			
	0.01	255.56			
14			5.4	50.2	
13+50			8.9	46.7	
13					
12+50					
12					
	T.P.	2.34	245.80 ✓	12.10	243.46 ✓
13			3.2	42.6	
12+50			7.8	38.0	
12					
11+50					
11					
10+50					
	T.P.	1.03	236.55 ✓	10.28	235.52 ✓
12			3.4	33.2	

LT

±

RT

stone
 $\frac{2.6}{26}$ $\frac{5.5}{21}$ $\frac{5.7}{18}$ $\frac{6.3}{17}$ $\frac{6.3}{15}$

5.1 $\frac{5.9}{12}$ $\frac{5.6}{12}$ $\frac{6.1}{15}$ $\frac{6.1}{17}$

Bottom of Wall

h

stone
 $\left(\frac{257.0}{37}\right)$ $\frac{8.5}{23}$ $\frac{9.0}{18}$ $\frac{9.6}{18}$ $\frac{9.7}{16}$

9.0 $\frac{9.4}{12}$ $\frac{9.1}{12}$ $\frac{10.0}{15}$ $\frac{9.8}{17}$

Top of Wall

$\frac{2.2}{24}$ $\frac{0.7}{29}$

h

h $\frac{0.8}{34}$

$\frac{13.0}{12}$

h $\frac{2.3}{39}$ $\frac{6.3}{36}$

$\frac{18.0}{12}$

h $\frac{6.6}{36}$ $\frac{12.0}{33}$

$\frac{23.0}{12}$

stone
 $\frac{3.4}{18}$ $\frac{4.1}{17}$ $\frac{4.0}{15}$ $\frac{3.4}{12}$

$\frac{3.7}{12}$

$\frac{3.4}{12}$ $\frac{4.1}{15}$ $\frac{4.0}{17}$ $\frac{3.5}{18}$

stone Top of Wall
 $\left(\frac{249.4}{25}\right)$ $\left(\frac{250.0}{29}\right)$

h

Top wall R $\frac{0.4}{31}$ $\frac{1.1}{25}$ $\frac{0.7}{17}$ $\frac{0.6}{14}$ $\frac{0.0}{12}$ $\frac{0.2}{12}$ L $\frac{7.9}{12}$ $\frac{8.1}{14}$ $\frac{8.7}{15}$ $\frac{0.7}{17}$ stone

h

$\frac{13.2}{12}$

Top of Wall
 $\frac{9.4}{22}$ $\frac{9.2}{24}$

h

$\frac{4.1}{34}$ $\frac{12.1}{28}$

$\frac{18.2}{12}$

$\frac{12.0}{28}$ $\frac{4.7}{33}$

h

$\frac{8.6}{36}$

$\frac{23.2}{12}$

$\frac{11.6}{30}$

h

$\frac{239.80}{33}$

$\frac{27.4}{12}$

stone
 $\frac{3.6}{18}$ $\frac{4.2}{17}$ $\frac{4.3}{15}$ $\frac{3.8}{14}$ $\frac{3.6}{12}$

$\frac{4.0}{12}$

$\frac{3.6}{12}$ $\frac{4.4}{15}$ $\frac{4.3}{17}$

Bottom of Wall

h

Sta	T	H.I	-	Elev
	1.03	286.55		
11+50			8.5	28.1
T.P.	0.47	225.23 ✓	11.79	224.76 ✓
11			2.1	23.1
10+50			6.6	18.6
10			9.1	16.1
B.M.	1.51	217.89 ✓	8.75	216.48 ✓ 216.38
9+50			-3.2	14.7
9			4.2	13.7
8			6.3	11.6
T.P.	1.87	211.16 ✓	8.60	209.29 ✓
7			2.0	09.2
6			4.4	06.8
5			6.8	04.4
4			9.2	02.0
T.P.	0.22	201.05 ✓	10.33	200.83 ✓
3			1.6	99.5

LT 4 RT

stone
 $\frac{8.4}{20}$ $\frac{8.7}{18}$ $\frac{9.4}{17}$ $\frac{9.5}{15}$ $\frac{8.6}{12}$ 9.0 $\frac{8.6}{12}$ $\frac{9.4}{15}$ $\frac{9.4}{17}$ $\frac{8.7}{18}$ $\frac{8.2}{21}$ h

stone
 $\frac{2.6}{18}$ $\frac{2.9}{17}$ $\frac{2.9}{15}$ $\frac{2.3}{12}$ 2.6 $\frac{2.2}{12}$ $\frac{3.1}{15}$ $\frac{2.9}{18}$ $\frac{2.2}{18}$ $\left(\frac{227.2}{27}\right)$ h

stone
 $\frac{1.7}{29}$ $\frac{5.1}{24}$ $\frac{6.8}{18}$ $\frac{7.4}{17}$ $\frac{7.5}{15}$ $\frac{6.8}{12}$ 7.3 $\frac{6.9}{12}$ $\frac{7.4}{14}$ $\frac{7.4}{17}$ $\frac{5.8}{21}$ $\frac{3.8}{24}$ $\frac{4.7}{27}$ h

stone
 $\frac{8.2}{30}$ $\frac{9.8}{26}$ $\frac{9.4}{18}$ $\frac{9.9}{17}$ $\frac{9.9}{15}$ $\frac{9.3}{12}$ 10.0 $\frac{9.1}{12}$ $\frac{10.1}{16}$ $\frac{10.1}{18}$ $\frac{9.7}{15}$ $\frac{10.5}{23}$ $\left(\frac{211.2}{29}\right)$ o

Spike in telepole 1A of 9 + 90

$\frac{4.0}{29}$ $\frac{3.5}{19}$ $\frac{3.2}{12}$ 3.0 $\frac{3.0}{12}$ $\frac{3.7}{20}$ $\frac{11.0}{33}$ h

$\frac{6.5}{36}$ $\frac{5.8}{27}$ $\frac{4.4}{18}$ $\frac{4.2}{12}$ 6.2 $\frac{4.3}{12}$ $\frac{4.3}{18}$ $\frac{12.8}{33}$ h

$\frac{8.7}{44}$ $\frac{13.0}{33}$ $\frac{6.3}{20}$ $\frac{6.4}{12}$ 7.0 $\frac{6.5}{12}$ $\frac{6.7}{17}$ $\frac{13.5}{33}$ h

$\frac{10.4}{38}$ $\frac{2.3}{20}$ $\frac{2.1}{12}$ 2.7 $\frac{2.1}{12}$ $\frac{2.3}{17}$ $\frac{10.4}{34}$ h

$\frac{12.7}{35}$ $\frac{4.7}{21}$ $\frac{4.5}{12}$ 5.1 $\frac{4.5}{12}$ $\frac{4.7}{19}$ $\frac{11.4}{32}$ h

$\frac{9.1}{38}$ $\frac{7.9}{21}$ $\frac{7.2}{18}$ $\frac{6.9}{12}$ 7.6 $\frac{7.0}{12}$ $\frac{7.3}{30}$ $\frac{7.0}{31}$ h

$\frac{10.8}{30}$ $\frac{10.2}{22}$ $\frac{9.4}{24}$ $\frac{9.3}{12}$ 12.0 $\frac{9.4}{12}$ $\frac{9.8}{19}$ $\frac{13.3}{29}$ $\frac{14.0}{34}$ h

$\frac{3.1}{28}$ $\frac{2.8}{22}$ $\frac{1.9}{19}$ $\frac{1.6}{12}$ 2.4 $\frac{1.7}{12}$ $\frac{2.0}{21}$ $\frac{5.0}{27}$ $\frac{5.3}{30}$ h

Sta	+	H.I.	-	Elev
	0.22	201.05		
2			4.0	97.1
1			6.4	94.7
0 + 14			8.6	92.5
0			9.0	92.1
B.M.			6.40	194.65 ✓ 194.63

RT \neq LT

$\frac{6.1}{36}$ $\frac{5.2}{22}$ $\frac{4.4}{19}$ $\frac{4.1}{12}$ $\frac{4.1}{12}$ $\frac{4.1}{21}$ $\frac{6.1}{26}$ $\frac{6.0}{30}$

8.8

$\frac{7.4}{34}$ $\frac{7.3}{26}$ $\frac{7.9}{24}$ $\frac{7.8}{23}$ $\frac{6.6}{20}$ $\frac{6.5}{14}$ $\frac{6.5}{13}$ $\frac{6.7}{21}$ $\frac{7.3}{23}$ $\frac{7.1}{24}$ $\frac{4.6}{27}$

7.3

$\frac{8.9}{22}$ $\frac{9.1}{16}$ $\frac{9.3}{15}$ $\frac{8.6}{18}$ $\frac{8.6}{18}$ $\frac{9.1}{21}$ $\frac{9.1}{23}$ $\frac{6.5}{28}$

9.4

$\frac{9.6}{25}$ $\frac{8.9}{15}$ $\frac{8.9}{23}$ $\frac{6.7}{27}$ $\frac{6.8}{32}$

9.7

Top of hydrant corner Eastica + Congo.

7+00

6+00

5+00

4+00


3+00

2+00

1+00

0+00

LT ♀ RT

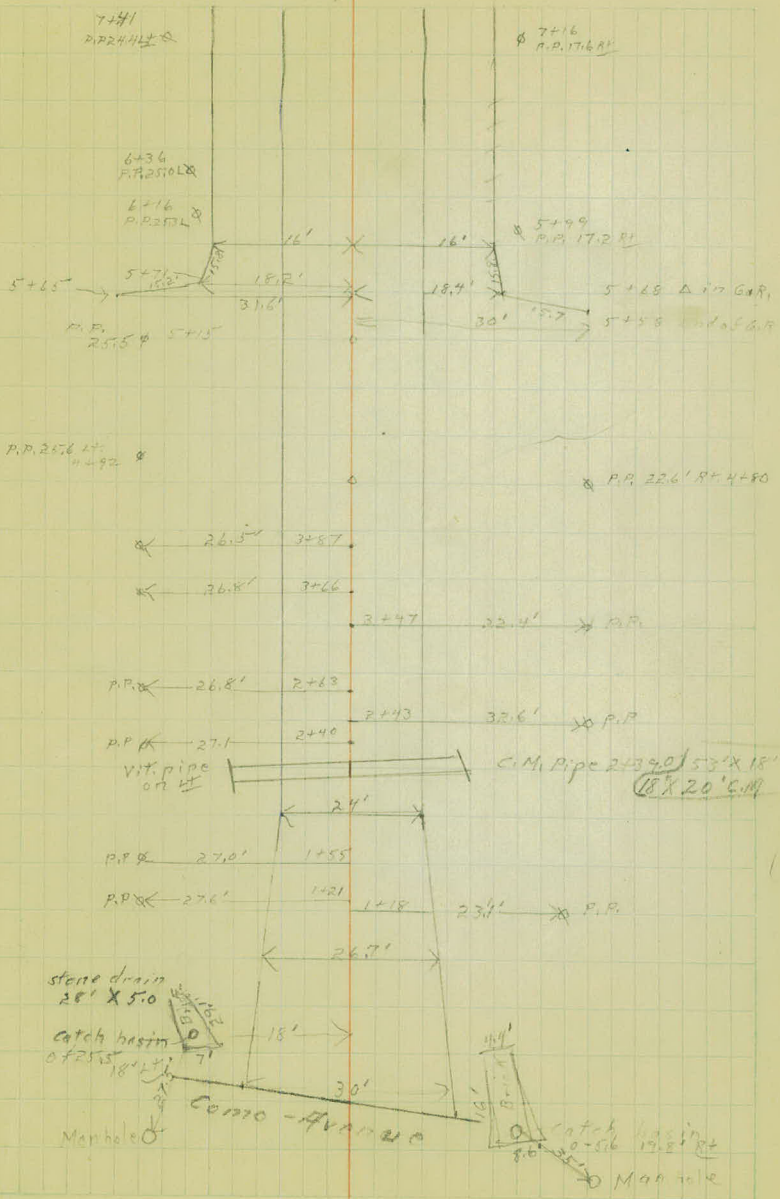

16

End of retaining wall 14+22

14

13

12

Retaining wall on the right front
sta 11+23.4 to sta

11

Average thickness of
wall 1.5'


10

Cobble stone ^{fill} begins P&T - 9+90
9+57.8 End of concrete
9+78.8 beginning of brick.

9


8

Perpendicular 16+23.8

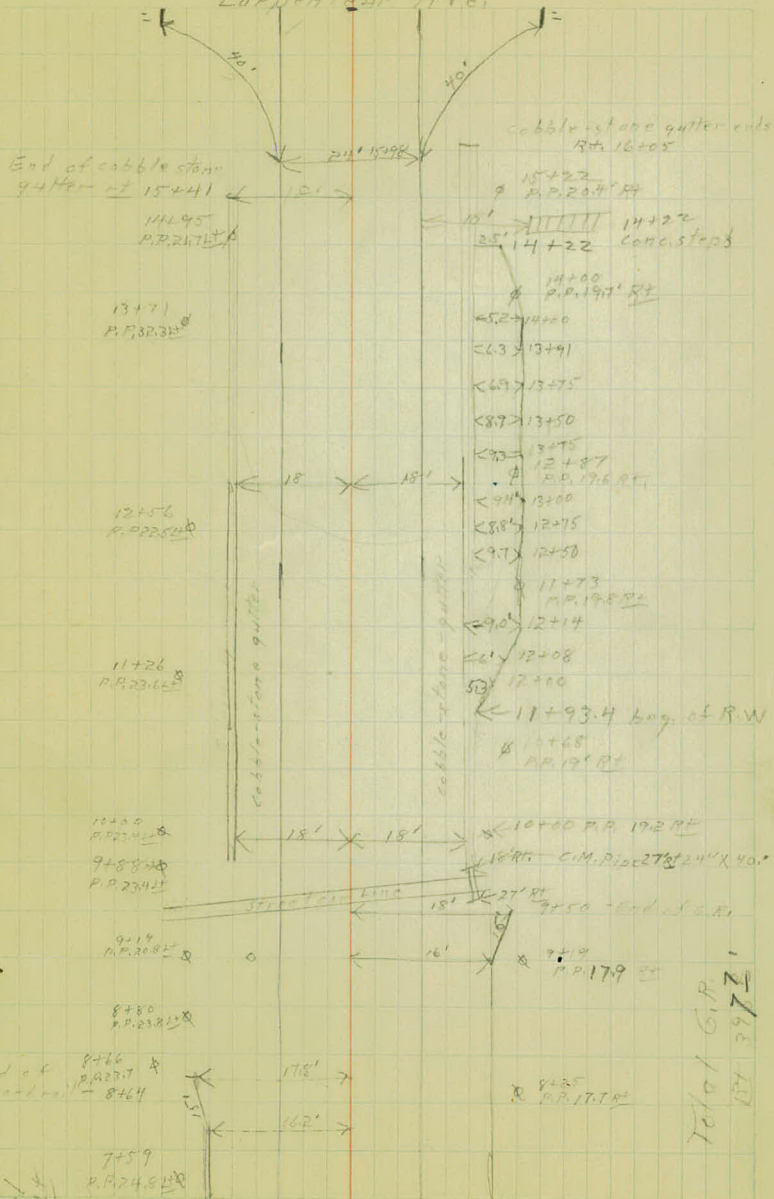

Total G.R. 177' 397'


Total G.R. 177' 397'

 


Carley
Parrish
B-1995
Eckl
Rose Hill Nursery

cloudy-cold.

10-24-23

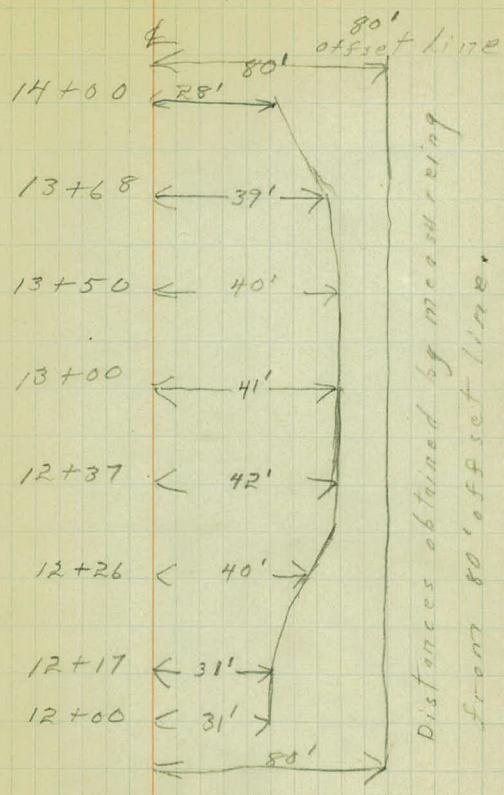


Distances obtained by measuring from 80' offset line.

 

DIETZGEN'S RAILROAD CURVE AND REDUCTION TABLES

Copyright, 1914, by Eugene Dietzgen Co., New York City

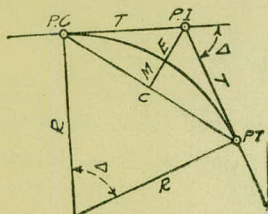

CURVE FORMULAS

$$\text{Radius} = R = \frac{50}{\sin. D/2} \quad (1) \quad \text{Degree of Curve} = D \text{ and } \sin. \frac{D}{2} = \frac{50}{R} \quad (2)$$

$$\text{Tangent} = T = R \tan \frac{\Delta}{2} \quad (3) \quad \text{Length of Curve} = L = 100 \frac{\Delta}{D} \quad (4)$$

$$\text{Middle ordinate} = M = R(1 - \cos. \frac{\Delta}{2}) \quad (5) = R \text{vers} \frac{\Delta}{2} \quad (6)$$

$$\text{External} = E = T \tan \frac{\Delta}{4} \quad (7) = R \div \cos. \frac{\Delta}{2} - R \quad (8) = R \text{exsec} \frac{\Delta}{2} \quad (9)$$

$$\text{Long Chord} = C = 2 R \sin. \frac{\Delta}{2} \quad (10) \quad \Delta = \text{Central Angle}$$

EXPLANATION AND USE OF TABLES

Stations.—Given P. I.—Sta. 161 + 60.35 to find Sta. of P. C. and P. T. $\Delta = 62^\circ 10'$ $D = 8^\circ 20'$. From Table IV for 1° curve $T = 3454.1$ and $\div 8\frac{1}{3} = 414.49$ ft. From Table V correction = .36 or $T = 414.85$ ft. P. C. = Sta. P. I. — $T = 157 + 45.50$. Also from (4) $L = 746.00$ and P. T. = Sta. P. C. + $L = 164 + 91.50$.

Offsets.—Tangent offsets vary (approximately) directly with D and with square of the distance. Thus tangent offset for Sta. 158 on above curve is 2.16 ft. found as follows. From Table III tangent offset for 100 ft. = 7.27 ft. Distance = 158 — Sta. P. C. = 54.50, hence offset = $7.27 (54.50 \div 100)^2 = 2.16$ ft. Also square of any distance divided by twice the radius equals (approximately) the distance from tangent to curve. Thus $(54.50)^2 \div (2 \times 688.26) = 2.16$ ft.

Deflections.—Deflection angle = $\frac{1}{2} D$ for 100 ft., $\frac{1}{4} D$ for 50 ft., etc. For c ft. = $(n \text{ minutes}) .3 \times C \times D^\circ$ or = defl. for 1 ft. from Table III $\times C$. For Sta. 158 of above curve = $.3 \times 54.5 \times 8\frac{1}{3} = 136.2'$ or $2^\circ 16.2'$, or = $2.50 \times 54.5 = 136.2'$ from Table III. For Sta. 159 deflection angle = $2^\circ 16.2' + 8^\circ 20' \div 2 = 6^\circ 26.2'$, etc.

Externals.—May be found in similar manner to tangents. Thus E for curve above is 91.37. For from Table IV for 1° curve $E = 960.6$ for $8^\circ 20' = 960.6 \div 8\frac{1}{3} = 91.27$ and from Table V correction = .10 or $E = 91.37$ ft. Or suppose $\Delta = 32^\circ$ and E is measured and found to be 42 ft. What is D ? From Table IV $E = 230.9$ and $\div 42 = 5.5$ or $D = 5^\circ 30'$.

TABLE I.—MINUTES IN DECIMALS OF A DEGREE.

1'	.0167	11'	.1833	21'	.3500	31'	.5167	41'	.6833	51'	.8500
2	.0333	12	.2000	22	.3667	32	.5333	42	.7000	52	.8667
3	.0500	13	.2167	23	.3833	33	.5500	43	.7167	53	.8833
4	.0667	14	.2333	24	.4000	34	.5667	44	.7333	54	.9000
5	.0833	15	.2500	25	.4167	35	.5833	45	.7500	55	.9167
6	.1000	16	.2667	26	.4333	36	.6000	46	.7667	56	.9333
7	.1167	17	.2833	27	.4500	37	.6167	47	.7833	57	.9500
8	.1333	18	.3000	28	.4667	38	.6333	48	.8000	58	.9667
9	.1500	19	.3167	29	.4833	39	.6500	49	.8167	59	.9833
10	.1667	20	.3333	30	.5000	40	.6667	50	.8333	60	1.0000

TABLE II.—INCHES IN DECIMALS OF A FOOT.

1-16	3-32	¼	3-16	¼	5-16	¾	½	¾	¾	¾
.0052	.0078	.0104	.0156	.0208	.0260	.0313	.0417	.0521	.0625	.0729
1	2	3	4	5	6	7	8	9	10	11
.0833	.1667	.2500	.3333	.4167	.5000	.5833	.6667	.7500	.8333	.9167

TABLE III.—RADI, ORDINATES AND DEFLECTIONS.

Deg.	Radius	Mid. Ord.	Tan. Offset	Def. for 1 Foot	Deg.	Radius	Mid. Ord.	Tan. Offset	Def. for 1 Foot	
0°	10'	34377.5	.036	.145	0.05'	7°	819.02	1.528	6.105	2.10'
	20	17188.8	.073	.291	0.10	20'	781.84	1.600	6.395	2.20
	30	11459.2	.109	.436	0.15	30	764.49	1.637	6.540	2.25
	40	8594.42	.145	.582	0.20	40	747.89	1.673	6.685	2.30
	50	6875.55	.182	.727	0.25					
					8	716.78	1.746	6.976	2.40	
1		5729.65	.218	.873	0.30	20	688.16	1.819	7.266	2.50
	10	4911.15	.255	1.018	0.35	30	674.69	1.855	7.411	2.55
	20	4297.28	.291	1.164	0.40	40	661.74	1.892	7.556	2.60
	30	3819.83	.327	1.309	0.45					
	40	3437.87	.364	1.454	0.50	9	637.28	1.965	7.846	2.70
	50	3125.36	.400	1.600	0.55	20	614.56	2.037	8.136	2.80
					30	603.80	2.074	8.281	2.85	
2		2864.93	.436	1.745	0.60	40	593.42	2.110	8.426	2.90
	10	2644.58	.473	1.891	0.65					
	20	2455.70	.509	2.036	0.70	10	573.69	2.153	8.716	3.00
	30	2292.01	.545	2.181	0.75	30	546.44	2.292	9.150	3.15
	40	2148.79	.582	2.327	0.80	11	521.67	2.402	9.585	3.30
	50	2022.41	.618	2.472	0.85	30	499.06	2.511	10.02	3.45
					12	478.34	2.620	10.45	3.60	
3		1910.08	.655	2.618	0.90	30	459.28	2.730	10.89	3.75
	10	1809.57	.691	2.763	0.95	13	441.68	2.839	11.32	3.90
	20	1719.12	.727	2.908	1.00	30	425.40	2.949	11.75	4.05
	30	1637.28	.764	3.054	1.05	14	410.28	3.058	12.18	4.20
	40	1562.88	.800	3.199	1.10	30	396.20	3.168	12.62	4.35
	50	1494.95	.836	3.345	1.15					
					15	383.07	3.277	13.05	4.50	
4		1432.69	.873	3.490	1.20	30	370.78	3.387	13.49	4.65
	10	1375.40	.909	3.635	1.25	16	359.27	3.496	13.92	4.80
	20	1322.53	.945	3.718	1.30	30	348.45	3.606	14.35	4.95
	30	1273.57	.982	3.926	1.35	17	338.27	3.716	14.78	5.10
	40	1228.11	1.018	4.071	1.40	18	319.62	3.935	15.64	5.40
	50	1185.78	1.055	4.217	1.45	19	302.94	4.155	16.51	5.70
					20	287.94	4.374	17.37	6.00	
5		1146.28	1.091	4.362	1.50	21	274.37	4.594	18.22	6.30
	10	1109.33	1.127	4.507	1.55	22	262.04	4.814	19.08	6.60
	20	1074.68	1.164	4.653	1.60	23	250.79	5.035	19.94	6.90
	30	1042.14	1.200	4.798	1.65	24	240.49	5.255	20.79	7.20
	40	1011.51	1.237	4.943	1.70					
	50	982.64	1.273	5.088	1.75	25	231.01	5.476	21.64	7.50
					26	222.27	5.697	22.50	7.80	
6		955.37	1.309	5.234	1.80	27	214.18	5.918	23.35	8.10
	10	929.57	1.346	5.379	1.85	28	206.68	6.139	24.19	8.40
	20	905.13	1.382	5.524	1.90	29	199.70	6.360	25.04	8.70
	30	881.95	1.418	5.669	1.95	30	193.18	6.583	25.88	9.00
	40	859.92	1.455	5.814	2.00					

Note. Chord Deflection=2 times tangent deflection.

TABLE IV.—TANGENTS AND EXTERNALS TO A 1° CURVE.

Central Angle	Tangent	External	Central Angle	Tangent	External	Central Angle	Tangent	External
1°	50.00	.22	11°	551.70	26.50	21°	1061.9	97.57
10'	58.34	.30	10'	560.11	27.31	10'	1070.6	99.16
20	66.67	.39	20	568.53	28.14	20	1079.2	100.75
30	75.01	.49	30	576.95	28.97	30	1087.8	102.35
40	83.34	.61	40	585.36	29.82	40	1096.4	103.97
50	91.68	.73	50	593.79	30.68	50	1105.1	105.60
2	100.01	.87	12	602.21	31.56	22	1113.7	107.24
10	108.35	1.02	10	610.64	32.45	10	1122.4	108.90
20	116.68	1.19	20	619.07	33.35	20	1131.0	110.57
30	125.02	1.36	30	627.50	34.26	30	1139.7	112.25
40	133.36	1.55	40	635.93	35.18	40	1148.4	113.95
50	141.70	1.75	50	644.37	36.12	50	1157.0	115.66
3	150.04	1.96	13	652.81	37.07	23	1165.7	117.38
10	158.38	2.19	10	661.25	38.03	10	1174.4	119.12
20	166.72	2.43	20	669.70	39.01	20	1183.1	120.87
30	175.06	2.67	30	678.15	39.99	30	1191.8	122.63
40	183.40	2.93	40	686.60	40.99	40	1200.5	124.41
50	191.74	3.21	50	695.06	42.00	50	1209.2	126.20
4	200.08	3.49	14	703.51	43.03	24	1217.9	128.00
10	208.43	3.79	10	711.97	44.07	10	1226.6	129.82
20	216.77	4.10	20	720.44	45.12	20	1235.3	131.65
30	225.12	4.42	30	728.90	46.18	30	1244.0	133.50
40	233.47	4.76	40	737.37	47.25	40	1252.8	135.35
50	241.81	5.10	50	745.85	48.34	50	1261.5	137.23
5	250.16	5.46	15	754.32	49.44	25	1270.2	139.11
10	258.51	5.83	10	762.80	50.55	10	1279.0	141.01
20	266.86	6.21	20	771.29	51.68	20	1287.7	142.93
30	275.21	6.61	30	779.77	52.89	30	1296.5	144.85
40	283.57	7.01	40	788.26	53.97	40	1305.3	146.79
50	291.92	7.43	50	796.75	55.13	50	1314.0	148.75
6	300.28	7.86	16	805.25	56.31	26	1322.8	150.71
10	308.64	8.31	10	813.75	57.50	10	1331.6	152.69
20	316.99	8.76	20	822.25	58.70	20	1340.4	154.69
30	325.35	9.23	30	830.76	59.91	30	1349.2	156.70
40	333.71	9.71	40	839.27	61.14	40	1358.0	158.72
50	342.08	10.20	50	847.78	62.38	50	1366.8	160.76
7	350.44	10.71	17	856.30	63.63	27	1375.6	162.81
10	358.81	11.22	10	864.82	64.90	10	1384.4	164.86
20	367.17	11.75	20	873.35	66.18	20	1393.2	166.95
30	375.54	12.29	30	881.88	67.47	30	1402.0	169.04
40	383.91	12.85	40	890.41	68.77	40	1410.9	171.15
50	392.28	13.41	50	898.95	70.09	50	1419.7	173.27
8	400.66	13.99	18	907.49	71.42	28	1428.6	175.41
10	409.03	14.58	10	916.03	72.76	10	1437.4	177.55
20	417.41	15.18	20	924.58	74.12	20	1446.3	179.72
30	425.79	15.80	30	933.13	75.49	30	1455.1	181.89
40	434.17	16.43	40	941.69	76.86	40	1464.0	184.08
50	442.55	17.07	50	950.25	78.26	50	1472.9	186.29
9	450.93	17.72	19	958.81	79.67	29	1481.8	188.51
10	459.32	18.38	10	967.38	81.09	10	1490.7	190.74
20	467.71	19.06	20	975.96	82.53	20	1499.6	192.99
30	476.10	19.75	30	984.53	83.97	30	1508.5	195.25
40	484.49	20.45	40	993.12	85.43	40	1517.4	197.53
50	492.88	21.16	50	1001.7	86.90	50	1526.3	199.82
10	501.28	21.89	20	1010.3	88.39	30	1535.3	202.12
10	509.68	22.62	10	1018.9	89.89	10	1544.2	204.44
20	518.08	23.38	20	1027.5	91.40	20	1553.1	206.77
30	526.48	24.14	30	1036.1	92.92	30	1562.1	209.12
40	534.89	24.91	40	1044.7	94.46	40	1571.0	211.48
50	543.29	25.70	50	1053.3	96.01	50	1580.0	213.86

TABLE IV.—TANGENTS AND EXTERNALS TO A 1° CURVE.

Central Angle	Tangent	External	Central Angle	Tangent	External	Central Angle	Tangent	External
31°	1589.0	216.3	41°	2142.2	387.4	51°	2732.9	618.4
10'	1598.0	218.7	10'	2151.7	390.7	10'	2743.1	622.8
20	1606.9	221.1	20	2161.2	394.1	20	2753.4	627.2
30	1615.9	223.5	30	2170.8	397.4	30	2763.7	631.7
40	1624.9	226.0	40	2180.3	400.8	40	2773.9	636.2
50	1633.9	228.4	50	2189.9	404.2	50	2784.2	640.7
32	1643.0	230.9	42	2199.4	407.6	52	2794.5	645.2
10	1652.0	233.4	10	2209.0	411.1	10	2804.9	649.7
20	1661.0	235.9	20	2218.6	414.5	20	2815.2	654.3
30	1670.0	238.4	30	2228.1	418.0	30	2825.6	658.8
40	1679.1	241.0	40	2237.7	421.4	40	2835.9	663.4
50	1688.1	243.5	50	2247.3	425.0	50	2846.3	668.0
33	1697.2	246.1	43	2257.0	428.5	53	2856.7	672.7
10	1706.3	248.7	10	2266.6	432.0	10	2867.1	677.3
20	1715.3	251.3	20	2276.2	435.6	20	2877.5	682.0
30	1724.4	253.9	30	2285.9	439.2	30	2888.0	686.7
40	1733.5	256.5	40	2295.6	442.8	40	2898.4	691.4
50	1742.6	259.1	50	2305.2	446.4	50	2908.9	696.1
34	1751.7	261.8	44	2314.9	450.0	54	2919.4	700.9
10	1760.8	264.5	10	2324.6	453.6	10	2929.9	705.7
20	1770.0	267.2	20	2334.3	457.3	20	2940.4	710.5
30	1779.1	269.9	30	2344.1	461.0	30	2951.0	715.3
40	1788.2	272.6	40	2353.8	464.6	40	2961.5	720.1
50	1797.4	275.3	50	2363.5	468.4	50	2972.1	725.0
35	1806.6	278.1	45	2373.3	472.1	55	2982.7	729.9
10	1815.7	280.8	10	2383.1	475.8	10	2993.3	734.8
20	1824.9	283.6	20	2392.8	479.6	20	3003.9	739.7
30	1834.1	286.4	30	2402.6	483.3	30	3014.5	744.6
40	1843.3	289.2	40	2412.4	487.2	40	3025.2	749.6
50	1852.5	292.0	50	2422.3	491.0	50	3035.8	754.6
36	1861.7	294.9	46	2432.1	494.8	56	3046.5	759.6
10	1870.9	297.7	10	2441.9	498.7	10	3057.2	764.6
20	1880.1	300.6	20	2451.8	502.5	20	3067.9	769.7
30	1889.4	303.5	30	2461.7	506.4	30	3078.7	774.7
40	1898.6	306.4	40	2471.5	510.3	40	3089.4	779.8
50	1907.9	309.3	50	2481.4	514.3	50	3100.2	784.9
37	1917.1	312.2	47	2491.3	518.2	57	3110.9	790.1
10	1926.4	315.2	10	2501.2	522.2	10	3121.7	795.2
20	1935.7	318.1	20	2511.2	526.1	20	3132.6	800.4
30	1945.0	321.1	30	2521.1	530.1	30	3143.4	805.6
40	1954.3	324.1	40	2531.1	534.2	40	3154.2	810.9
50	1963.6	327.1	50	2541.0	538.2	50	3165.1	816.1
38	1972.9	330.2	48	2551.0	542.2	58	3176.0	821.4
10	1982.2	333.2	10	2561.0	546.3	10	3186.9	826.7
20	1991.5	336.3	20	2571.0	550.4	20	3197.8	832.0
30	2000.9	339.3	30	2581.0	554.5	30	3208.8	837.3
40	2010.2	342.4	40	2591.0	558.6	40	3219.7	842.7
50	2019.6	345.5	50	2601.1	562.8	50	3230.7	848.1
39	2029.0	348.6	49	2611.2	566.9	59	3241.7	853.5
10	2038.4	351.8	10	2621.2	571.1	10	3252.7	858.9
20	2047.8	354.9	20	2631.3	575.3	20	3263.7	864.3
30	2057.2	358.1	30	2641.4	579.5	30	3274.8	869.8
40	2066.6	361.3	40	2651.5	583.8	40	3285.8	875.3
50	2076.0	364.5	50	2661.6	588.0	50	3296.9	880.8
40	2085.4	367.7	50	2671.8	592.3	60	3308.0	886.4
10	2094.9	371.0	10	2681.9	596.6	10	3319.1	892.0
20	2104.3	374.2	20	2692.1	600.9	20	3330.3	897.5
30	2113.8	377.5	30	2702.3	605.3	30	3341.4	903.2
40	2123.3	380.8	40	2712.5	609.6	40	3352.6	908.8
50	2132.7	384.1	50	2722.7	614.0	50	3363.8	914.5

TABLE IV.—TANGENTS AND EXTERNALS TO A 1° CURVE.

Central Angle	Tangent	External	Central Angle	Tangent	External	Central Angle	Tangent	External
61°	3375.0	920.2	71°	4086.9	1308.2	81°	4893.6	1805.3
10'	3386.3	925.9	10'	4099.5	1315.6	10'	4908.0	1814.7
20	3397.5	931.6	20	4112.1	1322.9	20	4922.5	1824.1
30	3408.8	937.3	30	4124.8	1330.3	30	4937.0	1833.6
40	3420.1	943.1	40	4137.4	1337.7	40	4951.5	1843.1
50	3431.4	948.9	50	4150.1	1345.1	50	4966.1	1852.6
62	3442.7	954.8	72	4162.8	1352.6	82	4980.7	1862.2
10	3454.1	960.6	10	4175.6	1360.1	10	4995.4	1871.8
20	3465.4	966.5	20	4188.5	1367.6	20	5010.0	1881.5
30	3476.8	972.4	30	4201.2	1375.2	30	5024.8	1891.2
40	3488.3	978.3	40	4214.0	1382.8	40	5039.5	1900.9
50	3499.7	984.3	50	4226.8	1390.4	50	5054.3	1910.7
63	3511.1	990.2	73	4239.7	1398.0	83	5069.2	1920.5
10	3522.6	996.2	10	4252.6	1405.7	10	5084.0	1930.4
20	3534.1	1002.3	20	4265.6	1413.5	20	5099.0	1940.3
30	3545.6	1008.3	30	4278.5	1421.2	30	5113.9	1950.3
40	3557.2	1014.4	40	4291.5	1429.0	40	5128.9	1960.2
50	3568.7	1020.5	50	4304.6	1436.8	50	5143.9	1970.3
64	3580.3	1026.6	74	4317.6	1444.6	84	5159.0	1980.4
10	3591.9	1032.8	10	4330.7	1452.5	10	5174.1	1990.5
20	3603.5	1039.0	20	4343.8	1460.4	20	5189.3	2000.6
30	3615.1	1045.2	30	4356.9	1468.4	30	5204.4	2010.8
40	3626.8	1051.4	40	4370.1	1476.4	40	5219.7	2021.1
50	3638.5	1057.7	50	4383.3	1484.4	50	5234.9	2031.4
65	3650.2	1063.9	75	4396.5	1492.4	85	5250.3	2041.7
10	3661.9	1070.2	10	4409.8	1500.5	10	5265.6	2052.1
20	3673.7	1076.6	20	4423.1	1508.6	20	5281.0	2062.5
30	3685.4	1082.9	30	4436.4	1516.7	30	5296.4	2073.0
40	3697.2	1089.3	40	4449.7	1524.9	40	5311.9	2083.5
50	3709.0	1095.7	50	4463.1	1533.1	50	5327.4	2094.1
66	3720.9	1102.2	76	4476.5	1541.4	86	5343.0	2104.7
10	3732.7	1108.6	10	4489.9	1549.7	10	5358.6	2115.3
20	3744.6	1115.1	20	4503.4	1558.0	20	5374.2	2126.0
30	3756.5	1121.7	30	4516.9	1566.3	30	5389.9	2136.7
40	3768.5	1128.2	40	4530.4	1574.7	40	5405.6	2147.5
50	3780.4	1134.8	50	4544.0	1583.1	50	5421.4	2158.4
67	3792.4	1141.4	77	4557.6	1591.6	87	5437.2	2169.2
10	3804.4	1148.0	10	4571.2	1600.1	10	5453.1	2180.2
20	3816.4	1154.7	20	4584.8	1608.6	20	5469.0	2191.1
30	3828.4	1161.3	30	4598.5	1617.1	30	5484.9	2202.2
40	3840.5	1168.1	40	4612.2	1625.7	40	5500.9	2213.2
50	3852.6	1174.8	50	4626.0	1634.4	50	5517.0	2224.3
68	3864.7	1181.6	78	4639.8	1643.0	88	5533.1	2235.5
10	3876.8	1188.4	10	4653.6	1651.7	10	5549.2	2246.7
20	3889.0	1195.2	20	4667.4	1660.5	20	5565.4	2258.0
30	3901.2	1202.0	30	4681.3	1669.2	30	5581.6	2269.3
40	3913.4	1208.9	40	4695.2	1678.1	40	5597.8	2280.6
50	3925.6	1215.8	50	4709.2	1686.9	50	5614.2	2292.0
69	3937.9	1222.7	79	4723.2	1695.8	89	5630.5	2303.5
10	3950.2	1229.7	10	4737.2	1704.7	10	5646.9	2315.0
20	3962.5	1236.7	20	4751.2	1713.7	20	5663.4	2326.6
30	3974.8	1243.7	30	4765.3	1722.7	30	5679.9	2338.2
40	3987.2	1250.8	40	4779.4	1731.7	40	5696.4	2349.8
50	3999.5	1257.9	50	4793.6	1740.8	50	5713.0	2361.5
70	4011.9	1265.0	80	4807.7	1749.9	90	5729.7	2373.3
10	4024.4	1272.1	10	4822.0	1759.0	10	5746.3	2385.1
20	4036.8	1279.3	20	4836.2	1768.2	20	5763.1	2397.0
30	4049.3	1286.5	30	4850.5	1777.4	30	5779.9	2408.9
40	4061.8	1293.6	40	4864.8	1786.7	40	5796.7	2420.9
50	4074.4	1300.9	50	4879.2	1796.0	50	5813.6	2432.9

TABLE IV.—TANGENTS AND EXTERNALS TO A 1° CURVE.

Central Angle	Tangent	External	Central Angle	Tangent	External	Central Angle	Tangent	External
91°	5830.5	2444.9	101°	6950.6	3278.1	111°	8336.7	4386.1
10'	5847.5	2457.1	10'	6971.3	3294.1	10'	8362.7	4407.6
20	5864.6	2469.3	20	6992.0	3310.1	20	8388.9	4429.2
30	5881.7	2481.5	30	7012.7	3326.1	30	8415.1	4450.9
40	5898.8	2493.8	40	7033.6	3342.3	40	8441.5	4472.7
50	5916.0	2506.1	50	7054.5	3358.5	50	8468.0	4494.6
92	5933.2	2518.5	102	7075.5	3374.9	112	8494.6	4516.6
10	5950.5	2531.0	10	7096.6	3391.2	10	8521.3	4538.8
20	5967.9	2543.5	20	7117.8	3407.7	20	8548.1	4561.1
30	5985.3	2556.0	30	7139.0	3424.3	30	8575.0	4583.4
40	6002.7	2568.6	40	7160.3	3440.9	40	8602.1	4606.0
50	6020.2	2581.3	50	7181.7	3457.6	50	8629.3	4628.6
93	6037.8	2594.0	103	7203.2	3474.4	113	8656.6	4651.3
10	6055.4	2606.8	10	7224.7	3491.3	10	8684.0	4674.2
20	6073.1	2619.7	20	7246.3	3508.2	20	8711.5	4697.2
30	6090.8	2632.6	30	7268.0	3525.2	30	8739.2	4720.3
40	6108.6	2645.5	40	7289.8	3542.4	40	8767.0	4743.6
50	6126.4	2658.5	50	7311.7	3559.6	50	8794.9	4766.9
94	6144.3	2671.6	104	7333.6	3576.8	114	8822.9	4790.4
10	6162.6	2684.7	10	7355.6	3594.2	10	8851.0	4814.1
20	6180.2	2697.9	20	7377.8	3611.7	20	8879.3	4837.8
30	6198.3	2711.2	30	7399.9	3629.2	30	8907.7	4861.7
40	6216.4	2724.5	40	7422.2	3646.8	40	8936.3	4885.7
50	6234.6	2737.9	50	7444.6	3664.5	50	8965.0	4909.9
95	6252.8	2751.3	105	7467.0	3682.3	115	8993.8	4934.1
10	6271.1	2764.8	10	7489.6	3700.2	10	9022.7	4958.6
20	6289.4	2778.3	20	7512.2	3718.2	20	9051.7	4983.1
30	6307.9	2792.0	30	7534.9	3736.2	30	9080.9	5007.8
40	6326.3	2805.6	40	7557.7	3754.4	40	9110.3	5032.6
50	6344.8	2819.4	50	7580.5	3772.6	50	9139.8	5057.6
96	6363.4	2833.2	106	7603.5	3791.0	116	9169.4	5082.7
10	6382.1	2847.0	10	7626.6	3809.4	10	9199.1	5107.9
20	6400.8	2861.0	20	7649.7	3827.9	20	9229.0	5133.3
30	6419.5	2875.0	30	7672.9	3846.5	30	9259.0	5158.8
40	6438.4	2889.0	40	7696.3	3865.2	40	9289.2	5184.5
50	6457.3	2903.1	50	7719.7	3884.0	50	9319.5	5210.3
97	6476.2	2917.3	107	7743.2	3902.9	117	9349.9	5236.2
10	6495.2	2931.6	10	7766.8	3921.9	10	9380.5	5262.3
20	6514.3	2945.9	20	7790.5	3940.9	20	9411.3	5288.6
30	6533.4	2960.3	30	7814.3	3960.1	30	9442.2	5315.0
40	6552.6	2974.7	40	7838.1	3979.4	40	9473.2	5341.5
50	6571.9	2989.2	50	7862.1	3998.7	50	9504.4	5368.2
98	6591.2	3003.8	108	7886.2	4018.2	118	9535.7	5395.1
10	6610.6	3018.4	10	7910.4	4037.8	10	9567.2	5422.1
20	6630.1	3033.1	20	7934.6	4057.4	20	9598.9	5449.2
30	6649.6	3047.9	30	7959.0	4077.2	30	9630.7	5476.5
40	6669.2	3062.8	40	7983.5	4097.1	40	9662.6	5504.0
50	6688.8	3077.7	50	8008.0	4117.0	50	9694.7	5531.7
99	6708.6	3092.7	109	8032.7	4137.1	119	9727.0	5559.4
10	6728.4	3107.7	10	8057.4	4157.3	10	9759.4	5587.4
20	6748.2	3122.9	20	8082.3	4177.5	20	9792.0	5615.5
30	6768.1	3138.1	30	8107.3	4197.9	30	9824.8	5643.8
40	6788.1	3153.3	40	8132.3	4218.4	40	9857.7	5672.3
50	6808.2	3168.7	50	8157.5	4239.0	50	9890.3	5700.9
100	6828.3	3184.1	110	8182.8	4259.7	120	9924.0	5729.7
10	6848.5	3199.6	10	8208.2	4280.5	10	9957.5	5758.6
20	6868.8	3215.1	20	8233.7	4301.4	20	9991.0	5787.7
30	6889.2	3230.8	30	8259.3	4322.4	30	10025.0	5817.0
40	6909.6	3246.5	40	8285.0	4343.6	40	10059.0	5846.5
50	6930.1	3262.3	50	8310.8	4364.8	50	10093.0	5876.1

TABLE V.—CORRECTIONS FOR TANGENTS AND EXTERNALS.

These corrections are to be added to the approximate values, found by dividing the tangent, or external, for a 1° curve (Table IV) by the degree of curve, in order to obtain the true tangents, or externals. Intermediate values may be obtained by interpolation.

FOR TANGENTS ADD

Central Angle	DEGREE OF CURVE													
	5°	10°	15°	20°	25°	30°	35°	40°	45°	50°	55°	60°	65°	70°
10°	.03	.06	.09	.13	.16	.19	.22	.25	.28	.31	.34	.38	.42	.46
15°	.04	.10	.14	.19	.24	.29	.34	.39	.45	.51	.53	.58	.63	.68
20°	.06	.13	.19	.26	.32	.39	.45	.51	.58	.65	.72	.79	.84	.90
25°	.08	.16	.24	.33	.40	.49	.58	.67	.75	.83	.90	.99	1.06	1.14
30°	.10	.19	.29	.39	.49	.59	.69	.79	.89	.99	1.09	1.20	1.29	1.39
35°	.11	.22	.34	.47	.58	.69	.79	.81	.92	1.04	1.29	1.42	1.54	1.66
40°	.13	.26	.40	.53	.67	.80	.93	1.06	1.20	1.34	1.49	1.64	1.79	1.94
45°	.15	.30	.44	.60	.76	.91	1.06	1.21	1.37	1.52	1.70	1.87	2.04	2.21
50°	.17	.34	.51	.68	.85	1.02	1.19	1.36	1.54	1.72	1.91	2.10	2.29	2.48
55°	.19	.38	.57	.76	.95	1.14	1.32	1.52	1.72	1.92	2.14	2.35	2.56	2.77
60°	.21	.42	.63	.84	1.05	1.27	1.49	1.71	1.94	2.17	2.38	2.60	2.83	3.07
65°	.23	.46	.69	.93	1.16	1.40	1.64	1.88	2.13	2.38	2.63	2.88	3.13	3.39
70°	.25	.51	.76	1.02	1.28	1.54	1.80	2.06	2.33	2.60	2.88	3.16	3.44	3.72
75°	.27	.56	.83	1.12	1.40	1.69	1.98	2.27	2.57	2.87	3.16	3.47	3.78	4.09
80°	.30	.61	.91	1.22	1.53	1.84	2.15	2.46	2.78	3.10	3.44	3.78	4.12	4.46
85°	.33	.66	1.00	1.33	1.68	2.02	2.36	2.70	3.05	3.40	3.74	4.14	4.55	4.89
90°	.36	.72	1.09	1.45	1.83	2.20	2.57	2.94	3.32	3.70	4.10	4.50	4.91	5.32
95°	.39	.79	1.19	1.55	2.00	2.40	2.80	3.20	3.61	4.02	4.40	4.98	5.38	5.83
100°	.43	.86	1.30	1.74	2.18	2.62	3.06	3.50	3.95	4.40	4.88	5.37	5.85	6.34
110°	.51	1.03	1.56	2.08	2.61	3.14	3.67	4.21	4.76	5.31	5.86	6.43	7.01	7.60
120°	.62	1.25	1.93	2.52	3.16	3.81	4.45	5.11	5.77	6.44	7.12	7.80	8.50	9.22

FOR EXTERNALS ADD

Central Angle.	DEGREE OF CURVE													
	5°	10°	15°	20°	25°	30°	35°	40°	45°	50°	55°	60°	65°	70°
10°	.001	.003	.004	.006	.007	.008	.009	.011	.012	.014	.015	.017	.018	.020
15°	.003	.007	.010	.014	.018	.023	.027	.029	.032	.035	.039	.043	.047	.051
20°	.006	.011	.017	.022	.028	.034	.038	.045	.051	.057	.063	.070	.076	.083
25°	.009	.018	.027	.036	.046	.056	.065	.074	.083	.093	.106	.120	.127	.135
30°	.013	.025	.038	.051	.065	.078	.090	.103	.116	.129	.149	.170	.179	.188
35°	.018	.035	.054	.072	.086	.109	.131	.153	.175	.197	.213	.230	.247	.264
40°	.023	.046	.070	.093	.117	.141	.172	.203	.234	.265	.277	.290	.315	.341
45°	.030	.060	.093	.119	.153	.184	.216	.254	.289	.325	.351	.378	.411	.445
50°	.037	.075	.116	.151	.189	.227	.266	.305	.345	.384	.425	.467	.508	.550
55°	.046	.093	.142	.188	.236	.283	.332	.381	.420	.479	.530	.582	.641	.700
60°	.056	.112	.168	.225	.283	.340	.398	.457	.516	.575	.636	.697	.774	.851
65°	.067	.135	.204	.273	.343	.412	.483	.554	.625	.697	.771	.845	.922	1.01
70°	.080	.159	.240	.321	.403	.485	.568	.652	.735	.819	.906	.994	1.08	1.17
75°	.095	.182	.286	.383	.480	.578	.678	.777	.877	.977	1.07	1.18	1.29	1.39
80°	.110	.220	.332	.445	.558	.671	.787	.903	1.02	1.13	1.25	1.38	1.50	1.62
85°	.128	.259	.391	.524	.657	.790	.926	1.06	1.20	1.34	1.47	1.62	1.76	1.91
90°	.149	.299	.450	.603	.756	.910	1.07	1.22	1.38	1.54	1.70	1.87	2.03	2.20
95°	.174	.350	.522	.706	.885	1.06	1.25	1.43	1.62	1.80	1.99	2.18	2.38	2.58
100°	.200	.401	.604	.809	1.01	1.22	1.43	1.64	1.85	2.06	2.28	2.50	2.73	2.96
110°	.268	.536	.806	1.08	1.35	1.63	1.91	2.20	2.48	2.76	3.05	3.35	3.66	3.96
120°	.360	.721	1.08	1.45	1.82	2.19	2.57	2.95	3.33	3.72	4.11	4.50	4.91	5.32

TABLE VI.--CORRECTIONS FOR SUB-CHORDS AND LONG CHORDS.

FOR SUB-CHORDS ADD										Excess of arc per 100 ft.	LONG CHORDS				
D	10	20	30	40	50	60	70	80	90		D	200	300	400	500
4°	.00	.00	.01	.01	.01	.01	.01	.01	.06	.02	1	199.99	299.97	399.92	499.85
6	.00	.01	.01	.02	.02	.02	.02	.01	.01	.05	2	199.97	299.88	399.70	499.39
8	.01	.02	.02	.03	.03	.03	.03	.02	.01	.08	3	199.93	299.73	399.32	498.63
10	.01	.02	.03	.04	.05	.05	.05	.04	.02	.13	4	199.88	299.51	398.78	497.57
12	.02	.04	.05	.06	.07	.07	.07	.05	.03	.18	5	199.81	299.24	398.10	496.20
14	.02	.05	.07	.08	.09	.10	.09	.07	.04	.25	6	199.73	298.90	397.26	494.53
16	.03	.06	.09	.11	.12	.12	.12	.09	.05	.33	7	199.63	298.51	396.28	492.57
18	.04	.08	.11	.14	.15	.16	.15	.12	.07	.41	8	199.51	298.05	395.14	490.31
20	.05	.10	.14	.17	.19	.20	.18	.15	.09	.51	9	199.38	297.54	393.86	487.75
22	.06	.12	.17	.21	.23	.24	.22	.18	.10	.62	10	199.24	296.96	392.42	484.90
24	.07	.14	.20	.25	.28	.28	.26	.21	.12	.74	12	198.90	295.63	389.12	478.34
26	.09	.17	.24	.29	.32	.33	.31	.25	.15	.86	14	198.51	294.06	385.22	470.65
28	.10	.19	.27	.34	.37	.38	.36	.29	.17	1.00	16	198.05	292.25	380.76	461.86
30	.11	.22	.31	.39	.43	.44	.41	.33	.19	1.15	18	197.54	290.21	375.74	452.02
32	.13	.25	.36	.44	.49	.50	.47	.38	.22	1.31	20	196.96	287.94	370.17	441.15
34	.15	.28	.40	.50	.55	.57	.53	.43	.25	1.48	22	196.32	285.44	364.06	429.30
36	.17	.32	.45	.56	.62	.64	.59	.48	.28	1.66	24	195.63	282.71	357.43	416.53
38	.18	.36	.51	.62	.70	.71	.66	.53	.31	1.86	26	194.87	279.76	350.30	402.89
40	.21	.40	.56	.69	.77	.79	.73	.59	.35	2.06	28	194.06	276.59	342.69	388.43
42	.23	.44	.62	.76	.85	.87	.81	.65	.38	2.28	30	193.18	273.20	334.61	373.20
44	.25	.48	.68	.84	.94	.96	.89	.72	.42	2.50	32	192.25	269.61	326.08	357.28
46	.27	.52	.75	.92	1.02	1.05	.98	.78	.46	2.74	34	191.26	265.81	317.12	340.73
48	.30	.57	.81	1.00	1.12	1.14	1.06	.86	.50	2.99	36	190.21	261.80	307.77	323.61
50	.32	.62	.89	1.09	1.21	1.24	1.15	.93	.55	3.24	38	189.10	257.60	298.03	305.99
52	.35	.67	.96	1.18	1.31	1.35	1.25	1.01	.59	3.52	40	187.94	253.21	287.94	287.94
54	.38	.73	1.04	1.28	1.42	1.46	1.35	1.09	.64	3.80	42	186.72	248.63	277.51	269.54
56	.41	.78	1.12	1.38	1.53	1.57	1.46	1.17	.69	4.09	44	185.44	243.87	266.78	250.85
58	.44	.84	1.20	1.48	1.65	1.69	1.57	1.26	.74	4.40	46	184.10	239.93	255.78	231.95
60	.47	.91	1.29	1.59	1.76	1.81	1.68	1.35	.80	4.72	48	182.71	233.83	244.51	212.92

NOTE.—When a chord of less than 100 ft. is used the corrections given in the above table should be added to the nominal length of chord to get the length which should be used in order that the 100 ft. points will check with those obtained by using the standard 100 ft. chord. Thus in locating a 14° curve by 25 ft. chords measure 25'.06 for each chord. Long chords are useful in passing obstacles.

TABLE VII.--MIDDLE ORDINATES FOR RAILS IN FEET.

Deg. of Curve	LENGTH OF RAILS							Deg. of Curve	LENGTH OF RAILS.						
	32	30	28	26	24	22	20		32	30	28	26	24	22	20
1°	.022	.020	.016	.013	.011	.009	.008	16°	.356	.313	.273	.236	.200	.170	.139
2	.045	.038	.034	.029	.025	.021	.017	17	.378	.333	.290	.252	.213	.180	.148
3	.037	.058	.051	.044	.037	.031	.026	18	.400	.351	.306	.265	.225	.190	.156
4	.089	.079	.069	.060	.050	.042	.035	19	.423	.371	.324	.280	.238	.201	.165
5	.112	.099	.086	.074	.063	.053	.044	20	.445	.392	.341	.296	.250	.212	.174
6	.134	.117	.102	.088	.076	.064	.052	21	.466	.410	.357	.309	.262	.222	.182
7	.156	.137	.120	.104	.088	.074	.061	22	.487	.430	.375	.325	.275	.233	.191
8	.179	.158	.137	.119	.100	.085	.070	23	.509	.450	.390	.338	.287	.243	.199
9	.201	.175	.153	.133	.112	.095	.078	24	.531	.469	.408	.354	.299	.253	.208
10	.223	.196	.171	.148	.125	.106	.087	25	.552	.486	.424	.367	.311	.263	.216
11	.245	.216	.188	.163	.139	.117	.096	26	.573	.506	.441	.382	.323	.274	.225
12	.268	.236	.206	.179	.151	.128	.105	27	.594	.524	.457	.396	.335	.284	.233
13	.290	.254	.222	.192	.163	.138	.113	28	.618	.545	.475	.411	.348	.294	.242
14	.312	.275	.239	.207	.175	.148	.122	29	.638	.564	.491	.424	.361	.303	.250
15	.334	.295	.257	.223	.188	.159	.131	30	.660	.583	.508	.438	.374	.313	.259


SLOPE REDUCTIONS.

When distances are measured on a slope they may be reduced to the equivalent horizontal distance by the following approximate rule:— subtract from the slope distance the square of the rise divided by twice the slope distance. Thus for a slope distance of 250.3 ft. and a rise of 15 ft. correction= $15^2 \div 2 \times 250.3 = .45$ (by slide rule) or horizontal distance= $250.3 - .45 = 249.85$. When vertical angle= $V. A.$ is measured horizontal distance= $\text{slope distance} - \text{slope distance} (1 - \text{Cos. } V. A.)$. Thus for slope distance of 248.7 ft. and $V. A.$ of $4^\circ 20'$ from Table VIII $\text{Cos.} = .99714$ and correction= $1 - .99714 = .00286$ per foot or total of $.286 \times 2\frac{1}{2}$ (near enough) = $.57$ and horizontal distance= $248.7 - .57 = 248.13$ ft.

See fig. (a).

TRIGONOMETRICAL FORMULAS.

$$\begin{aligned} \sin. & A = \frac{a}{c} \\ \cos. & A = \frac{b}{c} \\ \tan. & A = \frac{a}{b} \\ \cot. & A = \frac{b}{a} \\ \sec. & A = \frac{c}{b} \\ \text{cosec.} & A = \frac{c}{a} \end{aligned}$$

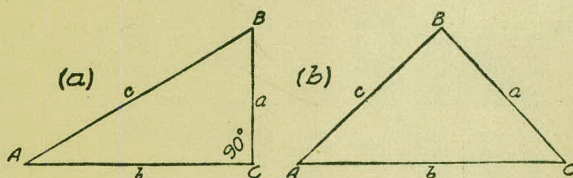

FORMULA FOR SOLVING TRIANGLES.

Given	Sought.	Right triangles. See fig. (a).
a, c	A, B, b	$\sin. A = \frac{a}{c}, \cos. B = \frac{a}{c}, b = \sqrt{(c+a)(c-a)}$
a, b	A, B, c	$\tan. A = \frac{a}{b}, \cot. B = \frac{a}{b}, c = \sqrt{a^2 + b^2}$
A, a	B, b, c	$B = 90^\circ - A, b = a \cot. A, c = \frac{a}{\sin. A}$
A, b	B, a, c	$B = 90^\circ - A, a = b \tan. A, c = \frac{b}{\cos. A}$
A, c	B, a, b	$B = 90^\circ - A, a = c \sin. A, b = c \cos. A$
Given	Sought.	Oblique triangles. See fig. (b).
A, B, a	b	$b = \frac{a \sin. B}{\sin. A}$
A, a, b	B	$\sin. B = \frac{b \sin. A}{a}$
a, b, C	$A - B$	$\tan. \frac{1}{2}(A - B) = \frac{(a - b) \tan. \frac{1}{2}(A + B)}{a + b}$
a, b, c	A	$\left\{ \begin{aligned} \text{If } s &= \frac{1}{2}(a + b + c), \sin. \frac{1}{2} A = \sqrt{\frac{(s-b)(s-c)}{bc}} \\ \cos. \frac{1}{2} A &= \sqrt{\frac{s(s-a)}{bc}}, \tan. \frac{1}{2} A = \sqrt{\frac{(s-b)(s-c)}{s(s-a)}}, \\ \sin. A &= \frac{2\sqrt{(s-a)(s-b)(s-c)s}}{bc} \end{aligned} \right.$
A, B, C, a	area	$\text{area} = \frac{a^2 \sin. B \sin. C}{2 \sin. A}$
A, b, c	area	$\text{area} = \frac{1}{2} b c \sin. A$
a, b, c	area	$s = \frac{1}{2}(a + b + c), \text{area} = \sqrt{s(s-a)(s-b)(s-c)}$

TABLE VIII.—NATURAL TRIGONOMETRICAL FUNCTIONS.

Angle	Sine.	Tan.	Cotg.	Cosin.		Angle	Sine.	Tan.	Cotg.	Cosin.	
0	0	0	∞	1	90	0	1	0	∞	0	90
10	.0029	.0029	343.8	I	50	8	.1392	.1405	7.115	.99027	82
20	.0058	.0058	171.9	.99998	40	10	.1421	.1435	6.968	.98986	50
30	.0087	.0087	114.6	.99996	30	20	.1449	.1465	6.827	.98944	40
40	.0116	.0116	85.94	.99993	20	30	.1478	.1495	6.691	.98902	30
50	.0145	.0145	68.75	.99989	10	40	.1507	.1524	6.561	.98858	20
1	.0175	.0175	57.29	.99985	89	50	.1536	.1554	6.435	.98814	10
10	.0204	.0204	49.10	.99979	50	9	.1564	.1584	6.314	.98769	81
20	.0233	.0233	42.96	.99973	40	10	.1593	.1614	6.197	.98723	50
30	.0262	.0262	38.19	.99966	30	20	.1622	.1644	6.084	.98676	40
40	.0291	.0291	34.37	.99958	20	30	.1650	.1673	5.976	.98629	30
50	.0320	.0320	31.24	.99949	10	40	.1679	.1703	5.871	.98580	20
2	.0349	.0349	28.64	.99939	88	50	.1708	.1733	5.769	.98531	10
10	.0378	.0378	26.43	.99929	50	10	.1736	.1763	5.671	.98481	80
20	.0407	.0407	24.54	.99917	40	10	.1765	.1793	5.576	.98430	50
30	.0436	.0437	22.90	.99905	30	20	.1794	.1823	5.485	.98378	40
40	.0465	.0466	21.47	.99892	20	30	.1822	.1853	5.396	.98325	30
50	.0494	.0495	20.21	.99878	10	40	.1851	.1883	5.309	.98272	20
3	.0523	.0524	19.08	.99863	87	50	.1880	.1914	5.226	.98218	10
10	.0552	.0553	18.07	.99847	50	11	.1908	.1944	5.145	.98163	79
20	.0581	.0582	17.17	.99831	40	10	.1937	.1974	5.066	.98107	50
30	.0610	.0612	16.35	.99813	30	20	.1965	.2004	4.989	.98050	40
40	.0640	.0641	15.60	.99795	20	30	.1994	.2035	4.915	.97992	30
50	.0669	.0670	14.92	.99776	10	40	.2022	.2065	4.843	.97934	20
4	.0698	.0699	14.30	.99756	86	50	.2051	.2095	4.773	.97875	10
10	.0727	.0729	13.73	.99736	50	12	.2079	.2126	4.705	.97815	78
20	.0756	.0758	13.20	.99714	40	10	.2108	.2156	4.638	.97754	50
30	.0785	.0787	12.71	.99692	30	20	.2136	.2186	4.574	.97692	40
40	.0814	.0816	12.25	.99668	20	30	.2164	.2217	4.511	.97630	30
50	.0843	.0846	11.83	.99644	10	40	.2193	.2247	4.449	.97566	20
5	.0872	.0875	11.43	.99619	85	50	.2221	.2278	4.390	.97502	10
10	.0901	.0904	11.06	.99594	50	13	.2250	.2309	4.331	.97437	77
20	.0929	.0934	10.71	.99567	40	10	.2278	.2339	4.275	.97371	50
30	.0958	.0963	10.39	.99540	30	20	.2306	.2370	4.219	.97304	40
40	.0987	.0992	10.08	.99511	20	30	.2334	.2401	4.165	.97237	30
50	.1016	.1022	9.788	.99482	10	40	.2363	.2432	4.113	.97169	20
6	.1045	.1051	9.514	.99452	84	50	.2391	.2462	4.061	.97100	10
10	.1074	.1080	9.255	.99421	50	14	.2419	.2493	4.011	.97030	76
20	.1103	.1110	9.010	.99390	40	10	.2447	.2524	3.962	.96959	50
30	.1132	.1139	8.777	.99357	30	20	.2476	.2555	3.914	.96887	40
40	.1161	.1169	8.556	.99324	20	30	.2504	.2586	3.867	.96815	30
50	.1190	.1198	8.345	.99290	10	40	.2532	.2617	3.821	.96742	20
7	.1219	.1228	8.144	.99255	83	50	.2560	.2648	3.776	.96667	10
10	.1248	.1257	7.953	.99219	50	15	.2588	.2679	3.732	.96593	75
20	.1276	.1287	7.770	.99182	40	10	.2616	.2711	3.689	.96517	50
30	.1305	.1317	7.596	.99144	30	20	.2644	.2742	3.647	.96440	40
40	.1334	.1346	7.429	.99106	20	30	.2672	.2773	3.606	.96363	30
50	.1363	.1376	7.269	.99067	10	40	.2700	.2805	3.566	.96285	20
					82	50	.2728	.2836	3.526	.96206	10
											74
	Cosin.	Cotg.	Tan.	Sine.	Angle.		Cosin.	Cotg.	Tan.	Sine.	Angle.

TABLE VIII.—NATURAL TRIGONOMETRICAL FUNCTIONS.

Angle	Sine.	Tan.	Cotg.	Cosin.		Angle	Sine.	Tan.	Cotg.	Cosin.	
<i>or</i> 16	.2756	.2867	3.487	.96126	74	<i>or</i> 24	.4067	.4452	2.246	.91355	66
10	.2784	.2899	3.450	.96046	50	10	.4094	.4487	2.229	.91236	50
20	.2812	.2931	3.412	.95964	40	20	.4120	.4522	2.211	.91116	40
30	.2840	.2962	3.376	.95882	30	30	.4147	.4557	2.194	.90996	30
40	.2868	.2994	3.340	.95799	20	40	.4173	.4592	2.177	.90875	20
50	.2896	.3026	3.305	.95715	10	50	.4200	.4628	2.161	.90753	10
17	.2924	.3057	3.271	.95615	73	25	.4226	.4663	2.145	.90631	65
10	.2952	.3089	3.237	.95545	50	10	.4253	.4699	2.128	.90507	50
20	.2979	.3121	3.204	.95459	40	20	.4279	.4734	2.112	.90383	40
30	.3007	.3153	3.172	.95372	30	30	.4305	.4770	2.097	.90259	30
40	.3035	.3185	3.140	.95284	20	40	.4331	.4806	2.081	.90133	20
50	.3062	.3217	3.108	.95195	10	50	.4358	.4841	2.066	.90007	10
18	.3090	.3249	3.078	.95106	72	26	.4384	.4877	2.050	.89879	64
10	.3118	.3281	3.048	.95015	50	10	.4410	.4913	2.035	.89752	50
20	.3145	.3314	3.018	.94924	40	20	.4436	.4950	2.020	.89623	40
30	.3173	.3346	2.989	.94832	30	30	.4462	.4986	2.006	.89493	30
40	.3201	.3378	2.960	.94740	20	40	.4488	.5022	1.991	.89363	20
50	.3228	.3411	2.932	.94646	10	50	.4514	.5059	1.977	.89232	10
19	.3256	.3443	2.904	.94552	71	27	.4540	.5095	1.963	.89101	63
10	.3283	.3476	2.877	.94457	50	10	.4566	.5132	1.949	.88968	50
20	.3311	.3508	2.850	.94361	40	20	.4592	.5169	1.935	.88835	40
30	.3338	.3541	2.824	.94264	30	30	.4617	.5206	1.921	.88701	30
40	.3365	.3574	2.798	.94167	20	40	.4643	.5243	1.907	.88566	20
50	.3393	.3607	2.773	.94068	10	50	.4669	.5280	1.894	.88431	10
20	.3420	.3640	2.747	.93969	70	28	.4695	.5317	1.881	.88295	62
10	.3448	.3673	2.723	.93869	50	10	.4720	.5354	1.868	.88158	50
20	.3475	.3706	2.669	.93769	40	20	.4746	.5392	1.855	.88020	40
30	.3502	.3739	2.675	.93667	30	30	.4772	.5430	1.842	.87882	30
40	.3529	.3772	2.651	.93565	20	40	.4797	.5467	1.829	.87743	20
50	.3557	.3805	2.628	.93462	10	50	.4823	.5505	1.816	.87603	10
21	.3584	.3839	2.605	.93358	69	29	.4848	.5543	1.804	.87462	61
10	.3611	.3872	2.583	.93253	50	10	.4874	.5581	1.792	.87321	50
20	.3638	.3906	2.560	.93148	40	20	.4899	.5619	1.780	.87178	40
30	.3665	.3939	2.539	.93042	30	30	.4924	.5658	1.767	.87036	30
40	.3692	.3973	2.517	.92935	20	40	.4950	.5696	1.756	.86892	20
50	.3719	.4006	2.496	.92827	10	50	.4975	.5735	1.744	.86748	10
22	.3746	.4040	2.475	.92718	68	30	.5000	.5774	1.732	.86603	60
10	.3773	.4074	2.455	.92609	50	10	.5025	.5812	1.720	.86457	50
20	.3800	.4108	2.434	.92499	40	20	.5050	.5851	1.709	.86310	40
30	.3827	.4142	2.414	.92388	30	30	.5075	.5890	1.698	.86163	30
40	.3854	.4176	2.394	.92276	20	40	.5100	.5930	1.686	.86015	20
50	.3881	.4210	2.375	.92164	10	50	.5125	.5969	1.675	.85866	10
23	.3907	.4245	2.356	.92050	67	31	.5150	.6009	1.664	.85717	59
10	.3934	.4279	2.337	.91936	50	10	.5175	.6048	1.653	.85567	50
20	.3961	.4314	2.318	.91822	40	20	.5200	.6088	1.643	.85416	40
30	.3987	.4348	2.300	.91706	30	30	.5225	.6128	1.632	.85264	30
40	.4014	.4383	2.282	.91590	20	40	.5250	.6168	1.621	.85112	20
50	.4041	.4417	2.264	.91472	10	50	.5275	.6208	1.611	.84959	10
					66						58
	Cosin.	Cotg.	Tan.	Sine.	Angle.		Cosin.	Cotg.	Tan.	Sine.	Angle.

TABLE VIII.—NATURAL TRIGONOMETRICAL FUNCTIONS.

Angle	Sine.	Tan.	Cotg.	Cosin.		Angle	Sine.	Tan.	Cotg.	Cosin.	
<i>or</i>						<i>or</i>					
32	.5299	.6249	1.600	.84805	58	30	.6225	.7954	1.257	.78261	30
10	.5324	.6289	1.590	.84650	50	40	.6248	.8002	1.250	.78079	20
20	.5348	.6330	1.580	.84495	40	50	.6271	.8050	1.242	.77897	10
30	.5373	.6371	1.570	.84339	30						
40	.5398	.6412	1.560	.84182	20	39	.6293	.8098	1.235	.77715	51
50	.5422	.6453	1.550	.84025	10	10	.6316	.8146	1.228	.77531	50
						20	.6338	.8195	1.220	.77347	40
33	.5446	.6494	1.540	.83867	57	30	.6361	.8243	1.213	.77162	30
10	.5471	.6536	1.530	.83708	50	40	.6383	.8292	1.206	.76977	20
20	.5495	.6577	1.520	.83549	40	50	.6406	.8342	1.199	.76791	10
30	.5519	.6619	1.511	.83389	30						
40	.5544	.6661	1.501	.83228	20	40	.6428	.8391	1.192	.76604	50
50	.5568	.6703	1.492	.83066	10	10	.6450	.8441	1.185	.76417	50
						20	.6472	.8491	1.178	.76229	40
34	.5592	.6745	1.483	.82904	56	30	.6494	.8541	1.171	.76041	30
10	.5616	.6787	1.473	.82741	50	40	.6517	.8591	1.164	.75851	20
20	.5640	.6830	1.464	.82577	40	50	.6539	.8642	1.157	.75661	10
30	.5664	.6873	1.455	.82413	30						
40	.5688	.6916	1.446	.82248	20	41	.6561	.8693	1.150	.75471	49
50	.5712	.6959	1.437	.82082	10	10	.6583	.8744	1.144	.75280	50
						20	.6604	.8796	1.137	.75088	40
35	.5736	.7002	1.428	.81915	55	30	.6626	.8847	1.130	.74896	30
10	.5760	.7046	1.419	.81748	50	40	.6648	.8899	1.124	.74703	20
20	.5783	.7089	1.411	.81580	40	50	.6670	.8952	1.117	.74509	10
30	.5807	.7133	1.402	.81412	30						
40	.5831	.7177	1.393	.81242	20	42	.6691	.9004	1.111	.74314	48
50	.5854	.7221	1.385	.81072	10	10	.6713	.9057	1.104	.74120	50
						20	.6734	.9110	1.098	.73924	40
36	.5878	.7265	1.376	.80902	54	30	.6756	.9163	1.091	.73728	30
10	.5901	.7310	1.368	.80730	50	40	.6777	.9217	1.085	.73531	20
20	.5925	.7355	1.360	.80558	40	50	.6799	.9271	1.079	.73333	10
30	.5948	.7400	1.351	.80386	30						
40	.5972	.7445	1.343	.80212	20	43	.6820	.9325	1.072	.73135	47
50	.5995	.7490	1.335	.80038	10	10	.6841	.9380	1.066	.72937	50
						20	.6862	.9435	1.060	.72737	40
37	.6018	.7536	1.327	.79864	53	30	.6884	.9490	1.054	.72537	30
10	.6041	.7581	1.319	.79688	50	40	.6905	.9545	1.048	.72337	20
20	.6065	.7627	1.311	.79512	40	50	.6926	.9601	1.042	.72136	10
30	.6088	.7673	1.303	.79335	30						
40	.6111	.7720	1.295	.79158	20	44	.6947	.9657	1.036	.71934	46
50	.6134	.7766	1.288	.78980	10	10	.6967	.9713	1.030	.71732	50
						20	.6988	.9770	1.024	.71529	40
38	.6157	.7813	1.280	.78801	52	30	.7009	.9827	1.018	.71325	30
10	.6180	.7860	1.272	.78622	50	40	.7030	.9884	1.012	.71121	20
20	.6202	.7907	1.265	.78442	40	50	.7050	.9942	1.006	.70916	10
							.7071	1.	1.	.70711	45
						<i>or</i>					
	Cosin.	Cotg.	Tan.	Sine.	Angle.		Cosin.	Cotg.	Tan.	Sine.	Angle.

TABLE IX.—CALCULATION OF EARTHWORK.


Width	HEIGHT														
	1	2	3	4	5	6	7	8	9	10	11	12	13	14	15
1	.02	.04	.06	.07	.09	.11	.13	.15	.17	.18	.20	.22	.24	.26	.28
2	.04	.07	.11	.15	.18	.22	.26	.30	.33	.37	.41	.44	.48	.52	.56
3	.06	.11	.17	.22	.28	.33	.39	.44	.50	.56	.61	.67	.72	.78	.83
4	.07	.15	.22	.30	.37	.44	.52	.59	.67	.74	.81	.89	.96	1.04	1.11
5	.09	.19	.28	.37	.46	.56	.65	.74	.83	.93	1.02	1.11	1.20	1.30	1.39
6	.11	.22	.33	.44	.56	.67	.78	.89	1.00	1.11	1.22	1.33	1.44	1.55	1.67
7	.13	.26	.39	.52	.65	.78	.91	1.04	1.16	1.30	1.42	1.55	1.68	1.81	1.94
8	.15	.30	.44	.59	.74	.89	1.04	1.19	1.33	1.48	1.63	1.78	1.92	2.08	2.22
9	.17	.33	.50	.67	.83	1.00	1.17	1.33	1.50	1.67	1.83	2.00	2.17	2.33	2.50
10	.18	.37	.56	.74	.93	1.11	1.30	1.48	1.67	1.85	2.04	2.22	2.41	2.59	2.78
11	.20	.41	.61	.82	1.02	1.22	1.43	1.63	1.83	2.04	2.24	2.44	2.65	2.85	3.06
12	.22	.44	.67	.89	1.11	1.33	1.56	1.78	2.00	2.22	2.44	2.67	2.89	3.11	3.33
13	.24	.48	.72	.96	1.20	1.44	1.68	1.92	2.16	2.41	2.65	2.89	3.13	3.37	3.61
14	.26	.52	.78	1.04	1.30	1.55	1.81	2.08	2.33	2.59	2.85	3.11	3.37	3.63	3.89
15	.28	.56	.83	1.11	1.39	1.67	1.94	2.22	2.50	2.78	3.06	3.33	3.61	3.89	4.17
16	.30	.59	.89	1.18	1.48	1.78	2.07	2.37	2.67	2.96	3.26	3.56	3.85	4.15	4.44
17	.31	.63	.94	1.26	1.57	1.89	2.20	2.52	2.83	3.15	3.46	3.78	4.09	4.41	4.72
18	.33	.67	1.00	1.33	1.67	2.00	2.33	2.67	3.00	3.33	3.67	4.00	4.33	4.67	5.00
19	.35	.70	1.06	1.41	1.76	2.11	2.46	2.82	3.17	3.52	3.87	4.22	4.57	4.92	5.28
20	.37	.74	1.11	1.48	1.85	2.22	2.59	2.96	3.33	3.70	4.07	4.44	4.81	5.18	5.56
21	.39	.78	1.17	1.55	1.94	2.33	2.72	3.11	3.50	3.89	4.28	4.67	5.06	5.44	5.83
22	.41	.81	1.22	1.63	2.04	2.44	2.85	3.26	3.67	4.07	4.48	4.89	5.30	5.70	6.11
23	.43	.85	1.28	1.70	2.13	2.56	2.98	3.41	3.83	4.26	4.68	5.11	5.54	5.96	6.39
24	.44	.89	1.33	1.78	2.22	2.67	3.11	3.56	4.00	4.44	4.89	5.33	5.78	6.22	6.67
25	.46	.92	1.39	1.85	2.31	2.78	3.24	3.70	4.17	4.63	5.09	5.56	6.02	6.48	6.94
26	.48	.96	1.44	1.92	2.41	2.89	3.37	3.85	4.33	4.82	5.30	5.78	6.26	6.74	7.24
27	.50	1.00	1.50	2.00	2.50	3.00	3.50	4.00	4.50	5.00	5.50	6.00	6.50	7.00	7.50
28	.52	1.04	1.55	2.07	2.59	3.11	3.63	4.15	4.67	5.18	5.70	6.22	6.74	7.26	7.78
29	.54	1.07	1.61	2.15	2.68	3.22	3.76	4.30	4.83	5.37	5.91	6.44	6.98	7.52	8.06
30	.56	1.11	1.67	2.22	2.78	3.33	3.89	4.44	5.00	5.55	6.11	6.67	7.22	7.78	8.33
31	.57	1.15	1.72	2.30	2.87	3.44	4.02	4.59	5.17	5.74	6.32	6.89	7.46	8.04	8.61
32	.59	1.18	1.78	2.37	2.96	3.56	4.15	4.74	5.33	5.92	6.52	7.11	7.70	8.30	8.89
33	.61	1.22	1.83	2.44	3.05	3.67	4.28	4.89	5.50	6.11	6.72	7.33	7.94	8.55	9.17
34	.63	1.26	1.89	2.52	3.15	3.78	4.40	5.04	5.67	6.29	6.93	7.56	8.18	8.81	9.44
35	.65	1.30	1.94	2.59	3.24	3.89	4.53	5.18	5.83	6.48	7.13	7.78	8.42	9.08	9.72
36	.67	1.33	2.00	2.67	3.33	4.00	4.66	5.33	6.00	6.67	7.33	8.00	8.67	9.33	10.00
37	.68	1.37	2.06	2.74	3.42	4.11	4.79	5.48	6.17	6.85	7.54	8.22	8.91	9.59	10.28
38	.70	1.41	2.11	2.82	3.52	4.22	4.92	5.63	6.33	7.03	7.74	8.44	9.15	9.85	10.56
39	.72	1.44	2.17	2.89	3.61	4.33	5.05	5.78	6.50	7.22	7.95	8.67	9.39	10.11	10.83
40	.74	1.48	2.22	2.96	3.70	4.44	5.18	5.92	6.67	7.41	8.15	8.89	9.63	10.37	11.11


Table gives cu. yds. in 1 ft. of a triangle of given width and height. Corrections for tenths of width are one tenth the values found under each height considering the widths from 1 to 9 as tenths and similarly the corrections for tenths of height are one tenth the figures opposite width considering the heights from 1 to 9 as tenths. Thus if $w = 16.2$ and $h = 5.3$, cu. yds. $= 1.48 + .028 + .089 = 1.597$ cu. yds. or practically 160 cu. yds. per 100 ft. If w exceeds 40 ft., use one half and multiply result by 2, if both w and h are large use one half of each and multiply result by 4. Any cross-section may be divided into triangles by the following rule. To the triangle of the sum of the outside cuts (or fills) $= h$, and $\frac{1}{2}$ the roadbed $= w$, add the triangles formed by taking the distance out to each break in turn ($= w$'s) by the difference between the cuts (or fills) on each side of it ($= h$'s) always subtracting the outer from the inner.


DIAGRAM FOR OBTAINING HORIZONTAL AND VERTICAL DISTANCES FROM STADIA READINGS


Enter on the horizontal scale with the value of the stadia reading or interval times the stadia constant (usually taken as 100) and run vertically upward to intersection with line representing the vertical angle. The location of this point with reference to the dotted line marked "ONE," etc., gives the correction to be subtracted from the entering value and to which "f+c" (usually about 1 ft.) must be added to obtain the Horizontal Distance. The reading on vertical scale plus about 0.1 ft. for each 5° of vertical angle [= (f+c) Sin α] is the Vertical Distance.

© 1944 BY J.K.FINCH.

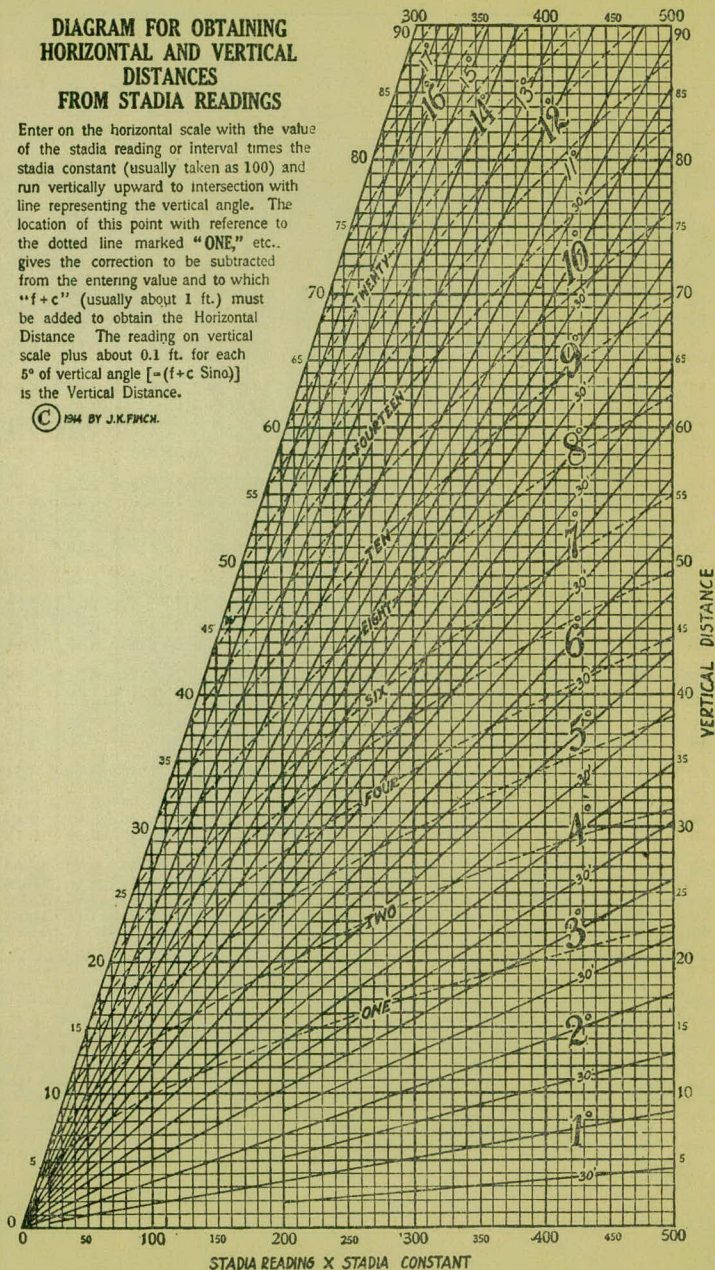

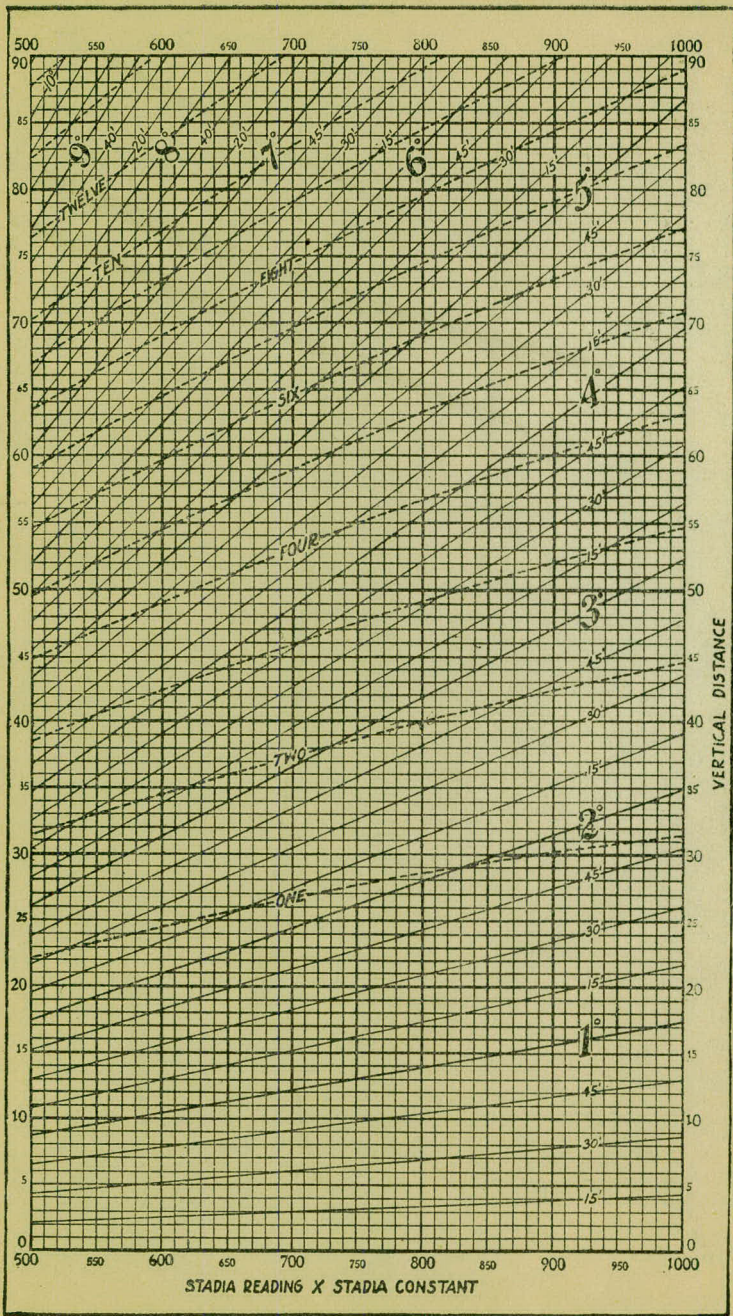

 

 

U2458

DISTANCES FROM CENTER OF ROADWAY FOR CROSS-SECTIONING.

Roadway 16 feet wide. Side Slopes 1 on 1½.
For Single Track Embankment.

H	0	.1	.2	.3	.4	.5	.6	.7	.8	.9	H
0	8.0	8.2	8.3	8.5	8.6	8.8	8.9	9.1	9.2	9.4	0
1	9.5	9.7	9.8	10.0	10.1	10.3	10.4	10.6	10.7	10.9	1
2	11.0	11.2	11.3	11.5	11.6	11.8	11.9	12.1	12.2	12.4	2
3	12.5	12.7	12.8	13.0	13.1	13.3	13.4	13.6	13.7	13.9	3
4	14.0	14.2	14.3	14.5	14.6	14.8	14.9	15.1	15.2	15.4	4
5	15.5	15.7	15.8	16.0	16.1	16.3	16.4	16.6	16.7	16.9	5
6	17.0	17.2	17.3	17.5	17.6	17.8	17.9	18.1	18.2	18.4	6
7	18.5	18.7	18.8	19.0	19.1	19.3	19.4	19.6	19.7	19.9	7
8	20.0	20.2	20.3	20.5	20.6	20.8	20.9	21.1	21.2	21.4	8
9	21.5	21.7	21.8	22.0	22.1	22.3	22.4	22.6	22.7	22.9	9
10	23.0	23.2	23.3	23.5	23.6	23.8	23.9	24.1	24.2	24.4	10
11	24.5	24.7	24.8	25.0	25.1	25.3	25.4	25.6	25.7	25.9	11
12	26.0	25.2	26.3	26.5	26.6	26.8	26.9	27.1	27.2	27.4	12
13	27.5	27.7	27.8	28.0	28.1	28.3	28.4	28.6	28.7	28.9	13
14	29.0	29.2	29.3	29.5	29.6	29.8	29.9	30.1	30.2	30.4	14
15	30.5	30.7	30.8	31.0	31.1	31.3	31.4	31.6	31.7	31.9	15
16	32.0	32.2	32.3	32.5	32.6	32.8	32.9	33.1	33.2	33.4	16
17	33.5	33.7	33.8	34.0	34.1	34.3	34.4	34.6	34.7	34.9	17
18	35.0	35.2	35.3	35.5	35.6	35.8	35.9	36.1	36.2	36.4	18
19	36.5	36.7	36.8	37.0	37.1	37.3	37.4	37.6	37.7	37.9	19
20	38.0	38.2	38.3	38.5	38.6	38.8	38.9	39.1	39.2	39.4	20
21	39.5	39.7	39.8	40.0	40.1	40.3	40.4	40.6	40.7	40.9	21
22	41.0	41.2	41.3	41.5	41.6	41.8	41.9	42.1	42.2	42.4	22
23	42.5	42.7	42.8	43.0	43.1	43.3	43.4	43.6	43.7	43.9	23
24	44.0	44.2	44.3	44.5	44.6	44.8	44.9	45.1	45.2	45.4	24
25	45.5	45.7	45.8	46.0	46.1	46.3	46.4	46.6	46.7	46.9	25
26	47.0	47.2	47.3	47.5	47.6	47.8	47.9	48.1	48.2	48.4	26
27	48.5	48.7	48.8	49.0	49.1	49.3	49.4	49.6	49.7	49.9	27
28	50.0	50.2	50.3	50.5	50.6	50.8	50.9	51.1	51.2	51.4	28
29	51.5	51.7	51.8	52.0	52.1	52.3	52.4	52.6	52.7	52.9	29
30	53.0	53.2	53.3	53.5	53.6	53.8	53.9	54.1	54.2	54.4	30
31	54.5	54.7	54.8	55.0	55.1	55.3	55.4	55.6	55.7	55.9	31
32	56.0	56.2	56.3	56.5	56.6	56.8	56.9	57.1	57.2	57.4	32
33	57.5	57.7	57.8	58.0	58.1	58.3	58.4	58.6	58.7	58.9	33
34	59.0	59.2	59.3	59.5	59.6	59.8	59.9	60.1	60.2	60.4	34
35	60.5	60.7	60.8	61.0	61.1	61.3	61.4	61.6	61.7	61.9	35
36	62.0	62.2	62.3	62.5	62.6	62.8	62.9	63.1	63.2	63.4	36
37	63.5	63.7	63.8	64.0	64.1	64.3	64.4	64.6	64.7	64.9	37
38	65.0	65.2	65.3	65.5	65.6	65.8	65.9	66.1	66.2	66.4	38
39	66.5	66.7	66.8	67.0	67.1	67.3	67.4	67.6	67.7	67.9	39
40	68.0	68.2	68.3	68.5	68.6	68.8	68.9	69.1	69.2	69.4	40

Example—If point is 22.6 ft. above grade, how far should it be from center line to be a slope stake point? Ans. from Table 41.9. For same slopes but other widths of roadbed correct above figures by one-half difference in width of roadbed; thus in example above for 20 ft. roadbed distance will be $41.9 + (20 - 16) \div 2$ or 2 ft. added to 41.9 = 43.9. For slopes of 1 on 1 see inside of front cover.