

OFFICE OF

CONSTRUCTION NOTES

COUNTY ROAD "E".

PROJ. NO. 26-07

1927

ENGINEERS'

FIELD BOOK

No. 10433

11-18-26

"5"

EUGENE DIETZGEN CO.

DRAWING MATERIALS, MATHEMATICAL and
SURVEYING INSTRUMENTS

Chicago New York San Francisco New Orleans Pittsburg Toronto


Distances from Center of Roadway for Cross-Sectioning
Roadway 16 feet wide. Side Slopes 1 on 1.
For Single Track Embankment.

H	0	.1	.2	.3	.4	.5	.6	.7	.8	.9	H
0	8.0	8.1	8.2	8.3	8.4	8.5	8.6	8.7	8.8	8.9	0
1	9.0	9.1	9.2	9.3	9.4	9.5	9.6	9.7	9.8	9.9	1
2	10.0	10.1	10.2	10.3	10.4	10.5	10.6	10.7	10.8	10.9	2
3	11.0	11.1	11.2	11.3	11.4	11.5	11.6	11.7	11.8	11.9	3
4	12.0	12.1	12.2	12.3	12.4	12.5	12.6	12.7	12.8	12.9	4
5	13.0	13.1	13.2	13.3	13.4	13.5	13.6	13.7	13.8	13.9	5
6	14.0	14.1	14.2	14.3	14.4	14.5	14.6	14.7	14.8	14.9	6
7	15.0	15.1	15.2	15.3	15.4	15.5	15.6	15.7	15.8	15.9	7
8	16.0	16.1	16.2	16.3	16.4	16.5	16.6	16.7	16.8	16.9	8
9	17.0	17.1	17.2	17.3	17.4	17.5	17.6	17.7	17.8	17.9	9
10	18.0	18.1	18.2	18.3	18.4	18.5	18.6	18.7	18.8	18.9	10
11	19.0	19.1	19.2	19.3	19.4	19.5	19.6	19.7	19.8	19.9	11
12	20.0	20.1	20.2	20.3	20.4	20.5	20.6	20.7	20.8	20.9	12
13	21.0	21.1	21.2	21.3	21.4	21.5	21.6	21.7	21.8	21.9	13
14	22.0	22.1	22.2	22.3	22.4	22.5	22.6	22.7	22.8	22.9	14
15	23.0	23.1	23.2	23.3	23.4	23.5	23.6	23.7	23.8	23.9	15
16	24.0	24.1	24.2	24.3	24.4	24.5	24.6	24.7	24.8	24.9	16
17	25.0	25.1	25.2	25.3	25.4	25.5	25.6	25.7	25.8	25.9	17
18	26.0	26.1	26.2	26.3	26.4	26.5	26.6	26.7	26.8	26.9	18
19	27.0	27.1	27.2	27.3	27.4	27.5	27.6	27.7	27.8	27.9	19
20	28.0	28.1	28.2	28.3	28.4	28.5	28.6	28.7	28.8	28.9	20
21	29.0	29.1	29.2	29.3	29.4	29.5	29.6	29.7	29.8	29.9	21
22	30.0	30.1	30.2	30.3	30.4	30.5	30.6	30.7	30.8	30.9	22
23	31.0	31.1	31.2	31.3	31.4	31.5	31.6	31.7	31.8	31.9	23
24	32.0	32.1	32.2	32.3	32.4	32.5	32.6	32.7	32.8	32.9	24
25	33.0	33.1	33.2	33.3	33.4	33.5	33.6	33.7	33.8	33.9	25
26	34.0	34.1	34.2	34.3	34.4	34.5	34.6	34.7	34.8	34.9	26
27	35.0	35.1	35.2	35.3	35.4	35.5	35.6	35.7	35.8	35.9	27
28	36.0	36.1	36.2	36.3	36.4	36.5	36.6	36.7	36.8	36.9	28
29	37.0	37.1	37.2	37.3	37.4	37.5	37.6	37.7	37.8	37.9	29
30	38.0	38.1	38.2	38.3	38.4	38.5	38.6	38.7	38.8	38.9	30
31	39.0	39.1	39.2	39.3	39.4	39.5	39.6	39.7	39.8	39.9	31
32	40.0	40.1	40.2	40.3	40.4	40.5	40.6	40.7	40.8	40.9	32
33	41.0	41.1	41.2	41.3	41.4	41.5	41.6	41.7	41.8	41.9	33
34	42.0	42.1	42.2	42.3	42.4	42.5	42.6	42.7	42.8	42.9	34
35	43.0	43.1	43.2	43.3	43.4	43.5	43.6	43.7	43.8	43.9	35
36	44.0	44.1	44.2	44.3	44.4	44.5	44.6	44.7	44.8	44.9	36
37	45.0	45.1	45.2	45.3	45.4	45.5	45.6	45.7	45.8	45.9	37
38	46.0	46.1	46.2	46.3	46.4	46.5	46.6	46.7	46.8	46.9	38
39	47.0	47.1	47.2	47.3	47.4	47.5	47.6	47.7	47.8	47.9	39
40	48.0	48.1	48.2	48.3	48.4	48.5	48.6	48.7	48.8	48.9	40

Example—If point is 22.6 ft. above grade, how far should it be from center line to be a slope stake point? Ans. from Table 30.6. For same slopes but other widths of roadbed, correct above figures by one-half difference in width of roadbed; thus in example above, for 20 ft. roadbed distance will be $30.6 + (20 - 16) \div 2$ or 2 ft. added to $30.6 = 32.6$. For slopes of 1 on $1\frac{1}{2}$ see inside of back cover.


Copyright, 1914, by Eugene Dietzgen Co.

26-07 "E"
CO. RD

 

Index

Sta	Sta	Description	Page
212+76.6	259+03.1	Alignment	4-6
✓	✓	x-sections (original)	7-15
212+76.6	259+03.1	✓ (Final)	16
212+76.6	259+03.1	Notes for staking Pavement	30-
✓	✓	(Final) Topography	39-50
✓	✓	Misc. (Finals)	51-52
✓	✓	Surface Drains	53
0-	13	Borrow Pit Align.	71
0-	7	✓ ✓ X-sec. (Orig.)	72-73
0	7	✓ ✓ ✓ (Final)	74-75

 


Sta P. L. R.

249+632 P.O.T.

240+741 P.O.T.

228+00 P.O.T.

217+258 P.T.

215+637 P.H. 89050'

212+764 P.C.


Handwritten signature or scribble

LT

RT


RT

2

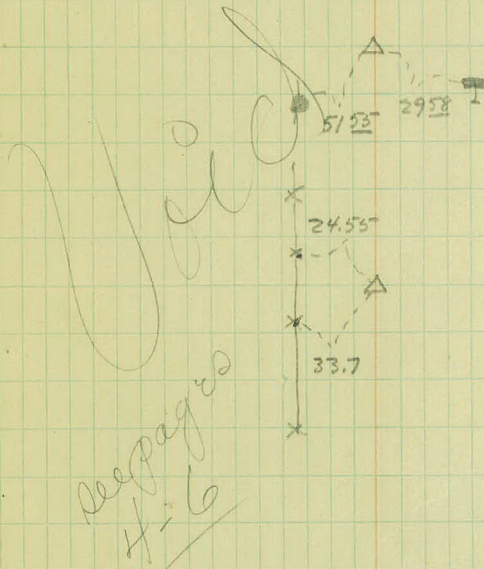

Repaired
H-6

No. 1/4 Corner
Sec 34.

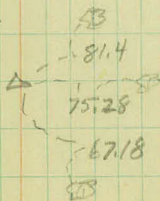

Δ 89°50'
D 20° Lt.
T 287.10
L 449.2

379

P.

L.

R.

259+03^L

P.C.C.
"P.T"

Handwritten signature

end of proj

257+41^R

P.I.

255+19^R


P.C

Lt

E

Rt

3

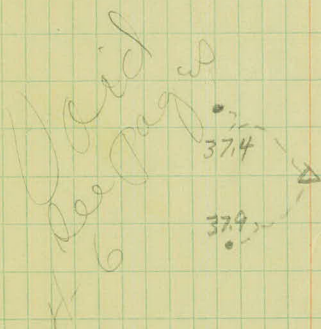

Δ 71°29'
D. 18°38'R
T. 222.3
L 383.63

station	Point	Lt.	A	Rt.
217+25.8	P.T.	44°-55'		
217		42°-20.4'		
+75		39°-50.4'		
+50		37°-20.4'		
+25		34°-50.4'		+31-35°-26'
216		32°-20.4'		20°-C.Lt.
+75		29°-50.4'		Δ 89°-50'
+50		27°-20.4'		P.I. 215+63.1
+25		24°-50.4'		T. 287.10'
215		22°-20.4'		L. 449.17'
+75		19°-50.4'		R. 287.94
+50		17°-20.4'		
+25		14°-50.4'		+14-13°-44'
214		12°-20.4'		+28 112°-08'
+75		9°-50.4'		+78 - 102°-08'
+50		7°-20.4'		
+25		4°-50.4'		
213		2°-20.4'		
212+76.	P.C.	0°-00'		

25.12 25.92
50.19

25.12
50.19


Station	Point	Lt.	Δ	Rt.
---------	-------	-----	---	-----

249+45.3	P.O.T.			
----------	--------	--	--	--

240+74.19	P.O.T.			
-----------	--------	--	--	--

230+00	P.O.T.			
--------	--------	--	--	--

Triple Oak

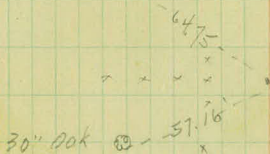

2" Hub

Hamline Av.

93.90

26.70

2" Hub

14" Poplar

1/2 Mile

Wall corner old Bldg

2" Hub

Steel Cyls
White Barn

2" Hub

43.00

43.00

2" Hub

2" Hub

Top A 31/0



Station	Point	Lt.	Δ	Rt.
259+03. ¹³	P.T.			35° 44. ⁵
259				35° 27. ⁰
+75				33° 07. ³
+50				30° 47. ⁵
+25				28° 27. ⁸
258				26° 08. ⁵
+75				23° 48. ² Δ 71° 29'
+50				21° 28. ⁵ 18° 33' Rt.
+25				19° 08. ⁸ P.I. 257+41.8'
257				16° 49. ⁰ 7.222.30
+75				14° 29. ³ 4.383.93
+50				12° 09. ⁵ R.308.85
+25				9° 46. ⁸
256				7° 36. ⁰
+75				5° 10. ³
+50				2° 50. ⁵
+25				0° 30. ⁸
255+19. ⁵	P.C.			0° 00. ⁰

3571
3676

55016

2510
3671


W.H.C.

June 28, 1926

E. F.

G. F. B.

H. T. B.

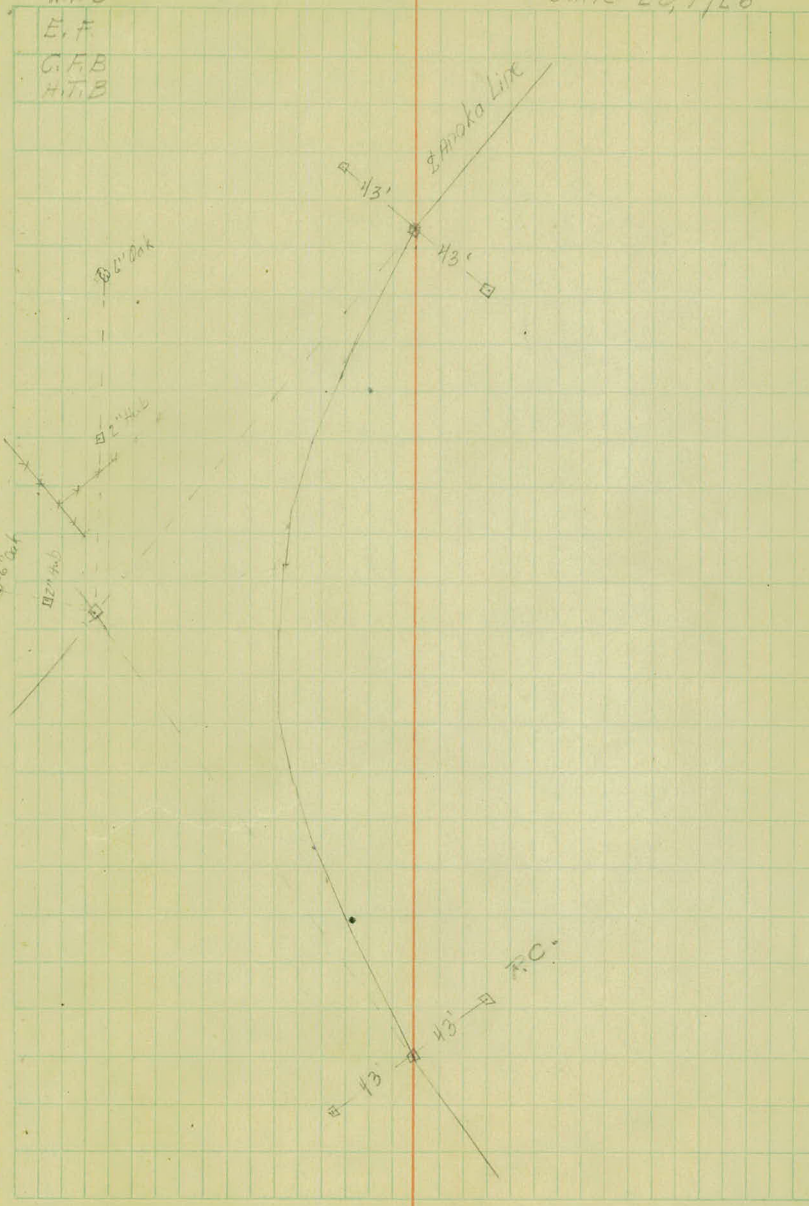

Original Cross Sections

Sta.	B. S.	H. I.	F. S.	Grade	Gr. R.
B.M.	1.89	954.20.			952.31
212+40				49.43	48
212+66.6			950.1	49.48	47.2
212+76.6			50.1	49.46 949.5	47
213			50.0	49.43	48
+50			41.6	48.99	54 50.3
+78			48.4	48.4	6.1 5.5
+88			46.6	48.3	6.4 5.9
214			46.8	47.6	7.2 6.6

Rod. W.H.C.
 Chain. H.T.P.
 W.H.

Aug 5, 1926 7

Left

C L

Right

R.R Spike 30" Oak 65' At. Sta 213+40

Edge Pine (2000)

66 63 71 71 44 437
 43 29 27 22 165 135

76 72 77 75 44 450 410
 43 19 27 30 23 17 135

77 73 76 73 43 422 412
 43 29 28 22 165 135

3 W. 72 74 76 73 44 431 411
 43 26 26 20.5 16 126

-0.17 73.5 73 74 74 73 47 469 461
 43 27 27 27 13 145 145 12 65 45

-0.3 +0.10 74.3 65 58 50 47 75 74 52 52 508
 43 23 5 103 27 11 195 7 35 00 1 412

-0.60 +0.40 74.9 74 74 53 53 76 76 54 534
 43 24 11 24 7 4 17 46 8

-0.60 70.50 74.0 10.1 0.0 97 5.6 56 74 77 56 5.50
 43 113 37.9 86 21 00 10 75 11 11 142

original Cross Sections

Sta.	B. S.	H. I.	V. C.	Grade	Gr. R.
		954.20			
214+14			48.3	947.2	7.8 64 7.0
+50			44.3	46.9	8.5 63 7.3
T.P.	5.04	946.01	13.23		940.97
215			40.2	45.8	1.4 4.04 0.2
+50			38.1	44.7	2.5 3.3 1.3
216			38.6	43.6	2.7 2.4
+31			38.7	42.9	3.1
+50			41.4	42.5	3.5
217			41.0	41.4	4.6
+20.8			40.7	40.9	5.1
760			40.4	40.1	5.9
218			40.1	39.3	6.7
+50			39.4	38.5	7.5
T.P.	4.70	944.16	6.55		939.46
219			38.6	37.9	6.3
219+50			37.6	37.6	6.6

Inet:
 Rod:
 Chain:

Aug 5, 1926 8

		Left			C L	Right									
-03 +06	240	121 43	^x 39.2 26	80 14	11.1	58 5	28 8	27 14	58 14	57 20					
+10 -100	240	129 43	^x 380 70	130 14	79 -26	3110			67 32	660 457					
+10 -120	240	96 43	^x 40 80	7.7 18	58 -56	26 15	12 -26	52	62 43						
+10 -120	240	129 43	^x 402 81	9.2 15	19 -66	6.1 15	48 -48	290	3.8 43						
20.3	24	108 43	^x 390 78	70 15	74 50	64 12	42 18	35 22	30 45						
	241	10.5 43	10.5 43	89 14	73 -22	11 9	3.6 22	12 35	2.0 39	10 43					
	24	102 43	^x 370 68	25 7	85 -11	40 14	44 245	44 29	51 245	3.5 40					
29.3		121 43	^x 335 5.1	20 18	57 12	53 7	50 -04	56 145	6.0 16	55 -09	12.8 334	3.1 43	(21)		
22.0		24 43	^x 306 43	83 19	44 14	57 11	13 -02	56 13	5.2 -05	219 209	42 324	3.5 43			
21.0		86 43	^x 207 20	79 20	74 20	73 15	61 10	56 103	57 12	63 17	59 06	200	12 107	48 321	43
20.0		57 43	^x 321 41	55 19	71 16	71 15	65 12	11 10.8	62 12	70 15	70 16	54 20	57 +16	33.4	5.1 43
		33 43	^x 373 44	33 22	69 17	71 12	66 10.9	71 13	75 12	75 15	34 21	45 +30	30	49 50	
30		86 43	^x 24 21	24 16	62 14	65 14	60 10	56 10.7	6.1 13	65 14	2.0 21	21 +39	36.9	80 13	
51		33.4 43	^x 50 11.6	43 19	73 15	75 13	70 12	66 00	19 14	74 10	75 16	54 19	54 19	2.8 18	5.0 13

original Cross Sections

Sta.	B. S.	H. I.	F. S.	Grade	Gr. R.
		944.16.			
219+75				37.3	937.5 6.7
220				36.9	37.4 6.8
+50				36.5	37.5 6.7
221			32 31	36.4	37.6 6.6
+50				37.0	37.8 6.4
222				37.4	37.9 6.3
T.P.	6.08	943.76.	6.48		
+50				38.1	38.1 5.7
223				38.9	38.2 5.6
+50				39.3	38.4 5.4
224				39.5	38.5 5.3
+50				39.3	38.6 5.2
225				38.6	38.6 5.2
+50				38.0	38.6 5.2

Inst. ...
 Rod. A.L.P.
 Chain. E.H.F.

July 23, 1926

Left					C L		Right								
$\frac{67}{43}$	$\frac{66}{43}$	$\frac{77}{16}$	$\frac{78}{14}$	$\frac{73}{10}$	$\frac{69}{-02}$	$\frac{73}{13}$	$\frac{79}{15}$	$\frac{79}{17}$	$\frac{70}{18}$	$\frac{73}{-06}$	$\frac{73}{212}$	$\frac{74}{200}$	$\frac{74}{43}$		
$\frac{81}{43}$	$\frac{81}{19}$	$\frac{82}{10}$	$\frac{86}{15}$	$\frac{75}{10}$	$\frac{73}{-05}$	$\frac{76}{12}$	$\frac{80}{16}$	$\frac{76}{20}$	$\frac{73}{-25}$	$\frac{73}{250}$	$\frac{88}{43}$				
$\frac{96}{43}$	$\frac{105}{-38}$	$\frac{107}{19}$	$\frac{83}{15}$	$\frac{81}{9}$	$\frac{77}{-10}$	$\frac{81}{11}$	$\frac{86}{17}$	$\frac{109}{21}$	$\frac{115}{-48}$	$\frac{115}{296}$	$\frac{112}{43}$				
$\frac{108}{43}$	$\frac{115}{-49}$	$\frac{115}{20}$	$\frac{89}{15}$	$\frac{81}{10}$	$\frac{78}{-12}$	$\frac{82}{12}$	$\frac{88}{17}$	$\frac{111}{22}$	$\frac{112}{-96}$	$\frac{112}{292}$	$\frac{112}{43}$				
$\frac{118}{43}$	$\frac{115}{-51}$	$\frac{114}{21}$	$\frac{82}{13}$	$\frac{76}{10}$	$\frac{72}{-08}$	$\frac{73}{11}$	$\frac{80}{15}$	$\frac{76}{20}$	$\frac{77}{-33}$	$\frac{77}{266}$	$\frac{73}{43}$				
$\frac{104}{43}$	$\frac{98}{-35}$	$\frac{93}{18}$	$\frac{76}{14}$	$\frac{73}{10}$	$\frac{68}{-05}$	$\frac{70}{11}$	$\frac{80}{16}$	$\frac{71}{19}$	$\frac{73}{-10}$	$\frac{73}{220}$	$\frac{73}{213}$	$\frac{69}{300}$	$\frac{69}{43}$		
937.68 - Top stake etc 224 75															
$\frac{80}{43}$	$\frac{69}{-28}$	$\frac{67}{-10}$	$\frac{70}{16}$	$\frac{65}{14}$	$\frac{61}{11}$	$\frac{57}{00}$	$\frac{59}{12}$	$\frac{67}{16}$	$\frac{66}{18}$	$\frac{58}{19}$	$\frac{57}{0.0}$	$\frac{48}{20}$	$\frac{48}{209}$	$\frac{48}{43}$	
$\frac{66}{43}$	$\frac{49}{19}$	$\frac{61}{17}$	$\frac{62}{15}$	$\frac{58}{14}$	$\frac{53}{10}$	$\frac{49}{107}$	$\frac{54}{12}$	$\frac{60}{17}$	$\frac{48}{19}$	$\frac{31}{25}$	$\frac{31}{33.8}$	$\frac{23}{43}$			
$\frac{58}{43}$	$\frac{44}{-40}$	$\frac{36}{21}$	$\frac{54}{16}$	$\frac{51}{14}$	$\frac{49}{11}$	$\frac{45}{109}$	$\frac{47}{12}$	$\frac{50}{18}$	$\frac{33}{21}$	$\frac{21}{27}$	$\frac{16}{43.8}$	$\frac{17}{36.7}$	$\frac{17}{43}$		
$\frac{23}{43}$	$\frac{47}{-36}$	$\frac{49}{22}$	$\frac{52}{14}$	$\frac{48}{13}$	$\frac{46}{10}$	$\frac{43}{110}$	$\frac{47}{12}$	$\frac{47}{19}$	$\frac{26}{21}$	$\frac{18}{25}$	$\frac{0.8}{14.5}$	$\frac{11}{37.8}$	$\frac{11}{43}$		
$\frac{12}{43}$	$\frac{113}{-39}$	$\frac{20}{20}$	$\frac{51}{16}$	$\frac{57}{14}$	$\frac{50}{12}$	$\frac{45}{167}$	$\frac{49}{12}$	$\frac{55}{17}$	$\frac{34}{20}$	$\frac{23}{11.9}$	$\frac{23}{339}$	$\frac{3.8}{43}$			
$\frac{51}{43}$	$\frac{67}{-10}$	$\frac{63}{15}$	$\frac{67}{-15}$	$\frac{72}{22}$	$\frac{68}{19}$	$\frac{53}{15}$	$\frac{55}{10}$	$\frac{52}{00}$	$\frac{53}{11}$	$\frac{61}{16}$	$\frac{65}{17}$	$\frac{6.6}{-1.4}$	$\frac{6.6}{22.8}$	$\frac{6.6}{22.8}$	$\frac{69}{43}$
$\frac{77}{43}$	$\frac{81}{-20}$	$\frac{86}{32}$	$\frac{86}{24}$	$\frac{90}{21}$	$\frac{63}{15}$	$\frac{62}{10}$	$\frac{58}{06}$	$\frac{60}{11}$	$\frac{62}{17}$	$\frac{62}{-10}$	$\frac{62}{220}$	$\frac{62}{110}$	$\frac{62}{245}$	$\frac{5.9}{43}$	

Original

Cross Sections

Sta.	B. S.	H. I.	F. S.	Grade	Gr. R.
		943.76			
226			37.6	38.6	5.2
+50			37.8	38.5	5.3
227			37.9	38.4	5.4
+50			38.0	38.3	5.5
+60			38.0	38.3	5.5
228+00			38.2	38.2	5.6
T.P.	4.64	942.92	5.48		
+50			38.4	38.1	4.8
229			38.2	37.9	5.0
+50			37.9	37.6	5.3
230+00			37.2	37.2	5.7
+50			36.8	36.8	6.1
B.M.	8.40	944.73	6.59		
231			36.4	36.4	8.3
+40			36.0	36.1	8.6
+70			35.8	35.8	8.9
232			35.4	35.6	9.1
+30			35.3	35.3	9.4
+65			35.2	34.8	9.9
233			34.5	34.3	10.4
T.P.	2.05	938.38	8.40		
+50			32.7	33.3	5.1

Inst. W.H.C.
 Rod. A.L. Pennington
 Chain F.H.F.

July 29/1926 10

		Left				C L				Right						
90	70	74	101	101	70	69	64	62	64	66	75	67	70	67	70	62
43	28	70	24	23	22	19	15	10	10	12	16	20	22	20	23	28
		92	28	94	75	76	63	60	62	70	85	86	246			23
		43		41	20	76	10	07	11	76	19	33	246			43
		81	268	71	71	74	63	59	61	67	80	79	27			78
		43		34	23	20	76	11	05	71	75	17	73	25	20	43
		102	298	124	94	71	62	58	61	66	60	67	58	20	54	54
		43		49	21	74	11	03	11	73	76	05	217	117	50.6	43
70	20	66	22	66	66	71	62	58	61	66	60	58			54	
43	44	109	22	11	17	14	11	03	11	73	20	51			43	
		40	41	52	63	60	56	51	51	51	44				41	
		43	333	75	77	76	72	00	11	22	112	328			23	
938.28		40	43	49	56	56	50	45	49	43	34					
		43	518	17	16	15	11	10.3	11	19	11.4	33.1			32	43
66	25	60	54	53	58	58	52	47	49	41	2.5				21	
43	19.5	110	20.8	0.4	17	76	75	11	10.3	12	18	12.5	348		43	
63	20	58	55	55	58	60	53	50	53	55	41	22			30	
43	308	115	20	10	18	17	14	8	10.3	12	14	19	12.1	342	43	
67	20	67	66	67	59	57	57	57	57	62	57	200	52	518	54	
43	298	110	218	09	14	7	00	00	7	14	00	200	10.5	518	43	
73	90	73	72	69	63	61	62	67	67	67	67	67	58	315	60	
43	211.8	222	11	13	7	00	00	11	14	15	01	202	10.3	315	43	
936.33		71	210	88	83	87	83	87	93	93	80	74			71	
		43	248	11	00	12	12	12	12	14	15	18	10.9	324	43	
		122	116	105	92	87	87	87	87	96	96	91	93	214	91	20
		43	20	19	11	01	12	12	12	15	17	07	214	115	30.3	43
		144	139	129	97	89	93	98	98	9.5	9.5				9.3	20
		43	20.0	16	11	01	11	15	15	16	17	06	212	116	30.1	43
		146	132	114	99	93	9.6	10.3	10.1	9.1	9.1				8.1	73
		43	28.4	16	11	02	11	15	16	18	00	20	11.0	32.5	43	
116	0.0	107	101	103	94	94	97	104	54	4.1					4.1	
43	29	107	24	74	71	01	12	15	21	15.0	38.5			70		
62	36.9	60	50	110	102	95	99	108	32	22				22		
43	439	73	74	71	104	104	12	76	28	28			77	426	43	
55	338	55	114	103	102	103	10.3	10.7	11.4	6.5	64				6.4	
43	449	15	14	6	102	102	11	12	15	25	140	370			43	
936.53		51	54	67	67	67	51	6.0	6.5	6.5	54	53			5.1	53
		43	100	18	16	14	10	12	14.5	16	18	0.1	204	00	31	43

original Cross Sections

Sta.	B. S.	1938.38.		Gr. R.
233+70			32.2	932.7 5.7
234			31.7	32.0 6.4
+50			30.6	30.6 7.2
+70			30.0	30.0 8.4
235			28.8	29.2 9.2
+25			27.5	28.5 9.9
T.P.	2.07	928.91.	11.54	726.84
+50			26.8	27.8 1.1
236			25.4	26.5 2.4
+50			24.5	25.5 3.4
237			24.2	24.9 4.0
+70			24.2	24.7 4.2
238			24.3	24.9 4.0
+50			24.6	25.5 3.4
239			25.4	26.4 2.5
T.P.	9.19	735.64	2.46	926.45
+50			26.4	27.4 2.2
+80			27.3	28.0 2.9

Inst. W.H.C.
 Rod. A.L.P.
 Chain. H.J.P.
 W.V.A.

Aug 6, 1926

11

Left

C L

Right

$\frac{62}{43}$ $\frac{64}{304}$ $\frac{64}{24}$ $\frac{65}{107}$ $\frac{72}{15}$ $\frac{72}{15}$ $\frac{66}{7}$ $\frac{62}{-90}$ $\frac{65}{11}$ $\frac{71}{148}$ $\frac{71}{16.5}$ $\frac{67}{19}$ $\frac{65}{0.8}$ $\frac{68}{216}$ $\frac{68}{40.9}$ $\frac{70}{294}$ $\frac{70}{43}$

$\frac{53}{43}$ $\frac{54}{325}$ $\frac{54}{160}$ $\frac{59}{19}$ $\frac{78}{16}$ $\frac{78}{15}$ $\frac{73}{13}$ $\frac{67}{-95}$ $\frac{72}{13}$ $\frac{79}{15}$ $\frac{79}{17}$ $\frac{79}{19.5}$ $\frac{74}{10}$ $\frac{74}{22.9}$ $\frac{67}{117}$ $\frac{70}{306}$ $\frac{68}{43}$

$\frac{37}{43}$ $\frac{37}{276}$ $\frac{37}{104}$ $\frac{49}{22}$ $\frac{49}{16}$ $\frac{43}{16}$ $\frac{26}{12}$ $\frac{12}{00}$ $\frac{84}{12}$ $\frac{84}{17}$ $\frac{43}{23}$ $\frac{40}{25.8}$ $\frac{40}{26.7}$ $\frac{40}{43}$ $\frac{40}{43}$

$\frac{50}{43}$ $\frac{36}{369}$ $\frac{43}{129}$ $\frac{48}{23}$ $\frac{102}{76}$ $\frac{94}{12}$ $\frac{84}{80}$ $\frac{94}{14}$ $\frac{97}{16}$ $\frac{32}{25}$ $\frac{26}{25.8}$ $\frac{26}{27.7}$ $\frac{26}{43}$

$\frac{126}{43}$ $\frac{36}{104}$ $\frac{88}{104}$ $\frac{12}{20}$ $\frac{113}{17}$ $\frac{106}{15}$ $\frac{96}{-89}$ $\frac{103}{16}$ $\frac{109}{18}$ $\frac{42}{26}$ $\frac{32}{46.0}$ $\frac{32}{100}$ $\frac{32}{43}$

$\frac{147}{43}$ $\frac{134}{270}$ $\frac{132}{23}$ $\frac{114}{17.5}$ $\frac{109}{11}$ $\frac{109}{-10}$ $\frac{112}{19}$ $\frac{93}{22}$ $\frac{8.5}{21.4}$ $\frac{8.5}{53.1}$ $\frac{77}{43}$

$\frac{29}{43}$ $\frac{76}{320}$ $\frac{70}{6.5}$ $\frac{38}{27}$ $\frac{27}{20}$ $\frac{27}{12}$ $\frac{24}{-11}$ $\frac{25}{10}$ $\frac{25}{18}$ $\frac{3.0}{-1.9}$ $\frac{2.7}{23.8}$ $\frac{2.7}{104}$ $\frac{12}{286}$ $\frac{12}{43}$

$\frac{126}{43}$ $\frac{100}{350}$ $\frac{100}{76}$ $\frac{100}{49}$ $\frac{49}{19}$ $\frac{3.8}{12}$ $\frac{3.8}{-11}$ $\frac{3.8}{12}$ $\frac{41}{19}$ $\frac{5.2}{24}$ $\frac{5.4}{3.0}$ $\frac{5.0}{26.0}$ $\frac{5.0}{43}$

$\frac{110}{43}$ $\frac{110}{352}$ $\frac{110}{7.6}$ $\frac{110}{27}$ $\frac{57}{18.5}$ $\frac{49}{13}$ $\frac{44}{-10}$ $\frac{3.8}{14}$ $\frac{5.2}{21}$ $\frac{6.8}{25}$ $\frac{6.6}{-3.2}$ $\frac{6.6}{26.4}$ $\frac{6.1}{43}$

$\frac{92}{43}$ $\frac{92}{368}$ $\frac{92}{5.9}$ $\frac{110}{29}$ $\frac{89}{21}$ $\frac{5.6}{12}$ $\frac{47}{-97}$ $\frac{48}{11}$ $\frac{5.5}{20}$ $\frac{7.5}{28}$ $\frac{7.4}{-3.9}$ $\frac{7.4}{26.8}$ $\frac{7.4}{43}$

$\frac{78}{43}$ $\frac{78}{284}$ $\frac{78}{42}$ $\frac{84}{27}$ $\frac{5.0}{21}$ $\frac{5.0}{11}$ $\frac{47}{-65}$ $\frac{5.0}{12}$ $\frac{5.4}{22}$ $\frac{6.7}{-3.5}$ $\frac{6.7}{25.0}$ $\frac{6.6}{43}$

$\frac{79}{43}$ $\frac{79}{292}$ $\frac{79}{46}$ $\frac{84}{27}$ $\frac{5.5}{19}$ $\frac{48}{12}$ $\frac{46}{-66}$ $\frac{5.0}{12}$ $\frac{5.4}{21}$ $\frac{7.6}{26.5}$ $\frac{7.4}{24}$ $\frac{7.4}{26.8}$ $\frac{7.3}{43}$

$\frac{90}{43}$ $\frac{90}{316}$ $\frac{90}{5.8}$ $\frac{90}{27}$ $\frac{54}{18}$ $\frac{46}{11}$ $\frac{43}{-97}$ $\frac{47}{13.5}$ $\frac{5.8}{21}$ $\frac{7.5}{28}$ $\frac{10.0}{-1.6}$ $\frac{10.0}{31.2}$ $\frac{10.4}{43}$

$\frac{84}{56}$ $\frac{84}{312}$ $\frac{84}{5.5}$ $\frac{80}{20}$ $\frac{5.0}{19}$ $\frac{41}{12}$ $\frac{35}{-10}$ $\frac{3.8}{13}$ $\frac{4.3}{19}$ $\frac{8.8}{29}$ $\frac{87}{-62}$ $\frac{87}{31.4}$ $\frac{86}{43}$

$\frac{106}{43}$ $\frac{106}{18}$ $\frac{106}{60}$ $\frac{106}{234}$ $\frac{106}{17}$ $\frac{105}{20}$ $\frac{99}{14}$ $\frac{42}{-0.9}$ $\frac{97}{12.5}$ $\frac{10.5}{16}$ $\frac{10.5}{18}$ $\frac{92}{-0.9}$ $\frac{92}{21.8}$ $\frac{92}{21.7}$ $\frac{94}{43}$

$\frac{2.1}{43}$ $\frac{2.1}{31}$ $\frac{2.1}{106}$ $\frac{2.1}{20}$ $\frac{2.1}{11}$ $\frac{9.5}{18}$ $\frac{9.5}{16}$ $\frac{2.1}{-0.6}$ $\frac{8.5}{14}$ $\frac{9.5}{15.5}$ $\frac{9.5}{17.5}$ $\frac{57}{21}$ $\frac{62}{145}$ $\frac{6.5}{22.3}$ $\frac{6.5}{43}$

original Cross Sections

Sta.	B. S.	H. I.	F. S.	Grade	Gr. R.
		935.64.			
240				28.0 - 28.4	7.8
D.M.	3.88	935.64.	3.88	231.74	
+50			29.8	29.2	6.4 2.2
+74		E. Hamline Av.	30.6	29.6	6.0
241			31.4 -	30.0	5.6
+08			31.6	30.1	5.5
+42			32.2	30.5	5.1
T.P.	5.77	936.93.	4.48		931.16
+75			32.6	30.9	6.0
242			32.6	31.2	5.7
+50			32.3	31.6	5.3
243			31.9	32.0	4.9
+50			31.2	32.2	4.7
244			31.0	32.5	4.4
+50			31.4	33.0	3.9
245			32.2	33.6	3.3

Inst.

Rod.

Chain.

Aug 6, 1926 12

Left

C L

Right

72	^x 161	66	86	88	80	74	81	88	82	62	66	^x 73	
43	328	41.2	20.5	18	16	13	-20	12	16	18	21	107	43

931.76 - 8.8 20.1 = 127.9 100 Rt. Sta. 240+94

66	^x 31.0	45	20	^x 1.5	61	58	62	72	72	57	63	^x 72
43	31.0	20	20	1.5	5	107	15	17	19	22	107	43

5.0	5.0	5.0	5.0	48
43	20	11.1	20	43

58	97	42	46	58	48
43	20	11.4	20	31	43

41	45	58	58	52	46	40	45	50	60	53	
43	39.5	38	34	31	19	11.5	16	16	31	34	43

39	^x 39.9	37	44	^x 5.1	5.0	42	34	39	47	47	3.6	2.5	^x 20	16
43	119	35	42.0	00	18.5	15	11.7	14	16	18	21	12.6	21	43

Top Stake 20' Lt. Sta. 241+1/2

20	^x 35.5	130	42	56	57	48	43	45	54	5.0	43	33	04	04	^x 0.4
43	150	21	19	16	13	11.7	11.7	12	15	18	19	25	34	15.6	43

28	^x 34.8	25	40	53	5.8	46	43	49	49	17	18	^x 1.67	2.1
43	132	21	19	17	13	11.4	11.4	11	17	27	13.9	43	43

35	^x 33.9	3.6	3.6	57	51	5.0	46	50	60	60	38	40	46
43	11.7	24	17	15	12	10.7	10.7	11	15	16	19	11.3	43

40	^x 31.6	45	40	62	62	54	50	55	62	69	5.1	109	49	49
43	104	20	18	17	12	12	12	10	14	16	10.1	109	100	43

65	80	61	^x 22.4	3.6	64	73	60	60	72	69	46	3.6	37	3.2
43	200	00	11.9	21	19	13	10	11	13	15	17	25	110	43

94	^x 31.6	102	99	70	63	59	62	72	9.2	9.5	9.5	9.5
43	58	24	19	12	12	11.5	10	16	11.6	43	43	43

12.6	^x 37.4	12.1	6.2	58	55	6.0	62	12.4	12.9	13.0
43	87	27	18	12	11.6	10	15	24	10.0	43

130	^x 34.7	12.9	120	5.3	48	47	5.1	5.7	11.0	11.2	11.2	11.2
43	96	15	16	14	11.4	11.4	10	16	25	10.2	10.2	43

original

Cross Sections

Sta.	B. S.	H. I.	F. S.	Grade	Gr. R.
		936.93.			
245+65			33.9	934.8	2.1
246			34.8	35.5	1.4
T.P.	10.85	947.50.	0.28		936.65
+50			36.7	36.7	10.8
247			38.7	37.8 38.0	7.6
+50			40.1	38.9	8.6
248			41.5	39.7	7.8
+50			43.0	40.3	7.2
249			43.1	40.8	6.7
+50			43.2	41.0	6.5
250			42.7	41.0	6.5
B.M.	5.84	945.12.	8.22		
+50			41.7	40.9	4.2
251			40.5	40.5	4.6
+50			39.6	40.0	5.1
252			39.0	39.3	5.8
+50			38.5	38.7	6.1
253			38.0	37.8 37.8	7.7

Inst. H. C. G.
 Rod. A. L. P.
 Chain. H. T. P.
W. A.

Aug 6, 1926 13

Left C L Right

7.3 ^x 21 77 3.6 3.2 30 3.4 3.6 5.8 6.0 6.1 /^x 6.1
 43 3.0-6.0 24 16 12 -29 4 16 20 22 40 20 43

2.5 20. 34 ^x 29 31 3.5 2.5 2.1 2.2 2.9 2.1 /^x 2.4 2.2 2.1 /^x 2.6
 43 28.9 60 23.0-7.5 19 16 11 -0.7 11 14 -1.7 2.4 31 11.4 22.1 43

8.1 ^x 9.1 8.7 12.1 12.1 11.2 10.8 11.2 12.6 12.4 5.8 5.6 /^x 5.7
 43 33.6 41.7 21 18 15 13 0.9 1.2 2.0 2.4 3.2 4.7 43

7.4 ^x 7.4 6.7 10.2 10.2 7.8 8.1 7.1 10.9 10.9 4.4 4.1 /^x 3.8
 43 34.3 42.2 21 18 16 13 +0.8 1.1 1.8 2.4 3.2 4.5 43

7.6 ^x 7.6 7.3 6.5 8.4 8.4 7.9 7.4 7.7 9.1 8.8 8.1 6.0 7.9 8.0 8.0 /^x 8.4
 43 32.9 32.9 +1.3 21 18 16 13 +1.2 1.1 1.7 2.0 2.2 2.6 3.0 4.8 43

6.9 ^x 6.4 5.5 7.5 6.6 6.0 6.4 6.4 7.2 7.2 1.2 1.2 5.3 5.3 /^x 5.4
 43 33.1 41.4 21 18 13 +1.8 1.2 1.7 2.1 3.1 4.4 43

5.0 ^x 5.0 4.5 4.0 5.9 5.9 5.0 4.5 4.8 5.8 5.8 2.6 2.5 2.5 /^x 2.4
 43 35.1 42.7 21 18 17 +2.7 1.2 1.5 1.7 2.2 4.9 4.9 43

4.3 ^x 4.3 3.5 5.2 5.3 4.8 4.4 4.3 5.6 5.2 2.3 2.1 /^x 2.6
 43 34.8 42.5 21 18 16 +2.3 1.0 1.5 1.7 2.1 4.0 4.0 43

4.1 ^x 4.1 3.7 3.4 5.1 4.9 4.5 4.3 4.8 5.6 5.6 2.5 2.0 /^x 3.0
 43 34.2 42.8 22 19 15 7 +2.2 1.1 1.5 1.6 2.0 2.5 4.3 43

5.6 ^x 5.6 4.8 4.0 6.2 6.4 5.5 4.8 5.1 6.4 6.1 2.1 2.5 /^x 2.7
 43 35.5 41.7 24 21 19 17 +1.7 1.0 1.5 1.6 2.2 4.0 4.0 43

359.28 - 88.90 = 270.38

5.4 ^x 5.4 5.2 5.0 5.6 6.5 4.7 3.9 3.4 3.9 4.4 5.1 5.1 4.2 /^x 4.2 3.8 /^x 3.4
 43 48.8 41.0 26 24 22 20.9 0.0 0.7 0.8 1.9 1.5 1.8 0.0 2.2 4.4 4.4 43

8.2 ^x 8.2 3.1 2.6 /^x 2.6 4.6 4.9 4.6 4.9 7 12 6 6.6 7.3 /^x 7.3 7.3 /^x 7.3





Original

Cross Sections

Sta.	B. S.	H. I.	F. S.	Grade	Gr. R.
		945.12.			
253+36				37.5	937.0 8.1
+75				36.5	36.1 9.0
254				35.5	35.3 9.9
T.R.	6.67	939.05.	12.74		932.38
+61				32.9	33.1 6.0
255				31.5	^{31.6} 31.5 7.5
204+75				30.8	30.8 8.3
+50				29.5	29.2 9.9
256				27.1	26.7 12.4
T.R.	4.31	933.64.	9.72		929.33
+32				27.9	25.1 8.5
+50				27.9	24.2 ^{9.1} 9.4
257				21.6	^{11.4} 21.7 ^{12.4} 11.7
T.R.	0.61	924.66.	9.59		924.05
+50				14.7	19.2 ^{4.9} ^{6.0} 2.4
258				12.9	17.2 7.5
+50				13.5	15.5 9.2
			7.26		

Inst. W. H. C.
 Rod. A. L. ...
 Chain: H. T. R.
 W. A.

Aug 7, 1926

14

Left				G L				Right	
60 43	61 44	62 45	22.8	75 14	76 15	77 16	78 17	81 9	82 10	83 877

Original Cross Sections

Sta.	B. S.	H. I.	F. S.	Grade	Gt. R.
259				142	9.50 914.1
703.1					

Inst.
Rod.
Chain.

15

Left

CL

Right

See Anaka Line
X-sections.

230

Final Cross Sections

Sta.	B. S.	H. L.	F. S.	Grade	Gr. R.
B.M.	9.68	927.08 ✓			
P.C. 259+03.13					
259+00				914.0	13.08.
+50				15.5	11.58.
258				17.2	9.88.
+50				19.3	7.78.
257				21.7	5.38.
T.P.	9.72	934.94 ✓	186		
+50				24.2	10.72.
+32				25.1	9.84.
256				26.7	8.24.
+50				29.2	5.74.
T.P.	7.95	942.88 ✓	001		
P.C. 255+19.5				30.8	12.08.

Inst. W.H.C
 Rod. R.R.
 Chain: C.L

NOV. 4, 1926 16

Left C L Right

917.40 - R.R. Spike 10' scrub oak 60 ft sta. 2584.50 -

(0.0 Fill)

Vert Slope shield $\frac{98}{2}$ $\frac{10.1}{25}$ $\frac{12.5}{31}$ $\frac{11.5}{43}$
 Area = 2

Slope = $\times \frac{12.5}{5}$ $\frac{74}{5}$ $\frac{26}{5}$ $\frac{24}{24}$ $\frac{10.5}{28.5 \times}$ $\frac{93}{43}$

(257130 = 0.0 Ditch Rt.)

Shield Area $\frac{5.0}{\sqrt{5}}$ $\frac{5.0}{24}$ $\frac{42}{27.5}$ $\frac{51}{34.5}$ $\frac{22}{40} \times$ $\frac{3.0}{43}$

925.22

$\times \frac{7.7}{2.5}$ $\frac{10.5}{25}$ $\frac{10.3}{25}$ $\frac{11.2}{36}$ $\frac{5.3}{42} \times$ $\frac{5.3}{43}$

10' Road

$\times \frac{8.9}{17}$ $\frac{9.5}{24}$ $\frac{9.3}{24}$ $\frac{9.8}{31}$ $\frac{3.9}{43} \times$

$\times \frac{7.8}{4}$ $\frac{7.8}{23.5}$ $\frac{7.9}{36}$ $\frac{8.9}{36}$ $\frac{1.5}{43}$

(255780 = 0.0 Ditch Lt.)

$\frac{1.2}{43} \times \frac{1.2}{37}$ $\frac{6.4}{30}$ $\frac{4.2}{24.5}$ $\frac{5.4}{21.5}$ 5.4 5.1 $\frac{6.2}{31}$ $\frac{7.03}{23.2 \times}$ $\frac{7.03}{43}$

934.93

Top 2.406 43 Lt. Sta. 255719.5

$\times \frac{26}{38}$ $\frac{27}{36}$ $\frac{9.2}{35}$ $\frac{13.0}{30}$ $\frac{13.0}{24}$ $\frac{1.8}{26.5}$ $\frac{11.74}{15.5}$ $\frac{11.61}{15.35}$ $\frac{11.71}{20.6}$ $\frac{11.8}{26}$ $\frac{13.4}{24.5}$ $\frac{13.4}{24.5}$ $\frac{9.0}{37}$ $\frac{8.5}{38.5 \times}$ $\frac{8.1}{43}$

S R EMI P S

Final Cross Sections

Sta.	B. S.	H. I. /	F. S.	Grade	Gr. R.
		942.88			
255+00				931.6	11.28.
+61				33.1	9.78.
254				35.3	7.58.
+75				36.1	6.78.
+36				37.0	5.88.
253+00				37.9	4.98.
+50				38.7	4.18.
252+00				39.3	3.58.
+50				40.0	2.88.
B.M.	6.73	945.97	3.64		
251+00				40.5	5.47.
250+50				40.9	5.07.
250+00				41.0	4.97.

Final Cross Sections

Sta.	B. S.	H. I. ✓ 945.97	F. S.	Grade	Gr. R.
249+50				41.0	4.97.
249+00				40.8	5.17.
248+50				40.3	5.67.
248+00				39.7	6.27.
+50				38.9	7.07.
247				37.9	8.07.
+50				36.7	9.27.
246				35.5	10.47.
T.P.	2.31	937.62	10.66		
+65				34.8	2.82.
245				33.6	4.02.
+50				33.0	4.62.
244+00				32.5	5.12.

Inst. W.H.C.
 Rod. A.P.
 Chain. R.R.

18
 Nov. 10, 1926

← Pave →

23 43	24 36.5	27 34	Left 55 32	43 19	44 13.5	440 G-L	451 13.5	46 18.5	67 18.5	67 18.5	32 36	17 37	110 43			
27 43	28 37.5	32 30.5	62 29.5	60 24	46 18	466	475 13.5	48 18.5	20 24.5	25 29	28 37	10 40.5	10 43			
30 43	33 37.5	38 38.5	68 28.5	64 22.5	49 18.5	514	518 13.5	52 18.5	72 23	76 29	15 37.5	9.8 41	99 43			
53 43	50 37.5	54 32	79 28	80 22.5	58 18	573	579 13.5	60 18.5	85 23.5	84 29.5	30 36.5	21 40.5	20 43			
62 43	60 36	62 31.5	88 28	88 23	65 18.5	650	659 13.5	64 18	92 33	91 29	31 37.5	23 40.5	21 43			
62 43	62 36.5	65 33	104 28	103 23	76 18.0	758	778 13.5	75 18.5	104 23.5	102 29.5	34 38	26 41	29 43			
74 43	76 37	74 33.5	115 27.5	110 23	88 18	878	875 13.5	86 18.5	110 22	111 28.5	50 27.5	43 39.5	44 43			
121 3	130 55.5	132 54.5	137 24.5	9.9 18.5	9.76 13.5	10.2 12.3	993	100 13.5	9.72 13.5	9.7 18.5	120 22	123 27.5	101 31	97 33.5	101 37	100 43
935.31																
77 43	76 32.5		21 18.5	21.5 13.5	24.1 12.5	221	392 13.5	314 13.5	22 18.5	70 300				6.2 43		
(266 + 70 = 0.0 Pitch Lt.)																
135 43	135 40	65 28	32 18.5	32.5 13.5	3.02 12.5	346	354 13.5	324 18.5	33 18.5	14.7 39				11.9 43		
130 43		30 30.5	3.6 19	3.85 13.5	4.15 12.5	410	418 12.5	3.89 13.5	39 18.5	12.7 39.5				13.4 43		
100 43	105 35		42 18.5	43.7 13.5	465 12.5	457	466 13.5	437 13.5	44 19	9.5 35.5				9.9 43		

Final

Cross Sections

Sta.	B. S.	H. I. ✓	F. S.	Grade	Gr. R.
243+50		937.62		32.2	5.42.
243+00				32.0	5.62.
T.P.	5.01	937.20 ✓	5.43		
242+50				31.6	5.60.
242+00				31.2	6.00.
+75				30.9	6.30.
+42				30.5	6.70.
+08				30.1	7.10.
241+00				30.0	7.20.
B.M.	0.73	932.49 ✓	5.47		
+74				29.6	2.89.
+50				29.2	3.29.
240+00				28.4	4.09.
239+80				28.0	4.49.

Inst.
 Rod.
 Chain.

(243792 = 0.0 Ditch Lt.)

(243792 = 0.0 Ditch Rt.)

Left			C.	P	GL	R	G.	Right				
71	72	73	471	476	487	491	460	46	72	70	4741	3.6
43	22	27.5	13.5	12.5	-	12.5	13.5	18	23.5	28.5	32	3.5

45	44	42	51	520	510	517	49	74	7.5	60	56	43
43	22	29	18.5	13.5	-	13.5	18.5	23.5	28.5	31	33	43

93 2.19 27 2.19 241400

40	38	44	51	511	501	507	52	77	78	50	43	49
33	36.5	33	23	18.5	13.5	13.5	18.5	23	28	31.5	35	43

P. P.

31	31	36	55	557	542	551	55	77	76	27	22	24
43	38	35	30	33.5	18.5	13.5	13.5	18.5	23.5	29.5	39	43

23	27	36	77	74	59	520	572	581	56	76	29	16	11	13
43	40	35	30.5	23	18.5	13.5	-	13.5	19	23	29	38	40.5	43

45	47	54	80	80	62	618	611	615	621	8.1	8.1	44	3.7	29
43	37	33	29.5	22	18	13.5	-	13.5	19	24	30	35	38	43

62	81	76	67	63	637	654	662	65	29	20	29	25	25	25
49	41	31	26	19.5	13.5	-	13.5	22	25	28	31	31	43	43

7.1			65	672	662	671	66					6.6	
43			20	13.5	-	13.5	21					43	

931.73 correct - R.R. Spike in T.P. 100 ft sta. 240794

2.0	2.0	2.1	3.25	2.8	2.34	2.3	2.1				1.7	
43	32	19	13.5	-	13.5	18.5	30				43	

(240757 = 0.0 Ditch Lt. & Rt.)

34	30	32	50	47	2.8	2.74	2.65	2.74	2.7	5.4	54	39	44
43	34.5	31.5	29	23	19.5	12.5	-	13.5	18.5	23	29	31	43

40	34	36	62	58	3.7	3.61	3.55	3.64	3.6	6.1	60	39	54	42
43	36.5	33.5	28	22.5	18.5	13.5	-	13.5	18.5	23	29	31.5	34	43

48	40	42	66	64	4.04	4.00	3.92	3.98	3.9	6.3	60	36	34	34
43	36	32	28.5	23.5	18	13.5	-	13.5	18.5	23.5	29.5	33.5	36	43

Final Cross Sections

Sta.	B. S.	H. I. ✓	F. S.	Grade	Gr. R.
		932.49			
239+50				27.4	5.09.
239+00				26.4	6.09.
+50				25.5	6.99.
238				24.9	7.59.
+50				24.7	7.79.
237				24.9	7.59.
+50				25.5	6.99.
236				26.5	5.99.
+50				27.8	4.69.
T.P.	8.68	937.83 ✓	3.34		
+25				28.5	9.33.
235				29.2	8.63.
334+70				30.0	7.83.

Inst. W.H.C.
 Rod. A.L.P.
 Chain. R.R.

Nov. 19, 1926

		Left				G.	P.	C.L.	R.	C.	Right				
7.1	69	7.2	20	7.8	44	1.28	4.56	4.49	4.57	4.26	4.2	7.7	7.7	6.2	6.5
43	36	32	30	24	18	1.35	1.25		1.23	1.35	1.8	24	29	32	43
(239+35=0.0 Ditch Lt.)															
11.7	11.5	9.5	5.5	5.38	5.63	5.48	5.57	5.27	5.2	5.2	2.1	12.1		12.3	
43	34	27	15	13.5	12.5		12.5	13.5	13.5	13.5	27	33		43	
12.4	12.5	6.5	6.24	6.50	6.29	6.51	6.27	6.2	6.2	6.2	13.6		14.0		
43	33	18	13.5	12.5		13.5	13.5	13.5	13.5	13.5	31.5		43		
11.3	12.0	6.7	6.79	7.07	7.00	7.09	6.82	6.7	6.7	6.7	10.4		10.6		
43	32	18.5	12.5	12.5		12.5	13.5	13.5	13.5	13.5	30		43		
11.2	11.4	6.9	7.08	7.22	7.22	7.20	7.00	7.1	7.1	7.1	10.2		10.2		
43	34	18.5	13.5	12.5		12.5	13.5	12.5	12.5	12.5	28		43		
12.8	13.1	6.7	6.86	7.13	7.03	7.12	6.82	6.6	6.6	6.6	10.7		10.7		
43	35	18.5	13.5	12.5		12.5	13.5	13.5	13.5	13.5	30		43		
11.6	10.9	6.3	6.22	6.52	6.44	6.02	6.24	6.1	6.1	6.1	10.0		9.8		
43	36	18	13.5	12.5		13.5	12.5	19	19	19	31		43		
12.0	13.3	5.4	5.21	5.48	5.42	5.54	5.23	5.1	5.1	5.1	9.2		8.7		
43	37	18.5	13.5	12.5		12.5	13.5	13.5	13.5	13.5	30		43		
(235+60=0.0 Ditch Pt.)															
11.5	11.4	4.0	3.87	4.20	4.06	4.13	3.83	3.8	3.8	3.8	6.1	6.6	6.2	5.5	
43	36	18	13.5	12.5		12.5	13.5	13.5	13.5	13.5	24	28	30	43	
929 15															
13.9	13.1	8.7	8.52	8.83	8.68	8.77	8.46	8.4	8.4	8.4	10.7	10.5	7.6	6.7	
43	31	18	13.5	12.5		12.5	13.5	18	18	18	24	28	33	43	
(235+18=0.0 Ditch Lt.)															
11.0	8.5	10.5	10.3	7.9	7.84	7.18	8.08	8.22	7.92	7.8	7.8	7.8	5.5	2.8	2.6
43	31	28	24	18	13.5	12.5		12.5	13.5	13.5	23	24	29	38	43
R															
11.0	11.0	4.5	4.5	4.1	7.2	7.28	7.16	7.28	7.0	7.1	7.1	2.7	2.1	2.0	
43	40	35	28	24.5	18.5	13.5		13.5	13.5	13.5	23	24	25	41.5	43
P															

Final

Cross Sections

Sta.	B. S.	H. I. ✓	F. S.	Grade	Gr. R.
		937.83			
234+50				30.6	7.23.
234				32.0	5.83.
+70				32.7	5.13.
+50				32.3	4.53.
T.P.	7.36	942.30 ✓	2.89		
233				34.3	8.00.
+65				34.8	7.50.
+30				35.3	7.00.
232				35.6	6.70.
+70				35.8	6.50.
+40				36.1	6.20.
231				36.4	5.90.
B.M.	7.01	946.36 ✓	5.95		
230+50				36.8	6.56.

Inst. W.H.C.
 Rod. A.L.P.
 Chain. R.R.

Nov. 10, 1926

21

Left						CL	Right						
32	30	35	92	93	219	671	664	874	81	85	38	32	32
43	40.5	36	27.5	24	185	135		135	185	23	29	43	43
46	45	49	76	72	53	501	524	530	57	76	77	65	60
43	35	32	28	23	18	135		135	19	26	28.5	30.5	33
												33	43
53	58	57	21	20	45	456	448	458	44	62	68	61	64
43	32	29.5	22	22	185	135		135	19	23	29	32	43
42	42	45	64	66	90	400	396	402	39	64	65	50	46
43	33	31	29	23	185	135		135	18.5	23	28	31.5	24.5
												24.5	43
93 4.94													
30	30	34	96	95	73	746	736	744	72	92	94	35	40
43	41.5	38	28	23	185	135		135	18.5	23	28	26	27.5
													43
41.2	37	40	92	92	68	691	682	693	67	84	84	97	102
43	40	35	28	22	185	135		135	18.5	22	28.5	41.5	92
													92
81	82	94	94	65	650	640	640	650	63	84	86	25	20
43	29.5	28	23.5	18.5	135			135	18.5	22	28	37.5	43
120	12	103	61	6.16	6.06	6.06	6.06	6.15	6.1	82	80	60	53
43	34	27	18.5	13.5				13.5	19	23	29	52	35.5
													43
(231+95=0.0 Ditch Lt.)													
122	115	60	596	587	587	587	587	596	59	80	83	69	66
43	28	18.5	135					135	18.5	23	31	33	43
(231+50=0.0 Ditch Lt.)													
99	96	102	98	57	571	564	564	571	57	80	80	67	65
43	35	32	22	18	135			135	19	23	31	33	43
70	67	70	79	57	570	579	579	576	51	69	68	50	47
43	27.5	29.5	25	18	135			135	19	23.5	31	34	43
936.35 R.R. Spike in Stump 40' Lt. 230+85													
37	37	37	83	67	609	598	598	607	60	71	72	62	64
43	32	30	24	19	135			135	19	23	32	34	43

x 100 ft

Final Cross Sections

Sta.	B. S.	H. I. /	F. S.	Grade	Gr. R.
		743.36			
230+00				37.2	6.16.
+50				37.6	5.76.
229				37.9	5.46.
+50				38.1	5.26.
228				38.2	5.16.
,					
+60				38.3	5.06.
+50				38.3	5.06.
227				38.4	4.96.
T.P.	4.56	943.73	4.19		
+50				38.5	5.23.
226				38.6	5.13.
+50				38.6	5.13.
225				38.6	5.13.

Inst. W.A.C.
 Rod. R.L.P.
 Chain. R.P.P.

Nov. 12, 1926 ⁷⁷

						C L	Right						
7.1 43	x 21 33	21 31	74 72.5	57 18.5	5.64 13.5	5.61	5.68 13.5	5.5 19	21 23	70 51.5	57 34	59 43	
66 43	x 62 33	70 31	70 24.5	52 19	5.29 13.5	5.20	5.30 13.5	5.0 18.5	66 23	62 32.5	39 35	38 43	
70 43	x 65 32.5	70 31	68 23.5	48 19	4.95 13.5	4.82	5.00 13.5	5.0 18.5	66 24	60 31	34 34	28 39	27 43
42 43	x 45 30.5	50 30.5	68 29.5	68 29.5	4.7 13.5	4.70	4.78 13.5	4.7 12.5	64 21.5	65 29.5	46 31	37 36	37 43
3.6 43	x 37 36	41 33	64 29.5	63 23.5	4.4 13.5	4.57	4.69 13.5	4.6 18.5	62 22	62 29.5	46 32	42 34.5	40 43
63 43	x 62 32	73 30.5	71 25.5	44 19	4.54 13.5	4.44	4.58 13.5	4.4 18.5	59 22	58 29.5	51 31	x 48 43	
(647+50 = 0.0 Ditch Lt.)													
85 43	x 24 30.5	76 25	47 19	4.55 13.5	4.45	4.61 13.5	4.5 18.5	62 22	61 29	57 30	x 52 43		
(227+40 = 0.0 Ditch Rt.)													
77 43	x 72 29	43 18	4.36 13.5	4.20	4.44 13.5	4.3 18.5	4.2 24	74 29	72 35	73 43			
939.17													
72 43	x 89 32	45 18.5	4.65 13.5	4.56	4.64 13.5	4.5 19	4.0 31	x 78 43					
(226+20 = 0.0 Ditch Rt.)													
30 43	x 70 31	45 18.5	4.57 13.5	4.50	4.63 13.5	4.5 18.5	21 25	22 31.5	66 34	x 62 43			
79 43	x 20 30	46 18.5	4.57 13.5	4.48	4.57 13.5	4.5 18.5	70 22.5	20 31	62 32	x 57 43			
(75+20 = 0.0 Ditch Lt.)													
51 43	x 61 31	76 28	24 24.5	46 18.5	4.37 13.5	4.45	4.2 13.5	4.4 18.5	67 23	x 64 43			
(325+30 = 0.0 Ditch Rt.)													

Final

Cross Sections

Sta.	B. S.	H. I.	F. S.	Grade	Gr. R.
		943.73			
224+50				38.6	5.13.
224				38.5	5.23.
+50				38.4	5.33.
223				38.2	5.53.
+50				38.1	5.63.
222				37.9	5.83.
+50				37.8	5.93.
221				37.6	6.13.
+50				37.5	6.23.
220				37.4	6.33.
T.P.	9.10	947.19	5.64		
+75				37.5	9.69.
219+50				37.6	9.59.

Inst. W.H.C.
 Rod. A.L.P.
 Chain. R.R.P.

NOV. 12, 1926 23

Left						Av.	C L	Av.	Right					
13	14	20	21	21	40	4.65	4.56	4.68	4.5	6.5	6.5	40	36	38
43	38	34	27	23	185	1.35		1.35	1.8	2.2	2.9	33	38	43

22413 = 0.0 Ditch 84

21	17	21	47	68	46	4.73	4.68	4.76	4.7	6.6	6.8	56	47	40
43	39	36	28	23.5	185	1.25		1.25	1.8	2.3	2.85	36	41	43

56	40	58	74	21	50	4.25	4.79	4.88	4.8	7.0	7.0	7.0	45	13
43	36	32.5	29	23.5	19	1.35		1.35	1.8	2.25	2.9	36	39.5	43

45	59	74	21	49	50	5.01	4.93	5.02	5.0	6.8	7.0	36	28	21
43	33	30	22.5	18	185	1.25		1.25	1.8	2.2	2.8	36	36	43

7.7	76	82	80	5.1	5.17	5.06	5.16	5.1	6.6	6.6	49	19
43	34	32	24	1.8	1.35		1.35	1.85	2.3	3.0	3.5	43

(22245 = 0.0 Ditch LT.)

9.5	83	52	5.35	5.26	5.31	5.3	7.3	7.2	6.6	6.6
43	30	1.85	1.35	1.35	1.8	2.4	3.1	3.2	43	

221190 = 0.0 Ditch 11

11.2	109	53	5.42	5.35	5.43	5.3	7.9	9.0
43	33	1.85	1.35	1.35	1.8	3.0	4.3	

10.2	103	5.4	5.36	5.47	5.55	5.5	10.7	10.8
43	33	1.9	1.35	1.35	1.85	3.15	4.3	

9.3	85	5.5	5.7	5.62	5.74	5.8	10.5	10.7
43	30	1.95	1.35	1.35	1.9	3.4	4.3	

720+10 = 0.0 Ditch LT.

7.2	77	8.6	8.6	6.1	5.74	5.63	5.72	5.6	8.5	8.3
43	30	2.8	1.35	1.85	1.35	1.25	1.9	2.8	4.3	

932.09

carb Av.

219 + 90 = 0.0 Ditch 11

9.8	86	89	121	121	21	8.90	8.9	9.10	9.18	9.0	10.9	11.0	10.2	10.4
43	34	31	22	23	18	1.35	1.25	1.35	1.35	1.85	2.1	2.2	3.0	4.3

2.0	40	8.5	120	120	28	8.33	8.10	8.60	8.0	10.5	10.5	8.7	8.5	8.4
43	35	30.5	22	23	18	1.35	1.25	1.35	1.35	1.85	2.2	2.85	3.2	4.3

Final

Cross Sections

Sta.	B. S.	H. I. ✓	F. S.	Grade	Gr. R.
		947.19			
219+00				37.9	9.79.
+50				38.5	8.69.
218				39.3	7.89.
+60				40.1	7.09.
+25.8				40.9	6.29.
217				41.4	5.79.
+50				42.5	4.69.
+31				42.9	4.29.
216				43.6	3.59.
+50				44.7	2.49.
T.P.	767	954.10 ✓	876		
215				45.8	8.30.
214+50				46.9	7.20.

Inst. W.A.C.
 Rod. A.L.D.
 Chain. R.P.

NOV 12, 1926 24

Left			Curb Pav.		CL	Pav.	Right								
60 43	58 38	66 34	109 27	109 13	84 18	845 135	372 125	8.60	8.70 135	26 135	102 228	102 29	53 36	56 89	50 43
46 43	46 39	51 35	101 27	96 21.5	78 18.5	785 135	812 125	8.04	8.13 135	27 19	25 23	9.5 29	63 35	53 38	54 43
70 43	68 36	73 32	90 27	90 23	70 18	714 135	740 125	7.80	7.86 135	72 135	29 23	92 30	67 32.5	63 36	5.8 43
(217+70=0.0 Ditch Lt.)															
75 43			93 20.5	64 19	630 142	657 13.0	652	6.57	6.57 135	65 19	21 23	20 30	64 32.0		5.9 43
12 43			108 35	54 20.5	537 15.4	585 14.4	577	5.70	5.70 135	58 19.5	72 23	75 29.5	56 32	53 34	4.7 43
112 43			108 36	48 21.5	501 16.3	538 15.4	519	5.21	5.21 15.0	58 20	70 24.5	62 31	50 33	47 35	4.3 43
114 43			113 40	43 23.5	406 172	431 16.0	421								
116 43			115 41.5	41 24	371 172	400 16.0	3.85	3.55	3.55 361	3.3 36.5	46 40	40 45		22 48	
117 43			110 41.5	33 23	316 172	342 16.0	3.16	3.01	3.01 135	3.1 32			37 45	43 43	5.3 5.6
(215+90=0.0 Ditch Rt.)															
			145 42	33 22	234 172	257 16.0	1.98	1.46	1.46 135	1.4 190	56 31			57 43	
946 43			177 45.5	82 20.5	214 172	235 162	267	2.23	2.23 135	21 18.5	39 24.5	93 37	28 41		
125 43			144 35	20 21.5	694 172	716 162	664	6.25	6.25 135	58 19	27 22	76 28		21 33	

Final

Cross Sections

Sta.	B. S.	H. I. ✓ 954.10	F. S.	Grade	Gr. R.
214+14				47.2	6.90.
214				47.6	6.50.
+88				48.3	5.80.
+78				48.4	5.70.
+50				48.97	5.13.
213				49.43	4.67.
+76.6				49.46	4.64.
212+66.6				49.48	4.62.
212+40					
B.M.			1.78		

Inst. W.H.C.
 Rod. A.L.P.
 Chain. P.R.

Nov. 12, 1926 ²⁵

	Left				C.I.			Right	
$\frac{118}{43}$	$\times \frac{102}{31}$	$\frac{62}{22}$	$\frac{571}{172}$	$\frac{607}{162}$	$\frac{589}{-}$	$\frac{564}{135}$		$\frac{570}{220}$	

$\frac{100}{43}$	$\times \frac{86}{275}$	$\frac{55}{21}$	$\frac{564}{172}$	$\frac{596}{162}$	$\frac{558}{-}$	$\frac{535}{135}$		$\frac{537}{142}$
------------------	-------------------------	-----------------	-------------------	-------------------	-----------------	-------------------	--	-------------------

(214400 = 0.0. Ditch 4.)

$\frac{80}{43}$	$\times \frac{70}{315}$	$\frac{24}{325}$	$\frac{82}{28}$	$\frac{53}{22}$	$\frac{535}{172}$	$\frac{561}{162}$	$\frac{521}{-}$	$\frac{515}{8}$
-----------------	-------------------------	------------------	-----------------	-----------------	-------------------	-------------------	-----------------	-----------------

Note! -
 Dotted line indicates
 west edge of Lex.
 Ave. Pavement.

$\frac{64}{43}$	$\times \frac{59}{37}$	$\frac{20}{33}$	$\frac{74}{26}$	$\frac{50}{22}$	$\frac{510}{172}$	$\frac{534}{162}$	$\frac{500}{-}$	$\frac{497}{42}$
-----------------	------------------------	-----------------	-----------------	-----------------	-------------------	-------------------	-----------------	------------------

					C.	P.		
$\frac{44}{43}$	$\times \frac{41}{40}$	$\frac{74}{52}$	$\frac{71}{27}$	$\frac{42}{215}$	$\frac{450}{172}$	$\frac{477}{162}$	$\frac{457}{115}$	$\frac{450}{-}$

(213710 = 0.0. Ditch 4.)

					C.	P.		
$\frac{72}{43}$	$\times \frac{57}{25}$	$\frac{41}{205}$	$\frac{394}{152}$		$\frac{420}{142}$	$\frac{418}{126}$		$\frac{407}{-}$


					C.	P.		
$\frac{75}{43}$	$\times \frac{71}{28}$	$\frac{40}{195}$			$\frac{380}{147}$	$\frac{411}{139}$		$\frac{401}{-}$

					C.	P.		
$\frac{77}{43}$	$\times \frac{49}{32}$	$\frac{39}{24}$	$\frac{39}{182}$		$\frac{385}{145}$	$\frac{409}{135}$		$\frac{400}{-}$

Somehow only

952.32

P.R. spike 30" oak 65' RT. Sta. 213740

 


Notes For staking Pavement

Station	+	H. I	-	Top of Pave Grade
B.M.	3.42	942.70		939.28
255+19.5				931.89
255+00				32.17
+75				33.12
+69.5				.
+50				34.20
+25				35.11
254+00				35.93
+75				36.69
+50				37.35
+25				37.95
253+00				38.47
+75				38.91
+50				39.27
+25				39.60
252+00				39.92
+75				40.25
+50				40.57
+25				40.88
251+00				41.12
250+75				41.33

Lt. ♀ Rt.

Remarks	Width	Gr. Rod	+ or -	Gr. Rod.	+ or -	Gr. Rod	Width	Remarks
								W.H.C. A.L.P. R.E. W.A. Oct 8, 1926
	13.5	11.53	-0.12	11.41	-0.12	11.53	15.3	P.C.
✓	10.65	10.65	-0.12	10.53	✓	10.65	14.0	
✓	9.70	9.70	-0.12	9.58	✓	9.70	13.6	
							15.5	B.W.T.
✓	8.62	8.62	✓	8.50	✓	8.62	13.5	
✓	7.71	7.71	✓	7.59	✓	7.71	✓	
✓	6.89	6.89	✓	6.77	✓	6.89	✓	
✓	6.13	6.13	✓	6.01	✓	6.13	✓	
✓	5.47	5.47	✓	5.35	✓	5.47	✓	
✓	4.87	4.87	✓	4.75	✓	4.87	✓	
✓	4.35	4.35	✓	4.23	✓	4.35	✓	
✓	3.91	3.91	✓	3.79	✓	3.91	✓	
✓	3.55	3.55	✓	3.43	✓	3.55	✓	
✓	3.22	3.22	✓	3.10	✓	3.22	✓	
✓	2.90	2.90	✓	2.78	✓	2.90	✓	
✓	2.57	2.57	✓	2.45	✓	2.57	✓	
✓	2.25	2.25	✓	2.13	✓	2.25	✓	
✓	1.94	1.94	✓	1.82	✓	1.94	✓	
✓	1.70	1.70	✓	1.58	✓	1.70	✓	
13.5	1.49	1.49	-0.12	1.37	-0.12	1.49	13.5	

Station	+	H.I	-	TOP \bar{E} Pave Grade
		942.70		
250+50				941.98
+25				41.59
250+00				41.64
+25				41.66
249+50				41.62
B.M.	6.25	945.53	3.42	939.28
249+25				41.52
249+00				41.38
+75				41.20
+50				40.96
+25				40.68
248+00				40.34
+75				39.96
+50				39.53
+25				39.05
247+00				38.52
+75				37.95
+50				37.32
+25				36.69
246+00				36.11
T.P.	0.70	936.69	9.54	935.99
+75				35.58
245+50				35.09

Remarks	Width	Lt.		C		Rt.		Remarks
		Gr. Red	+ or -	Gr. Red.	+ or -	Gr. Red.	Width	
	13.5	1.34	-0.12	1.22	-0.12	1.34	13.5	
	✓	1.23	✓	1.11	✓	1.23	✓	
	✓	1.18	✓	1.06	✓	1.18	✓	
	✓	1.16	✓	1.04	✓	1.16	✓	
	13.5	1.20	-0.12	1.08	-0.12	1.20	13.5	
	13.5	4.13	-0.12	4.01	-0.12	4.13	13.5	
	✓	4.27	✓	4.15	✓	4.27	✓	
	✓	4.45	✓	4.33	✓	4.45	✓	
	✓	4.69	✓	4.57	✓	4.69	✓	
	✓	4.97	✓	4.85	✓	4.97	✓	
	✓	5.31	✓	5.19	✓	5.31	✓	
				5.57	✓	5.69	✓	
				6.00	✓	6.12	✓	
				6.48		6.60		
				7.01		7.13		
				7.58		7.70		
				8.21		8.33		
				8.84		8.96		
				9.42	-0.12	9.54	13.5	
Tag Blue Top on Rt.				1.11	-0.12	1.23	13.5	
				1.60	✓	1.72	✓	

Station	+	H.I	-	Top of Pave Grade
		936.69		
245+25				34.64
245+00				34.25
+75				33.89
+50				33.59
+25				33.33
244+00				33.11
+75				32.94
+50				32.82
+25				32.71
243+00				32.57
T.P.	3.65	935.61	473	
+75				32.41
+50				32.22
+25				32.01
242+00				31.77
+75				31.51
+50				31.22
+25				30.91
241				30.57
+75				30.21
+50				29.82
240 +25				29.41

Lt.

L

Rt.

Width	G. R.	+ or -	G. Rad	+ or -	G. R.	Width
			2.05	-0.12	2.17	13.5
			2.05	-0.12	2.17	
			2.44	✓	2.56	
			2.80		2.92	
			3.10		3.22	
			3.56		3.48	
			3.58		3.70	
			3.75		3.87	
			3.87		3.79	
			3.98		4.10	
			4.12	-0.12	4.24	13.5
Br. 96	Top Hub 20' Rt.		Sta. 243100			
			3.20	-0.12	3.32	13.5
			3.39		3.51	
			3.60		3.72	
			3.84		3.96	
			4.10		4.22	
			4.39		4.51	
			4.70		4.82	
			5.04		5.16	
			5.40		5.52	
			5.79		5.91	
			6.20		6.32	

2.17

	+	H.I.		Top & Prev. Grade
B.M.	0.65	932.41		928.97
240 to J				28.51 ✓
239 + 75				28.02 ✓
+50				27.52
+25				27.02
239				26.52
+75				26.07
+50				25.72 ✓
+25				25.47 ✓
238				25.32
+75				25.27
+50				25.32
+25				25.47
237 + 00				25.72
+75				26.07
+50				26.52
+25				27.07
236 + 00				
T.P.	12.13	938.52	6.02	27.72
+75				28.42
+50				29.12
+25				29.82
235				30.52 ✓
234 + 75				

	Width	Gr	+ or -	Gr. Rod	+ or -	E.R.	Width	
931.76	13.5	3.56	-0.12	3.44	-0.12	3.56	13.5	
				3.90		4.02		
				4.39		4.51		
				4.89		5.01		
				5.39		5.51		
				5.89		6.01		
				6.34		6.46		
				6.69		6.81		
				6.94		7.06		
				7.09		7.21		
				7.14		7.26		
				7.09		7.21		Low Point in Pav.
				6.94		7.06		
				6.69		6.81		
				6.34		6.46		
				5.89		6.01		
				5.34		5.46		
926.39				10.80		10.92		
				10.10		10.22		
				9.40		9.52		
				8.70		8.82		
				8.00		8.12		

35.61
2.91
5

32.41
6.1
6

Station	+	H.I		Top of Pav. Grade
		938.52		
234+50				931.22
+75				31.92
234				32.62
+75				33.27
+50				33.89
+25				34.42
233				34.92
+75				35.34
+50				35.69
+25				35.99
232				36.22
+75				36.42
+50				36.62
+25				36.82
231				37.02
+75				37.22
+50				37.42
+25				37.62
230+00				37.82
B.M.	6.82	943.15	2.19	936.33
+75				38.01
+50				38.16
+25				38.34

	G.P.	+ or -	G.R.	Width
13.5	7.30	-0.12	7.42	13.5
	6.60	✓	6.72	
	5.90	✓	6.02	
	5.25	✓	5.37	
	4.63	✓	4.75	
	4.10	✓	4.22	--
	3.60	✓	3.72	
	3.18	✓	3.30	
	2.83	✓	2.95	
	2.53	✓	2.65	
	2.30	✓	2.42	
	2.10	✓	2.22	
	1.90	✓	2.02	
	1.70	✓	1.82	
	1.50	✓	1.62	
	1.30	✓	1.42	
	1.10	✓	1.22	
	0.90	✓	1.02	
	0.70	✓	0.82	
spike in stump 40' Lt. 2304 85				
	5.14	✓	5.26	
	4.99	✓	5.11	
	4.81	-0.12	4.95	

Sta.	+	H.I.		Top of Pvt. Grade
229+00		943.15		738.47
+75				38.59
+50				38.66
+25				38.76
228				38.82
+75				38.87
+50				38.92
+25				38.97
227				39.02
+75				39.07
+50				39.12
+25				39.16
226				39.20
+75				39.22
+50				39.24
+25				39.24
225				39.23
T.P.	3.61	942.73	403	939.12
+75				39.22
+50				39.19
+25				39.15
224				39.10
223+75				39.04

Gr. Red.	+ or -	G.R.	Width
4.68	-0.12	4.80	
4.56	✓	4.68	
4.49		4.61	
4.37		4.57	
4.33		4.45	
4.28		4.40	
4.23		4.35	
4.18		4.30	
4.13		4.25	
4.08		4.20	
4.03		4.15	
3.99		4.11	
3.95		4.07	
3.93		4.05	
3.91		4.03	
3.91		4.03	
3.92		4.02	
3.57		3.63	
3.54		3.66	
3.58		3.70	
3.63		3.75	
3.69		3.81	

Station	+	H.I.		Top E	
		942.73		FAVO Grade	
223+50				938.97	
+25				38.90	
223				38.82	
+75				38.75	
+50				38.67	
+25				38.60	
222				38.52	
+75				38.45	
+50				38.37	
+25				38.30	
221				38.22	
+75				38.15	
+50				38.07	
+25				38.03	
220				38.02	
T.P.	7.44	945.34	4.83		927.90
+75				38.08	
+50				38.19	
+25				38.35	
219				38.56	
+75				38.82	
+50				39.14	
+25				39.50	

station.	+	H.I.		Top \hat{E}	Par. Error
		945.34			
218+00				939.92	
217+75.8					
+75				40.40	
+50				40.92	
217+25.8				41.47	
T.P	10.21	953.43	2.12		943.22
217+00				42.02	
216+75				42.57	
216+50				43.12	
216+25				43.67	
216+00 ⁹				44.22	
216+00				44.22	
215+75				44.77	
215+50				45.32	
215+25				45.87	
215				46.42	
+75				46.97	
+50				47.52	
+25				48.07	
214				48.62	
+75					
+50					
+25					
213					

L. I RT

Width	E.T.	+ or -	G.R.	+ or -	G.R.	Width
13.5	5.54	-0.12	5.42	-0.12	5.54	13.5
B.W.T.						
13.5	5.06	✓	4.94	-0.12	5.06	✓
14.5	4.54	✓	4.42	✓	4.54	✓
P.T.						
15.5	3.99	✓	3.87	✓	3.99	13.5
Top of R.W. 43' RT. C.K. 217 + 25.8						
16.8	11.54	-0.13	11.41	-0.12	11.53	14.7
17.2	11.01	-0.15	10.86	-0.12	10.99	12.4
17.2	10.55 10.47	0.08 0.02	10.31	-0.12	10.43	24.2
17.2	10.16 9.88	0.04 0.12	9.76	-0.12	9.88	33.2
17.2	9.23	0.12	9.21	-0.12	9.23	16+13.8=32.9 Wide
✓	9.71	-0.50	9.21	-0.12	9.13	13.5
✓	9.26	-0.60	8.66	+0.30	8.96	
✓	8.91	-0.80	8.11	+0.40	7.71	
✓	8.36	-0.80	7.56	+0.40	7.16	
✓	7.81	-0.80	7.01	+0.40	6.61	
✓	7.26	-0.80	6.46	+0.40	6.06	
✓	6.61	-0.70	5.91	+0.30	5.61	
✓	5.96	-0.60	5.36	+0.16	5.20	
✓	5.31	-0.50	4.81	+0.09	4.72	13.5
17.2	4.71	-0.40	4.31			3.4
17.0	4.16	-0.30	3.86			
16.0	3.85	-0.23	3.62			
15.7	3.60	-0.17	3.43			

For Detail see P. 38

sta.

+

H.I

953.43

212+76.6

212+66.6


B.M.


1.12

952.31

P.C.	14.6	3.47	10.10	3.36
		3.45	10.10	3.25

(R.R. spike 30" oak 65' Rt.)
213+46

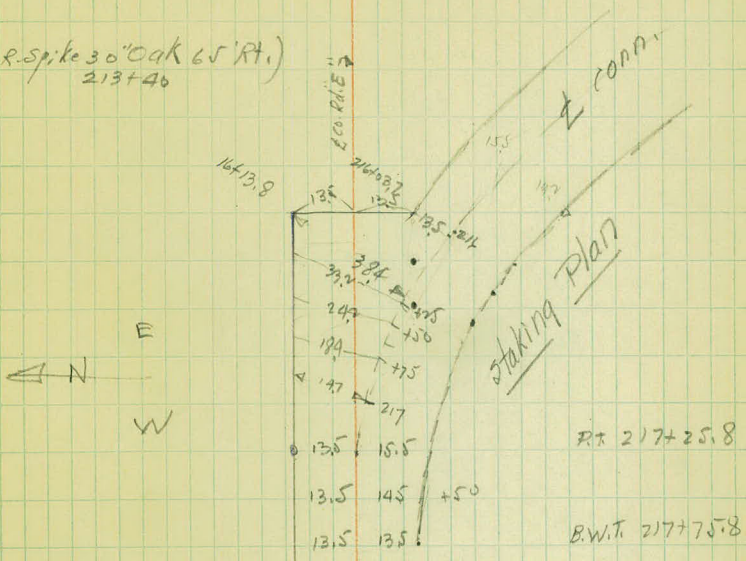


 

Final Topography.


Final Topography.

Misc. Finals see pages 51, 52, 53.

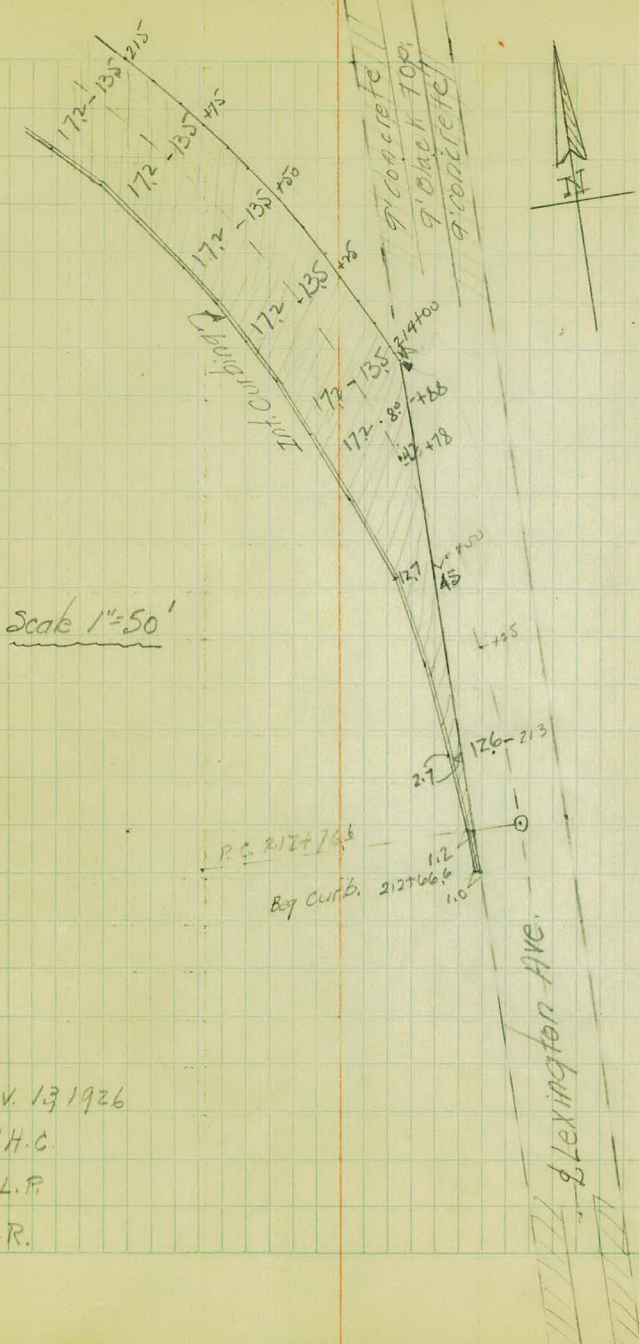

Scale 1"=50'

Nov. 13 1926
 W.H.C.
 A.L.P.
 R.R.

 



1 mi. Curbing

B.W.T. 217+75.8

P.T. 217+25.80

177-R.P. 34'

Scale 1" = 50'

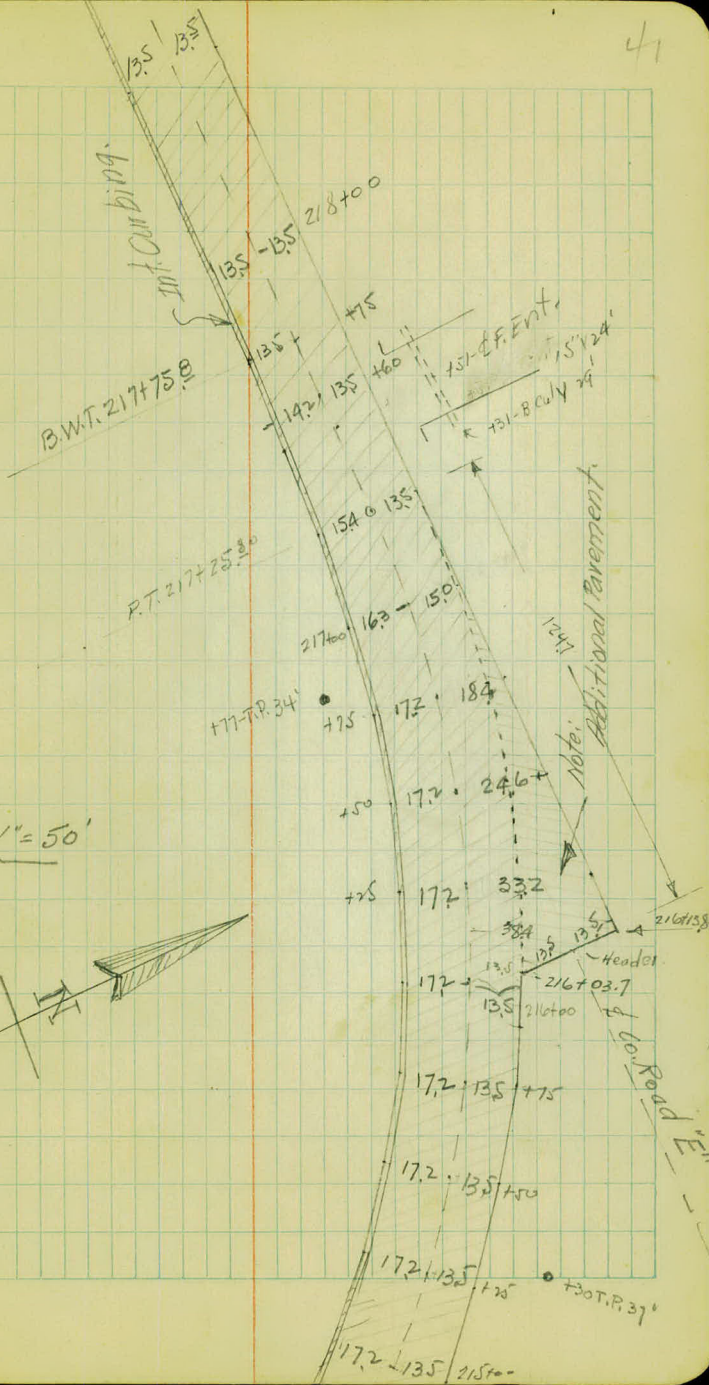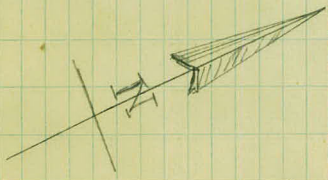

223

222

221

185 - £ 18" x 56' P.3

220

219

218

135 135

+27-T.P. 38



+43-T.P. 38'



300

265

+49.5- E. Curbing.

+83.5 B. Curbing
+02- E. Spillway



+96.5- E. Curbing.

Scale 1/4" = 100'

+60-T.P. 38'



Curbing.

+03-T.P. 38'



228

227

158 £ 18" x 56' P.3

226

225

224

223

135 135

+60-T.P. 38
+57-F. Ctr. 43



280 285

+24-T.P. 38



+90-T.P. 38



+53-T.P. 38



233

232

231

122- L.F. ENT LT

230

229

228

F. 43'

135 135

Nov. 12, 1926

44

W.H.C.

A.L.P.

R.R.

+29-T.P. 38

+35-T.P. 58'

15" x 24" C.M.
+10-B. CULV. 31

+10-T.P. 38

F. 44'

cultivated.

+85-T.P. 38

238

237

236

235

234

767 F. Ent Rt.

233

F. 43'

135 135

45

+56-T.P. 37'

+47-B. curbing.
+44-E Spillway
+35-E. Curbing.

+46-B. curbing.
+39.5 E Spillway.
+34-E. curbing

+34-T.P. 37'

curbing

Curbing.

+06-T.P. 37'

+74.5 Beg Curbing

+72.5-Beg Curbing.

+85-T.P. 37'



15' 24" C.M.

+85-B. Culv. 29'

243

242

241

+74.1 *E Hamline Ave.*

240

239

+50- *E 18" X 64' P.3*

238

+49 - F. Col. 43'



+24 - T.P. 37'



+75 - E. Curbing.

+85 - T.P. 37'



32.3

32.7


North

A-WIRES

+46 - T.P. 70'
15" X 54' C.M.

+51 - B. Curb 22'

+14 - E. Curbing.

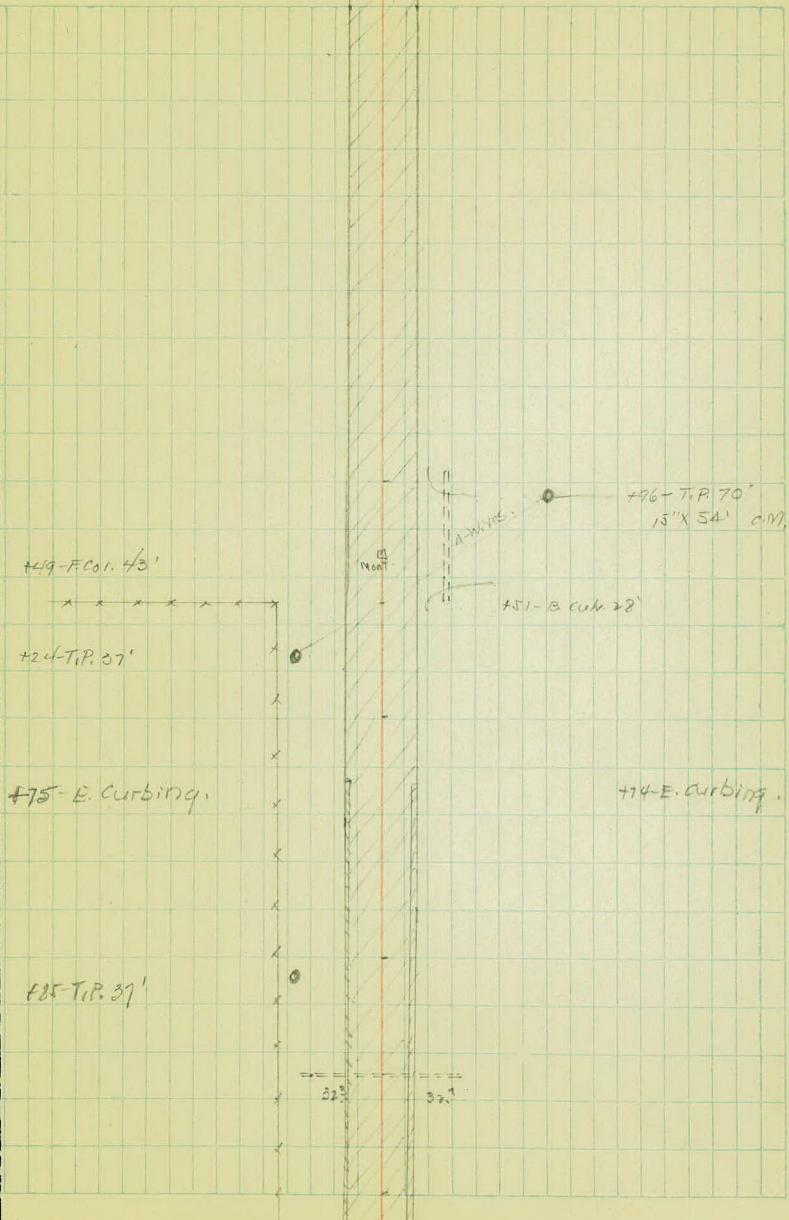

248

247

+22- £ FENT H.

246

245

+73- £ 18" x 72' P3

244

243

+50-E. Curbing.

+50-E. Curbing.

15" x 24" C.M.
+10-B. curv. 30'



Pasture.

Pasture.



+83 - B. curbing.
+75 - L. spillway.
+70 - E. curbing.

+83 B. curbing.
+70 - L. Spillway.

+75 - E. Curbing

+02.5 - Beg Curbing.

+03.5 - E. Curbing.

253

252

251

+42- E.F. Ent Rt.

250

249

248

F-43'

NS 135

Timber.

27 One Course Concrete.

cultivated.



15x24' C.M.
138-8' C.M. 80'

199-F Cor 43'



259

258

257

256

PC = +19.5 End of 1926 Pavement.

255

254

422 - L.F. Ent Rt

253

W.H.C.

NOV. 5, 1926

R.R.

C.L.

F-43

F-43'

F-43'

F-44'

(2" x 10" x 29' Fir Header)

F-44'

135 1528

-140

135 + 69.5 = B.W.T.

Timber


27' fine coarse concrete

Timber

139-B.F. 43

F-43'

15" x 24" C.M.
110-B. C.W. 375

 


Miscellaneous Finals

X-Drains; Side Drains, and F. Entrances.

Station	Descrip.	P.B. Cu.V.	C.M. Cu.V.	Lin. Ft. Curbing	
		18"	15"	Left	Right
253+22	F. Ent Rt.		24'		
250+42	F. Ent Rt.		24'		
246+22	F. Ent Lt.		24'		
240+70 ⁺	^{Curb. Rt.} Hornline Rt.		54		
233+67	F. Ent. Rt.		24		
230+22	F. Ent. Lt.		24		
217+51	F. Ent Rt.		24		
244+73		72			
238+50		64			
226+58		56			
220+85		56			
Total		248	198		

W.H.C.
H.L.P.
R.R.

Nov. 13, 1926

51

Embankment

Excavation.

1' x 9' x 22' = 7 cu. yds

1' x 9' x 22' = 7 cu. yds

2' x 9' x 22 = 14 cu. ~~yds~~

NONE

1' x 9' x 22 = 7 cu. yds

1.5' x 9' x 22 = 10 cu. ~~yds~~

1' x 9' x 22 = 7 cu. yds

52 cu. yds

Misc Finals contd

Station ^{to}	Station	Lineal Feet curbing	
		Lt	Rt.
234+74.5	237+35.0	260.5	
234+73.5	237+34		259.0
237+47.0	239+75.0	227.0	
237+46.0	239+74.0		228.5
243+03.5	243+95.0		90.5
243+02.5	243+70.0	67.0	
244+08.0	246+50.0		242.0
243+83	246+50.0	266.0	
212+66.0	219+96.5	707.5	
220+08.5	220+49.5	41.0	
		<u>1569.0</u>	<u>820.0</u>
Total Lineal Feet Curbing			2389

Headers

255+19.5	29'	
216+08	27'	
Left Cord E.		
Bit Fill Jt.		135' Lin Ft.

W.H.C

NOV 13 1926

A.L.P

R.R.



Misc. Final cont'd
Concrete Spillways.

737+39.5

237+41.0

243+75

244+00

220+03




W.H.C.


Lt.

L

Rt. Nov. 13, 1926 53

A.L.P.
R.R.

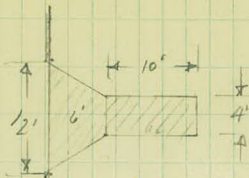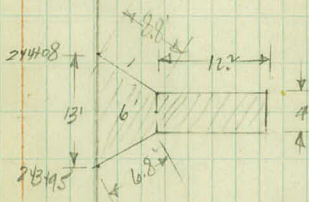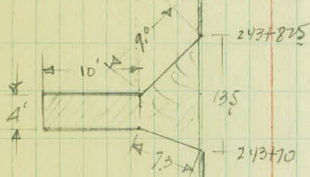

 


Alignment for Borrow Pit

(Align same as Relocation of Co. Rd. "E.")

13+74.4

P.T.

12 C.R.T.

AI: 16'

PI: 13+11⁰⁰

T: 63.3

L: 126.7

12+47.7

P.C.

0+00 Mont.

Aug 14, 1926

W.H.C.
A.L.P.
H.T.P.
W.A.


T.P. ○

52.55 ○

42.60 ○

T.P. ○

In sec line
E Co. Road E.

 

Mont Set in Pav.



E Anoko COND.

○ P.T.

X-sec. for Borrow Pit.

E. along Co. Road E. Beg. at Lexington Av.

Sta.	+	H.J	-	Elev.
B.M.	0.36	952.67 ✓		952.31
B.M.	4.40	951.81 ✓	5.26	947.41 ✓
0+00			5.50	46.31 ✓
0+20				46.21
0+33				46.41
0+66				46.81
T.P.	8.18	955.52 ³ ✓	4.46	947.34 ⁵ ✓
1+00				47.21
1+50				47.91
2+00				48.71
+30				48.71
T.P.	6.56	955.29 ✓	6.80	948.73 ✓
+65				48.81
3+00				48.71
3+50				48.61

Aug-14, 1926

W.H.C.
A.L.P.
H.T.P.
W.A.

Anoka Line

P.R. Spike 30" Oak 65' Rt. Sta. 213+40

1 16" Oak N.E. Cor. Lex. & Co Rd E'

Top Mon & Lex. Av.

$$\frac{66}{33}$$

$$\frac{63}{19}$$

$$\frac{56}{17}$$

$$\frac{55}{17}$$

$$\frac{55}{33}$$

$$\frac{65}{33}$$

$$\frac{62}{19}$$

$$\frac{54}{17}$$

$$\frac{56}{20}$$

$$\frac{63}{25}$$

$$\frac{60}{29}$$

$$\frac{45}{20}$$

$$\frac{43}{33}$$

$$\frac{56}{33}$$

$$\frac{50}{20}$$

$$\frac{53}{17}$$

$$\frac{50}{17}$$

$$\frac{56}{10}$$

$$\frac{58}{13}$$

$$\frac{37}{17}$$

$$\frac{41}{33}$$

$$\frac{63}{33}$$

$$\frac{61}{23}$$

$$\frac{80}{20}$$

$$\frac{92}{17}$$

$$\frac{86}{13}$$

$$\frac{83}{17}$$

$$\frac{88}{10}$$

$$\frac{91}{14}$$

$$\frac{78}{17}$$

$$\frac{27}{25}$$

$$\frac{20}{33}$$

$$\frac{52}{33}$$

$$\frac{42}{26}$$

$$\frac{66}{22}$$

$$\frac{85}{18}$$

$$\frac{74}{11}$$

$$\frac{76}{17}$$

$$\frac{85}{12}$$

$$\frac{81}{13}$$

$$\frac{72}{20}$$

$$\frac{17}{28}$$

$$\frac{21}{33}$$

$$\frac{85}{33}$$

$$\frac{74}{24}$$

$$\frac{86}{21}$$

$$\frac{81}{17}$$

$$\frac{71}{10}$$

$$\frac{68}{17}$$

$$\frac{73}{7}$$

$$\frac{80}{10}$$

$$\frac{85}{15}$$

$$\frac{79}{22}$$

$$\frac{34}{30}$$

$$\frac{34}{33}$$

$$\frac{100}{33}$$

$$\frac{95}{23}$$

$$\frac{75}{17}$$

$$\frac{68}{11}$$

$$\frac{68}{17}$$

$$\frac{25}{8}$$

$$\frac{26}{12}$$

$$\frac{84}{19}$$

$$\frac{71}{25}$$

$$\frac{64}{33}$$

$$\frac{126}{33}$$

$$\frac{116}{25}$$

$$\frac{82}{20}$$

$$\frac{73}{17}$$

$$\frac{65}{10}$$

$$\frac{65}{17}$$

$$\frac{71}{6}$$

$$\frac{86}{10}$$

$$\frac{89}{12}$$

$$\frac{63}{18}$$

$$\frac{68}{28}$$

$$\frac{52}{33}$$

$$\frac{128}{33}$$

$$\frac{109}{23}$$

$$\frac{76}{19}$$

$$\frac{67}{17}$$

$$\frac{66}{17}$$

$$\frac{69}{5}$$

$$\frac{76}{8}$$

$$\frac{78}{71}$$

$$\frac{64}{12}$$

$$\frac{54}{28}$$

$$\frac{42}{33}$$

$$\frac{97}{33}$$

$$\frac{87}{26}$$

$$\frac{71}{19}$$

$$\frac{66}{13}$$

$$\frac{67}{17}$$

$$\frac{74}{6}$$

$$\frac{40}{12}$$

$$\frac{26}{26}$$

$$\frac{19}{33}$$

Sta.	+	H.I	-	Elev.
		755.28		
4+00				48.2
+50				47.5
5+00				46.7
+50				45.6
6+00				44.7
T.P.	3.50	948.08	10.71	944.58
6+50				43.5
7+00				42.5
checking.	6.41	953.77	0.72	947.36
			7.45	946.32

Final X-Sec. of Borrow Pit

E. along Co Road E' beg @ Lex. Ave.

Station	+	H.I.	-	Orig. of Elev.	Gr. Red.
B.M.	739	953.70		946.31	
0+00					
0+20					
0+33					
0+66					
1+00					
1+50					
2+00					
+					
+					
3+00					
3+50					

W.H.C.
H.L.P.
H.T.P.
W.A.

Lt

L

Rt

Aug. 27, 1926

74

Top L Stone Mor.

7.39

7.5

$\frac{86}{33}$

$\frac{81}{17}$

$\frac{75}{17}$

$\frac{74}{17}$

$\frac{74}{33}$

$\frac{88}{33}$

$\frac{75}{14}$

7.3

$\frac{72}{17}$

$\frac{75}{20}$

$\frac{80}{24}$

$\frac{78}{29}$

$\frac{66}{33}$

$\frac{73}{34}$

$\frac{86}{32}$

$\frac{85}{21}$

$\frac{74}{10}$

6.9

6.9

$\frac{72}{7}$

$\frac{79}{19}$

$\frac{81}{29}$

$\frac{60}{33}$

$\frac{45}{33}$

$\frac{77}{30}$

$\frac{27}{20}$

$\frac{66}{11}$

6.4

6.4

$\frac{69}{10}$

$\frac{75}{15}$

$\frac{74}{26}$

$\frac{11}{30}$

$\frac{37}{33}$

$\frac{73}{27}$

$\frac{71}{19}$

$\frac{61}{13}$

5.8

5.8

$\frac{60}{8}$

$\frac{73}{15}$

$\frac{68}{24}$

$\frac{02}{33}$

$\frac{69}{33}$

$\frac{61}{15}$

$\frac{54}{10}$

5.0

5.0

$\frac{54}{6}$

$\frac{58}{10}$

$\frac{72}{14}$

$\frac{69}{25}$

$\frac{16}{33}$

2+10 = 0.0. cut Lt

$\frac{58}{18}$

$\frac{53}{10}$

5.0

5.0

$\frac{52}{6}$

$\frac{58}{8}$

$\frac{69}{12}$

$\frac{67}{27}$

$\frac{44}{31}$

$\frac{46}{33}$

No borrow here

$\frac{56}{17}$

$\frac{52}{10}$

4.9

5.0

$\frac{54}{5}$

$\frac{62}{8}$

$\frac{20}{10}$

$\frac{67}{24}$

$\frac{60}{29}$

$\frac{42}{33}$

$\frac{61}{19}$

$\frac{52}{12}$

5.0

5.0

$\frac{52}{5}$

$\frac{59}{8}$

$\frac{66}{10}$

$\frac{66}{24}$

$\frac{58}{28}$

$\frac{25}{33}$

$\frac{54}{19}$

$\frac{50}{13}$

5.2

5.2

$\frac{53}{5}$

$\frac{62}{8}$

$\frac{4}{10}$

$\frac{61}{23}$

$\frac{02}{33}$

Station	Final +	X-Sec. H.I.	Borrow -	Pit (Cond) Original & Elev.	Gr. Rod
4+00		953.70 ✓			
4+50					
5+00					
5+50					
6+00					
6+50					
7+00					
B.M.			7.39	46.31	

A

L

R1

576 = 0.0. Cut Lt.

42	68	65	57	58
36	32	22	18	13

(55)

54	56	62	65	109
6	6	9	23	33

35	68	68	63	59
35	30	22	19	14

(2)

60	63	67	68	13
6	5	7	23	33

(10)

29	80	80	72	67
37	31	23	22	14

70	70	78	77	28
-	4	6	23	33

(11)

20	84	85	78	75
39	33	22	20	14

79	80	90	91	64
-	5	5	27	33

(90)

58	96	97	89	86
39	35	23	21	15

90	91	100	106	90
-	2	5	31	33

(102)

48	99	103	98	96
37	35	23	21	14

100	103	117	72	109	125
-	4	12	19	22	33

(6+73 = 0.0. Cut Lt.)


(6+62 = 0.0. Cut R1.)

Same as original!

top stone Mon.


compute Overhaul

All material placed bet.
Sta. 214+00 - to 217+25

 

DIETZGEN'S RAILROAD CURVE AND REDUCTION TABLES

Copyright, 1914, by Eugene Dietzgen Co., New York City

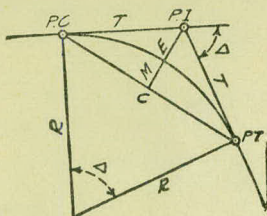

CURVE FORMULAS

Radius= $R = \frac{50}{\sin. \frac{D}{2}}$ (1) Degree of Curve= D and $\sin. \frac{D}{2} = \frac{50}{R}$ (2)

Tangent= $T = R \tan \frac{\Delta}{2}$ (3) Length of Curve= $L = 100 \frac{\Delta}{D}$ (4)

Middle ordinate= $M = R(1 - \cos. \frac{\Delta}{2}) = R \text{vers} \frac{\Delta}{2}$ (5) (6)

External= $E = T \tan \frac{\Delta}{4} = R \div \cos. \frac{\Delta}{2} - R$ (8) = $R \text{exsec} \frac{\Delta}{2}$ (9)

Long Chord= $C = 2 R \sin. \frac{\Delta}{2}$ (10) $\Delta =$ Central Angle

EXPLANATION AND USE OF TABLES

Stations.—Given P. I.=Sta. 161+60.35 to find Sta. of P. C. and P. T. $\Delta = 62^\circ 10'$ $D = 8^\circ 20'$. From Table IV for 1° curve $T = 3454.1$ and $\div 8\frac{1}{3} = 414.49$ ft. From Table V correction=.36 or $T = 414.85$ ft. P. C.=Sta. P.I.— $T = 157 + 45.50$. Also from (4) $L = 746.00$ and P. T.=Sta. P. C. + $L = 164 + 91.50$.

Offsets.—Tangent offsets vary (approximately) directly with D and with square of the distance. Thus tangent offset for Sta. 158 on above curve is 2.16 ft. found as follows. From Table III tangent offset for 100 ft.=7.27 ft. Distance=158—Sta. P. C.=54.50, hence offset= $7.27 (54.50 \div 100)^2 = 2.16$ ft. Also square of any distance divided by twice the radius equals (approximately) the distance from tangent to curve. Thus $(54.50)^2 \div (2 \times 688.26) = 2.16$ ft.

Deflections.—Deflection angle= $\frac{1}{2} D$ for 100 ft., $\frac{1}{4} D$ for 50 ft., etc. For c ft.—(in minutes) $.3 \times C \times D^\circ$ or=defl. for 1 ft. from Table III $\times C$. For Sta. 158 of above curve= $.3 \times 54.5 \times 8\frac{1}{3} = 136.2'$ or $2^\circ 16.2'$, or= $2.50 \times 54.5 = 136.2'$ from Table III. For Sta. 159 deflection angle= $2^\circ 16.2' + 8^\circ 20' \div 2 = 6^\circ 26.2'$, etc.

Externals.—May be found in similar manner to tangents. Thus E for curve above is 91.37. For from Table IV for 1° curve $E = 960.6$ for $8^\circ 20' = 960.6 \div 8\frac{1}{3} = 91.27$ and from Table V correction=.10 or $E = 91.37$ ft. Or suppose $\Delta = 32^\circ$ and E is measured and found to be 42 ft. What is D ? From Table IV $E = 230.9$ and $\div 42 = 5.5$ or $D = 5^\circ 30'$.

TABLE I.—MINUTES IN DECIMALS OF A DEGREE.

1'	.0167	11'	.1833	21'	.3500	31'	.5167	41'	.6833	51'	.8500
2	.0333	12	.2000	22	.3667	32	.5333	42	.7000	52	.8667
3	.0500	13	.2167	23	.3833	33	.5500	43	.7167	53	.8833
4	.0667	14	.2333	24	.4000	34	.5667	44	.7333	54	.9000
5	.0833	15	.2500	25	.4167	35	.5833	45	.7500	55	.9167
6	.1000	16	.2667	26	.4333	36	.6000	46	.7667	56	.9333
7	.1167	17	.2833	27	.4500	37	.6167	47	.7833	57	.9500
8	.1333	18	.3000	28	.4667	38	.6333	48	.8000	58	.9667
9	.1500	19	.3167	29	.4833	39	.6500	49	.8167	59	.9833
10	.1667	20	.3333	30	.5000	40	.6667	50	.8333	60	1.0000

TABLE II.—INCHES IN DECIMALS OF A FOOT.

1-16	3-32	1/8	3-16	1/4	5-16	3/8	1/2	5/8	3/4	7/8
.0052	.0078	.0104	.0156	.0208	.0260	.0313	.0417	.0521	.0625	.0729
1	2	3	4	5	6	7	8	9	10	11
.0833	.1667	.2500	.3333	.4167	.5000	.5833	.6667	.7500	.8333	.9167

TABLE III.—RADI, ORDINATES AND DEFLECTIONS.

Deg.	Radius	Mid. Ord.	Tan. Offset	Def. for 1 Foot	Deg.	Radius	Mid. Ord.	Tan. Offset	Def. for 1 Foot
0° 10'	34377.5	.036	.145	0.05'	7°	819.02	1.528	6.105	2.10'
20	17188.8	.073	.291	0.10	20'	781.84	1.600	6.395	2.20
30	11459.2	.109	.436	0.15	30	764.49	1.637	6.540	2.25
40	8594.42	.145	.582	0.20	40	747.89	1.673	6.685	2.30
50	6875.55	.182	.727	0.25					
1	5729.65	.218	.873	0.30	8	716.78	1.746	6.976	2.40
10	4911.15	.255	1.018	0.35	20	688.16	1.819	7.266	2.50
20	4297.28	.291	1.164	0.40	30	674.69	1.855	7.411	2.55
30	3819.83	.327	1.309	0.45	40	661.74	1.892	7.556	2.60
40	3437.87	.364	1.454	0.50	9	637.28	1.965	7.846	2.70
50	3125.36	.400	1.600	0.55	20	614.56	2.037	8.136	2.80
					30	603.80	2.074	8.281	2.85
2	2864.93	.436	1.745	0.60	40	593.42	2.110	8.426	2.90
10	2644.58	.473	1.891	0.65					
20	2455.70	.509	2.036	0.70	10	573.69	2.183	8.716	3.00
30	2292.01	.545	2.181	0.75	30	546.44	2.292	9.150	3.15
40	2148.79	.582	2.327	0.80	11	521.67	2.402	9.585	3.30
50	2022.41	.618	2.472	0.85	30	499.06	2.511	10.02	3.45
					12	478.34	2.620	10.45	3.60
3	1910.08	.655	2.618	0.90	30	459.28	2.730	10.89	3.75
10	1809.57	.691	2.763	0.95	13	441.68	2.839	11.32	3.90
20	1719.12	.727	2.908	1.00	30	425.40	2.949	11.75	4.05
30	1637.28	.764	3.054	1.05	14	410.28	3.058	12.18	4.20
40	1562.88	.800	3.199	1.10	30	396.20	3.168	12.62	4.35
50	1494.95	.836	3.345	1.15					
					15	383.07	3.277	13.05	4.50
4	1432.69	.873	3.490	1.20	30	370.78	3.387	13.49	4.65
10	1375.40	.909	3.635	1.25	16	359.27	3.496	13.92	4.80
20	1322.53	.945	3.718	1.30	30	348.45	3.606	14.35	4.95
30	1273.57	.982	3.926	1.35	17	338.27	3.716	14.78	5.10
40	1228.11	1.018	4.071	1.40	18	319.62	3.935	15.64	5.40
50	1185.78	1.055	4.217	1.45	19	302.94	4.155	16.51	5.70
					20	287.94	4.374	17.37	6.00
5	1146.28	1.091	4.362	1.50	21	274.37	4.594	18.22	6.30
10	1109.33	1.127	4.507	1.55	22	262.04	4.814	19.08	6.60
20	1074.68	1.164	4.653	1.60	23	250.79	5.035	19.94	6.90
30	1042.14	1.200	4.798	1.65	24	240.49	5.255	20.79	7.20
40	1011.51	1.237	4.943	1.70					
50	982.64	1.273	5.088	1.75	25	231.01	5.476	21.64	7.50
					26	222.27	5.697	22.50	7.80
6	955.37	1.309	5.234	1.80	27	214.18	5.918	23.35	8.10
10	929.57	1.346	5.379	1.85	28	206.68	6.139	24.19	8.40
20	905.13	1.382	5.524	1.90	29	199.70	6.360	25.04	8.70
30	881.95	1.418	5.669	1.95	30	193.18	6.583	25.88	9.00
40	859.92	1.455	5.814	2.00					

Note. Chord Deflection=2 times tangent deflection.

TABLE IV.—TANGENTS AND EXTERNALS TO A 1° CURVE.

Central Angle	Tangent	External	Central Angle	Tangent	External	Central Angle	Tangent	External
1°	50.00	.22	11°	551.70	26.50	21°	1061.9	97.57
10'	58.34	.30	10'	560.11	27.31	10'	1070.6	99.16
20	66.67	.39	20	568.53	28.14	20	1079.2	100.75
30	75.01	.49	30	576.95	28.97	30	1087.8	102.35
40	83.34	.61	40	585.36	29.82	40	1096.4	103.97
50	91.68	.73	50	593.79	30.68	50	1105.1	105.60
2	100.01	.87	12	602.21	31.56	22	1113.7	107.24
10	108.35	1.02	10	610.64	32.45	10	1122.4	108.90
20	116.68	1.19	20	619.07	33.35	20	1131.0	110.57
30	125.02	1.36	30	627.50	34.26	30	1139.7	112.25
40	133.36	1.55	40	635.93	35.18	40	1148.4	113.95
50	141.70	1.75	50	644.37	36.12	50	1157.0	115.66
3	150.04	1.96	13	652.81	37.07	23	1165.7	117.38
10	158.38	2.19	10	661.25	38.03	10	1174.4	119.12
20	166.72	2.43	20	669.70	39.01	20	1183.1	120.87
30	175.06	2.67	30	678.15	39.99	30	1191.8	122.63
40	183.40	2.93	40	686.60	40.99	40	1200.5	124.41
50	191.74	3.21	50	695.06	42.00	50	1209.2	126.20
4	200.08	3.49	14	703.51	43.03	24	1217.9	128.00
10	208.43	3.79	10	711.97	44.07	10	1226.6	129.82
20	216.77	4.10	20	720.44	45.12	20	1235.3	131.65
30	225.12	4.42	30	728.90	46.18	30	1244.0	133.50
40	233.47	4.76	40	737.37	47.25	40	1252.8	135.35
50	241.81	5.10	50	745.85	48.34	50	1261.5	137.23
5	250.16	5.46	15	754.32	49.44	25	1270.2	139.11
10	258.51	5.83	10	762.80	50.55	10	1279.0	141.01
20	266.86	6.21	20	771.29	51.68	20	1287.7	142.93
30	275.21	6.61	30	779.77	52.89	30	1296.5	144.85
40	283.57	7.01	40	788.26	53.97	40	1305.3	146.79
50	291.92	7.43	50	796.75	55.13	50	1314.0	148.75
6	300.28	7.86	16	805.25	56.31	26	1322.8	150.71
10	308.64	8.31	10	813.75	57.50	10	1331.6	152.69
20	316.99	8.76	20	822.25	58.70	20	1340.4	154.69
30	325.35	9.23	30	830.76	59.91	30	1349.2	156.70
40	333.71	9.71	40	839.27	61.14	40	1358.0	158.72
50	342.08	10.20	50	847.78	62.38	50	1366.8	160.76
7	350.44	10.71	17	856.30	63.63	27	1375.6	162.81
10	358.81	11.22	10	864.82	64.90	10	1384.4	164.86
20	367.17	11.75	20	873.35	66.18	20	1393.2	166.95
30	375.54	12.29	30	881.88	67.47	30	1402.0	169.04
40	383.91	12.85	40	890.41	68.77	40	1410.9	171.15
50	392.28	13.41	50	898.95	70.09	50	1419.7	173.27
8	400.66	13.99	18	907.49	71.42	28	1428.6	175.41
10	409.03	14.58	10	916.03	72.76	10	1437.4	177.55
20	417.41	15.18	20	924.58	74.12	20	1446.3	179.72
30	425.79	15.80	30	933.13	75.49	30	1455.1	181.89
40	434.17	16.43	40	941.69	76.86	40	1464.0	184.08
50	442.55	17.07	50	950.25	78.26	50	1472.9	186.29
9	450.93	17.72	19	958.81	79.67	29	1481.8	188.51
10	459.32	18.38	10	967.38	81.09	10	1490.7	190.74
20	467.71	19.06	20	975.96	82.53	20	1499.6	192.99
30	476.10	19.75	30	984.53	83.97	30	1508.5	195.25
40	484.49	20.45	40	993.12	85.43	40	1517.4	197.53
50	492.88	21.16	50	1001.7	86.90	50	1526.3	199.82
10	501.28	21.89	20	1010.3	88.39	30	1535.3	202.12
10	509.68	22.62	10	1018.9	89.89	10	1544.2	204.44
20	518.08	23.38	20	1027.5	91.40	20	1553.1	206.77
30	526.48	24.14	30	1036.1	92.92	30	1562.1	209.12
40	534.89	24.91	40	1044.7	94.46	40	1571.0	211.48
50	543.29	25.70	50	1053.3	96.01	50	1580.0	213.86

TABLE IV.—TANGENTS AND EXTERNALS TO A 1° CURVE.

Central Angle	Tangent	External	Central Angle	Tangent	External	Central Angle	Tangent	External
31°	1589.0	216.3	41°	2142.2	387.4	51°	2732.9	618.4
10'	1598.0	218.7	10'	2151.7	390.7	10'	2743.1	622.8
20	1606.9	221.1	20	2161.2	394.1	20	2753.4	627.2
30	1615.9	223.5	30	2170.8	397.4	30	2763.7	631.7
40	1624.9	226.0	40	2180.3	400.8	40	2773.9	636.2
50	1633.9	228.4	50	2189.9	404.2	50	2784.2	640.7
32	1643.0	230.9	42	2199.4	407.6	52	2794.5	645.2
10	1652.0	233.4	10	2209.0	411.1	10	2804.9	649.7
20	1661.0	235.9	20	2218.6	414.5	20	2815.2	654.3
30	1670.0	238.4	30	2228.1	418.0	30	2825.6	658.8
40	1679.1	241.0	40	2237.7	421.4	40	2835.9	663.4
50	1688.1	243.5	50	2247.3	425.0	50	2846.3	668.0
33	1697.2	246.1	43	2257.0	428.5	53	2856.7	672.7
10	1706.3	248.7	10	2266.6	432.0	10	2867.1	677.3
20	1715.3	251.3	20	2276.2	435.6	20	2877.5	682.0
30	1724.4	253.9	30	2285.9	439.2	30	2888.0	686.7
40	1733.5	256.5	40	2295.6	442.8	40	2898.4	691.4
50	1742.6	259.1	50	2305.2	446.4	50	2908.9	696.1
34	1751.7	261.8	44	2314.9	450.0	54	2919.4	700.9
10	1760.8	264.5	10	2324.6	453.6	10	2929.9	705.7
20	1770.0	267.2	20	2334.3	457.3	20	2940.4	710.5
30	1779.1	269.9	30	2344.1	461.0	30	2951.0	715.3
40	1788.2	272.6	40	2353.8	464.6	40	2961.5	720.1
50	1797.4	275.3	50	2363.5	468.4	50	2972.1	725.0
35	1806.6	278.1	45	2373.3	472.1	55	2982.7	729.9
10	1815.7	280.8	10	2383.1	475.8	10	2993.3	734.8
20	1824.9	283.6	20	2392.8	479.6	20	3003.9	739.7
30	1834.1	286.4	30	2402.6	483.3	30	3014.5	744.6
40	1843.3	289.2	40	2412.4	487.2	40	3025.2	749.6
50	1852.5	292.0	50	2422.3	491.0	50	3035.8	754.6
36	1861.7	294.9	46	2432.1	494.8	56	3046.5	759.6
10	1870.9	297.7	10	2441.9	498.7	10	3057.2	764.6
20	1880.1	300.6	20	2451.8	502.5	20	3067.9	769.7
30	1889.4	303.5	30	2461.7	506.4	30	3078.7	774.7
40	1898.6	306.4	40	2471.5	510.3	40	3089.4	779.8
50	1907.9	309.3	50	2481.4	514.3	50	3100.2	784.9
37	1917.1	312.2	47	2491.3	518.2	57	3110.9	790.1
10	1926.4	315.2	10	2501.2	522.2	10	3121.7	795.2
20	1935.7	318.1	20	2511.2	526.1	20	3132.6	800.4
30	1945.0	321.1	30	2521.1	530.1	30	3143.4	805.6
40	1954.3	324.1	40	2531.1	534.2	40	3154.2	810.9
50	1963.6	327.1	50	2541.0	538.2	50	3165.1	816.1
38	1972.9	330.2	48	2551.0	542.2	58	3176.0	821.4
10	1982.2	333.2	10	2561.0	546.3	10	3186.9	826.7
20	1991.5	336.3	20	2571.0	550.4	20	3197.8	832.0
30	2000.9	339.3	30	2581.0	554.5	30	3208.8	837.3
40	2010.2	342.4	40	2591.0	558.6	40	3219.7	842.7
50	2019.6	345.5	50	2601.1	562.8	50	3230.7	848.1
39	2029.0	348.6	49	2611.2	566.9	59	3241.7	853.5
10	2038.4	351.8	10	2621.2	571.1	10	3252.7	858.9
20	2047.8	354.9	20	2631.3	575.3	20	3263.7	864.3
30	2057.2	358.1	30	2641.4	579.5	30	3274.8	869.8
40	2066.6	361.3	40	2651.5	583.8	40	3285.8	875.3
50	2076.0	364.5	50	2661.6	588.0	50	3296.9	880.8
40	2085.4	367.7	50	2671.8	592.3	60	3308.0	886.4
10	2094.9	371.0	10	2681.9	596.6	10	3319.1	892.0
20	2104.3	374.2	20	2692.1	600.9	20	3330.3	897.5
30	2113.8	377.5	30	2702.3	605.3	30	3341.4	903.2
40	2123.3	380.8	40	2712.5	609.6	40	3352.6	908.8
50	2132.7	384.1	50	2722.7	614.0	50	3363.8	914.5

TABLE IV.—TANGENTS AND EXTERNALS TO A 1° CURVE.

Central Angle	Tangent	External	Central Angle	Tangent	External	Central Angle	Tangent	External
61°	3375.0	920.2	71°	4086.9	1308.2	81°	4893.6	1805.3
10'	3386.3	925.9	10'	4099.5	1315.6	10'	4908.0	1814.7
20	3397.5	931.6	20	4112.1	1322.9	20	4922.5	1824.1
30	3408.8	937.3	30	4124.8	1330.3	30	4937.0	1833.6
40	3420.1	943.1	40	4137.4	1337.7	40	4951.5	1843.1
50	3431.4	948.9	50	4150.1	1345.1	50	4966.1	1852.6
62	3442.7	954.8	72	4162.8	1352.6	82	4980.7	1862.2
10	3454.1	960.6	10	4175.6	1360.1	10	4995.4	1871.8
20	3465.4	966.5	20	4188.5	1367.6	20	5010.0	1881.5
30	3476.8	972.4	30	4201.2	1375.2	30	5024.8	1891.2
40	3488.3	978.3	40	4214.0	1382.8	40	5039.5	1900.9
50	3499.7	984.3	50	4226.8	1390.4	50	5054.3	1910.7
63	3511.1	990.2	73	4239.7	1398.0	83	5069.2	1920.5
10	3522.6	996.2	10	4252.6	1405.7	10	5084.0	1930.4
20	3534.1	1002.3	20	4265.6	1413.5	20	5099.0	1940.3
30	3545.6	1008.3	30	4278.5	1421.2	30	5113.9	1950.3
40	3557.2	1014.4	40	4291.5	1429.0	40	5128.9	1960.2
50	3568.7	1020.5	50	4304.6	1436.8	50	5143.9	1970.3
64	3580.3	1026.6	74	4317.6	1444.6	84	5159.0	1980.4
10	3591.9	1032.8	10	4330.7	1452.5	10	5174.1	1990.5
20	3603.5	1039.0	20	4343.8	1460.4	20	5189.3	2000.6
30	3615.1	1045.2	30	4356.9	1468.4	30	5204.4	2010.8
40	3626.8	1051.4	40	4370.1	1476.4	40	5219.7	2021.1
50	3638.5	1057.7	50	4383.3	1484.4	50	5234.9	2031.4
65	3650.2	1063.9	75	4396.5	1492.4	85	5250.3	2041.7
10	3661.9	1070.2	10	4409.8	1500.5	10	5265.6	2052.1
20	3673.7	1076.6	20	4423.1	1508.6	20	5281.0	2062.5
30	3685.4	1082.9	30	4436.4	1516.7	30	5296.4	2073.0
40	3697.2	1089.3	40	4449.7	1524.9	40	5311.9	2083.5
50	3709.0	1095.7	50	4463.1	1533.1	50	5327.4	2094.1
66	3720.9	1102.2	76	4476.5	1541.4	86	5343.0	2104.7
10	3732.7	1108.6	10	4489.9	1549.7	10	5358.6	2115.3
20	3744.6	1115.1	20	4503.4	1558.0	20	5374.2	2126.0
30	3756.5	1121.7	30	4516.9	1566.3	30	5389.9	2136.7
40	3768.5	1128.2	40	4530.4	1574.7	40	5405.6	2147.5
50	3780.4	1134.8	50	4544.0	1583.1	50	5421.4	2158.4
67	3792.4	1141.4	77	4557.6	1591.6	87	5437.2	2169.2
10	3804.4	1148.0	10	4571.2	1600.1	10	5453.1	2180.2
20	3816.4	1154.7	20	4584.8	1608.6	20	5469.0	2191.1
30	3828.4	1161.3	30	4598.5	1617.1	30	5484.9	2202.2
40	3840.5	1168.1	40	4612.2	1625.7	40	5500.9	2213.2
50	3852.6	1174.8	50	4626.0	1634.4	50	5517.0	2224.3
68	3864.7	1181.6	78	4639.8	1643.0	88	5533.1	2235.5
10	3876.8	1188.4	10	4653.6	1651.7	10	5549.2	2246.7
20	3889.0	1195.2	20	4667.4	1660.5	20	5565.4	2258.0
30	3901.2	1202.0	30	4681.3	1669.2	30	5581.6	2269.3
40	3913.4	1208.9	40	4695.2	1678.1	40	5597.8	2280.6
50	3925.6	1215.8	50	4709.2	1686.9	50	5614.2	2292.0
69	3937.9	1222.7	79	4723.2	1695.8	89	5630.5	2303.5
10	3950.2	1229.7	10	4737.2	1704.7	10	5646.9	2315.0
20	3962.5	1236.7	20	4751.2	1713.7	20	5663.4	2326.6
30	3974.8	1243.7	30	4765.3	1722.7	30	5679.9	2338.2
40	3987.2	1250.8	40	4779.4	1731.7	40	5696.4	2349.8
50	3999.5	1257.9	50	4793.6	1740.8	50	5713.0	2361.5
70	4011.9	1265.0	80	4807.7	1749.9	90	5729.7	2373.3
10	4024.4	1272.1	10	4822.0	1759.0	10	5746.3	2385.1
20	4036.8	1279.3	20	4836.2	1768.2	20	5763.1	2397.0
30	4049.3	1286.5	30	4850.5	1777.4	30	5779.9	2408.9
40	4061.8	1293.6	40	4864.8	1786.7	40	5796.7	2420.9
50	4074.4	1300.9	50	4879.2	1796.0	50	5813.6	2432.9

TABLE IV.—TANGENTS AND EXTERNALS TO A 1° CURVE.

Central Angle	Tangent	External	Central Angle	Tangent	External	Central Angle	Tangent	External
91°	5830.5	2444.9	101°	6950.6	3278.1	111°	8336.7	4386.1
10'	5847.5	2457.1	10'	6971.3	3294.1	10'	8362.7	4407.6
20	5864.6	2469.3	20	6992.0	3310.1	20	8388.9	4429.2
30	5881.7	2481.5	30	7012.7	3326.1	30	8415.1	4450.9
40	5898.8	2493.8	40	7033.6	3342.3	40	8441.5	4472.7
50	5916.0	2506.1	50	7054.5	3358.5	50	8468.0	4494.6
92	5933.2	2518.5	102	7075.5	3374.9	112	8494.6	4516.6
10	5950.5	2531.0	10	7096.6	3391.2	10	8521.3	4538.8
20	5967.9	2543.5	20	7117.8	3407.7	20	8548.1	4561.1
30	5985.3	2556.0	30	7139.0	3424.3	30	8575.0	4583.4
40	6002.7	2568.6	40	7160.3	3440.9	40	8602.1	4606.0
50	6020.2	2581.3	50	7181.7	3457.6	50	8629.3	4628.6
93	6037.8	2594.0	103	7203.2	3474.4	113	8656.6	4651.3
10	6055.4	2606.8	10	7224.7	3491.3	10	8684.0	4674.2
20	6073.1	2619.7	20	7246.3	3508.2	20	8711.5	4697.2
30	6090.8	2632.6	30	7268.0	3525.2	30	8739.2	4720.3
40	6108.6	2645.5	40	7289.8	3542.4	40	8767.0	4743.6
50	6126.4	2658.5	50	7311.7	3559.6	50	8794.9	4766.9
94	6144.3	2671.6	104	7333.6	3576.8	114	8822.9	4790.4
10	6162.6	2684.7	10	7355.6	3594.2	10	8851.0	4814.1
20	6180.2	2697.9	20	7377.8	3611.7	20	8879.3	4837.8
30	6198.3	2711.2	30	7399.9	3629.2	30	8907.7	4861.7
40	6216.4	2724.5	40	7422.2	3646.8	40	8936.3	4885.7
50	6234.6	2737.9	50	7444.6	3664.5	50	8965.0	4909.9
95	6252.8	2751.3	105	7467.0	3682.3	115	8993.8	4934.1
10	6271.1	2764.8	10	7489.6	3700.2	10	9022.7	4958.6
20	6289.4	2778.3	20	7512.2	3718.2	20	9051.7	4983.1
30	6307.9	2792.0	30	7534.9	3736.2	30	9080.9	5007.3
40	6326.3	2805.6	40	7557.7	3754.4	40	9110.3	5032.6
50	6344.8	2819.4	50	7580.5	3772.6	50	9139.8	5057.6
96	6363.4	2833.2	106	7603.5	3791.0	116	9169.4	5082.7
10	6382.1	2847.0	10	7626.6	3809.4	10	9199.1	5107.9
20	6400.8	2861.0	20	7649.7	3827.9	20	9229.0	5133.3
30	6419.5	2875.0	30	7672.9	3846.5	30	9259.0	5158.8
40	6438.4	2889.0	40	7696.3	3865.2	40	9289.2	5184.5
50	6457.3	2903.1	50	7719.7	3884.0	50	9319.5	5210.3
97	6476.2	2917.3	107	7743.2	3902.9	117	9349.9	5236.2
10	6495.2	2931.6	10	7766.8	3921.9	10	9380.5	5262.3
20	6514.3	2945.9	20	7790.5	3940.9	20	9411.3	5288.6
30	6533.4	2960.3	30	7814.3	3960.1	30	9442.2	5315.0
40	6552.6	2974.7	40	7838.1	3979.4	40	9473.2	5341.5
50	6571.9	2989.2	50	7862.1	3998.7	50	9504.4	5368.2
98	6591.2	3003.8	108	7886.2	4018.2	118	9535.7	5395.1
10	6610.6	3018.4	10	7910.4	4037.8	10	9567.2	5422.1
20	6630.1	3033.1	20	7934.6	4057.4	20	9598.9	5449.2
30	6649.6	3047.9	30	7959.0	4077.2	30	9630.7	5476.5
40	6669.2	3062.8	40	7983.5	4097.1	40	9662.6	5504.0
50	6688.8	3077.7	50	8008.0	4117.0	50	9694.7	5531.7
99	6708.6	3092.7	109	8032.7	4137.1	119	9727.0	5559.4
10	6728.4	3107.7	10	8057.4	4157.3	10	9759.4	5587.4
20	6748.2	3122.9	20	8082.3	4177.5	20	9792.0	5615.5
30	6768.1	3138.1	30	8107.3	4197.9	30	9824.8	5643.8
40	6788.1	3153.3	40	8132.3	4218.4	40	9857.7	5672.3
50	6808.2	3168.7	50	8157.5	4239.0	50	9890.8	5700.9
100	6828.3	3184.1	110	8182.8	4259.7	120	9924.0	5729.7
10	6848.5	3199.6	10	8208.2	4280.5	10	9957.5	5758.6
20	6868.8	3215.1	20	8233.7	4301.4	20	9991.0	5787.7
30	6889.2	3230.8	30	8259.3	4322.4	30	10025.0	5817.0
40	6909.6	3246.5	40	8285.0	4343.6	40	10059.0	5846.5
50	6930.1	3262.3	50	8310.8	4364.8	50	10093.0	5876.1

TABLE V.—CORRECTIONS FOR TANGENTS AND EXTERNALS.

These corrections are to be added to the approximate values, found by dividing the tangent, or external, for a 1° curve (Table IV) by the degree of curve, in order to obtain the true tangents, or externals. Intermediate values may be obtained by interpolation.

FOR TANGENTS ADD

Central Angle	DEGREE OF CURVE													
	5°	10°	15°	20°	25°	30°	35°	40°	45°	50°	55°	60°	65°	70°
10°	.03	.06	.09	.13	.16	.19	.22	.25	.28	.31	.34	.38	.42	.46
15°	.04	.10	.14	.19	.24	.29	.34	.39	.45	.51	.53	.58	.63	.68
20°	.06	.13	.19	.26	.32	.39	.45	.51	.58	.65	.72	.79	.84	.90
25°	.08	.16	.24	.33	.40	.49	.58	.67	.75	.83	.90	.99	1.06	1.14
30°	.10	.19	.29	.39	.49	.59	.69	.79	.89	.99	1.09	1.20	1.29	1.39
35°	.11	.22	.34	.47	.58	.69	.79	.81	.92	1.04	1.29	1.42	1.54	1.66
40°	.13	.26	.40	.53	.67	.80	.93	1.06	1.20	1.34	1.49	1.64	1.79	1.94
45°	.15	.30	.44	.60	.76	.91	1.06	1.21	1.37	1.52	1.70	1.87	2.04	2.21
50°	.17	.34	.51	.68	.85	1.02	1.19	1.36	1.54	1.72	1.91	2.10	2.29	2.48
55°	.19	.38	.57	.76	.95	1.14	1.32	1.52	1.72	1.92	2.14	2.35	2.56	2.77
60°	.21	.42	.63	.84	1.05	1.27	1.49	1.71	1.94	2.17	2.38	2.60	2.83	3.07
65°	.23	.46	.69	.93	1.16	1.40	1.64	1.88	2.13	2.38	2.63	2.88	3.13	3.39
70°	.25	.51	.76	1.02	1.28	1.54	1.80	2.06	2.33	2.60	2.88	3.16	3.44	3.72
75°	.27	.56	.83	1.12	1.40	1.69	1.98	2.27	2.57	2.87	3.16	3.47	3.78	4.09
80°	.30	.61	.91	1.22	1.53	1.84	2.15	2.46	2.78	3.10	3.44	3.78	4.12	4.46
85°	.33	.66	1.00	1.33	1.68	2.02	2.36	2.70	3.05	3.40	3.77	4.14	4.55	4.89
90°	.36	.72	1.09	1.45	1.83	2.20	2.57	2.94	3.32	3.70	4.10	4.50	4.91	5.32
95°	.39	.79	1.19	1.55	2.00	2.40	2.80	3.20	3.61	4.02	4.40	4.98	5.38	5.83
100°	.43	.86	1.30	1.74	2.18	2.62	3.06	3.50	3.95	4.40	4.88	5.37	5.85	6.34
110°	.51	1.03	1.56	2.08	2.61	3.14	3.67	4.21	4.76	5.31	5.86	6.43	7.01	7.60
120°	.62	1.25	1.93	2.52	3.16	3.81	4.45	5.11	5.77	6.44	7.12	7.80	8.50	9.22

FOR EXTERNALS ADD

Central Angle	DEGREE OF CURVE													
	5°	10°	15°	20°	25°	30°	35°	40°	45°	50°	55°	60°	65°	70°
10°	.001	.003	.004	.006	.007	.008	.009	.011	.012	.014	.015	.017	.018	.020
15°	.003	.007	.010	.014	.018	.023	.027	.029	.032	.035	.039	.043	.047	.051
20°	.006	.011	.017	.022	.028	.034	.038	.045	.051	.057	.063	.070	.076	.083
25°	.009	.018	.027	.036	.046	.056	.066	.074	.083	.093	.106	.120	.127	.135
30°	.013	.025	.038	.051	.065	.078	.090	.103	.116	.129	.149	.170	.179	.188
35°	.018	.035	.054	.072	.086	.109	.131	.153	.175	.197	.213	.230	.247	.264
40°	.023	.046	.070	.093	.117	.141	.172	.203	.234	.265	.277	.290	.315	.341
45°	.030	.060	.093	.119	.153	.184	.216	.254	.289	.325	.351	.378	.411	.445
50°	.037	.075	.116	.151	.189	.227	.266	.305	.345	.384	.425	.467	.508	.550
55°	.046	.093	.142	.188	.236	.283	.332	.381	.420	.479	.530	.582	.641	.700
60°	.056	.112	.168	.225	.283	.340	.398	.457	.516	.575	.636	.697	.774	.851
65°	.067	.135	.204	.273	.343	.412	.483	.554	.625	.697	.771	.845	.922	1.01
70°	.080	.159	.240	.321	.403	.485	.568	.652	.735	.819	.906	.994	1.08	1.17
75°	.095	.182	.286	.383	.480	.578	.678	.777	.877	.977	1.07	1.18	1.29	1.39
80°	.110	.220	.332	.445	.558	.671	.787	.903	1.02	1.13	1.25	1.38	1.50	1.62
85°	.128	.259	.391	.524	.657	.790	.926	1.06	1.20	1.34	1.47	1.62	1.76	1.91
90°	.149	.299	.450	.603	.756	.910	1.07	1.22	1.38	1.54	1.70	1.87	2.03	2.20
95°	.174	.350	.522	.706	.885	1.06	1.25	1.43	1.62	1.80	1.99	2.18	2.38	2.58
100°	.200	.401	.604	.809	1.01	1.22	1.43	1.64	1.85	2.06	2.28	2.50	2.73	2.96
110°	.268	.536	.806	1.08	1.35	1.63	1.91	2.20	2.48	2.76	3.05	3.35	3.66	3.96
120°	.360	.721	1.08	1.45	1.82	2.19	2.57	2.95	3.33	3.72	4.11	4.50	4.91	5.32

VIII

TABLE VI.—CORRECTIONS FOR SUB-CHORDS AND LONG CHORDS.

FOR SUB-CHORDS ADD										Excess of arc per 100 ft.	LONG CHORDS				
D	10	20	30	40	50	60	70	80	90		D	200	300	400	500
4°	.00	.00	.01	.01	.01	.01	.01	.01	.00	.02	1	199.99	299.97	399.92	499.85
6	.00	.01	.01	.02	.02	.02	.02	.01	.01	.05	2	199.97	299.88	399.70	499.39
8	.01	.02	.02	.03	.03	.03	.03	.02	.01	.08	3	199.93	299.73	399.32	498.63
10	.01	.02	.03	.04	.05	.05	.05	.04	.02	.13	4	199.88	299.51	398.78	497.57
12	.02	.04	.05	.06	.07	.07	.07	.05	.03	.18	5	199.81	299.24	398.10	496.20
14	.02	.05	.07	.08	.09	.10	.09	.07	.04	.25	6	199.73	298.90	397.26	494.53
16	.03	.06	.09	.11	.12	.12	.12	.09	.05	.33	7	199.63	298.51	396.28	492.57
18	.04	.08	.11	.14	.15	.16	.15	.12	.07	.41	8	199.51	298.05	395.14	490.31
20	.05	.10	.14	.17	.19	.20	.18	.15	.09	.51	9	199.38	297.54	393.86	487.75
22	.06	.12	.17	.21	.23	.24	.22	.18	.10	.62	10	199.24	296.96	392.42	484.90
24	.07	.14	.20	.25	.28	.28	.26	.21	.12	.74	12	198.90	295.63	389.12	478.34
26	.09	.17	.24	.29	.32	.33	.31	.25	.15	.86	14	198.51	294.06	385.22	470.65
28	.10	.19	.27	.34	.37	.38	.36	.29	.17	1.00	16	198.05	292.25	380.76	461.86
30	.11	.22	.31	.39	.43	.44	.41	.33	.19	1.15	18	197.54	290.21	375.74	452.02
32	.13	.25	.36	.44	.49	.50	.47	.38	.22	1.31	20	196.96	287.94	370.17	441.15
34	.15	.28	.40	.50	.55	.57	.53	.43	.25	1.48	22	196.32	285.44	364.06	429.80
36	.17	.32	.45	.56	.62	.64	.59	.48	.28	1.66	24	195.63	282.71	357.43	416.53
38	.18	.36	.51	.62	.70	.71	.66	.53	.31	1.86	26	194.87	279.76	350.30	402.89
40	.21	.40	.56	.69	.77	.79	.73	.59	.35	2.06	28	194.06	276.59	342.69	388.43
42	.23	.44	.62	.76	.85	.87	.81	.65	.38	2.28	30	193.18	273.20	334.61	373.20
44	.25	.48	.68	.84	.94	.96	.89	.72	.42	2.50	32	192.25	269.61	326.08	357.28
46	.27	.52	.75	.92	1.02	1.05	.98	.78	.46	2.74	34	191.26	265.81	317.12	340.73
48	.30	.57	.81	1.00	1.12	1.14	1.06	.86	.50	2.99	36	190.21	261.80	307.77	323.61
50	.32	.62	.89	1.09	1.21	1.24	1.15	.93	.55	3.24	38	189.10	257.60	298.03	305.99
52	.35	.67	.96	1.18	1.31	1.35	1.25	1.01	.59	3.52	40	187.94	253.21	287.94	287.94
54	.38	.73	1.04	1.28	1.42	1.46	1.35	1.09	.64	3.80	42	186.72	248.63	277.51	269.54
56	.41	.78	1.12	1.38	1.53	1.57	1.46	1.17	.69	4.09	44	185.44	243.87	266.78	250.85
58	.44	.84	1.20	1.48	1.65	1.69	1.57	1.26	.74	4.40	46	184.10	239.93	255.78	231.95
60	.47	.91	1.29	1.59	1.76	1.81	1.68	1.35	.80	4.72	48	182.71	233.83	244.51	212.92

NOTE.—When a chord of less than 100 ft. is used the corrections given in the above table should be added to the nominal length of chord to get the length which should be used in order that the 100 ft. points will check with those obtained by using the standard 100 ft. chord. Thus in locating a 14° curve by 25 ft. chords measure 25°.06 for each chord. Long chords are useful in passing obstacles.

TABLE VII.—MIDDLE ORDINATES FOR RAILS IN FEET.

Deg. of Curve	LENGTH OF RAILS							Deg. of Curve	LENGTH OF RAILS.						
	32	30	28	26	24	22	20		32	30	28	26	24	22	20
1°	.022	.020	.016	.013	.011	.009	.008	16°	.356	.313	.273	.236	.200	.170	.139
2	.045	.038	.034	.029	.025	.021	.017	17	.378	.333	.290	.252	.213	.180	.148
3	.037	.058	.051	.044	.037	.031	.026	18	.400	.351	.306	.265	.225	.190	.156
4	.089	.079	.069	.060	.050	.042	.035	19	.423	.371	.324	.280	.238	.201	.165
5	.112	.099	.086	.074	.063	.053	.044	20	.445	.392	.341	.296	.250	.212	.174
6	.134	.117	.102	.088	.076	.064	.052	21	.466	.410	.357	.309	.262	.222	.182
7	.156	.137	.120	.104	.088	.074	.061	22	.487	.430	.375	.325	.275	.233	.191
8	.179	.158	.137	.119	.100	.085	.070	23	.509	.450	.390	.338	.287	.243	.199
9	.201	.175	.153	.133	.112	.095	.078	24	.531	.469	.408	.354	.299	.253	.208
10	.223	.196	.171	.148	.125	.106	.087	25	.552	.486	.424	.367	.311	.263	.216
11	.245	.216	.188	.163	.139	.117	.096	26	.573	.506	.441	.382	.323	.274	.225
12	.268	.236	.206	.179	.151	.128	.105	27	.594	.524	.457	.396	.335	.284	.233
13	.290	.254	.222	.192	.163	.138	.113	28	.618	.545	.475	.411	.348	.294	.242
14	.312	.275	.239	.207	.175	.148	.122	29	.638	.564	.491	.424	.361	.303	.250
15	.334	.295	.257	.223	.188	.159	.131	30	.660	.583	.508	.438	.374	.313	.259


SLOPE REDUCTIONS.

When distances are measured on a slope they may be reduced to the equivalent horizontal distance by the following approximate rule:— subtract from the slope distance the square of the rise divided by twice the slope distance. Thus for a slope distance of 250.3 ft. and a rise of 15 ft. correction= $15^2 \div 2 \times 250.3 = .45$ (by slide rule) or horizontal distance= $250.3 - .45 = 249.85$. When vertical angle= $V. A.$ is measured horizontal distance= $\text{slope distance} - \text{slope distance} (1 - \text{Cos. } V. A.)$. Thus for slope distance of 248.7 ft. and $V. A.$ of $4^\circ 20'$ from Table VIII $\text{Cos.} = .99714$ and correction= $1 - .99714 = .00286$ per foot or total of $.286 \times 2\frac{1}{2}$ (near enough) = .57 and horizontal distance= $248.7 - .57 = 248.13$ ft.

See fig. (a).

TRIGONOMETRICAL FORMULAS.

$$\begin{aligned} \sin. & A = \frac{a}{c} \\ \cos. & A = \frac{b}{c} \\ \tan. & A = \frac{a}{b} \\ \cot. & A = \frac{b}{a} \\ \sec. & A = \frac{c}{b} \\ \text{cosec.} & A = \frac{c}{a} \end{aligned}$$

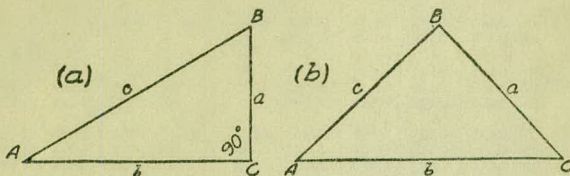

FORMULA FOR SOLVING TRIANGLES.

Given	Sought.	Right triangles. See fig. (a).
a, c	A, B, b	$\sin. A = \frac{a}{c}, \cos. B = \frac{a}{c}, b = \sqrt{(c+a)(c-a)}$
a, b	A, B, c	$\tan. A = \frac{a}{b}, \cot. B = \frac{a}{b}, c = \sqrt{a^2 + b^2}$
A, a	B, b, c	$B = 90^\circ - A, b = a \cot. A, c = \frac{a}{\sin. A}$
A, b	B, a, c	$B = 90^\circ - A, a = b \tan. A, c = \frac{b}{\cos. A}$
A, c	B, a, b	$B = 90^\circ - A, a = c \sin. A, b = c \cos. A$
Given	Sought.	Oblique triangles. See fig. (b).
A, B, a	b	$b = \frac{a \sin. B}{\sin. A}$
A, a, b	B	$\sin. B = \frac{b \sin. A}{a}$
a, b, C	$A - B$	$\tan. \frac{1}{2}(A - B) = \frac{(a - b) \tan. \frac{1}{2}(A + B)}{a + b}$
a, b, c	A	$\left\{ \begin{aligned} &\text{If } s = \frac{1}{2}(a + b + c), \sin. \frac{1}{2} A = \sqrt{\frac{(s - b)(s - c)}{bc}} \\ &\cos. \frac{1}{2} A = \sqrt{\frac{s(s - a)}{bc}}, \tan. \frac{1}{2} A = \sqrt{\frac{(s - b)(s - c)}{s(s - a)}} \\ &\sin. A = \frac{2 \sqrt{s(s - a)(s - b)(s - c)}}{bc} \end{aligned} \right.$
A, B, C, a	area	$\text{area} = \frac{a^2 \sin. B \sin. C}{2 \sin. A}$
A, b, c	area	$\text{area} = \frac{1}{2} bc \sin. A$
a, b, c	area	$s = \frac{1}{2}(a + b + c), \text{area} = \sqrt{s(s - a)(s - b)(s - c)}$

TABLE VIII.—NATURAL TRIGONOMETRICAL FUNCTIONS.

Angle	Sine.	Tan.	Cotg.	Cosin.		Angle	Sine.	Tan.	Cotg.	Cosin.	
°					°						
16	.2756	.2867	3.487	.96126	74	24	.4067	.4452	2.246	.91355	66
10	.2784	.2899	3.450	.96046	50	10	.4094	.4487	2.229	.91236	50
20	.2812	.2931	3.412	.95964	40	20	.4120	.4522	2.211	.91116	40
30	.2840	.2962	3.376	.95882	30	30	.4147	.4557	2.194	.90996	30
40	.2868	.2994	3.340	.95799	20	40	.4173	.4592	2.177	.90875	20
50	.2896	.3026	3.305	.95715	10	50	.4200	.4628	2.161	.90753	10
17	.2924	.3057	3.271	.95615	73	25	.4226	.4663	2.145	.90631	65
10	.2952	.3089	3.237	.95545	50	10	.4253	.4699	2.128	.90507	50
20	.2979	.3121	3.204	.95459	40	20	.4279	.4734	2.112	.90383	40
30	.3007	.3153	3.172	.95372	30	30	.4305	.4770	2.097	.90259	30
40	.3035	.3185	3.140	.95284	20	40	.4331	.4806	2.081	.90133	20
50	.3062	.3217	3.108	.95195	10	50	.4358	.4841	2.066	.90007	10
18	.3090	.3249	3.078	.95106	72	26	.4384	.4877	2.050	.89879	64
10	.3118	.3281	3.048	.95015	50	10	.4410	.4913	2.035	.89752	50
20	.3145	.3314	3.018	.94924	40	20	.4436	.4950	2.020	.89623	40
30	.3173	.3346	2.989	.94832	30	30	.4462	.4986	2.006	.89493	30
40	.3201	.3378	2.960	.94740	20	40	.4488	.5022	1.991	.89363	20
50	.3228	.3411	2.932	.94646	10	50	.4514	.5059	1.977	.89232	10
19	.3256	.3443	2.904	.94552	71	27	.4540	.5095	1.963	.89101	63
10	.3283	.3476	2.877	.94457	50	10	.4566	.5132	1.949	.88968	50
20	.3311	.3508	2.850	.94361	40	20	.4592	.5169	1.935	.88835	40
30	.3338	.3541	2.824	.94264	30	30	.4617	.5206	1.921	.88701	30
40	.3365	.3574	2.798	.94167	20	40	.4643	.5243	1.907	.88566	20
50	.3393	.3607	2.773	.94068	10	50	.4669	.5280	1.894	.88431	10
20	.3420	.3640	2.747	.93969	70	28	.4695	.5317	1.881	.88295	62
10	.3448	.3673	2.723	.93869	50	10	.4720	.5354	1.868	.88158	50
20	.3475	.3706	2.669	.93769	40	20	.4746	.5392	1.855	.88020	40
30	.3502	.3739	2.675	.93667	30	30	.4772	.5430	1.842	.87882	30
40	.3529	.3772	2.651	.93565	20	40	.4797	.5467	1.829	.87743	20
50	.3557	.3805	2.628	.93462	10	50	.4823	.5505	1.816	.87603	10
21	.3584	.3839	2.605	.93358	69	29	.4848	.5543	1.804	.87462	61
10	.3611	.3872	2.583	.93253	50	10	.4874	.5581	1.792	.87321	50
20	.3638	.3906	2.560	.93148	40	20	.4899	.5619	1.780	.87178	40
30	.3665	.3939	2.539	.93042	30	30	.4924	.5658	1.767	.87036	30
40	.3692	.3973	2.517	.92935	20	40	.4950	.5696	1.756	.86892	20
50	.3719	.4006	2.496	.92827	10	50	.4975	.5735	1.744	.86748	10
22	.3746	.4040	2.475	.92718	68	30	.5000	.5774	1.732	.86603	60
10	.3773	.4074	2.455	.92609	50	10	.5025	.5812	1.720	.86457	50
20	.3800	.4108	2.434	.92499	40	20	.5050	.5851	1.709	.86310	40
30	.3827	.4142	2.414	.92388	30	30	.5075	.5890	1.698	.86163	30
40	.3854	.4176	2.394	.92276	20	40	.5100	.5930	1.686	.86015	20
50	.3881	.4210	2.375	.92164	10	50	.5125	.5969	1.675	.85866	10
23	.3907	.4245	2.356	.92050	67	31	.5150	.6009	1.664	.85717	59
10	.3934	.4279	2.337	.91936	50	10	.5175	.6048	1.653	.85567	50
20	.3961	.4314	2.318	.91822	40	20	.5200	.6088	1.643	.85416	40
30	.3987	.4348	2.300	.91706	30	30	.5225	.6128	1.632	.85264	30
40	.4014	.4383	2.282	.91590	20	40	.5250	.6168	1.621	.85112	20
50	.4041	.4417	2.264	.91472	10	50	.5275	.6208	1.611	.84959	10
					66						58
	Cosin.	Cotg.	Tan.	Sine.	Angle.		Cosin.	Cotg.	Tan.	Sine.	Angle.

TABLE VIII.—NATURAL TRIGONOMETRICAL FUNCTIONS.

Angle	Sine.	Tan.	Cotg.	Cosin.		Angle	Sine.	Tan.	Cotg.	Cosin.	
°						°					
32	.5299	.6249	1.600	.84805	58	30	.6225	.7954	1.257	.78261	30
10	.5324	.6289	1.590	.84650	50	40	.6248	.8002	1.250	.78079	20
20	.5348	.6330	1.580	.84495	40	50	.6271	.8050	1.242	.77897	10
30	.5373	.6371	1.570	.84339	30						
40	.5398	.6412	1.560	.84182	20	39	.6293	.8098	1.235	.77715	51
50	.5422	.6453	1.550	.84025	10	10	.6316	.8146	1.228	.77531	50
						20	.6338	.8195	1.220	.77347	40
33	.5446	.6494	1.540	.83867	57	30	.6361	.8243	1.213	.77162	30
10	.5471	.6536	1.530	.83708	50	40	.6383	.8292	1.206	.76977	20
20	.5495	.6577	1.520	.83549	40	50	.6406	.8342	1.199	.76791	10
30	.5519	.6619	1.511	.83389	30						
40	.5544	.6661	1.501	.83228	20	40	.6428	.8391	1.192	.76604	50
50	.5568	.6703	1.492	.83066	10	10	.6450	.8441	1.185	.76417	50
						20	.6472	.8491	1.178	.76229	40
34	.5592	.6745	1.483	.82904	56	30	.6494	.8541	1.171	.76041	30
10	.5616	.6787	1.473	.82741	50	40	.6517	.8591	1.164	.75851	20
20	.5640	.6830	1.464	.82577	40	50	.6539	.8642	1.157	.75661	10
30	.5664	.6873	1.455	.82413	30						
40	.5688	.6916	1.446	.82248	20	41	.6561	.8693	1.150	.75471	49
50	.5712	.6959	1.437	.82082	10	10	.6583	.8744	1.144	.75280	50
						20	.6604	.8796	1.137	.75088	40
35	.5736	.7002	1.428	.81915	55	30	.6626	.8847	1.130	.74896	30
10	.5760	.7046	1.419	.81748	50	40	.6648	.8899	1.124	.74703	20
20	.5783	.7089	1.411	.81580	40	50	.6670	.8952	1.117	.74509	10
30	.5807	.7133	1.402	.81412	30						
40	.5831	.7177	1.393	.81242	20	42	.6691	.9004	1.111	.74314	48
50	.5854	.7221	1.385	.81072	10	10	.6713	.9057	1.104	.74120	50
						20	.6734	.9110	1.098	.73924	40
36	.5878	.7265	1.376	.80902	54	30	.6756	.9163	1.091	.73728	30
10	.5901	.7310	1.368	.80730	50	40	.6777	.9217	1.085	.73531	20
20	.5925	.7355	1.360	.80558	40	50	.6799	.9271	1.079	.73333	10
30	.5948	.7400	1.351	.80386	30						
40	.5972	.7445	1.343	.80212	20	43	.6820	.9325	1.072	.73135	47
50	.5995	.7490	1.335	.80038	10	10	.6841	.9380	1.066	.72937	50
						20	.6862	.9435	1.060	.72737	40
37	.6018	.7536	1.327	.79864	53	30	.6884	.9490	1.054	.72537	30
10	.6041	.7581	1.319	.79688	50	40	.6905	.9545	1.048	.72337	20
20	.6065	.7627	1.311	.79512	40	50	.6926	.9601	1.042	.72136	10
30	.6088	.7673	1.303	.79335	30						
40	.6111	.7720	1.295	.79158	20	44	.6947	.9657	1.036	.71934	46
50	.6134	.7766	1.288	.78980	10	10	.6967	.9713	1.030	.71732	50
						20	.6988	.9770	1.024	.71529	40
38	.6157	.7813	1.280	.78801	52	30	.7009	.9827	1.018	.71325	30
10	.6180	.7860	1.272	.78622	50	40	.7030	.9884	1.012	.71121	20
20	.6202	.7907	1.265	.78442	40	50	.7050	.9942	1.006	.70916	10
							.7071	1.	1.	.70711	45
											°
	Cosin.	Cotg.	Tan.	Sine.	Angle.		Cosin.	Cotg.	Tan.	Sine.	Angle.

TABLE IX.—CALCULATION OF EARTHWORK.


Width	HEIGHT														
	1	2	3	4	5	6	7	8	9	10	11	12	13	14	15
1	.02	.04	.06	.07	.09	.11	.13	.15	.17	.18	.20	.22	.24	.26	.28
2	.04	.07	.11	.15	.18	.22	.26	.30	.33	.37	.41	.44	.48	.52	.56
3	.06	.11	.17	.22	.28	.33	.39	.44	.50	.56	.61	.67	.72	.78	.83
4	.07	.15	.22	.30	.37	.44	.52	.59	.67	.74	.81	.89	.96	1.04	1.11
5	.09	.19	.28	.37	.46	.56	.65	.74	.83	.93	1.02	1.11	1.20	1.30	1.39
6	.11	.22	.33	.44	.56	.67	.78	.89	1.00	1.11	1.22	1.33	1.44	1.55	1.67
7	.13	.26	.39	.52	.65	.78	.91	1.04	1.16	1.30	1.42	1.55	1.68	1.81	1.94
8	.15	.30	.44	.59	.74	.89	1.04	1.19	1.33	1.48	1.63	1.78	1.92	2.08	2.22
9	.17	.33	.50	.67	.83	1.00	1.17	1.33	1.50	1.67	1.83	2.00	2.17	2.33	2.50
10	.18	.37	.56	.74	.93	1.11	1.30	1.48	1.67	1.85	2.04	2.22	2.41	2.59	2.78
11	.20	.41	.61	.82	1.02	1.22	1.43	1.63	1.83	2.04	2.24	2.44	2.65	2.85	3.06
12	.22	.44	.67	.89	1.11	1.33	1.56	1.78	2.00	2.22	2.44	2.67	2.89	3.11	3.33
13	.24	.48	.72	.96	1.20	1.44	1.68	1.92	2.16	2.41	2.65	2.89	3.13	3.37	3.61
14	.26	.52	.78	1.04	1.30	1.55	1.81	2.08	2.33	2.59	2.85	3.11	3.37	3.63	3.89
15	.28	.56	.83	1.11	1.39	1.67	1.94	2.22	2.50	2.78	3.06	3.33	3.61	3.89	4.17
16	.30	.59	.89	1.18	1.48	1.78	2.07	2.37	2.67	2.96	3.26	3.56	3.85	4.15	4.44
17	.31	.63	.94	1.26	1.57	1.89	2.20	2.52	2.83	3.15	3.46	3.78	4.09	4.41	4.72
18	.33	.67	1.00	1.33	1.67	2.00	2.33	2.67	3.00	3.33	3.67	4.00	4.33	4.67	5.00
19	.35	.70	1.06	1.41	1.76	2.11	2.46	2.82	3.17	3.52	3.87	4.22	4.57	4.92	5.28
20	.37	.74	1.11	1.48	1.85	2.22	2.59	2.96	3.33	3.70	4.07	4.44	4.81	5.18	5.56
21	.39	.78	1.17	1.55	1.94	2.33	2.72	3.11	3.50	3.89	4.28	4.67	5.06	5.44	5.83
22	.41	.81	1.22	1.63	2.04	2.44	2.85	3.26	3.67	4.07	4.48	4.89	5.30	5.70	6.11
23	.43	.85	1.28	1.70	2.13	2.56	2.98	3.41	3.83	4.26	4.68	5.11	5.54	5.96	6.39
24	.44	.89	1.33	1.78	2.22	2.67	3.11	3.56	4.00	4.44	4.89	5.33	5.78	6.22	6.67
25	.46	.92	1.39	1.85	2.31	2.78	3.24	3.70	4.17	4.63	5.09	5.56	6.02	6.48	6.94
26	.48	.96	1.44	1.92	2.41	2.89	3.37	3.85	4.33	4.82	5.30	5.78	6.26	6.74	7.24
27	.50	1.00	1.50	2.00	2.50	3.00	3.50	4.00	4.50	5.00	5.50	6.00	6.50	7.00	7.50
28	.52	1.04	1.55	2.07	2.59	3.11	3.63	4.15	4.67	5.18	5.70	6.22	6.74	7.26	7.78
29	.54	1.07	1.61	2.15	2.68	3.22	3.76	4.30	4.83	5.37	5.91	6.44	6.98	7.52	8.06
30	.56	1.11	1.67	2.22	2.78	3.33	3.89	4.44	5.00	5.55	6.11	6.67	7.22	7.78	8.33
31	.57	1.15	1.72	2.30	2.87	3.44	4.02	4.59	5.17	5.74	6.32	6.89	7.46	8.04	8.61
32	.59	1.18	1.78	2.37	2.96	3.56	4.15	4.74	5.33	5.92	6.52	7.11	7.70	8.30	8.89
33	.61	1.22	1.83	2.44	3.05	3.67	4.28	4.89	5.50	6.11	6.72	7.33	7.94	8.55	9.17
34	.63	1.26	1.89	2.52	3.15	3.78	4.40	5.04	5.67	6.29	6.93	7.56	8.18	8.81	9.44
35	.65	1.30	1.94	2.59	3.24	3.89	4.53	5.18	5.83	6.48	7.13	7.78	8.42	9.08	9.72
36	.67	1.33	2.00	2.67	3.33	4.00	4.66	5.33	6.00	6.67	7.33	8.00	8.67	9.33	10.00
37	.68	1.37	2.06	2.74	3.42	4.11	4.79	5.48	6.17	6.85	7.54	8.22	8.91	9.59	10.28
38	.70	1.41	2.11	2.82	3.52	4.22	4.92	5.63	6.33	7.03	7.74	8.44	9.15	9.85	10.56
39	.72	1.44	2.17	2.89	3.61	4.33	5.05	5.78	6.50	7.22	7.95	8.67	9.39	10.11	10.83
40	.74	1.48	2.22	2.96	3.70	4.44	5.18	5.92	6.67	7.41	8.15	8.89	9.63	10.37	11.11

Table gives cu. yds. in 1 ft. of a triangle of given width and height. Corrections for tenths of width are one tenth the values found under each height considering the widths from 1 to 9 as tenths and similarly the corrections for tenths of height are one tenth the figures opposite width considering the heights from 1 to 9 as tenths. Thus if $w = 16.2$ and $h = 5.3$, cu. yds. $= 1.43 + .028 + .089 = 1.597$ cu. yds. or practically 160 cu. yds. per 100 ft. If w exceeds 40 ft., use one half and multiply result by 2, if both w and h are large use one half of each and multiply result by 4. Any cross-section may be divided into triangles by the following rule. To the triangle of the sum of the outside cuts (or fills) $= h$, and $\frac{1}{2}$ the roadbed $= w$, add the triangles formed by taking the distance out to each break in turn ($= w$'s) by the difference between the cuts (or fills) on each side of it ($= h$'s) always subtracting the outer from the inner.


DIAGRAM FOR OBTAINING HORIZONTAL AND VERTICAL DISTANCES FROM STADIA READINGS

Enter on the horizontal scale with the value of the stadia reading or interval times the stadia constant (usually taken as 100) and run vertically upward to intersection with line representing the vertical angle. The location of this point with reference to the dotted line marked "ONE" etc., gives the correction to be subtracted from the entering value and to which "f+c" (usually about 1 ft.) must be added to obtain the Horizontal Distance. The reading on vertical scale plus about 0.1 ft. for each 5° of vertical angle [$-(f+c \text{ Sino})$] is the Vertical Distance.


© 1914 BY J.K.FINCH.

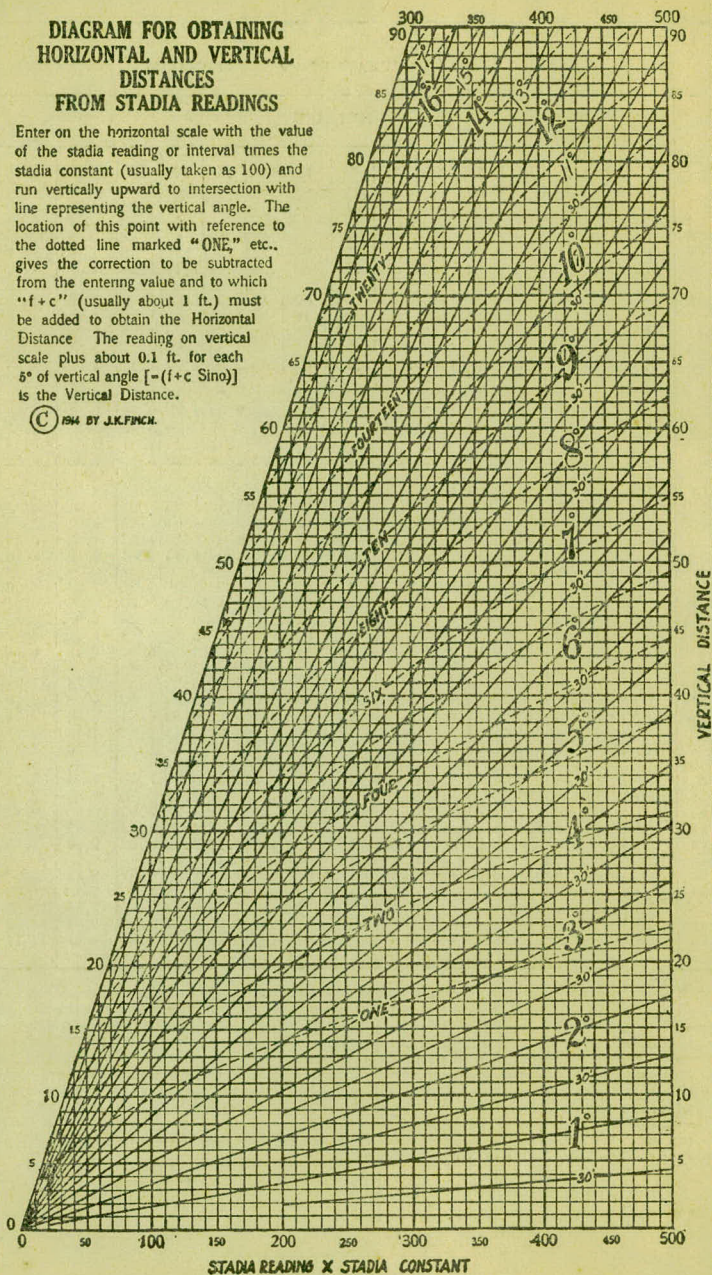



500 550 600 650 700 750 800 850 900 950 1000

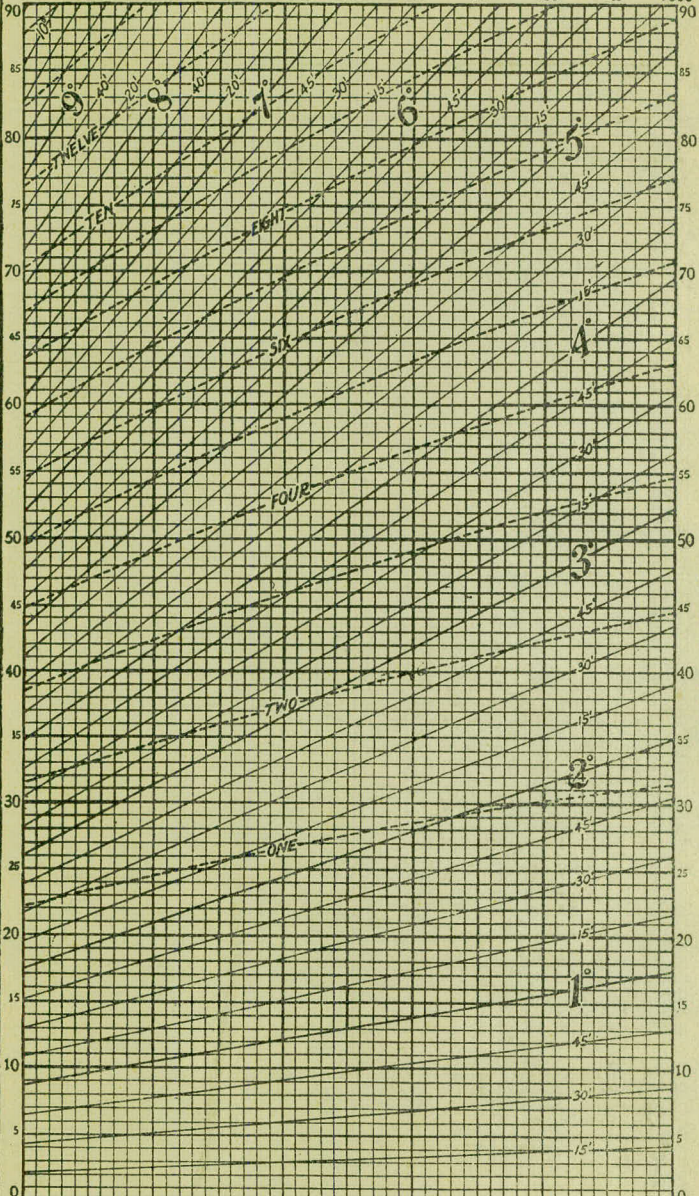


STADIA READING X STADIA CONSTANT

 


 


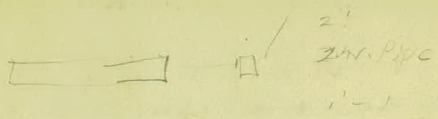

17.00
17.18
17.38

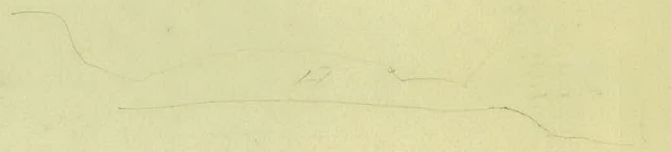

34.93
7.25
47.68

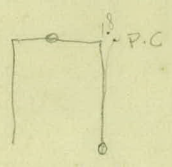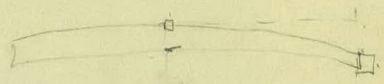

U2489

DISTANCES FROM CENTER OF ROADWAY FOR
CROSS-SECTIONING.

Roadway 16 feet wide. Side Slopes 1 on 1½.
For Single Track Embankment.

H	0	.1	.2	.3	.4	.5	.6	.7	.8	.9	H
0	8.0	8.2	8.3	8.5	8.6	8.8	8.9	9.1	9.2	9.4	0
1	9.5	9.7	9.8	10.0	10.1	10.3	10.4	10.6	10.7	10.9	1
2	11.0	11.2	11.3	11.5	11.6	11.8	11.9	12.1	12.2	12.4	2
3	12.5	12.7	12.8	13.0	13.1	13.3	13.4	13.6	13.7	13.9	3
4	14.0	14.2	14.3	14.5	14.6	14.8	14.9	15.1	15.2	15.4	4
5	15.5	15.7	15.8	16.0	16.1	16.3	16.4	16.6	16.7	16.9	5
6	17.0	17.2	17.3	17.5	17.6	17.8	17.9	18.1	18.2	18.4	6
7	18.5	18.7	18.8	19.0	19.1	19.3	19.4	19.6	19.7	19.9	7
8	20.0	20.2	20.3	20.5	20.6	20.8	20.9	21.1	21.2	21.4	8
9	21.5	21.7	21.8	22.0	22.1	22.3	22.4	22.6	22.7	22.9	9
10	23.0	23.2	23.3	23.5	23.6	23.8	23.9	24.1	24.2	24.4	10
11	24.5	24.7	24.8	25.0	25.1	25.3	25.4	25.6	25.7	25.9	11
12	26.0	25.2	26.3	26.5	26.6	26.8	26.9	27.1	27.2	27.4	12
13	27.5	27.7	27.8	28.0	28.1	28.3	28.4	28.6	28.7	28.9	13
14	29.0	29.2	29.3	29.5	29.6	29.8	29.9	30.1	30.2	30.4	14
15	30.5	30.7	30.8	31.0	31.1	31.3	31.4	31.6	31.7	31.9	15
16	32.0	32.2	32.3	32.5	32.6	32.8	32.9	33.1	33.2	33.4	16
17	33.5	33.7	33.8	34.0	34.1	34.3	34.4	34.6	34.7	34.9	17
18	35.0	35.2	35.3	35.5	35.6	35.8	35.9	36.1	36.2	36.4	18
19	36.5	36.7	36.8	37.0	37.1	37.3	37.4	37.6	37.7	37.9	19
20	38.0	38.2	38.3	38.5	38.6	38.8	38.9	39.1	39.2	39.4	20
21	39.5	39.7	39.8	40.0	40.1	40.3	40.4	40.6	40.7	40.9	21
22	41.0	41.2	41.3	41.5	41.6	41.8	41.9	42.1	42.2	42.4	22
23	42.5	42.7	42.8	43.0	43.1	43.3	43.4	43.6	43.7	43.9	23
24	44.0	44.2	44.3	44.5	44.6	44.8	44.9	45.1	45.2	45.4	24
25	45.5	45.7	45.8	46.0	46.1	46.3	46.4	46.6	46.7	46.9	25
26	47.0	47.2	47.3	47.5	47.6	47.8	47.9	48.1	48.2	48.4	26
27	48.5	48.7	48.8	49.0	49.1	49.3	49.4	49.6	49.7	49.9	27
28	50.0	50.2	50.3	50.5	50.6	50.8	50.9	51.1	51.2	51.4	28
29	51.5	51.7	51.8	52.0	52.1	52.3	52.4	52.6	52.7	52.9	29
30	53.0	53.2	53.3	53.5	53.6	53.8	53.9	54.1	54.2	54.4	30
31	54.5	54.7	54.8	55.0	55.1	55.3	55.4	55.6	55.7	55.9	31
32	56.0	56.2	56.3	56.5	56.6	56.8	56.9	57.1	57.2	57.4	32
33	57.5	57.7	57.8	58.0	58.1	58.3	58.4	58.6	58.7	58.9	33
34	59.0	59.2	59.3	59.5	59.6	59.8	59.9	60.1	60.2	60.4	34
35	60.5	60.7	60.8	61.0	61.1	61.3	61.4	61.6	61.7	61.9	35
36	62.0	62.2	62.3	62.5	62.6	62.8	62.9	63.1	63.2	63.4	36
37	63.5	63.7	63.8	64.0	64.1	64.3	64.4	64.6	64.7	64.9	37
38	65.0	65.2	65.3	65.5	65.6	65.8	65.9	66.1	66.2	66.4	38
39	66.5	66.7	66.8	67.0	67.1	67.3	67.4	67.6	67.7	67.9	39
40	68.0	68.2	68.3	68.5	68.6	68.8	68.9	69.1	69.2	69.4	40

Example—If point is 22.0 ft. above grade, how far should it be from center line to be a slope stake point? Ans. from Table 41.9. For same slopes but other widths of roadbed correct above figures by one-half difference in width of roadbed; thus in example above for 20 ft. roadbed distance will be $41.9 + (20 - 16) \div 2$ or 2 ft. added to 41.9 = 43.9. For slopes of 1 on 1 see inside of front cover.