

OFFICE OF
SAMSEY COUNTY ENGR.

CONSTRUCTION NOTES

CARPENTERS AVENUE.

CO. PROJ. N^o 26-54

FILE N^o. 7

ENGINEERS'
FIELD BOOK
NO. 10103

3-17-26

7

EUGENE DIETZGEN CO.

DRAWING MATERIALS, MATHEMATICAL and
SURVEYING INSTRUMENTS

Chicago New York San Francisco New Orleans Pittsburg Toronto

Distances from Center of Roadway for Cross-Sectioning
Roadway 16 feet wide. Side Slopes 1 on 1.
For Single Track Embankment.


H	0	.1	.2	.3	.4	.5	.6	.7	.8	.9	H
0	8.0	8.1	8.2	8.3	8.4	8.5	8.6	8.7	8.8	8.9	0
1	9.0	9.1	9.2	9.3	9.4	9.5	9.6	9.7	9.8	9.9	1
2	10.0	10.1	10.2	10.3	10.4	10.5	10.6	10.7	10.8	10.9	2
3	11.0	11.1	11.2	11.3	11.4	11.5	11.6	11.7	11.8	11.9	3
4	12.0	12.1	12.2	12.3	12.4	12.5	12.6	12.7	12.8	12.9	4
5	13.0	13.1	13.2	13.3	13.4	13.5	13.6	13.7	13.8	13.9	5
6	14.0	14.1	14.2	14.3	14.4	14.5	14.6	14.7	14.8	14.9	6
7	15.0	15.1	15.2	15.3	15.4	15.5	15.6	15.7	15.8	15.9	7
8	16.0	16.1	16.2	16.3	16.4	16.5	16.6	16.7	16.8	16.9	8
9	17.0	17.1	17.2	17.3	17.4	17.5	17.6	17.7	17.8	17.9	9
10	18.0	18.1	18.2	18.3	18.4	18.5	18.6	18.7	18.8	18.9	10
11	19.0	19.1	19.2	19.3	19.4	19.5	19.6	19.7	19.8	19.9	11
12	20.0	20.1	20.2	20.3	20.4	20.5	20.6	20.7	20.8	20.9	12
13	21.0	21.1	21.2	21.3	21.4	21.5	21.6	21.7	21.8	21.9	13
14	22.0	22.1	22.2	22.3	22.4	22.5	22.6	22.7	22.8	22.9	14
15	23.0	23.1	23.2	23.3	23.4	23.5	23.6	23.7	23.8	23.9	15
16	24.0	24.1	24.2	24.3	24.4	24.5	24.6	24.7	24.8	24.9	16
17	25.0	25.1	25.2	25.3	25.4	25.5	25.6	25.7	25.8	25.9	17
18	26.0	26.1	26.2	26.3	26.4	26.5	26.6	26.7	26.8	26.9	18
19	27.0	27.1	27.2	27.3	27.4	27.5	27.6	27.7	27.8	27.9	19
20	28.0	28.1	28.2	28.3	28.4	28.5	28.6	28.7	28.8	28.9	20
21	29.0	29.1	29.2	29.3	29.4	29.5	29.6	29.7	29.8	29.9	21
22	30.0	30.1	30.2	30.3	30.4	30.5	30.6	30.7	30.8	30.9	22
23	31.0	31.1	31.2	31.3	31.4	31.5	31.6	31.7	31.8	31.9	23
24	32.0	32.1	32.2	32.3	32.4	32.5	32.6	32.7	32.8	32.9	24
25	33.0	33.1	33.2	33.3	33.4	33.5	33.6	33.7	33.8	33.9	25
26	34.0	34.1	34.2	34.3	34.4	34.5	34.6	34.7	34.8	34.9	26
27	35.0	35.1	35.2	35.3	35.4	35.5	35.6	35.7	35.8	35.9	27
28	36.0	36.1	36.2	36.3	36.4	36.5	36.6	36.7	36.8	36.9	28
29	37.0	37.1	37.2	37.3	37.4	37.5	37.6	37.7	37.8	37.9	29
30	38.0	38.1	38.2	38.3	38.4	38.5	38.6	38.7	38.8	38.9	30
31	39.0	39.1	39.2	39.3	39.4	39.5	39.6	39.7	39.8	39.9	31
32	40.0	40.1	40.2	40.3	40.4	40.5	40.6	40.7	40.8	40.9	32
33	41.0	41.1	41.2	41.3	41.4	41.5	41.6	41.7	41.8	41.9	33
34	42.0	42.1	42.2	42.3	42.4	42.5	42.6	42.7	42.8	42.9	34
35	43.0	43.1	43.2	43.3	43.4	43.5	43.6	43.7	43.8	43.9	35
36	44.0	44.1	44.2	44.3	44.4	44.5	44.6	44.7	44.8	44.9	36
37	45.0	45.1	45.2	45.3	45.4	45.5	45.6	45.7	45.8	45.9	37
38	46.0	46.1	46.2	46.3	46.4	46.5	46.6	46.7	46.8	46.9	38
39	47.0	47.1	47.2	47.3	47.4	47.5	47.6	47.7	47.8	47.9	39
40	48.0	48.1	48.2	48.3	48.4	48.5	48.6	48.7	48.8	48.9	40

Example—If point is 22.6 ft. above grade, how far should it be from center line to be a slope stake point? Ans. from Table 30.6. . For same slopes but other widths of roadbed, correct above figures by one-half difference in width of roadbed; thus in example above, for 20 ft. roadbed distance will be $30.6 + (20 - 16) \div 2$ added to $30.6 = 32.6$. For slopes of 1 on $1\frac{1}{2}$ see inside of back cover.

Copyright, 1914, by Eugene Dietzgen Co.

INDEX.

Sta	Sta	Description	P.	P
0	35+18	Alignment	4	6
0	35+18	X-Sections Originals	9	16
30+00	32+00	X-Sections for Borrow Pit		17
		± and cross Levels to determine Grade Change, also elev of		
12+50	21+50	Truck Garden where natural ground beared	18	22
	13+11	Orig. X-Sec. F. Ent. Rt.		36
	13+11	Final X-Sec. F. Ent. Rt.		37
	15+29	Original X-Sec. F. Ent.		38
0+00	34+50	Final X-Sec. ⁽²⁾ (Was 0 Outs)	39	48
	15+29	Final X-Sec. F. Ent Lt.	49	50
	15+25	✓ ✓ ✓ ✓ Rt.		51
	23+04	✓ ✓ ✓ ✓ Lt.		52
	23+25	✓ ✓ ✓ ✓ Rt.		53
0-	24	Final - Culverts & F. Ent.		54
15-	34	Final Gaurd Rail		55
		Loc. of Proposed Ditches & Culv.		56
15+38	23+10	± Levels & X-Sec. ✓ ✓ Rt.	57	58
14+66	20+00	✓ ✓ ✓ ✓ ✓ Lt.		59
20+00		X-Sec. of Roadbed @ Culv. loc.		59
14+68		± X-Sec. of County Ditch M.W.S.		60

 



Station	Point	Lt.	Rt.	Bear.
---------	-------	-----	-----	-------

12+21. ²⁵

P.O.T.

13+11.03

2+00

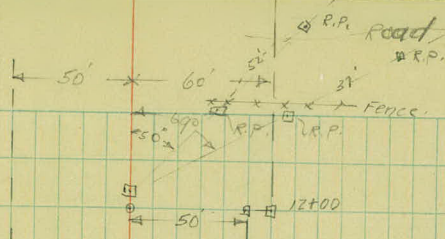

5+50 □ - □

○ 50' □ 5+85
 ○ 33' □ 5+35
 (Kent Str.)

0+33 □ 33' - □ 0+33

Mount set in Payment

Station	Point	Lt. Δ	Rt.	Bear.
---------	-------	-------	-----	-------

24103.23	P.T.		7°15'	
20100			7°11.2'	
19750		6301	6°11.2'	
19750		5241	5°11.2'	4° C. Rt.
18150		4211	4°11.2'	Δ 140°30'
18100		3241	3°11.2'	PI. 18+23.00
17750		2201	2°11.2'	T. 82.27'
17700		1241	1°11.2'	L. 362.50
16750		0241	0°11.2'	R. 1432.64
			0°00'	

Eq. = 16+40.73
 16+38.80


P.C.

6 Willow

Hub

46

8 Willow

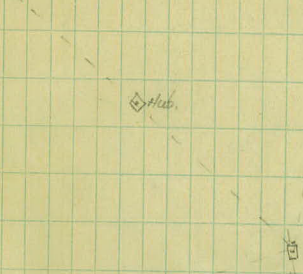

Station Point Lt. Δ Rt. Bear.

35+18.75

32+81.50

RT.

14°-35'

+50

13°-19.4'

32

11°-19.4'

8°-C.Rt

+50

P.O.C.

9°-19.4'

Δ 29°-10'

31

7°-19.4'

P.I. 31+03.4

+50

5°-19.4'

T. 126.48

30

3°-19.4'

L. 364.58

+50

1°-19.4'

R. 716.78

29+16.92

P.C.

0°-00'

Eq 29+16.35

see loc. notes for
location of
wheelock party

S. 1.8 @ Willow.

drilled hole in
asphalt

S. 6.90

S.E. cor. C.B.
Flats



Too E. Bail Black Water Tank.


1/2 Mile.


about 105'

about 115'

Point of
Yellow Basin


442.

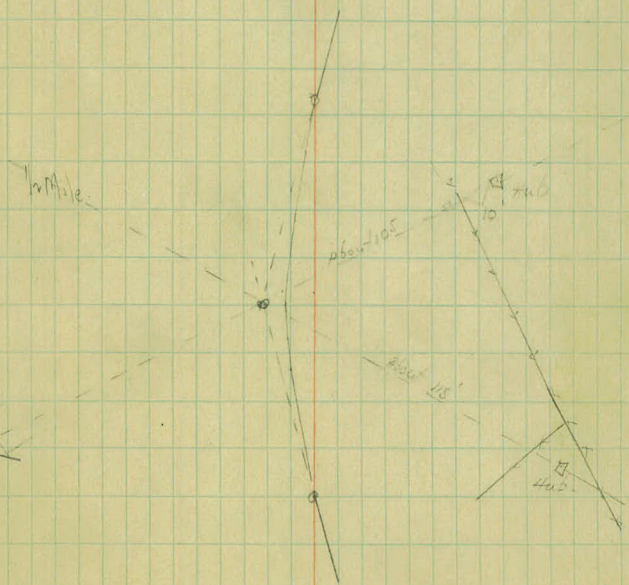

 

The image shows a page of graph paper with a grid of small squares. A vertical red line runs down the center of the page, dividing the grid into two equal halves. The grid consists of 20 columns and 30 rows of squares. The paper is off-white or light beige. There are a few small dark spots on the page, one notably in the upper right quadrant of the grid.

5.75	924.68		918.93
7.52	929.85	2.35	922.33
1.64	929.29	2.20	927.65
		2.88	926.41

 

Original Cross Sections

Sta.	B. S.	H. I.	F. S.	Grade	Gr. R.
B.M.	2.87	921.80			
0				918.9	2.9
+10				18.9	2.9
+18				18.9	2.9
+33				18.9	2.9
+50				19.0	2.9
1				19.0	2.8
+50				19.1	2.7
2				19.1	2.7
+50				19.2	2.6
3				19.2	2.6
T.P.	6.48	926.05	2.23		
+50				19.3	2.6

In W.H.C.
 Roa. A.L.P.
 Chain. C.F.B.
 H.T.P.

June 14 1926

9

Left

C L

Right

30' Roadway
 Ent slope 1/2' 1
 Exc " 1/2' 1



Top of monument Date at Larpenteur (918.9)

$\frac{34}{33}$ $\frac{30}{30}$ $\frac{2.90}{10}$ $\frac{2.81}{10}$ $\frac{2.95}{33}$ (2.9)

$\frac{34}{33}$ $\frac{3.2}{24}$ $\frac{2.85}{10}$ $\frac{2.88}{10}$ $\frac{2.97}{33}$ (2.9)

$\frac{3.7}{33}$ $\frac{3.2}{25}$ $\frac{3.5}{20}$ $\frac{3.3}{10}$ $\frac{3.3}{10}$ $\frac{3.5}{33}$ (2.9)

$\frac{3.8}{33}$ $\frac{4.1}{20}$ $\frac{4.2}{10}$ $\frac{4.3}{10}$ $\frac{3.7}{4}$ $\frac{2.7}{15}$ $\frac{2.9}{26}$ $\frac{2.8}{33}$ (2.9)

$\frac{4.6}{33}$ $\frac{4.5}{19}$ $\frac{4.8}{18.4}$ $\frac{4.8}{20}$ $\frac{4.6}{2}$ $\frac{4.0}{1}$ $\frac{4.0}{-1.2}$ $\frac{3.7}{4}$ $\frac{3.3}{6}$ $\frac{3.1}{-0.3}$ $\frac{3.1}{15.5}$ $\frac{3.1}{11.7}$ $\frac{3.2}{10.6}$ $\frac{3.2}{33}$ (2.8)

$\frac{4.5}{33}$ $\frac{5.6}{19.2}$ $\frac{5.8}{-2.8}$ $\frac{5.5}{-2.7}$ $\frac{5.2}{8}$ $\frac{4.8}{-2.0}$ $\frac{4.7}{18.0}$ $\frac{4.7}{24}$ $\frac{4.7}{33}$ (2.8)

$\frac{5.5}{33}$ $\frac{6.0}{20.4}$ $\frac{5.5}{-3.3}$ $\frac{5.5}{15}$ $\frac{6.1}{-2.4}$ $\frac{6.2}{9}$ $\frac{6.0}{-2.8}$ $\frac{6.2}{20.7}$ $\frac{6.2}{33}$ (2.7)

$\frac{5.6}{33}$ $\frac{5.9}{20}$ $\frac{5.5}{-3.2}$ $\frac{5.5}{14}$ $\frac{6.0}{-3.3}$ $\frac{6.3}{11}$ $\frac{6.6}{16}$ $\frac{6.1}{-3.4}$ $\frac{6.1}{20.1}$ $\frac{6.5}{33}$ (2.7)

$\frac{4.8}{33}$ $\frac{5.3}{24}$ $\frac{5.7}{19.7}$ $\frac{5.7}{-3.1}$ $\frac{5.3}{4}$ $\frac{5.7}{-2.1}$ $\frac{6.4}{3}$ $\frac{5.9}{8}$ $\frac{6.1}{-3.5}$ $\frac{6.1}{20.3}$ $\frac{6.1}{33}$ (2.6)

$\frac{3.7}{33}$ $\frac{3.6}{21.8}$ $\frac{3.6}{4.0}$ $\frac{3.6}{18.1}$ $\frac{3.6}{17.1}$ $\frac{4.0}{-1.4}$ $\frac{4.4}{16}$ $\frac{4.3}{14}$ $\frac{4.5}{-1.9}$ $\frac{5.3}{8}$ $\frac{5.0}{14}$ $\frac{4.5}{17.5}$ $\frac{4.6}{-2.0}$ $\frac{4.6}{18.0}$ $\frac{4.9}{33}$ (2.6)

919.57
 $\frac{6.1}{33}$ $\frac{6.4}{26}$ $\frac{6.4}{10.4}$ $\frac{6.4}{22}$ $\frac{6.0}{7}$ $\frac{6.3}{15.3}$ $\frac{6.2}{-0.4}$ $\frac{6.2}{14}$ $\frac{6.3}{-0.3}$ $\frac{6.3}{7}$ $\frac{7.0}{10}$ $\frac{7.3}{-0.5}$ $\frac{7.3}{15.8}$ $\frac{7.8}{10}$ $\frac{7.7}{10.245}$ $\frac{7.7}{33}$ (6.8)

original

Sta.	B. S.	H. I.	F. S.	Grade	Gr. R.
4		926.05		919.3	6.8
	+50			19.4	6.7
5				19.4	6.7
	+50			19.5	6.6
6				19.5	6.6
T.P.	9.66	930.12	5.59		
	+50			19.6	10.5
7				19.6	10.5
	+50			19.7	10.4
8				19.7	10.4
	+50			19.7	10.4
9				19.2	10.9

Inst. W.H.C.
 Rod. A.L.P.
 Chain. C.F.B.
 H.T.P.

June 14, 1926

10

Left

C L

Right

$\frac{5.1}{33}$ $\frac{5.4}{11.4}$ $\frac{5.6}{17}$ $\frac{5.9}{13}$ $\frac{5.8}{10}$ $\frac{6.0}{11}$ $\frac{6.1}{10.7}$ $\frac{5.8}{32.5}$

$\frac{5.0}{33}$ $\frac{4.9}{11.8}$ $\frac{4.9}{24}$ $\frac{5.3}{22}$ $\frac{5.2}{15}$ $\frac{5.7}{14}$ $\frac{5.4}{11.3}$ $\frac{5.3}{15}$ $\frac{5.6}{11.1}$ $\frac{5.9}{33}$

$\frac{4.7}{33}$ $\frac{4.6}{29.1}$ $\frac{4.4}{24}$ $\frac{4.5}{14}$ $\frac{5.5}{10}$ $\frac{5.0}{11.7}$ $\frac{5.6}{10}$ $\frac{5.4}{11.3}$ $\frac{5.5}{33}$

$\frac{6.1}{33}$ $\frac{6.0}{26.9}$ $\frac{6.1}{23}$ $\frac{4.8}{11}$ $\frac{5.3}{8}$ $\frac{5.9}{10.7}$ $\frac{6.1}{9}$ $\frac{6.1}{10.5}$ $\frac{6.1}{33}$

$\frac{5.6}{33}$ $\frac{5.4}{27.8}$ $\frac{5.5}{21}$ $\frac{5.8}{10}$ $\frac{5.2}{5}$ $\frac{5.7}{4}$ $\frac{5.7}{10.9}$ $\frac{5.5}{12}$ $\frac{5.0}{11.6}$ $\frac{5.0}{33}$

920.4/6 $\frac{8.0}{33}$ $\frac{8.0}{29.8}$ $\frac{7.6}{25}$ $\frac{8.0}{14}$ $\frac{8.6}{5}$ $\frac{9.1}{11.4}$ $\frac{8.2}{6}$ $\frac{8.9}{22}$ $\frac{8.5}{22.0}$ $\frac{8.5}{33}$

$\frac{6.5}{50}$ $\frac{6.5}{32.0}$ $\frac{6.2}{23}$ $\frac{7.3}{5}$ $\frac{7.8}{13.7}$ $\frac{7.0}{6}$ $\frac{7.9}{12.6}$ $\frac{7.9}{29.9}$ $\frac{7.9}{33}$

$\frac{5.1}{50}$ $\frac{5.5}{33.4}$ $\frac{5.2}{22}$ $\frac{6.1}{8}$ $\frac{5.6}{5}$ $\frac{5.9}{14.5}$ $\frac{5.6}{5}$ $\frac{6.0}{10.1}$ $\frac{6.0}{32.6}$ $\frac{6.0}{50}$

$\frac{4.7}{50}$ $\frac{5.1}{34.0}$ $\frac{4.7}{24}$ $\frac{5.2}{10}$ $\frac{5.7}{9}$ $\frac{5.2}{4}$ $\frac{5.7}{14.7}$ $\frac{5.0}{7}$ $\frac{6.0}{14}$ $\frac{5.4}{16}$ $\frac{5.2}{15.2}$ $\frac{5.7}{50}$

$\frac{5.3}{50}$ $\frac{5.5}{33.4}$ $\frac{5.2}{22}$ $\frac{5.9}{17}$ $\frac{6.0}{2}$ $\frac{5.6}{13.8}$ $\frac{6.1}{7}$ $\frac{6.7}{27}$ $\frac{6.6}{13.8}$ $\frac{6.6}{31.7}$ $\frac{7.4}{50}$

$\frac{5.5}{50}$ $\frac{5.5}{33.6}$ $\frac{4.9}{24}$ $\frac{5.4}{20}$ $\frac{5.6}{3}$ $\frac{6.1}{14.5}$ $\frac{6.0}{8}$ $\frac{7.0}{13}$ $\frac{6.6}{16.5}$ $\frac{6.4}{14.5}$ $\frac{7.8}{50}$

Original Cross Sections

Sta.	B.S.	H.I. 930.12	F.S.	Grade	Gr. R.
T.P.	10.15	933.92	6.35		
+50				918.6	15.3
10				17.6	16.3
+50				16.4	17.5
11				14.9	19.0
+50				13.2	20.7
12				11.0	22.9
+40				09.1	24.8
+81				07.0	26.9
13				06.0	27.9
B.M.	2.88	929.28	7.52		926.40
+43				03.5	25.8
T.P.	1.7	917.97	12.48		916.80
+80				901.1	16.7
14				899.8	18.2

Original

Sections

Sta. B.M. H.I. S.S. Grade C.G.P.

917.97

+25

898.1 199

T.P. 2.07 908.90 11.14 906.83

+50

96.4 12.5

15

92.8 16.1

B.M. 0.72 901.16 8.46 900.44

+32

90.3 10.9

T.P. 0.45 889.25 12.36 888.80

15+50

88.9 ✓ 0.4

T.P. 0.16 876.82 12.59 876.66

16+00

85.0 ✓ +8.2

T.P. 0.03 864.90 12.45 864.37

+25

83.1 +18.7

Eq. $\frac{14+32.3}{16+40.73}$

+50

81.1 ✓ +16.7

+65

79.9 +15.5

17

77.2 +12.8

T.P. 0.54 853.39 11.55 852.85

+50

73.3 ✓ +9.9

18

69.4 +16.0

+50

65.5 +12.1

19

61.6 +9.9

CURVE 4° RT.

Original Cross Sections

Sta.	B. S.	11. I. 853.39	I. S.	Grade	Gr. R.
B.M.	5.80	853.39	5.80		847.59 +41 +3
19 +50				857.8	+44
T.P.	9.64	856.89	6.14		847.25 +17 +2
20				55.0	19
+50				53.2	3.6 28 3.7
21				52.5	24
+50				52.8	4.1
22				54.2	2.7
B.M.	5.43	856.89	5.43		(851.46)
+50				56.5	0.4
23				59.0	+21
T.P.	11.18	862.64	5.43		851.46
+50				61.5	1.1
+62				62.1	0.5
24				64.0	+14
T.P.	7.84	870.05	0.43		(862.21)
+50				66.5	3.6

W. H. C.
 Rod. A. L. P.
 Chain. C. F. B.
 J. T. P.
 Wolf

June 23, 1926

W. H. C. T.P. 44 Lt. Sta 19+07

+0.34
 -0.04

$\frac{74}{50}$	$\frac{74}{323}$	$\frac{74}{-115}$	$\frac{74}{20}$	$\frac{75}{-129}$	$\frac{75}{20}$	$\frac{70}{-118}$	$\frac{72}{347}$	$\frac{72}{50}$
-----------------	------------------	-------------------	-----------------	-------------------	-----------------	-------------------	------------------	-----------------

Top stake Sta 20

+0.22
 1.10-0.25

$\frac{110}{33}$	$\frac{110}{290}$	$\frac{110}{-93}$	$\frac{110}{-91}$	$\frac{107}{-85}$	$\frac{107}{289}$	$\frac{107}{33}$
------------------	-------------------	-------------------	-------------------	-------------------	-------------------	------------------

+0.07
 -0.08

$\frac{110}{33}$	$\frac{110}{261}$	$\frac{110}{-74}$	$\frac{110}{-73}$	$\frac{110}{-72}$	$\frac{110}{258}$	$\frac{110}{33}$
------------------	-------------------	-------------------	-------------------	-------------------	-------------------	------------------

$\frac{102}{33}$	$\frac{102}{-37}$	$\frac{102}{-58}$	$\frac{108}{-64}$	$\frac{106}{-62}$	$\frac{106}{273}$	$\frac{106}{33}$
------------------	-------------------	-------------------	-------------------	-------------------	-------------------	------------------

$\frac{95}{33}$	$\frac{95}{231}$	$\frac{95}{-54}$	$\frac{98}{-57}$	$\frac{90}{-59}$	$\frac{90}{239}$	$\frac{90}{33}$
-----------------	------------------	------------------	------------------	------------------	------------------	-----------------

$\frac{80}{33}$	$\frac{80}{239}$	$\frac{80}{-50}$	$\frac{88}{-61}$	$\frac{89}{-62}$	$\frac{90}{240}$	$\frac{90}{33}$
-----------------	------------------	------------------	------------------	------------------	------------------	-----------------

R.R. Stake T.P. Lt. Sta 22+45

$\frac{69}{33}$	$\frac{69}{208}$	$\frac{69}{-65}$	$\frac{73}{-69}$	$\frac{79}{-75}$	$\frac{80}{263}$	$\frac{80}{33}$
-----------------	------------------	------------------	------------------	------------------	------------------	-----------------

$\frac{62}{33}$	$\frac{62}{270}$	$\frac{62}{-87}$	$\frac{68}{-89}$	$\frac{68}{-89}$	$\frac{68}{283}$	$\frac{68}{33}$
-----------------	------------------	------------------	------------------	------------------	------------------	-----------------

$\frac{33}{33}$	$\frac{33}{133}$	$\frac{33}{-122}$	$\frac{47}{-106}$	$\frac{103}{-92}$	$\frac{97}{288}$	$\frac{97}{33}$
-----------------	------------------	-------------------	-------------------	-------------------	------------------	-----------------

$\frac{33}{33}$	$\frac{33}{124}$	$\frac{33}{125}$	$\frac{124}{-119}$	$\frac{112}{7}$	$\frac{25}{-90}$	$\frac{88}{285}$	$\frac{88}{33}$
-----------------	------------------	------------------	--------------------	-----------------	------------------	------------------	-----------------

$\frac{33}{33}$	$\frac{33}{109}$	$\frac{33}{-123}$	$\frac{33}{8}$	$\frac{35}{-49}$	$\frac{55}{17}$	$\frac{54}{-48}$	$\frac{44}{252}$	$\frac{44}{33}$
-----------------	------------------	-------------------	----------------	------------------	-----------------	------------------	------------------	-----------------

$\frac{153}{33}$	$\frac{153}{376}$	$\frac{117}{-117}$	$\frac{117}{15}$	$\frac{85}{-49}$	$\frac{74}{3}$	$\frac{58}{-22}$	$\frac{50}{183}$	$\frac{26}{106}$	$\frac{37}{239}$	$\frac{37}{33}$
------------------	-------------------	--------------------	------------------	------------------	----------------	------------------	------------------	------------------	------------------	-----------------

563
 562

Original

Cross

Sta.	B. S.	H. I. 870.05	F. S.	Grade	Gr. R.
25				869.0	1.1
T.P.	9.35	878.35	1.05		(869.00)
+50				71.5	2.9
26				74.0	4.4
T.P.	10.31	888.42	0.24		(878.11)
+70				75.0	13.4
+46				76.3	12.1
T.P.	10.99	895.20	4.21		(884.21)
27				79.0	16.2
+56				81.5	14.7
T.P.	11.50	900.24	6.46		(888.74)
28				84.0	16.2
+50				86.5	12.5 13.9 13.7
T.P.	11.65	903.79	8.10		(892.14)
29				89.0	14.4 14.8
+50				91.5	11.8 12.3
T.P.	11.70	906.89	8.60		(895.19)
30				94.0	12.3 12.9
+50				96.5	9.8 10.4

Left

C L

Right

	X				X		X	
110	103	23	53	22	167	0.5	269	+0.9
33	238	-9.2	15	-42	-11	+0.6	269.9	269.9
								33

	X			X		X	
16.0	153	10.1	10.1	7.7	102	5.7	50
33	26.1	-7.4	-7.2	-0.9	10.2	21.2	27.8

	X						X	
12.7	106	8.7	5.5	0.4	90	-2.4	362	
33	243	-6.2	14	-1.1	58	28.5	26.8	36.2

	X				X		
20.8	18.3	13.4	9.8	5.7	37.1		
33	21.4	-4.9	0.0	17	17.4		

	X				X		
19.5	15.7	13.2	1.8	4.6	40.4		
33	250	+1.3	7.5	+4.4	210	19.6	5.3
							50

W.	S.							
		20.5	18.7	18.6	12.2	9.6	1.6	5.3
		33	33	56	50.4	23.8	23	50

0.00								
		18.7	15.4	11.4	5.0	400.5	711	901.0
		33	17.9	-1.9	72.3	25	47.3	50

Top Stake pg								
		20.8	14.6	12.8	12.5	7.8	2.7	1.5
0.45		33	4.3	-0.2	22	22.3	20	50

90								
		18.1	11.0	12.8	10.6	6.2	4.9	0.6
		33	18.3	-1.2	12.0	41.7	24	50

00								
		19.1	16.7	12.5	8.6	3.4	4.3	1.6
		33	21.6	-4.4	10.1	22	10.2	50

00								
		21.4	14.9	14.2	11.0	6.7	2.0	9.3
		33	24.1	-6.1	16	10.6	19.1	50

Original Cross Sections

Sta.	B. S.	H. I.	F. S.	Grade	Gr. Pt.
		906.89			
31				899.0	^{7.3} 7.9 ^{8.6}
T.P.	7.72	910.72	3.89		(903.00)
+50				900.8	^{9.3} 9.9 ^{10.7}
32				91.4	^{8.7} 9.3 ^{10.0}
+25				901.1	^{9.0} 9.6 ^{10.2}
+50				900.6	^{9.6} 10.1 ^{10.7}
T.P.	2.84	903.81	9.75		(900.97)
+70				899.9	^{3.5} 3.9 ^{4.4}
+83				99.4	4.4
33				98.5	^{5.0} 5.7 ^{6.3}
+31.5				96.8	^{6.8} 7.0
+60				95.2	7.6
B.M.	0.42	894.56	9.63		(894.12)
34				93.0	1.6
+50				90.3	4.4
35				887.5	7.1

E LEVELS
DITCHES A & B

①
of 35 sheets

Larpenteur Ave.

Sta.	+	H.I.	-	Elev.	
B.M.	7.72	107.72 853.64		100.00 845.92	
0 + 00			7.7	45.9	Ditch
+ 50			7.9	45.7	"
			7.7	45.9	Water
1 + 00			8.4	45.2	Ditch
			7.8	45.8	Water
+ 50			8.5	45.1	Ditch
			7.9	45.7	Water
2 + 00			8.0	45.6	Ditch
			7.8	45.8	Water
+ 50			7.6	46.0	Ditch
					No Water
3 + 00			7.5	46.1	Ditch
			7.3	46.3	Water
+ 50			6.7	46.9	Ditch
4 + 00			5.9	47.7	"
+ 50			3.5	50.1	"
5 + 00			0.0	53.6	"

(DITCH A)

9-30-27

(2)

Flow Line South End of Culvert

B.M. Elev. assumed

Sta 0+00 = End of Culvert


Sta.	+	H.I.	-	Elev.	
		107.72			
		853.64			
0+00			8.5	45.1	Ditch
			7.9	45.7	Water
+50			7.9	45.7	Ditch
			7.8	45.8	Water
1+00			7.8	45.8	Ditch
+50			7.7	45.9	"
2+00			7.6	46.0	"
+50			7.1	46.5	"
3+00			6.5	47.1	"
+50			6.5	47.1	"
B.M.			7.72	100.00	
				845.92	

(DITCH B)

9-30-27

(3)

0+00 Ditch B = 1+50 Ditch A

 

	Left		C L		Right						
2.00	+0.56 -0.68	$\frac{142}{33}$	\times $\frac{12.7}{5.4}$	$\frac{168}{70}$	$\frac{47}{+0.2}$	$\frac{45}{20}$	$\frac{0.6}{+2.0}$	$\frac{104}{400}$	$\frac{407.8}{50}$		
3.00	+0.56 -0.68	$\frac{148}{33}$	\times $\frac{12}{1.9}$	$\frac{8.5}{+14}$	$\frac{61}{19}$	$\frac{7.5}{+7.2}$	$\frac{7}{388}$	$\frac{2.5}{53}$			
2.00	+0.56 -0.68	$\frac{144}{33}$	\times $\frac{11.4}{2.7}$	$\frac{121}{18}$	$\frac{83}{+1.0}$	$\frac{59}{29}$	$\frac{4.4}{+5.6}$	$\frac{2.3}{50}$	$\frac{5.0}{64}$ E curb,		
2.00	+0.6 -0.6	$\frac{148}{33}$	\times $\frac{12.4}{3.4}$	$\frac{115}{16}$	$\frac{92}{+0.4}$	$\frac{7.2}{15}$	$\frac{6.2}{26}$	$\frac{6.9}{29}$	$\frac{30}{+5.7}$	$\frac{6.9}{42}$	$\frac{7.3}{42}$ = Pave

Original Cross Sections

Sta. B. S. H. I. F. S. Grade Cr. Bl.

894.56

35+18.75

B.M.

0.42

In. W. H. C.
Rod. P. L. P.
Chain. H. T. P.
C. F. B.
Left

June 23, 1926

16

C L

Right

$\frac{72}{30}$ $\frac{7.24}{15.2}$ $\frac{7.80}{15.0}$ $\frac{7.44}{15.0}$ $\frac{7.71}{15.0}$
15.0 ← *average* → 15.0

Cross Sections for Borrow Pit

Sta.	Cross sections		Grade	Co. M.
	F. S.	H. I.		
B.M.	12.03	906.21	894.18	
T.P.	10.67	914.68	0.20	906.01
30+00				
30+50				
31+00				
450				
32+00				
32+50				
T.P.	10.3	906.21	11.50	905.18
B.M.			12.02	894.18

Inst. Sankup
 Rod.
 Chain.

Aug 1926

17

Left

C L

Right

All Sections checked
 and additional ones
 added

$\frac{11.3}{50}$ $\frac{8.5}{65}$ $\frac{6.5}{74}$ $\frac{5.8}{85}$

$\frac{12.1}{50}$ $\frac{8.3}{57}$ $\frac{4.6}{70}$ $\frac{5.0}{82}$ $\frac{3.5}{90}$

W.H.C. Aug 17, 1926

(17.7)

$\frac{9.0}{50}$ $\frac{7.0}{64}$ $\frac{5.7}{72}$ $\frac{4.2}{85}$ $\frac{2.1}{100}$ $\frac{1.8}{126}$ $\frac{1.6}{150}$ $\frac{10.5}{173}$ $\frac{17.3}{175}$

(15.9)

$\frac{8.4}{50}$ $\frac{6.8}{61}$ $\frac{5.3}{74}$ $\frac{3.8}{90}$ $\frac{3.0}{108}$ $\frac{3.2}{125}$ $\frac{5.7}{151}$ $\frac{6.5}{160}$
 $\frac{6.0}{150}$ $\frac{72.1}{231}$

$\frac{8.3}{50}$ $\frac{10.0}{53}$ $\frac{11.2}{64}$ Edge Cont

31400

31450

31500

31550


31600

231'

175'

90'

Fence Line

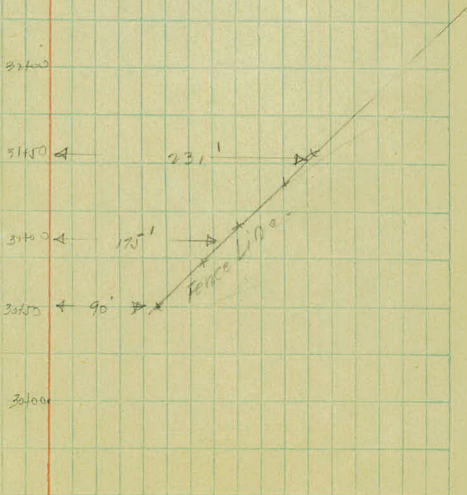

Top of New Grade to determine
 Grade change and Elev. of
 Cross Sections Truck Center

Sta.	B. S.			Gr. R.
		912.65		
9+00				
9+50				
10+00				
10+50				
11+00				
11+50				
T.P.	1.00	911.05	12.60	910.05
12+00				
12+40				
12+80				
13+20				
13+60				
14+00				
14+40				
14+80				
T.P.	1.90	900.70	12.25	898.20

Ir. W.A.C.
 R. A.L.P.
 Chain. H.T.P.
 W.A.

Aug 17, 1926

18

Left

G L

Right

$\frac{30}{15}$	26	$\frac{53}{15}$	$\frac{30}{919.7}$
$\frac{48}{15}$	$\frac{44}{15}$	$\frac{49}{15}$	$\frac{46}{18.1}$
$\frac{62}{15}$	45	$\frac{59}{15}$	$\frac{50}{17.7}$
$\frac{75}{15}$	65	$\frac{76}{15}$	$\frac{70}{15.7}$
$\frac{87}{15}$	77	$\frac{88}{15}$	$\frac{83}{14.4}$
$\frac{134}{15}$	$\frac{115}{15}$	$\frac{122}{15}$	$\frac{122}{10.5}$
$\frac{51}{15}$	30	$\frac{32}{15}$	$\frac{30}{07.9}$
$\frac{71}{15}$	$\frac{57}{15}$	$\frac{52}{15}$	$\frac{57}{05.4}$
$\frac{85}{15}$	46	$\frac{63}{15}$	$\frac{46}{04.5}$
$\frac{74}{15}$	83	$\frac{74}{15}$	$\frac{83}{02.8}$
$\frac{117}{15}$	$\frac{104}{15}$	$\frac{99}{15}$	$\frac{104}{900.7}$
$\frac{130}{15}$	$\frac{129}{15}$	$\frac{130}{15}$	$\frac{130}{98.1}$

Cross Sections

Sta.	B. S.	H. I.	I. S.	Grade	Gr. R.
		900.70			
14+00					
14+25					
14+50					
15+00					
B.M.	0.26	900.70	0.26	900.44	
15+32					
T.P.	0.22	888.59	12.33	888.37	
15+50					
16+00					
16+50					
T.P.	0.12	876.10	12.61	875.98	
17					
150					
18					
	1.03	864.50	12.63	863.47	

Inst.
 Rod.
 Chain.

Left

C L

Right

	$\frac{4.5}{15}$	$\frac{36}{5}$	$\frac{41}{15}$	$\frac{38}{5}$	96.9
	$\frac{53}{15}$	$\frac{47}{5}$	$\frac{47}{15}$	$\frac{48}{5}$	95.9
	$\frac{73}{15}$	$\frac{59}{5}$	$\frac{70}{15}$	$\frac{65}{5}$	94.2
	$\frac{99}{15}$	$\frac{95}{5}$	$\frac{12}{15}$	$\frac{95}{5}$	91.2
	$\frac{130}{15}$	$\frac{147}{5}$	$\frac{127}{15}$	$\frac{117}{5}$	89.0
	$\frac{13}{17}$	$\frac{13}{5}$	$\frac{17}{17.6}$	$\frac{13}{5}$	87.3
	$\frac{67}{18}$	$\frac{63}{5}$	$\frac{67}{17}$	$\frac{63}{5}$	82.3
	$\frac{112}{186}$	$\frac{115}{5}$	$\frac{114}{20}$	$\frac{115}{5}$	77.1
	$\frac{43}{125}$	$\frac{43}{5}$	$\frac{44}{22}$	$\frac{43}{5}$	71.8
	$\frac{91}{18}$	$\frac{85}{5}$	$\frac{87}{21}$	$\frac{85}{5}$	67.6
	$\frac{113}{16}$	$\frac{110}{5}$	$\frac{127}{21}$	$\frac{113}{5}$	64.8

..... Cross Sections

Sta.	B. S.	H. I.	F. S.	Grade	Gr. R.
		264.50			
18+50					
19					
T.P.	0.17	258.18	6.49	258.01	
19+50					
20+00					
20+50					
21+00				52.5	5.7
21+50				52.8	5.4
22+00					
22+50					
T.P.	2.58		0.50	257.68	
B.M.	12.74	264.20	8.80	251.46	
23+00				59.0	5.2
23+50				61.5	2.7

Inst.
 Rod.
 Chain.

Left

C L

Right

$\frac{2.3}{62.2}$

$\frac{2.7}{16.5}$

2.1

$\frac{2.5}{1.5}$

$\frac{1.2}{3.0}$

$\frac{16.0}{5.6}$

$\frac{14.0}{6.4}$

$\frac{6.0}{7.4}$

$\frac{17.0}{10.0}$

$\frac{5.0}{59.5}$

$\frac{5.0}{14}$

4.7

$\frac{5.0}{14}$

$\frac{1.5}{2.9}$

$\frac{6.0}{4.3}$

$\frac{14.0}{5.5}$

$\frac{15.5}{6.6}$

$\frac{17.0}{10.0}$

$\frac{1.2}{17.2}$

$\frac{1.2}{14}$

1.0

$\frac{0.7}{1.2}$

$\frac{1.2}{2.5}$

$\frac{1.2}{3.0}$

$\frac{5.3}{4.0}$

$\frac{8.1}{6.2}$

$\frac{10.4}{10.0}$

$\frac{1.5}{1.0}$

$\frac{3.7}{55.0}$

$\frac{3.7}{13}$

3.2

$\frac{3.0}{14}$

$\frac{1.0}{2.7}$

$\frac{1.0}{3.2}$

$\frac{8.0}{3.4}$

$\frac{6.5}{6.3}$

$\frac{9.0}{10.0}$

$\frac{11.1}{10.0}$

$\frac{1.5}{6.6}$
 $\frac{1.7}{5.7}$

$\frac{5.0}{52.7}$

$\frac{5.0}{11}$

5.5

$\frac{6.0}{14}$

$\frac{7.5}{19}$

$\frac{10.3}{3.2}$

$\frac{8.5}{3.7}$

$\frac{10.0}{6.0}$

$\frac{11.5}{10.0}$

$\frac{1.0}{12.3}$

$\frac{6.0}{16}$

5.9

$\frac{6.5}{14}$

$\frac{11.7}{2.7}$

$\frac{10.4}{3.5}$

$\frac{11.3}{5.3}$

$\frac{11.5}{5.0}$

$\frac{6.2}{52.0}$

$\frac{6.2}{1.5}$

6.3

$\frac{6.0}{1.5}$

$\frac{16.5}{3.5}$

$\frac{11.0}{3.3}$

$\frac{11.2}{5.0}$

3.1

55.1

1.7

56.5

5.9

58.3

5.9

60.9

Cross Sections

Sta.	B. S.	H. I. 864.20	F. S.	Grade	Gr. &
24+00				64.0	0.2
T.P.	9.20	872.42	0.98		883.72
24+50				66.5	59
25+00				69.0	34
25+50				71.5	0.9
T.P.	9.31	880.83	0.90		871.52
26+00				74.0	6.8
26+46				76.3	4.5
27+00				79.0	1.8
T.P.	11.40	890.44	1.79		879.04
27+50				81.5	89
28+00				84.0	6.4
28+50				86.5	27 39
29+00				89.0	02 08 07
T.P.	11.49	901.84	0.09		890.35 93 109
29+50				91.5	103

Inst.
Rod.
Chain.

Left

G L

Right

17

62.5

74

65.0

74

68.0

16

70.8

73

73.5

47

76.1

18

79.0

10

82.4

55

84.9

32

87.2

58

89.6

103

91.5

		Cross Sections			
St. No.	Dist.	H. I.	P. S.	Grade	Gr. No.
		901.84			7.2 7.8
30+00				94.0	7.8
30+50				96.5	4.6 6.0 5.3
31+00				99.0	2.2 3.5 2.8
T.P.	5.45	906.39	0.90		900.94 5.0 6.3
31+50				900.8	5.6
32+00				901.4	4.4 5.7 5.0
32+50				900.6	5.3 5.8
D.M.			12.21		894.18
32+17					

L
Reo.
Chain.

Left

C L

Right

70 ✓

57 -0.4

23 +0.5'

42 +1.4

44 +0.6

54 +0.4

Top of catch Basin From 0.

Inst.
Red:
Chain.

.....

Left

G L

Right

Cross

28

Sta.

B. S.

H. I.

F. S.

Grade

Gr. R.

Inst.
Rod.
Chain.

.....

Left

C L

Right

The page contains a large grid of graph paper. A vertical red line runs down the center of the grid, dividing it into two equal halves. The grid is composed of small squares, with the vertical line acting as a central axis. The labels 'Left', 'C L', and 'Right' are positioned at the top of the grid, indicating the left and right sides of the central axis.

Cross Sections

.....
Sta. B. S. H. I. F. S. Grade Gr. R.

If
Roc
Chain.

.....

Left

C L

Right

In:
Rod:
Chain:

.....

Left

C L

Right

In:
Rod.
Chain.

.....

Left

C L

Right

The page contains a large grid of graph paper. A vertical red line runs down the center of the grid, dividing it into two equal halves. The grid consists of approximately 20 columns and 30 rows of small squares. The labels 'Left', 'C L', and 'Right' are positioned at the top of the grid, corresponding to the left, center, and right sections respectively.

Inst.
Rod.
Chain.

Left

G L

Right

The page contains a large grid of graph paper. A vertical red line runs down the center of the page, dividing it into two equal halves. The left half is labeled 'Left' and the right half is labeled 'Right'. The grid consists of small squares, with the red line acting as a central axis. The labels 'Left', 'G L', and 'Right' are positioned at the top of their respective sections.

Sta.

B. S.

H. L.

F. S.

Grade

Gr. R.

In°
Rec.
Chain.

.....

Left

G L

Right

The page contains a large grid of graph paper. A vertical red line runs down the center of the page, dividing it into two equal halves. The grid consists of small squares, with the red line acting as a central axis. The labels 'Left', 'G L', and 'Right' are positioned at the top of the grid, indicating the left and right sides of the central axis.

Cross Sections

Sta.

B. S.

H. I.

F. S.

Grade

Gr. R.

In
Rod.
Chain.

.....

Left

C L

Right

Cross Sections

Sta.

B. S.

H. I.

F. S.

Grade

Gr. R.

Inst.
Rod.
Chain.

Left

C L

Right

..... Cross sections

Sta. 3381 H. I. P. S. Grade Gr. 10

In:
Rod.
Chain.

.....

Left

C L

Right

The page contains a large grid of graph paper. A vertical red line runs down the center of the page, dividing it into two equal halves. The grid is composed of small squares, with the vertical line acting as a central axis. The labels 'Left', 'C L', and 'Right' are positioned at the top of the grid, indicating the orientation of the data to be recorded.

Cross Sections

Sta. B. S. H. I. F. S. Grade Cr. H.

In.
Rod.
Chain.

Left

C. I.

Right

The page contains a large grid of graph paper. A vertical red line runs down the center of the page, dividing it into two equal halves. The grid consists of 20 columns and 30 rows. The columns are labeled 'Left' on the left side, 'C. I.' in the center (aligned with the red line), and 'Right' on the right side. The grid is intended for recording survey data, with the 'Left' and 'Right' columns likely representing measurements on either side of a central point or line.

Sta.

B. S.

H. I.

Gr. R.
G. R.

Inst.
Rod.
Chain.

THIS SURFACE IS THE SURFACE OF THE INSTRUMENT

Left

C L

Right

The page contains a large grid of graph paper. A vertical red line runs down the center of the page, dividing it into two equal halves. The grid consists of 20 columns and 30 rows of small squares. The labels 'Left', 'C L', and 'Right' are positioned at the top of the grid, corresponding to the left, center, and right sections respectively.

Farm Entrance Right Sta. 13+10

Original

Cross

Curves

Sta.	B. S.	H. I.	F. S.	Grade	Gr. R.
B.M.	11.40	911.84		900.44	
T.P.	10.39	921.67	0.56	911.28	
T.P.	9.87	930.79	0.75	920.92	
0+54				28.2	✓
0+75				27.4	✓
1+00				25.8	✓
1+50				21.6	✓
2+00				20.8	✓
+25				19.8	✓
4+50				16.3	✓
T.P.	0.83	921.75	9.87	920.92	
T.P.	1.51	711.18	12.08	909.67	
B.M.			10.74	900.44	

Inst. crane
 Rod.
 Chain.

7/16/26

Left

G L

Right

66	57	58		34	17	18
30	25	8	24	15	26	30

88	62	43		30	41	41	33	24	26
30	20	7	34	5	8	15	19	25	30

93	69			48	57	56	41	44
30	15	50		4	6	12	14	30

126	120	✓	99	94	89	82
30	17	92	2	8	11	30

133	127	113	✓	100	136	134	96	103
30	26	15	100	2	7	12	18	53


150	136	136	✓	115	153	152	113	111
30	24	18	110	6	11	17	24	50

171	163	152	✓	145	175	172	161	141	140
30	24	13	145	10	15	21	25	29	30

small. see next page.

15+11⁰⁰

0+00

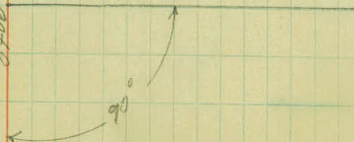

Form Entrance Rt. 13+11
Final

Sta	B. S.	H. I.	Cross F. S.	Sections Grade	Gr. R.
T.P.	10.85	908.84			
0+00 =	13+11				
0+20					
0+25					
0+30					
0+32					
0+54				28.2	+19.4
0+75				27.4	+18.6
T.P.	11.53	919.59	0.78		
1+00				25.8	+6.2
1+50				21.6	+2.0
2+00				20.8	+1.2
2+25				19.8	+0.2
2+50				16.3	+3.3
2+55					
T.P.	3.55		12.66		
B.M.			10.04		

Inst. W.H.C.
 Rod. A.L.P.
 Chain. W.A.
H.T.P.

Sept 10, 1916

37

Left

C L

Right

East

West

897.99 - Top Stake Sta. 14 (from P. 43)

Fill = 0.0

$\frac{7.0}{25}$ $\frac{4.6}{23}$ $\frac{5.0}{20}$ $\frac{4.6}{15}$ $\frac{6.4}{17}$ \times slope

Bottom Disk

$\frac{7.0}{24}$ $\frac{4.6}{22}$ $\frac{5.3}{21}$ $\frac{4.6}{14}$ $\frac{6.4}{16}$

(0.0 Fill)
(0.0 Cut.)

Slope = 70 $\frac{4.6}{18}$ $\frac{5.1}{17}$ $\frac{3.7}{7}$ $\bar{5}2 = 5/lope$

Slope = 35.1 $\frac{3.1}{17}$ $\frac{2.6}{16}$ $\frac{2.4}{4}$ $\bar{2}4 = slope.$

0.8.06 slope = 53 $\frac{12.1}{14}$ $\frac{11.8}{14}$ $\frac{11.7}{4}$ $\bar{2}4 = slope.$

slope $\times \frac{0.6}{25}$ $\frac{3.0}{17}$ $\frac{8.0}{13}$ 78 $\frac{2.9}{6}$ $\frac{2.3}{11}$ $\bar{2}2 = slope.$

slope $\times \frac{1.2}{23}$ $\frac{5.1}{17}$ $\frac{6.5}{12}$ $\frac{4.5}{7}$ $\frac{4.1}{17}$ $25 = slope.$

slope $\times \frac{1.9}{21}$ $\frac{5.0}{17}$ $\frac{6.0}{12}$ 40 $\frac{5.3}{19}$ $\frac{2.7}{26}$ \times slope

$\frac{5.2}{23}$ $\frac{3.0}{16}$ $\frac{4.7}{10}$ $\frac{5.1}{9}$ $\frac{5.1}{9}$ $\frac{5.7}{10}$ $\frac{5.7}{25} \times slope.$

(0.0 cut)

6.93

0.44 cor. Bldg. 81' N. 14+90

F. Ent Lt. Sta. 15+29.4

Original

Cross Sections

Sta.	B. S.	H. I.	F. S.	Grade	Gr. R.
B.M.	3.73	904.17		900.44	
0+30				91.2	
0+50				92.7	✓
1+00				96.6	✓
1+25				0.1	
1+50				99.0	

Inst. CRANE
 Rod.....
 Chain.....

7/16/25

Left

G L

Right

$\frac{5.5}{30}$	$\frac{3.7}{28}$	$\frac{12.2}{3}$	$\frac{12.7}{2}$	13.0	$\frac{14.4}{9}$	$\frac{15.8}{11}$	$\frac{22.0}{30}$
------------------	------------------	------------------	------------------	------	------------------	-------------------	-------------------


$\frac{5.0}{30}$	$\frac{4.2}{28}$	$\frac{4.5}{21}$	11.5	$\frac{12.1}{1}$	$\frac{13.4}{11}$	$\frac{15.0}{13}$	$\frac{20.9}{30}$
------------------	------------------	------------------	------	------------------	-------------------	-------------------	-------------------

$\frac{0.0}{30}$	$\frac{0.8}{25}$	$\frac{3.2}{10}$	$\frac{7.5}{4}$	7.6	$\frac{7.3}{8}$	$\frac{10.0}{9}$	$\frac{11.8}{18}$	$\frac{13.3}{20}$	$\frac{17.1}{30}$
------------------	------------------	------------------	-----------------	-----	-----------------	------------------	-------------------	-------------------	-------------------

$\frac{1.0}{20}$	4.1	$\frac{9.9}{7}$	$\frac{11.4}{21}$	$\frac{12.5}{23}$	$\frac{15.1}{30}$
------------------	-----	-----------------	-------------------	-------------------	-------------------

$\frac{1.7}{18}$	5.2	$\frac{7.8}{7}$	$\frac{13.6}{17}$	$\frac{12.4}{17}$	$\frac{14.0}{30}$
------------------	-----	-----------------	-------------------	-------------------	-------------------

Final Y-sec
 Page 50

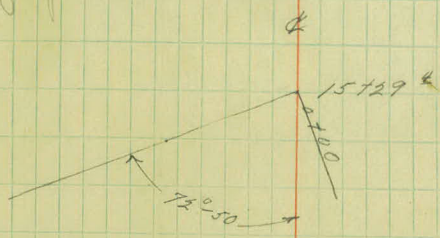

Final

Cross Sections

Sta.	B. S.	H. I.	F. S.	Grade	Gr. R.
B.M.	4.88	923.81 ✓			
0+00					04.9
+10					4.9
+18					4.9
+33					4.9
+50					4.8
1+00					4.8
+50					4.7
2					4.7
+50					4.6
3					4.6
+50					4.5

Final

Cross

Cross

Sta.	B. S.	H. I.	F. S.	Grade	Gr. R.
4		923.81 ✓			4.5
+50					4.4
✓					4.4
+50					4.3
6					4.3
T.P.	8.61	927.78 ✓	4.64		
+50					8.2
7					8.2
+50					8.1
8					8.1
+50					8.1
9					8.6
+50					9.2

Inst.
 Rod.
 Chain.

Sept 10, 1916

Left

C L

Right

3.0 3.3	3.1 x 28	6.4 24	6.5 21	6.2 17	4.7 14	4.5	4.7 14	5.7 15	6.3 21	6.2 24	3.8 27	3.6 33	
4.1 33	x 27 29	4.7 27	6.7 24	6.7 21	6.0 16	4.5	4.4 14	5.0 16	6.1 22	3.4 27	3.7 33		
2.4 3.2	2.4 29	6.3 23	6.3 20	5.9 17	4.5 15	4.6	4.6 14	5.6 16	6.4 20	6.3 23	3.2 27	3.4 33	
3.7 33	3.7 28	6.2 24	6.0 20	5.4 16	4.2 14	4.2	4.3 14	5.5 16	6.1 21	6.0 24	4.0 27	4.0 33	
3.2 33	3.2 29	6.3 24	6.1 21	5.6 17	3.8 14	3.8	4.1 14	5.2 17	6.2 25	2.9 30	2.9 33		
9.19.17 ✓ Top west end c.m. calc. H. Sta. 6+21													
5.6 33	5.6 31	7.7 27	10.0 24	10.0 21	8.5 18	8.0 15	7.6 14	7.9 21	9.3 25	8.0 27	7.6 29	6.4 30	6.4 33
x	4.8 33	2.5 28	7.6 25	7.2 20	7.7 15	7.7	7.8 15	8.9 17	9.3 22	2.6 26	5.6 30	5.6 33	
x	3.1 35	6.9 30	9.3 26	9.3 22	8.8 17	7.7 15	7.4 17	7.6 19	7.1 22	9.3 26	3.4 33	3.4 33	
x	2.7 35		9.1 26	9.1 21	8.3 16	7.6 15	7.5	7.7 16	8.5 18	9.1 22	9.3 26	5.6 30	2.8 35
x	3.2 34		9.4 25	9.4 20	8.8 16	7.9 14	8.0	8.3 14	9.0 17	10.0 21	10.0 24	4.0 32	4.0 33
x	3.2 34	3.3 29	10.3 23	10.2 19	9.5 15	8.7 14	8.5	8.9 14	9.3 17	10.7 22	9.8 33	4.2 30	4.2 33
x	2.0 37	5.0 33	11.3 23	11.3 20	10.5 16	9.3 14	9.4	9.7 14	11.1 16	11.6 18	11.6 21	7.7 27	3.5 33

Final

Cross Sections

Sta.	B.S.	H. I.	I.S.	Grade	Gr. E.
		927.78			
10+00					10.7
+50					11.4
11+00					12.9
11+50					14.6
T.B.M.	8.98	934.73		2.03	
12+00					23.7
+40					25.6
+81					27.7
13					28.7
11					
+43					31.2
T.P.	1.14	923.77		12.10	
+80					22.7
T.P.	1.21	913.37		11.61	
14					13.6
125					15.3

Inst.
 Rod.
 Chain.

Left

C L

Right

x $\frac{16}{40}$ $\frac{52}{52}$ $\frac{123}{21}$ $\frac{122}{19}$ $\frac{117}{16}$ $\frac{106}{15}$ $\frac{109}{14}$ $\frac{120}{17}$ $\frac{123}{20}$ $\frac{83}{27}$ $\frac{50}{33}$ $\frac{39}{37}$ x

x $\frac{18}{41}$ $\frac{61}{33}$ $\frac{136}{23}$ $\frac{136}{20}$ $\frac{134}{17}$ $\frac{120}{15}$ $\frac{119}{14}$ $\frac{121}{15}$ $\frac{135}{18}$ $\frac{135}{21}$ $\frac{40}{37}$ $\frac{29}{41}$ x

$\frac{43}{40}$ $\frac{78}{39}$ $\frac{151}{22}$ $\frac{130}{18}$ $\frac{140}{15}$ $\frac{137}{16}$ $\frac{167}{20}$ $\frac{167}{22}$ $\frac{30}{21}$ $\frac{17}{25}$ x

$\frac{52}{41}$ $\frac{93}{34}$ cont'd sections $\frac{44}{42}$ $\frac{24}{47}$ x

925.75 ✓ Nail in T.P. RT. 11+80

x $\frac{81}{49}$ cont'd $\frac{122}{45}$ x

x $\frac{69}{50}$ cont'd $\frac{126}{47}$ $\frac{101}{101}$ x

v $\frac{56}{50}$ cont'd Driveway use slope @ 54'

x $\frac{16}{52}$ $\frac{8.6}{47}$ cont'd use slope @ 54'

$\frac{113}{52}$ cont'd use slope @ 54'

922.13 ✓ Top Stake RT. 13+25

x $\frac{88}{47}$ cont'd $\frac{126}{44}$ $\frac{100}{50}$ x

912.16 ✓

$\frac{3.8}{50}$ x $\frac{39}{43}$ cont'd $\frac{45}{42}$ x $\frac{31}{47}$

$\frac{50}{50}$ x x $\frac{53}{43}$ cont'd $\frac{9.9}{40}$ $\frac{8.8}{44}$ x

Inst. _____
 Rod. _____
 Chain. _____

Sept. 10 1926 42

Left Right

$\frac{68}{56} \times \frac{70}{41}$ cont'd $\frac{108}{39} \frac{75}{43} \times \frac{106}{60}$

900.44 N.E. cor. Blackhouse Top Foundation 87' Rt. 14190

$\frac{69}{30} \frac{140}{28} \frac{136}{17} \frac{135}{15}$ $\frac{137}{17} \frac{106}{17} \frac{136}{20} \frac{140}{22} \frac{140}{27} \frac{63}{36} \frac{52}{39} \times \frac{63}{60}$

891.69 ✓ Top Guard Rail Post -

(Washout Left 56. 14150)

st	E	W	cut	Area	Cu. Yds
0+00			0.0		
0+20				0.0	= 3
0+30		$\frac{140}{8}$	$\frac{+45}{3}$	24.0	= 13
0+40	$\frac{0.0}{7}$	$\frac{+70}{3}$	$\frac{+70}{3}$	49.0	= 4
0+45		$\frac{0.0}{1}$	$\frac{0.0}{1}$	0.0	
				Cu Yds =	20

919.17 Top West end of Culvert Rt. 6121

$\frac{126}{53} \frac{130}{19} \frac{125}{16} \frac{107}{13} \frac{101}{16} \frac{109}{16} \frac{123}{19} \frac{123}{23}$

909.78

$\frac{39}{33} \frac{38}{18} \frac{10}{14} \frac{07}{15} \frac{09}{15} \frac{25}{19} \frac{2.8}{21} \frac{28}{25}$

$\frac{53}{13} \frac{58}{20} \frac{56}{16} \frac{30}{12} \frac{30}{17} \frac{44}{19} \frac{48}{23} \frac{48}{26} \frac{2.8}{31}$

$\frac{73}{18} \frac{73}{15} \frac{55}{12} \frac{34}{18} \frac{51}{18} \frac{67}{23} \frac{7.1}{27} \frac{6.8}{32}$

Final

Sta.	B. S.	H. I.	F. S.	Cross Sections Grade	Gr. R.
		910.03 ✓			
13+00					4.0
+43					6.5
T.P.	1.55	899.54 ✓	12.04		+0.6
+80					
14					+0.3
+25					1.4
+50					3.1
T.P.	0.01	891.70 ✓	7.25		
15+00-	supra page				
15+32					
15+50					
16+00					
16+25					

Inst.
 Rod.
 Chain.

Sept 10, 1926

43

Left

C L

Right

$\frac{86}{16}$	$\frac{85}{14}$	$\frac{66}{11}$	64	$\frac{19}{20}$	$\frac{73}{24}$	$\frac{73}{32}$
-----------------	-----------------	-----------------	----	-----------------	-----------------	-----------------

$\frac{113}{19}$	$\frac{113}{14}$	$\frac{94}{7}$	88	$\frac{85}{20}$	$\frac{104}{24}$	$\frac{108}{27}$	$\frac{107}{32}$
------------------	------------------	----------------	----	-----------------	------------------	------------------	------------------

897.99 700 5/16 c At Sta 14+00

$\frac{31}{21}$	$\frac{30}{14}$	$\frac{12}{11}$	$\frac{10}{1}$	$\frac{09}{17}$	$\frac{25}{21}$	$\frac{25}{24}$	$\frac{22}{27}$
-----------------	-----------------	-----------------	----------------	-----------------	-----------------	-----------------	-----------------

$\frac{43}{22}$	$\frac{42}{18}$	$\frac{40}{14}$	$\frac{22}{11}$	20	$\frac{22}{17}$	$\frac{38}{20}$	$\frac{39}{26}$
-----------------	-----------------	-----------------	-----------------	----	-----------------	-----------------	-----------------

$\frac{55}{23}$	$\frac{57}{19}$	$\frac{54}{15}$	$\frac{35}{12}$	$\frac{36}{1}$	$\frac{39}{18}$	$\frac{56}{20}$	$\frac{56}{24}$
-----------------	-----------------	-----------------	-----------------	----------------	-----------------	-----------------	-----------------

$\frac{72}{27}$	$\frac{70}{15}$	$\frac{51}{13}$	$\frac{51}{1}$	$\frac{52}{17}$	$\frac{21}{21}$	$\frac{24}{25}$
-----------------	-----------------	-----------------	----------------	-----------------	-----------------	-----------------

894.69 ✓

Top Guard Rail Post.

$\frac{50}{20}$	$\frac{30}{17}$	33	$\frac{1.4}{19}$	$\frac{3.2}{19}$	$\frac{5.4}{22}$
-----------------	-----------------	----	------------------	------------------	------------------

$\frac{80}{42}$	x $\frac{89}{26}$	$\frac{46}{18}$	48	$\frac{49}{19}$	$\frac{72}{25}$	$\frac{28}{26}$	x
-----------------	-------------------	-----------------	----	-----------------	-----------------	-----------------	---

x $\frac{234}{39}$	$\frac{82}{17}$	94	$\frac{6.7}{13}$	$\frac{9.1}{13}$	$\frac{96}{195}$	$\frac{221}{37}$	x
--------------------	-----------------	----	------------------	------------------	------------------	------------------	---

$\frac{302}{47}$	$\frac{110}{17}$	113	$\frac{8.6}{14}$	$\frac{11.4}{14}$	$\frac{11.3}{20}$	$\frac{30.0}{46}$
------------------	------------------	-----	------------------	-------------------	-------------------	-------------------

Final Cross Sections

Sta.	B. S.	H. I.	F. S.	Grade	Gr. R.
		891.70	✓		
16+50					
T.P.	0.78	879.46	✓	13.02	
16+65					
17+00					
17+50					
18+00					
T.P.	0.82	867.44	✓	12.84	
18+50					
19+00					
19+50					
20+00					
T.P.	2.73	859.02	✓	11.15	
20+50					
21					
31+50					

Inst.
 Rod.
 Chain.

Sept 14, 1926

Left

C L

Right

~~31.6~~
~~55~~

~~47.6~~
~~58~~

12.7
 17

13.2
 10.6

13.3
 22

36.2
 55

37.7
 62

878.68

27.4
 75

26.0
 54

4.9
 17

2.0
 40.5

2.3
 21.5

26.1
 57

28.4
 70

27.8
 62

27.8
 48

5.0
 16.5

4.8
 2.3

5.5
 22

28.0
 50

29.3
 60

31.2
 65

4.0
 45

7.8
 16

9.0
 6.2

10.2
 21

28.8
 56

30.5
 75

31.0
 56

30.1
 45

12.9
 16

12.7
 10.1

13.3
 79

27.5
 40

30.5
 75

866.62

12.4
 50

12.4
 37

4.0
 15

4.0
 1.9

4.3
 18

14.7
 33

19.0
 50

19.0
 60

17.5
 50

18.7
 37

11.0
 30

6.7
 15

6.6
 6.5

7.0
 12

7.8
 18

18.4
 33

18.4
 51

18.6
 60

16.4
 50

16.4
 41

21.4
 30

21.4
 30

8.0
 14.5

9.0
 9.6

10.1
 17

22.0
 30

22.0
 34

14.4
 42

14.6
 60

16.7
 50

16.1
 35

18.2
 29

18.2
 75

10.9
 15

11.2
 12.4

11.4
 16

27.0
 28

21.0
 30

16.0
 40

16.0
 60

856.29

top stake 20 to 3 RT.

11.0
 25

11.0
 31

9.2
 38

8.2
 42

10.7
 34

12.4
 30

12.4
 26

3.2
 15

4.1
 5.8

4.6
 16

4.1
 33

12.2
 24

4.2
 15

4.5
 6.5

4.9
 15

11.5
 23

11.7
 31

4.4
 33

11.7
 33

10.6
 22

4.3
 15

5.1
 6.2

4.6
 15

12.0
 24

11.0
 31

11.5
 33

Final

Cross Sections

Sta.	B. S.	H. I.	F. S.	Grade	Gr. R.
22+00		859.02 ✓			
22+50					
B.M.	12.20	863.66 ✓	7.56		
23+00					
23+50					
23+62					
24+00					
T.P.	10.88	872.51 ✓	2.03		
24+50					
25					
T.P.	11.12	882.75 ✓	0.88		
+50					
26					
+20					
26+46					

Inst.
 Rod.
 Chain.

Sept 14, 1926 45

Left C L Right

$\frac{19.0}{33}$ $\frac{10.0}{23}$ $\frac{34}{15}$ $\frac{30}{4.8}$ $\frac{37}{15.5}$ $\frac{19.5}{26}$ $\frac{19.5}{32}$

$\frac{9.0}{33}$ $\frac{8.2}{24}$ $\frac{1.8}{15.5}$ $\frac{18}{2.5}$ $\frac{1.6}{15}$ $\frac{2.4}{26}$ $\frac{4.8}{33}$

851.46 - R.P. T.P. 4 Sta. 22 + 45

$\times \frac{12.7}{27}$ $\frac{4.7}{16}$ $\frac{44}{4.7}$ $\frac{4.7}{15}$ $\frac{11.7}{25}$ $\frac{12.6}{29}$ $\frac{12.6}{33}$

$\frac{14.1}{37}$ $\frac{12.5}{30}$ $\frac{2.5}{16}$ $\frac{2.4}{2.2}$ $\frac{2.6}{15}$ $\frac{2.4}{23}$ $\frac{10.8}{28}$ $\frac{10.8}{33}$

$\frac{14.2}{40}$ $\frac{12.2}{31}$ $\frac{2.3}{16}$ $\frac{1.7}{1.6}$ $\frac{2.0}{14}$ $\frac{4.2}{24}$ $\frac{10.0}{27}$ $\frac{10.1}{33}$

$\frac{12.9}{43}$ $\frac{12}{34}$ $\frac{0.4}{17}$ $\frac{0.3}{1.0}$ $\frac{0.0}{15}$ $\frac{6.6}{24}$ $\frac{3.4}{33}$

861.63

$\frac{17.5}{36}$ $\frac{7.2}{19}$ $\frac{6.3}{6.0}$ $\frac{6.5}{15}$ $\frac{7.4}{18}$ $\frac{10.0}{23}$ $\frac{7.2}{26}$ $\frac{6.5}{31}$ $\frac{4.5}{33}$

$\frac{12.6}{33}$ $\frac{12.4}{30}$ $\frac{3.6}{18}$ $\frac{3.3}{3.5}$ $\frac{3.5}{15}$ $\frac{5.1}{18}$ $\frac{6.0}{24}$ $\frac{2.8}{27}$ $\frac{1.2}{33}$

871.63 top sta. 10 Lt. 25 + 50

$\frac{7.4}{33}$ $\frac{14.7}{28}$ $\frac{1.3}{17}$ $\frac{1.0}{11.3}$ $\frac{11.4}{14}$ $\frac{12.8}{18}$ $\frac{13.0}{24}$ $\frac{9.8}{29}$ $\frac{7.5}{33}$

$\frac{16.6}{33}$ $\frac{14.7}{24}$ $\frac{8.7}{16}$ $\frac{8.4}{4.8}$ $\frac{8.5}{15}$ $\frac{10.2}{18}$ $\frac{10.2}{26}$ $\frac{8.8}{29}$ $\frac{3.1}{35}$ $\frac{2.5}{37}$

$\frac{14.6}{33}$ $\frac{11.8}{22}$ $\frac{7.7}{16}$ $\frac{7.4}{7.8}$ $\frac{7.6}{16}$ $\frac{9.2}{19}$ $\frac{7.2}{26}$ $\frac{7.5}{35}$ $\frac{4.7}{41}$ $\frac{0.2}{43}$

$\frac{12.5}{33}$ $\frac{9.0}{19}$ $\frac{6.3}{16}$ $\frac{5.7}{6.5}$ $\frac{5.9}{16}$ $\frac{8.0}{20}$ $\frac{8.1}{21}$ $\frac{1.4}{37}$

continue
 871.63

Final

Cross sections

Sta. B. S. H. I. F. S. Grade Gr. R.

882.75 ✓

27+00

27+50

T.B.M.

11.58

893.89 ✓

0.44

28+00

+50

29

+50

T.P.

10.75

903.03 ✓

1.11

30+00

Inst.
 Rod.
 Chain.

Sept 14, 1926

Left

C L

Right

2.0 4.4 4.5 3.5 3.2 3.0 5.6 5.1 0.3
 33 24 19 16 145 145 14 27 35 - cont'd

4.8 2.2 2.0 0.9 0.6 0.6 2.5 2.8
 33 24 19 17 15 17 25 - cont'd

882.31 ✓ top stake Lt. sta 27450

wash out Rt. 27480

14.0 12.2 10.7 8.5 8.7 9.0 11.1 11.5
 33 23 18 14.5 10.0 74 19 27 - cont'd

12.6 10.2 7.0 4.9 4.6 8.4 9.1
 33 22 15 16 16 14 27 - cont'd

10.3 6.2 4.5 4.0 5.1 6.4 6.8 2.2
 33 18 15 16 16 14.5 16 35 - cont'd

8.3 4.1 1.6 2.0 2.6 4.3 4.0
 33 18 15 16 16 21 29 - cont'd

5.4 2.9 8.4 3.9 9.6 10.6 6.8
 33 22 15 16 18 29 37 - cont'd

See p. 48 for continued list

3.8

1.3

10.0

7.5

5.0

2.5

9.0

(15.0 cont'd)

4.78 ✓

Final

Cross Sections

Sta. B.S. H.L. F.S. Grade Gr. R.

903.03

20+50

31

T.P.

4.38

906.51

0.90

+50

32

+75

+50

+70

+83

33+00

+31.5

T.P.

0.78

896.43

10.86

+60

34+00

34+50

B.M.

2.29

Lt.

Rt.

Sept 15, 1926

$\frac{13.8}{33}$ $\frac{11.8}{23}$ $\frac{8.9}{15}$ 42 $\frac{6.9}{16}$ $\frac{2.7}{25}$ $\frac{6.3}{41}$ - contd

Reef age
(48)

$\frac{1.0}{33}$ $\frac{8.7}{24}$ $\frac{3.2}{15}$ 33 $\frac{4.3}{15}$ $\frac{4.7}{17}$ $\frac{5.4}{23}$ $\frac{3.9}{25}$ $\frac{3.0}{42}$ $\frac{1.6}{61}$ contd

102.13 ✓

$\frac{10.5}{33}$ $\frac{8.7}{26}$ $\frac{7.0}{18}$ $\frac{4.8}{14}$ 54 $\frac{6.3}{16}$ $\frac{6.8}{18}$ $\frac{6.7}{24}$ $\frac{5.2}{27}$ $\frac{4.1}{35}$ $\frac{3.2}{57}$ $\frac{1.4}{62}$ $\frac{1.0}{100}$ - contd

$\frac{10.3}{33}$ $\frac{7.1}{28}$ $\frac{7.1}{19}$ $\frac{4.4}{14}$ 45 $\frac{4.2}{22}$ $\frac{5.4}{9}$ $\frac{3.9}{32}$ $\frac{2.3}{48}$ 6.9 (top curb.)

$\frac{10.4}{33}$ $\frac{8.0}{20}$ $\frac{4.7}{14}$ 47 $\frac{4.7}{23}$ $\frac{5.0}{26}$ $\frac{4.8}{32}$ $\frac{1.9}{37}$ $\frac{1.2}{42}$ - top curb

$\frac{11.0}{33}$ $\frac{7.6}{27}$ $\frac{8.0}{19}$ $\frac{5.4}{14}$ 55 $\frac{4.7}{25}$ = Pave

$\frac{11.0}{33}$ $\frac{7.0}{16}$ $\frac{6.1}{14}$ 62 $\frac{5.8}{15}$ = Pave

$\frac{11.0}{33}$ $\frac{9.9}{24}$ $\frac{7.6}{19}$ $\frac{6.9}{15}$ 68 $\frac{4.6}{10.5}$ = Pave.

$\frac{10.9}{33}$ $\frac{10.4}{29}$ $\frac{7.6}{17}$ $\frac{2.6}{15}$ 74 $\frac{7.4}{5.2}$ = Pave

$\frac{10.1}{33}$ $\frac{9.7}{17}$ $\frac{7.2}{12}$ 81 $\frac{9.7}{PAVE}$ (9.7)

995.65 ✓

$\frac{8.1}{31}$ x $\frac{6.5}{24}$ $\frac{6.4}{16}$ $\frac{0.4}{12}$ $\frac{1.0}{30}$ $\frac{0.78}{PAVE}$ (1.2)

x $\frac{4.8}{23}$ $\frac{2.6}{16}$ $\frac{3.2}{1}$ $\frac{2.4}{PAVE}$ $x 3.4$

0.0 Fill

94.14 - Top N.E. cor. C.B. Rt. 33194

Final X- Sec.

Sta.	+	H.I	-	Elev.
T.B.M. 26+46	11.39	893.70 ✓		
27				
+50	17.30	904.62 ✓	1.38	
28				
+50				
29				
T.P. +50	10.81	913.51 ✓	1.92	
30				
+50				
31				
T.P.	6.11	913.97 ✓	5.65	
31+50				
T.P.	5.13	904.25 ✓	12.85	
B.M.			10.11	

H. Z Rt.

Sept 15, 1926

882.31

top stake lt. Sta. 77+50

16.4

$$\frac{75}{29} \times \frac{77}{50}$$

14.7

$$\frac{45}{44} \times \frac{39}{50}$$

897.32 ✓

23.1

$$\frac{94}{55} \times$$

20.6

$$\frac{52}{52} \times$$

continued X-sec find 5.

$$\frac{37}{50} \times$$

18.1

15.6

$$\frac{33}{47} \times \frac{24}{50}$$

907.70 ✓

21.0

$$\frac{112}{46} \times \frac{104}{50}$$

19.5

$$\frac{94}{46} \times \frac{82}{50}$$

17.0

$$\frac{51}{59} \times$$

14.5

$$\frac{14}{82} \times$$

907.86 ✓


13.2

$$\frac{156}{117} \quad \frac{32}{145} \times \quad \frac{20}{157}$$


901.12 ✓

896.14 ✓

C.B.

 

Misc. Finals.

 A sheet of graph paper with a grid of small squares. A vertical red line runs down the center of the page, dividing the grid into two equal halves. The grid extends from the top margin to the bottom margin and across most of the page width.

Final X-Sec. Farm Ent Lt. Sta 15+29.4

B.M.	2.73	903.17	900.44
------	------	--------	--------

0+33

0+50

92.7

1+00

96.6

1+25

00.1

1+40

Sept 14, 1975 50

W.H.C.

Lt.

±

Rt.

A.L.P.

original X-sec. p. 38

H.T.P.

W.A.

Fill over curb 2' X 6' X 75' = cu yds

(O.O. cut & Fill)

$\frac{4.4}{78}$	$\frac{10.3}{13}$	$\frac{10.7}{10.5}$	$\frac{11.1}{70}$	$\frac{16.9}{16}$
------------------	-------------------	---------------------	-------------------	-------------------

$\frac{1.6}{15}$	$\frac{6.9}{10}$	$\frac{7.0}{6.6}$	$\frac{7.1}{70}$	$\frac{11.8}{78.5}$
------------------	------------------	-------------------	------------------	---------------------

$\frac{1.6}{12}$	$\frac{4.9}{9}$	$\frac{11.0}{3.1}$	$\frac{5.3}{5}$	$\frac{7.2}{9}$	$\frac{8.3}{17}$	$\frac{11.0}{22}$
------------------	-----------------	--------------------	-----------------	-----------------	------------------	-------------------

(O.O. cut & Fill)

Final - Farm Entrance Rt. Sta 15+25

	Area	Exc. cu yds	Fill cu yds
0+73	0.0	5	
0+55	16.0	16	
0+35	26.5	3	
0+30	0.0	24	3
0+27	64.0		12
0+22	64.0		2
0+20	0.0		
0+00 = 15+25			17

Sept 14, 1926

0.0 Cut

$$\frac{0.0}{6} \quad \frac{+1.0}{0} \quad \frac{+2.0}{8} \quad \frac{0.0}{9.0}$$

$$\frac{0.0}{10} \quad \frac{+2.0}{0} \quad \frac{+3.0}{8} \quad \frac{0.0}{10}$$

0.0 Fill - 0.0 Cut

$$\frac{0.0}{23} \quad \frac{-2.0}{10} \quad \frac{-2.0}{0} \quad \frac{-2.0}{10} \quad \frac{0.0}{12}$$

$$\frac{0.0}{12} \quad \frac{-2.0}{10} \quad \frac{-2.0}{6} \quad \frac{-2.0}{10} \quad \frac{0.0}{12}$$

0.0 Fill

90°



S+D

Final

Farm Ent. Lt. Sta. 23+04

	Area	Emb. cu. Yds.
0+67	0.0	39
0+95	97.0	77
0+27	133.0	27
0+16	0.0	

0+00 = 23+04

143

Sept 14 - 1926



(0.0 Fill)

$$\frac{0.0}{15}$$

$$\frac{4.0}{9}$$

$$\frac{-4.3}{8}$$

$$\frac{0.0}{15}$$

$$\frac{0.0}{16}$$

$$\frac{-5.7}{8}$$

$$\frac{-4.7}{10}$$

$$\frac{0.0}{17}$$

(0.0 Fill)

 Total

Final
Farm Ent Rt. Sta 23 + 25

	Area	Emb. Cu Yds
0+96	0.0	79
0+61	122.0	199
0+28	193.	46
0+15	0.0	

0+00 - 23+25

324

Sept 14 1926

0.0 Fall

 $\frac{0.0}{13}$ $\frac{-4.7}{7}$ $\frac{-6.1}{9}$ $\frac{-0.0}{16}$ $\frac{0.0}{17}$ $\frac{-6.2}{10}$ $\frac{-7.6}{10}$ $\frac{0.0}{19}$

(0.0 Fall)

23/25

N

Miscellaneous Finals.

station

1+70

18" X 40' P.3 ✓

2+50

18" X 8' - P.5 (Not in place)

X 4+62

F. ENT Rt.

15" X 24' C.M. ✓

X 5+67

F. ENT Lt.

15" X 24' C.M. ✓

X 6+36

F. ENT Rt.

15" X 24' C.M. ✓

X 13+11

F. ENT Rt.

15" X 40' C.M. ✓

X 15+25

F. ENT Rt.

15" X 24' C.M. ³² ✓

X 15+29

F. ENT Lt.

15" X 24' C.M. ✓

near 30+00

30" X 60' P.9

(Not in place.)

X 23+04

F. ENT Lt.

None

23+25

F. ENT Rt.

30" X 32' C.M.

Sept 15, 1926

W.H.C.

A.L.P.

W.A.P.

H.T.P.

Width Length Depth

20' X 8' X 1.5 = 9 cu. Yds Emb.

20' X 10' X 2 = 7 " " "

20' X 10' X 2 = 7 " " " (16' X 20' X 1 = 12 Cu. Yds Exc.)

(See p. 37 for Cut & Fill Notes) ✓

(See p. 51 for Cut & Fill Notes)

See p. 50 for Cut & Fill (Notes)

See p. 52 for Fill Notes.

see p. 53 for Fill Notes

Final

Lineal Feet Gaurd Rail

Sta	to	Sta,	Lt. +	Rt.	anchors
15+36		22+87		773	3
15+31		23+05	765		3
23+47		24+53		106.	2
23+21		33+10	996		

1761
879
1761
2640

PLUS 10 LIN. FT. FOR STUB POSTS *1000*

W.H.C.

Sept 15, 1926

A.L.P.

W.A.


H.T.P.

(Includes wing) 1- Post (decay) @ anchor Block.

1- ✓ ✓

1- ✓ ✓

1- ✓ ✓

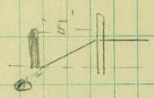

5

Proposed Drainage Ditches

On Right Sta 15+32 to 23+10


On Left .. 19+66 to 21+00

Old Ditch Left & Right.

Levels and X-section following pages.

W.H.C.
 A.L.P.
 R.A.S.
 W.G.A.

Oct 1, 1926 56

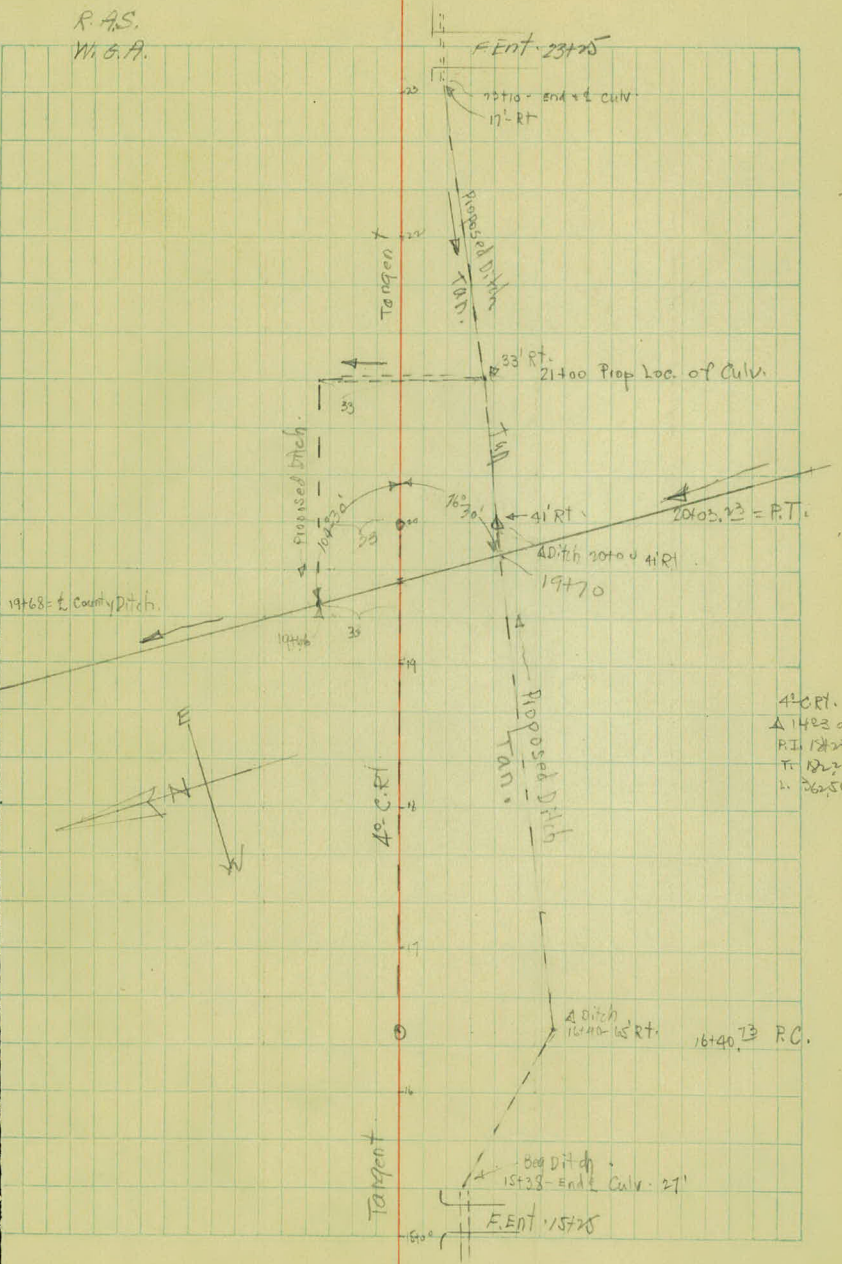

Levels & X-Sections

	Prop Ditch	on Rt.	Sta	15+38 - 23+10	
B.M.	+0.02	^{H.I.} 900.46 ✓	-	^{Elev.} 900.44	
T.P.	0.99	888.90 ✓	12.55	887.91 ✓	
15+38					86.6
15+50					83.5
T.P.	3.77	879.41 ✓	13.26	875.64 ✓	
16					70.9
T.P.	1.65	869.62 ✓	11.44	867.97 ✓	
16+40					56.3
T.P.	3.37	860.19 ✓	12.80	856.82 ✓	
17+00					50.2
17+50					49.1
18+00					48.2
18+50					49.5
19+00					49.8
19+50					52.0
20+00					51.2

← Base line of Ditch
see p. 56

Lt.

Rt.

Rt.

N.E. cor Blk House

top road foundations
floor line

87' Rt. 14+90

$\frac{0.7}{4}$ $\frac{7.3}{1}$ $\frac{4.8}{1}$ $\frac{2.3}{1}$ $\frac{4.7}{3}$ $\frac{0.7}{5}$

Beginning of Ditch
Outlet of C.M. Culvert.

$\frac{5.3}{6}$ $.54$ $\frac{5.0}{10}$

$\frac{8.7}{14}$ $.85$ $\frac{7.1}{10}$

$\frac{13.2}{14}$ $\frac{13.3}{10}$ $\frac{12.6}{10}$

π

Nail in T.P. Rt. Sta. 16+50

$\frac{9.2}{10}$ 1.00 $\frac{10.8}{10}$ $\frac{11.2}{50}$

$\frac{10.0}{10}$ 1.11 $\frac{11.6}{10}$ $\frac{12.3}{50}$

$\frac{10.8}{21}$ 1.20 $\frac{12.2}{10}$ $\frac{12.8}{50}$

$\frac{12.0}{13}$ $\frac{12.0}{5}$ 1.07 $\frac{10.4}{5}$ $\frac{12.0}{12}$ $\frac{13.1}{50}$

$\frac{12.0}{23}$ $\frac{12.3}{13}$ $\frac{11.0}{9}$ 1.04 $\frac{10.5}{5}$ $\frac{11.6}{12}$ $\frac{12.0}{50}$

$\frac{11.0}{22}$ $\frac{11}{10}$ $\frac{8.1}{8}$ $.82$ $\frac{8.2}{3}$ $\frac{9.7}{9}$ $\frac{11.4}{20}$ $\frac{12.4}{50}$

$\frac{13.2}{14}$ $\frac{13.1}{8}$ $\frac{10.5}{6}$ $.90$ $\frac{11.0}{21}$ $\frac{12.6}{50}$

Toe of s/bpc New Road

Sta	+	H.I	-	Elev.
		86.19 ✓		
20+00				49.6
21+00	Prop. Culv.			47.6
21+50				47.5
22+00				48.4
22+50				49.1
23+00				51.2
23+10				50.4
B.M.			8.73	851.96 ✓

	Lt	C	Rt
Top of Slope New Road	$\frac{120}{12}$	$\frac{123}{4}$	$\frac{126}{1}$
	$\frac{127}{12}$	$\frac{126}{1}$	$\frac{130}{15}$
	$\frac{129}{9}$	$\frac{127}{1}$	$\frac{128}{10}$
	$\frac{119}{6}$	$\frac{118}{1}$	$\frac{120}{50}$
	$\frac{100}{6}$	$\frac{111}{1}$	$\frac{110}{10}$
	$\frac{88}{6}$	$\frac{90}{1}$	$\frac{92}{10}$

98

Outlet of 30" C.M. Culvert

R.R. spike in T.P. ~~At~~ Sta. 22+45

Levels & X-Sections

Prop Ditch on Lt. Sta 19+66 to 21+00

860.19 ✓

19+66	48.4
20+00	50.0
20+50	47.5
21+00	47.4

X-sec. of Fill @ Prop Culv Sta 21+00

860.19 ✓

21+00 54.6

S.M.

8.73

851.46 ✓

Levels and X-Sections of
County Ditch North & South of #
86019

1750	44.8
1400	44.8
0760	46.5
0748	51.1
0733	48.4
0114	57.5
6100 = 19468	
0714	56.4
0727	47.7
0735	47.7
0745	51.5
0755	51.2
0765	49.0
1400	46.3
1750	45.9
2700	46.0
2750	
B.M.	8.73 251.46

W.H.C.

W N E

Oct. 1, 1926

A.L.P.

Base Line of Ditch (See p. 56)

W.P.

R.A.S.

$\frac{154}{2}$ 154 $\frac{154}{2}$

$\frac{12.8}{6}$ $\frac{15.4}{15}$ $\frac{15.4}{15}$ $\frac{15.4}{15}$ $\frac{12.8}{4}$ — Grv. Grade

$\frac{11.7}{1}$ $\frac{13.7}{1}$ 13.7 $\frac{13.7}{1}$ $\frac{13.7}{4}$

$\frac{7.0}{4}$ 9.1 $\frac{9.1}{4}$

118

0+14 → 29

29

6° 30'

14+68

0+14 → 29

29

76° 30'

E of L'Esperance Ave

125

125

$\frac{9.5}{10}$ 81 $\frac{8.7}{10}$

$\frac{9.0}{10}$ 9.0 $\frac{7.0}{10}$

$\frac{11.2}{2}$ $\frac{11.2}{1}$ 11.2 $\frac{11.2}{1}$ $\frac{10.2}{2}$

$\frac{12.6}{2}$ $\frac{13.0}{1}$ 13.7 $\frac{13.9}{1}$ $\frac{12.6}{2}$

$\frac{13.0}{2}$ $\frac{14.0}{1}$ 14.6 $\frac{14.3}{1}$ $\frac{13.2}{2}$

$\frac{13.1}{2}$ $\frac{14.2}{1}$ 14.2 $\frac{14.2}{1}$ $\frac{13.2}{2}$

Grv. Grade

N E

11.7

11.7

11.7

B.M.	0.09	900.53		900.44	G.P.
T.P.	0.70	889.49	11.74	888.79	
15+3.8				86.6	2.9
15+50				83.2	6.3
T.P.	1.01	878.53	11.77	877.52	
16+00				1690	9.5
T.P.	0.23	866.87	11.89	866.64	
16+40				55.2	11.7
T.B.M.	2.08	858.89	10.06	856.81	856.82
17+00				48.2	10.7
17+50				42.2	11.7
18+00				46.2	12.7
+50				46.1	12.8
19+00				45.9	13.0
+50				45.7	13.2
20+00				45.5	13.4

24

Solo

$$\frac{54}{9} \quad 2.4 \frac{59}{20.4} \quad \frac{61}{0.2} \quad \frac{53}{110} / \frac{30}{10} \quad \frac{52}{10}$$

$$\frac{83}{10} \quad 3.5 \frac{80}{11.5} \quad \frac{77}{118} \quad \frac{70}{2.5} / \frac{45}{10} \quad \frac{66}{10}$$

$$\frac{112}{10} \quad \frac{116}{5} \quad 2.7 \frac{110}{.07} \quad \frac{107}{16.0} \quad \frac{10.0}{11.7} / \frac{3.7}{10} \quad \frac{88}{10}$$

mail in T.T Right 519 16+40

$$\frac{71}{10} \quad 4.7 \frac{80}{12.7} \quad \frac{87}{16.0} \quad \frac{71}{11.6} / \frac{3.6}{10} \quad \frac{75}{4} \quad \frac{92}{10}$$

$$\frac{81}{10} \quad 4.5 \frac{88}{12.9} \quad \frac{93}{12.4} \quad \frac{97}{22.0} / \frac{4.0}{10} \quad \frac{101}{10}$$

$$\frac{73}{10} \quad 4.7 \frac{100}{12.7} \quad \frac{106}{12.1} \quad \frac{107}{23.0} / \frac{4}{10} \quad \frac{109}{10}$$

$$\frac{107}{10} \quad 4.5 \frac{103}{12.5} \quad \frac{100}{5} \quad \frac{95}{13.3} \quad \frac{87}{3} \quad \frac{92}{13.6} / \frac{5.6}{10} \quad \frac{98}{10}$$

$$\frac{89}{10} \quad 5.5 \frac{95}{12.5} \quad \frac{91}{13.9} \quad \frac{87}{4} \quad \frac{94}{13.6} / \frac{5.6}{10} \quad \frac{103}{10}$$

$$\frac{110}{9} \quad 8.5 \frac{67}{6.5} \quad \frac{69}{16.3} \quad \frac{64}{3} \quad \frac{80}{15.2} / \frac{7.2}{10}$$

$$\frac{113}{9} \quad 5.4 \frac{98}{18.6} \quad \frac{80}{2} \quad \frac{77}{15.7} \quad \frac{78}{15.6} / \frac{7.6}{10} \quad \frac{93}{10}$$

5/2

+

NT

-

F/0.0

858.89

20+50

45.4

13.5

21+00

45.43

13.46

+50

46.0

12.9

22+00

46.7

12.2

+50

47.4

11.5

23+00

49.9

9.0

23+10

50.4

BT

740

851.49

851.46

$$\frac{11.0}{10}$$

$$4.5 / \frac{11.0}{2.5}$$

$$\frac{11.0}{11}$$

$$\frac{9.3}{+4.2}$$

$$\frac{9.2}{+4.3 / 4.3}$$

$$\frac{7.6}{10}$$

$$\frac{10.6}{10}$$

$$4.2 / \frac{11.3}{2.2}$$

$$\frac{1.2}{2.3}$$

$$\frac{1.6}{2.4 / 4.4}$$

BT starts For Calc

set 2.3 above floor

$$\frac{11.3}{10}$$

$$3.6 / \frac{11.3}{+1.6}$$

$$\frac{11.4}{+1.5}$$

$$\frac{11.2}{+1.7 / 3.7}$$

$$\frac{11.6}{10}$$

$$\frac{10.4}{7}$$

$$3.4 / \frac{10.6}{+1.6}$$

$$\frac{10.5}{+1.7}$$

$$\frac{10.5}{+1.7 / 3.7}$$

$$\frac{10.7}{10}$$

$$\frac{8.9}{7}$$

$$4.1 / \frac{9.4}{+2.1}$$

$$\frac{9.5}{+2.0}$$

$$\frac{9.8}{+1.7 / 3.7}$$

$$\frac{7.7}{10}$$

$$\frac{6.7}{8}$$

$$3.6 / \frac{7.4}{+1.6}$$

$$\frac{7.6}{+1.4}$$

$$\frac{7.6}{1.4 / 3.4}$$

$$\frac{7.8}{8}$$

RR SPINGS IN T P LT STA 32+45

Co. Pitch on Right

858.89

+45-				45.7	13.2
+55-				45.7	13.2
+65-				45.7	13.2
BM	612	857.58	740	881.49	881.46
1+00				45.8	11.8
+50				45.9	11.7
2+00				46.0	11.6

Lt

Rt

$$\frac{7.5}{10} \quad 7.8 / \frac{7.4}{5.8} \quad \frac{7.6}{1} \quad \frac{8.8}{4.4} \quad \frac{7.4}{2} \quad \frac{7.5}{5.7} / 7.7 \quad \frac{7.7}{10}$$

$$\frac{9.3}{10} \quad 6.0 / \frac{9.2}{4.0} \quad \frac{9.0}{1} \quad \frac{10.4}{12.8} \quad \frac{10.1}{1} \quad \frac{9.0}{1.5} \quad \frac{9.4}{3.8} / 5.8 \quad \frac{9.4}{10}$$

$$\frac{10.5}{10} \quad 3.6 / \frac{10.2}{1.6} \quad \frac{11.3}{1} \quad \frac{11.4}{10.4} \quad \frac{10.1}{1} \quad \frac{9.6}{2.2} / 4.2 \quad \frac{10.0}{5} \quad \frac{10.1}{10}$$

$$\frac{10.9}{10} \quad 2.9 / \frac{10.8}{10.9} \quad \frac{10.8}{1.5} \quad \frac{11.6}{1} \quad \frac{11.7}{10} \quad \frac{11.6}{1} \quad \frac{10.8}{1.5} \quad \frac{10.6}{11} / 3.1 \quad \frac{10.2}{5} \quad \frac{11.0}{6} \quad \frac{10.8}{10}$$

59170

Ditch Left.

B.M.	852.58		
1946		45.04	12.5
2040		45.1	12.6
150		45.2	12.4
2140		45.3	12.3

Co. Ditch on left

+33		45.04	12.5
+48		45.01	12.6
+60		44.9	12.7
1400		44.8	12.9
B.M.	6.12	851.46	

L+

R+

$$\frac{72}{10} \quad \frac{95}{7} \quad 5.5 / \frac{90}{35} \quad \frac{104}{21} \quad \frac{99}{+26} / 46 \quad \frac{76}{9}$$

$$\frac{64}{10} \quad \frac{84}{+66} / \frac{69}{5} \quad \frac{62}{5} \quad \frac{77}{+49} \quad \frac{92}{+44} / 64 \quad \frac{72}{9}$$

$$\frac{100}{10} \quad \frac{70}{7} \quad 5.8 / \frac{86}{38} \quad \frac{82}{+32} \quad \frac{108}{+17} / 37 \quad \frac{106}{9}$$

B.T. 3 sta/10
for Culy 3' above
Flow line
6' offset center
center

$$\frac{109}{10} \quad \frac{98}{+18} / \frac{105}{2.2} \quad \frac{101}{2.2} \quad \frac{98}{+25} / 4.5 \quad \frac{95}{10}$$


$$3.9 / \frac{102}{1.9}$$

$$\frac{60}{10} \quad 8.5 / \frac{6.2}{+63} \quad \frac{66}{60} \quad \frac{70}{+56} / 7.4 \quad \frac{67}{10}$$

$$\frac{74}{10} \quad \frac{6.8}{+4.8} / \frac{7.9}{+4.1} \quad \frac{86}{+4.1} \quad \frac{89}{+39} / 8.9 \quad \frac{80}{10}$$


$$\frac{101}{10} \quad \frac{102}{5} \quad 8.7 / \frac{161}{+17} \quad \frac{122}{2} \quad \frac{128}{20} \quad \frac{128}{15} \quad \frac{11.2}{1.6} / 3.1 \quad \frac{105}{10}$$

Spike in T.P. L+

 

DIETZGEN'S RAILROAD CURVE AND REDUCTION TABLES

Copyright, 1914, by Eugene Dietzgen Co., New York City

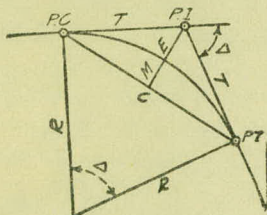

1893
488
23.81

CURVE FORMULAS

Radius= $R = \frac{50}{\sin \frac{D}{2}}$ (1) Degree of Curve= D and $\sin \frac{D}{2} = \frac{50}{R}$ (2)

Tangent= $T = R \tan \frac{\Delta}{2}$ (3) Length of Curve= $L = 100 \frac{\Delta}{D}$ (4)

Middle ordinate= $M = R(1 - \cos \frac{\Delta}{2})$ (5) $= R \text{vers} \frac{\Delta}{2}$ (6)

External= $E = T \tan \frac{\Delta}{4}$ (7) $= R \div \cos \frac{\Delta}{2} - R$ (8) $= R \text{exsec} \frac{\Delta}{2}$ (9)

Long Chord= $C = 2 R \sin \frac{\Delta}{2}$ (10) $\Delta =$ Central Angle

EXPLANATION AND USE OF TABLES

Stations.—Given P. I.=Sta. 161+60.35 to find Sta. of P. C. and P. T. $\Delta=62^\circ 10'$ $D=8^\circ 20'$. From Table IV for 1° curve $T=3454.1$ and $\div 8\frac{1}{3}=414.49$ ft. From Table V correction=.36 or $T=414.85$ ft. P. C.=Sta. P. I.— $T=157+45.50$. Also from (4) $L=746.00$ and P. T.=Sta. P. C. + $L=164+91.50$.

Offsets.—Tangent offsets vary (approximately) directly with D and with square of the distance. Thus tangent offset for Sta. 158 on above curve is 2.16 ft. found as follows. From Table III tangent offset for 100 ft.=7.27 ft. Distance= $158 - \text{Sta. P. C.}=54.50$, hence offset= $7.27 (54.50 \div 100)^2=2.16$ ft. Also square of any distance divided by twice the radius equals (approximately) the distance from tangent to curve. Thus $(54.50)^2 \div (2 \times 688.26)=2.16$ ft.

Deflections.—Deflection angle= $\frac{1}{2} D$ for 100 ft., $\frac{1}{4} D$ for 50 ft., etc. For c ft.=(in minutes) $.3 \times C \times D^\circ$ or=defl. for 1 ft. from Table III $\times C$. For Sta. 158 of above curve= $.3 \times 54.5 \times 8\frac{1}{3}=136.2'$ or $2^\circ 16.2'$, or= $2.50 \times 54.5=136.2'$ from Table III. For Sta. 159 deflection angle= $2^\circ 16.2' + 8^\circ 20' \div 2=6^\circ 26.2'$, etc.

Externals.—May be found in similar manner to tangents. Thus E for curve above is 91.37. For from Table IV for 1° curve $E=960.6$ for $8^\circ 20'=960.6 \div 8\frac{1}{3}=91.27$ and from Table V correction=.10 or $E=91.37$ ft. Or suppose $\Delta=32^\circ$ and E is measured and found to be 42 ft. What is D ? From Table IV $E=230.9$ and $\div 42=5.5$ or $D=5^\circ 30'$.

TABLE I.—MINUTES IN DECIMALS OF A DEGREE.

1'	.0167	11'	.1833	21'	.3500	31'	.5167	41'	.6833	51'	.8500
2	.0333	12	.2000	22	.3667	32	.5333	42	.7000	52	.8667
3	.0500	13	.2167	23	.3833	33	.5500	43	.7167	53	.8833
4	.0667	14	.2333	24	.4000	34	.5667	44	.7333	54	.9000
5	.0833	15	.2500	25	.4167	35	.5833	45	.7500	55	.9167
6	.1000	16	.2667	26	.4333	36	.6000	46	.7667	56	.9333
7	.1167	17	.2833	27	.4500	37	.6167	47	.7833	57	.9500
8	.1333	18	.3000	28	.4667	38	.6333	48	.8000	58	.9667
9	.1500	19	.3167	29	.4833	39	.6500	49	.8167	59	.9833
10	.1667	20	.3333	30	.5000	40	.6667	50	.8333	60	1.0000

TABLE II.—INCHES IN DECIMALS OF A FOOT.

1-16	3-32	1/8	3-16	1/4	5-16	3/8	1/2	5/8	3/4	7/8
.0052	.0078	.0104	.0156	.0208	.0260	.0313	.0417	.0521	.0625	.0729
1	2	3	4	5	6	7	8	9	10	11
.0833	.1667	.2500	.3333	.4167	.5000	.5833	.6667	.7500	.8333	.9167

TABLE III.—RADI, ORDINATES AND DEFLECTIONS.

Deg.	Radius	Mid. Ord.	Tan. Offset	Def. for 1 Foot	Deg.	Radius	Mid. Ord.	Tan. Offset	Def. for 1 Foot
0° 10'	34377.5	.036	.145	0.05	7°	819.02	1.528	6.105	2.10'
20	17188.8	.073	.291	0.10	20'	781.84	1.600	6.395	2.20
30	11459.2	.109	.436	0.15	30	764.49	1.637	6.540	2.25
40	8594.42	.145	.582	0.20	40	747.89	1.673	6.685	2.30
50	6875.55	.182	.727	0.25	8	716.78	1.746	6.976	2.40
1	5729.65	.218	.873	0.30	20	688.16	1.819	7.266	2.50
10	4911.15	.255	1.018	0.35	30	674.69	1.855	7.411	2.55
20	4297.28	.291	1.164	0.40	40	661.74	1.892	7.556	2.60
30	3819.83	.327	1.309	0.45	9	637.28	1.965	7.846	2.70
40	3437.87	.364	1.454	0.50	20	614.56	2.037	8.136	2.80
50	3125.36	.400	1.600	0.55	30	603.80	2.074	8.281	2.85
2	2864.93	.436	1.745	0.60	40	593.42	2.110	8.426	2.90
10	2644.58	.473	1.891	0.65	10	573.69	2.183	8.716	3.00
20	2455.70	.509	2.036	0.70	30	546.44	2.292	9.150	3.15
30	2292.01	.545	2.181	0.75	11	521.67	2.402	9.585	3.30
40	2148.79	.582	2.327	0.80	30	499.06	2.511	10.02	3.45
50	2022.41	.618	2.472	0.85	12	478.34	2.620	10.45	3.60
3	1910.08	.655	2.618	0.90	30	459.28	2.730	10.89	3.75
10	1809.57	.691	2.763	0.95	13	441.68	2.839	11.32	3.90
20	1719.12	.727	2.908	1.00	30	425.40	2.949	11.75	4.05
30	1637.28	.764	3.054	1.05	14	410.28	3.058	12.18	4.20
40	1562.88	.800	3.199	1.10	30	396.20	3.168	12.62	4.35
50	1494.95	.836	3.345	1.15	15	383.07	3.277	13.05	4.50
4	1432.69	.873	3.490	1.20	30	370.78	3.387	13.49	4.65
10	1375.40	.909	3.635	1.25	16	359.27	3.496	13.92	4.80
20	1322.53	.945	3.718	1.30	30	348.45	3.606	14.35	4.95
30	1273.57	.982	3.926	1.35	17	338.27	3.716	14.78	5.10
40	1228.11	1.018	4.071	1.40	18	319.62	3.935	15.64	5.40
50	1185.78	1.055	4.217	1.45	19	302.94	4.155	16.51	5.70
5	1146.28	1.091	4.362	1.50	20	287.94	4.374	17.37	6.00
10	1109.33	1.127	4.507	1.55	21	274.37	4.594	18.22	6.30
20	1074.68	1.164	4.653	1.60	22	262.04	4.814	19.08	6.60
30	1042.14	1.200	4.798	1.65	23	250.79	5.035	19.94	6.90
40	1011.51	1.237	4.943	1.70	24	240.49	5.255	20.79	7.20
50	982.64	1.273	5.088	1.75	25	231.01	5.476	21.64	7.50
6	955.37	1.309	5.234	1.80	26	222.27	5.697	22.50	7.80
10	929.57	1.346	5.379	1.85	27	214.18	5.918	23.35	8.10
20	905.13	1.382	5.524	1.90	28	206.68	6.139	24.19	8.40
30	881.95	1.418	5.669	1.95	29	199.70	6.360	25.04	8.70
40	859.92	1.455	5.814	2.00	30	193.18	6.583	25.88	9.00

Note. Chord Deflection=2 times tangent deflection.

TABLE IV.—TANGENTS AND EXTERNALS TO A 1° CURVE.

Central Angle	Tangent	External	Central Angle	Tangent	External	Central Angle	Tangent	External
1°	50.00	.22	11°	551.70	26.50	21°	1061.9	97.57
10'	58.34	.30	10'	560.11	27.31	10'	1070.6	99.16
20	66.67	.39	20	568.53	28.14	20	1079.2	100.75
30	75.01	.49	30	576.95	28.97	30	1087.8	102.35
40	83.34	.61	40	585.36	29.82	40	1096.4	103.97
50	91.68	.73	50	593.79	30.68	50	1105.1	105.60
2	100.01	.87	12	602.21	31.56	22	1113.7	107.24
10	108.35	1.02	10	610.64	32.45	10	1122.4	108.90
20	116.68	1.19	20	619.07	33.35	20	1131.0	110.57
30	125.02	1.36	30	627.50	34.26	30	1139.7	112.25
40	133.36	1.55	40	635.93	35.18	40	1148.4	113.95
50	141.70	1.75	50	644.37	36.12	50	1157.0	115.66
3	150.04	1.96	13	652.81	37.07	23	1165.7	117.38
10	158.38	2.19	10	661.25	38.03	10	1174.4	119.12
20	166.72	2.43	20	669.70	39.01	20	1183.1	120.87
30	175.06	2.67	30	678.15	39.99	30	1191.8	122.63
40	183.40	2.93	40	686.60	40.99	40	1200.5	124.41
50	191.74	3.21	50	695.06	42.00	50	1209.2	126.20
4	200.08	3.49	14	703.51	43.03	24	1217.9	128.00
10	208.43	3.79	10	711.97	44.07	10	1226.6	129.82
20	216.77	4.10	20	720.44	45.12	20	1235.3	131.65
30	225.12	4.42	30	728.90	46.18	30	1244.0	133.50
40	233.47	4.76	40	737.37	47.25	40	1252.8	135.35
50	241.81	5.10	50	745.85	48.34	50	1261.5	137.23
5	250.16	5.46	15	754.32	49.44	25	1270.2	139.11
10	258.51	5.83	10	762.80	50.55	10	1279.0	141.01
20	266.86	6.21	20	771.29	51.68	20	1287.7	142.93
30	275.21	6.61	30	779.77	52.89	30	1296.5	144.85
40	283.57	7.01	40	788.26	53.97	40	1305.3	146.79
50	291.92	7.43	50	796.75	55.13	50	1314.0	148.75
6	300.28	7.86	16	805.25	56.31	26	1322.8	150.71
10	308.64	8.31	10	813.75	57.50	10	1331.6	152.69
20	316.99	8.76	20	822.25	58.70	20	1340.4	154.69
30	325.35	9.23	30	830.76	59.91	30	1349.2	156.70
40	333.71	9.71	40	839.27	61.14	40	1358.0	158.72
50	342.08	10.20	50	847.78	62.38	50	1366.8	160.76
7	350.44	10.71	17	856.30	63.63	27	1375.6	162.81
10	358.81	11.22	10	864.82	64.90	10	1384.4	164.86
20	367.17	11.75	20	873.35	66.18	20	1393.2	166.95
30	375.54	12.29	30	881.88	67.47	30	1402.0	169.04
40	383.91	12.85	40	890.41	68.77	40	1410.9	171.15
50	392.28	13.41	50	898.95	70.09	50	1419.7	173.27
8	400.66	13.99	18	907.49	71.42	28	1428.6	175.41
10	409.03	14.58	10	916.03	72.76	10	1437.4	177.55
20	417.41	15.18	20	924.58	74.12	20	1446.3	179.72
30	425.79	15.80	30	933.13	75.49	30	1455.1	181.89
40	434.17	16.43	40	941.69	76.86	40	1464.0	184.08
50	442.55	17.07	50	950.25	78.26	50	1472.9	186.29
9	450.93	17.72	19	958.81	79.67	29	1481.8	188.51
10	459.32	18.38	10	967.38	81.09	10	1490.7	190.74
20	467.71	19.06	20	975.96	82.53	20	1499.6	192.99
30	476.10	19.75	30	984.53	83.97	30	1508.5	195.25
40	484.49	20.45	40	993.12	85.43	40	1517.4	197.53
50	492.88	21.16	50	1001.7	86.90	50	1526.3	199.82
10	501.28	21.89	20	1010.3	88.39	30	1535.3	202.12
10	509.68	22.62	10	1018.9	89.89	10	1544.2	204.44
20	518.08	23.38	20	1027.5	91.40	20	1553.1	206.77
30	526.48	24.14	30	1036.1	92.92	30	1562.1	209.12
40	534.89	24.91	40	1044.7	94.46	40	1571.0	211.48
50	543.29	25.70	50	1053.3	96.01	50	1580.0	213.86

3
9074
20

TABLE IV.—TANGENTS AND EXTERNALS TO A 1° CURVE.

Central Angle	Tangent	External	Central Angle	Tangent	External	Central Angle	Tangent	External
31°	1589.0	216.3	41°	2142.2	387.4	51°	2732.9	618.4
10'	1598.0	218.7	10'	2151.7	390.7	10'	2743.1	622.8
20	1606.9	221.1	20	2161.2	394.1	20	2753.4	627.2
30	1615.9	223.5	30	2170.8	397.4	30	2763.7	631.7
40	1624.9	226.0	40	2180.3	400.8	40	2773.9	636.2
50	1633.9	228.4	50	2189.9	404.2	50	2784.2	640.7
32	1643.0	230.9	42	2199.4	407.6	52	2794.5	645.2
10	1652.0	233.4	10	2209.0	411.1	10	2804.9	649.7
20	1661.0	235.9	20	2218.6	414.5	20	2815.2	654.3
30	1670.0	238.4	30	2228.1	418.0	30	2825.6	658.8
40	1679.1	241.0	40	2237.7	421.4	40	2835.9	663.4
50	1688.1	243.5	50	2247.3	425.0	50	2846.3	668.0
33	1697.2	246.1	43	2257.0	428.5	53	2856.7	672.7
10	1706.3	248.7	10	2266.6	432.0	10	2867.1	677.3
20	1715.3	251.3	20	2276.2	435.6	20	2877.5	682.0
30	1724.4	253.9	30	2285.9	439.2	30	2888.0	686.7
40	1733.5	256.5	40	2295.6	442.8	40	2898.4	691.4
50	1742.6	259.1	50	2305.2	446.4	50	2908.9	696.1
34	1751.7	261.8	44	2314.9	450.0	54	2919.4	700.9
10	1760.8	264.5	10	2324.6	453.6	10	2929.9	705.7
20	1770.0	267.2	20	2334.3	457.3	20	2940.4	710.5
30	1779.1	269.9	30	2344.1	461.0	30	2951.0	715.3
40	1788.2	272.6	40	2353.8	464.6	40	2961.5	720.1
50	1797.4	275.3	50	2363.5	468.4	50	2972.1	725.0
35	1806.6	278.1	45	2373.3	472.1	55	2982.7	729.9
10	1815.7	280.8	10	2383.1	475.8	10	2993.3	734.8
20	1824.9	283.6	20	2392.8	479.6	20	3003.9	739.7
30	1834.1	286.4	30	2402.6	483.8	30	3014.5	744.6
40	1843.3	289.2	40	2412.4	487.2	40	3025.2	749.6
50	1852.5	292.0	50	2422.3	491.0	50	3035.8	754.6
36	1861.7	294.9	46	2432.1	494.8	56	3046.5	759.6
10	1870.9	297.7	10	2441.9	498.7	10	3057.2	764.6
20	1880.1	300.6	20	2451.8	502.5	20	3067.9	769.7
30	1889.4	303.5	30	2461.7	506.4	30	3078.7	774.7
40	1898.6	306.4	40	2471.5	510.3	40	3089.4	779.8
50	1907.9	309.3	50	2481.4	514.3	50	3100.2	784.9
37	1917.1	312.2	47	2491.3	518.2	57	3110.9	790.1
10	1926.4	315.2	10	2501.2	522.2	10	3121.7	795.2
20	1935.7	318.1	20	2511.2	526.1	20	3132.6	800.4
30	1945.0	321.1	30	2521.1	530.1	30	3143.4	805.6
40	1954.3	324.1	40	2531.1	534.2	40	3154.2	810.9
50	1963.6	327.1	50	2541.0	538.2	50	3165.1	816.1
38	1972.9	330.2	48	2551.0	542.2	58	3176.0	821.4
10	1982.2	333.2	10	2561.0	546.3	10	3186.9	826.7
20	1991.5	336.3	20	2571.0	550.4	20	3197.8	832.0
30	2000.9	339.3	30	2581.0	554.5	30	3208.8	837.3
40	2010.2	342.4	40	2591.0	558.6	40	3219.7	842.7
50	2019.6	345.5	50	2601.1	562.8	50	3230.7	848.1
39	2029.0	348.6	49	2611.2	566.9	59	3241.7	853.5
10	2038.4	351.8	10	2621.2	571.1	10	3252.7	858.9
20	2047.8	354.9	20	2631.3	575.3	20	3263.7	864.3
30	2057.2	358.1	30	2641.4	579.5	30	3274.8	869.8
40	2066.6	361.3	40	2651.5	583.8	40	3285.8	875.3
50	2076.0	364.5	50	2661.6	588.0	50	3296.9	880.8
40	2085.4	367.7	50	2671.8	592.3	60	3308.0	886.4
10	2094.9	371.0	10	2681.9	596.6	10	3319.1	892.0
20	2104.3	374.2	20	2692.1	600.9	20	3330.3	897.5
30	2113.8	377.5	30	2702.3	605.3	30	3341.4	903.2
40	2123.3	380.8	40	2712.5	609.6	40	3352.6	908.8
50	2132.7	384.1	50	2722.7	614.0	50	3363.8	914.5

TABLE IV.—TANGENTS AND EXTERNALS TO A 1° CURVE.

Central Angle	Tangent	External	Central Angle	Tangent	External	Central Angle	Tangent	External
61°	3375.0	920.2	71°	4086.9	1308.2	81°	4893.6	1805.3
10'	3386.3	925.9	10'	4099.5	1315.6	10'	4908.0	1814.7
20	3397.5	931.6	20	4112.1	1322.9	20	4922.5	1824.1
30	3408.8	937.3	30	4124.8	1330.3	30	4937.0	1833.6
40	3420.1	943.1	40	4137.4	1337.7	40	4951.5	1843.1
50	3431.4	948.9	50	4150.1	1345.1	50	4966.1	1852.6
62	3442.7	954.8	72	4162.8	1352.6	82	4980.7	1862.2
10	3454.1	960.6	10	4175.6	1360.1	10	4995.4	1871.8
20	3465.4	966.5	20	4188.5	1367.6	20	5010.0	1881.5
30	3476.8	972.4	30	4201.2	1375.2	30	5024.8	1891.2
40	3488.3	978.3	40	4214.0	1382.8	40	5039.5	1900.9
50	3499.7	984.3	50	4226.8	1390.4	50	5054.3	1910.7
63	3511.1	990.2	73	4239.7	1398.0	83	5069.2	1920.5
10	3522.6	996.2	10	4252.6	1405.7	10	5084.0	1930.4
20	3534.1	1002.3	20	4265.6	1413.5	20	5099.0	1940.3
30	3545.6	1008.3	30	4278.5	1421.2	30	5113.9	1950.3
40	3557.2	1014.4	40	4291.5	1429.0	40	5128.9	1960.2
50	3568.7	1020.5	50	4304.6	1436.8	50	5143.9	1970.3
64	3580.3	1026.6	74	4317.6	1444.6	84	5159.0	1980.4
10	3591.9	1032.8	10	4330.7	1452.5	10	5174.1	1990.5
20	3603.5	1039.0	20	4343.8	1460.4	20	5189.3	2000.6
30	3615.1	1045.2	30	4356.9	1468.4	30	5204.4	2010.8
40	3626.8	1051.4	40	4370.1	1476.4	40	5219.7	2021.1
50	3638.5	1057.7	50	4383.3	1484.4	50	5234.9	2031.4
65	3650.2	1063.9	75	4396.5	1492.4	85	5250.3	2041.7
10	3661.9	1070.2	10	4409.8	1500.5	10	5265.6	2052.1
20	3673.7	1076.6	20	4423.1	1508.6	20	5281.0	2062.5
30	3685.4	1082.9	30	4436.4	1516.7	30	5296.4	2073.0
40	3697.2	1089.3	40	4449.7	1524.9	40	5311.9	2083.5
50	3709.0	1095.7	50	4463.1	1533.1	50	5327.4	2094.1
66	3720.9	1102.2	76	4476.5	1541.4	86	5343.0	2104.7
10	3732.7	1108.6	10	4489.9	1549.7	10	5358.6	2115.3
20	3744.6	1115.1	20	4503.4	1558.0	20	5374.2	2126.0
30	3756.5	1121.7	30	4516.9	1566.3	30	5389.9	2136.7
40	3768.5	1128.2	40	4530.4	1574.7	40	5405.6	2147.5
50	3780.4	1134.8	50	4544.0	1583.1	50	5421.4	2158.4
67	3792.4	1141.4	77	4557.6	1591.6	87	5437.2	2169.2
10	3804.4	1148.0	10	4571.2	1600.1	10	5453.1	2180.2
20	3816.4	1154.7	20	4584.8	1608.6	20	5469.0	2191.1
30	3828.4	1161.3	30	4598.5	1617.1	30	5484.9	2202.2
40	3840.5	1168.1	40	4612.2	1625.7	40	5500.9	2213.2
50	3852.6	1174.8	50	4626.0	1634.4	50	5517.0	2224.3
68	3864.7	1181.6	78	4639.8	1643.0	88	5533.1	2235.5
10	3876.8	1188.4	10	4653.6	1651.7	10	5549.2	2246.7
20	3889.0	1195.2	20	4667.4	1660.5	20	5565.4	2258.0
30	3901.2	1202.0	30	4681.3	1669.2	30	5581.6	2269.3
40	3913.4	1208.9	40	4695.2	1678.1	40	5597.8	2280.6
50	3925.6	1215.8	50	4709.2	1686.9	50	5614.2	2292.0
69	3937.9	1222.7	79	4723.2	1695.8	89	5630.5	2303.5
10	3950.2	1229.7	10	4737.2	1704.7	10	5646.9	2315.0
20	3962.5	1236.7	20	4751.2	1713.7	20	5663.4	2326.6
30	3974.8	1243.7	30	4765.3	1722.7	30	5679.9	2338.2
40	3987.2	1250.8	40	4779.4	1731.7	40	5696.4	2349.8
50	3999.5	1257.9	50	4793.6	1740.8	50	5713.0	2361.5
70	4011.9	1265.0	80	4807.7	1749.9	90	5729.7	2373.3
10	4024.4	1272.1	10	4822.0	1759.0	10	5746.3	2385.1
20	4036.8	1279.3	20	4836.2	1768.2	20	5763.1	2397.0
30	4049.3	1286.5	30	4850.5	1777.4	30	5779.9	2408.9
40	4061.8	1293.6	40	4864.8	1786.7	40	5796.7	2420.9
50	4074.4	1300.9	50	4879.2	1796.0	50	5813.6	2432.9

TABLE IV.—TANGENTS AND EXTERNALS TO A 1° CURVE.

Central Angle	Tangent	External	Central Angle	Tangent	External	Central Angle	Tangent	External
91°	5830.5	2444.9	101°	6950.6	3278.1	111°	8336.7	4386.1
10'	5847.5	2457.1	10'	6971.3	3294.1	10'	8362.7	4407.6
20	5864.6	2469.3	20	6992.0	3310.1	20	8388.9	4429.2
30	5881.7	2481.5	30	7012.7	3326.1	30	8415.1	4450.9
40	5898.8	2493.8	40	7033.6	3342.3	40	8441.5	4472.7
50	5916.0	2506.1	50	7054.5	3358.5	50	8468.0	4494.6
92	5933.2	2518.5	102	7075.5	3374.9	112	8494.6	4516.6
10	5950.5	2531.0	10	7096.6	3391.2	10	8521.3	4538.8
20	5967.9	2543.5	20	7117.8	3407.7	20	8548.1	4561.1
30	5985.3	2556.0	30	7139.0	3424.3	30	8575.0	4583.4
40	6002.7	2568.6	40	7160.3	3440.9	40	8602.1	4606.0
50	6020.2	2581.3	50	7181.7	3457.6	50	8629.3	4628.6
93	6037.8	2594.0	103	7203.2	3474.4	113	8656.6	4651.3
10	6055.4	2606.8	10	7224.7	3491.3	10	8684.0	4674.2
20	6073.1	2619.7	20	7246.3	3508.2	20	8711.5	4697.2
30	6090.8	2632.6	30	7268.0	3525.2	30	8739.2	4720.3
40	6108.6	2645.5	40	7289.8	3542.4	40	8767.0	4743.6
50	6126.4	2658.5	50	7311.7	3559.6	50	8794.9	4766.9
94	6144.3	2671.6	104	7333.6	3576.8	114	8822.9	4790.4
10	6162.6	2684.7	10	7355.6	3594.2	10	8851.0	4814.1
20	6180.2	2697.9	20	7377.8	3611.7	20	8879.3	4837.8
30	6198.3	2711.2	30	7399.9	3629.2	30	8907.7	4861.7
40	6216.4	2724.5	40	7422.2	3646.8	40	8936.3	4885.7
50	6234.6	2737.9	50	7444.6	3664.5	50	8965.0	4909.9
95	6252.8	2751.3	105	7467.0	3682.3	115	8993.8	4934.1
10	6271.1	2764.8	10	7489.6	3700.2	10	9022.7	4958.6
20	6289.4	2778.3	20	7512.2	3718.2	20	9051.7	4983.1
30	6307.9	2792.0	30	7534.9	3736.2	30	9080.9	5007.8
40	6326.3	2805.6	40	7557.7	3754.4	40	9110.3	5032.6
50	6344.8	2819.4	50	7580.5	3772.6	50	9139.8	5057.6
96	6363.4	2833.2	106	7603.5	3791.0	116	9169.4	5082.7
10	6382.1	2847.0	10	7626.6	3809.4	10	9199.1	5107.9
20	6400.8	2861.0	20	7649.7	3827.9	20	9229.0	5133.3
30	6419.5	2875.0	30	7672.9	3846.5	30	9259.0	5158.8
40	6438.4	2889.0	40	7696.3	3865.2	40	9289.2	5184.5
50	6457.3	2903.1	50	7719.7	3884.0	50	9319.5	5210.3
97	6476.2	2917.3	107	7743.2	3902.9	117	9349.9	5236.2
10	6495.2	2931.6	10	7766.8	3921.9	10	9380.5	5262.3
20	6514.3	2945.9	20	7790.5	3940.9	20	9411.3	5288.6
30	6533.4	2960.3	30	7814.3	3960.1	30	9442.2	5315.0
40	6552.6	2974.7	40	7838.1	3979.4	40	9473.2	5341.5
50	6571.9	2989.2	50	7862.1	3998.7	50	9504.4	5368.2
98	6591.2	3003.8	108	7886.2	4018.2	118	9535.7	5395.1
10	6610.6	3018.4	10	7910.4	4037.8	10	9567.2	5422.1
20	6630.1	3033.1	20	7934.6	4057.4	20	9598.9	5449.2
30	6649.6	3047.9	30	7959.0	4077.2	30	9630.7	5476.5
40	6669.2	3062.8	40	7983.5	4097.1	40	9662.6	5504.0
50	6688.8	3077.7	50	8008.0	4117.0	50	9694.7	5531.7
99	6708.6	3092.7	109	8032.7	4137.1	119	9727.0	5559.4
10	6728.4	3107.7	10	8057.4	4157.3	10	9759.4	5587.4
20	6748.2	3122.9	20	8082.3	4177.5	20	9792.0	5615.5
30	6768.1	3138.1	30	8107.3	4197.9	30	9824.8	5643.8
40	6788.1	3153.3	40	8132.3	4218.4	40	9857.7	5672.3
50	5808.2	3168.7	50	8157.5	4239.0	50	9890.8	5700.9
100	6828.3	3184.1	110	8182.8	4259.7	120	9924.0	5729.7
10	6848.5	3199.6	10	8208.2	4280.5	10	9957.5	5758.6
20	6868.8	3215.1	20	8233.7	4301.4	20	9991.0	5787.7
30	6889.2	3230.8	30	8259.3	4322.4	30	10025.0	5817.0
40	6909.6	3246.5	40	8285.0	4343.6	40	10059.0	5846.5
50	6930.1	3262.3	50	8310.8	4364.8	50	10093.0	5876.1

TABLE V.—CORRECTIONS FOR TANGENTS AND EXTERNALS.

These corrections are to be added to the approximate values, found by dividing the tangent, or external, for a 1° curve (Table IV) by the degree of curve, in order to obtain the true tangents, or externals. Intermediate values may be obtained by interpolation.

FOR TANGENTS ADD

Central Angle	DEGREE OF CURVE													
	5°	10°	15°	20°	25°	30°	35°	40°	45°	50°	55°	60°	65°	70°
10°	.03	.06	.09	.13	.16	.19	.22	.25	.28	.31	.34	.38	.42	.46
15°	.04	.10	.14	.19	.24	.29	.34	.39	.45	.51	.53	.58	.63	.68
20°	.06	.13	.19	.26	.32	.39	.45	.51	.58	.65	.72	.79	.84	.90
25°	.08	.16	.24	.33	.40	.49	.58	.67	.75	.83	.90	.99	1.06	1.14
30°	.10	.19	.29	.39	.49	.59	.69	.79	.89	.99	1.09	1.20	1.29	1.39
35°	.11	.22	.34	.47	.58	.69	.79	.81	.92	1.04	1.29	1.42	1.54	1.66
40°	.13	.26	.40	.53	.67	.80	.93	1.06	1.20	1.34	1.49	1.64	1.79	1.94
45°	.15	.30	.44	.60	.76	.91	1.06	1.21	1.37	1.52	1.70	1.87	2.04	2.21
50°	.17	.34	.51	.68	.85	1.02	1.19	1.36	1.54	1.72	1.91	2.10	2.29	2.48
55°	.19	.38	.57	.76	.95	1.14	1.32	1.52	1.72	1.92	2.14	2.35	2.56	2.77
60°	.21	.42	.63	.84	1.05	1.27	1.49	1.71	1.94	2.17	2.38	2.60	2.83	3.07
65°	.23	.46	.69	.93	1.16	1.40	1.64	1.88	2.13	2.38	2.63	2.88	3.13	3.39
70°	.25	.51	.76	1.02	1.28	1.54	1.80	2.06	2.33	2.60	2.88	3.16	3.44	3.72
75°	.27	.56	.83	1.12	1.40	1.69	1.98	2.27	2.57	2.87	3.16	3.47	3.78	4.09
80°	.30	.61	.91	1.22	1.53	1.84	2.15	2.46	2.78	3.10	3.44	3.78	4.12	4.46
85°	.33	.66	1.00	1.33	1.68	2.02	2.36	2.70	3.05	3.40	3.77	4.14	4.55	4.89
90°	.36	.72	1.09	1.45	1.83	2.20	2.57	2.94	3.32	3.70	4.10	4.50	4.91	5.32
95°	.39	.79	1.19	1.55	2.00	2.40	2.80	3.20	3.61	4.02	4.40	4.98	5.38	5.83
100°	.43	.86	1.30	1.74	2.18	2.62	3.06	3.50	3.95	4.40	4.88	5.37	5.85	6.34
110°	.51	1.03	1.56	2.08	2.61	3.14	3.67	4.21	4.76	5.31	5.86	6.43	7.01	7.60
120°	.62	1.25	1.93	2.52	3.16	3.81	4.45	5.11	5.77	6.44	7.12	7.80	8.50	9.22

FOR EXTERNALS ADD

Central Angle	DEGREE OF CURVE													
	5°	10°	15°	20°	25°	30°	35°	40°	45°	50°	55°	60°	65°	70°
10°	.001	.003	.004	.006	.007	.008	.009	.011	.012	.014	.015	.017	.018	.020
15°	.003	.007	.010	.014	.018	.023	.027	.032	.035	.039	.043	.047	.051	.051
20°	.006	.011	.017	.022	.028	.034	.038	.045	.051	.057	.063	.070	.076	.083
25°	.009	.018	.027	.036	.046	.056	.065	.074	.083	.093	.106	.120	.127	.135
30°	.013	.025	.038	.051	.065	.078	.090	.103	.116	.129	.149	.170	.179	.188
35°	.018	.035	.054	.072	.086	.109	.131	.153	.175	.197	.213	.230	.247	.264
40°	.023	.046	.070	.093	.117	.141	.172	.203	.234	.265	.277	.290	.315	.341
45°	.030	.060	.093	.119	.153	.184	.216	.254	.289	.325	.351	.378	.411	.445
50°	.037	.075	.116	.151	.189	.227	.266	.305	.345	.384	.425	.467	.508	.550
55°	.046	.093	.142	.188	.236	.283	.332	.381	.420	.470	.530	.582	.641	.700
60°	.056	.112	.168	.225	.283	.340	.398	.457	.516	.575	.636	.697	.774	.851
65°	.067	.135	.204	.273	.343	.412	.483	.554	.625	.697	.771	.845	.922	1.01
70°	.080	.159	.240	.321	.403	.485	.568	.652	.735	.819	.906	.994	1.08	1.17
75°	.095	.182	.266	.353	.440	.528	.617	.707	.797	.897	1.07	1.18	1.29	1.39
80°	.110	.220	.332	.445	.558	.671	.787	.903	1.02	1.13	1.25	1.38	1.50	1.62
85°	.128	.259	.391	.524	.657	.790	.926	1.06	1.20	1.34	1.47	1.62	1.76	1.91
90°	.149	.299	.450	.603	.756	.910	1.07	1.22	1.38	1.54	1.70	1.87	2.03	2.20
95°	.174	.350	.522	.706	.885	1.06	1.25	1.43	1.62	1.80	1.99	2.18	2.38	2.58
100°	.200	.401	.604	.809	1.01	1.22	1.43	1.64	1.85	2.06	2.28	2.50	2.73	2.96
110°	.268	.536	.806	1.08	1.35	1.63	1.91	2.20	2.48	2.76	3.05	3.35	3.65	3.96
120°	.360	.721	1.08	1.45	1.82	2.19	2.57	2.95	3.33	3.72	4.11	4.50	4.91	5.32

TABLE VI.—CORRECTIONS FOR SUB-CHORDS AND LONG CHORDS.

FOR SUB-CHORDS ADD										Excess of arc per 100 ft.	LONG CHORDS				
D	10	20	30	40	50	60	70	80	90		D	200	300	400	500
4°	.00	.00	.01	.01	.01	.01	.01	.01	.00	.02	1	199.99	299.97	399.92	499.85
6	.00	.01	.01	.02	.02	.02	.02	.02	.01	.05	2	199.97	299.88	399.70	499.39
8	.01	.02	.02	.03	.03	.03	.03	.02	.01	.08	3	199.93	299.73	399.32	498.63
10	.01	.02	.03	.04	.05	.05	.05	.04	.02	.13	4	199.88	299.51	398.78	497.57
12	.02	.04	.05	.06	.07	.07	.07	.05	.03	.18	5	199.81	299.24	398.10	496.20
14	.02	.05	.07	.08	.09	.10	.09	.07	.04	.25	6	199.73	298.90	397.26	494.53
16	.03	.06	.09	.11	.12	.12	.12	.09	.05	.33	7	199.63	298.51	396.28	492.57
18	.04	.08	.11	.14	.15	.16	.15	.12	.07	.41	8	199.51	298.05	395.14	490.31
20	.05	.10	.14	.17	.19	.20	.18	.15	.09	.51	9	199.38	297.54	393.86	487.75
22	.06	.12	.17	.21	.23	.24	.22	.18	.10	.62	10	199.24	296.96	392.42	484.90
24	.07	.14	.20	.25	.28	.28	.26	.21	.12	.74	12	198.90	295.63	389.12	478.34
26	.09	.17	.24	.29	.32	.33	.31	.25	.15	.86	14	198.51	294.06	385.22	470.65
28	.10	.19	.27	.34	.37	.38	.36	.29	.17	1.00	16	198.05	292.25	380.76	461.86
30	.11	.22	.31	.39	.43	.44	.41	.33	.19	1.15	18	197.54	290.21	375.74	452.02
32	.13	.25	.36	.44	.49	.50	.47	.38	.22	1.31	20	196.96	287.94	370.17	441.15
34	.15	.28	.40	.50	.55	.57	.53	.43	.25	1.48	22	196.32	285.44	364.06	429.30
36	.17	.32	.45	.56	.62	.64	.59	.48	.28	1.66	24	195.63	282.71	357.43	416.53
38	.18	.36	.51	.62	.70	.71	.66	.53	.31	1.86	26	194.87	279.76	350.30	402.89
40	.21	.40	.56	.69	.77	.79	.73	.59	.35	2.06	28	194.06	276.59	342.69	388.43
42	.23	.44	.62	.76	.85	.87	.81	.65	.38	2.28	30	193.18	273.20	334.61	373.20
44	.25	.48	.68	.84	.94	.96	.89	.72	.42	2.50	32	192.25	269.61	326.08	357.28
46	.27	.52	.75	.92	1.02	1.05	.98	.78	.46	2.74	34	191.26	265.81	317.12	340.73
48	.30	.57	.81	1.00	1.12	1.14	1.06	.86	.50	2.99	36	190.21	261.80	307.77	323.61
50	.32	.62	.89	1.09	1.21	1.24	1.15	.93	.55	3.24	38	189.10	257.60	298.03	305.99
52	.35	.67	.96	1.18	1.31	1.35	1.25	1.01	.59	3.52	40	187.94	253.21	287.94	287.94
54	.38	.73	1.04	1.28	1.42	1.46	1.35	1.09	.64	3.80	42	186.72	248.63	277.51	269.54
56	.41	.78	1.12	1.38	1.53	1.57	1.46	1.17	.69	4.09	44	185.44	243.87	266.78	250.85
58	.44	.84	1.20	1.48	1.65	1.69	1.57	1.26	.74	4.40	46	184.10	239.93	255.78	231.95
60	.47	.91	1.29	1.59	1.76	1.81	1.68	1.35	.80	4.72	48	182.71	233.83	244.51	212.92

NOTE.—When a chord of less than 100 ft. is used the corrections given in the above table should be added to the nominal length of chord to get the length which should be used in order that the 100 ft. points will check with those obtained by using the standard 100 ft. chord. Thus in locating a 14° curve by 25 ft. chords measure 25°.06 for each chord. Long chords are useful in passing obstacles.

TABLE VII.—MIDDLE ORDINATES FOR RAILS IN FEET.

Deg. of Curve	LENGTH OF RAILS							Deg. of Curve	LENGTH OF RAILS.						
	32	30	28	26	24	22	20		32	30	28	26	24	22	20
1°	.022	.020	.016	.013	.011	.009	.008	16°	.356	.313	.273	.236	.200	.170	.139
2	.045	.038	.034	.029	.025	.021	.017	17	.378	.333	.290	.252	.213	.180	.148
3	.037	.058	.051	.044	.037	.031	.026	18	.400	.351	.306	.265	.225	.190	.156
4	.089	.079	.069	.060	.050	.042	.035	19	.423	.371	.324	.280	.238	.201	.165
5	.112	.099	.086	.074	.063	.053	.044	20	.445	.392	341	.296	.250	.212	.174
6	.134	.117	.102	.088	.076	.064	.052	21	.466	.410	.357	.309	.262	.222	.182
7	.156	.137	.120	.104	.088	.074	.061	22	.487	.430	.375	.325	.275	.233	.191
8	.179	.158	.137	.119	.100	.085	.070	23	.509	.450	.390	.338	.287	.243	.199
9	.201	.175	.153	.133	.112	.095	.078	24	.531	.469	.408	.354	.299	.253	.208
10	.223	.196	.171	.148	.125	.106	.087	25	.552	.486	.424	.367	.311	.263	.216
11	.245	.216	.188	.163	.139	.117	.096	26	.573	.506	.441	.382	.323	.274	.225
12	.268	.236	.206	.179	.151	.128	.105	27	.594	.524	.457	.396	.335	.284	.233
13	.290	.254	.222	.192	.163	.138	.113	28	.618	.545	.475	.411	.348	.294	.242
14	.312	.275	.239	.207	.175	.148	.122	29	.638	.564	.491	.424	.361	.303	.250
15	.334	.295	.257	.223	.188	.159	.131	30	.660	.583	.508	.438	.374	.313	.259



SLOPE REDUCTIONS.

When distances are measured on a slope they may be reduced to the equivalent horizontal distance by the following approximate rule:— subtract from the slope distance the square of the rise divided by twice the slope distance. Thus for a slope distance of 250.3 ft. and a rise of 15 ft. correction= $15^2 \div 2 \times 250.3 = .45$ (by slide rule) or horizontal distance= $250.3 - .45 = 249.85$. When vertical angle= $V. A.$ is measured horizontal distance= $\text{slope distance} - \text{slope distance} (1 - \text{Cos. } V. A.)$. Thus for slope distance of 248.7 ft. and $V. A.$ of $4^\circ 20'$ from Table VIII $\text{Cos.} = .99714$ and correction= $1 - .99714 = .00286$ per foot or total of $.286 \times 2\frac{1}{2}$ (near enough) = .57 and horizontal distance= $248.7 - .57 = 248.13$ ft.

See fig. (a).

TRIGONOMETRICAL FORMULAS.

$$\begin{aligned} \sin. & A = \frac{a}{c} \\ \cos. & A = \frac{b}{c} \\ \tan. & A = \frac{a}{b} \\ \cot. & A = \frac{b}{a} \\ \sec. & A = \frac{c}{b} \\ \text{cosec.} & A = \frac{c}{a} \end{aligned}$$

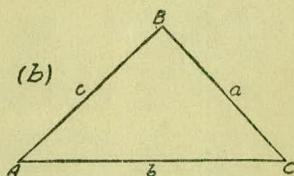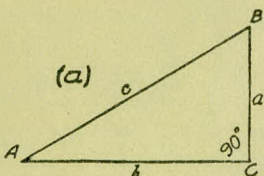

FORMULA FOR SOLVING TRIANGLES.

Given	Sought.	Right triangles. See fig. (a).
a, c	A, B, b	$\sin. A = \frac{a}{c}, \cos. B = \frac{a}{c}, b = \sqrt{(c+a)(c-a)}$
a, b	A, B, c	$\tan. A = \frac{a}{b}, \cot. B = \frac{a}{b}, c = \sqrt{a^2 + b^2}$
A, a	B, b, c	$B = 90^\circ - A, b = a \cot. A, c = \frac{a}{\sin. A}$
A, b	B, a, c	$B = 90^\circ - A, a = b \tan. A, c = \frac{b}{\cos. A}$
A, c	B, a, b	$B = 90^\circ - A, a = c \sin. A, b = c \cos. A$

Given	Sought.	Oblique triangles. See fig. (b).
A, B, a	b	$b = \frac{a \sin. B}{\sin. A}$
A, a, b	B	$\sin. B = \frac{b \sin. A}{a}$
a, b, C	$A - B$	$\tan. \frac{1}{2}(A - B) = \frac{(a - b) \tan. \frac{1}{2}(A + B)}{a + b}$
a, b, c	A	$\left\{ \begin{aligned} \text{If } s = \frac{1}{2}(a + b + c), \sin. \frac{1}{2} A &= \sqrt{\frac{(s - b)(s - c)}{bc}} \\ \cos. \frac{1}{2} A &= \sqrt{\frac{s(s - a)}{bc}}, \tan. \frac{1}{2} A = \sqrt{\frac{(s - b)(s - c)}{s(s - a)}}, \\ \sin. A &= \frac{2\sqrt{s(s - a)(s - b)(s - c)}}{bc} \end{aligned} \right.$
A, B, C, a	area	$\text{area} = \frac{a^2 \sin. B \sin. C}{2 \sin. A}$
A, b, c	area	$\text{area} = \frac{1}{2} bc \sin. A$
a, b, c	area	$s = \frac{1}{2}(a + b + c), \text{area} = \sqrt{s(s - a)(s - b)(s - c)}$

TABLE VIII.—NATURAL TRIGONOMETRICAL FUNCTIONS.

Angle	Sine.	Tan.	Cotg.	Cosin.		Angle	Sine.	Tan.	Cotg.	Cosin.	
0	0	0	∞	1	90	0	0	∞	1	90	0
10	.0029	.0029	343.8	1	50	8	.1392	.1405	7.115	.99027	82
20	.0058	.0058	171.9	.99998	40	10	.1421	.1435	6.968	.98986	50
30	.0087	.0087	114.6	.99996	30	20	.1449	.1465	6.827	.98944	40
40	.0116	.0116	85.94	.99993	20	30	.1478	.1495	6.691	.98902	30
50	.0145	.0145	68.75	.99989	10	40	.1507	.1524	6.561	.98858	20
						50	.1536	.1554	6.435	.98814	10
1	.0175	.0175	57.29	.99985	89	9	.1564	.1584	6.314	.98769	81
10	.0204	.0204	49.10	.99979	50	10	.1593	.1614	6.197	.98723	50
20	.0233	.0233	42.96	.99973	40	20	.1622	.1644	6.084	.98676	40
30	.0262	.0262	38.19	.99966	30	30	.1650	.1673	5.976	.98629	30
40	.0291	.0291	34.37	.99958	20	40	.1679	.1703	5.871	.98580	20
50	.0320	.0320	31.24	.99949	10	50	.1708	.1733	5.769	.98531	10
2	.0349	.0349	28.64	.99939	88	10	.1736	.1763	5.671	.98481	80
10	.0378	.0378	26.43	.99929	50	10	.1765	.1793	5.576	.98430	50
20	.0407	.0407	24.54	.99917	40	20	.1794	.1823	5.485	.98378	40
30	.0436	.0437	22.90	.99905	30	30	.1822	.1853	5.396	.98325	30
40	.0465	.0466	21.47	.99892	20	40	.1851	.1883	5.309	.98272	20
50	.0494	.0495	20.21	.99878	10	50	.1880	.1914	5.226	.98218	10
3	.0523	.0524	19.08	.99863	87	11	.1908	.1944	5.145	.98163	79
10	.0552	.0553	18.07	.99847	50	10	.1937	.1974	5.066	.98107	50
20	.0581	.0582	17.17	.99831	40	20	.1965	.2004	4.989	.98050	40
30	.0610	.0612	16.35	.99813	30	30	.1994	.2035	4.915	.97992	30
40	.0640	.0641	15.60	.99795	20	40	.2022	.2065	4.843	.97934	20
50	.0669	.0670	14.92	.99776	10	50	.2051	.2095	4.773	.97875	10
4	.0698	.0699	14.30	.99756	86	12	.2079	.2126	4.705	.97815	78
10	.0727	.0729	13.73	.99736	50	10	.2108	.2156	4.638	.97754	50
20	.0756	.0758	13.20	.99714	40	20	.2136	.2186	4.574	.97692	40
30	.0785	.0787	12.71	.99692	30	30	.2164	.2217	4.511	.97630	30
40	.0814	.0816	12.25	.99668	20	40	.2193	.2247	4.449	.97566	20
50	.0843	.0846	11.83	.99644	10	50	.2221	.2278	4.390	.97502	10
5	.0872	.0875	11.43	.99619	85	13	.2250	.2309	4.331	.97437	77
10	.0901	.0904	11.06	.99594	50	10	.2278	.2339	4.275	.97371	50
20	.0929	.0934	10.71	.99567	40	20	.2306	.2370	4.219	.97304	40
30	.0958	.0963	10.39	.99540	30	30	.2334	.2401	4.165	.97237	30
40	.0987	.0992	10.08	.99511	20	40	.2363	.2432	4.113	.97169	20
50	.1016	.1022	9.788	.99482	10	50	.2391	.2462	4.061	.97100	10
6	.1045	.1051	9.514	.99452	84	14	.2419	.2493	4.011	.97030	76
10	.1074	.1080	9.255	.99421	50	10	.2447	.2524	3.962	.96959	50
20	.1103	.1110	9.010	.99390	40	20	.2476	.2555	3.914	.96887	40
30	.1132	.1139	8.777	.99357	30	30	.2504	.2586	3.867	.96815	30
40	.1161	.1169	8.556	.99324	20	40	.2532	.2617	3.821	.96742	20
50	.1190	.1198	8.345	.99290	10	50	.2560	.2648	3.776	.96667	10
7	.1219	.1228	8.144	.99255	83	15	.2588	.2679	3.732	.96593	75
10	.1248	.1257	7.953	.99219	50	10	.2616	.2711	3.689	.96517	50
20	.1276	.1287	7.770	.99182	40	20	.2644	.2742	3.647	.96440	40
30	.1305	.1317	7.596	.99144	30	30	.2672	.2773	3.606	.96363	30
40	.1334	.1346	7.429	.99106	20	40	.2700	.2805	3.566	.96285	20
50	.1363	.1376	7.269	.99067	10	50	.2728	.2836	3.526	.96206	10
					82						74
	Cosin.	Cotg.	Tan.	Sine.	Angle.		Cosin.	Cotg.	Tan.	Sine.	Angle.

TABLE VIII.—NATURAL TRIGONOMETRICAL FUNCTIONS.

Angle	Sine.	Tan.	Cotg.	Cosin.		Angle	Sine.	Tan.	Cotg.	Cosin.	
<i>or</i> 16	.2756	.2867	3.487	.96126	74	<i>or</i> 24	.4067	.4452	2.246	.91355	66
10	.2784	.2899	3.450	.96046	50	10	.4094	.4487	2.229	.91236	50
20	.2812	.2931	3.412	.95964	40	20	.4120	.4522	2.211	.91116	40
30	.2840	.2962	3.376	.95882	30	30	.4147	.4557	2.194	.90996	30
40	.2868	.2994	3.340	.95799	20	40	.4173	.4592	2.177	.90875	20
50	.2896	.3026	3.305	.95715	10	50	.4200	.4628	2.161	.90753	10
17	.2924	.3057	3.271	.95615	73	25	.4226	.4663	2.145	.90631	65
10	.2952	.3089	3.237	.95545	50	10	.4253	.4699	2.128	.90507	50
20	.2979	.3121	3.204	.95459	40	20	.4279	.4734	2.112	.90383	40
30	.3007	.3153	3.172	.95372	30	30	.4305	.4770	2.097	.90259	30
40	.3035	.3185	3.140	.95284	20	40	.4331	.4806	2.081	.90133	20
50	.3062	.3217	3.108	.95195	10	50	.4358	.4841	2.066	.90007	10
18	.3090	.3249	3.078	.95106	72	26	.4384	.4877	2.050	.89879	64
10	.3118	.3281	3.048	.95015	50	10	.4410	.4913	2.035	.89752	50
20	.3145	.3314	3.018	.94924	40	20	.4436	.4950	2.020	.89623	40
30	.3173	.3346	2.989	.94832	30	30	.4462	.4986	2.006	.89493	30
40	.3201	.3378	2.960	.94740	20	40	.4488	.5022	1.991	.89363	20
50	.3228	.3411	2.932	.94646	10	50	.4514	.5059	1.977	.89232	10
19	.3256	.3443	2.904	.94552	71	27	.4540	.5095	1.963	.89101	63
10	.3283	.3476	2.877	.94457	50	10	.4566	.5132	1.949	.88968	50
20	.3311	.3508	2.850	.94361	40	20	.4592	.5169	1.935	.88835	40
30	.3338	.3541	2.824	.94264	30	30	.4617	.5206	1.921	.88701	30
40	.3365	.3574	2.798	.94167	20	40	.4643	.5243	1.907	.88566	20
50	.3393	.3607	2.773	.94068	10	50	.4669	.5280	1.894	.88431	10
20	.3420	.3640	2.747	.93969	70	28	.4695	.5317	1.881	.88295	62
10	.3448	.3673	2.723	.93869	50	10	.4720	.5354	1.868	.88158	50
20	.3475	.3706	2.669	.93769	40	20	.4746	.5392	1.855	.88020	40
30	.3502	.3739	2.675	.93667	30	30	.4772	.5430	1.842	.87882	30
40	.3529	.3772	2.651	.93565	20	40	.4797	.5467	1.829	.87743	20
50	.3557	.3805	2.628	.93462	10	50	.4823	.5505	1.816	.87603	10
21	.3584	.3839	2.605	.93358	69	29	.4848	.5543	1.804	.87462	61
10	.3611	.3872	2.583	.93253	50	10	.4874	.5581	1.792	.87321	50
20	.3638	.3906	2.560	.93148	40	20	.4899	.5619	1.780	.87178	40
30	.3665	.3939	2.539	.93042	30	30	.4924	.5658	1.767	.87036	30
40	.3692	.3973	2.517	.92935	20	40	.4950	.5696	1.756	.86892	20
50	.3719	.4006	2.496	.92827	10	50	.4975	.5735	1.744	.86748	10
22	.3746	.4040	2.475	.92718	68	30	.5000	.5774	1.732	.86603	60
10	.3773	.4074	2.455	.92609	50	10	.5025	.5812	1.720	.86457	50
20	.3800	.4108	2.434	.92499	40	20	.5050	.5851	1.709	.86310	40
30	.3827	.4142	2.414	.92388	30	30	.5075	.5890	1.698	.86163	30
40	.3854	.4176	2.394	.92276	20	40	.5100	.5930	1.686	.86015	20
50	.3881	.4210	2.375	.92164	10	50	.5125	.5969	1.675	.85866	10
23	.3907	.4245	2.356	.92050	67	31	.5150	.6009	1.664	.85717	59
10	.3934	.4279	2.337	.91936	50	10	.5175	.6048	1.653	.85567	50
20	.3961	.4314	2.318	.91822	40	20	.5200	.6088	1.643	.85416	40
30	.3987	.4348	2.300	.91706	30	30	.5225	.6128	1.632	.85264	30
40	.4014	.4383	2.282	.91590	20	40	.5250	.6168	1.621	.85112	20
50	.4041	.4417	2.264	.91472	10	50	.5275	.6208	1.611	.84959	10
					66						58
	Cosin.	Cotg.	Tan.	Sine.	Angle.		Cosin.	Cotg.	Tan.	Sine.	Angle.

TABLE VIII.—NATURAL TRIGONOMETRICAL FUNCTIONS.

Angle	Sine.	Tan.	Cotg.	Cosin.		Angle	Sine.	Tan.	Cotg.	Cosin.	
or						or					
32	.5299	.6249	1.600	.84805	58	30	.6225	.7954	1.257	.78261	
10	.5324	.6289	1.590	.84650	50	40	.6248	.8002	1.250	.78079	
20	.5348	.6330	1.580	.84495	40	50	.6271	.8050	1.242	.77897	
30	.5373	.6371	1.570	.84339	30						
40	.5398	.6412	1.560	.84182	20	39	.6293	.8098	1.235	.77715	
50	.5422	.6453	1.550	.84025	10	10	.6316	.8146	1.228	.77531	
						20	.6338	.8195	1.220	.77347	
33	.5446	.6494	1.540	.83867	57	30	.6361	.8243	1.213	.77162	
10	.5471	.6536	1.530	.83708	50	40	.6383	.8292	1.206	.76977	
20	.5495	.6577	1.520	.83549	40	50	.6406	.8342	1.199	.76791	
30	.5519	.6619	1.511	.83389	30						
40	.5544	.6661	1.501	.83228	20	40	.6428	.8391	1.192	.76604	
50	.5568	.6703	1.492	.83066	10	10	.6450	.8441	1.185	.76417	
						20	.6472	.8491	1.178	.76229	
34	.5592	.6745	1.483	.82904	56	30	.6494	.8541	1.171	.76041	
10	.5616	.6787	1.473	.82741	50	40	.6517	.8591	1.164	.75851	
20	.5640	.6830	1.464	.82577	40	50	.6539	.8642	1.157	.75661	
30	.5664	.6873	1.455	.82413	30						
40	.5688	.6916	1.446	.82248	20	41	.6561	.8693	1.150	.75471	
50	.5712	.6959	1.437	.82082	10	10	.6583	.8744	1.144	.75280	
						20	.6604	.8796	1.137	.75088	
35	.5736	.7002	1.428	.81915	55	30	.6626	.8847	1.130	.74896	
10	.5760	.7046	1.419	.81748	50	40	.6648	.8899	1.124	.74703	
20	.5783	.7089	1.411	.81580	40	50	.6670	.8952	1.117	.74509	
30	.5807	.7133	1.402	.81412	30						
40	.5831	.7177	1.393	.81242	20	42	.6691	.9004	1.111	.74314	
50	.5854	.7221	1.385	.81072	10	10	.6713	.9057	1.104	.74120	
						20	.6734	.9110	1.098	.73924	
36	.5878	.7265	1.376	.80902	54	30	.6756	.9163	1.091	.73728	
10	.5901	.7310	1.368	.80730	50	40	.6777	.9217	1.085	.73531	
20	.5925	.7355	1.360	.80558	40	50	.6799	.9271	1.079	.73333	
30	.5948	.7400	1.351	.80386	30						
40	.5972	.7445	1.343	.80212	20	43	.6820	.9325	1.072	.73135	
50	.5995	.7490	1.335	.80038	10	10	.6841	.9380	1.066	.72937	
						20	.6862	.9435	1.060	.72737	
37	.6018	.7536	1.327	.79864	53	30	.6884	.9490	1.054	.72537	
10	.6041	.7581	1.319	.79688	50	40	.6905	.9545	1.048	.72337	
20	.6065	.7627	1.311	.79512	40	50	.6926	.9601	1.042	.72136	
30	.6088	.7673	1.303	.79335	30						
40	.6111	.7720	1.295	.79158	20	44	.6947	.9657	1.036	.71934	
50	.6134	.7766	1.288	.78980	10	10	.6967	.9713	1.030	.71732	
						20	.6988	.9770	1.024	.71529	
38	.6157	.7813	1.280	.78801	52	30	.7009	.9827	1.018	.71325	
10	.6180	.7860	1.272	.78622	50	40	.7030	.9884	1.012	.71121	
20	.6202	.7907	1.265	.78442	40	50	.7050	.9942	1.006	.70916	
							.7071	1.	1.	.70711	
										or	
	Cosin.	Cotg.	Tan.	Sine.	Angle.		Cosin.	Cotg.	Tan.	Sine.	Angle.

TABLE IX.—CALCULATION OF EARTHWORK.


Width	HEIGHT														
	1	2	3	4	5	6	7	8	9	10	11	12	13	14	15
1	.02	.04	.06	.07	.09	.11	.13	.15	.17	.18	.20	.22	.24	.26	.28
2	.04	.07	.11	.15	.18	.22	.26	.30	.33	.37	.41	.44	.48	.52	.56
3	.06	.11	.17	.22	.28	.33	.39	.44	.50	.56	.61	.67	.72	.78	.83
4	.07	.15	.22	.30	.37	.44	.52	.59	.67	.74	.81	.89	.96	1.04	1.11
5	.09	.19	.28	.37	.46	.56	.65	.74	.83	.93	1.02	1.11	1.20	1.30	1.39
6	.11	.22	.33	.44	.56	.67	.78	.89	1.00	1.11	1.22	1.33	1.44	1.55	1.67
7	.13	.26	.39	.52	.65	.78	.91	1.04	1.16	1.30	1.42	1.55	1.68	1.81	1.94
8	.15	.30	.44	.59	.74	.89	1.04	1.19	1.33	1.48	1.63	1.78	1.92	2.08	2.22
9	.17	.33	.50	.67	.83	1.00	1.17	1.33	1.50	1.67	1.83	2.00	2.17	2.33	2.50
10	.18	.37	.56	.74	.93	1.11	1.30	1.48	1.67	1.85	2.04	2.22	2.41	2.59	2.78
11	.20	.41	.61	.82	1.02	1.22	1.43	1.63	1.83	2.04	2.24	2.44	2.65	2.85	3.06
12	.22	.44	.67	.89	1.11	1.33	1.56	1.78	2.00	2.22	2.44	2.67	2.89	3.11	3.33
13	.24	.48	.72	.96	1.20	1.44	1.68	1.92	2.16	2.41	2.65	2.89	3.13	3.37	3.61
14	.26	.52	.78	1.04	1.30	1.55	1.81	2.08	2.33	2.59	2.85	3.11	3.37	3.63	3.89
15	.28	.56	.83	1.11	1.39	1.67	1.94	2.22	2.50	2.78	3.06	3.33	3.61	3.89	4.17
16	.30	.59	.89	1.18	1.48	1.78	2.07	2.37	2.67	2.96	3.26	3.56	3.85	4.15	4.44
17	.31	.63	.94	1.26	1.57	1.89	2.20	2.52	2.83	3.15	3.46	3.78	4.09	4.41	4.72
18	.33	.67	1.00	1.33	1.67	2.00	2.33	2.67	3.00	3.33	3.67	4.00	4.33	4.67	5.00
19	.35	.70	1.06	1.41	1.76	2.11	2.46	2.82	3.17	3.52	3.87	4.22	4.57	4.92	5.28
20	.37	.74	1.11	1.48	1.85	2.22	2.59	2.96	3.33	3.70	4.07	4.44	4.81	5.18	5.56
21	.39	.78	1.17	1.55	1.94	2.33	2.72	3.11	3.50	3.89	4.28	4.67	5.06	5.44	5.83
22	.41	.81	1.22	1.63	2.04	2.44	2.85	3.26	3.67	4.07	4.48	4.89	5.30	5.70	6.11
23	.43	.85	1.28	1.70	2.13	2.56	2.98	3.41	3.83	4.26	4.68	5.11	5.54	5.96	6.39
24	.44	.89	1.33	1.78	2.22	2.67	3.11	3.56	4.00	4.44	4.89	5.33	5.78	6.22	6.67
25	.46	.92	1.39	1.85	2.31	2.78	3.24	3.70	4.17	4.63	5.09	5.56	6.02	6.48	6.94
26	.48	.96	1.44	1.92	2.41	2.89	3.37	3.85	4.33	4.82	5.30	5.78	6.26	6.74	7.24
27	.50	1.00	1.50	2.00	2.50	3.00	3.50	4.00	4.50	5.00	5.50	6.00	6.50	7.00	7.50
28	.52	1.04	1.55	2.07	2.59	3.11	3.63	4.15	4.67	5.18	5.70	6.22	6.74	7.26	7.78
29	.54	1.07	1.61	2.15	2.68	3.22	3.76	4.30	4.83	5.37	5.91	6.44	6.98	7.52	8.06
30	.56	1.11	1.67	2.22	2.78	3.33	3.89	4.44	5.00	5.55	6.11	6.67	7.22	7.78	8.33
31	.57	1.15	1.72	2.30	2.87	3.44	4.02	4.59	5.17	5.74	6.32	6.89	7.46	8.04	8.61
32	.59	1.18	1.78	2.37	2.96	3.56	4.15	4.74	5.33	5.92	6.52	7.11	7.70	8.30	8.89
33	.61	1.22	1.83	2.44	3.05	3.67	4.28	4.89	5.50	6.11	6.72	7.33	7.94	8.55	9.17
34	.63	1.26	1.89	2.52	3.15	3.78	4.40	5.04	5.67	6.29	6.93	7.56	8.18	8.81	9.44
35	.65	1.30	1.94	2.59	3.24	3.89	4.53	5.18	5.83	6.48	7.13	7.78	8.42	9.08	9.72
36	.67	1.33	2.00	2.67	3.33	4.00	4.66	5.33	6.00	6.67	7.33	8.00	8.67	9.33	10.00
37	.68	1.37	2.06	2.74	3.42	4.11	4.79	5.48	6.17	6.85	7.54	8.22	8.91	9.59	10.28
38	.70	1.41	2.11	2.82	3.52	4.22	4.92	5.63	6.33	7.03	7.74	8.44	9.15	9.85	10.56
39	.72	1.44	2.17	2.89	3.61	4.33	5.05	5.78	6.50	7.22	7.95	8.67	9.39	10.11	10.83
40	.74	1.48	2.22	2.96	3.70	4.44	5.18	5.92	6.67	7.41	8.15	8.89	9.63	10.37	11.11


Table gives cu. yds. in 1 ft. of a triangle of given width and height. Corrections for tenths of width are one tenth the values found under each height considering the widths from 1 to 9 as tenths and similarly the corrections for tenths of height are one tenth the figures opposite width considering the heights from 1 to 9 as tenths. Thus if $w = 16.2$ and $h = 5.3$, cu. yds. $= 1.48 + .028 + .089 = 1.597$ cu. yds. or practically 160 cu. yds. per 100 ft. If w exceeds 40 ft., use one half and multiply result by 2, if both w and h are large use one half of each and multiply result by 4. Any cross-section may be divided into triangles by the following rule. To the triangle of the sum of the outside cuts (or fills) $= h$, and $\frac{1}{2}$ the roadbed $= w$, add the triangles formed by taking the distance out to each break in turn ($= w$'s) by the difference between the cuts (or fills) on each side of it ($= h$'s) always subtracting the outer from the inner.

DIAGRAM FOR OBTAINING HORIZONTAL AND VERTICAL DISTANCES FROM STADIA READINGS

Enter on the horizontal scale with the value of the stadia reading or interval times the stadia constant (usually taken as 100) and run vertically upward to intersection with line representing the vertical angle. The location of this point with reference to the dotted line marked "ONE," etc., gives the correction to be subtracted from the entering value and to which " $f+c$ " (usually about 1 ft.) must be added to obtain the Horizontal Distance. The reading on vertical scale plus about 0.1 ft. for each 5° of vertical angle [$-(f+c \text{ Sino})$] is the Vertical Distance.


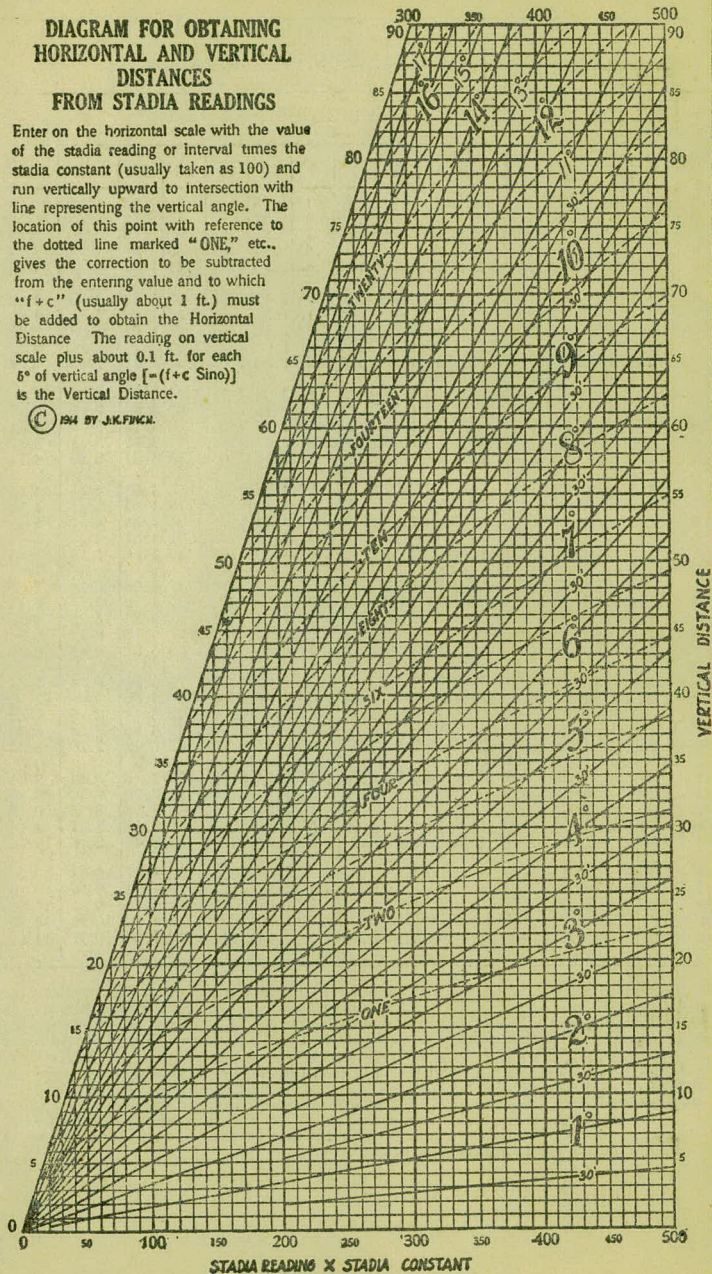

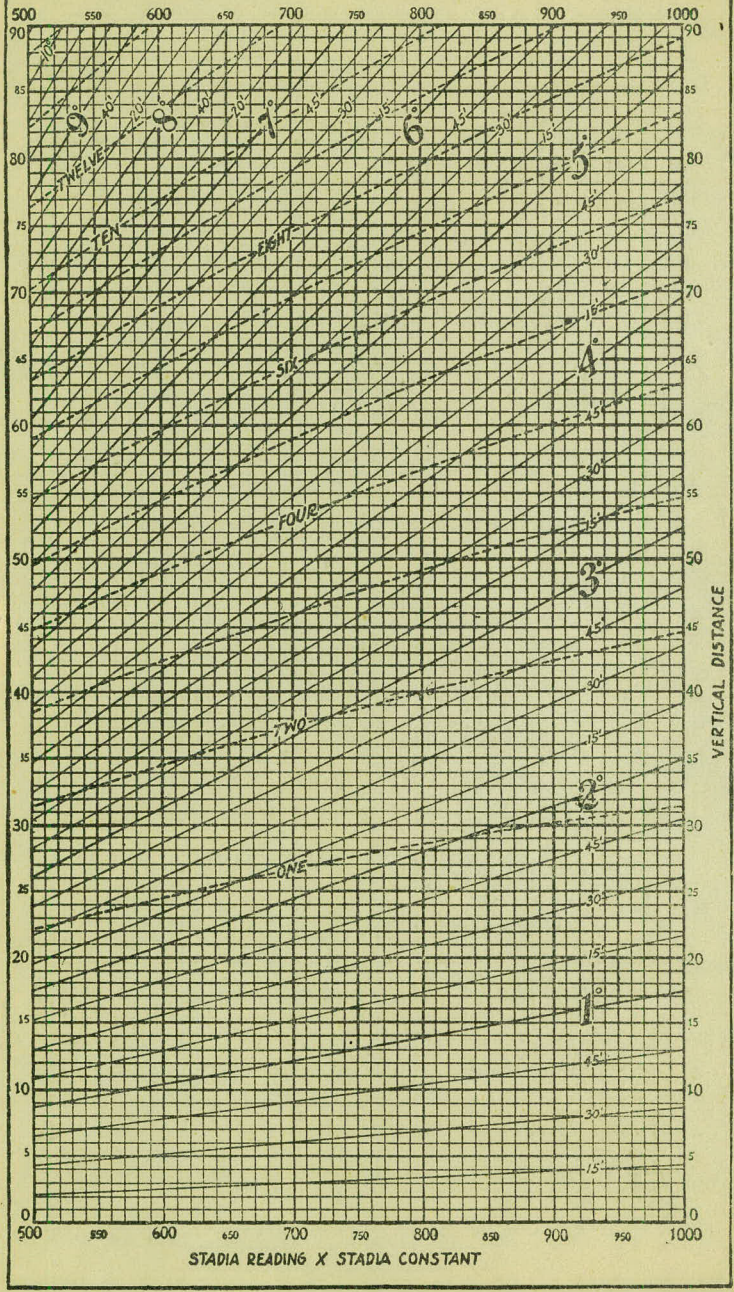

STADIA READING X STADIA CONSTANT

VERTICAL DISTANCE

U2493

458
18
3664
458
8.222

165) 6.00
5.94
96

62) 284 458
248
360
310
500
496

100) .300
003

18) 458
62
916
.003
278
45.628396
45.4

900.46
12.41
877.91
99
888.90
13.22
875.64
2.17
879.41
11.26
867.99
1.65
869.67
12.80
856.82
3.37
860.19
51.46
808.73

458
100
45.800

45.5
45.4
45.3




2540
284
284
248
540

32
.002
.064
2589
65) 17.6
12.6
400
340
600
544
560
544
16

21400
33
40
39

20400
33
464
33

6440

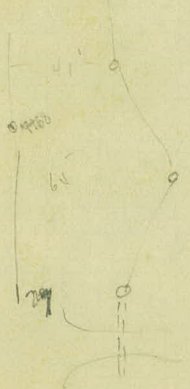

139) .200
138
620
552
680
832
142
690
880
552
128

10
05
50

8458

100
.005
1000

258

100144
68
1152
864
09792

284
.62
19568
1904
19608
866
17.6
69.0

866
157
70.9

14400

45.5
45.26

284
14
568
285
34.18

142
32
17.6

214
100
29400

2493

PROJECT #26-54
LEVELS

INVESTIGATION SURVEY OF
DRAINAGE.

JULY - 28 - 27.

Received 7.30.27
O. J. Van Liew

file

Plotted 7/30/27
O. J. Van Liew

STA.	B.S.	H.I.	F.S.	ELEV.
	DITCH ON SOUTH SIDE OF ROAD			
	6.46	857.92		851.46

0+00

1+00

1+85

2+00

3+00

4+65

DITCH ON NORTH SIDE OF ROAD.

0+00

1+00

2+00

3+00

T.P. B.M.	7.03	858.49	6.46	851.46
T.P.	4.37	858.92	3.94	854.55
T.P.	3.89	861.05	1.76	857.16
T.P.	2.72	851.36	12.41	848.64
T.P.	2.08	850.44	3.00	848.36
T.P.			3.14	847.30

A.L.D. LT.
W.G.A. 7-28-27
M.A.B.

♀
DITCH

RT.

T.P. LT. STA. 22+45

				♀ SIDE DITCH					
INLET	11.7	11.9	12.3	11.7	10.1	11.2	11.4	10.3	8.8
	12.0	121	100	55	88	100	130	200	250

12.1

				FIELD		
11.8	$\frac{11.5}{100}$	$\frac{10.1}{200}$	$\frac{9.0}{250}$			

11.9	$\frac{11.6}{5}$	$\frac{11.4}{100}$	$\frac{10.0}{200}$	$\frac{8.9}{250}$				
------	------------------	--------------------	--------------------	-------------------	--	--	--	--

10.8	$\frac{10.6}{5}$	$\frac{10.7}{100}$	$\frac{9.2}{180}$						
------	------------------	--------------------	-------------------	--	--	--	--	--	--

10.1	$\frac{9.4}{100}$	$\frac{8.5}{165}$	$\frac{7.4}{185}$						
------	-------------------	-------------------	-------------------	--	--	--	--	--	--

				♀ SIDE DITCH		
12.1	$\frac{12.7}{90}$	$\frac{12.2}{121}$	12.65	OUTLET		

13.0

13.1


13.2

15.9 Δ DITCH

24" C.M. NEW. 6.83

18" VIT. OLD. 8.20

NAIL T.P. N.W. COR. WHEELOCK & MARION ST.

 

CHECK LEVELS.

#26-54

	B.S.	H.I.	F.S.	ELEV.
--	------	------	------	-------

T.P.	5.27	852.57		847.30
------	------	--------	--	--------

T.P.	5.13	852.39	5.31	847.26
------	------	--------	------	--------


T.P.	12.03	864.30	0.12	852.27
------	-------	--------	------	--------

T.P.	6.35	857.44	13.21	851.09
------	------	--------	-------	--------

B.M.			5.99	851.45 851.46
------	--	--	------	---------------

NAIL IN T.P. N.W. COR. WHEELOCK & MARION ST.

SPIKE IN T.P. LT. STA. 22 + 45 (851.46)

 

842.0

DITCH

$\frac{3400}{844.7}$

$\frac{2400}{844.8}$

$\frac{1700}{844.9}$

845.2 845.7 OUTLET
 $\frac{20'}{845.27}$

$\frac{845.8}{845.8}$

LARRCUTOFF

INLET

$\frac{845.6}{845.72}$
 $\frac{846.0}{846.2}$
 $\frac{12.7}{12.7}$

849.1 847.6 846.5 846.7 847.8 846.2
 $\frac{200'}{847.9}$ $\frac{130'}{847.8}$ $\frac{100'}{846.5}$ $\frac{88'}{846.2}$ $\frac{85'}{847.8}$

$\frac{1700}{845.8}$

$\frac{848.9}{180'}$ 847.8 $\frac{846.4}{100'}$ DITCH

$\frac{847.0}{200'}$ 847.9 $\frac{846.5}{100'}$

$\frac{3700}{847.1}$

FENCE $\frac{848.7}{180'}$ 847.2 $\frac{100'}$

$\frac{4765}{847.8}$

$\frac{850.5}{185'}$ 849.4 $\frac{848.5}{165'}$ $\frac{100'}$


IN. OLD 842.24
IN. NEW 843.67

18" VIT
24" C.M.

MARION STREET

WHEELOCK PKWY.



 

DISTANCES FROM CENTER OF ROADWAY FOR CROSS-SECTIONING.

Roadway 16 feet wide. Side Slopes 1 on 1½.
For Single Track Embankment.

H	0	.1	.2	.3	.4	.5	.6	.7	.8	.9	H
0	8.0	8.2	8.3	8.5	8.6	8.8	8.9	9.1	9.2	9.4	0
1	9.5	9.7	9.8	10.0	10.1	10.3	10.4	10.6	10.7	10.9	1
2	11.0	11.2	11.3	11.5	11.6	11.8	11.9	12.1	12.2	12.4	2
3	12.5	12.7	12.8	13.0	13.1	13.3	13.4	13.6	13.7	13.9	3
4	14.0	14.2	14.3	14.5	14.6	14.8	14.9	15.1	15.2	15.4	4
5	15.5	15.7	15.8	16.0	16.1	16.3	16.4	16.6	16.7	16.9	5
6	17.0	17.2	17.3	17.5	17.6	17.8	17.9	18.1	18.2	18.4	6
7	18.5	18.7	18.8	19.0	19.1	19.3	19.4	19.6	19.7	19.9	7
8	20.0	20.2	20.3	20.5	20.6	20.8	20.9	21.1	21.2	21.4	8
9	21.5	21.7	21.8	22.0	22.1	22.3	22.4	22.6	22.7	22.9	9
10	23.0	23.2	23.3	23.5	23.6	23.8	23.9	24.1	24.2	24.4	10
11	24.5	24.7	24.8	25.0	25.1	25.3	25.4	25.6	25.7	25.9	11
12	26.0	25.2	26.3	26.5	26.6	26.8	26.9	27.1	27.2	27.4	12
13	27.5	27.7	27.8	28.0	28.1	28.3	28.4	28.6	28.7	28.9	13
14	29.0	29.2	29.3	29.5	29.6	29.8	29.9	30.1	30.2	30.4	14
15	30.5	30.7	30.8	31.0	31.1	31.3	31.4	31.6	31.7	31.9	15
16	32.0	32.2	32.3	32.5	32.6	32.8	32.9	33.1	33.2	33.4	16
17	33.5	33.7	33.8	34.0	34.1	34.3	34.4	34.6	34.7	34.9	17
18	35.0	35.2	35.3	35.5	35.6	35.8	35.9	36.1	36.2	36.4	18
19	36.5	36.7	36.8	37.0	37.1	37.3	37.4	37.6	37.7	37.9	19
20	38.0	38.2	38.3	38.5	38.6	38.8	38.9	39.1	39.2	39.4	20
21	39.5	39.7	39.8	40.0	40.1	40.3	40.4	40.6	40.7	40.9	21
22	41.0	41.2	41.3	41.5	41.6	41.8	41.9	42.1	42.2	42.4	22
23	42.5	42.7	42.8	43.0	43.1	43.3	43.4	43.6	43.7	43.9	23
24	44.0	44.2	44.3	44.5	44.6	44.8	44.9	45.1	45.2	45.4	24
25	45.5	45.7	45.8	46.0	46.1	46.3	46.4	46.6	46.7	46.9	25
26	47.0	47.2	47.3	47.5	47.6	47.8	47.9	48.1	48.2	48.4	26
27	48.5	48.7	48.8	49.0	49.1	49.3	49.4	49.6	49.7	49.9	27
28	50.0	50.2	50.3	50.5	50.6	50.8	50.9	51.1	51.2	51.4	28
29	51.5	51.7	51.8	52.0	52.1	52.3	52.4	52.6	52.7	52.9	29
30	53.0	53.2	53.3	53.5	53.6	53.8	53.9	54.1	54.2	54.4	30
31	54.5	54.7	54.8	55.0	55.1	55.3	55.4	55.6	55.7	55.9	31
32	56.0	56.2	56.3	56.5	56.6	56.8	56.9	57.1	57.2	57.4	32
33	57.5	57.7	57.8	58.0	58.1	58.3	58.4	58.6	58.7	58.9	33
34	59.0	59.2	59.3	59.5	59.6	59.8	59.9	60.1	60.2	60.4	34
35	60.5	60.7	60.8	61.0	61.1	61.3	61.4	61.6	61.7	61.9	35
36	62.0	62.2	62.3	62.5	62.6	62.8	62.9	63.1	63.2	63.4	36
37	63.5	63.7	63.8	64.0	64.1	64.3	64.4	64.6	64.7	64.9	37
38	65.0	65.2	65.3	65.5	65.6	65.8	65.9	66.1	66.2	66.4	38
39	66.5	66.7	66.8	67.0	67.1	67.3	67.4	67.6	67.7	67.9	39
40	68.0	68.2	68.3	68.5	68.6	68.8	68.9	69.1	69.2	69.4	40

Example—If point is 22.6 ft. above grade, how far should it be from center line to be a slope stake point? Ans. from Table 41.9. For same slopes but other widths of roadbed correct above figures by one-half difference in width of roadbed; thus in example above for 20 ft. roadbed distance will be $41.9 + (20 - 16) \div 2$ or 2 ft. added to $41.9 = 43.9$. For slopes of 1 on 1 see inside of front cover.