

OFFICE OF COUNTY ENGINEER  
RAMSEY CO. MINN.

# FINAL CROSS SECTIONS

ANOKA CUT-OFF

PROJ. No 26-62

---

FIELD BOOK

810 A

---

DIV. A.

10-10-27

5

# KEUFFEL & ESSER CO.

## DRAWING MATERIALS AND SURVEYING INSTRUMENTS. NEW YORK.

CHICAGO. ST. LOUIS. SAN FRANCISCO. MONTREAL.

### TABLES FOR EXCAVATIONS AND EMBANKMENTS.

DISTANCES FROM CENTER OF ROADWAY FOR CROSS-SECTIONING.  
ROADWAY 18 FEET WIDE. SIDE SLOPES 1 TO 1.  
FOR SINGLE TRACK EXCAVATION.

*"Copyright, 1895, by Keuffel & Esser Co."*

	0	.1	.2	.3	.4	.5	.6	.7	.8	.9	
0	9.0	9.1	9.2	9.3	9.4	9.5	9.6	9.7	9.8	9.9	0
1	10.0	10.1	10.2	10.3	10.4	10.5	10.6	10.7	10.8	10.9	1
2	11.0	11.1	11.2	11.3	11.4	11.5	11.6	11.7	11.8	11.9	2
3	12.0	12.1	12.2	12.3	12.4	12.5	12.6	12.7	12.8	12.9	3
4	13.0	13.1	13.2	13.3	13.4	13.5	13.6	13.7	13.8	13.9	4
5	14.0	14.1	14.2	14.3	14.4	14.5	14.6	14.7	14.8	14.9	5
6	15.0	15.1	15.2	15.3	15.4	15.5	15.6	15.7	15.8	15.9	6
7	16.0	16.1	16.2	16.3	16.4	16.5	16.6	16.7	16.8	16.9	7
8	17.0	17.1	17.2	17.3	17.4	17.5	17.6	17.7	17.8	17.9	8
9	18.0	18.1	18.2	18.3	18.4	18.5	18.6	18.7	18.8	18.9	9
10	19.0	19.1	19.2	19.3	19.4	19.5	19.6	19.7	19.8	19.9	10
11	20.0	20.1	20.2	20.3	20.4	20.5	20.6	20.7	20.8	20.9	11
12	21.0	21.1	21.2	21.3	21.4	21.5	21.6	21.7	21.8	21.9	12
13	22.0	22.1	22.2	22.3	22.4	22.5	22.6	22.7	22.8	22.9	13
14	23.0	23.1	23.2	23.3	23.4	23.5	23.6	23.7	23.8	23.9	14
15	24.0	24.1	24.2	24.3	24.4	24.5	24.6	24.7	24.8	24.9	15
16	25.0	25.1	25.2	25.3	25.4	25.5	25.6	25.7	25.8	25.9	16
17	26.0	26.1	26.2	26.3	26.4	26.5	26.6	26.7	26.8	26.9	17
18	27.0	27.1	27.2	27.3	27.4	27.5	27.6	27.7	27.8	27.9	18
19	28.0	28.1	28.2	28.3	28.4	28.5	28.6	28.7	28.8	28.9	19
20	29.0	29.1	29.2	29.3	29.4	29.5	29.6	29.7	29.8	29.9	20
21	30.0	30.1	30.2	30.3	30.4	30.5	30.6	30.7	30.8	30.9	21
22	31.0	31.1	31.2	31.3	31.4	31.5	31.6	31.7	31.8	31.9	22
23	32.0	32.1	32.2	32.3	32.4	32.5	32.6	32.7	32.8	32.9	23
24	33.0	33.1	33.2	33.3	33.4	33.5	33.6	33.7	33.8	33.9	24
25	34.0	34.1	34.2	34.3	34.4	34.5	34.6	34.7	34.8	34.9	25
26	35.0	35.1	35.2	35.3	35.4	35.5	35.6	35.7	35.8	35.9	26
27	36.0	36.1	36.2	36.3	36.4	36.5	36.6	36.7	36.8	36.9	27
28	37.0	37.1	37.2	37.3	37.4	37.5	37.6	37.7	37.8	37.9	28
29	38.0	38.1	38.2	38.3	38.4	38.5	38.6	38.7	38.8	38.9	29
30	39.0	39.1	39.2	39.3	39.4	39.5	39.6	39.7	39.8	39.9	30
31	40.0	40.1	40.2	40.3	40.4	40.5	40.6	40.7	40.8	40.9	31
32	41.0	41.1	41.2	41.3	41.4	41.5	41.6	41.7	41.8	41.9	32
33	42.0	42.1	42.2	42.3	42.4	42.5	42.6	42.7	42.8	42.9	33
34	43.0	43.1	43.2	43.3	43.4	43.5	43.6	43.7	43.8	43.9	34
35	44.0	44.1	44.2	44.3	44.4	44.5	44.6	44.7	44.8	44.9	35
36	45.0	45.1	45.2	45.3	45.4	45.5	45.6	45.7	45.8	45.9	36

Calculated by Julien A. Hall, M. Am. Soc. C. E.

For Keith's Railroad Curve Tables see end of book.

# Index.

	Page
171+65	
216+34 Final Xsections	1-16
171+65	
308+80 Final Xsections	1-40
267+25	
268+35 Final Xsection Under Pass	84-85
171+60-301+85 Final Topography	40-62
Drive Ways	63'

Sta	+	HI	-	Elev
B.M.	4.75	922.01.		917.26
171+00				14.5
	+65			15.1
172				15.5
	+56			16.1
173				16.5
174				17.5
175				18.1
	+50			18.1
176				18.0
	+50			17.8
177				17.5

spike in 24" Oak 50' Lt Sta 172+33

(6.9)

+05 Beg Ditch

$\frac{7.8}{33}$	$\frac{8.4}{25}$	$\frac{6.6}{20}$	$\frac{6.5}{20}$	$\frac{8.8}{33}$
------------------	------------------	------------------	------------------	------------------

+00 Beg Ditch

(6.5)

$\frac{8.0}{33}$	$\frac{8.5}{25}$	$\frac{6.1}{20}$	$\frac{6.0}{20}$	$\frac{6.2}{20}$	$\frac{8.2}{25}$	$\frac{8.5}{29}$	$\frac{7.5}{30}$	$\frac{7.0}{33}$
------------------	------------------	------------------	------------------	------------------	------------------	------------------	------------------	------------------

(5.9)

$\frac{3.2}{33}$	$\frac{7.4}{28}$	$\frac{7.1}{24}$	$\frac{5.7}{20}$	$\frac{5.5}{20}$	$\frac{5.6}{20}$	$\frac{7.1}{24}$	$\frac{7.4}{29}$	$\frac{4.8}{31}$	$\frac{4.5}{33}$
------------------	------------------	------------------	------------------	------------------	------------------	------------------	------------------	------------------	------------------

(5.5)

$\frac{2.1}{33}$	$\frac{7.1}{27}$	$\frac{6.5}{23}$	$\frac{5.3}{20}$	$\frac{5.5}{20}$	$\frac{7.0}{23}$	$\frac{7.2}{27}$	$\frac{4.3}{30}$	$\frac{4.0}{33}$
------------------	------------------	------------------	------------------	------------------	------------------	------------------	------------------	------------------

(4.5)

$\frac{1.5}{33}$	$\frac{6.7}{28}$	$\frac{6.2}{23}$	$\frac{4.8}{20}$	$\frac{4.7}{20}$	$\frac{4.8}{20}$	$\frac{6.4}{23}$	$\frac{6.6}{27}$	$\frac{2.5}{31}$	$\frac{1.8}{33}$
------------------	------------------	------------------	------------------	------------------	------------------	------------------	------------------	------------------	------------------

(3.9)

$\frac{1.7}{33}$	$\frac{6.3}{29}$	$\frac{5.6}{24}$	$\frac{4.4}{20}$	$\frac{4.4}{20}$	$\frac{5.8}{24}$	$\frac{6.0}{29}$	$\frac{1.7}{33}$
------------------	------------------	------------------	------------------	------------------	------------------	------------------	------------------

(3.9)

$\frac{1.0}{33}$	$\frac{6.1}{29}$	$\frac{5.2}{23}$	$\frac{4.0}{20}$	$\frac{4.3}{20}$	$\frac{4.0}{20}$	$\frac{5.5}{23}$	$\frac{5.8}{30}$	$\frac{2.6}{33}$
------------------	------------------	------------------	------------------	------------------	------------------	------------------	------------------	------------------

(4.0)

$\frac{2.6}{33}$	$\frac{6.2}{29}$	$\frac{5.6}{23}$	$\frac{4.4}{20}$	$\frac{4.3}{20}$	$\frac{4.3}{20}$	$\frac{5.6}{23}$	$\frac{6.2}{30}$	$\frac{5.2}{32}$	$\frac{5.1}{33}$
------------------	------------------	------------------	------------------	------------------	------------------	------------------	------------------	------------------	------------------

+25 End Ditch

(4.2)

$\frac{4.6}{33}$	$\frac{5.0}{31}$	$\frac{6.3}{29}$	$\frac{6.0}{25}$	$\frac{4.7}{20}$	$\frac{4.6}{20}$	$\frac{4.2}{20}$	$\frac{7.0}{26}$	$\frac{7.4}{33}$
------------------	------------------	------------------	------------------	------------------	------------------	------------------	------------------	------------------

(4.5)

$\frac{5.8}{33}$	$\frac{6.1}{30}$	$\frac{7.0}{29}$	$\frac{6.7}{23}$	$\frac{4.8}{20}$	$\frac{4.7}{20}$	$\frac{9.0}{30}$	$\frac{7.6}{32}$	$\frac{7.4}{33}$
------------------	------------------	------------------	------------------	------------------	------------------	------------------	------------------	------------------

Sta	+	H.I.	-	Elev.
177+50		922.01.		17.3
178				17.0
+50				16.8
179				16.4
T.P	5.86	919.54.	8.33	913.68.
+50				16.0
180				15.5
+50				15.1
181				14.5
+60				13.7
182				13.2
183				12.1

$$\begin{array}{cccccc} 7.2 & 7.4 & 8.1 & 7.8 & 5.1 & \textcircled{4.7} \\ 33 & 30 & 29 & 25 & 20 & 5.0 \\ +50 \text{ End Ditch} & & & & & 20 \end{array} \quad \begin{array}{ccc} 5.0 & 9.8 & 10.1 \\ 20 & 31 & 33 \end{array}$$

$$\begin{array}{cccccc} 7.8 & 8.0 & 5.0 & \textcircled{5.0} & & \\ 23 & 28 & 20 & 5.0 & 5.0 & 9.3 \\ & & & & 20 & 29 \end{array} \quad \begin{array}{ccc} 7.4 & & \\ & & 5.3 \end{array}$$

$$\begin{array}{cccccc} 8.4 & 8.1 & 5.3 & \textcircled{5.2} & & \\ 33 & 26 & 20 & 5.3 & 5.5 & 8.4 \\ & & & & 20 & 27 \end{array} \quad \begin{array}{ccc} 6.0 & & \\ & & 3.3 \end{array}$$

$$\begin{array}{cccccc} 8.7 & 7.8 & 8.0 & 8.0 & 6.0 & \textcircled{5.6} & & \\ 33 & 28 & 27 & 25 & 20 & 5.7 & 5.7 & 7.5 \\ +50 \text{ Beg Ditch} & & & & & & 20 & 25 \end{array} \quad \begin{array}{ccc} 5.0 & & \\ & & 3.3 \\ +25 \text{ Beg Ditch} & & \end{array}$$

$$\begin{array}{cccccc} 3.4 & 3.4 & 5.7 & 5.4 & 5.7 & \textcircled{3.5} & & \\ 33 & 32 & 28 & 24 & 20 & 5.7 & 5.6 & 5.2 \\ & & & & & & 20 & 23 \end{array} \quad \begin{array}{ccc} 5.3 & 4.3 & 3.1 \\ 27 & 29 & 33 \end{array}$$

$$\begin{array}{cccccc} 3.8 & 3.9 & 6.0 & 5.5 & 4.0 & \textcircled{4.0} & & \\ 33 & 31 & 29 & 24 & 20 & 3.8 & 4.0 & 5.8 \\ & & & & & & 20 & 24 \end{array} \quad \begin{array}{ccc} 6.0 & 0.3 & \\ 27 & 33 & \end{array}$$

$$\begin{array}{cccccc} 6.8 & 6.2 & 5.8 & 4.2 & 4.3 & \textcircled{4.4} & & \\ 33 & 28 & 25 & 20 & 20 & 4.6 & 6.4 & 6.4 \\ +40 \text{ End Ditch} & & & & & 20 & 24 & 27 \end{array} \quad \begin{array}{ccc} 2.0 & & \\ & & 3.3 \end{array}$$

$$\begin{array}{cccccc} 7.8 & 7.0 & 4.9 & 2.1 & 5.2 & \textcircled{5.0} & & \\ 33 & 25 & 20 & 2.1 & 2.0 & 7.0 & 2.2 & 6.6 \\ & & & & 20 & 24 & 27 & 28 \end{array} \quad \begin{array}{ccc} 5.6 & & \\ & & 3.3 \\ +50 \text{ End Ditch} & & \end{array}$$

$$\begin{array}{cccccc} 9.2 & 8.8 & 5.5 & 5.5 & 5.7 & \textcircled{5.8} & & \\ 33 & 27 & 20 & 5.5 & 2.0 & 7.4 & 7.8 & 6.8 \\ & & & & & 25 & 31 & 33 \end{array}$$

$$\begin{array}{cccccc} 10.2 & 9.8 & 6.1 & 6.2 & 6.1 & \textcircled{6.3} & & \\ 33 & 29 & 20 & 6.2 & 2.0 & 7.7 & 8.2 & \\ & & & & & 25 & 33 & \end{array}$$

$$\begin{array}{cccccc} 12.5 & 10.3 & 7.4 & 6.8 & 7.2 & \textcircled{7.4} & & \\ 33 & 26 & 20 & 6.8 & 2.0 & 8.1 & 9.6 & \\ & & & & & 25 & 33 & \end{array}$$

Sta	+	HI	-	Elev.
		919.54.		
183	+67			11.8
184				11.7
	+50			11.7
185				11.6
T.P	2.55	916.15	8.94	910.60
	+70			11.5
186				11.5
	+30			11.5
	+50			11.5
187				11.4
	+40			11.4
B.M.			5.40	910.75 = 910.77
188				11.4

$$\begin{array}{r} 12.5 \\ 33 \end{array} \quad \begin{array}{r} 11.0 \\ 29 \end{array} \quad \begin{array}{r} 7.6 \\ 20 \end{array} \quad \begin{array}{r} 7.7 \\ 20 \end{array} \quad \begin{array}{r} 7.8 \\ 20 \end{array} \quad \begin{array}{r} 9.6 \\ 25 \end{array} \quad \begin{array}{r} 9.8 \\ 33 \end{array}$$

$$\begin{array}{r} 106 \\ 33 \end{array} \quad \begin{array}{r} 115 \\ 32 \end{array} \quad \begin{array}{r} 115 \\ 29 \end{array} \quad \begin{array}{r} 100 \\ 24 \end{array} \quad \begin{array}{r} 7.7 \\ 20 \end{array} \quad \begin{array}{r} 7.7 \\ 7.7 \end{array} \quad \begin{array}{r} 7.8 \\ 20 \end{array} \quad \begin{array}{r} 9.1 \\ 24 \end{array} \quad \begin{array}{r} 9.4 \\ 29 \end{array} \quad \begin{array}{r} 9.2 \\ 30 \end{array} \quad \begin{array}{r} 9.2 \\ 33 \end{array}$$

+ 100 Bog Ditch L & R

$$\begin{array}{r} 9.2 \\ 33 \end{array} \quad \begin{array}{r} 9.5 \\ 29 \end{array} \quad \begin{array}{r} 10.2 \\ 28 \end{array} \quad \begin{array}{r} 10.0 \\ 25 \end{array} \quad \begin{array}{r} 7.7 \\ 20 \end{array} \quad \begin{array}{r} 7.7 \\ 20 \end{array} \quad \begin{array}{r} 9.1 \\ 24 \end{array} \quad \begin{array}{r} 9.5 \\ 28 \end{array} \quad \begin{array}{r} 8.8 \\ 29 \end{array} \quad \begin{array}{r} 6.6 \\ 33 \end{array}$$

$$\begin{array}{r} 9.6 \\ 33 \end{array} \quad \begin{array}{r} 9.3 \\ 29 \end{array} \quad \begin{array}{r} 10.0 \\ 28 \end{array} \quad \begin{array}{r} 9.5 \\ 24 \end{array} \quad \begin{array}{r} 7.8 \\ 20 \end{array} \quad \begin{array}{r} 7.8 \\ 20 \end{array} \quad \begin{array}{r} 9.0 \\ 23 \end{array} \quad \begin{array}{r} 9.5 \\ 28 \end{array} \quad \begin{array}{r} 7.8 \\ 30 \end{array} \quad \begin{array}{r} 6.2 \\ 33 \end{array}$$

$$\begin{array}{r} 6.0 \\ 33 \end{array} \quad \begin{array}{r} 6.0 \\ 29 \end{array} \quad \begin{array}{r} 6.6 \\ 28 \end{array} \quad \begin{array}{r} 6.5 \\ 25 \end{array} \quad \begin{array}{r} 4.7 \\ 20 \end{array} \quad \begin{array}{r} 4.7 \\ 20 \end{array} \quad \begin{array}{r} 5.0 \\ 20 \end{array} \quad \begin{array}{r} 6.1 \\ 23 \end{array} \quad \begin{array}{r} 6.7 \\ 28 \end{array} \quad \begin{array}{r} 5.7 \\ 29 \end{array} \quad \begin{array}{r} 5.4 \\ 33 \end{array}$$

$$\begin{array}{r} 5.9 \\ 33 \end{array} \quad \begin{array}{r} 5.9 \\ 29 \end{array} \quad \begin{array}{r} 6.6 \\ 28 \end{array} \quad \begin{array}{r} 6.4 \\ 24 \end{array} \quad \begin{array}{r} 5.9 \\ 23 \end{array} \quad \begin{array}{r} 4.6 \\ 20 \end{array} \quad \begin{array}{r} 4.8 \\ 20 \end{array} \quad \begin{array}{r} 5.2 \\ 20 \end{array} \quad \begin{array}{r} 6.2 \\ 23 \end{array} \quad \begin{array}{r} 6.7 \\ 29 \end{array} \quad \begin{array}{r} 4.4 \\ 31 \end{array} \quad \begin{array}{r} 4.0 \\ 33 \end{array}$$

+ 10 End Ditch.

$$\text{Drive.} \quad \begin{array}{r} 4.8 \\ 33 \end{array} \quad \begin{array}{r} 4.8 \\ 28 \end{array} \quad \begin{array}{r} 4.5 \\ 20 \end{array} \quad \begin{array}{r} 4.9 \\ 20 \end{array} \quad \begin{array}{r} 5.4 \\ 20 \end{array} \quad \begin{array}{r} 6.6 \\ 23 \end{array} \quad \begin{array}{r} 7.4 \\ 29 \end{array} \quad \begin{array}{r} 7.1 \\ 30 \end{array} \quad \begin{array}{r} 6.0 \\ 33 \end{array}$$

$$\begin{array}{r} 7.0 \\ 33 \end{array} \quad \begin{array}{r} 6.6 \\ 25 \end{array} \quad \begin{array}{r} 4.6 \\ 20 \end{array} \quad \begin{array}{r} 5.0 \\ 20 \end{array} \quad \begin{array}{r} 5.4 \\ 20 \end{array} \quad \begin{array}{r} 6.8 \\ 23 \end{array} \quad \begin{array}{r} 7.8 \\ 29 \end{array} \quad \begin{array}{r} 7.2 \\ 30 \end{array} \quad \begin{array}{r} 6.8 \\ 33 \end{array}$$

$$\begin{array}{r} 7.6 \\ 33 \end{array} \quad \begin{array}{r} 7.5 \\ 26 \end{array} \quad \begin{array}{r} 4.9 \\ 20 \end{array} \quad \begin{array}{r} 5.1 \\ 20 \end{array} \quad \begin{array}{r} 5.4 \\ 20 \end{array} \quad \begin{array}{r} 7.1 \\ 23 \end{array} \quad \begin{array}{r} 8.0 \\ 28 \end{array} \quad \begin{array}{r} 7.4 \\ 29 \end{array} \quad \begin{array}{r} 7.3 \\ 33 \end{array}$$

+ 25 End Ditch

$$\begin{array}{r} 7.2 \\ 33 \end{array} \quad \begin{array}{r} 7.2 \\ 26 \end{array} \quad \begin{array}{r} 4.8 \\ 20 \end{array} \quad \begin{array}{r} 4.8 \\ 20 \end{array} \quad \begin{array}{r} 5.3 \\ 20 \end{array} \quad \begin{array}{r} 5.7 \\ 28 \end{array} \quad \begin{array}{r} 5.7 \\ 33 \end{array} \quad \text{Drive.}$$

$$\text{Spike in T.P. 50' R + 24' R + 50' R} \quad \begin{array}{r} 6.6 \\ 33 \end{array} \quad \begin{array}{r} 6.5 \\ 24 \end{array} \quad \begin{array}{r} 4.8 \\ 20 \end{array} \quad \begin{array}{r} 4.7 \\ 20 \end{array} \quad \begin{array}{r} 5.1 \\ 20 \end{array} \quad \begin{array}{r} 6.8 \\ 23 \end{array} \quad \begin{array}{r} 6.5 \\ 33 \end{array}$$

Sta	+	HI	-	Elev.
		916.15.		
188+50				11.5
189				11.5
+50				11.6
190				11.7
T.P.	5.70	916.95.	4.90	911.25.
+50				11.8
+60				11.8
191				11.9
+21				12.0
+50				11.9
192				11.7
+50.				11.4

(4.7)

	$\frac{5.8}{3.9}$	$\frac{5.6}{2.2}$	$\frac{4.7}{2.0}$	$\frac{4.4}{4.4}$	$\frac{4.4}{2.0}$	$\frac{5.2}{2.1}$	$\frac{5.7}{2.6}$	$\frac{5.2}{2.7}$	$\frac{5.0}{3.3}$
--	-------------------	-------------------	-------------------	-------------------	-------------------	-------------------	-------------------	-------------------	-------------------

+ 70 Beg Ditch

(4.7)

$\frac{5.1}{3.3}$	$\frac{4.8}{3.0}$	$\frac{6.0}{2.7}$	$\frac{5.5}{2.2}$	$\frac{4.4}{2.0}$	$\frac{4.1}{4.1}$	$\frac{3.8}{2.0}$	$\frac{3.7}{3.3}$
-------------------	-------------------	-------------------	-------------------	-------------------	-------------------	-------------------	-------------------

(4.6)

$\frac{4.3}{3.3}$	$\frac{4.1}{2.9}$	$\frac{6.3}{2.7}$	$\frac{5.5}{2.2}$	$\frac{4.3}{2.0}$	$\frac{4.1}{4.1}$	$\frac{3.6}{2.0}$	$\frac{4.1}{2.2}$	$\frac{4.3}{3.3}$
-------------------	-------------------	-------------------	-------------------	-------------------	-------------------	-------------------	-------------------	-------------------

(4.5)

$\frac{5.5}{3.3}$	$\frac{5.7}{2.7}$	$\frac{5.8}{2.5}$	$\frac{5.8}{2.1}$	$\frac{4.5}{2.0}$	$\frac{4.2}{4.2}$	$\frac{3.6}{2.0}$	$\frac{4.3}{2.2}$	$\frac{4.8}{3.0}$	$\frac{4.8}{3.3}$
-------------------	-------------------	-------------------	-------------------	-------------------	-------------------	-------------------	-------------------	-------------------	-------------------

(5.2)

$\frac{4.2}{3.3}$	$\frac{4.7}{2.5}$	$\frac{5.0}{2.0}$	$\frac{4.4}{4.4}$	$\frac{4.2}{1.9}$	$\frac{5.3}{2.1}$	$\frac{5.8}{2.5}$	$\frac{4.5}{2.7}$	$\frac{4.0}{3.3}$
-------------------	-------------------	-------------------	-------------------	-------------------	-------------------	-------------------	-------------------	-------------------

+ 25 Beg Ditch

(5.2)

$\frac{2.0}{3.3}$	$\frac{2.0}{3.1}$	$\frac{6.6}{2.6}$	$\frac{6.4}{2.2}$	$\frac{5.4}{2.0}$	$\frac{4.3}{4.3}$	$\frac{4.2}{1.9}$	$\frac{5.2}{2.1}$	$\frac{5.7}{2.5}$	$\frac{4.0}{2.7}$	$\frac{3.6}{3.3}$
-------------------	-------------------	-------------------	-------------------	-------------------	-------------------	-------------------	-------------------	-------------------	-------------------	-------------------

(5.1)

$\frac{0.3}{3.3}$	$\frac{6.3}{2.5}$	$\frac{6.5}{2.2}$	$\frac{5.7}{2.0}$	$\frac{4.7}{4.7}$	$\frac{3.8}{2.0}$	$\frac{4.7}{2.2}$	$\frac{5.1}{2.6}$	$\frac{3.1}{2.8}$	$\frac{3.0}{3.3}$
-------------------	-------------------	-------------------	-------------------	-------------------	-------------------	-------------------	-------------------	-------------------	-------------------

(5.0)

$\frac{0.8}{3.3}$	$\frac{0.8}{3.2}$	$\frac{6.7}{2.6}$	$\frac{6.9}{2.2}$	$\frac{5.9}{2.0}$	$\frac{4.6}{4.6}$	$\frac{3.8}{2.0}$	$\frac{4.5}{2.2}$	$\frac{5.0}{2.6}$	$\frac{3.0}{2.8}$	$\frac{3.4}{3.3}$
-------------------	-------------------	-------------------	-------------------	-------------------	-------------------	-------------------	-------------------	-------------------	-------------------	-------------------

(5.1)

$\frac{3.0}{3.3}$	$\frac{3.8}{2.7}$	$\frac{6.8}{2.4}$	$\frac{7.0}{2.2}$	$\frac{6.3}{2.0}$	$\frac{4.9}{4.9}$	$\frac{3.9}{2.0}$	$\frac{4.4}{2.1}$	$\frac{4.7}{2.6}$	$\frac{3.1}{2.7}$	$\frac{3.2}{3.3}$
-------------------	-------------------	-------------------	-------------------	-------------------	-------------------	-------------------	-------------------	-------------------	-------------------	-------------------

(5.3)

$\frac{7.3}{3.3}$	$\frac{7.2}{2.7}$	$\frac{7.4}{2.6}$	$\frac{7.1}{2.2}$	$\frac{6.5}{2.0}$	$\frac{5.4}{5.4}$	$\frac{4.3}{2.2}$	$\frac{4.6}{2.4}$	$\frac{4.8}{2.7}$	$\frac{4.1}{2.8}$	$\frac{3.6}{3.3}$
-------------------	-------------------	-------------------	-------------------	-------------------	-------------------	-------------------	-------------------	-------------------	-------------------	-------------------

(5.6)

$\frac{4.4}{3.3}$	$\frac{4.4}{3.1}$	$\frac{8.2}{2.7}$	$\frac{7.8}{2.2}$	$\frac{7.0}{2.0}$	$\frac{5.8}{5.8}$	$\frac{4.6}{2.2}$	$\frac{5.2}{2.4}$	$\frac{5.4}{2.7}$	$\frac{3.4}{2.9}$	$\frac{3.3}{3.3}$
-------------------	-------------------	-------------------	-------------------	-------------------	-------------------	-------------------	-------------------	-------------------	-------------------	-------------------

Sta	+	HI	-	Elev.
		916.95.		
193				10.9
	+50			10.3
194				09.7
	+50			09.1
195				08.5
	+50			07.9
T.P.	0.86	908.49.	9.32	907.63.
196				07.4
	+50			07.2
197				06.9
	+50			06.9
198.				1.0

(6.1)

$\frac{11}{33}$	$\frac{8.5}{26}$	$\frac{8.2}{22}$	$\frac{7.4}{20}$	$\frac{6.4}{20}$	$\frac{4.8}{20}$	$\frac{5.8}{22}$	$\frac{6.0}{25}$	$\frac{3.8}{27}$	$\frac{3.6}{33}$
-----------------	------------------	------------------	------------------	------------------	------------------	------------------	------------------	------------------	------------------

(6.7)

$\frac{0.8}{36}$	$\frac{1.7}{33}$	$\frac{8.7}{26}$	$\frac{8.7}{22}$	$\frac{7.8}{20}$	$\frac{6.7}{20}$	$\frac{5.3}{28}$	$\frac{6.5}{21}$	$\frac{6.2}{25}$	$\frac{4.7}{26}$	$\frac{5.1}{33}$
------------------	------------------	------------------	------------------	------------------	------------------	------------------	------------------	------------------	------------------	------------------

(7.3)

$\frac{2.1}{36}$	$\frac{2.7}{33}$	$\frac{9.4}{26}$	$\frac{9.2}{22}$	$\frac{8.4}{20}$	$\frac{7.2}{22}$	$\frac{6.0}{21}$	$\frac{7.4}{25}$	$\frac{7.9}{28}$	$\frac{6.3}{30}$	$\frac{5.8}{33}$
------------------	------------------	------------------	------------------	------------------	------------------	------------------	------------------	------------------	------------------	------------------

(7.9)

$\frac{5.1}{36}$	$\frac{5.8}{33}$	$\frac{10.3}{28}$	$\frac{10.0}{22}$	$\frac{9.1}{21}$	$\frac{7.6}{26}$	$\frac{6.9}{20}$	$\frac{8.3}{24}$	$\frac{8.8}{29}$	$\frac{6.7}{31}$	$\frac{5.4}{32}$	$\frac{5.4}{33}$
------------------	------------------	-------------------	-------------------	------------------	------------------	------------------	------------------	------------------	------------------	------------------	------------------

(8.5)

$\frac{7.1}{35}$	$\frac{7.6}{32}$	$\frac{10.8}{29}$	$\frac{10.5}{23}$	$\frac{9.2}{20}$	$\frac{8.6}{26}$	$\frac{8.4}{20}$	$\frac{10.0}{22}$	$\frac{10.6}{26}$	$\frac{8.1}{28}$	$\frac{8.3}{33}$
------------------	------------------	-------------------	-------------------	------------------	------------------	------------------	-------------------	-------------------	------------------	------------------

+ 1.5 End Ditch

(9.1)

$\frac{10.0}{33}$	$\frac{10.3}{31}$	$\frac{11.5}{29}$	$\frac{10.6}{23}$	$\frac{9.3}{20}$	$\frac{7.6}{26}$	$\frac{9.3}{20}$	$\frac{16.3}{33}$
-------------------	-------------------	-------------------	-------------------	------------------	------------------	------------------	-------------------

+ 7.5 End Ditch

(1.1)

$\frac{4.7}{37}$	$\frac{4.3}{35}$	$\frac{5.0}{33}$	$\frac{4.6}{30}$	$\frac{1.2}{20}$	$\frac{1.3}{19}$	$\frac{1.3}{19}$	$\frac{11.0}{33}$
------------------	------------------	------------------	------------------	------------------	------------------	------------------	-------------------

(1.3)

$\frac{5.7}{33}$	$\frac{5.3}{30}$	$\frac{1.7}{20}$	$\frac{1.7}{19}$	$\frac{1.9}{19}$	$\frac{12.6}{33}$
------------------	------------------	------------------	------------------	------------------	-------------------

(1.6)

$\frac{5.5}{33}$	$\frac{5.8}{32}$	$\frac{5.7}{29}$	$\frac{1.8}{21}$	$\frac{2.4}{24}$	$\frac{2.8}{18}$	$\frac{12.2}{33}$
------------------	------------------	------------------	------------------	------------------	------------------	-------------------

(1.6)

$\frac{6.2}{33}$	$\frac{5.9}{29}$	$\frac{1.6}{20}$	$\frac{2.5}{25}$	$\frac{2.8}{20}$	$\frac{9.6}{32}$	$\frac{10.0}{33}$
------------------	------------------	------------------	------------------	------------------	------------------	-------------------

(1.5)

$\frac{6.2}{33}$	$\frac{6.0}{30}$	$\frac{1.0}{20}$	$\frac{2.0}{20}$	$\frac{2.5}{20}$	$\frac{4.3}{32}$	$\frac{4.5}{33}$	Drive
------------------	------------------	------------------	------------------	------------------	------------------	------------------	-------

Sta	+	HI	-	Elev.	
		908.49.			
198+50				07.3	
TP.	7.89	914.77.	1.61	906.88	
199				07.7	
+50				08.1	
200				08.4	
+50				08.4	
201				08.4	
+60				08.2	✓
202				07.8	✓
B.M.			1.19	913.58. = 913.57	
+50				07.2	✓
203				06.5	✓
+50				05.7	✓



Sta	+	HI	-	Elev.
		914.77.		
204				04.4
+50				03.3
TP	1130	914.16.	11.91	902.86.
205				02.0
+50				900.6
B.M.	6.36	908.03.	12.49	901.67.
206				899.1
+50				97.8
207				96.4
TP	1.21	897.78.	11.46	896.57.
+50				95.2
+75				94.4
208				93.7
+19 <sup>52</sup>				92.8

10.4

$\frac{1.0}{50}$   $\frac{1.6}{45}$   $\frac{2.3}{42}$   $\frac{11.3}{33}$   $\frac{10.2}{23}$   $\frac{9.1}{21}$   $\frac{9.6}{21}$   $\frac{11.1}{23}$   $\frac{12.0}{23}$   $\frac{12.7}{28}$   $\frac{6.8}{33}$

11.5

$\frac{2.6}{50}$   $\frac{2.8}{45}$   $\frac{3.4}{43}$   $\frac{12.2}{33}$   $\frac{11.1}{23}$   $\frac{10.1}{20}$   $\frac{10.8}{20}$   $\frac{12.0}{22}$   $\frac{12.5}{26}$   $\frac{12.7}{30}$   $\frac{11.6}{31}$   $\frac{11.0}{33}$

12.8

$\frac{4.1}{50}$   $\frac{6.5}{41}$   $\frac{7.5}{37}$   $\frac{13.0}{32}$   $\frac{12.8}{24}$   $\frac{11.2}{20}$   $\frac{11.7}{20}$   $\frac{12.7}{26}$   $\frac{13.5}{31}$   $\frac{13.7}{33}$  +100 End Ditch

13.7

$\frac{5.9}{50}$   $\frac{7.2}{42}$   $\frac{8.2}{39}$   $\frac{12.6}{32}$   $\frac{14.4}{24}$   $\frac{12.8}{20}$   $\frac{13.7}{20}$   $\frac{14.3}{20}$   $\frac{14.7}{33}$

Spills in P.P. 40' R+20' 205+60.

$\frac{0.8}{50}$   $\frac{2.0}{42}$   $\frac{3.0}{39}$   $\frac{9.2}{32}$   $\frac{9.4}{24}$   $\frac{8.4}{21}$   $\frac{8.9}{21}$   $\frac{9.6}{20}$   $\frac{9.0}{38}$   $\frac{9.5}{50}$

10.2

$\frac{4.5}{50}$   $\frac{5.8}{38}$   $\frac{6.5}{36}$   $\frac{10.2}{32}$   $\frac{10.0}{24}$   $\frac{9.2}{21}$   $\frac{10.2}{21}$   $\frac{11.2}{20}$   $\frac{11.8}{22}$   $\frac{11.7}{23}$   $\frac{10.7}{26}$   $\frac{9.7}{47}$   $\frac{9.7}{50}$   
+90 End Ditch +50 Beg. D.

11.6

$\frac{12.6}{50}$   $\frac{13.3}{27}$   $\frac{10.6}{20}$   $\frac{11.7}{20}$   $\frac{12.4}{21}$   $\frac{13.4}{25}$   $\frac{14.6}{32}$   $\frac{9.8}{39}$   $\frac{9.1}{50}$

21.6

$\frac{7.3}{50}$   $\frac{7.7}{32}$   $\frac{1.7}{20}$   $\frac{2.5}{25}$   $\frac{3.5}{22}$   $\frac{4.4}{25}$   $\frac{4.8}{28}$   $\frac{5.7}{30}$   $\frac{6.2}{33}$   $\frac{3.3}{36}$   $\frac{2.7}{37}$   $\frac{4.8}{48}$   $\frac{4.8}{50}$

3.4

$\frac{8.8}{50}$   $\frac{8.6}{33}$   $\frac{2.6}{20}$   $\frac{3.5}{35}$   $\frac{4.5}{22}$   $\frac{5.0}{24}$   $\frac{5.5}{28}$   $\frac{6.7}{32}$   $\frac{7.2}{35}$   $\frac{3.3}{39}$   $\frac{2.6}{42}$   $\frac{0.2}{48}$   $\frac{4.8}{50}$

4.1

$\frac{10.4}{50}$   $\frac{9.0}{33}$   $\frac{3.8}{20}$   $\frac{4.3}{43}$   $\frac{4.9}{22}$   $\frac{7.8}{29}$   $\frac{7.8}{32}$   $\frac{8.8}{35}$   $\frac{8.7}{35}$   $\frac{6.3}{41}$   $\frac{5.8}{48}$   $\frac{3.6}{50}$

5.0

$\frac{10.0}{50}$   $\frac{10.0}{32}$   $\frac{4.3}{20}$   $\frac{4.9}{49}$   $\frac{5.3}{22}$   $\frac{8.8}{29}$   $\frac{9.3}{38}$   $\frac{8.5}{39}$   $\frac{6.3}{40}$   
+195 End D.

Sta	+	HI	-	Elev
		897.78.		
209				91.2
	+30			90.4
	+50			
	+65			89.6
210				89.2
	+40			88.6
	+70			88.0
211.				87.6
	+22			87.3
	+50			87.0
T.P	5.37	891.56.	11.59	886.19.
	+80			86.7

PT

Sta Beg Ditch.

$\frac{70}{50}$	$\frac{89}{31}$	$\frac{93}{30}$	$\frac{95}{26}$	$\frac{63}{20}$	$\frac{66}{24}$	$\frac{66}{20}$	$\frac{94}{26}$	$\frac{66}{50}$
-----------------	-----------------	-----------------	-----------------	-----------------	-----------------	-----------------	-----------------	-----------------

66

$\frac{41}{50}$	$\frac{60}{35}$	$\frac{65}{33}$	$\frac{95}{50}$	$\frac{93}{26}$	$\frac{73}{20}$	$\frac{70}{20}$	$\frac{92}{23}$	$\frac{98}{28}$	$\frac{90}{29}$	$\frac{85}{31}$	$\frac{64}{50}$
-----------------	-----------------	-----------------	-----------------	-----------------	-----------------	-----------------	-----------------	-----------------	-----------------	-----------------	-----------------

74

+25 Beg. D.

$\frac{24}{50}$	$\frac{42}{39}$	$\frac{47}{37}$	$\frac{100}{30}$	$\frac{95}{25}$	$\frac{77}{20}$	$\frac{75}{20}$	$\frac{76}{20}$	$\frac{98}{24}$	$\frac{101}{29}$	$\frac{77}{32}$	$\frac{22}{34}$	$\frac{61}{50}$
-----------------	-----------------	-----------------	------------------	-----------------	-----------------	-----------------	-----------------	-----------------	------------------	-----------------	-----------------	-----------------

$\frac{16}{50}$	$\frac{24}{43}$	$\frac{30}{40}$	$\frac{103}{31}$	$\frac{96}{26}$	$\frac{80}{20}$	$\frac{77}{20}$	$\frac{81}{20}$	$\frac{100}{24}$	$\frac{100}{29}$	$\frac{72}{33}$	$\frac{67}{36}$	$\frac{62}{50}$
-----------------	-----------------	-----------------	------------------	-----------------	-----------------	-----------------	-----------------	------------------	------------------	-----------------	-----------------	-----------------

82

$\frac{+24}{50}$	$\frac{+14}{46}$	$\frac{00}{44}$	$\frac{110}{33}$	$\frac{101}{24}$	$\frac{87}{20}$	$\frac{85}{20}$	$\frac{87}{20}$	$\frac{101}{23}$	$\frac{101}{31}$	$\frac{50}{37}$	$\frac{47}{40}$	$\frac{40}{50}$
------------------	------------------	-----------------	------------------	------------------	-----------------	-----------------	-----------------	------------------	------------------	-----------------	-----------------	-----------------

86

$\frac{+23}{50}$	$\frac{+17}{48}$	$\frac{00}{47}$	$\frac{114}{34}$	$\frac{108}{24}$	$\frac{94}{20}$	$\frac{92}{20}$	$\frac{92}{20}$	$\frac{110}{25}$	$\frac{115}{31}$	$\frac{45}{40}$	$\frac{40}{42}$	$\frac{40}{50}$
------------------	------------------	-----------------	------------------	------------------	-----------------	-----------------	-----------------	------------------	------------------	-----------------	-----------------	-----------------

92

$\frac{+20}{50}$	$\frac{+15}{48}$	$\frac{00}{47}$	$\frac{116}{35}$	$\frac{108}{25}$	$\frac{97}{20}$	$\frac{96}{20}$	$\frac{96}{20}$	$\frac{110}{23}$	$\frac{119}{30}$	$\frac{51}{40}$	$\frac{46}{42}$	$\frac{48}{50}$
------------------	------------------	-----------------	------------------	------------------	-----------------	-----------------	-----------------	------------------	------------------	-----------------	-----------------	-----------------

98

$\frac{+01}{50}$	$\frac{03}{48}$	$\frac{120}{35}$	$\frac{115}{25}$	$\frac{102}{20}$	$\frac{101}{20}$	$\frac{101}{20}$	$\frac{101}{20}$	$\frac{116}{23}$	$\frac{124}{30}$	$\frac{80}{35}$	$\frac{77}{38}$	$\frac{80}{50}$
------------------	-----------------	------------------	------------------	------------------	------------------	------------------	------------------	------------------	------------------	-----------------	-----------------	-----------------

102

$\frac{17}{50}$	$\frac{18}{48}$	$\frac{27}{45}$	$\frac{122}{35}$	$\frac{114}{25}$	$\frac{102}{20}$	$\frac{103}{20}$	$\frac{107}{20}$	$\frac{120}{23}$	$\frac{126}{29}$	$\frac{97}{32}$	$\frac{96}{34}$	$\frac{103}{50}$
-----------------	-----------------	-----------------	------------------	------------------	------------------	------------------	------------------	------------------	------------------	-----------------	-----------------	------------------

105

$\frac{25}{50}$	$\frac{87}{49}$	$\frac{94}{37}$	$\frac{125}{32}$	$\frac{120}{23}$	$\frac{107}{20}$	$\frac{108}{20}$	$\frac{108}{20}$	$\frac{122}{23}$	$\frac{130}{37}$	$\frac{123}{29}$	$\frac{136}{50}$
-----------------	-----------------	-----------------	------------------	------------------	------------------	------------------	------------------	------------------	------------------	------------------	------------------

108

$\frac{07}{50}$	$\frac{40}{34}$	$\frac{45}{32}$	$\frac{64}{29}$	$\frac{57}{23}$	$\frac{49}{20}$	$\frac{50}{20}$	$\frac{43}{20}$	$\frac{98}{30}$	$\frac{101}{50}$
-----------------	-----------------	-----------------	-----------------	-----------------	-----------------	-----------------	-----------------	-----------------	------------------

49

+60 End Ditch

+85 End D.

Sta	+	H.I.	-	Elev.
		891.56.		
212	+00			86.5
	+50			86.1
213				85.8
	+50			85.6
214				85.7
	+15			85.7
	+50			85.7
	+80			85.7
215				85.8
	+50			86.0
	+78			86.2



	+	HI	-	Flow	
		891.56.			
216				86.4	
	+34			86.7	
B.M.	6.72	895.92 <sup>✓</sup>	2.35 <sup>-</sup>	889.21.	= 889.20
	+60			88.7	
	+80			87.3	
217				87.6	
	+30			88.1	
	+65 <sup>-</sup>			88.7	
218				89.4	
	+40			90.3	
	+72.			91.0	
219				91.8	

(5.2)

$\frac{6.5}{50}$	$\frac{7.0}{44}$	$\frac{7.1}{35}$	$\frac{7.6}{32}$	$\frac{6.8}{26}$	$\frac{4.7}{20}$	4.8	$\frac{4.8}{20}$	$\frac{10.4}{53}$	$\frac{11.8}{50}$
------------------	------------------	------------------	------------------	------------------	------------------	-----	------------------	-------------------	-------------------

(4.9)

$\frac{9.4}{50}$	$\frac{10.4}{39}$	$\frac{10.2}{29}$	$\frac{4.4}{19}$	4.2	$\frac{4.4}{19}$	$\frac{11.3}{29}$	$\frac{11.4}{41}$	$\frac{10.7}{50}$
------------------	-------------------	-------------------	------------------	-----	------------------	-------------------	-------------------	-------------------

+ 44 Bog Bridge.

2 pike in 24" Oak 60' R+ Sta 217+07.

Bridge

+ 66 End Bridge.

(8.6)

$\frac{15.0}{50}$	$\frac{15.0}{43}$	$\frac{16.0}{42}$	$\frac{15.7}{33}$	$\frac{8.4}{18}$	8.2	$\frac{8.5}{20}$	$\frac{9.8}{23}$	$\frac{15.5}{34}$	$\frac{15.5}{40}$	$\frac{15.0}{45}$	$\frac{13.0}{50}$
-------------------	-------------------	-------------------	-------------------	------------------	-----	------------------	------------------	-------------------	-------------------	-------------------	-------------------

(8.3)

$\frac{15.5}{50}$	$\frac{14.8}{32}$	$\frac{8.4}{20}$	8.0	$\frac{8.2}{20}$	$\frac{9.2}{24}$	$\frac{9.3}{27}$	$\frac{7.3}{31}$	$\frac{7.1}{40}$	$\frac{9.0}{50}$
-------------------	-------------------	------------------	-----	------------------	------------------	------------------	------------------	------------------	------------------

(7.8)

$\frac{14.8}{50}$	$\frac{14.4}{35}$	$\frac{7.8}{20}$	7.7	$\frac{7.5}{20}$	$\frac{7.2}{25}$	$\frac{9.2}{28}$	$\frac{6.0}{33}$	$\frac{3.1}{50}$
-------------------	-------------------	------------------	-----	------------------	------------------	------------------	------------------	------------------

(7.7)

$\frac{13.3}{50}$	$\frac{12.0}{31}$	$\frac{8.5}{24}$	$\frac{7.2}{20}$	7.0	$\frac{7.0}{20}$	$\frac{8.8}{25}$	$\frac{8.8}{29}$	$\frac{4.8}{34}$	$\frac{2.3}{15}$
-------------------	-------------------	------------------	------------------	-----	------------------	------------------	------------------	------------------	------------------

+ 75 Bog D.

(6.5)

$\frac{7.3}{50}$	$\frac{6.1}{30}$	$\frac{8.3}{27}$	$\frac{8.3}{23}$	$\frac{6.5}{20}$	6.3	$\frac{6.4}{20}$	$\frac{8.0}{24}$	$\frac{8.0}{29}$	$\frac{3.5}{36}$	$\frac{2.0}{50}$
------------------	------------------	------------------	------------------	------------------	-----	------------------	------------------	------------------	------------------	------------------

(5.6)

$\frac{6.5}{50}$	$\frac{6.3}{37}$	$\frac{7.3}{29}$	$\frac{6.8}{23}$	$\frac{5.6}{20}$	5.2	$\frac{5.7}{20}$	$\frac{7.0}{25}$	$\frac{7.3}{30}$	$\frac{1.4}{38}$	$\frac{1.5}{50}$
------------------	------------------	------------------	------------------	------------------	-----	------------------	------------------	------------------	------------------	------------------

(4.8)

$\frac{2.8}{50}$	$\frac{1.7}{36}$	$\frac{6.2}{28}$	$\frac{6.4}{24}$	$\frac{4.8}{20}$	4.4	$\frac{4.8}{20}$	$\frac{7.0}{26}$	$\frac{7.1}{30}$	$\frac{3.0}{36}$	$\frac{4.4}{50}$
------------------	------------------	------------------	------------------	------------------	-----	------------------	------------------	------------------	------------------	------------------

(4.1)

$\frac{4.3}{50}$	$\frac{3.6}{32}$	$\frac{5.8}{29}$	$\frac{5.3}{23}$	$\frac{3.6}{18}$	3.5	$\frac{3.8}{20}$	$\frac{6.2}{25}$	$\frac{6.6}{31}$	$\frac{5.2}{34}$	$\frac{2.0}{50}$
------------------	------------------	------------------	------------------	------------------	-----	------------------	------------------	------------------	------------------	------------------

+ 25 End. D R+L

Sta	+	HI	-	Elev
		895.92		
219+50				932
220				947
T.P.	8.16	903.68 ✓	0.20	895.52 ✓
+50				962
221				977
+35				988
+65				998
222				900.7
+30				01.6
T.P.	8.40	971.56 ✓	0.52	903.16 ✓
+65				02.7
223				03.7
+66				05.7

9.5

(2.7)

$\frac{4.3}{50}$   $\frac{5.1}{25}$   $\frac{2.0}{19}$   $\frac{1.8}{20}$   $\frac{2.2}{20}$   $\frac{11.5}{29}$   $\frac{8.7}{50}$

(1.2)

$\frac{5.3}{50}$   $\frac{5.3}{29}$   $\frac{0.4}{19}$   $\frac{0.3}{19}$   $\frac{0.6}{19}$   $\frac{6.8}{30}$   $\frac{7.4}{50}$

(7.5)

$\frac{15.8}{50}$   $\frac{14.2}{34}$   $\frac{6.7}{19}$   $\frac{6.8}{20}$   $\frac{7.3}{20}$   $\frac{13.0}{31}$   $\frac{14.3}{50}$

(6.0)

$\frac{15.8}{50}$   $\frac{15.0}{39}$   $\frac{5.4}{19}$   $\frac{5.3}{20}$   $\frac{5.2}{20}$   $\frac{10.8}{30}$   $\frac{13.3}{50}$

(4.9)

$\frac{14.2}{50}$   $\frac{13.7}{39}$   $\frac{4.4}{20}$   $\frac{4.4}{20}$   $\frac{4.3}{20}$   $\frac{12.8}{36}$   $\frac{14.4}{50}$

(3.9)

$\frac{10.4}{15}$   $\frac{9.3}{28}$   $\frac{3.4}{19}$   $\frac{3.2}{20}$   $\frac{3.3}{20}$   $\frac{11.4}{24}$   $\frac{12.8}{50}$

(3.0)

400 800 10  
 $\frac{5.1}{50}$   $\frac{5.3}{30}$   $\frac{6.1}{29}$   $\frac{5.2}{20}$   $\frac{3.3}{19}$   $\frac{2.2}{20}$   $\frac{2.4}{20}$   $\frac{8.4}{31}$   $\frac{10.1}{50}$

(2.1)

$\frac{0.8}{50}$   $\frac{2.0}{31}$   $\frac{4.6}{28}$   $\frac{4.2}{25}$   $\frac{1.3}{19}$   $\frac{1.3}{20}$   $\frac{1.2}{20}$   $\frac{5.7}{28}$   $\frac{7.8}{50}$

(8.9)

$\frac{7.0}{50}$   $\frac{8.8}{31}$   $\frac{11.4}{28}$   $\frac{10.9}{25}$   $\frac{8.3}{20}$   $\frac{8.7}{20}$   $\frac{9.5}{20}$   $\frac{15.2}{33}$   $\frac{17.7}{50}$

(7.9)

$\frac{5.2}{50}$   $\frac{6.8}{35}$   $\frac{7.2}{32}$   $\frac{10.0}{29}$   $\frac{9.4}{24}$   $\frac{7.2}{20}$   $\frac{7.2}{20}$   $\frac{16.4}{37}$   $\frac{18.0}{50}$

(5.9)

$\frac{2.3}{50}$   $\frac{4.0}{35}$   $\frac{4.7}{32}$   $\frac{7.7}{29}$   $\frac{7.2}{24}$   $\frac{5.7}{20}$   $\frac{5.4}{20}$   $\frac{5.7}{21}$   $\frac{13.0}{35}$   $\frac{15.2}{50}$

Sta	+	HI	-	Elev
		911.56		
224				06.7
	+50			08.2
225				09.7
	+39			10.9
T.P.	8.79	919.55	0.80	910.76
	+60			11.4
226				12.3
	+33			11.9
	+72			13.4
227				13.6
	+50			13.9
228				13.8

(4.9)

$\frac{2.2}{50}$	$\frac{6.4}{28}$	$\frac{7.0}{27}$	$\frac{7.0}{24}$	$\frac{5.0}{20}$	4.5	$\frac{4.7}{20}$	$\frac{10.9}{32}$	$\frac{11.7}{50}$
------------------	------------------	------------------	------------------	------------------	-----	------------------	-------------------	-------------------

(3.4)

$\frac{1.0}{50}$	$\frac{3.1}{36}$	$\frac{3.5}{33}$	$\frac{5.1}{31}$	$\frac{4.7}{25}$	$\frac{3.6}{21}$	3.3	$\frac{3.5}{20}$	$\frac{6.8}{27}$	$\frac{6.2}{50}$
------------------	------------------	------------------	------------------	------------------	------------------	-----	------------------	------------------	------------------

(1.9)

$\frac{3.3}{32}$	$\frac{3.3}{27}$	$\frac{2.0}{22}$	1.6	$\frac{2.0}{20}$	$\frac{3.6}{25}$	$\frac{4.0}{29}$	$\frac{2.3}{30}$	$\frac{2.0}{32}$	$\frac{1.1}{50}$
------------------	------------------	------------------	-----	------------------	------------------	------------------	------------------	------------------	------------------

(0.7)

$\frac{2.5}{34}$	$\frac{2.4}{29}$	$\frac{0.8}{22}$	0.6	$\frac{0.7}{20}$	$\frac{2.3}{25}$	$\frac{2.8}{30}$	$\frac{1.0}{32}$	$\frac{0.5}{54}$	$\frac{0.8}{50}$
------------------	------------------	------------------	-----	------------------	------------------	------------------	------------------	------------------	------------------

(8.2)

$\frac{10.0}{33}$	$\frac{9.4}{27}$	$\frac{8.4}{21}$	8.1	$\frac{8.1}{20}$	$\frac{9.7}{25}$	$\frac{10.0}{30}$	$\frac{7.0}{33}$	$\frac{7.0}{36}$	$\frac{8.0}{50}$
-------------------	------------------	------------------	-----	------------------	------------------	-------------------	------------------	------------------	------------------

(7.3)

$\frac{8.1}{33}$	$\frac{8.7}{26}$	$\frac{7.5}{22}$	7.1	$\frac{7.3}{20}$	$\frac{8.8}{26}$	$\frac{9.2}{32}$
------------------	------------------	------------------	-----	------------------	------------------	------------------

(7.7)

$\frac{8.5}{34}$	$\frac{8.1}{27}$	$\frac{6.8}{23}$	$\frac{6.4}{21}$	$\frac{6.4}{20}$	$\frac{8.0}{27}$	$\frac{8.4}{35}$
------------------	------------------	------------------	------------------	------------------	------------------	------------------

(6.2)

$\frac{8.0}{34}$	$\frac{7.6}{27}$	$\frac{6.4}{23}$	5.6	$\frac{5.6}{20}$	$\frac{7.3}{29}$	$\frac{7.7}{37}$
------------------	------------------	------------------	-----	------------------	------------------	------------------

(6.0)

$\frac{8.0}{35}$	$\frac{7.4}{28}$	$\frac{6.4}{23}$	5.5	$\frac{5.2}{20}$	$\frac{6.5}{27}$	$\frac{7.1}{37}$
------------------	------------------	------------------	-----	------------------	------------------	------------------

(5.7)

$\frac{7.7}{35}$	$\frac{7.4}{27}$	$\frac{6.0}{23}$	5.3	$\frac{4.8}{20}$	$\frac{5.8}{25}$	$\frac{6.8}{36}$
------------------	------------------	------------------	-----	------------------	------------------	------------------

(5.6)

$\frac{8.0}{36}$	$\frac{7.5}{28}$	$\frac{6.5}{22}$	5.5	$\frac{5.0}{20}$	$\frac{6.4}{25}$	$\frac{7.0}{35}$
------------------	------------------	------------------	-----	------------------	------------------	------------------

Sta	+	HI	-	Elev
		919.55		
228	+50			13.5
	+75			13.7
229				12.8
	+32			13.7
Cont'd. next page				
225	+00			9.7
	+39			10.9
T.P	11.52	930.20 ✓	0.87	918.68 ✓
	+60			11.4
226	+00			12.3
	+33			11.9
	+72			13.4
227				913.6

$\frac{8.5}{36}$	$\frac{9.0}{27}$	$\frac{6.8}{21}$	$\frac{6.1}{57}$	$\frac{5.2}{20}$	$\frac{6.9}{25}$	$\frac{7.2}{32}$	$\frac{2.0}{37}$	$\frac{1.8}{39}$	$\frac{3.5}{50}$
------------------	------------------	------------------	------------------	------------------	------------------	------------------	------------------	------------------	------------------

(6.1)

$\frac{2.5}{50}$	$\frac{3.0}{47}$	$\frac{1.6}{44}$	$\frac{2.0}{42}$	$\frac{8.4}{34}$	$\frac{8.4}{26}$	$\frac{7.0}{22}$	$\frac{6.0}{60}$	$\frac{5.5}{20}$	$\frac{6.6}{24}$	$\frac{7.2}{30}$	$\frac{4.0}{33}$	$\frac{4.0}{36}$	$\frac{6.7}{50}$
------------------	------------------	------------------	------------------	------------------	------------------	------------------	------------------	------------------	------------------	------------------	------------------	------------------	------------------

(6.6)

$\frac{4.3}{50}$	$\frac{4.5}{44}$	$\frac{3.6}{42}$	$\frac{3.8}{40}$	$\frac{8.5}{35}$	$\frac{8.2}{26}$	$\frac{7.3}{23}$	$\frac{6.7}{67}$	$\frac{5.8}{20}$	$\frac{7.0}{24}$	$\frac{7.6}{29}$	$\frac{5.5}{31}$	$\frac{5.2}{34}$	$\frac{8.7}{50}$
------------------	------------------	------------------	------------------	------------------	------------------	------------------	------------------	------------------	------------------	------------------	------------------	------------------	------------------

(6.8)

$\frac{7.2}{50}$	$\frac{7.7}{41}$	$\frac{6.3}{37}$	$\frac{9.2}{33}$	$\frac{8.6}{26}$	$\frac{7.6}{22}$	$\frac{6.3}{63}$	$\frac{6.2}{21}$	$\frac{8.1}{25}$	$\frac{8.6}{28}$	$\frac{8.4}{29}$	$\frac{8.5}{30}$	$\frac{12.6}{50}$
------------------	------------------	------------------	------------------	------------------	------------------	------------------	------------------	------------------	------------------	------------------	------------------	-------------------

(7.6)

$\frac{5.6}{50}$	$\frac{7.2}{36}$
------------------	------------------

(9.8)

$\frac{2.7}{50}$	$\frac{2.8}{42}$	$\frac{3.8}{40}$
------------------	------------------	------------------

(8.6)

$\frac{8.7}{50}$	$\frac{6.7}{47}$	$\frac{9.6}{45}$
------------------	------------------	------------------

(18.8)

$\frac{2.5}{53}$	$\frac{2.8}{50}$
------------------	------------------

(17.9)

$\frac{12.7}{40}$	$\frac{12.6}{43}$	$\frac{13.5}{52}$
-------------------	-------------------	-------------------

$\frac{1.0}{53}$	$\frac{1.4}{50}$
------------------	------------------

(18.3)

$\frac{8.0}{47}$	$\frac{7.8}{50}$
------------------	------------------

$\frac{0.0}{52}$	$\frac{0.4}{50}$
------------------	------------------

(16.8)

$\frac{6.0}{48}$	$\frac{5.6}{50}$
------------------	------------------

$\frac{1.4}{52}$	$\frac{1.7}{50}$
------------------	------------------

(16.6)

$\frac{5.0}{48}$	$\frac{4.8}{50}$
------------------	------------------

Sta	+	H I	-	Elev
		930.20		
227+50				13.9
228				13.8
+50				13.5
T.P.	0.90	919.72 ✓	11.18	919.02 ✓
T.P.	1.17	913.93 ✓	216	912.76 ✓
D.M.	13.11	913.99 ✓	13.11	900.82 ✓ = 900.88
229+70				11.5
230-				11.0
+30				10.5
+50				10.1
+73				09.7
231				09.2
+24				08.8

$$\frac{5.0}{51} \quad \frac{7.8}{51}$$

(16.3)

$$\frac{3.4}{50} \quad \frac{3.2}{53}$$

$$\frac{100}{50} \quad \frac{88}{47} \quad \frac{93}{45}$$

(16.4)

$$\frac{8.8}{42} \quad \frac{8.1}{45} \quad \frac{8.5}{50}$$

$$\frac{4.2}{50} \quad \frac{12.6}{47} \quad \frac{11.0}{44} \quad \frac{11.4}{43}$$

(16.7)

$$\frac{4.7}{50} \quad \frac{4.7}{46}$$

(2.5)

$$\frac{5.3}{38} \quad \frac{5.2}{36} \quad \frac{4.0}{33} \quad \frac{4.0}{31} \quad \frac{4.4}{30} \quad \frac{4.2}{26} \quad \frac{3.2}{21} \quad 2.2 \quad \frac{1.6}{21} \quad \frac{8.2}{33} \quad \frac{14.5}{50}$$

(3.0)

$$\frac{7.4}{50} \quad \frac{7.0}{39} \quad \frac{7.7}{37} \quad \frac{9.2}{36} \quad \frac{8.6}{33} \quad \frac{4.2}{25} \quad 5.0 \quad \frac{2.7}{22}$$

(3.5)

$$\frac{9.0}{50} \quad \frac{10.6}{44} \quad \frac{11.6}{43} \quad \frac{11.6}{40} \quad \frac{10.8}{32} \quad \frac{4.0}{21} \quad 3.5 \quad \frac{3.0}{22}$$

(3.9)

$$\frac{18.0}{50} \quad \frac{13.3}{40} \quad \frac{4.4}{23} \quad 3.8 \quad \frac{3.2}{21}$$

(4.3)

$$\frac{4.8}{24} \quad \frac{4.2}{21} \quad \frac{3.7}{21}$$

(4.6)

$$\frac{5.4}{25} \quad 4.7 \quad \frac{4.4}{21}$$

(5.2)

$$\frac{5.7}{23} \quad 5.0 \quad \frac{4.8}{21}$$

Sta	+	H.I.	-	Elev.
		713.99		
231+65				08.0
232				07.4
B.M.	463	905.51	13.11	900.98 ✓
230+73				9.7
231.				9.2
+24				8.8
+65				8.0
J.P.	415	908.75 <sup>76</sup>	0.90	904.61 ✓
T.P.	0.91	897.82 ✓	11.85	896.91 ✓
230+00				11.0 ↗
+30				10.5 ↗
+50				16.1 ↗
+73				9.7 ↗
231				09.4 ↗

(6.0)

$$\frac{62}{22} \quad 5.7 \quad \frac{5.7}{22} \quad \frac{14.8}{37} \quad \frac{13.2}{50}$$

(6.6)

$$\frac{196}{50} \quad \frac{190}{45} \quad \frac{73}{28} \quad \frac{73}{26} \quad \frac{66}{21} \quad \frac{41}{21} \quad \frac{6.4}{21} \quad \frac{97}{27} \quad \frac{102}{30} \quad \frac{86}{32} \quad \frac{92}{50}$$

$$\frac{116}{50} \quad \frac{112}{48}$$

(4.5)

$$\frac{131}{50} \quad \frac{130}{48}$$

(4.0)

$$\frac{150}{54} \quad \frac{144}{50}$$

(3.6)

$$\frac{135}{50} \quad \frac{130}{50}$$

(+2.8)

(13.2)

$$\frac{46}{50} \quad \frac{50}{50}$$

(12.7)

$$\frac{124}{60}$$

(12.3)

$$\frac{129}{59}$$

(+11.9)

$$\frac{70}{45} \quad \frac{11.9}{52}$$

(+11.4)

$$\frac{84}{42} \quad \frac{104}{50}$$

Sta	+	HI	-	Elev.
		897.8 ✓		
231+24				08.8
T.P.	12.98	909.90 ✓	090	896.92 ✓
B.M.			900	900.90, 900.88
232+14				07.1
+42				06.6
T.P.	11.35	912.23 ✓		900.88
+75				06.0
233				05.6
38				04.9
+75				04.2
234				03.8
+25				03.4
+72				02.9
135				02.9

+110

 $\frac{70}{48} \frac{75}{50}$ 

7.8

$\frac{133}{58}$	$\frac{135}{56}$	$\frac{103}{50}$	$\frac{48}{4}$	$\frac{2.7}{2}$	$\frac{2.1}{21}$	$\frac{2.1}{21}$	$\frac{5.4}{26}$	$\frac{6.0}{31}$	$\frac{3.5}{35}$	$\frac{5.0}{50}$
------------------	------------------	------------------	----------------	-----------------	------------------	------------------	------------------	------------------	------------------	------------------

3.3

+15 50p.D.

$\frac{81}{50}$	$\frac{62}{37}$	$\frac{40}{34}$	$\frac{48}{30}$	$\frac{60}{27}$	$\frac{5.5}{23}$	$\frac{2.8}{20}$	$\frac{2.4}{20}$	$\frac{2.5}{20}$	$\frac{5.7}{26}$	$\frac{5.8}{27}$	$\frac{4.7}{30}$	$\frac{4.5}{32}$	$\frac{4.4}{34}$	$\frac{3.6}{35}$	$\frac{4}{50}$
-----------------	-----------------	-----------------	-----------------	-----------------	------------------	------------------	------------------	------------------	------------------	------------------	------------------	------------------	------------------	------------------	----------------

6.2

$\frac{5.3}{50}$	$\frac{3.6}{42}$	$\frac{2.3}{40}$	$\frac{2.7}{35}$	$\frac{8.4}{27}$	$\frac{8.2}{25}$	$\frac{5.4}{19}$	$\frac{5.2}{20}$	$\frac{7.5}{25}$	$\frac{7.7}{25}$	$\frac{7.8}{29}$	$\frac{4.7}{33}$	$\frac{4.2}{36}$	$\frac{5.5}{50}$
------------------	------------------	------------------	------------------	------------------	------------------	------------------	------------------	------------------	------------------	------------------	------------------	------------------	------------------

6.6

$\frac{5.2}{50}$	$\frac{2.0}{44}$	$\frac{1.1}{41}$	$\frac{1.5}{38}$	$\frac{8.7}{27}$	$\frac{8.6}{24}$	$\frac{5.6}{19}$	$\frac{5.6}{21}$	$\frac{5.6}{25}$	$\frac{8.2}{29}$	$\frac{3.0}{37}$	$\frac{2.7}{40}$	$\frac{3.2}{50}$
------------------	------------------	------------------	------------------	------------------	------------------	------------------	------------------	------------------	------------------	------------------	------------------	------------------

7.3

$\frac{2.8}{50}$	$\frac{1.1}{42}$	$\frac{1.2}{39}$	$\frac{9.5}{27}$	$\frac{9.3}{25}$	$\frac{5.7}{19}$	$\frac{5.7}{20}$	$\frac{5.9}{20}$	$\frac{8.8}{24}$	$\frac{8.8}{29}$	$\frac{1.7}{40}$	$\frac{1.2}{43}$	$\frac{1.6}{50}$
------------------	------------------	------------------	------------------	------------------	------------------	------------------	------------------	------------------	------------------	------------------	------------------	------------------

8.0

$\frac{0.2}{50}$	$\frac{5.0}{42}$	$\frac{3.4}{40}$	$\frac{5.8}{37}$	$\frac{10.2}{27}$	$\frac{9.4}{24}$	$\frac{6.2}{19}$	$\frac{6.0}{20}$	$\frac{6.2}{20}$	$\frac{9.6}{26}$	$\frac{7.7}{29}$	$\frac{6.4}{32}$	$\frac{5.8}{35}$	$\frac{9.0}{50}$
------------------	------------------	------------------	------------------	-------------------	------------------	------------------	------------------	------------------	------------------	------------------	------------------	------------------	------------------

8.4

$\frac{8.0}{50}$	$\frac{5.2}{39}$	$\frac{5.8}{35}$	$\frac{10.4}{28}$	$\frac{10.5}{25}$	$\frac{6.5}{19}$	$\frac{6.1}{20}$	$\frac{6.1}{20}$	$\frac{9.8}{25}$	$\frac{10.0}{28}$	$\frac{9.3}{29}$	$\frac{9.2}{32}$	$\frac{15.4}{50}$
------------------	------------------	------------------	-------------------	-------------------	------------------	------------------	------------------	------------------	-------------------	------------------	------------------	-------------------

+15 End.D.

8.8

$\frac{4.3}{50}$	$\frac{3.3}{42}$	$\frac{3.7}{38}$	$\frac{10.6}{28}$	$\frac{10.3}{26}$	$\frac{6.5}{19}$	$\frac{6.4}{20}$	$\frac{6.5}{20}$	$\frac{17.3}{36}$	$\frac{19.3}{50}$
------------------	------------------	------------------	-------------------	-------------------	------------------	------------------	------------------	-------------------	-------------------

9.3

$\frac{+1.4}{50}$	$\frac{+1.0}{48}$	$\frac{1.2}{44}$	$\frac{10.8}{30}$	$\frac{10.8}{26}$	$\frac{6.7}{19}$	$\frac{6.3}{20}$	$\frac{6.6}{20}$	$\frac{17.0}{36}$	$\frac{20.0}{50}$
-------------------	-------------------	------------------	-------------------	-------------------	------------------	------------------	------------------	-------------------	-------------------

9.3

$\frac{1.5}{50}$	$\frac{1.1}{42}$	$\frac{1.6}{43}$	$\frac{10.8}{30}$	$\frac{10.5}{24}$	$\frac{6.6}{18}$	$\frac{6.4}{21}$	$\frac{6.5}{21}$	$\frac{17.3}{36}$	$\frac{20.3}{50}$
------------------	------------------	------------------	-------------------	-------------------	------------------	------------------	------------------	-------------------	-------------------

Sta	+	HZ	-	Elev
		912.23		
235	+34			02.7
	+48			02.7
	+70			02.8
236	+00			03.1
T.P.	2.15	909.83 ✓	4.55	907.68 ✓
	+50			03.8
237				04.7
	+50			06.2
T.P.	4.59	913.44 ✓	0.98	908.85 ✓
	+75			07.0
238				08.2
	+50			10.2
	+74			11.2
T.P.	10.95	923.45 ✓	0.94	912.50 ✓
239				12.2



Sta	+	HI	-	Flow
		923.45		
239+32				13.5
+70				15.0
240				16.2
+30				17.4
+75				19.2
T.P.	924	930.78 ✓	2.51	920.94 ✓
241				20.2
+28				21.3
+54				22.4
242				24.2
			534	
+23				25.1
+50				26.1
+75				27.0
T.P.	12.10	939.58	3.30	927.48 ✓

$$\frac{1.2}{50} \quad \frac{1.3}{48} \quad \frac{2.0}{46} \quad \frac{12.1}{30} \quad \frac{12.5}{25} \quad \frac{9.2}{21} \quad \frac{10.0}{96} \quad \frac{10.1}{21} \quad \frac{12.5}{25} \quad \frac{12.5}{28} \quad \frac{6.0}{34} \quad \frac{7.5}{37} \quad \frac{7.5}{50}$$

(8.5)

4.H.I

$$+ \frac{3.0}{53} + \frac{2.6}{50} \quad \frac{0.0}{47} \quad \frac{10.6}{39} \quad \frac{10.8}{27} \quad \frac{8.2}{21} \quad 8.2 \quad \frac{8.5}{21} \quad \frac{11.0}{26} \quad \frac{10.7}{29} \quad \frac{7.0}{33} \quad \frac{6.3}{36} \quad \frac{7.3}{50}$$

(9.3)

$$\frac{1.73}{53} \quad \frac{1.2.0}{50} \quad \frac{0.0}{44} \quad \frac{9.4}{33} \quad \frac{8.9}{26} \quad \frac{7.0}{24} \quad 7.0 \quad \frac{7.4}{21} \quad \frac{7.5}{25} \quad \frac{9.5}{28} \quad \frac{6.9}{32} \quad \frac{6.3}{35} \quad \frac{5.8}{44} \quad \frac{7.6}{50}$$

(6.1)

$$+ \frac{7.9}{53} \quad \frac{7.5}{50} \quad \frac{0.0}{49} \quad \frac{7.5}{32} \quad \frac{8.0}{26} \quad \frac{6.0}{22} \quad 5.7 \quad \frac{6.2}{21} \quad \frac{8.5}{25} \quad \frac{8.0}{29} \quad \frac{6.3}{32} \quad \frac{5.7}{34} \quad \frac{7.7}{50}$$

(4.3)

$$+ \frac{6.0}{50} \quad \frac{5.3}{46} \quad \frac{0.0}{40} \quad \frac{6.6}{31} \quad \frac{6.3}{25} \quad \frac{4.4}{20} \quad 4.0 \quad \frac{4.5}{21} \quad \frac{6.6}{25} \quad \frac{6.8}{28} \quad \frac{5.5}{31} \quad \frac{5.4}{33} \quad \frac{6.8}{39} \quad \frac{9.7}{50}$$

(10.6)

$$\frac{3.2}{50} \quad \frac{3.5}{45} \quad \frac{4.0}{42} \quad \frac{13.2}{30} \quad \frac{7.2.8}{25} \quad \frac{11.0}{22} \quad 10.6 \quad \frac{11.0}{21} \quad \frac{12.8}{24} \quad \frac{13.0}{28} \quad \frac{12.6}{30} \quad \frac{12.7}{31} \quad \frac{17.0}{50}$$

(9.5)

$$\frac{6.8}{50} \quad \frac{6.2}{37} \quad \frac{6.4}{37} \quad \frac{12.0}{29} \quad \frac{11.6}{25} \quad \frac{9.6}{22} \quad 9.5 \quad \frac{10.0}{22} \quad \frac{11.8}{25} \quad \frac{11.8}{28} \quad \frac{11.2}{29} \quad \frac{11.2}{32} \quad \frac{13.0}{50}$$

(8.0)

$$\frac{6.4}{50} \quad \frac{7.8}{34} \quad \frac{11.0}{30} \quad \frac{11.0}{26} \quad \frac{8.8}{22} \quad 8.5 \quad \frac{8.7}{21} \quad \frac{10.2}{24} \quad \frac{10.3}{27} \quad \frac{8.8}{29} \quad \frac{8.8}{32} \quad \frac{12.2}{50}$$

(6.6)

$$\frac{5.5}{50} \quad \frac{5.0}{46} \quad \frac{5.0}{34} \quad \frac{9.4}{30} \quad \frac{8.7}{25} \quad \frac{7.0}{21} \quad 7.0 \quad \frac{7.0}{20} \quad \frac{9.5}{24} \quad \frac{10.3}{28} \quad \frac{9.0}{30} \quad \frac{9.0}{33} \quad \frac{10.8}{50}$$

+ 100 Error.

(5.7)

$$\frac{3.6}{50} \quad \frac{5.0}{35} \quad \frac{8.4}{30} \quad \frac{7.7}{24} \quad \frac{6.0}{21} \quad 6.1 \quad \frac{6.5}{22} \quad \frac{11.1}{32} \quad \frac{12.1}{50}$$

(4.7)

$$\frac{2.8}{50} \quad \frac{3.0}{42} \quad \frac{6.8}{33} \quad \frac{7.5}{31} \quad \frac{7.4}{27} \quad \frac{5.1}{21} \quad 5.2 \quad \frac{5.5}{21} \quad \frac{11.1}{35} \quad \frac{11.6}{50}$$

(3.8)

$$+ \frac{0.8}{50} \quad \frac{0.0}{44} \quad \frac{1.2}{37} \quad \frac{6.7}{30} \quad \frac{5.7}{24} \quad \frac{4.1}{20} \quad 4.7 \quad \frac{4.5}{21} \quad \frac{6.2}{23} \quad \frac{7.0}{28} \quad \frac{9.8}{50}$$

+ 80 Deg. D

939.58

243

27.8

+42

29.8

244

30.7

+27

31.4

+70

32.3

245

32.8

246

34.2

+58

34.8

247

35.2

+40

35.6

+70

35.9

$$\begin{array}{r} 7.5 \\ 50 \end{array} \quad \begin{array}{r} 4.5 \\ 41 \end{array} \quad \begin{array}{r} 14.0 \\ 31 \end{array} \quad \begin{array}{r} 14.0 \\ 25 \end{array} \quad \begin{array}{r} 12.1 \\ 21 \end{array} \quad \textcircled{11.8} \quad \begin{array}{r} 12.2 \\ 21 \end{array} \quad \begin{array}{r} 14.6 \\ 21 \end{array} \quad \begin{array}{r} 14.8 \\ 25 \end{array} \quad \begin{array}{r} 14.9 \\ 28 \end{array} \quad \begin{array}{r} 12.0 \\ 33 \end{array} \quad \begin{array}{r} 14.4 \\ 50 \end{array}$$

$$\begin{array}{r} 5.0 \\ 50 \end{array} \quad \begin{array}{r} 3.8 \\ 42 \end{array} \quad \begin{array}{r} 12.8 \\ 31 \end{array} \quad \begin{array}{r} 12.8 \\ 24 \end{array} \quad \begin{array}{r} 10.6 \\ 20 \end{array} \quad \textcircled{9.8} \quad 10.8 \quad \begin{array}{r} 11.0 \\ 27 \end{array} \quad \begin{array}{r} 13.3 \\ 24 \end{array} \quad \begin{array}{r} 13.2 \\ 29 \end{array} \quad \begin{array}{r} 3.4 \\ 42 \end{array} \quad \begin{array}{r} 4.4 \\ 50 \end{array}$$

$$\begin{array}{r} 4.2 \\ 50 \end{array} \quad \begin{array}{r} 4.0 \\ 41 \end{array} \quad \begin{array}{r} 3.2 \\ 40 \end{array} \quad \begin{array}{r} 11.4 \\ 30 \end{array} \quad \begin{array}{r} 11.2 \\ 24 \end{array} \quad \begin{array}{r} 9.2 \\ 21 \end{array} \quad \textcircled{8.9} \quad 9.4 \quad \begin{array}{r} 9.5 \\ 20 \end{array} \quad \begin{array}{r} 11.5 \\ 24 \end{array} \quad \begin{array}{r} 11.1 \\ 29 \end{array} \quad \begin{array}{r} 0.0 \\ 45 \end{array} \quad \begin{array}{r} 0.0 \\ 50 \end{array}$$

$$\begin{array}{r} 4.7 \\ 50 \end{array} \quad \begin{array}{r} 3.7 \\ 46 \end{array} \quad \begin{array}{r} 3.4 \\ 38 \end{array} \quad \begin{array}{r} 10.8 \\ 30 \end{array} \quad \begin{array}{r} 10.7 \\ 26 \end{array} \quad \begin{array}{r} 8.7 \\ 22 \end{array} \quad \textcircled{8.2} \quad 8.7 \quad \begin{array}{r} 8.7 \\ 20 \end{array} \quad \begin{array}{r} 10.7 \\ 24 \end{array} \quad \begin{array}{r} 10.8 \\ 29 \end{array} \quad \begin{array}{r} 0.7 \\ 43 \end{array} \quad \begin{array}{r} 0.8 \\ 50 \end{array}$$

$$\begin{array}{r} 7.0 \\ 50 \end{array} \quad \begin{array}{r} 7.2 \\ 32 \end{array} \quad \begin{array}{r} 9.4 \\ 28 \end{array} \quad \begin{array}{r} 9.2 \\ 24 \end{array} \quad \begin{array}{r} 2.6 \\ 21 \end{array} \quad \textcircled{9.2} \quad 7.7 \quad 7.4 \quad \begin{array}{r} 7.6 \\ 25 \end{array} \quad \begin{array}{r} 9.2 \\ 28 \end{array} \quad \begin{array}{r} 8.8 \\ 29 \end{array} \quad \begin{array}{r} 8.8 \\ 50 \end{array}$$

180 5

$$\begin{array}{r} 9.9 \\ 50 \end{array} \quad \begin{array}{r} 9.8 \\ 29 \end{array} \quad \begin{array}{r} 7.2 \\ 22 \end{array} \quad \textcircled{6.8} \quad 7.0 \quad \begin{array}{r} 7.2 \\ 21 \end{array} \quad \begin{array}{r} 8.0 \\ 24 \end{array} \quad \begin{array}{r} 7.4 \\ 26 \end{array} \quad \begin{array}{r} 10.0 \\ 30 \end{array} \quad \begin{array}{r} 10.2 \\ 50 \end{array}$$

$$\begin{array}{r} 8.3 \\ 50 \end{array} \quad \begin{array}{r} 9.5 \\ 30 \end{array} \quad \begin{array}{r} 5.6 \\ 22 \end{array} \quad \textcircled{5.4} \quad 5.5 \quad \begin{array}{r} 5.7 \\ 21 \end{array} \quad \begin{array}{r} 7.2 \\ 24 \end{array} \quad \begin{array}{r} 8.0 \\ 27 \end{array} \quad \begin{array}{r} 10.0 \\ 32 \end{array} \quad \begin{array}{r} 10.2 \\ 50 \end{array}$$

$$\begin{array}{r} 5.2 \\ 50 \end{array} \quad \begin{array}{r} 6.7 \\ 33 \end{array} \quad \begin{array}{r} 7.4 \\ 32 \end{array} \quad \begin{array}{r} 6.6 \\ 30 \end{array} \quad \begin{array}{r} 6.3 \\ 25 \end{array} \quad \begin{array}{r} 4.7 \\ 21 \end{array} \quad \textcircled{6.8} \quad 4.6 \quad \begin{array}{r} 5.0 \\ 20 \end{array} \quad \begin{array}{r} 6.8 \\ 24 \end{array} \quad \begin{array}{r} 7.7 \\ 27 \end{array} \quad \begin{array}{r} 10.0 \\ 31 \end{array} \quad \begin{array}{r} 10.2 \\ 50 \end{array}$$

$$\begin{array}{r} 5.2 \\ 50 \end{array} \quad \begin{array}{r} 5.0 \\ 29 \end{array} \quad \begin{array}{r} 6.2 \\ 28 \end{array} \quad \begin{array}{r} 6.2 \\ 24 \end{array} \quad \begin{array}{r} 4.3 \\ 21 \end{array} \quad \textcircled{4.4} \quad 4.3 \quad \begin{array}{r} 4.5 \\ 21 \end{array} \quad \begin{array}{r} 8.7 \\ 30 \end{array} \quad \begin{array}{r} 9.7 \\ 42 \end{array} \quad \begin{array}{r} 9.8 \\ 50 \end{array}$$

$$\begin{array}{r} 5.8 \\ 50 \end{array} \quad \begin{array}{r} 5.4 \\ 30 \end{array} \quad \begin{array}{r} 5.8 \\ 27 \end{array} \quad \begin{array}{r} 6.6 \\ 24 \end{array} \quad \begin{array}{r} 4.2 \\ 21 \end{array} \quad \textcircled{4.0} \quad 3.9 \quad \begin{array}{r} 3.8 \\ 20 \end{array} \quad \begin{array}{r} 5.7 \\ 23 \end{array} \quad \begin{array}{r} 6.7 \\ 50 \end{array}$$

$$\begin{array}{r} 6.7 \\ 50 \end{array} \quad \begin{array}{r} 5.5 \\ 28 \end{array} \quad \begin{array}{r} 5.7 \\ 27 \end{array} \quad \begin{array}{r} 5.8 \\ 24 \end{array} \quad \begin{array}{r} 3.7 \\ 20 \end{array} \quad \textcircled{3.7} \quad 3.7 \quad \begin{array}{r} 3.6 \\ 20 \end{array} \quad \begin{array}{r} 5.5 \\ 25 \end{array} \quad \begin{array}{r} 5.8 \\ 32 \end{array} \quad \begin{array}{r} 3.5 \\ 36 \end{array} \quad \begin{array}{r} 3.7 \\ 50 \end{array}$$

Sta	+	HI	-	Elev
		939.58		
248				36.4
B.M	10.42	946.76 ✓	3.26	936.32 ✓ = 936.34
+50				36.7
249				37.2 ✓
+50				37.6
250				37.8
+50				37.8
251				37.6
+50				37.3
252				37.0
+50				36.6
253				35.8
T.P	5.97	942.40 ✓	10.33	936.43 ✓

$$\frac{70}{50} \quad \frac{46}{38} \quad \frac{56}{27} \quad \frac{50}{24} \quad \frac{33}{20} \quad \frac{34}{20} \quad \frac{54}{24} \quad \frac{54}{32} \quad \frac{54}{36} \quad \frac{06}{36} \quad \frac{01}{50}$$

(3.4)

$$\frac{164}{50} \quad \frac{112}{28} \quad \frac{120}{26} \quad \frac{120}{25} \quad \frac{100}{20} \quad \frac{78}{21} \quad \frac{100}{21} \quad \frac{118}{24} \quad \frac{122}{31} \quad \frac{45}{40} \quad \frac{42}{45} \quad \frac{56}{50}$$

(10.1)

RR sp. ks 18" Oak 5 6 Lt 5 9 2 4 9 4 0 5

$$\frac{145}{50} \quad \frac{93}{31} \quad \frac{115}{27} \quad \frac{117}{25} \quad \frac{97}{21} \quad \frac{74}{21} \quad \frac{95}{21} \quad \frac{114}{25} \quad \frac{116}{31} \quad \frac{45}{38} \quad \frac{50}{41} \quad \frac{43}{48} \quad \frac{40}{50}$$

(9.6)

$$\frac{104}{50} \quad \frac{70}{33} \quad \frac{110}{28} \quad \frac{110}{20} \quad \frac{92}{21} \quad \frac{90}{21} \quad \frac{92}{21} \quad \frac{105}{24} \quad \frac{108}{31} \quad \frac{27}{21} \quad \frac{23}{50}$$

(9.7)

$$\frac{125}{50} \quad \frac{91}{31} \quad \frac{106}{28} \quad \frac{104}{24} \quad \frac{90}{21} \quad \frac{88}{21} \quad \frac{88}{21} \quad \frac{103}{24} \quad \frac{106}{28} \quad \frac{100}{32} \quad \frac{37}{39} \quad \frac{35}{50}$$

(9.0)

$$\frac{166}{50} \quad \frac{122}{33} \quad \frac{108}{25} \quad \frac{92}{21} \quad \frac{86}{21} \quad \frac{88}{21} \quad \frac{101}{24} \quad \frac{105}{31} \quad \frac{46}{37} \quad \frac{44}{50}$$

(9.0)

$$\frac{156}{50} \quad \frac{133}{34} \quad \frac{120}{26} \quad \frac{95}{21} \quad \frac{70}{20} \quad \frac{90}{20} \quad \frac{105}{24} \quad \frac{107}{32} \quad \frac{28}{44} \quad \frac{22}{50}$$

(9.7)

$$\frac{175}{50} \quad \frac{148}{31} \quad \frac{98}{22} \quad \frac{92}{21} \quad \frac{92}{21} \quad \frac{110}{27} \quad \frac{110}{31} \quad \frac{62}{36} \quad \frac{124}{50}$$

(9.5)

$$\frac{180}{50} \quad \frac{158}{33} \quad \frac{101}{21} \quad \frac{96}{21} \quad \frac{96}{21} \quad \frac{118}{25} \quad \frac{120}{30} \quad \frac{90}{33} \quad \frac{66}{50}$$

(9.8)

$$\frac{154}{50} \quad \frac{127}{26} \quad \frac{103}{21} \quad \frac{121}{21} \quad \frac{102}{21} \quad \frac{122}{26} \quad \frac{125}{31} \quad \frac{70}{36} \quad \frac{60}{50}$$

(10.2)

$$\frac{142}{50} \quad \frac{118}{30} \quad \frac{102}{27} \quad \frac{102}{24} \quad \frac{110}{17} \quad \frac{108}{21} \quad \frac{108}{26} \quad \frac{129}{31} \quad \frac{53}{39} \quad \frac{50}{50}$$

(11.0)

Sta	+	H.I	-	Elev.
		942.40		
253	+30			35.3
	+60			34.6
254				33.6
	+50			32.5
255				30.2
T.P.	2.30	933.65 ✓	11.05	931.35 ✓
	+50			28.1
256				25.8
	+30			24.3
	+51			23.3
	+76			22.1
	+93			21.3

$$\frac{82}{50} \quad \frac{66}{32} \quad \frac{74}{20} \quad \frac{94}{24} \quad \frac{74}{20}$$

(7.1)

$$\frac{71}{71} \quad \frac{22}{21} \quad \frac{90}{25} \quad \frac{90}{31} \quad \frac{10}{41} \quad \frac{0.9}{50}$$

$$\frac{65}{50} \quad \frac{58}{35} \quad \frac{100}{30} \quad \frac{100}{25} \quad \frac{80}{21}$$

(7.8)

$$\frac{7.8}{7.8} \quad \frac{7.8}{21} \quad \frac{9.7}{25} \quad \frac{9.8}{31} \quad \frac{1.3}{42} \quad \frac{0.0}{50}$$

$$\frac{65}{50} \quad \frac{48}{47} \quad \frac{42}{40} \quad \frac{110}{30} \quad \frac{110}{26} \quad \frac{88}{21}$$

(8.8)

$$\frac{8.8}{8.8} \quad \frac{8.8}{20} \quad \frac{110}{25} \quad \frac{110}{30} \quad \frac{4.5}{38} \quad \frac{4.3}{50}$$

$$\frac{60}{50} \quad \frac{60}{38} \quad \frac{126}{30} \quad \frac{126}{25} \quad \frac{101}{20}$$

(9.9)

$$\frac{100}{100} \quad \frac{102}{21} \quad \frac{122}{25} \quad \frac{122}{31} \quad \frac{4.4}{40} \quad \frac{4.4}{50}$$

$$\frac{65}{50} \quad \frac{62}{20} \quad \frac{137}{30} \quad \frac{127}{24} \quad \frac{122}{21}$$

(11.7)

$$\frac{11.7}{11.7} \quad \frac{12.0}{22} \quad \frac{18.4}{25} \quad \frac{13.5}{30} \quad \frac{1.40}{31} \quad \frac{3.7}{40} \quad \frac{3.6}{50}$$

$$\frac{20}{50} \quad \frac{22}{36} \quad \frac{77}{30} \quad \frac{77}{25} \quad \frac{56}{21}$$

(5.6)

$$\frac{5.6}{5.6} \quad \frac{5.6}{21} \quad \frac{7.6}{25} \quad \frac{7.3}{31} \quad \frac{1.0}{39} \quad \frac{0.3}{50}$$

$$\frac{85}{50} \quad \frac{85}{31} \quad \frac{103}{29} \quad \frac{100}{24} \quad \frac{82}{21}$$

(7.9)

$$\frac{7.9}{7.9} \quad \frac{7.8}{21} \quad \frac{9.8}{25} \quad \frac{9.8}{29} \quad \frac{7.4}{32} \quad \frac{6.4}{50}$$

$$\frac{120}{50} \quad \frac{120}{41} \quad \frac{115}{25} \quad \frac{100}{21}$$

(9.4)

$$\frac{9.4}{9.4} \quad \frac{9.5}{20} \quad \frac{11.2}{25} \quad \frac{11.2}{30} \quad \frac{10.3}{32} \quad \frac{9.5}{40} \quad \frac{10.5}{50}$$

$$\frac{142}{50} \quad \frac{138}{35} \quad \frac{117}{31} \quad \frac{110}{22}$$

(10.4)

$$\frac{10.4}{10.4} \quad \frac{10.0}{30} \quad \frac{10.5}{33} \quad \frac{10.0}{50}$$

$$\frac{140}{50} \quad \frac{130}{38}$$

(11.6)

$$\frac{11.1}{11.1} \quad \frac{12.0}{50}$$

$$\frac{135}{50} \quad \frac{126}{27}$$

(12.4)

$$\frac{12.0}{12.0} \quad \frac{11.5}{28} \quad \frac{8.8}{50}$$

Sta	+	H.I.	-	Elev.
		933.65		
257				21.1
T.P.	1.79	920.18 ✓	12.26	921.39 ✓
B.M.	430	921.68	5.79	917.39 = 917.38
+14				20.6
+50				19.1
258				17.3
+50				15.7
259				14.2
+50				12.9
260				11.8
T.P.	6.04	915.94	11.78	909.90
+50				10.8
+75				10.3

$\frac{135}{50}$	$\frac{130}{33}$	$\frac{125}{20}$	$\frac{126}{11.4}$	$\frac{122}{20}$	$\frac{113}{37}$	$\frac{112}{50}$
------------------	------------------	------------------	--------------------	------------------	------------------	------------------

R.R. spike in 10" shred Oct 60' Rt Sta 258+50

$\frac{28}{50}$	$\frac{14}{20}$	$\frac{14}{20}$	$\frac{14}{20}$	$\frac{0.7}{26}$	$\frac{0.0}{31}$	$\frac{0.7}{50}$
-----------------	-----------------	-----------------	-----------------	------------------	------------------	------------------

$\frac{40}{50}$	$\frac{2.7}{20}$	$\frac{2.7}{20}$	$\frac{2.7}{20}$	$\frac{2.0}{21}$	$\frac{0.6}{50}$
-----------------	------------------	------------------	------------------	------------------	------------------

$\frac{27}{50}$	$\frac{22}{38}$	$\frac{27}{34}$	$\frac{23}{25}$	$\frac{4.2}{19}$	$\frac{44}{40}$	$\frac{3.7}{22}$	$\frac{3.0}{29}$	$\frac{3.4}{47}$	$\frac{6.0}{50}$
-----------------	-----------------	-----------------	-----------------	------------------	-----------------	------------------	------------------	------------------	------------------

$\frac{70}{50}$	$\frac{76}{30}$	$\frac{98}{28}$	$\frac{27}{25}$	$\frac{55}{19}$	$\frac{6}{58}$	$\frac{5.6}{25}$	$\frac{8.3}{32}$	$\frac{8.2}{34}$	$\frac{7.2}{36}$	$\frac{6.5}{50}$
-----------------	-----------------	-----------------	-----------------	-----------------	----------------	------------------	------------------	------------------	------------------	------------------

$\frac{2.5}{50}$	$\frac{91}{30}$	$\frac{101}{27}$	$\frac{101}{25}$	$\frac{23}{19}$	$\frac{72}{72}$	$\frac{7.4}{20}$	$\frac{8.8}{24}$	$\frac{7.0}{28}$	$\frac{6.6}{32}$	$\frac{5.6}{50}$
------------------	-----------------	------------------	------------------	-----------------	-----------------	------------------	------------------	------------------	------------------	------------------

$\frac{105}{30}$	$\frac{8.5}{31}$	$\frac{11.4}{26}$	$\frac{11.4}{25}$	$\frac{8.2}{19}$	$\frac{83}{24}$	$\frac{92}{20}$	$\frac{102}{24}$	$\frac{102}{30}$	$\frac{12}{34}$	$\frac{3.8}{41}$	$\frac{3.3}{50}$
------------------	------------------	-------------------	-------------------	------------------	-----------------	-----------------	------------------	------------------	-----------------	------------------	------------------

$\frac{102}{50}$	$\frac{91}{32}$	$\frac{12.4}{28}$	$\frac{12.4}{25}$	$\frac{9.4}{19}$	$\frac{99}{77}$	$\frac{102}{22}$	$\frac{11.5}{26}$	$\frac{11.5}{30}$
------------------	-----------------	-------------------	-------------------	------------------	-----------------	------------------	-------------------	-------------------

$\frac{118}{53}$	$\frac{10}{36}$	$\frac{76}{30}$	$\frac{75}{24}$	$\frac{4.5}{20}$	$\frac{51}{46}$	$\frac{5.3}{21}$	$\frac{6.5}{25}$	$\frac{6.8}{27}$
------------------	-----------------	-----------------	-----------------	------------------	-----------------	------------------	------------------	------------------

$\frac{42}{50}$	$\frac{10}{36}$	$\frac{82}{30}$	$\frac{78}{25}$	$\frac{52}{20}$	$\frac{56}{52}$	$\frac{6.1}{21}$	$\frac{7.4}{26}$	$\frac{7.4}{30}$
-----------------	-----------------	-----------------	-----------------	-----------------	-----------------	------------------	------------------	------------------

Sta	+	HZ	-	Elev.
261		915.94		09.8
+60				08.7
262				07.8
+50				06.8
	3.09	910.84	869	907.25
263				05.8
+45				04.8
264				03.8
+36				03.1
+69				02.4
265				01.8
+20				01.4
+56				900.7



Sta	+	HZ	-	Elev
		910.34.		
266				899.8
+75				98.5
267				97.8
T.P.	13.15	923.00.	0.49	909.85.
260+00				11.8
T.P.	11.13	933.10.	1.03	921.77.
+50				10.8
+75				10.3
261				09.8
+60				08.7
262				07.8
+50				06.8
T.P.	08.4	922.77.	1.17	921.93.
263				05.8
T.P.	5.28	915.61.	12.44	910.33.

$$\frac{250}{46}$$

$$\frac{237}{41}$$

$$\frac{114}{20}$$

(10.5)

$$\frac{113}{20}$$

$$\frac{113}{20}$$

$$\frac{211}{30}$$

$$\frac{211}{49}$$

$$\frac{205}{50}$$

$$\frac{243}{44}$$

$$\frac{124}{20}$$

(11.8)

$$\frac{125}{20}$$

$$\frac{125}{20}$$

$$\frac{206}{36}$$

$$\frac{220}{41}$$

$$\frac{220}{45}$$

$$\frac{215}{46}$$

$$\frac{205}{50}$$

(12.5)

$$\frac{255}{50}$$

$$\frac{237}{40}$$

$$\frac{127}{20}$$

$$\frac{127}{19}$$

$$\frac{128}{19}$$

$$\frac{215}{39}$$

$$\frac{221}{41}$$

$$\frac{223}{44}$$

$$\frac{210}{45}$$

$$\frac{203}{50}$$

(11.2)

$$\frac{10}{43}$$

$$\frac{07}{45}$$

$$\frac{01}{50}$$

(12.3)

$$\frac{50}{49}$$

$$\frac{41}{50}$$

(22.8)

$$\frac{30}{50}$$

$$\frac{26}{52}$$

(83.3)

$$\frac{26}{50}$$

$$\frac{23}{52}$$

(24.4)

$$\frac{73}{51}$$

$$\frac{68}{53}$$

(25.3)

$$\frac{85}{50}$$

$$\frac{78}{52}$$

(26.3)

$$\frac{130}{49}$$

$$\frac{125}{51}$$

(11.0)

$$\frac{112}{50}$$

$$\frac{104}{43}$$

$$\frac{86}{50}$$

5th + HI - Flow

915.61

263+45

904.8

264

03.8

136

03.1

+69

02.4

T.P.

1.35

903.74

13.22

902.39

1.62

898.80

6.56

897.18

4.72

896.13

7.38

891.42

891.41

267+25 }  
268+35 }

Final X section  
on Pages 84-85

268+50

94.8

269

93.8

+50

92.8

270

91.8

+50

890.8

(10.8)

$$\frac{21}{35} \quad \frac{67}{39} \quad \frac{49}{50}$$

(11.8)

$$\frac{40}{43} \quad \frac{31}{46} \quad \frac{44}{50}$$

(12.5)

$$\frac{55}{42} \quad \frac{46}{45} \quad \frac{36}{50}$$

(13.2)

$$\frac{113}{34} \quad \frac{103}{38} \quad \frac{98}{50}$$

(13)

$$\frac{108}{50} \quad \frac{97}{34} \quad \frac{18}{19} \quad 15 \quad \frac{15}{20} \quad \frac{100}{34} \quad \frac{102}{50}$$

(2.3)

$$\frac{105}{50} \quad \frac{113}{40} \quad \frac{107}{25} \quad \frac{24}{20} \quad 26 \quad \frac{26}{20} \quad \frac{122}{41} \quad \frac{128}{50}$$

(3.3)

$$\frac{72}{50} \quad \frac{82}{39} \quad \frac{96}{36} \quad \frac{90}{29} \quad \frac{38}{20} \quad 38 \quad \frac{32}{20} \quad \frac{127}{39} \quad \frac{133}{50}$$

(4.3)

$$\frac{38}{50} \quad \frac{52}{32} \quad \frac{88}{29} \quad \frac{58}{28} \quad \frac{49}{20} \quad 47 \quad 59 \quad \frac{128}{38} \quad \frac{133}{50}$$

(5.3)

$$\frac{23}{50} \quad \frac{40}{36} \quad \frac{82}{31} \quad \frac{80}{25} \quad \frac{59}{20} \quad 52 \quad \frac{46}{20} \quad \frac{120}{35} \quad \frac{132}{50}$$

Sta

+

HI

-

Elev

896.13

271

89.8

+29

89.5

+65

88.6

272

88.1

+25

87.7

+56

87.5

273

86.9

+38

86.6

+25

86.5

274

86.5

T.P

912

905.32

2.53

895.60

272 + 25

87.7

+56

87.4



Sta		H I	-	Elev
		905.32		
273				86.9
+38				86.6
+75				86.5
274				86.4
T.P.	0.98	898.55	12.75	892.57
+50				86.2
275				86.1
+50				85.9
276				85.8
+50				85.6
277				85.5
+50				885.3

$$\frac{27}{52} \quad \frac{31}{20}$$

(8.4)

$$\frac{6.8}{50} \quad \frac{73}{48}$$

(8.7)

$$\frac{8.8}{51} \quad \frac{90}{49}$$

(8.8)

$$\frac{130}{50} \quad \frac{133}{48}$$

(15.9)

$$\frac{7.8}{50} \quad \frac{80}{49} \quad \frac{9.3}{46} \quad \frac{89}{24} \quad \frac{72}{21} \quad \frac{65}{20} \quad \frac{56}{20} \quad \frac{8.9}{24} \quad \frac{90}{46} \quad \frac{5.2}{50}$$

(7.4)

$$\frac{120}{50} \quad \frac{123}{30} \quad \frac{7.8}{21} \quad \frac{65}{20} \quad \frac{61}{20} \quad \frac{117}{33} \quad \frac{11.8}{50}$$

(7.5)

$$\frac{143}{50} \quad \frac{138}{32} \quad \frac{7.7}{21} \quad \frac{68}{20} \quad \frac{62}{20} \quad \frac{140}{32} \quad \frac{14.3}{50}$$

(7.7)

$$\frac{143}{50} \quad \frac{140}{35} \quad \frac{7.8}{22} \quad \frac{68}{20} \quad \frac{6.5}{20} \quad \frac{144}{37} \quad \frac{14.8}{50}$$

(7.8)

$$\frac{11.8}{50} \quad \frac{11.7}{28} \quad \frac{8.0}{21} \quad \frac{80}{20} \quad \frac{63}{19} \quad \frac{132}{33} \quad \frac{13.8}{50}$$

(8.0)

$$\frac{84}{50} \quad \frac{84}{44} \quad \frac{11.5}{45} \quad \frac{110}{34} \quad \frac{103}{38} \quad \frac{9.5}{25} \quad \frac{83}{21} \quad \frac{72}{20} \quad \frac{6.5}{20} \quad \frac{8.6}{25} \quad \frac{11.9}{48} \quad \frac{11.3}{49} \quad \frac{11.5}{50}$$

(8.1)

$$\frac{3.7}{50} \quad \frac{10.7}{44} \quad \frac{9.1}{24} \quad \frac{8.1}{21} \quad \frac{73}{20} \quad \frac{6.7}{20} \quad \frac{7.8}{23} \quad \frac{96}{44} \quad \frac{62}{47} \quad \frac{6.3}{50}$$

(8.3)

sta	+	HZ	-	Elev
		893.55.		
278				885.2
	+40			85.2
	+70			84.9
279				84.9
T.P.	11.01	902.08.	248	891.07.
278				85.2
	+40			85.2
	+70			84.9
279				84.9
T.P.	088	891.95.	11.01	891.07.
T.P.	125	887.10.	6.10	885.85.
279+50				84.7
280				84.6
	+50			84.6

(8.4)

$\frac{10.4}{40}$	$\frac{9.5}{23}$	$\frac{8.5}{20}$	78	$\frac{6.8}{20}$	$\frac{7.7}{23}$	$\frac{8.2}{31}$	$\frac{7.4}{42}$
-------------------	------------------	------------------	----	------------------	------------------	------------------	------------------

(8.1)

$\frac{10.6}{38}$	$\frac{10.0}{23}$	$\frac{8.6}{20}$	80	$\frac{7.0}{19}$	$\frac{7.8}{22}$	$\frac{8.5}{31}$	$\frac{9.2}{35}$	$\frac{9.7}{42}$
-------------------	-------------------	------------------	----	------------------	------------------	------------------	------------------	------------------

(8.7)

$\frac{11.0}{38}$	$\frac{9.8}{24}$	$\frac{8.5}{20}$	81	$\frac{7.3}{19}$	$\frac{8.5}{23}$	$\frac{9.0}{34}$	$\frac{9.5}{37}$	$\frac{10.1}{43}$
-------------------	------------------	------------------	----	------------------	------------------	------------------	------------------	-------------------

(8.7)

$\frac{11.3}{39}$	$\frac{10.0}{25}$	$\frac{8.4}{20}$	80	$\frac{7.4}{20}$	$\frac{9.0}{22}$	$\frac{10.0}{35}$	$\frac{11.0}{39}$	$\frac{11.3}{44}$
-------------------	-------------------	------------------	----	------------------	------------------	-------------------	-------------------	-------------------

(16.9)

$\frac{4.6}{51}$	$\frac{8.8}{49}$	$\frac{8.9}{50}$
------------------	------------------	------------------

(16.9)

$\frac{3.2}{50}$	$\frac{8.8}{50}$
------------------	------------------

(17.2)

$\frac{4.0}{50}$	$\frac{10.5}{50}$
------------------	-------------------

(17.2)

$\frac{8.1}{50}$	$\frac{9.2}{48}$	$\frac{15.0}{49}$	$\frac{15.2}{50}$
------------------	------------------	-------------------	-------------------

(2.4)

$\frac{1.5}{50}$	$\frac{2.0}{45}$	$\frac{6.0}{40}$	$\frac{4.3}{26}$	$\frac{2.0}{20}$	1.6	$\frac{1.3}{20}$	$\frac{4.5}{26}$	$\frac{6.5}{47}$	$\frac{5.7}{49}$	$\frac{5.7}{50}$
------------------	------------------	------------------	------------------	------------------	-----	------------------	------------------	------------------	------------------	------------------

(2.5)

$\frac{1.5}{50}$	$\frac{2.8}{43}$	$\frac{6.4}{42}$	$\frac{5.1}{27}$	$\frac{1.8}{20}$	$\frac{1.1}{20}$	$\frac{8.2}{31}$	$\frac{8.7}{50}$
------------------	------------------	------------------	------------------	------------------	------------------	------------------	------------------

(2.5)

$\frac{6.0}{50}$	$\frac{6.3}{46}$	$\frac{7.1}{44}$	$\frac{7.3}{29}$	$\frac{1.6}{17}$	$\frac{1.5}{20}$	$\frac{9.5}{34}$	$\frac{9.8}{50}$
------------------	------------------	------------------	------------------	------------------	------------------	------------------	------------------

Sta	+	HI	-	Eleu
		887.10		
281				84.6
	+50			84.8
282				85.0
	+50			85.2
283				85.4
284				85.6
285				85.6
T.P.	2.15	888.25	1.00	886.10
	+50			85.6
286				85.6
B.M.			5.94	882.31
	+50			85.5
287				85.4

882.34

$$\frac{5.7}{50} \quad \frac{60}{46} \quad \frac{22}{44} \quad \frac{7.8}{30} \quad \frac{20}{29} \quad \frac{68.13}{27.18} \quad \frac{12}{19} \quad \frac{14}{19} \quad \frac{96}{34} \quad \frac{9.8}{50}$$

(25)

$$\frac{44}{50} \quad \frac{45}{48} \quad \frac{20}{44} \quad \frac{20}{29} \quad \frac{6.0}{27} \quad \frac{11}{19} \quad \frac{0.9}{17} \quad \frac{11}{17} \quad \frac{9.2}{35} \quad \frac{10.0}{50}$$

(23)

$$\frac{45}{50} \quad \frac{4.6}{48} \quad \frac{7.5}{43} \quad \frac{25}{29} \quad \frac{5.6}{27} \quad \frac{1.0}{20} \quad \frac{1.0}{19} \quad \frac{1.0}{19} \quad \frac{8.8}{34} \quad \frac{9.5}{50}$$

(21)

$$\frac{46}{50} \quad \frac{44}{49} \quad \frac{28}{45} \quad \frac{8.2}{33} \quad \frac{1.2}{25} \quad \frac{1.0}{19} \quad \frac{11}{19} \quad \frac{9.2}{34} \quad \frac{9.7}{50}$$

(19)

$$\frac{5.8}{52} \quad \frac{5.8}{48} \quad \frac{8.5}{44} \quad \frac{8.8}{32} \quad \frac{0.9}{20} \quad \frac{0.6}{19} \quad \frac{0.7}{19} \quad \frac{10.0}{37} \quad \frac{10.5}{50}$$

(17)

$$\frac{8.7}{50} \quad \frac{90}{48} \quad \frac{9.7}{46} \quad \frac{9.3}{32} \quad \frac{1.0}{20} \quad \frac{12}{20} \quad \frac{12}{20} \quad \frac{10.6}{39} \quad \frac{9.6}{50}$$

(15)

Raised

$$\frac{10.5}{50} \quad \frac{114}{49} \quad \frac{11.0}{46} \quad \frac{10.1}{48} \quad \frac{10.2}{39} \quad \frac{12}{20} \quad \frac{12}{20} \quad \frac{11}{19} \quad \frac{9.7}{33} \quad \frac{10.2}{50}$$

(13)

$$\frac{11.5}{53} \quad \frac{130}{51} \quad \frac{12.8}{47} \quad \frac{11.1}{46} \quad \frac{11.6}{40} \quad \frac{26}{24} \quad \frac{26}{26} \quad \frac{26}{26} \quad \frac{11.6}{42} \quad \frac{12.0}{50}$$

(27)

+75 Bml H.D.

$$\frac{12.0}{50} \quad \frac{12.5}{43} \quad \frac{2.5}{26} \quad \frac{2.0}{27} \quad \frac{2.6}{27} \quad \frac{10.8}{41} \quad \frac{11.4}{50}$$

$$\frac{12.2}{50} \quad \frac{12.2}{44} \quad \frac{2.8}{29} \quad \frac{2.7}{29} \quad \frac{2.7}{29} \quad \frac{10.8}{42} \quad \frac{10.8}{50}$$

$$\frac{12.0}{50} \quad \frac{12.0}{45} \quad \frac{3.0}{28} \quad \frac{2.7}{27} \quad \frac{2.7}{27} \quad \frac{9.5}{40} \quad \frac{10.0}{50}$$

- 549	+	14 I	-	Elev
		888.25.		
+50				85.2
+86				85.0
288				85.0
+28				84.8
289				84.4
+50				84.1
290				83.8
+50				83.5
291				83.2
+17				83.1
+50				82.9
T.R	10.21	896.73.	1.73	886.52.



Sta		HI		Elev
		896.73		
291				83.2
+17				83.1
+50				82.9
T.P	1.42	887.94	1.02	886.52
B.M.	1.88	887.97	1.88	886.06
292				82.6
+50				82.3
293				82.0
+50				81.8
294				81.7
+50				81.6
295				81.5
+50				81.65

886.09

$$\frac{40}{50}$$

(135)

$$\frac{2.3}{50}$$

(136)

$$\frac{10.0}{50}$$

(138)

sp. no in 8" oak 6x51-29'+20"

$$\frac{67}{50} \quad \frac{7.5}{48} \quad \frac{77}{27} \quad \frac{43}{20} \quad \frac{54}{58} \quad \frac{70}{22} \quad \frac{90}{28} \quad \frac{9.5}{50}$$

$$\frac{94}{50} \quad \frac{77}{31} \quad \frac{47}{22} \quad \frac{57}{22} \quad \frac{21}{22} \quad \frac{101}{28} \quad \frac{104}{50}$$

$$\frac{108}{50} \quad \frac{108}{31} \quad \frac{53}{21} \quad \frac{63}{22} \quad \frac{7.5}{26} \quad \frac{102}{28} \quad \frac{10.2}{50}$$

$$\frac{107}{50} \quad \frac{107}{30} \quad \frac{59}{20} \quad \frac{69}{22} \quad \frac{77}{22} \quad \frac{106}{28} \quad \frac{10.3}{50}$$

$$\frac{107}{50} \quad \frac{107}{31} \quad \frac{56}{20} \quad \frac{68}{22} \quad \frac{81}{22} \quad \frac{104}{28} \quad \frac{10.5}{50}$$

$$\frac{94}{50} \quad \frac{97}{29} \quad \frac{55}{20} \quad \frac{61}{22} \quad \frac{77}{22} \quad \frac{9.8}{25} \quad \frac{10.3}{50}$$

$$\frac{63}{50} \quad \frac{72}{37} \quad \frac{78}{36} \quad \frac{74}{33} \quad \frac{78}{25} \quad \frac{51}{20} \quad \frac{80}{22} \quad \frac{94}{25} \quad \frac{101}{45} \quad \frac{82}{42} \quad \frac{82}{50}$$

$$\frac{80}{28} \quad \frac{78}{23} \quad \frac{56}{20} \quad \frac{83}{21} \quad \frac{7.8}{24} \quad \frac{102}{45} \quad \frac{7.6}{29} \quad \frac{76}{50}$$

887.97.

295+25

81.6

296

81.6

T.P.

490

887.21.

5.66

882.31.

+21

81.6

+50

81.6

297

81.7

5.5

+50

81.75

5.4

298

81.8

5.4

+25

81.8

5.4

299

81.9

5.3

+50

81.95

5.2

299+79.9  
= 298+82.21

82.0

5.2

B.N.

9.41

895.50.

114

886.01.

886.09.

$$\begin{array}{ccccccc} \frac{78}{27} & \frac{78}{23} & \frac{60}{20} & \textcircled{64} & \frac{72}{21} & \frac{98}{26} & \frac{101}{46} & \frac{64}{50} \end{array}$$

$$\begin{array}{ccccccc} \frac{76}{29} & \frac{87}{24} & \frac{62}{20} & \textcircled{64} & \frac{70}{22} & \frac{97}{27} & \frac{100}{44} \end{array}$$

$$\begin{array}{ccccccc} \frac{72}{30} & \frac{72}{24} & \frac{52}{20} & 55 & \frac{63}{22} & \frac{90}{29} & \frac{73}{43} \end{array}$$

$$\begin{array}{ccccccc} \frac{72}{30} & \frac{73}{24} & \frac{52}{20} & \textcircled{56} & \frac{58}{22} & \frac{88}{27} & \frac{71}{40} \end{array}$$

$$\begin{array}{ccccccc} \frac{68}{30} & \frac{70}{24} & \frac{51}{20} & 53 & \frac{58}{21} & \frac{83}{27} & \frac{85}{40} \end{array}$$

$$\begin{array}{ccccccc} \frac{72}{29} & \frac{72}{23} & \frac{54}{20} & 52 & \frac{54}{22} & \frac{80}{27} & \frac{83}{40} \end{array}$$

$$\begin{array}{ccccccc} \frac{73}{27} & \frac{74}{22} & \frac{54}{20} & 52 & \frac{56}{21} & \frac{80}{27} & \frac{82}{41} \end{array}$$

$$\begin{array}{ccccccc} \frac{75}{29} & \frac{74}{23} & \frac{56}{20} & 54 & \frac{56}{21} & \frac{83}{28} & \frac{82}{44} & \frac{34}{50} \end{array}$$

$$\begin{array}{ccccccc} \frac{70}{28} & \frac{71}{24} & \frac{55}{20} & 51 & \frac{56}{22} & \frac{76}{28} & \frac{82}{41} & \frac{62}{50} \end{array}$$

$$\begin{array}{ccccccc} \frac{71}{29} & \frac{71}{25} & \frac{55}{21} & 50 & \frac{52}{21} & \frac{73}{27} & \frac{80}{46} & \frac{88}{50} \end{array}$$

$$\begin{array}{ccccccc} \frac{66}{30} & \frac{77}{29} & \frac{74}{25} & \frac{52}{21} & 52 & \frac{52}{20} & \frac{87}{28} & \frac{100}{50} \end{array}$$

		H Z	-	Elev	
279	+				
		895.50			
295+50				81.65	13.8
T.P	7.62	899.96	5.16	890.34	
+75				81.6	18.4
296				81.6	18.4
+21				81.6	18.4
+50				81.6	18.4
297				81.7	18.3
+50				81.75	18.2
298				81.8	18.1
+25				81.8	18.1
299				81.9	18.1
T.P.	1.67	891.79	9.84	890.12	
+50				81.95	9.8
299+79.03 = 284+83.21				82.0	
T.P	4.93	886.86	9.86	881.93	

$$\frac{21}{50}$$

$$\frac{28}{36}$$

$$\frac{32}{50}$$

$$\frac{34}{44}$$

$$\frac{27}{50}$$

$$\frac{26}{45}$$

$$\frac{156}{50}$$

$$\frac{26}{50}$$

$$\frac{25}{44}$$

$$\frac{131}{50}$$

$$\frac{32}{50}$$

$$\frac{29}{45}$$

$$\frac{94}{50}$$

$$\frac{50}{50}$$

$$\frac{53}{43}$$

$$\frac{54}{50}$$

$$\frac{65}{50}$$

$$\frac{65}{42}$$

$$\frac{25}{50}$$

$$\frac{93}{50}$$

$$\frac{97}{38}$$

$$\frac{138}{49}$$

$$\frac{136}{50}$$

$$\frac{105}{50}$$

$$\frac{111}{37}$$

$$\frac{143}{50}$$

$$\frac{143}{34}$$

$$\frac{88}{50}$$

$$\frac{94}{31}$$

$$\frac{108}{50}$$

$$\frac{114}{30}$$

Sta	+	HI	-	Elev	
T		886.86			
299				819	
	+50			819.5	
300				82.0	4.9
	+45			82.0	4.9
301				82.0	4.9
	+50			82.0	4.9
	+80			82.0	4.9
T.P.	10.64	896.10	1.40	885.46	
	+80			82.0	14.1
T.P.	1.42	886.88	10.64	885.46	
B.M.			1.30	877.58	877.62

$$\frac{6.3}{50} \quad \frac{32}{26} \quad \frac{49}{21} \quad 4.8 \quad \frac{4.8}{20} \quad \frac{5.8}{28} \quad \frac{10.1}{50}$$

$$\frac{8.5}{50} \quad \frac{8.2}{26} \quad \frac{5.3}{20} \quad 4.8 \quad \frac{5.0}{21} \quad \frac{9.5}{30} \quad \frac{10.6}{50}$$

$$\frac{9.0}{50} \quad \frac{9.0}{28} \quad \frac{5.3}{20} \quad 5.1 \quad \frac{5.3}{20} \quad \frac{10.0}{30} \quad \frac{10.5}{50}$$

$$\frac{9.4}{50} \quad \frac{9.0}{27} \quad \frac{5.1}{20} \quad 5.1 \quad \frac{5.3}{20} \quad \frac{10.4}{31} \quad \frac{10.6}{50}$$

$$\frac{7.6}{50} \quad \frac{7.7}{37} \quad \frac{9.4}{35} \quad \frac{9.4}{33} \quad \frac{7.8}{32} \quad \frac{6.0}{26} \quad \frac{5.4}{19} \quad 5.0 \quad \frac{5.1}{20} \quad \frac{9.7}{29} \quad \frac{10.0}{50}$$

$$\frac{2.4}{50} \quad \frac{2.5}{38} \quad \frac{7.4}{33} \quad \frac{6.7}{22} \quad \frac{5.2}{19} \quad 5.0 \quad \frac{4.8}{20} \quad \frac{8.7}{28} \quad \frac{9.7}{50}$$

$$\frac{7.1}{31} \quad \frac{7.0}{25} \quad \frac{5.4}{20} \quad 5.0 \quad \frac{4.8}{20} \quad \frac{7.3}{25} \quad \frac{9.5}{50}$$

$$\frac{1.5}{50} \quad \frac{1.9}{45}$$

Top RW Hub 50' Pt sta 301+100

177

176

175

174

173

+8

172

+58 Drive Rt 24x15" CM New

171

F 35'  
 +84 P 30  
 +79 T 34  
 +39 T 34'  
 +06 T 34'  
 F 35'  
 +65 T 33  
 +25 T 34'  
 F 36'  
 +88 T 34  
 +51 T 34  
 +14 P P 30'  
 +08 T 34  
 F 37'  
 +72 T 34  
 +32 T 35'  
 +11 T 33'  
 +60 P P 29'  
 F 38'  
 +05 T 35'  
 +72 F 35'  
 +92 X F F 33  
 +15 F C 33  
 +65 P P 30  
 +80 T 32

Pasture

~~-----~~  
~~-----~~

Cultivated

- - -  
 - - -

+79 T 34  
 + 31 T P 34  
 +02 T 34'  
 +25 T 34  
 +88 T P 34  
 +86 T 33  
 +08 T 32'  
 +38 T P 33  
 +30 T 31'  
 +92 T 31'  
 +14 T 30  
 +90 T P 32  
 +70 E C 32  
 +65 X F 28  
 +80 T 32'

183

182

181

180

179

178

F 40

+06 PP 30'

F 35'

+91 T 33'

+55 T 33'

+08 T 33'

F. 34'

+71 T 33'

+35 T 33'

F. 34'

+98 T 33'

+17 T 33'

+36 PP 30'

+21 T 33'

F 34'

+84 T 33'

+44 T 33'

+04 T 33'

F. 35'

+64 T 34'

+99 T 34'

+62 T 34'

+25 T. 35'

+11 TP 36'

+91 T. 36'

+48 T 36'

+71 T 36'

+20 TP 35'

+34 T 35'

+58 T 35'

+34 TP 35'

+21 T. 33'

+84 T 34'

+44 T 34'

+99 TP 34'

+64 T 35'

189

+94 X SWC 29' 27' 20m. 12" X 7'  
+90 & Drive Rt.

188

+40 & Rd Rt A+35'

187

+33 & Drive Lt.

186

185

184

+50 PP 30'

Row.  
+04 X Tree 38'

+98 X Hedge 50'

+87 X Hedge 50'

+82 X Row Tree 38'

+32 T 34'

+92 T 34'

+57 T 26'

+25 T 36'

28 New VP

+08 New Man Hole T'

00+00 PP 32'

+86 T 36'

+72 T 36'

+35 T 36'

+09 T 36'

+78 T 36'

+46 T 36'


+46 PP 33'

+55 PP 57' + 1.1  
+55 XF + End Fence 57'

Hackney Farm



Nolan Estate

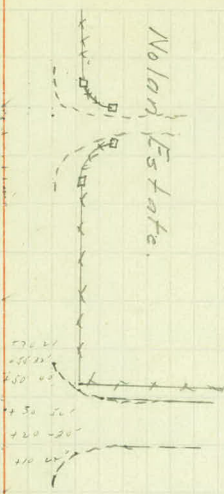

+13 NB 30'  
+15 Con Post 32'  
+09 F 34'  
+00 Con Post 48'

+81 Con 45'  
+75 F 36'  
+63 Con Post 32'

F 52.5

+59 F C. 132' 485'

+99 TP 39'

+92 NB 21'

+26 TP 37'

+44 T 40'

+96 T.P 35'

+78 T 40'

+45 T 40'

+51 TP 31'

+37 T 34'

195

194


193

192

191

+41 E Drive Lt 15" x 24 CM No W

190

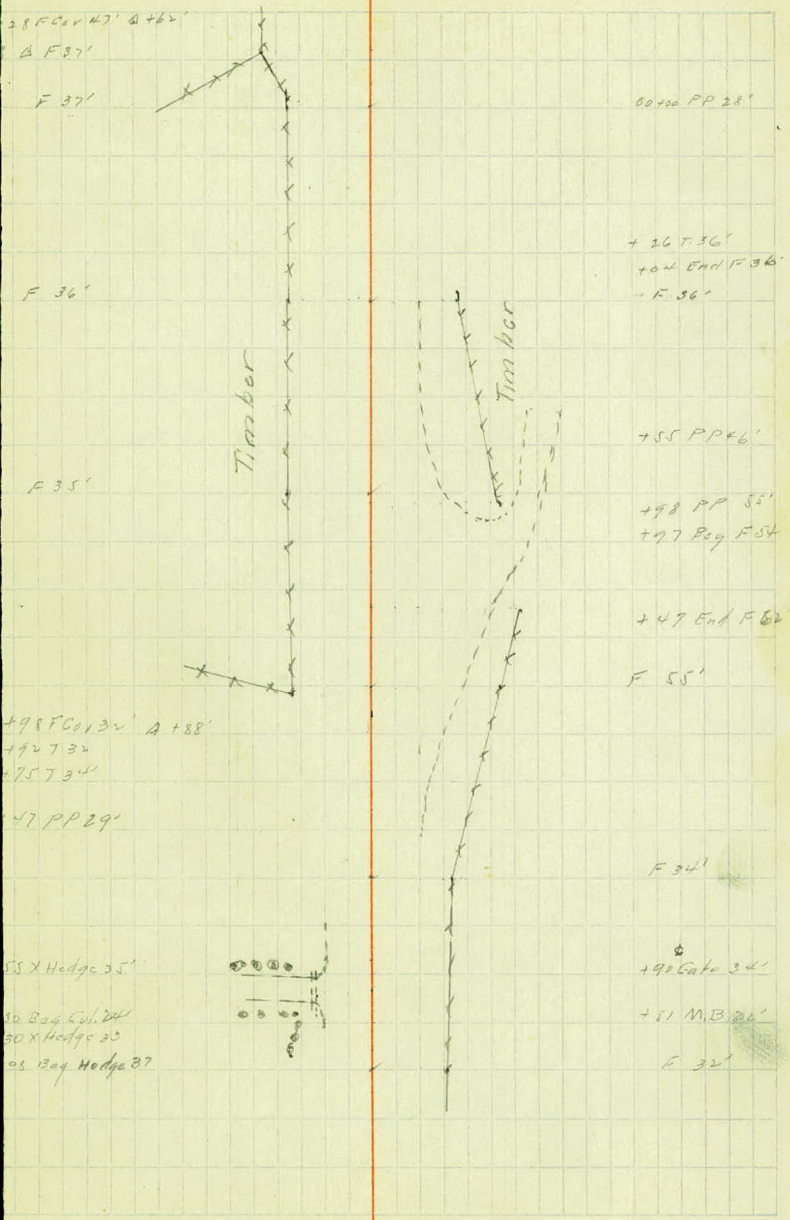

28 FC or 47' @ +62'  
@ F 37'

F 37'

60.000 PP 28'

F 36'

+ 26 F 36'  
+ 04 End F 36'  
- F 36'

Timber

Timber

F 35'

+ 55 PP 46'

+ 98 PP 55'  
+ 97 Beg F 54'

+ 47 End F 62'

F 55'

+ 98 FC or 132' @ +88'  
+ 92 7 32  
+ 75 7 34

+ 47 PP 29'

F 34'

55 X Hedge 35'

190 Gate 34'

30 Bay Cul. 24'  
30 X Hedge 33'  
30 Bay Hedge 37'

+ 51 M.B. 26'

F 32'

201

200

\*77 Double  
Drive Way Rt. CM 15" x 30 New

199

+85 Drive Rt 12" x 17 CM Old

+02 2 Drive Rt A 100 42" x 22" CM, 10ld.

198

197

+11 X Drain

34' Rt.  
38' Lt 24" x 17 1/2" P<sup>s</sup>.

196

+09 TP42'

F 31'

F 341  
 + 75 MB 31  
 + 90 PP 32'  
 + 78 X Hedge  
 + 62 BCG C-1 27'

+75 TP34'

F 35'

+ 77 BCG C-1 33'  
 + 17 PP 29'  
 + 14 MB 21  
 + 13 FC 4 20'  
 + 95 BCG C-1 34'

+51 TT 37'  
 +27 FC 4 34' A158


F. 35'

+83' GF 28'

F 40'

471

+50 TP 30'

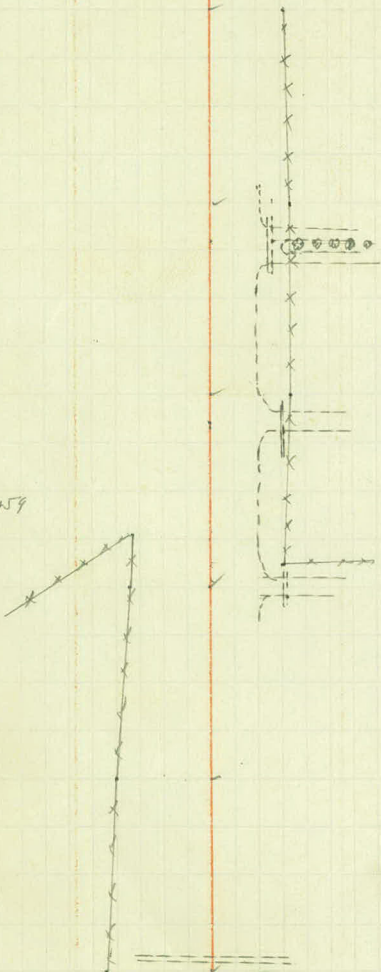

207

206

205

+22 B Drive Rt  $\Delta +30$  15' X 24' CM Nov.

204

203

+92 E Drive Rt  $\Delta 21300$  CM 15' X 24' Nov.

202

+47 R Drive Rt  $\Delta 43$  15' X 24' Nov.

+85 TP 35'

+19 TP 44'

+33 TP 46'

+95 TP 43'

Pasture.



100 & Hamline Ave 57'

+58 Rd 39 28'

110 & Ham Ave 31'

+

+68 PP 48'

+50 RD 24'

Rd 27'

+90 & Hamline Ave.

+46 PP 30'

+36 RR 23'

+10 Bay Cul 26'

405 PP 32'

+81 Bay Cul 24'

127 KF 31 32

+37 Ent H. 31'

Low Hed. 30'

+57 Bay Hed. 30'

+42 FC. V. 31 47

+39 PP 29'

+36 B.Cul 22

213

+95 X Drain

31<sup>1</sup>/<sub>2</sub> Lt.

35

24" X 66' P<sub>3</sub>

212

+39 # Drive Lt.

Δ +05

15" X 24 CM Now

211

+25 Drive R + Δ +50

15" X 120' CM IVeuv

210

209


+00 X Drain

33<sup>1</sup>/<sub>2</sub> Lt.

33

24" X 66' P<sub>3</sub>.

208

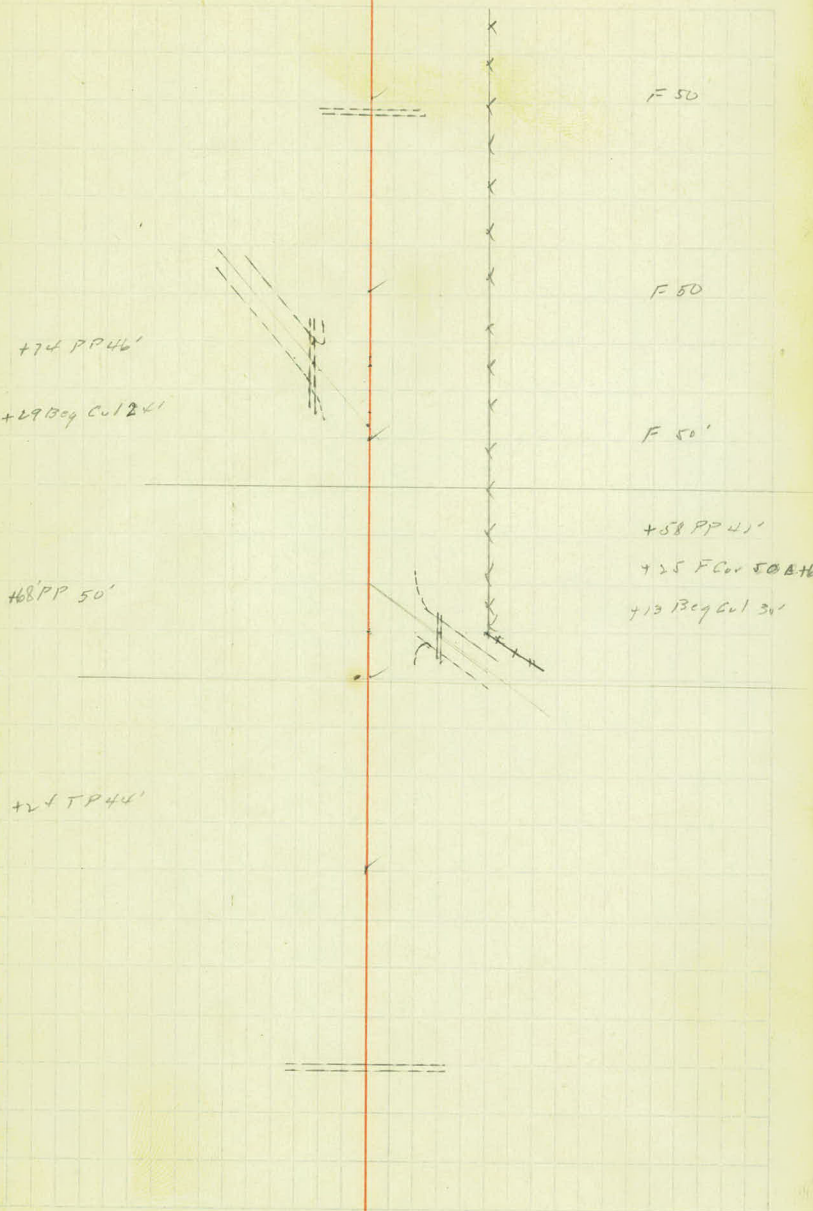

219

218

217

+55<sup>5</sup> Center Bridge.

216

215

214



F 50'

F 50'

+00 T. 46' F 50'

+67 End Bridge.

+44 Beg. Bridge.



+16 T. 50'



F 50'

+86 X F. enco 50'

F 57'

F 50'

225

224

223

222

221

220



F 50

F 50

F 50

F 50'

Pasture.

F 50'

F 50

231

H<sub>2</sub> Drive Lt

15" x 20" CM 16W


230

229

228

227

226

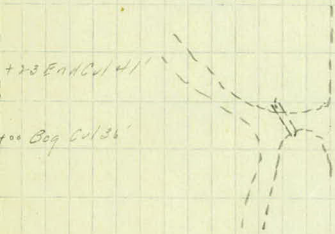

+23 End C/41'

100 Bog C/36'



F 50'

F 52'

F 50

F 51

52

F 50'

+02 2 X Cattle Pass 4' x 6' x 42'  
238

+02 X Drain 108' x  $\textcircled{24}$ ' P3  
237 30"

236

235

234

233

+17 6 Drive Lt 20'  $\Delta$  sta 232+00

232 /

Cattle Pass

F 47

+18.54'

45.1 +1.8

F 59

F 39'

F 49

F 37

F 50

F 37

X Fence Sd' A+77.

+22.4 F 36

F 39

F 40

F 49



244

243

242

763 Drive W 15° 124 CM No W

241

240

239

F 41

F 49

F 44

F 48

F 46

F 48'

+ 51 Bag 50/26

F 47

F 49

F 54

F 49'

F 48

F 50

Timber

Timber



250

249

248

+68  $\pm$  Drive RT 15" x 20' CM. 1" NW.

247

246

245

F 34'

28'

F 34

48'

34

F 44'

F 35'

+59 Bog Cu/31

F 50'

Timber


Timber

F 36'

F 50

F 39'

F 50

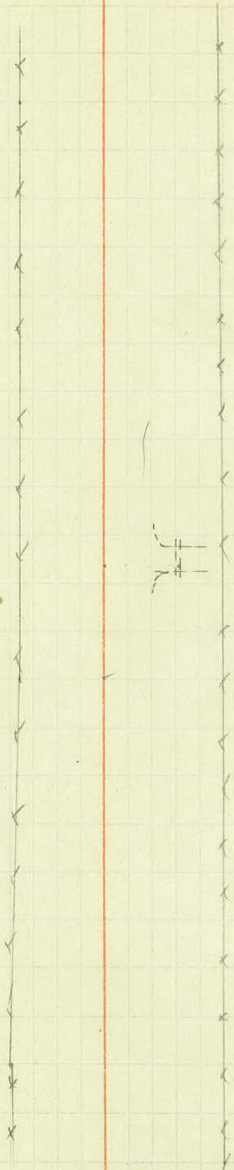

7  
249 x Drain

27.29' 20°25'47"

256

255

254

253

252

251

+57 F. Cor 42 A +62

20'

X X X +20 + F. Cor. 47' A 35'

F 42'

F 47'

F 42'

F 47'

F 44'

F 47'

F 38'


F 47'

F 35'

F 47'

F 35'

F 47'

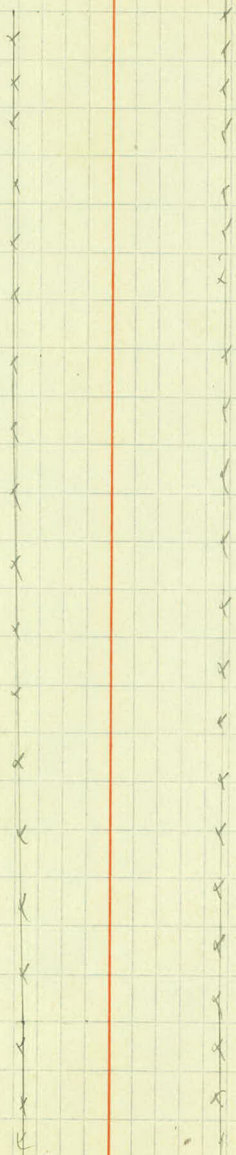

262

261

260

259

+50

1 Drain

24' x 5' P<sub>3</sub>

28' P<sub>1</sub>


26' L<sub>1</sub>

258

257

+80

\* Co Rd. E.

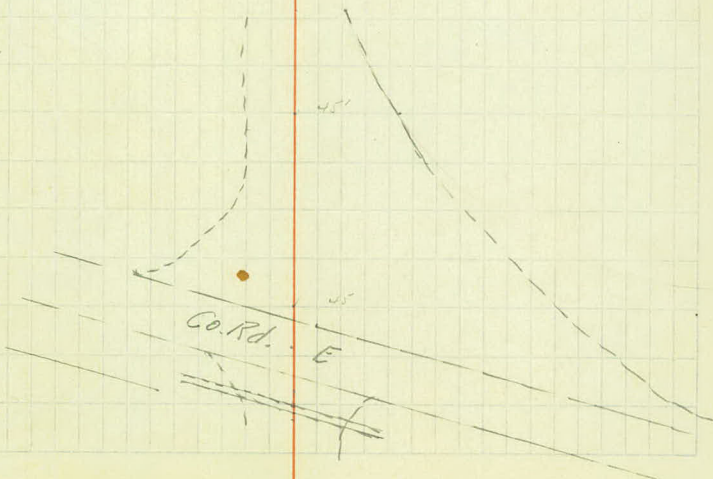

~~268~~

+53

X Drain

24" X 98' 1/2

37 RT

41 L+

~~267~~ 268

+80. X West Track

+72<sup>s</sup> X East Track

\*10 A Drain

30" X 82' P<sub>2</sub>

43 L+

44

~~\*6~~ 267

265

264


263

+18 End R.S.W. 22

+95 Beg R.S.W. 22

C. +66 End R.S.W. 22

+42 R.S.W. 22

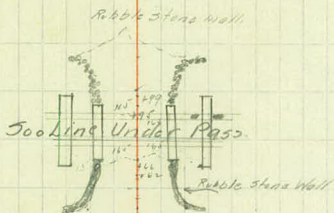

+18 End R.S.W. 22

+95 Beg R.S.W. 22

+66 End R.S.W. 22

+42 Beg R.S.W. 22

51

274

273

272

271

270

269

The image shows a page of graph paper with a grid of small squares. A vertical red line is drawn down the left side of the page, creating a margin. The grid covers most of the page area.

280

279

278

+25' @ Drive RT

15" x 24 C 19 No. 11

+25' @ Drive RT

15" x 24 C 19, No. 91

277

276

+95' x Drain

20" x 72' B

38' RT

34' Lt

275

+12 Bay Col 44'

+18 Bay Col 47'

286

285

+ 80<sup>+</sup> & Brid 90.

284

283

+ 64 & Drive 64.

15<sup>+</sup> & 24 C, 174, 16w.

282

281

+96' End Bridge

+73' Beg Bridge

+52' Beg Cul 42'

292

291

290

289

288

:

287

292 + 75

24" X 54' P3

298

297

296

295

466 E Drive Nt.

294

293

The image shows a sheet of aged, cream-colored paper with a grid of small squares. A solid red vertical line runs down the center of the page. Two dashed vertical lines are positioned on either side of the red line, creating three vertical columns of different widths. The grid covers the majority of the page, with a blank margin at the top and bottom.

30 ✓

301

+95 \* Drain 30" X 60 P<sub>3</sub>

32 Lt.  
28' Rt.

300

299

The image shows a page of graph paper with a grid of small squares. A vertical red line is drawn down the left side of the page, creating a margin. The grid covers most of the page area.

Drives. Ways.	Rt	Lt	EXtraction		C.M.
			Rt	Lt	
171+58	16X14X1'				15"X24'
188+94		2'			12"X7 <sup>old</sup>
190+41		10X22 X1			15"X24
198+02	12X30X2				12X22 Old
198+85	20X12X1.5				12X17 Old
199+77	25X8X1				15"X30'
201X47	16X6X1		30X10 X1.5		15"X20'
202+92	20X4X1		30X10X1.5		15"X24'
204+22	20X4X1				15"X24
210+25	22X12X2		25X12X1		15"X20'
211+39		12X18X2		18'X40'X2.5	15"X24
230+12		15X110X2.5			15"X24
232+17		15X55X3'			No Col.
241X63		20X8X2			15"X24
247+68	20X12X2				15"X20'

---

262

Exc

Fill

8

2

8

27

13

7

4

17

~~4~~ 4

4

11

20

40

16

152

92

12


17


—

68

—

386

 

 

X-sec. of Under Pass showing backfill by line

B.M.	7.94	899.25.		891.41	
T.P.	6.42	903.97.	1.68	897.57.	
267+25				97.3	6.7.
+37				97.1	6.9.
+66				96.5	7.5.
+74				96.3	7.7.
+89.4				96.0	8.0.
268+00				95.8	8.2.
T.P.	11.89	915.27.	0.61	903.38.	
T.P.	4.19	918.41.	1.05	914.22.	
+66				96.5	21.9.
+74				96.3	22.1.
+89.4				96.0	22.4.
268+00				95.8	22.6.

Spike in 14" Oak 125' Pt sta 268+75.

$\frac{145}{50}$	$\frac{140}{33}$	$\frac{66}{20}$	68	$\frac{68}{19}$	$\frac{123}{37}$	$\frac{123}{40}$	$\frac{113}{50}$
------------------	------------------	-----------------	----	-----------------	------------------	------------------	------------------

$\frac{68}{50}$	$\frac{68}{43}$	$\frac{68}{20}$	69	$\frac{21}{22}$	$\frac{57}{24}$	$\frac{60}{43}$	$\frac{72}{50}$
-----------------	-----------------	-----------------	----	-----------------	-----------------	-----------------	-----------------

$\frac{02}{18.2}$	$\frac{062}{18.2}$	$\frac{062}{16.6}$	$\frac{540}{16.6}$	$\frac{540}{15.3}$	$\frac{615}{15.3}$	$\frac{615}{13.8}$	$\frac{70}{13.8}$	72	$\frac{69}{13.9}$	$\frac{615}{13.9}$	$\frac{615}{15.5}$	$\frac{540}{15.9}$	$\frac{540}{16.8}$	$\frac{065}{16.8}$	$\frac{065}{18.2}$	$\frac{03}{18.5}$
-------------------	--------------------	--------------------	--------------------	--------------------	--------------------	--------------------	-------------------	----	-------------------	--------------------	--------------------	--------------------	--------------------	--------------------	--------------------	-------------------

$\frac{062}{17.2}$	$\frac{062}{16.5}$	$\frac{540}{16.5}$	$\frac{540}{15.2}$	$\frac{615}{15.2}$	$\frac{615}{13.9}$	$\frac{73}{13.9}$	73	$\frac{71}{13.9}$	$\frac{615}{13.9}$	$\frac{615}{15.5}$	$\frac{540}{15.5}$	$\frac{540}{16.8}$	$\frac{062}{16.8}$	$\frac{062}{17.5}$
--------------------	--------------------	--------------------	--------------------	--------------------	--------------------	-------------------	----	-------------------	--------------------	--------------------	--------------------	--------------------	--------------------	--------------------

$\frac{065}{17.3}$	$\frac{065}{16.6}$	$\frac{565}{16.6}$	$\frac{565}{15.3}$	$\frac{640}{15.3}$	$\frac{640}{13.9}$	$\frac{7.7}{13.9}$	76	$\frac{73}{13.9}$	$\frac{640}{13.9}$	$\frac{640}{15.3}$	$\frac{565}{15.3}$	$\frac{565}{16.7}$	$\frac{065}{16.7}$	$\frac{065}{17.2}$
--------------------	--------------------	--------------------	--------------------	--------------------	--------------------	--------------------	----	-------------------	--------------------	--------------------	--------------------	--------------------	--------------------	--------------------

$\frac{0.8}{19.2}$	$\frac{8.0}{16}$	8.0	$\frac{8.0}{16}$	$\frac{0.7}{19.2}$
--------------------	------------------	-----	------------------	--------------------

$\frac{15}{50}$	$\frac{220}{32}$	$\frac{220}{31}$	$\frac{457}{31}$	$\frac{457}{29.5}$	$\frac{8.5}{29.5}$	$\frac{90}{29.5}$	$\frac{419}{29.5}$	$\frac{419}{31.0}$	$\frac{175}{31.0}$	$\frac{175}{32.0}$	$\frac{04}{50}$
-----------------	------------------	------------------	------------------	--------------------	--------------------	-------------------	--------------------	--------------------	--------------------	--------------------	-----------------

$\frac{2.5}{50}$	$\frac{2.5}{32}$	$\frac{4.50}{29.5}$	$\frac{10.2}{29.5}$
------------------	------------------	---------------------	---------------------

$\frac{2.3}{50}$	$\frac{26}{33}$	$\frac{4.57}{29.5}$	$\frac{10.2}{29.5}$
------------------	-----------------	---------------------	---------------------

$\frac{100}{29.5}$	$\frac{413}{29.5}$	$\frac{2.6}{31}$	$\frac{1.8}{50}$
--------------------	--------------------	------------------	------------------

$\frac{100}{29.5}$	$\frac{413}{29.5}$	$\frac{2.2}{33}$	$\frac{1.6}{50}$
--------------------	--------------------	------------------	------------------

$\frac{4.7}{50}$	$\frac{5.3}{37}$	$\frac{7.8}{31}$
------------------	------------------	------------------


$\frac{86}{30}$	$\frac{4.9}{36}$	$\frac{4.0}{50}$
-----------------	------------------	------------------


Sta	T	H.I	-	Elev
		918.41		
T.P	0.85	915.07	4.19	914.22
T.P	0.86	904.19	11.74	903.33
T.P	1.85	959.42	6.62	957.57
		899.42		897.57

268 +23				95.3	4.1
+35				95.1	4.3
B.M <sub>1</sub>			8.01	891.41	
				851.41	

$$\frac{25}{50} \quad \frac{25}{41} \quad \frac{30}{26} \quad \frac{40}{20} \quad 41 \quad \frac{38}{17} \quad \frac{33}{19} \quad \frac{25}{37} \quad \frac{20}{50}$$

$$\frac{100}{50} \quad \frac{96}{28} \quad \frac{45}{20} \quad 45 \quad \frac{45}{19} \quad \frac{114}{29} \quad \frac{102}{40} \quad \frac{100}{50}$$

 

 

249	+	HI	-	Elev	
B.M.	0.38	917.76		917.38	
		<del>917.36</del>			
T.P.	10.6	908.59.	10.23	907.53	
267+25				897.3.	
+37				97.1.	
+66				96.5	
+74				96.3	
+894				96.0	
268				95.8	12.8.
				95.3	13.3
+23				95.3	
+35				95.1	
TP	10.05	917.47.	117	907.42	
267+66				96.5	21.0.
+74				96.3	21.2.
+894				96.0	21.5.

Spike in 10" shrub Oak 60 At 579 285 + 50

$\frac{19.4}{50}$	$\frac{18.5}{32}$	$\frac{11.2}{20}$	$\frac{11.3}{11.4}$	$\frac{11.4}{19}$	$\frac{17.0}{32}$	$\frac{16.0}{50}$
-------------------	-------------------	-------------------	---------------------	-------------------	-------------------	-------------------

$\frac{12.5}{50}$	$\frac{11.2}{21}$	$\frac{11.5}{11.5}$	$\frac{11.1}{19}$	$\frac{12.5}{50}$
-------------------	-------------------	---------------------	-------------------	-------------------

$\frac{0.5}{34.6}$	$\frac{1.2}{29}$	$\frac{11.1}{19}$	$\frac{11.6}{11.6}$	$\frac{11.4}{19}$	$\frac{0.7}{29}$	$\frac{1.0}{36}$
--------------------	------------------	-------------------	---------------------	-------------------	------------------	------------------

$\frac{1.0}{34}$	$\frac{1.2}{29}$	$\frac{12.0}{20}$	$\frac{12.3}{11.6}$	$\frac{11.7}{20}$	$\frac{0.6}{29}$	$\frac{0.5}{36}$
------------------	------------------	-------------------	---------------------	-------------------	------------------	------------------

$\frac{0.9}{35}$	$\frac{1.2}{29}$	$\frac{12.0}{20}$	$\frac{12.6}{12.1}$	$\frac{12.4}{20}$	$\frac{0.5}{29}$	$\frac{0.0}{35}$
------------------	------------------	-------------------	---------------------	-------------------	------------------	------------------

$\frac{1.3}{34}$	$\frac{1.3}{29}$	$\frac{12.6}{20}$	$\frac{12.8}{12.4}$	$\frac{12.6}{20}$	$\frac{0.5}{29}$	$\frac{0.5}{33}$
------------------	------------------	-------------------	---------------------	-------------------	------------------	------------------

$\frac{1.8}{50}$	$\frac{1.2}{49}$	$\frac{5.8}{48}$	$\frac{6.0}{40}$
------------------	------------------	------------------	------------------

$\frac{6.8}{39}$	$\frac{5.8}{48}$	$\frac{1.0}{49}$	$\frac{1.0}{50}$
------------------	------------------	------------------	------------------

$\frac{1.3}{50}$	$\frac{1.3}{49}$	$\frac{5.3}{48}$	$\frac{5.3}{39}$
------------------	------------------	------------------	------------------

$\frac{5.8}{39}$	$\frac{5.8}{47}$	$\frac{0.9}{48}$	$\frac{0.9}{50}$
------------------	------------------	------------------	------------------

$\frac{1.3}{50}$	$\frac{1.3}{49}$	$\frac{5.6}{48}$	$\frac{5.3}{40}$
------------------	------------------	------------------	------------------

$\frac{5.5}{39}$	$\frac{5.8}{48}$	$\frac{0.7}{49}$	$\frac{0.7}{50}$
------------------	------------------	------------------	------------------


Sta	+	HZ	-	Elev	
		917.47			
268				95.8	21.7.
T.P	1.06	908.48	10.05	907.42	
T.P.	2.01	899.70	10.59	897.89	
268+23		899.90		<del>95.1</del> 95.3	4.6.
+35				95.1	
BM			84	891.39	891.41
				891.41	

$\frac{15}{50}$	$\frac{13}{49}$	$\frac{6.0}{48}$	$\frac{5.0}{40}$	+19.6	$\frac{5.7}{40}$	$\frac{4.7}{48}$	$\frac{0.7}{49}$	$\frac{1.7}{50}$
-----------------	-----------------	------------------	------------------	-------	------------------	------------------	------------------	------------------

		(4.6)		
$\frac{4.5}{50}$	$\frac{4.5}{21}$	$\frac{4.5}{19}$	$\frac{4.2}{19}$	$\frac{4.8}{50}$
		(4.8)		

$\frac{12.0}{50}$	$\frac{10.8}{31}$	$\frac{4.8}{19}$	5.0	$\frac{4.6}{19}$	$\frac{13.0}{31}$	$\frac{11.8}{50}$
-------------------	-------------------	------------------	-----	------------------	-------------------	-------------------

spike in 14" Oak 125" RT 27a 268+74-

 

# KEITH'S RAILROAD CURVE TABLES.

Published by KEUFFEL & ESSER CO., New York.

Entered according to Act of Congress in the year 1883,  
by W. Keuffel & H. Esser, in the office of the Librarian of Congress,  
in Washington, D.C.

Copyright, 1902, by Keuffel & Esser Co.

## HOW TO USE KEITH'S TABLES.

### EXAMPLE.

Wanted a Curve with an Ext. of about 12 ft. Angle  
of Intersection or I. P.= $23^{\circ} 20'$  to the R. at Station  
 $542+72$ .

Ext. in Tab. IV opposite  $23^{\circ} 20'$ =120.87  
 $120.87 \div 12 = 10.07$ . Say a  $10^{\circ}$  Curve.

Tan. in Tab. IV opp.  $23^{\circ} 20'$ =1183.1  
 $1183.1 \div 10 = 118.31$ .

Tab. V. correction for A.  $23^{\circ} 20'$  for a  $10^{\circ}$  Cur.=0.16  
 $118.31 + 0.16 = 118.47$ =corrected Tangent.

(If corrected Ext. is required find in same way)

Ang.  $23^{\circ} 20'$ = $23.33^{\circ} \div 10 = 2.3333$ =L. C.

$2^{\circ} 19\frac{1}{2}'$ =def. for sta.	542	I. P.=sta.	542+72
$4^{\circ} 49\frac{1}{2}'$ = " " "	+50	Tan.=	<u>118.47</u>
$7^{\circ} 19\frac{1}{2}'$ = " " "	543	B. C.=sta.	541+53.53
$9^{\circ} 49\frac{1}{2}'$ = " " "	+50	L. C.=	<u>2.33.33</u>
$11^{\circ} 40'$ = " " "	543+	E. C.=sta.	543+86.86
	86.86		

$100 - 53.53 = 46.47 \times 3'$  (def. for 1 ft. of  $10^{\circ}$  Cur.)= $139.41'$ =  
 $2^{\circ} 19\frac{1}{2}'$ =def. for sta. 542.

Def. for 50 ft.= $2^{\circ} 30'$  for a  $10^{\circ}$  Curve.

Def. for 36.86 ft.= $1^{\circ} 50\frac{1}{2}'$  for a  $10^{\circ}$  Curve

(These tables are published in Field Books of  
KEUFFEL & ESSER Co., New York, N. Y.)

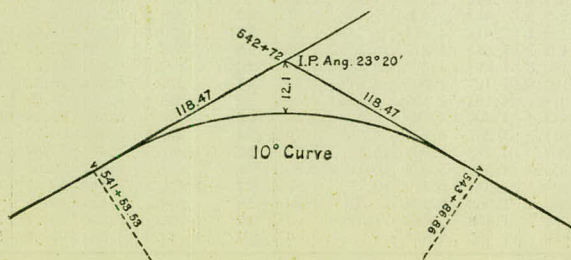


TABLE I. — Minutes in Decimals of a Degree.

<b>1'</b>	.0167	<b>11'</b>	.1833	<b>21'</b>	.3500	<b>31'</b>	.5167	<b>41'</b>	.6833	<b>51'</b>	.8500
<b>2</b>	.0333	<b>12</b>	.2000	<b>22</b>	.3667	<b>32</b>	.5333	<b>42</b>	.7000	<b>52</b>	.8667
<b>3</b>	.0500	<b>13</b>	.2167	<b>23</b>	.3833	<b>33</b>	.5500	<b>43</b>	.7167	<b>53</b>	.8833
<b>4</b>	.0667	<b>14</b>	.2333	<b>24</b>	.4000	<b>34</b>	.5667	<b>44</b>	.7333	<b>54</b>	.9000
<b>5</b>	.0833	<b>15</b>	.2500	<b>25</b>	.4167	<b>35</b>	.5833	<b>45</b>	.7500	<b>55</b>	.9167
<b>6</b>	.1000	<b>16</b>	.2667	<b>26</b>	.4333	<b>36</b>	.6000	<b>46</b>	.7667	<b>56</b>	.9333
<b>7</b>	.1167	<b>17</b>	.2833	<b>27</b>	.4500	<b>37</b>	.6167	<b>47</b>	.7833	<b>57</b>	.9500
<b>8</b>	.1333	<b>18</b>	.3000	<b>28</b>	.4667	<b>38</b>	.6333	<b>48</b>	.8000	<b>58</b>	.9667
<b>9</b>	.1500	<b>19</b>	.3167	<b>29</b>	.4833	<b>39</b>	.6500	<b>49</b>	.8167	<b>59</b>	.9833
<b>10</b>	.1667	<b>20</b>	.3333	<b>30</b>	.5000	<b>40</b>	.6667	<b>50</b>	.8333	<b>60</b>	1.0000

TABLE II. — Inches in Decimals of a Foot.

1-16	3-32	<sup>1</sup> / <sub>8</sub>	3-16	<sup>1</sup> / <sub>4</sub>	5-16	<sup>3</sup> / <sub>8</sub>	<sup>1</sup> / <sub>2</sub>	<sup>5</sup> / <sub>8</sub>	<sup>3</sup> / <sub>4</sub>	<sup>7</sup> / <sub>8</sub>
.0052	.0078	.0104	.0156	.0208	.0260	.0313	.0417	.0521	.0625	.0729
1	2	3	4	5	6	7	8	9	10	11
.0833	.1667	.2500	.3333	.4167	.5000	.5833	.6667	.7500	.8333	.9167

TABLE III. — Radii, Ordinates and Deflections.

Deg.	Radius	Mid. Ord.	Tan. Def.	Chd. Def.	Def. for 1 Foot	Deg.	Radius	Mid. Ord.	Tan. Def.	Chd. Def.	Def. for 1 Foot
<b>0° 10'</b>	34377.	.036	.145	.291	0.05	<b>7°</b>	819.0	1.528	6.105	12.21	2.10'
20	17189.	.073	.291	.582	0.10	20'	781.8	1.600	6.395	12.79	2.20
30	11459.	.109	.436	.873	0.15	30	764.5	1.637	6.540	13.08	2.25
40	8594.4	.145	.582	1.164	0.20	40	747.9	1.673	6.685	13.37	2.30
50	6875.5	.182	.727	1.454	0.25	<b>8</b>	716.8	1.746	6.976	13.95	2.40
<b>1</b>	5729.6	.218	.873	1.745	0.30	20	688.2	1.819	7.266	14.53	2.50
10	4911.2	.255	1.018	2.036	0.35	30	674.7	1.855	7.411	14.82	2.55
20	4297.3	.291	1.164	2.327	0.40	40	661.7	1.892	7.556	15.11	2.60
30	3819.8	.327	1.309	2.618	0.45	<b>9</b>	637.3	1.965	7.846	15.69	2.70
40	3437.9	.364	1.454	2.909	0.50	20	614.6	2.037	8.136	16.27	2.80
50	3125.4	.400	1.600	3.200	0.55	30	603.8	2.074	8.281	16.56	2.85
<b>2</b>	2864.9	.436	1.745	3.490	0.60	40	593.4	2.110	8.426	16.85	2.90
10	2644.6	.473	1.891	3.781	0.65	<b>10</b>	573.7	2.183	8.716	17.43	3.00
20	2455.7	.509	2.036	4.072	0.70	30	546.4	2.292	9.150	18.30	3.15
30	2292.0	.545	2.181	4.363	0.75	<b>11</b>	521.7	2.402	9.585	19.16	3.30
40	2148.8	.582	2.327	4.654	0.80	30	499.1	2.511	10.02	20.04	3.45
50	2022.4	.618	2.472	4.945	0.85	<b>12</b>	478.3	2.620	10.45	20.91	3.60
<b>3</b>	1910.1	.655	2.618	5.235	0.90	30	459.3	2.730	10.89	21.77	3.75
10	1809.6	.691	2.763	5.526	0.95	<b>13</b>	441.7	2.839	11.32	22.64	3.90
20	1719.1	.727	2.908	5.817	1.00	30	425.4	2.949	11.75	23.51	4.05
30	1637.3	.764	3.054	6.108	1.05	<b>14</b>	410.3	3.058	12.18	24.37	4.20
40	1562.9	.800	3.199	6.398	1.10	30	396.2	3.168	12.62	25.24	4.35
50	1495.0	.836	3.345	6.689	1.15	<b>15</b>	383.1	3.277	13.05	26.11	4.50
<b>4</b>	1432.7	.873	3.490	6.980	1.20	30	370.8	3.387	13.49	26.97	4.65
10	1375.4	.909	3.635	7.271	1.25	<b>16</b>	359.3	3.496	13.92	27.84	4.80
20	1322.5	.945	3.781	7.561	1.30	30	348.5	3.606	14.35	28.70	4.95
30	1273.6	.982	3.926	7.852	1.35	<b>17</b>	338.3	3.716	14.78	29.56	5.10
40	1228.1	1.018	4.071	8.143	1.40	<b>18</b>	319.6	3.935	15.64	31.29	5.40
50	1185.8	1.055	4.217	8.433	1.45	<b>19</b>	302.9	4.155	16.51	33.01	5.70
<b>5</b>	1146.3	1.091	4.362	8.724	1.50	<b>20</b>	287.9	4.374	17.37	34.73	6.00
10	1109.3	1.127	4.507	9.014	1.55	<b>21</b>	274.4	4.594	18.22	36.44	6.30
20	1074.7	1.164	4.653	9.305	1.60	<b>22</b>	262.0	4.814	19.08	38.16	6.60
30	1042.1	1.200	4.798	9.596	1.65	<b>23</b>	250.8	5.035	19.94	39.87	6.90
40	1011.5	1.237	4.943	9.886	1.70	<b>24</b>	240.5	5.255	20.79	41.58	7.20
50	982.6	1.273	5.088	10.18	1.75	<b>25</b>	231.0	5.476	21.64	43.28	7.50
<b>6</b>	955.4	1.309	5.234	10.47	1.80	<b>26</b>	222.3	5.697	22.50	44.99	7.80
10	929.6	1.346	5.379	10.76	1.85	<b>27</b>	214.2	5.918	23.35	46.69	8.10
20	905.1	1.382	5.524	11.05	1.90	<b>28</b>	206.7	6.139	24.19	48.38	8.40
30	881.9	1.418	5.669	11.34	1.95	<b>29</b>	199.7	6.360	25.04	50.07	8.70
40	859.9	1.455	5.814	11.63	2.00	<b>30</b>	193.2	6.583	25.88	51.76	9.00

TABLE IV. — Tangents and Externals to a 1° Curve.

Angle	Tangent	External	Angle	Tangent	External	Angle	Tangent	External
<b>1°</b>	50.00	.22	<b>11°</b>	551.70	26.50	<b>21°</b>	1061.9	97.57
10'	58.34	.30	10'	560.11	27.31	10'	1070.6	99.16
20	66.67	.39	20	568.53	28.14	20	1079.2	100.75
30	75.01	.49	30	576.95	28.97	30	1087.8	102.35
40	83.34	.61	40	585.36	29.82	40	1096.4	103.97
50	91.68	.73	50	593.79	30.68	50	1105.1	105.60
<b>2</b>	100.01	.87	<b>12</b>	602.21	31.56	<b>22</b>	1113.7	107.24
10	108.35	1.02	10	610.64	32.45	10	1122.4	108.90
20	116.68	1.19	20	619.07	33.35	20	1131.0	110.57
30	125.02	1.36	30	627.50	34.26	30	1139.7	112.25
40	133.36	1.55	40	635.93	35.18	40	1148.4	113.95
50	141.70	1.75	50	644.37	36.12	50	1157.0	115.66
<b>3</b>	150.04	1.96	<b>13</b>	652.81	37.07	<b>23</b>	1165.7	117.38
10	158.38	2.19	10	661.25	38.03	10	1174.4	119.12
20	166.72	2.43	20	669.70	39.01	20	1183.1	120.87
30	175.06	2.67	30	678.15	39.99	30	1191.8	122.63
40	183.40	2.93	40	686.60	40.99	40	1200.5	124.41
50	191.74	3.21	50	695.06	42.00	50	1209.2	126.20
<b>4</b>	200.08	3.49	<b>14</b>	703.51	43.03	<b>24</b>	1217.9	128.00
10	208.43	3.79	10	711.97	44.07	10	1226.6	129.82
20	216.77	4.10	20	720.44	45.12	20	1235.3	131.65
30	225.12	4.42	30	728.90	46.18	30	1244.0	133.50
40	233.47	4.76	40	737.37	47.25	40	1252.8	135.35
50	241.81	5.10	50	745.85	48.34	50	1261.5	137.23
<b>5</b>	250.16	5.46	<b>15</b>	754.32	49.44	<b>25</b>	1270.2	139.11
10	258.51	5.83	10	762.80	50.55	10	1279.0	141.01
20	266.86	6.21	20	771.29	51.68	20	1287.7	142.93
30	275.21	6.61	30	779.77	52.89	30	1296.5	144.85
40	283.57	7.01	40	788.26	53.97	40	1305.3	146.79
50	291.92	7.43	50	796.75	55.13	50	1314.0	148.75
<b>6</b>	300.28	7.86	<b>16</b>	805.25	56.31	<b>26</b>	1322.8	150.71
10	308.64	8.31	10	813.75	57.50	10	1331.6	152.69
20	316.99	8.76	20	822.25	58.70	20	1340.4	154.69
30	325.35	9.23	30	830.76	59.91	30	1349.2	156.70
40	333.71	9.71	40	839.27	61.14	40	1358.0	158.72
50	342.08	10.20	50	847.78	62.38	50	1366.8	160.76
<b>7</b>	350.44	10.71	<b>17</b>	856.30	63.63	<b>27</b>	1375.6	162.81
10	358.81	11.22	10	864.82	64.90	10	1384.4	164.86
20	367.17	11.75	20	873.35	66.18	20	1393.2	166.95
30	375.54	12.29	30	881.88	67.47	30	1402.0	169.04
40	383.91	12.85	40	890.41	68.77	40	1410.9	171.15
50	392.28	13.41	50	898.95	70.09	50	1419.7	173.27
<b>8</b>	400.66	13.99	<b>18</b>	907.49	71.42	<b>28</b>	1428.6	175.41
10	409.03	14.58	10	916.03	72.76	10	1437.4	177.55
20	417.41	15.18	20	924.58	74.12	20	1446.3	179.72
30	425.79	15.80	30	933.13	75.49	30	1455.1	181.89
40	434.17	16.43	40	941.69	76.86	40	1464.0	184.08
50	442.55	17.07	50	950.25	78.26	50	1472.9	186.29
<b>9</b>	450.93	17.72	<b>19</b>	958.81	79.67	<b>29</b>	1481.8	188.51
10	459.32	18.38	10	967.38	81.09	10	1490.7	190.74
20	467.71	19.06	20	975.96	82.53	20	1499.6	192.99
30	476.10	19.75	30	984.53	83.97	30	1508.5	195.25
40	484.49	20.45	40	993.12	85.43	40	1517.4	197.53
50	492.88	21.16	50	1001.7	86.90	50	1526.3	199.82
<b>10</b>	501.28	21.89	<b>20</b>	1010.3	88.39	<b>30</b>	1535.3	202.12
10	509.68	22.62	10	1018.9	89.89	10	1544.2	204.44
20	518.08	23.38	20	1027.5	91.40	20	1553.1	206.77
30	526.48	24.14	30	1036.1	92.92	30	1562.1	209.12
40	534.89	24.91	40	1044.7	94.46	40	1571.0	211.48
50	543.29	25.70	50	1053.3	96.01	50	1580.0	213.86

TABLE IV. — Tangents and Externals to a 1° Curve.

Angle	Tangent	External	Angle	Tangent	External	Angle	Tangent	External
<b>31°</b>	1589.0	216.3	<b>41°</b>	2142.2	387.4	<b>51°</b>	2732.9	618.4
10'	1598.0	218.7	10'	2151.7	390.7	10'	2743.1	622.8
20	1606.9	221.1	20	2161.2	394.1	20	2753.4	627.2
30	1615.9	223.5	30	2170.8	397.4	30	2763.7	631.7
40	1624.9	226.0	40	2180.3	400.8	40	2773.9	636.2
50	1633.9	228.4	50	2189.9	404.2	50	2784.2	640.7
<b>32</b>	1643.0	230.9	<b>42</b>	2199.4	407.6	<b>52</b>	2794.5	645.2
10	1652.0	233.4	10	2209.0	411.1	10	2804.9	649.7
20	1661.0	235.9	20	2218.6	414.5	20	2815.2	654.3
30	1670.0	238.4	30	2228.1	418.0	30	2825.6	658.8
40	1679.1	241.0	40	2237.7	421.4	40	2835.9	663.4
50	1688.1	243.5	50	2247.3	425.0	50	2846.3	668.0
<b>33</b>	1697.2	246.1	<b>43</b>	2257.0	428.5	<b>53</b>	2856.7	672.7
10	1706.3	248.7	10	2266.6	432.0	10	2867.1	677.3
20	1715.3	251.3	20	2276.2	435.6	20	2877.5	682.0
30	1724.4	253.9	30	2285.9	439.2	30	2888.0	686.7
40	1733.5	256.5	40	2295.6	442.8	40	2898.4	691.4
50	1742.6	259.1	50	2305.2	446.4	50	2908.9	696.1
<b>34</b>	1751.7	261.8	<b>44</b>	2314.9	450.0	<b>54</b>	2919.4	700.9
10	1760.8	264.5	10	2324.6	453.6	10	2929.9	705.7
20	1770.0	267.2	20	2334.3	457.3	20	2940.4	710.5
30	1779.1	269.9	30	2344.1	461.0	30	2951.0	715.3
40	1788.2	272.6	40	2353.8	464.6	40	2961.5	720.1
50	1797.4	275.3	50	2363.5	468.4	50	2972.1	725.0
<b>35</b>	1806.6	278.1	<b>45</b>	2373.3	472.1	<b>55</b>	2982.7	729.9
10	1815.7	280.8	10	2383.1	475.8	10	2993.3	734.8
20	1824.9	283.6	20	2392.8	479.6	20	3003.9	739.7
30	1834.1	286.4	30	2402.6	483.4	30	3014.5	744.6
40	1843.3	289.2	40	2412.4	487.2	40	3025.2	749.6
50	1852.5	292.0	50	2422.3	491.0	50	3035.8	754.6
<b>36</b>	1861.7	294.9	<b>46</b>	2432.1	494.8	<b>56</b>	3046.5	759.6
10	1870.9	297.7	10	2441.9	498.7	10	3057.2	764.6
20	1880.1	300.6	20	2451.8	502.5	20	3067.9	769.7
30	1889.4	303.5	30	2461.7	506.4	30	3078.7	774.7
40	1898.6	306.4	40	2471.5	510.3	40	3089.4	779.8
50	1907.9	309.3	50	2481.4	514.3	50	3100.2	784.9
<b>37</b>	1917.1	312.2	<b>47</b>	2491.3	518.2	<b>57</b>	3110.9	790.1
10	1926.4	315.2	10	2501.2	522.2	10	3121.7	795.2
20	1935.7	318.1	20	2511.2	526.1	20	3132.6	800.4
30	1945.0	321.1	30	2521.1	530.1	30	3143.4	805.6
40	1954.3	324.1	40	2531.1	534.2	40	3154.2	810.9
50	1963.6	327.1	50	2541.0	538.2	50	3165.1	816.1
<b>38</b>	1972.9	330.2	<b>48</b>	2551.0	542.2	<b>58</b>	3176.0	821.4
10	1982.2	333.2	10	2561.0	546.3	10	3186.9	826.7
20	1991.5	336.3	20	2571.0	550.4	20	3197.8	832.0
30	2000.9	339.3	30	2581.0	554.5	30	3208.8	837.3
40	2010.2	342.4	40	2591.0	558.6	40	3219.7	842.7
50	2019.6	345.5	50	2601.1	562.8	50	3230.7	848.1
<b>39</b>	2029.0	348.6	<b>49</b>	2611.2	566.9	<b>59</b>	3241.7	853.5
10	2038.4	351.8	10	2621.2	571.1	10	3252.7	858.9
20	2047.8	354.9	20	2631.3	575.3	20	3263.7	864.3
30	2057.2	358.1	30	2641.4	579.5	30	3274.8	869.8
40	2066.6	361.3	40	2651.5	583.8	40	3285.8	875.3
50	2076.0	364.5	50	2661.6	588.0	50	3296.9	880.8
<b>40</b>	2085.4	367.7	<b>50</b>	2671.8	592.3	<b>60</b>	3308.0	886.4
10	2094.9	371.0	10	2681.9	596.6	10	3319.1	892.0
20	2104.3	374.2	20	2692.1	600.9	20	3330.3	897.5
30	2113.8	377.5	30	2702.3	605.3	30	3341.4	903.2
40	2123.3	380.8	40	2712.5	609.6	40	3352.6	908.8
50	2132.7	384.1	50	2722.7	614.0	50	3363.8	914.5

TABLE IV. — Tangents and Externals to a 1° Curve.

Angle	Tangent	External	Angle	Tangent	External	Angle	Tangent	External
<b>61°</b>	3375.0	920.2	<b>71°</b>	4086.9	1308.2	<b>81°</b>	4893.6	1805.3
10'	3386.3	925.9	10'	4099.5	1315.6	10'	4908.0	1814.7
20	3397.5	931.6	20	4112.1	1322.9	20	4922.5	1824.1
30	3408.8	937.3	30	4124.8	1330.3	30	4937.0	1833.6
40	3420.1	943.1	40	4137.4	1337.7	40	4951.5	1843.1
50	3431.4	948.9	50	4150.1	1345.1	50	4966.1	1852.6
<b>62</b>	3442.7	954.8	<b>72</b>	4162.8	1352.6	<b>82</b>	4980.7	1862.2
10	3454.1	960.6	10	4175.6	1360.1	10	4995.4	1871.8
20	3465.4	966.5	20	4188.5	1367.6	20	5010.0	1881.5
30	3476.8	972.4	30	4201.2	1375.2	30	5024.8	1891.2
40	3488.3	978.3	40	4214.0	1382.8	40	5039.5	1900.9
50	3499.7	984.3	50	4226.8	1390.4	50	5054.3	1910.7
<b>63</b>	3511.1	990.2	<b>73</b>	4239.7	1398.0	<b>83</b>	5069.2	1920.5
10	3522.6	996.2	10	4252.6	1405.7	10	5084.0	1930.4
20	3534.1	1002.3	20	4265.6	1413.5	20	5099.0	1940.3
30	3545.6	1008.3	30	4278.5	1421.2	30	5113.9	1950.3
40	3557.2	1014.4	40	4291.5	1429.0	40	5128.9	1960.2
50	3568.7	1020.5	50	4304.6	1436.8	50	5143.9	1970.3
<b>64</b>	3580.3	1026.6	<b>74</b>	4317.6	1444.6	<b>84</b>	5159.0	1980.4
10	3591.9	1032.8	10	4330.7	1452.5	10	5174.1	1990.5
20	3603.5	1039.0	20	4343.8	1460.4	20	5189.3	2000.6
30	3615.1	1045.2	30	4356.9	1468.4	30	5204.4	2010.8
40	3626.8	1051.4	40	4370.1	1476.4	40	5219.7	2021.1
50	3638.5	1057.7	50	4383.3	1484.4	50	5234.9	2031.4
<b>65</b>	3650.2	1063.9	<b>75</b>	4396.5	1492.4	<b>85</b>	5250.3	2041.7
10	3661.9	1070.2	10	4409.8	1500.5	10	5265.6	2052.1
20	3673.7	1076.6	20	4423.1	1508.6	20	5281.0	2062.5
30	3685.4	1082.9	30	4436.4	1516.7	30	5296.4	2073.0
40	3697.2	1089.3	40	4449.7	1524.9	40	5311.9	2083.5
50	3709.0	1095.7	50	4463.1	1533.1	50	5327.4	2094.1
<b>66</b>	3720.9	1102.2	<b>76</b>	4476.5	1541.4	<b>86</b>	5343.0	2104.7
10	3732.7	1108.6	10	4489.9	1549.7	10	5358.6	2115.3
20	3744.6	1115.1	20	4503.4	1558.0	20	5374.2	2126.0
30	3756.5	1121.7	30	4516.9	1566.3	30	5389.9	2136.7
40	3768.5	1128.2	40	4530.4	1574.7	40	5405.6	2147.5
50	3780.4	1134.8	50	4544.0	1583.1	50	5421.4	2158.4
<b>67</b>	3792.4	1141.4	<b>77</b>	4557.6	1591.6	<b>87</b>	5437.2	2169.2
10	3804.4	1148.0	10	4571.2	1600.1	10	5453.1	2180.2
20	3816.4	1154.7	20	4584.8	1608.6	20	5469.0	2191.1
30	3828.4	1161.3	30	4598.5	1617.1	30	5484.9	2202.2
40	3840.5	1168.1	40	4612.2	1625.7	40	5500.9	2213.2
50	3852.6	1174.8	50	4626.0	1634.4	50	5517.0	2224.3
<b>68</b>	3864.7	1181.6	<b>78</b>	4639.8	1643.0	<b>88</b>	5533.1	2235.5
10	3876.8	1188.4	10	4653.6	1651.7	10	5549.2	2246.7
20	3889.0	1195.2	20	4667.4	1660.5	20	5565.4	2258.0
30	3901.2	1202.0	30	4681.3	1669.2	30	5581.6	2269.3
40	3913.4	1208.9	40	4695.2	1678.1	40	5597.8	2280.6
50	3925.6	1215.8	50	4709.2	1686.9	50	5614.2	2292.0
<b>69</b>	3937.9	1222.7	<b>79</b>	4723.2	1695.8	<b>89</b>	5630.5	2303.5
10	3950.2	1229.7	10	4737.2	1704.7	10	5646.9	2315.0
20	3962.5	1236.7	20	4751.2	1713.7	20	5663.4	2326.6
30	3974.8	1243.7	30	4765.3	1722.7	30	5679.9	2338.2
40	3987.2	1250.8	40	4779.4	1731.7	40	5696.4	2349.8
50	3999.5	1257.9	50	4793.6	1740.8	50	5713.0	2361.5
<b>70</b>	4011.9	1265.0	<b>80</b>	4807.7	1749.9	<b>90</b>	5729.7	2373.3
10	4024.4	1272.1	10	4822.0	1759.0	10	5746.3	2385.1
20	4036.8	1279.3	20	4836.2	1768.2	20	5763.1	2397.0
30	4049.3	1286.5	30	4850.5	1777.4	30	5779.9	2408.9
40	4061.8	1293.6	40	4864.8	1786.7	40	5796.7	2420.9
50	4074.4	1300.9	50	4879.2	1796.0	50	5813.6	2432.9

TABLE IV. — Tangents and Externals to a 1° Curve.

Angle	Tangent	External	Angle	Tangent	External	Angle	Tangent	External
<b>91°</b>	5830.5	2444.9	<b>101°</b>	6950.6	3278.1	<b>111°</b>	8336.7	4386.1
10'	5847.5	2457.1	10'	6971.3	3294.1	10'	8362.7	4407.6
20	5864.6	2469.3	20	6992.0	3310.1	20	8388.9	4429.2
30	5881.7	2481.5	30	7012.7	3326.1	30	8415.1	4450.9
40	5898.8	2493.8	40	7033.6	3342.3	40	8441.5	4472.7
50	5916.0	2506.1	50	7054.5	3358.5	50	8468.0	4494.6
<b>92</b>	5933.2	2518.5	<b>102</b>	7075.5	3374.9	<b>112</b>	8494.6	4516.6
10	5950.5	2531.0	10	7096.6	3391.2	10	8521.3	4538.8
20	5967.9	2543.5	20	7117.8	3407.7	20	8548.1	4561.1
30	5985.3	2556.0	30	7139.0	3424.3	30	8575.0	4583.4
40	6002.7	2568.6	40	7160.3	3440.9	40	8602.1	4606.0
50	6020.2	2581.3	50	7181.7	3457.6	50	8629.3	4628.6
<b>93</b>	6037.8	2594.0	<b>103</b>	7203.2	3474.4	<b>113</b>	8656.6	4651.3
10	6055.4	2606.8	10	7224.7	3491.3	10	8684.0	4674.2
20	6073.1	2619.7	20	7246.3	3508.2	20	8711.5	4697.2
30	6090.8	2632.6	30	7268.0	3525.2	30	8739.2	4720.3
40	6108.6	2645.5	40	7289.8	3542.4	40	8767.0	4743.6
50	6126.4	2658.5	50	7311.7	3559.6	50	8794.9	4766.9
<b>94</b>	6144.3	2671.6	<b>104</b>	7333.6	3576.8	<b>114</b>	8822.9	4790.4
10	6162.6	2684.7	10	7355.6	3594.2	10	8851.0	4814.1
20	6180.2	2697.9	20	7377.8	3611.7	20	8879.3	4837.8
30	6198.3	2711.2	30	7399.9	3629.2	30	8907.7	4861.7
40	6216.4	2724.5	40	7422.2	3646.8	40	8936.3	4885.7
50	6234.6	2737.9	50	7444.6	3664.5	50	8965.0	4909.9
<b>95</b>	6252.8	2751.3	<b>105</b>	7467.0	3682.3	<b>115</b>	8993.8	4934.1
10	6271.1	2764.8	10	7489.6	3700.2	10	9022.7	4958.6
20	6289.4	2778.3	20	7512.2	3718.2	20	9051.7	4983.1
30	6307.9	2792.0	30	7534.9	3736.2	30	9080.9	5007.8
40	6326.3	2805.6	40	7557.7	3754.4	40	9110.3	5032.6
50	6344.8	2819.4	50	7580.5	3772.6	50	9139.8	5057.6
<b>96</b>	6363.4	2833.2	<b>106</b>	7603.5	3791.0	<b>116</b>	9169.4	5082.7
10	6382.1	2847.0	10	7626.6	3809.4	10	9199.1	5107.9
20	6400.8	2861.0	20	7649.7	3827.9	20	9229.0	5133.3
30	6419.5	2875.0	30	7672.9	3846.5	30	9259.0	5158.8
40	6438.4	2889.0	40	7696.3	3865.2	40	9289.2	5184.5
50	6457.3	2903.1	50	7719.7	3884.0	50	9319.5	5210.3
<b>97</b>	6476.2	2917.3	<b>107</b>	7743.2	3902.9	<b>117</b>	9349.9	5236.2
10	6495.2	2931.6	10	7766.8	3921.9	10	9380.5	5262.3
20	6514.3	2945.9	20	7790.5	3940.9	20	9411.3	5288.6
30	6533.4	2960.3	30	7814.3	3960.1	30	9442.2	5315.0
40	6552.6	2974.7	40	7838.1	3979.4	40	9473.2	5341.5
50	6571.9	2989.2	50	7862.1	3998.7	50	9504.4	5368.2
<b>98</b>	6591.2	3003.8	<b>108</b>	7886.2	4018.2	<b>118</b>	9535.7	5395.1
10	6610.6	3018.4	10	7910.4	4037.8	10	9567.2	5422.1
20	6630.1	3033.1	20	7934.6	4057.4	20	9598.9	5449.2
30	6649.6	3047.9	30	7959.0	4077.2	30	9630.7	5476.5
40	6669.2	3062.8	40	7983.5	4097.1	40	9662.6	5504.0
50	6688.8	3077.7	50	8008.0	4117.0	50	9694.7	5531.7
<b>99</b>	6708.6	3092.7	<b>109</b>	8032.7	4137.1	<b>119</b>	9727.0	5559.4
10	6728.4	3107.7	10	8057.4	4157.3	10	9759.4	5587.4
20	6748.2	3122.9	20	8082.3	4177.5	20	9792.0	5615.5
30	6768.1	3138.1	30	8107.3	4197.9	30	9824.8	5643.8
40	6788.1	3153.3	40	8132.3	4218.4	40	9857.7	5672.3
50	6808.2	3168.7	50	8157.5	4239.0	50	9890.8	5700.9
<b>100</b>	6828.3	3184.1	<b>110</b>	8182.8	4259.7	<b>120</b>	9924.0	5729.7
10	6848.5	3199.6	10	8208.2	4280.5	10	9957.5	5758.6
20	6868.8	3215.1	20	8233.7	4301.4	20	9991.0	5787.7
30	6889.2	3230.8	30	8259.3	4322.4	30	10025.0	5817.0
40	6909.6	3246.5	40	8285.0	4343.6	40	10059.0	5846.5
50	6930.1	3262.3	50	8310.8	4364.8	50	10093.0	5876.1

Table V. Corrections for use with table IV,

COPYRIGHT, 1902, BY KEUFFEL &amp; ESSER CO.

For Tangents Add															
ANGLE	CURVE	5°	10°	15°	20°	25°	30°	35°	40°	45°	50°	55°	60°	65°	70°
10°		.03	.06	.09	.13	.16	.19	.22	.25	.28	.31	.34	.38	.42	.46
15°		.04	.10	.14	.19	.24	.29	.34	.39	.45	.51	.53	.58	.63	.68
20°		.06	.13	.19	.26	.32	.39	.45	.51	.58	.65	.72	.79	.84	.90
25°		.08	.16	.24	.33	.40	.49	.58	.67	.75	.83	.90	.99	1.06	1.14
30°		.10	.19	.29	.39	.49	.59	.69	.79	.89	.99	1.09	1.20	1.29	1.39
35°		.11	.22	.34	.47	.58	.69	.70	.81	.92	1.04	1.29	1.42	1.54	1.66
40°		.13	.26	.40	.53	.67	.80	.93	1.06	1.20	1.34	1.49	1.64	1.79	1.94
45°		.15	.30	.44	.60	.76	.91	1.06	1.21	1.37	1.52	1.70	1.87	2.04	2.21
50°		.17	.34	.51	.68	.85	1.02	1.19	1.36	1.54	1.72	1.91	2.10	2.29	2.48
55°		.19	.38	.57	.76	.95	1.14	1.32	1.52	1.72	1.92	2.14	2.35	2.56	2.77
60°		.21	.42	.63	.84	1.05	1.27	1.49	1.71	1.94	2.17	2.38	2.60	2.83	3.07
65°		.23	.46	.69	.93	1.16	1.40	1.64	1.88	2.13	2.38	2.63	2.88	3.13	3.39
70°		.25	.51	.76	1.02	1.28	1.54	1.80	2.06	2.33	2.60	2.88	3.16	3.44	3.72
75°		.27	.56	.83	1.12	1.40	1.69	1.98	2.27	2.57	2.87	3.16	3.47	3.78	4.09
80°		.30	.61	.91	1.22	1.53	1.84	2.15	2.46	2.78	3.10	3.44	3.78	4.12	4.46
85°		.33	.66	1.00	1.33	1.68	2.02	2.36	2.70	3.05	3.40	3.77	4.14	4.55	4.89
90°		.36	.72	1.09	1.45	1.83	2.20	2.57	2.94	3.32	3.70	4.10	4.50	4.91	5.32
95°		.39	.79	1.19	1.55	2.00	2.40	2.80	3.20	3.61	4.02	4.49	4.98	5.38	5.83
100°		.43	.86	1.30	1.74	2.18	2.62	3.06	3.50	3.95	4.40	4.88	5.37	5.85	6.34

## For Externals Add

ANGLE	CURVE	5°	10°	15°	20°	25°	30°	35°	40°	45°	50°	55°	60°	65°	70°
10°		.001	.003	.004	.006	.007	.008	.009	.011	.012	.014	.015	.017	.018	.020
15°		.003	.007	.010	.014	.018	.023	.027	.029	.032	.035	.039	.043	.047	.051
20°		.006	.011	.017	.022	.028	.034	.038	.045	.051	.057	.063	.070	.076	.083
25°		.009	.018	.027	.036	.046	.056	.065	.074	.083	.093	.106	.120	.127	.135
30°		.013	.025	.038	.051	.065	.078	.090	.103	.116	.129	.149	.170	.179	.188
35°		.018	.035	.054	.072	.086	.109	.131	.153	.175	.197	.213	.230	.247	.264
40°		.023	.046	.070	.093	.117	.141	.172	.203	.234	.265	.277	.290	.315	.341
45°		.030	.060	.093	.119	.153	.184	.216	.254	.289	.325	.351	.378	.411	.445
50°		.037	.075	.116	.151	.189	.227	.266	.305	.345	.384	.425	.467	.508	.550
55°		.046	.093	.142	.188	.236	.283	.332	.381	.420	.479	.530	.582	.641	.700
60°		.056	.112	.168	.225	.283	.340	.398	.457	.516	.575	.636	.697	.774	.851
65°		.067	.135	.204	.273	.343	.412	.483	.554	.625	.697	.771	.845	.922	1.01
70°		.080	.159	.240	.321	.403	.485	.568	.652	.735	.819	.906	.994	1.08	1.17
75°		.095	.182	.286	.383	.480	.578	.678	.777	.877	.977	1.07	1.18	1.29	1.39
80°		.110	.220	.332	.445	.558	.671	.787	.903	1.02	1.13	1.25	1.38	1.50	1.62
85°		.128	.259	.391	.524	.657	.790	.926	1.06	1.20	1.34	1.47	1.62	1.76	1.91
90°		.149	.299	.450	.603	.756	.910	1.07	1.22	1.38	1.54	1.70	1.87	2.03	2.20
95°		.174	.350	.522	.706	.885	1.06	1.25	1.43	1.62	1.80	1.99	2.18	2.38	2.58
100°		.200	.401	.604	.809	1.01	1.22	1.43	1.64	1.85	2.06	2.28	2.50	2.73	2.96

Table VI. Deflections for Sub Chords for Short Radius Curves.

Degree of Curve	Radius 50 sin. def. ang.	$\frac{1}{2}$ sub chord = sin of def. angle R				Length of arc for 100 ft.
		12.5 Ft.	15 Ft.	20 Ft.	25 Ft.	
30°	193.18	1° 51'	2° 17'	2° 58'	3° 43'	101.15
32°	181.39	1° 59'	2° 25'	3° 10'	3° 58'	101.33
34°	171.01	2° 06'	2° 33'	3° 21'	4° 12'	101.48
36°	161.80	2° 13'	2° 41'	3° 33'	4° 26'	101.66
38°	153.58	2° 20'	2° 49'	3° 44'	4° 40'	101.85
40°	146.19	2° 27'	2° 57'	3° 55'	4° 54'	102.06
42°	139.52	2° 34'	3° 05'	4° 07'	5° 08'	102.29
44°	133.47	2° 41'	3° 13'	4° 18'	5° 22'	102.53
46°	127.97	2° 48'	3° 21'	4° 29'	5° 36'	102.76
48°	122.92	2° 55'	3° 29'	4° 40'	5° 50'	103.00
50°	118.31	3° 02'	3° 38'	4° 51'	6° 04'	103.24
52°	114.06	3° 09'	3° 46'	5° 02'	6° 17'	103.54
54°	110.11	3° 16'	3° 54'	5° 13'	6° 31'	103.84
56°	106.50	3° 22'	4° 02'	5° 23'	6° 44'	104.14
58°	103.14	3° 29'	4° 10'	5° 34'	6° 57'	104.43
60°	100.00	3° 35'	4° 18'	5° 44'	7° 11'	104.72

## CURVE FORMULAS.

$$T = R \tan \frac{1}{2} I$$

$$T = \frac{50 \tan. \frac{1}{2} I}{\text{Sin. D}}$$

$$\text{Sin. D} = \frac{50}{R}$$

$$\text{Sin. D} = \frac{50 \tan. \frac{1}{2} I}{T}$$

$$R = T \cot. \frac{1}{2} I$$

$$R = \frac{50}{\text{Sin. D}}$$

$$E = R \text{ ex. sec. } \frac{1}{2} I$$

$$E = T \tan \frac{1}{4} I$$

$$\text{Chord def.} = \frac{\text{chord}^2}{R}$$

$$\text{No. chords} = \frac{\frac{1}{2} I}{D}$$

$$\text{Tan. def.} = \frac{1}{2} \text{ chord def.}$$

The square of any distance, divided by twice the radius, will equal the distance from tangent to curve, very nearly.

Table IV. contains Tangents and External to a 1° curve. Tan. and Ext. to any other radius may be found, nearly enough, by dividing the Tan. or Ext. opposite the given Central Angle by the given degree of curve.

To find Deg. of Curve, having the Central Angle and Tangent: Divide Tan. opposite the given Central Angle by the given Tangent.

To find Deg. of Curve, having the Central Angle and Tangent: Divide Ext. opposite the given Central Angle by the given External.

To find, Nat. Tan. and Nat. Ex. Sec. for any angle by Table IV.: Tan. or Ext. of twice the given angle divided by the radius of a 1° curve will be the Nat. Tan. or Nat. Ex. Sec.

To find angle for a given distance and deflection.

Rule 1. Multiply the given distance by .01745 (def. for 1° for 1 ft.), and divide given deflection by the product.

Rule 2. Multiply given deflection by 57.3, and divide the product by the given distance.

To find deflection for a given angle and distance: Multiply the angle by .01745, and the product by the distance.

RIGHT ANGLE TRIANGLES.— Square the altitude, divide by twice the base. Add quotient to base for hypotenuse.

Given Base 100, Alt 10.  $10^2 \div 200 = .5$ .  $100 + .5 = 100.5$  hyp.

Given Hyp. 100, Alt. 25.  $25^2 \div 200 = 3.125$ .  $100 - 3.125 = 96.875 =$  Base.

Error in first example, .002; in last, .045.

To find Tons of Rail in one mile of track: multiply weight per yard by 11, and divide by 7.

## Natural Sines

DEG.	0'	10'	20'	30'	40'	50'	DEG.	DEG.	0'	10'	20'	30'	40'	50'	DEG.
0	0000	0029	0058	0087	0116	0145	89	40	6428	6450	6472	6494	6517	6539	49
1	0175	0204	0233	0262	0291	0320	88	41	6561	6583	6604	6626	6648	6670	48
2	0349	0378	0407	0436	0465	0494	87	42	6691	6713	6734	6756	6777	6799	47
3	0523	0552	0581	0610	0640	0669	86	43	6820	6841	6862	6884	6905	6926	46
4	0698	0727	0756	0785	0814	0843	85	44	6947	6967	6988	7009	7030	7050	45
5	0872	0901	0929	0958	0987	1016	84	45	7071	7092	7112	7133	7153	7173	44
6	1045	1074	1103	1132	1161	1190	83	46	7193	7214	7234	7254	7274	7294	43
7	1219	1248	1276	1305	1334	1363	82	47	7314	7335	7355	7375	7395	7415	42
8	1392	1421	1449	1478	1507	1536	81	48	7431	7451	7470	7490	7509	7528	41
9	1564	1593	1622	1650	1679	1708	80	49	7547	7566	7585	7604	7623	7642	40
10	1736	1765	1794	1822	1851	1880	79	50	7660	7679	7698	7716	7735	7753	39
11	1908	1937	1965	1994	2022	2051	78	51	7771	7790	7808	7826	7844	7862	38
12	2079	2108	2136	2164	2193	2221	77	52	7880	7898	7916	7934	7951	7969	37
13	2250	2278	2306	2334	2363	2391	76	53	7986	8004	8021	8039	8056	8073	36
14	2419	2447	2475	2504	2532	2560	75	54	8090	8107	8124	8141	8158	8175	35
15	2588	2616	2644	2672	2700	2728	74	55	8192	8208	8225	8241	8258	8274	34
16	2756	2784	2812	2840	2868	2896	73	56	8290	8307	8323	8339	8355	8371	33
17	2924	2952	2979	3007	3035	3062	72	57	8387	8403	8418	8434	8450	8465	32
18	3090	3118	3145	3173	3201	3228	71	58	8480	8496	8511	8526	8542	8557	31
19	3256	3283	3311	3338	3365	3393	70	59	8572	8587	8601	8616	8631	8646	30
20	3420	3448	3475	3502	3529	3557	69	60	8660	8675	8689	8704	8718	8732	29
21	3584	3611	3638	3665	3692	3719	68	61	8746	8760	8774	8788	8802	8816	28
22	3746	3773	3800	3827	3854	3881	67	62	8829	8843	8857	8870	8884	8897	27
23	3907	3934	3961	3987	4014	4041	66	63	8910	8923	8936	8949	8962	8975	26
24	4067	4094	4120	4147	4173	4200	65	64	8988	9001	9013	9026	9038	9051	25
25	4226	4253	4279	4305	4331	4358	64	65	9063	9075	9088	9100	9112	9124	24
26	4384	4410	4436	4462	4488	4514	63	66	9135	9147	9159	9171	9182	9194	23
27	4540	4566	4592	4617	4643	4669	62	67	9205	9216	9228	9239	9250	9261	22
28	4695	4720	4746	4772	4797	4823	61	68	9272	9283	9293	9304	9315	9325	21
29	4848	4874	4899	4924	4950	4975	60	69	9336	9346	9356	9367	9377	9387	20
30	5000	5025	5050	5075	5100	5125	59	70	9397	9407	9417	9426	9436	9446	19
31	5150	5175	5200	5225	5250	5275	58	71	9455	9465	9474	9483	9492	9502	18
32	5299	5324	5348	5373	5398	5422	57	72	9511	9520	9529	9537	9546	9555	17
33	5446	5471	5495	5519	5544	5568	56	73	9563	9572	9580	9588	9596	9605	16
34	5592	5616	5640	5664	5688	5712	55	74	9613	9621	9628	9636	9644	9652	15
35	5736	5760	5783	5807	5831	5854	54	75	9659	9667	9674	9681	9689	9696	14
36	5878	5901	5925	5948	5972	5995	53	76	9703	9710	9717	9724	9730	9737	13
37	6018	6041	6065	6088	6111	6134	52	77	9744	9750	9757	9763	9769	9775	12
38	6157	6180	6202	6225	6248	6271	51	78	9781	9787	9793	9799	9805	9811	11
39	6293	6316	6338	6361	6383	6406	50	79	9816	9822	9827	9833	9838	9843	10
DEG.	60'	50'	40'	30'	20'	10'	DEG.	DEG.	60'	50'	40'	30'	20'	10'	DEG.
DEG.	0'	10'	20'	30'	40'	50'	DEG.								DEG.
80	9848	9853	9858	9863	9868	9872	9								
81	9877	9881	9886	9890	9894	9898	8								
82	9903	9907	9911	9914	9918	9922	7								
83	9925	9929	9932	9936	9939	9942	6								
84	9945	9948	9951	9954	9957	9959	5								
85	9962	9964	9967	9969	9971	9974	4								
86	9976	9978	9980	9981	9983	9985	3								
87	9986	9988	9989	9990	9992	9993	2								
88	9994	9995	9996	9997	9997	9998	1								
89	9998	9999	9999	9999	I.0000	I.0000	0								
DEG.	60'	50'	40'	30'	20'	10'	DEG.								DEG.

## Natural Cosines

Natural Tangents

DEG.	0'	10'	20'	30'	40'	50'	DEG.	0'	10'	20'	30'	40'	50'	DEG.
0	0000	0029	0058	0087	0116	0145	89	8391	8441	8491	8541	8591	8642	49
1	0175	0204	0233	0262	0291	0320	88	8693	8744	8796	8847	8899	8952	48
2	0349	0378	0407	0437	0466	0495	87	9004	9057	9110	9163	9217	9271	47
3	0524	0553	0582	0612	0641	0670	86	9325	9380	9435	9490	9545	9601	46
4	0699	0729	0758	0787	0816	0846	85	9657	9713	9770	9827	9884	9942	45
5	0875	0904	0934	0963	0992	1022	84	1.0000	1.0058	1.0117	1.0176	1.0235	1.0295	44
6	1051	1080	1110	1139	1169	1198	83	1.0355	1.0416	1.0477	1.0533	1.0599	1.0661	43
7	1228	1257	1287	1317	1346	1376	82	1.0724	1.0786	1.0850	1.0913	1.0977	1.1041	42
8	1405	1435	1465	1495	1524	1554	81	1.1106	1.1171	1.1237	1.1303	1.1369	1.1436	41
9	1584	1614	1644	1673	1703	1733	80	1.1504	1.1571	1.1640	1.1708	1.1778	1.1847	40
10	1763	1793	1823	1853	1883	1914	79	1.1918	1.1988	1.2059	1.2131	1.2203	1.2276	39
11	1944	1974	2004	2035	2065	2095	78	1.2349	1.2423	1.2497	1.2572	1.2647	1.2723	38
12	2126	2156	2186	2217	2247	2278	77	1.2799	1.2876	1.2954	1.3032	1.3111	1.3190	37
13	2309	2339	2370	2401	2432	2462	76	1.3270	1.3351	1.3432	1.3514	1.3597	1.3680	36
14	2493	2524	2555	2586	2617	2648	75	1.3764	1.3848	1.3934	1.4019	1.4106	1.4193	35
15	2679	2711	2742	2773	2805	2836	74	1.4281	1.4370	1.4460	1.4550	1.4641	1.4733	34
16	2867	2899	2931	2962	2994	3026	73	1.4826	1.4919	1.5013	1.5108	1.5204	1.5301	33
17	3057	3089	3121	3153	3185	3217	72	1.5399	1.5497	1.5597	1.5697	1.5798	1.5900	32
18	3249	3281	3314	3346	3378	3411	71	1.6003	1.6107	1.6212	1.6319	1.6426	1.6534	31
19	3443	3476	3508	3541	3574	3607	70	1.6643	1.6753	1.6864	1.6977	1.7090	1.7205	30
20	3640	3673	3706	3739	3772	3805	69	1.7321	1.7437	1.7556	1.7675	1.7797	1.7917	29
21	3839	3872	3906	3939	3973	4006	68	1.8040	1.8165	1.8291	1.8418	1.8546	1.8676	28
22	4040	4074	4108	4142	4176	4210	67	1.8807	1.8940	1.9074	1.9210	1.9347	1.9486	27
23	4245	4279	4314	4348	4383	4417	66	1.9626	1.9768	1.9912	2.0057	2.0204	2.0353	26
24	4452	4487	4522	4557	4592	4628	65	2.0503	2.0655	2.0809	2.0965	2.1123	2.1283	25
25	4663	4699	4734	4770	4806	4841	64	2.1445	2.1609	2.1775	2.1943	2.2113	2.2286	24
26	4877	4913	4950	4986	5022	5059	63	2.2460	2.2637	2.2817	2.2998	2.3183	2.3369	23
27	5095	5132	5169	5206	5243	5280	62	2.3559	2.3750	2.3945	2.4142	2.4342	2.4545	22
28	5317	5354	5392	5430	5467	5505	61	2.4751	2.4960	2.5172	2.5386	2.5605	2.5826	21
29	5543	5581	5619	5658	5696	5735	60	2.6051	2.6279	2.6511	2.6746	2.6985	2.7228	20
30	5774	5812	5851	5890	5930	5969	59	2.7475	2.7725	2.7980	2.8239	2.8502	2.8770	19
31	6009	6048	6088	6128	6168	6208	58	2.9042	2.9319	2.9600	2.9887	3.0178	3.0475	18
32	6249	6289	6330	6371	6412	6453	57	3.0777	3.1084	3.1397	3.1716	3.2041	3.2371	17
33	6494	6536	6577	6619	6661	6703	56	3.2709	3.3052	3.3402	3.3759	3.4124	3.4495	16
34	6745	6787	6830	6873	6916	6959	55	3.4874	3.5261	3.5656	3.6059	3.6470	3.6891	15
35	7002	7046	7089	7133	7177	7221	54	3.7321	3.7760	3.8208	3.8667	3.9136	3.9617	14
36	7265	7310	7355	7400	7445	7490	53	4.0108	4.0611	4.1126	4.1653	4.2193	4.2747	13
37	7536	7581	7627	7673	7720	7766	52	4.3315	4.3897	4.4494	4.5107	4.5736	4.6382	12
38	7813	7860	7907	7954	8002	8050	51	4.7046	4.7729	4.8430	4.9152	4.9894	5.0658	11
39	8098	8146	8195	8243	8292	8342	50	5.1446	5.2257	5.3093	5.3955	5.4845	5.5764	10
DEG.	60'	50'	40'	30'	20'	10'	DEG.	60'	50'	40'	30'	20'	10'	DEG.

DEG.	0'	10'	20'	30'	40'	50'	DEG.
80	5.6713	5.7694	5.8708	5.9758	6.0844	6.1970	9
81	6.3138	6.4348	6.5606	6.6912	6.8269	6.9682	8
82	7.1154	7.2687	7.4287	7.5958	7.7704	7.9530	7
83	8.1443	8.3450	8.5555	8.7769	9.0098	9.2553	6
84	9.5144	9.7882	10.078	10.385	10.711	11.059	5
85	11.430	11.826	12.250	12.706	13.197	13.727	4
86	14.300	14.924	15.605	16.350	17.169	18.075	3
87	19.081	20.206	21.470	22.903	24.542	26.432	2
88	28.636	31.242	34.368	38.189	42.964	49.104	1
89	57.290	68.750	85.940	114.588	171.885	343.770	0
DEG.	60'	50'	40'	30'	20'	10'	DEG.

Natural Cotangents

294466. 25 X 30 X 15

---

25' X 22 X 6'

Lt 25 X 22 X 3'

R.T. 24 X 40 X 3'

3.2

8  
9  
7

906.7

908

909.90  
6.04  
915.94  
8.69  
907.25  
3.09  
910.34

915.9  
9.1  
906.8

42.8

43.16

X Section no  
For Grade Change.

USED AS FINAL  
7/18/27  
M.W.L.

Sta	+	HI	-	Elev
B.M.	12.98	913.86.		900.88
T.P.	7.46	920.85.	0.47	913.39.

225+00				09.7	10.1
--------	--	--	--	------	------

+39				10.9	12.2
-----	--	--	--	------	------

11.4

+60					13.4
-----	--	--	--	--	------

T.P.	12.94	924.98.	3.81	917.04.	
------	-------	---------	------	---------	--

226				12.3	14.8
-----	--	--	--	------	------

+33				12.9	16.5
-----	--	--	--	------	------

+72				13.4	17.0
-----	--	--	--	------	------

227				13.6	16.7
-----	--	--	--	------	------

+50				13.9	15.3
-----	--	--	--	------	------

228				13.8	15.2
-----	--	--	--	------	------

T.P.	2.07	919.11.	12.94	917.04.	
------	------	---------	-------	---------	--

+50				13.5	15.5
-----	--	--	--	------	------

+75				13.2	15.1
-----	--	--	--	------	------

11.2

$\frac{70}{56}$	$\frac{78}{39}$	$\frac{82}{37}$	$\frac{90}{35}$	$\frac{73}{21}$	10.8	$\frac{108}{20}$	$\frac{110}{31}$	$\frac{10.4}{50}$
-----------------	-----------------	-----------------	-----------------	-----------------	------	------------------	------------------	-------------------

10.0

$\frac{38}{56}$	$\frac{37}{44}$	$\frac{43}{41}$	$\frac{78}{37}$	$\frac{75}{7}$	$\frac{90}{5}$	8.7	$\frac{90}{26}$	$\frac{9.8}{36}$	$\frac{10.1}{50}$
-----------------	-----------------	-----------------	-----------------	----------------	----------------	-----	-----------------	------------------	-------------------

9.5

$\frac{10.3}{50}$	$\frac{0.0}{46}$	$\frac{68}{39}$	$\frac{65}{7}$	$\frac{75}{6}$	7.5	$\frac{8.0}{21}$	$\frac{73}{22}$	$\frac{78}{32}$	$\frac{8.7}{34}$	$\frac{9.4}{50}$
-------------------	------------------	-----------------	----------------	----------------	-----	------------------	-----------------	-----------------	------------------	------------------

17.7

$\frac{2.7}{50}$	$\frac{138}{38}$	$\frac{142}{6}$	$\frac{123}{5}$	12.2	$\frac{15.6}{21}$	$\frac{14.3}{23}$	$\frac{14.8}{37}$	$\frac{12.4}{41}$	$\frac{13.0}{50}$
------------------	------------------	-----------------	-----------------	------	-------------------	-------------------	-------------------	-------------------	-------------------

17.1

$\frac{10}{50}$	$\frac{129}{39}$	$\frac{127}{7}$	$\frac{136}{6}$	13.5	$\frac{143}{22}$	$\frac{13.3}{23}$	$\frac{13.6}{40}$	$\frac{8.0}{46}$	$\frac{7.5}{50}$
-----------------	------------------	-----------------	-----------------	------	------------------	-------------------	-------------------	------------------	------------------

16.6

$\frac{0.3}{50}$	$\frac{12.4}{40}$	$\frac{121}{8}$	$\frac{132}{7}$	13.0	$\frac{133}{22}$	$\frac{12.4}{23}$	$\frac{12.7}{41}$	$\frac{5.9}{47}$	$\frac{5.4}{50}$
------------------	-------------------	-----------------	-----------------	------	------------------	-------------------	-------------------	------------------	------------------

16.4

$\frac{15}{50}$	$\frac{12.7}{40}$	$\frac{123}{8}$	$\frac{133}{7}$	13.3	$\frac{135}{22}$	$\frac{12.8}{23}$	$\frac{12.9}{41}$	$\frac{5.0}{47}$	$\frac{4.7}{50}$
-----------------	-------------------	-----------------	-----------------	------	------------------	-------------------	-------------------	------------------	------------------

16.1

$\frac{4.7}{50}$	$\frac{135}{40}$	$\frac{135}{9}$	$\frac{145}{8}$	14.7	$\frac{145}{20}$	$\frac{138}{21}$	$\frac{136}{39}$	$\frac{3.3}{39.5}$	$\frac{3.0}{50}$
------------------	------------------	-----------------	-----------------	------	------------------	------------------	------------------	--------------------	------------------

16.2

$\frac{9.8}{50}$	$\frac{8.8}{48}$	$\frac{91}{46}$	$\frac{142}{42}$	$\frac{140}{10}$	$\frac{149}{9}$	14.8	$\frac{15.2}{19}$	$\frac{145}{20}$	$\frac{14.8}{37}$	$\frac{8.5}{43}$	$\frac{8.0}{46}$	$\frac{8.7}{50}$
------------------	------------------	-----------------	------------------	------------------	-----------------	------	-------------------	------------------	-------------------	------------------	------------------	------------------

5.6

$\frac{12}{50}$	$\frac{17}{48}$	$\frac{0.0}{45}$	$\frac{0.2}{43}$	$\frac{34}{39}$	$\frac{28}{12}$	$\frac{40}{11}$	3.6	$\frac{4.0}{17}$	$\frac{3.4}{18}$	$\frac{3.8}{34}$	$\frac{1.4}{37}$	$\frac{1.3}{40}$	$\frac{3.1}{50}$
-----------------	-----------------	------------------	------------------	-----------------	-----------------	-----------------	-----	------------------	------------------	------------------	------------------	------------------	------------------

5.9

$\frac{21}{50}$	$\frac{26}{48}$	$\frac{12}{45}$	$\frac{15}{43}$	$\frac{35}{39}$	$\frac{33}{14}$	$\frac{43}{13}$	4.0	$\frac{45}{16}$	$\frac{39}{17}$	$\frac{4.7}{31}$	$\frac{3.5}{34}$	$\frac{3.6}{36}$	$\frac{6.2}{50}$
-----------------	-----------------	-----------------	-----------------	-----------------	-----------------	-----------------	-----	-----------------	-----------------	------------------	------------------	------------------	------------------

Sta		HI	-	Elev	
229+00		919.11.		12.8	14.0
32				12.2	12.6
+70				11.5	11.0

~~229+00~~

T.P	3.48	913.13.	9.46	909.65.	
B.M			12.27.	900.86.	900.88.
230+00				11.0	10.1

+30				10.5	9.8
-----	--	--	--	------	-----

+50				10.1	9.1
-----	--	--	--	------	-----

+73				9.7	8.7
-----	--	--	--	-----	-----

231				9.2	8.4
-----	--	--	--	-----	-----

+24				5 8.8	8.1
-----	--	--	--	----------	-----

+65				8.0	7.4
-----	--	--	--	-----	-----

232				7.4	7.1
-----	--	--	--	-----	-----

$$\frac{36}{50} \frac{40}{44} \quad \frac{28}{42} \frac{31}{40} \quad \frac{46}{37} \frac{44}{14} \frac{54}{13} \quad 51 \quad \frac{56}{31} \frac{50}{32} \quad \frac{48}{24} \quad \frac{85}{50}$$

6.3

6.9

$$\frac{70}{50} \frac{70}{44} \frac{75}{42} \frac{60}{38} \quad \frac{61}{36} \frac{67}{35} \quad \frac{59}{15} \frac{67}{14} \quad 65 \quad \frac{70}{31} \quad \frac{110}{50}$$

7.6

$$\frac{105}{50} \frac{104}{40} \frac{114}{37} \quad \frac{101}{36} \frac{107}{33} \quad \frac{90}{32} \frac{97}{30} \quad 81 \quad \frac{77}{18} \frac{68}{21} \quad \frac{153}{36}$$

2.1

$$\frac{22}{50} \frac{27}{36} \frac{90}{81} \quad \frac{78}{30} \frac{62}{27} \quad \frac{61}{24} \frac{45}{23} \quad \frac{32}{15} \quad 30 \quad \frac{24}{15} \quad \frac{20}{17} \quad \frac{16}{20} \quad \frac{48}{25} \quad \frac{61}{29} \quad \frac{105}{36}$$

2.6

$$\frac{127}{50} \quad \frac{108}{45} \quad \frac{107}{35} \quad \frac{57}{21} \quad 33 \quad \frac{30}{14} \quad \frac{17}{17} \quad \frac{120}{33}$$

3.1

$$\frac{163}{50} \quad \frac{125}{40} \quad \frac{41}{24} \quad 40 \quad \frac{37}{13} \quad \frac{30}{17} \quad \frac{120}{30}$$

3.4

$$\frac{130}{40} \quad \frac{67}{31} \quad \frac{43}{24} \quad 44 \quad \frac{42}{13} \quad \frac{30}{16} \quad \frac{130}{32}$$

3.9

$$\frac{107}{35} \quad \frac{50}{26} \quad 47 \quad \frac{55}{20} \quad \frac{128}{32}$$

4.3

$$\frac{133}{37} \quad \frac{54}{24} \quad 50 \quad \frac{53}{21} \quad \frac{128}{35}$$

5.1

$$\frac{127}{36} \quad \frac{90}{30} \quad \frac{70}{27} \quad \frac{56}{20} \quad 57 \quad \frac{60}{20} \quad \frac{133}{37} \quad \frac{125}{50}$$

5.7

$$\frac{124}{36} \quad \frac{85}{28} \quad \frac{84}{13} \quad \frac{64}{20} \quad 57 \quad \frac{58}{20} \quad \frac{90}{26} \quad \frac{76}{30} \quad \frac{79}{32} \quad \frac{84}{50}$$

5+9

+

H7

-

Elev

913.73.

232 H4

7.1 7.3

+42

6.6 6.9

+75

6.0 6.1

233

5.6 5.9

38

4.9 5.0

+75

4.2 4.4

234

3.8 3.8

+25

3.4 3.5

+72

2.9 3.1

235

2.9 2.9

134

2.7 3.4

# Finals x Section Cut.

232+14 to 235+70

6.0

$\frac{162}{50}$   $\frac{145}{39}$   $\frac{9.2}{30}$   $\frac{9.0}{24}$   $\frac{6.3}{20}$  5.8  $\frac{6.2}{20}$   $\frac{8.5}{24}$   $\frac{9.4}{31}$   $\frac{6.6}{36}$   $\frac{8.2}{50}$

6.5

$\frac{18.8}{50}$   $\frac{11.2}{45}$   $\frac{7.6}{33}$   $\frac{7.2}{30}$   $\frac{9.3}{27}$   $\frac{9.1}{24}$   $\frac{6.5}{19}$  6.2  $\frac{6.6}{20}$   $\frac{9.0}{25}$   $\frac{9.0}{28}$   $\frac{7.6}{31}$   $\frac{7.8}{34}$   $\frac{7.0}{37}$   $\frac{7.7}{50}$

7.1

$\frac{2.7}{50}$   $\frac{3.3}{37}$   $\frac{9.5}{27}$   $\frac{9.5}{25}$   $\frac{6.8}{20}$  7.0  $\frac{7.1}{21}$   $\frac{8.8}{24}$   $\frac{8.9}{28}$   $\frac{4.5}{35}$   $\frac{5.7}{50}$

7.5

$\frac{4.4}{50}$   $\frac{2.0}{40}$   $\frac{9.8}{27}$   $\frac{9.6}{24}$   $\frac{7.1}{19}$  7.2  $\frac{7.4}{21}$   $\frac{9.0}{24}$   $\frac{9.2}{27}$   $\frac{3.4}{38}$   $\frac{4.2}{50}$

8.2

$\frac{3.8}{50}$   $\frac{1.5}{41}$   $\frac{10.3}{27}$   $\frac{10.0}{23}$   $\frac{8.0}{20}$  8.1  $\frac{8.0}{21}$   $\frac{9.5}{24}$   $\frac{9.5}{27}$   $\frac{2.2}{40}$   $\frac{2.7}{50}$

8.9

$\frac{8.2}{50}$   $\frac{4.4}{38}$   $\frac{11.3}{28}$   $\frac{11.3}{24}$   $\frac{8.8}{20}$  8.7  $\frac{8.6}{40}$   $\frac{10.6}{24}$   $\frac{11.0}{28}$   $\frac{7.5}{32}$   $\frac{7.0}{35}$   $\frac{10.6}{50}$

9.3

$\frac{9.6}{50}$   $\frac{6.2}{37}$   $\frac{11.5}{28}$   $\frac{11.3}{23}$   $\frac{7.2}{19}$  9.3  $\frac{9.2}{20}$   $\frac{10.8}{23}$   $\frac{11.2}{26}$   $\frac{9.8}{29}$   $\frac{19.2}{50}$

9.7

$\frac{5.6}{50}$   $\frac{4.3}{39}$   $\frac{11.5}{28}$   $\frac{11.2}{24}$   $\frac{9.5}{20}$  9.6  $\frac{9.5}{20}$   $\frac{10.8}{23}$   $\frac{10.8}{25}$

10.2

$\frac{0.0}{50}$   $\frac{0.5}{48}$   $\frac{2.2}{44}$   $\frac{12.0}{28}$   $\frac{11.8}{24}$   $\frac{9.7}{20}$  10.0  $\frac{10.0}{22}$

10.2

$\frac{2.2}{50}$   $\frac{1.8}{44}$   $\frac{12.0}{29}$   $\frac{12.0}{24}$   $\frac{10.0}{20}$  10.2  $\frac{10.1}{22}$

10.4

$\frac{2.3}{50}$   $\frac{2.8}{42}$   $\frac{12.7}{30}$   $\frac{12.1}{23}$   $\frac{9.4}{19}$  9.7  $\frac{9.4}{21}$

279 + HI -

913.13.

235+48

2.7

3.8

+70

2.8

4.3

T.P.

3.23

907.74.

8.62

904.51.

234+25

3.4

+72

2.9

235

2.9

+34

2.7

+48

2.7

+70

2.8

236+00

3.1

4.9

+50

3.8

5.9

237

4.7

7.0

T.P.

11.60

918.22.

1.12

906.62.

$$\begin{array}{r} 27.14 \\ \hline 5044 \end{array} \quad \begin{array}{r} 12.1 \\ \hline 29 \end{array} \quad \begin{array}{r} 12.1 \\ \hline 23 \end{array} \quad \begin{array}{r} 22 \\ \hline 19 \end{array} \quad \begin{array}{r} 9.3 \\ \hline 21 \end{array} \quad \begin{array}{r} 9.2 \\ \hline 21 \end{array}$$

10.4

$$\begin{array}{r} 4 \\ \hline 50 \end{array} \quad \begin{array}{r} 5 \\ \hline 37 \end{array} \quad \begin{array}{r} 12 \\ \hline 28 \end{array} \quad \begin{array}{r} 11.9 \\ \hline 23 \end{array} \quad \begin{array}{r} 8.9 \\ \hline 18 \end{array} \quad \begin{array}{r} 8.8 \\ \hline 20 \end{array} \quad \begin{array}{r} 8.9 \\ \hline 20 \end{array}$$

10.3

+ 80 = 00 Cut.

Water Water

4.3

$$\begin{array}{r} 13.4 \\ \hline 38 \end{array} \quad \begin{array}{r} 14.3 \\ \hline 42 \end{array}$$

Water Water

4.8

$$\begin{array}{r} 13.3 \\ \hline 31 \end{array} \quad \begin{array}{r} 14.9 \\ \hline 42 \end{array}$$

Water Water

4.8

$$\begin{array}{r} 13.3 \\ \hline 35 \end{array} \quad \begin{array}{r} 14.0 \\ \hline 38 \end{array}$$

Water Water.

5.0

$$\begin{array}{r} 13.3 \\ \hline 38 \end{array} \quad \begin{array}{r} 14.5 \\ \hline 42 \end{array}$$

Water Water.

5.0

$$\begin{array}{r} 13.3 \\ \hline 36 \end{array} \quad \begin{array}{r} 15.8 \\ \hline 40 \end{array}$$

Water W

$$\begin{array}{r} 13.3 \\ \hline 36 \end{array} \quad \begin{array}{r} 16.3 \\ \hline 40 \end{array}$$

4.6

$$\begin{array}{r} 3.2 \\ \hline 12.5 \end{array} \quad \begin{array}{r} 2.8 \\ \hline 20 \end{array} \quad \begin{array}{r} 3.3 \\ \hline 20 \end{array}$$

3.9

$$\begin{array}{r} 2.0 \\ \hline 19 \end{array} \quad \begin{array}{r} 1.8 \\ \hline 20 \end{array} \quad \begin{array}{r} 2.6 \\ \hline 20 \end{array}$$

3.0

$$\begin{array}{r} 1.2 \\ \hline 20 \end{array} \quad \begin{array}{r} 0.7 \\ \hline 22 \end{array} \quad \begin{array}{r} 1.1 \\ \hline 22 \end{array}$$

Sta + HI - Elev

918.22.

+50

6.2

8.3

+75

7.0

8.9

238

8.2

9.5

+50

10.2

10.5

+74

11.2

11.3

239

12.1

T.P.

10.39

926.51.

2.10

916.12.

B.M.

1.06

925.45. = 925.47

$$\frac{10.1}{20} \quad \frac{12.0}{9.9} \quad \frac{9.9}{20}$$


$$\frac{9.4}{18} \quad \frac{11.2}{9.3} \quad \frac{9.8}{20}$$

$$\frac{8.2}{19} \quad \frac{10.0}{8.7} \quad \frac{9.5}{19}$$

$$\frac{7.4}{18} \quad \frac{8.0}{7.7} \quad \frac{7.8}{19}$$

$$\frac{6.7}{19} \quad \frac{7.0}{6.9} \quad \frac{7.1}{20}$$

$$\frac{5.7}{20} \quad 6.1 \quad \frac{6.3}{20}$$

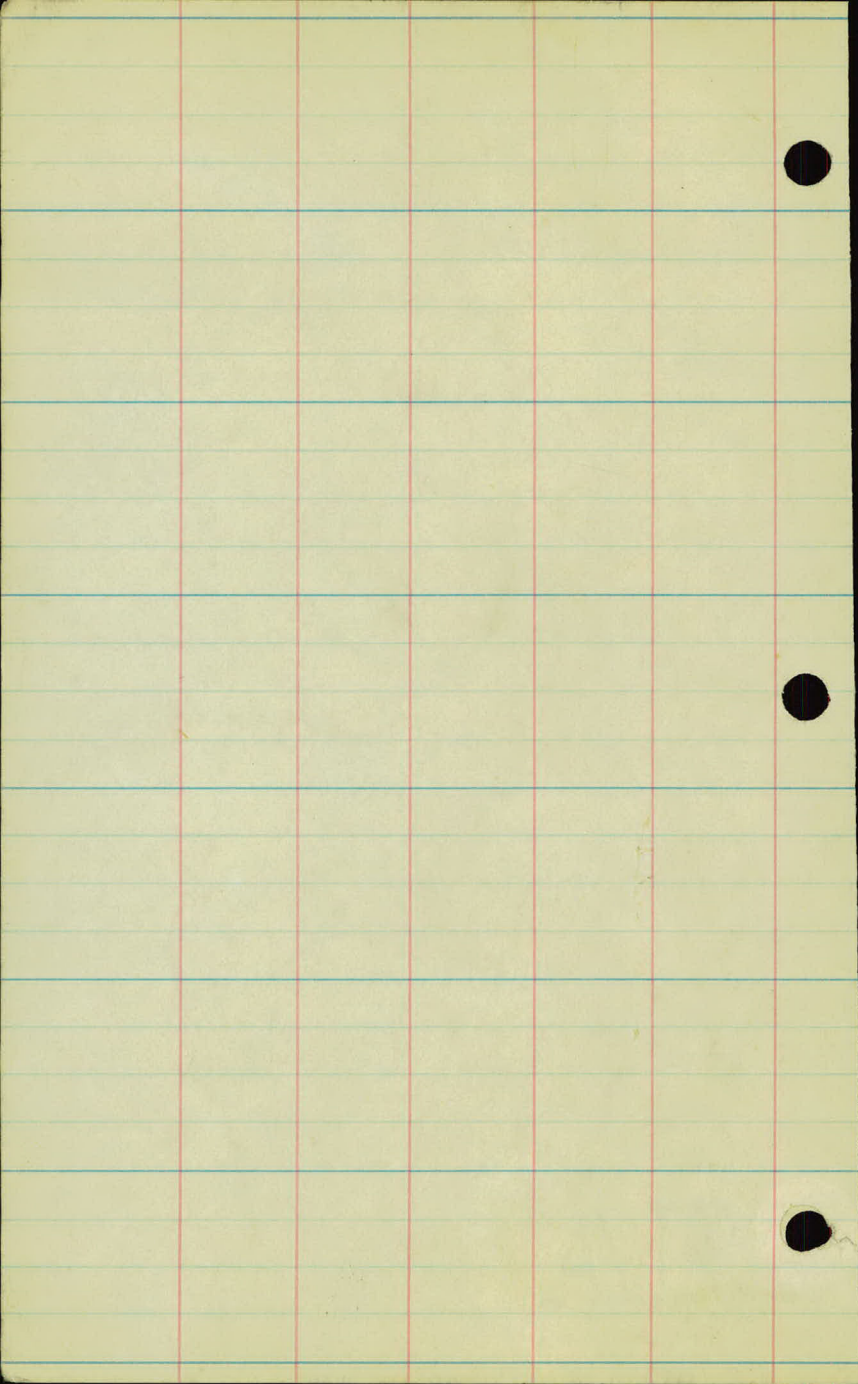

DISTANCES FROM CENTER OF ROADWAY FOR CROSS-SECTIONING.

ROADWAY 14 FEET WIDE. SIDE SLOPES 1<sup>1</sup>/<sub>2</sub> TO 1.

FOR SINGLE TRACK EMBANKMENT.

	0	.1	.2	.3	.4	.5	.6	.7	.8	.9	
0	7.0	7.2	7.3	7.5	7.6	7.8	7.9	8.1	8.2	8.4	0
1	8.5	8.7	8.8	9.0	9.1	9.3	9.4	9.6	9.7	9.9	1
2	10.0	10.2	10.3	10.5	10.6	10.8	10.9	11.1	11.2	11.4	2
3	11.5	11.7	11.8	12.0	12.1	12.3	12.4	12.6	12.7	12.9	3
4	13.0	13.2	13.3	13.5	13.6	13.8	13.9	14.1	14.2	14.4	4
5	14.5	14.7	14.8	15.0	15.1	15.3	15.4	15.6	15.7	15.9	5
6	16.0	16.2	16.3	16.5	16.6	16.8	16.9	17.1	17.2	17.4	6
7	17.5	17.7	17.8	18.0	18.1	18.3	18.4	18.6	18.7	18.9	7
8	19.0	19.2	19.3	19.5	19.6	19.8	19.9	20.1	20.2	20.4	8
9	20.5	20.7	20.8	21.0	21.1	21.3	21.4	21.6	21.7	21.9	9
10	22.0	22.2	22.3	22.5	22.6	22.8	22.9	23.1	23.2	23.4	10
11	23.5	23.7	23.8	24.0	24.1	24.3	24.4	24.6	24.7	24.9	11
12	25.0	25.2	25.3	25.5	25.6	25.8	25.9	26.1	26.2	26.4	12
13	26.5	26.7	26.8	27.0	27.1	27.3	27.4	27.6	27.7	27.9	13
14	28.0	28.2	28.3	28.5	28.6	28.8	28.9	29.1	29.2	29.4	14
15	29.5	29.7	29.8	30.0	30.1	30.3	30.4	30.6	30.7	30.9	15
16	31.0	31.2	31.3	31.5	31.6	31.8	31.9	32.1	32.2	32.4	16
17	32.5	32.7	32.8	33.0	33.1	33.3	33.4	33.6	33.7	33.9	17
18	34.0	34.2	34.3	34.5	34.6	34.8	34.9	35.1	35.2	35.4	18
19	35.5	35.7	35.8	36.0	36.1	36.3	36.4	36.6	36.7	36.9	19
20	37.0	37.2	37.3	37.5	37.6	37.8	37.9	38.1	38.2	38.4	20
21	38.5	38.7	38.8	39.0	39.1	39.3	39.4	39.6	39.7	39.9	21
22	40.0	40.2	40.3	40.5	40.6	40.8	40.9	41.1	41.2	41.4	22
23	41.5	41.7	41.8	42.0	42.1	42.3	42.4	42.6	42.7	42.9	23
24	43.0	43.2	43.3	43.5	43.6	43.8	43.9	44.1	44.2	44.4	24
25	44.5	44.7	44.8	45.0	45.1	45.3	45.4	45.6	45.7	45.9	25
26	46.0	46.2	46.3	46.5	46.6	46.8	46.9	47.1	47.2	47.4	26
27	47.5	47.7	47.8	48.0	48.1	48.3	48.4	48.6	48.7	48.9	27
28	49.0	49.2	49.3	49.5	49.6	49.8	49.9	50.1	50.2	50.4	28
29	50.5	50.7	50.8	51.0	51.1	51.3	51.4	51.6	51.7	51.9	29
30	52.0	52.2	52.3	52.5	52.6	52.8	52.9	53.1	53.2	53.4	30
31	53.5	53.7	53.8	54.0	54.1	54.3	54.4	54.6	54.7	54.9	31
32	55.0	55.2	55.3	55.5	55.6	55.8	55.9	56.1	56.2	56.4	32
33	56.5	56.7	56.8	57.0	57.1	57.3	57.4	57.6	57.7	57.9	33
34	58.0	58.2	58.3	58.5	58.6	58.8	58.9	59.1	59.2	59.4	34
35	59.5	59.7	59.8	60.0	60.1	60.3	60.4	60.6	60.7	60.9	35
36	61.0	61.2	61.3	61.5	61.6	61.8	61.9	62.1	62.2	62.4	36

Calculated by Julien A. Hall, M. Am. Soc. C. E.

MADE IN GERMANY.

02999