

OFFICE OF  
RAMSEY COUNTY ENGINEER

# FINAL TOPOGRAPHY

ANOKA CUT-OFF

PROJ. 26-62-"D"

---

---

FIELD BOOK

NO. 1

---

---

# KEUFFEL & ESSER CO.

DRAWING MATERIALS

AND

SURVEYING INSTRUMENTS.

NEW YORK.

CHICAGO. ST. LOUIS. SAN FRANCISCO. MONTREAL.

## TABLES FOR EXCAVATIONS AND EMBANKMENTS.

DISTANCES FROM CENTER OF ROADWAY FOR CROSS-SECTIONING.

ROADWAY 18 FEET WIDE. SIDE SLOPES 1 TO 1.

FOR SINGLE TRACK EXCAVATION.


*"Copyright, 1895, by Keuffel & Esser Co."*

	0	.1	.2	.3	.4	.5	.6	.7	.8	.9	
0	9.0	9.1	9.2	9.3	9.4	9.5	9.6	9.7	9.8	9.9	0
1	10.0	10.1	10.2	10.3	10.4	10.5	10.6	10.7	10.8	10.9	1
2	11.0	11.1	11.2	11.3	11.4	11.5	11.6	11.7	11.8	11.9	2
3	12.0	12.1	12.2	12.3	12.4	12.5	12.6	12.7	12.8	12.9	3
4	13.0	13.1	13.2	13.3	13.4	13.5	13.6	13.7	13.8	13.9	4
5	14.0	14.1	14.2	14.3	14.4	14.5	14.6	14.7	14.8	14.9	5
6	15.0	15.1	15.2	15.3	15.4	15.5	15.6	15.7	15.8	15.9	6
7	16.0	16.1	16.2	16.3	16.4	16.5	16.6	16.7	16.8	16.9	7
8	17.0	17.1	17.2	17.3	17.4	17.5	17.6	17.7	17.8	17.9	8
9	18.0	18.1	18.2	18.3	18.4	18.5	18.6	18.7	18.8	18.9	9
10	19.0	19.1	19.2	19.3	19.4	19.5	19.6	19.7	19.8	19.9	10
11	20.0	20.1	20.2	20.3	20.4	20.5	20.6	20.7	20.8	20.9	11
12	21.0	21.1	21.2	21.3	21.4	21.5	21.6	21.7	21.8	21.9	12
13	22.0	22.1	22.2	22.3	22.4	22.5	22.6	22.7	22.8	22.9	13
14	23.0	23.1	23.2	23.3	23.4	23.5	23.6	23.7	23.8	23.9	14
15	24.0	24.1	24.2	24.3	24.4	24.5	24.6	24.7	24.8	24.9	15
16	25.0	25.1	25.2	25.3	25.4	25.5	25.6	25.7	25.8	25.9	16
17	26.0	26.1	26.2	26.3	26.4	26.5	26.6	26.7	26.8	26.9	17
18	27.0	27.1	27.2	27.3	27.4	27.5	27.6	27.7	27.8	27.9	18
19	28.0	28.1	28.2	28.3	28.4	28.5	28.6	28.7	28.8	28.9	19
20	29.0	29.1	29.2	29.3	29.4	29.5	29.6	29.7	29.8	29.9	20
21	30.0	30.1	30.2	30.3	30.4	30.5	30.6	30.7	30.8	30.9	21
22	31.0	31.1	31.2	31.3	31.4	31.5	31.6	31.7	31.8	31.9	22
23	32.0	32.1	32.2	32.3	32.4	32.5	32.6	32.7	32.8	32.9	23
24	33.0	33.1	33.2	33.3	33.4	33.5	33.6	33.7	33.8	33.9	24
25	34.0	34.1	34.2	34.3	34.4	34.5	34.6	34.7	34.8	34.9	25
26	35.0	35.1	35.2	35.3	35.4	35.5	35.6	35.7	35.8	35.9	26
27	36.0	36.1	36.2	36.3	36.4	36.5	36.6	36.7	36.8	36.9	27
28	37.0	37.1	37.2	37.3	37.4	37.5	37.6	37.7	37.8	37.9	28
29	38.0	38.1	38.2	38.3	38.4	38.5	38.6	38.7	38.8	38.9	29
30	39.0	39.1	39.2	39.3	39.4	39.5	39.6	39.7	39.8	39.9	30
31	40.0	40.1	40.2	40.3	40.4	40.5	40.6	40.7	40.8	40.9	31
32	41.0	41.1	41.2	41.3	41.4	41.5	41.6	41.7	41.8	41.9	32
33	42.0	42.1	42.2	42.3	42.4	42.5	42.6	42.7	42.8	42.9	33
34	43.0	43.1	43.2	43.3	43.4	43.5	43.6	43.7	43.8	43.9	34
35	44.0	44.1	44.2	44.3	44.4	44.5	44.6	44.7	44.8	44.9	35
36	45.0	45.1	45.2	45.3	45.4	45.5	45.6	45.7	45.8	45.9	36

Calculated by Julien A. Hall, M. Am. Soc. C. E.


For Keith's Railroad Curve Tables see end of book.


H. C. BOYESON CO.  
ST. PAUL.

 

Proj. # 26-62 D.

Sta.	to	Sta.	Description	Page	to	Page.
809		1083	Art. Topog.	2		56

 

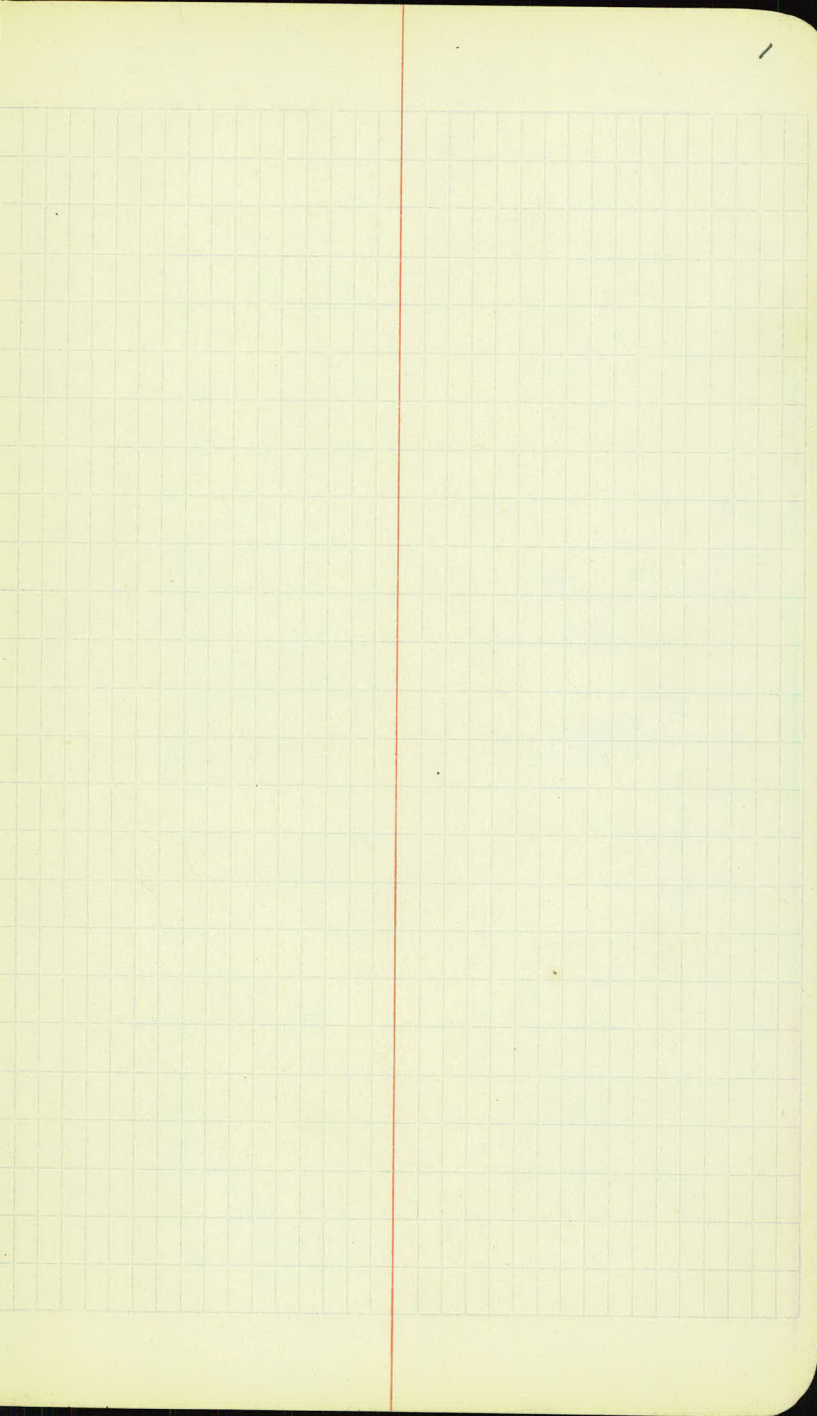

814

813

812

811

810 -


809

4-26-27

+00 F. 36

+00 F. 36

+53 Reg. F. 35

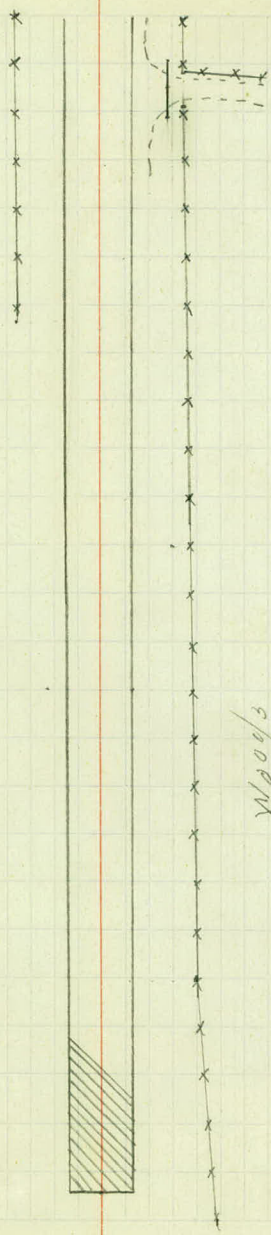

+00 F. 35  
 +76 F. Cor. 35  
 +70 Farm Ent.  
 +70 Side Drain 28  
 New 15" x 24" C.M.  
 +63 End. of F. 35  
 +60 T.P. 30  
 +00 F. 36

+28 T.P. 32  
 +00 F. 37

Woods

+00 F. 39  
 +94 T.P. 35

+00 F. 40  
 +76 stump 37  
 +47 T.P. 40

+13<sup>2</sup>/<sub>3</sub> Reg. of Pave.  
 F. 49

819

818

817

816

815

814

7-26-27

+00 F. 36  
+28 Mail Box 15.  
+81 P.P. 32

+73 Side Road  
+79 Side Drain 28  
New 15" X 30 C.M.

+42 T.P. 27

+85-18"-T-30

+56-24"-T-32  
+48 Farm Ent.  
+41-24"-T-32

+75 Box of F. 36.

+18 T.P. 22

Yard

+70 Side Walk 24  
4" Wide.

+68 Farm Ent.  
+63 Side Drain 28  
New 15" X 24 C.M.

Farm

+94 Farm Ent.  
+98 Side Drain 28  
New 15" X 24 C.M.


+44 End of F. 34

+28 T.P. 28

Woods

+00 F. 33

+22 End of F. 34

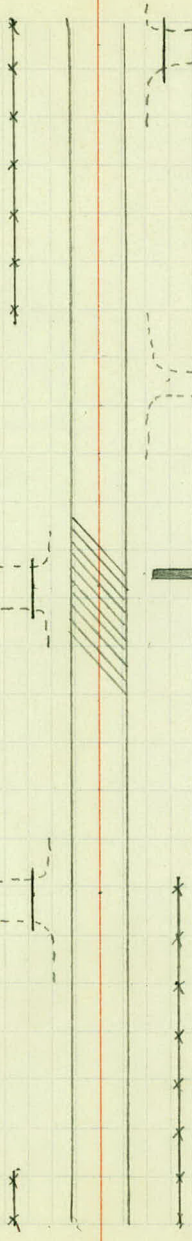

824

823

822

821

820

819

4-26-27

+80 Cross Rain  
34" x 66 10"  
Extends 331.233 N.  
Drains L.

+66 Beg. of G. Rail 17


+33 P.P. 27

+13 End of F. 37

+00 F. 37

+58 P.P. 27

+00 F. 37

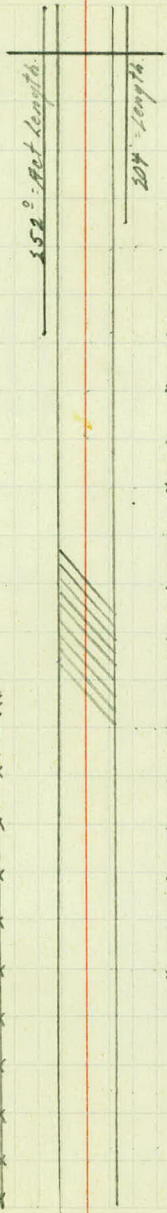

+100 F. 49  
+95 T.P. 30  
+92 Beg. of G. Rail 17  
+66 F. 37

+00 F. 37

+53 T.P. 29

+00 F. 37

+15 T.P. 28

+00 F. 38

+53 F. 42

+27 F. Cor. 48

Woods

829

828

827

826

825

824

4-26-27

+96 Beg of F. 35.

+64 P.P. 27

+77 P.P. 26

+74 Mail Box 16.

+47 Side Road.

+26 P.P. 27

+19 End of C. Rail 17  

+06 P.P. 27


Woods.

+71 Field Ent  
+71 Side Drain 29  
01/12" X 31' P'  
+54 T.P. 27

+40 T.P. 28

+19 T.P. 29.

+77 End of C. Rail 17  
204' = Hot Length  
+56 T.P. 30

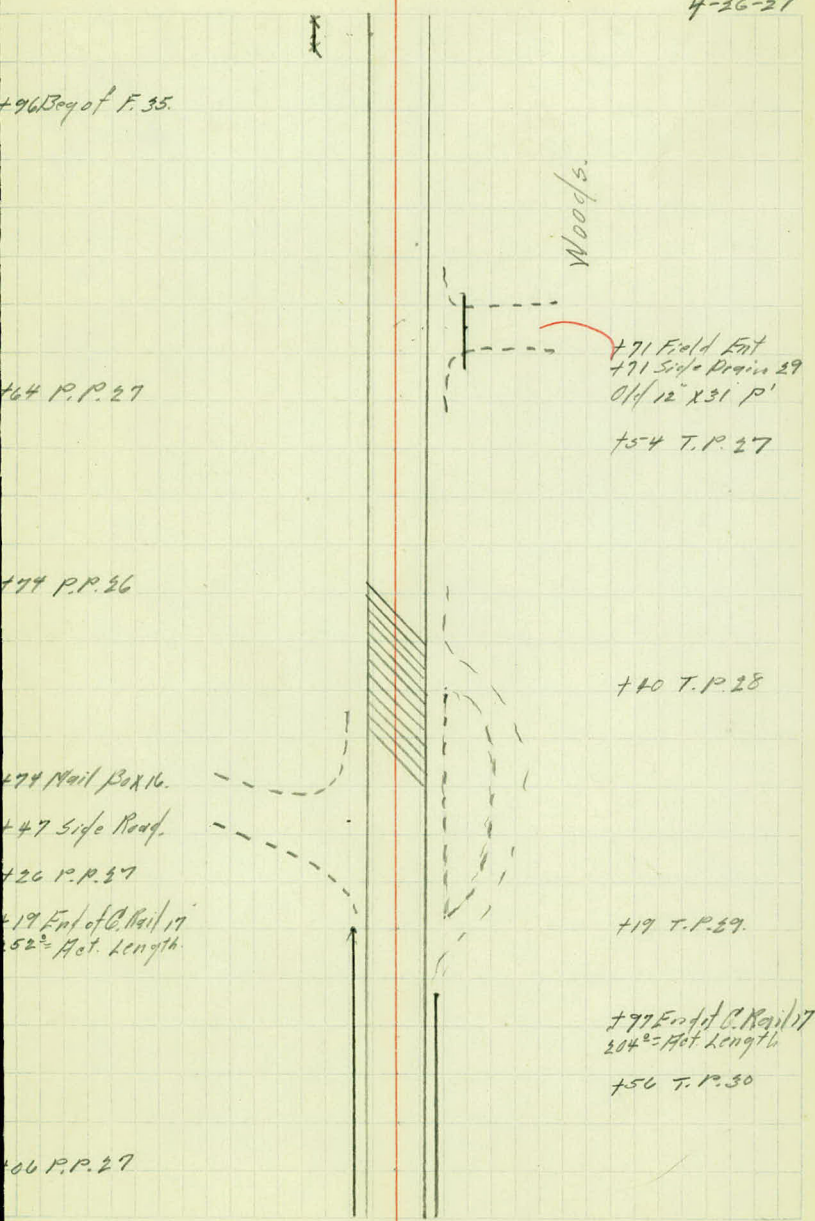

834

833

832

831

830

829

4-26-27

+97 P.P. 28

+76 T.P. 26

+00 F. 45

+00 F. 42

+17 T.P. 25

+77 P.P. 27

+00 F. 41

+34 Farm Ent.

+16 Mail Box 18

+91 Beg. of F. 38

+79 School Ent.



+68 T.P. 24

+64 End of F. 37

+79 T.P. 36

+62 P.P. 28

+06 T.P. 26

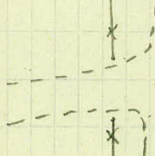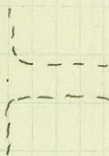

839

838

837

836

835

834

4-26-27

+26 P.P. 28

+00 F. 52

+00 F. 51

+06 P.P. 28

+00 F. 48.

+84 School Sign 26.

+00 F. 48

+56 Beg. of F. 46

+18 Field Ent.

+01 End of F. 47

+23 T.P. 28.

+73 T.P. 28

+00 Side Road.

+31 T.P. 28.

Woods.



844

843

842

841

840

839

4-26-27

400 F. 41

400 F. 44

431 P.P. 28

400 F. 46

400 F. 48

431 P.P. 28

400 F. 51

400 F. 52



779 T.P. 28

*Uncultivated.*

727 T.P. 28

768 T.P. 29

849

848

847

846

845

844

4-26-27

+67 Farm Ent.  
+67 Side Drain 28  
New 15" X 24 C.M.

+74 Beg of F. 37  
+70 T.P. 30  
+56 Farm Ent  
+56 Side Drain 29  
New 15" X 24 C.M.

+65 P.P. 25

+72 P.P. 30

+93 Farm Ent.  
+93 Side Drain 29  
New 15" X 24 C.M.

+28 T.P. 29

+76 Farm Ent.  
+76 Side Drain 29  
New 15" X 24 C.M.

+29 P.P. 27  
+31 End of F. 35


+00 F. 36

+80 T.P. 29

+00 F. 38

+44 P.P. 27

+20 T.P. 29

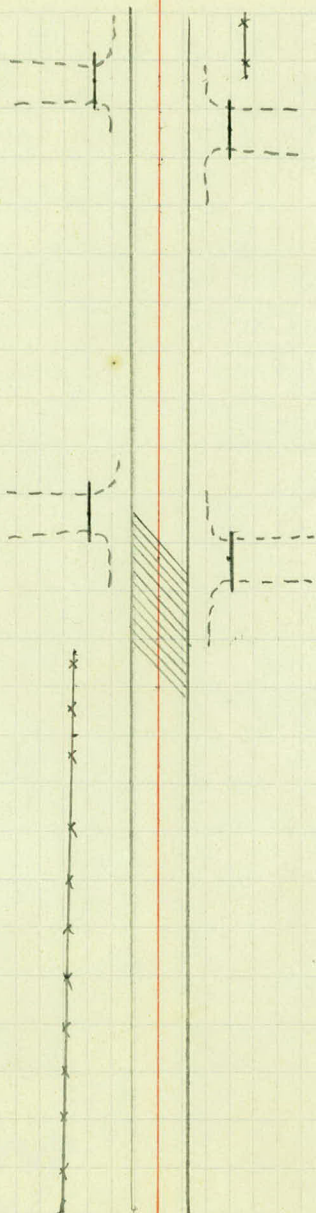

854

853

852

851

850

849

420-27

464 R.P. 19

407 T.P. 28

400 F. 37

Woods

470 R.P. 28

403 Bay of F. 37

491 Farm Ent  
491 5/8" Drain 29  
New 15" x 24" C.M.  
478 End of F. 37  
456 T.P. 29

400 F. 35

454 F. 38

416 T.P. 30

400 F. 38

Woods

472 R.P. 22

400 Mail Box 15



859

858

857

856

855

854

4-26-27

+89 F. Cor. 36

+81 Farm Ent  
+81 S. Dr. 29  
New 15' X 24' C.M.

+78 T.P. 28

Farm Yard

+40 P.P. 20  
+36 N.R. Sign 19  
+04 Mail Box 15

+94 Foot Path  
+94 Side Drain 29  
New 15' X 10' C.M.  
+89 Mail Box 15

+28 Farm Ent.  
+28 Side Drain 29  
New 12' X 21' 10"

+67 P.P. 19

+99 Side Drain 54  
New 18' X 36' C.M.

+71 Side Road  
+61 Side Drain 71

+34 F. Cor. 51  
+15 T.P. 28


+97 F. 36  
+81 F. 33

Woods

+00 F. 35

+58 T.P. 28

+00 F. 36

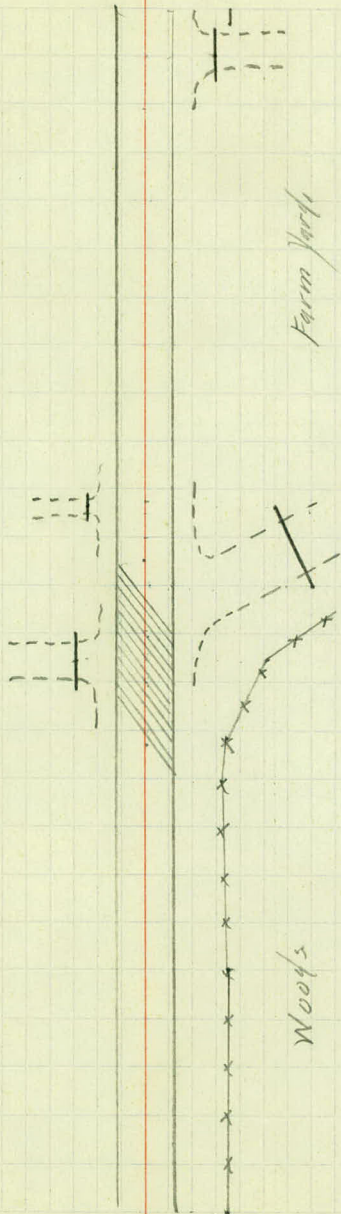

864

863

862

861

860

859

4-26-27

+00 F. 34

+76 T.P. 27

+20 P.P. 21

+00 F. 35

+56 T.P. 28

Wooded Pasture.

+00 F. 35

+32 P.P. 20

+00 F. 35

+82 T.P. 28

+9 P.P. 20

+00 F. 35

+16 T.P. 28



869

868

867

866

865

864

4-26-27

+100 F. 35

+115 T.P. 27

+100 F. 35

19 P.P. 21

+100 F. 35

+170 T.P. 29

Wooded Pasture.

+100 F. 35

21 P.P. 21

+125 T.P. 27

+100 F. 35

40 Field Ent  
40 Side Drain 28  
10W 15' X 24' C.M.



874

873

872

871

870

869

4-26-27

+00 F. 35

+94 Guy Polo 28

+09 Boy. of F. 35

+95 Farm Rd.

+89 F. Cor. 35

+67 T. P. 27

+00 F. 35

+13 T. P. 27

+00 F. 35

+00 F. 35

+71 T. P. 27

90 P. P. 21


63 T. P. 31

41 Farm Rd.

28 Mail Box 19

34 P. P. 21

5 T. P. 21

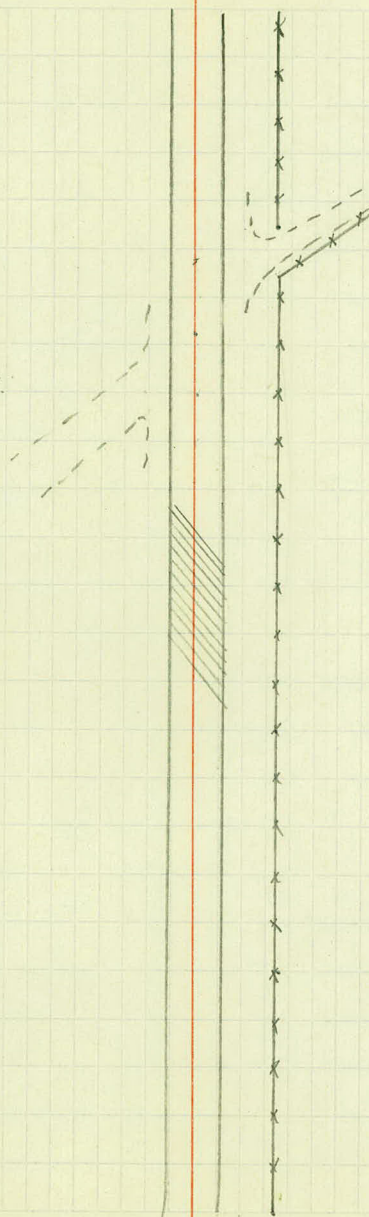

879

878

877

876

875

874

4-26-27

98 P.P. 22

+00 F. 35

+09 T.P. 27

+00 F. 35

83 P.P. 21

+09 T.P. 26

+00 F. 35

Cultivated.

+00 F. 35

+60 T.P. 27

72 P.P. 21

+00 F. 35

+12 T.P. 28



884

883

882

881

880

879

4-26-27

+00 F. 34

+10 T. P. 28

+00 F. 34

+00 F. 35

+60 T. P. 28

+00 F. 35

+15 T. P. 28

+00 F. 35

82 P. P. 23

6 P. P. 22



889

888

887

886

885

884

4-26-27

+00 F. 33

48 P.P. 24

73 Farm Ent.  
73 5 1/2 Drain 28  
EW 15' X 24 C.M.

54 Mail Box 16

+00 F. 33

+76 T.P. 28

8 P.P. 24

+00 F. 33

+68 Guy Pole 21

+23 T.P. 28

+00 F. 34

2 P.P. 23

+00 F. 34

+70 T.P. 28

894

893

892

891

890

889

4-26-27

+00 F. 35

+73 P.P. 26

+00 F. 35

+50 Req. of F. 34

+29 P.P. 25

+85 Mail Box 19

+40 P.P. 24

+00 F. 35.

+80 T.P. 28

+46 Cross F.

+00 F. 35

+95 T.P. 28

+93 Req. of F. 35

+86 Form Ent.

+80 Sic/a Drain 28

Now. 15" X 24" C.M.

+78 F. Cor. 35

+00 F. 36


+81 T.P. 28

+00 F. 35

+27 T.P. 27

+11 F. 35

+09 Cross F. 34

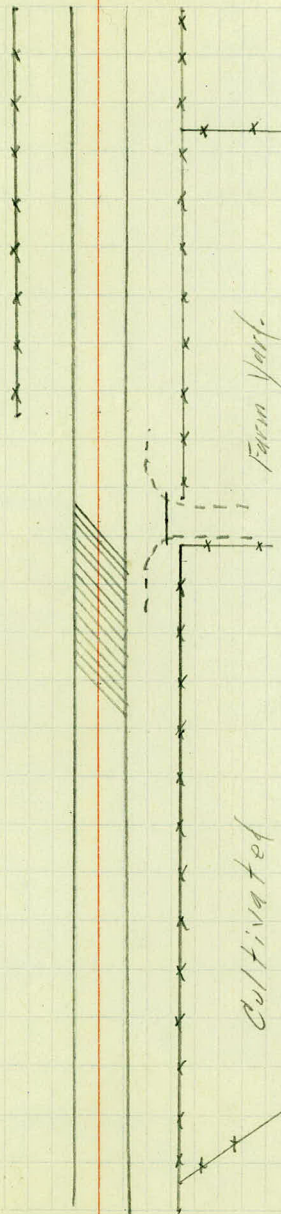

Farm Yard

Cultivated

899

898

897

896

895

894

4-26-27

+00 F. 35

+38 T.P. 29

+00 F. 35

+54 Cuy. P. 20


+33 P.P. 27

+00 F. 35

+82 T.P. 27

+42 Farm Ent.

+18 Mail Box 14

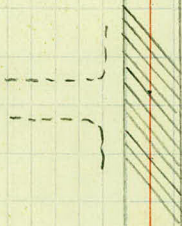

Cultivated

+00 F. 35

+45 P.P. 20

+2 P.P. 26

+0 End of F. 35

+25 T.P. 28

+00 F. 35

904

903

902

901

900

899

4-26-27

72 P.P. 25

+11 T.P. 29

+96 F. Cor. 37

+100 F. 35

+61 T.P. 28

35 T.P. 26

Cultivated.

+94 F. Cor. 36

+93 P.P. 35

+55 TOWN Hill Ent.

+55 Side Drain 20


Now 15" X 24 C.M.

+10 F. Cor. 35

+89 T.P. 27

24 P.P. 25

10 Farm Ent.  
10 Side Drain 20  
Now 15" X 24 C.M.

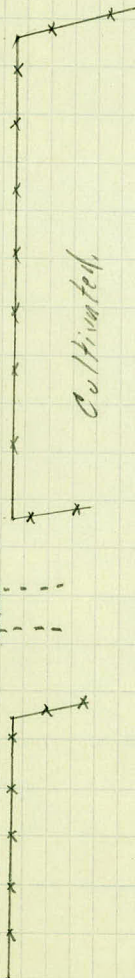

909

908

907

906

905

904

4-26-37

12 Mail Box 18

+10 Farm Ent.  
+14 Side Drains  
New 15' x 24' C.M.



+97 T.P. 28

68 P.P. 25



+53 T.P. 28

Cultivated

4 P.P. 25

+10 P.P. 37

+72 T.P. 28



+15 Farm Ent

914

913

912

911

910

909

4-26-27

+00 F. 34  
+76 Cross Drain  
24" X 60' P<sup>3</sup>  
Extends into 8 296  
Prains R.

+90 F. 35  
+77 Beg. of F. 49  
+75 Beg. of C. Rail 19  
-  
+61 T.P. 28

03 Beg. of F. 30.  
03 P.P. 27

32 P.P. 26

05 Farm Ent  
05 Side Drain 28  
EW 15" X 24' C.M.

+09 T.P. 28

98 P.P. 25

+50 T.P. 28



Cultivated.

Yard

919

918

917

916

915

914

4-26-27

92 P.P. 36  
15 End of F. 38

+91 T.P. 28

04 P.P. 33  
00 F. 36

+58 T.P. 27

+00 F. 34

*Cultivated.*

+79 T.P. 27


04 P.P. 32  
0 F. 34

+00 F. 35

+31 End of G. Rail 17  
156" = Foot length.

00 F. 33.

+31 T.P. 28

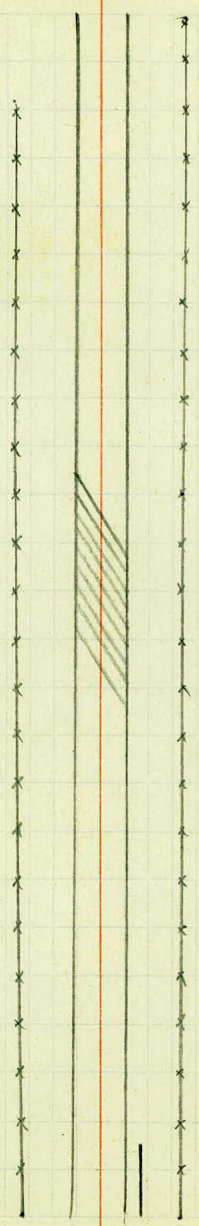

924

923

922

921

920

919

4-27-27

17 Mail Box 18  
New 15" x 10" C.M.  
12 Foot Path  
14 5/16 Drain 30'  
27 End of F. 43.

+50 T.P. 28

+08 Side Road  
+03 Side Drain 27  
New 15" x 10" C.M.

48 P.P. 40

104 T.P. 28

1 Box of F. 44.


52 P.P. 39

+39 T.P. 27

2 Farm Est.  
5 Mail Box 14

+65 Farm Est.

+25 F. Cor. 34

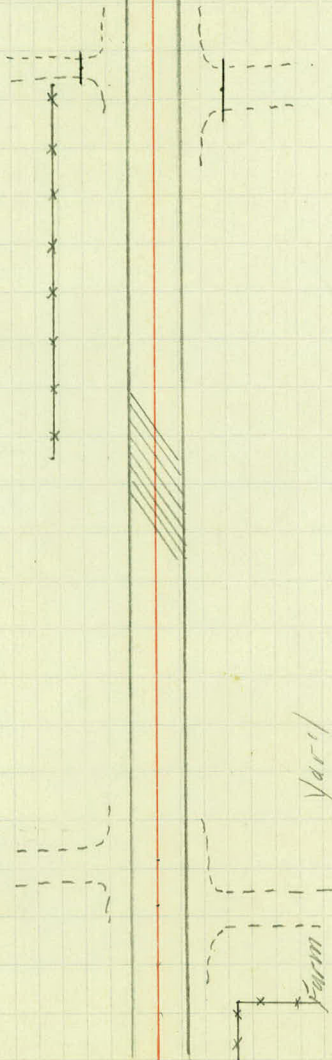

929

928

927

926

925

924

9 Trolley Pole 35.

18 T.P. 31

18 End of F. 34

25 Cross Drain

11" x 48' P<sup>3</sup>

tends 24 L. & 24 R.

against L.

7 Guy Pole 37

10 F. 35

4 P.P. 33

1 F. 38

100 yd. of F. 40.

5 Farm Ent

3.40 Drain 31

N. 15' x 24' C.M.

Mail Box 19

5 P.P. 36

Cultivated

+46 T.P. 28

+72 T.P. 28

Woods

+13 T.P. 28



934

933

932

931

930

929

55 P.P. 27

Cultivated.

+27 T.P. 30.

+28 Field Ent.  
+23 Side Drain 30  
12" x 26 pi

88 P.P. 27



+60 T.P. 28

Cultivated

+76 T.P. 28

96 P.P. 29

959

958

937

936

935

934

95 P.P. 30

+11 T.P. 29

94 P.P. 29



Cultivated

+36 T.P. 30

90 P.P. 29

+92 T.P. 31

744

743


742

741


740

739

00 Farm Ent  
00 Side Drain 30  
2" x 26' P'

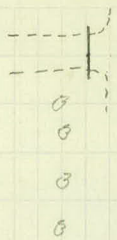

100 Field Ent  
100 Side Drain 30  
New 15" x 18' C.M.

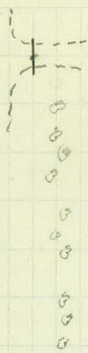

10 P.P. 32

104 T.P. 28

00 End of F. 37.



Cultivated

106 T.P. 28

04 P.P. 51

00 F. 34

147 T.P. 28

00 Beg. of F. 34

749

748

747

746

745

744

0 F. 59.

2 P.P. 34


F. 41

7 P.P. 34

0 F. 41

3 P.P. 34

2 Beg. of F. 41

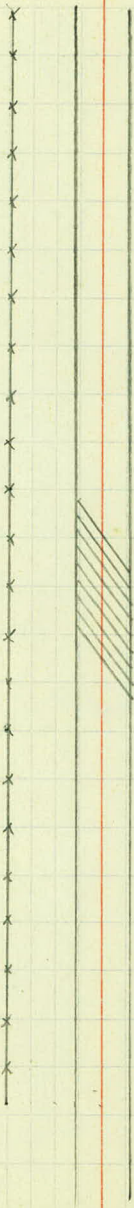

+70 T.P. 28

Cultivated

+09 A.P. 268.52

0  
0  
0  
0

+35 T.P. 24

954

953

952

951

950

949


+91 T.P. 28

+48 P.P. 33

+50 P.P. 33

+52 T.P. 28

Mail Box 19

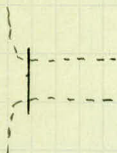

+90 Side Road  
 +90 Side Drain 28  
 01/18' x 30' C.M.



+05 T.P. 28

+2 P.P. 33

Cultivated

+7 End of F. 37



+34 T.P. 28

959

958

957

956


955

954

19 P.P. 28

23 P.P. 33

P.P. 33

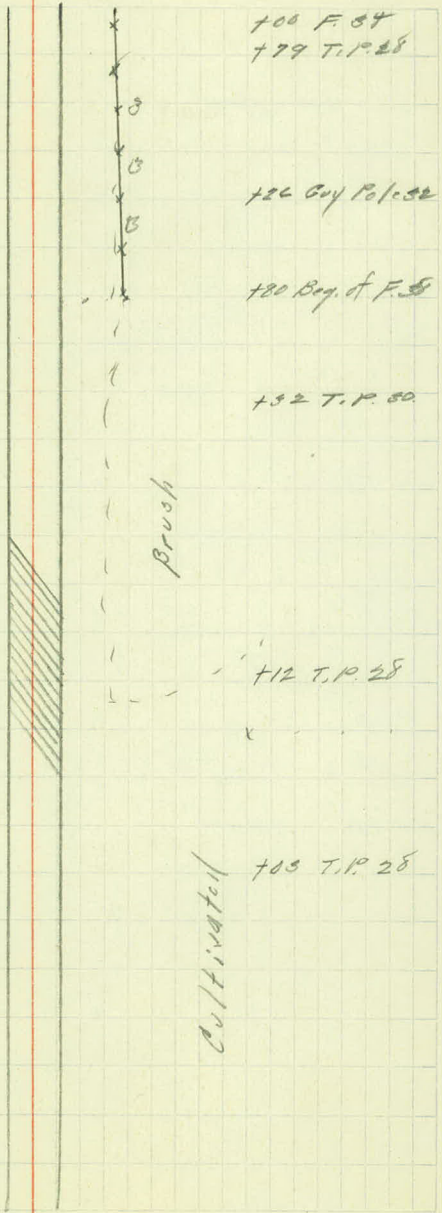

100 F. 84  
179 T.P. 28

126 Guy Pol. 32

180 Reg. of F. 5

132 T.P. 30

brush

112 T.P. 28

cultivated  
103 T.P. 28

964

963

962

961

960

959

9 P.P. 32

+00 F. 34

+01 T. P. 27

9 P.P. 35  
5 Enj. of F. 37

+00 T.P. 26  
+00 F. 34

0 F. 38



*cultivated.*

+42 T. P. 28

3 Beg. of F. 37

96 P.P. 34

969

968

967


966

965

964

7 P.P. 30

93 P.P. 29

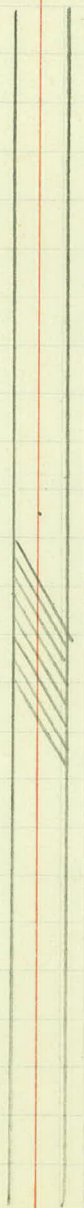

+18 T.P. 28

+04 F. Cor. 53

+00 T.P. 28

+00 F. 33

Cultivated

+12 T.P. 38

974

973

972


971

970

969

4 P.P. 28

07 Farm Int  
07 Side Drain 31  
W 15" X 24' C.M.

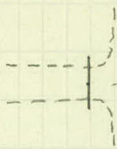

5 P.P. 28

<sup>E</sup> Beg of 4" Curve.

1 P.P. 29



Cultivated

+15 T.P. 28

+55 T.P. 29

+21 <sup>E</sup> Beg of 4" Curve.

+17 T.P. 28

979

978



977

14  $\frac{5}{11}$

976

975

974

7 P.P. 28

Surface Drain



2 P.P. 28

Bay of C. Rail 17

5 Farm Rd.  
6 Side Drain 8'  
W 15" x 24" C.M.

Mail Box 20

0 P.P. 28

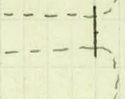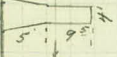

Wooded Pasture

Yard

Farm

+27 T.P. 28

+00 F. 34

+89 Surface Drain

+01 T.P. 28

+31 F. Cor. 33

+90 T.P. 28

+64 Farm Ent.  
+65 Side Drain 29'  
New 15" x 24" C.M.

984

983

982

981

980

979

50 F. 38

52 P.P. 28

58 Beg. of F. 32.

51 P.P. 28

53 P.P. 28.



Wooded Pasture

Wooded Pasture

+35 T.P. 28

+00 F. 33

+70 T.P. 28

+00 F. Cor. 33

+49 F. 1/4 E. 21

+49 5/4 Drain to

Now (5) x 24 C.M.



+41 End of F. 34

+10 F. 34

+96 T.P. 28

989

988

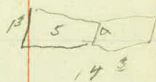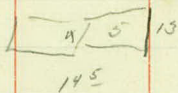


987

986



985

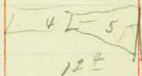

984

2 End of 4" Corlo  
10° Het. Length  
#7 Surface Drain


4 P.P. 28  
5 Side Drain 38  
W. 15' X 18' C.N.

0 Farm Rd.

9 End of C. Rail  
Het. Length.

5 Cross Drain  
1" X 56" P.  
Kaife 51 L. & 25 R.  
Culms L.  
#7 Surface Drain

0 F. 32

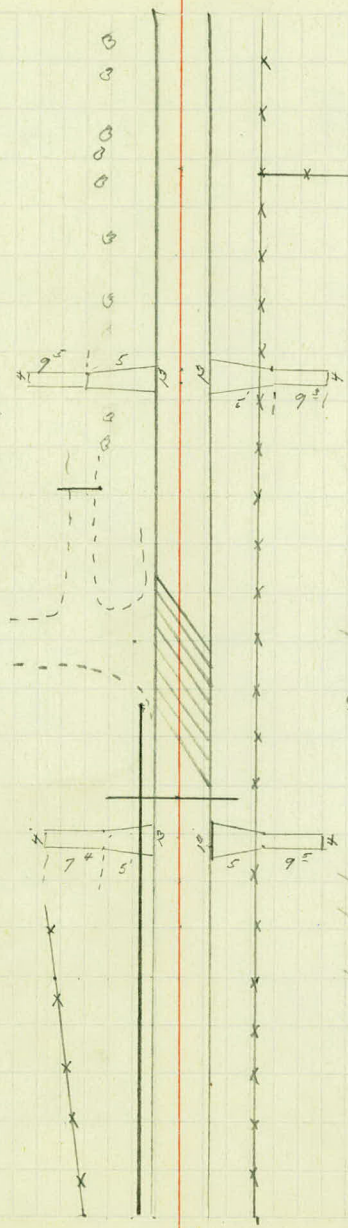

+37 C.F. 34  
+25 T.P. 28

+62 End of 4" Corlo  
1710° = Het. Length  
#47 Surface Drain

+00 F. 33

+69 T.P. 28

Pasture.

Wooded

+52 Surface Drain

+05 T.P. 28

+00 F. 33

994

993

992

991

14<sup>56</sup>  
14<sup>57</sup>

990

989



999

998

997

996

995

14<sup>o</sup> - 1.

14<sup>o</sup> - 2

994

4-27-27

+90 P.P. 28

6

8

0

3

6

9


















+95 P.P. 28

+100 P.P. 28

+74 surface Drain

Cultivated

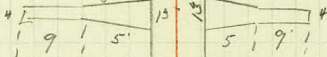

Cultivated

+91 T.P. 28

+47 5/4 Road  
+47 5/4 Drain 27  
New 15" X 24" C.M.

+29 T.P. 28

Farm Yard

+80 T.P. 28

+74 surface Drain

1004

1003

1002

1001

1000

999

4-28-27

+00 F. 39

+01 P.P. 28

+02 F. 39

Wooded Pasture

+00 End of Corp.  
98° Act. Length.

+05 F. Cor. 38

+14 P.P. 28

+56 Farm Ent.  
+56 Side Drain 30  
New 15" X 24 C.M.

+26 Farm Ent.  
+26 Side Drain 27  
New 15" X 24 C.M.

Cultivated.


+95 T.P. 28

+99 End of Corp.  
96° Act Length

+26 T.P. 28

+80 Farm Ent.  
+80 Side Drain 29  
12" X 27 P'

+93 P.P. 33  
+75 Foot Path.  
+75 Side Drain 26  
12" X 15' P'  
+57 T.P. 25  
+43 Farm Ent.  
+43 Side Drain 28  
New 15" X 24 C.M.

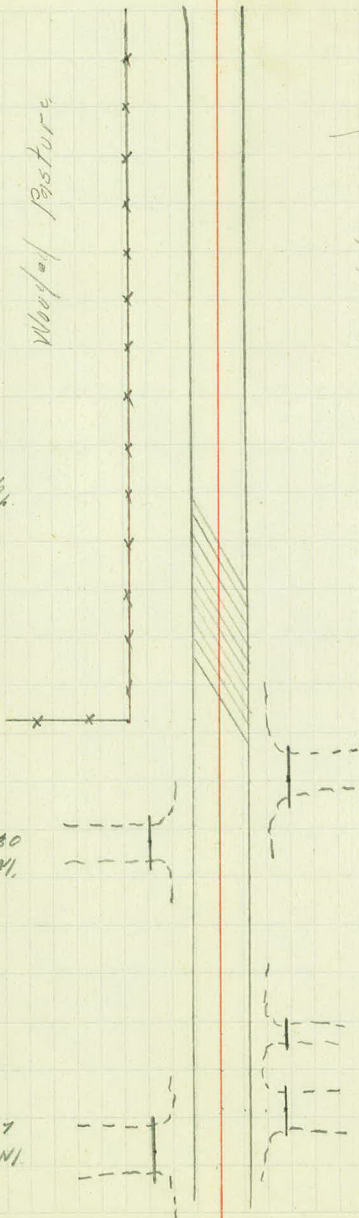

1009

1008

1007

1006

1005

1004

4-28-27

00 F. 43

44 P.P. 29

00 F. 42

00 F. 41

01 P.P. 29

00 F. 40

00 F. 40

77 P.P. 29

Wooded Pasture.



+78 T.P. 28

Woods +13 T.P. 28

,758 T.P. 28

1014

1013

1012

1011

1010

1009

92 P.P. 28

58 End of C. Nail 17  
6' = Tot. Length.

88 P.P. 28

Cultivated.

Cultivated.

+68 T.P. 28

400 Beg. of C. Nail 17

+68 Farm Rd.  
+68 Side Drain 29  
New 15" X 24" C.M.

+57 F. Cor. 40

+25 P.P. 28

+00 F. 42

Wooded Pasture

Woods

+04 Farm Rd.  
+04 Side Drain 29  
New 15" X 24" C.M.

+88 T.P. 26

+41 T.P. 27



1019

1018

1017

1016

1015

1014

93 Mail Box 17  
95 P.P. 28

22 Farm Rd.

31 P.P. 28

74 F. Cor. 98.  
65 F. Cor. 98  
65 F. Cor. 99  
90 Farm Ent.  
90 5 1/4" Drain 30  
New 15" X 20" C.M.  
40 P.P. 28  
48 Farm Ent.  
48 Side Drain 31  
2" X 13' P.  
99 F. Cor. 95.

55 Cross Drain  
4" X 48' P.  
Extends 24' L. & 24' R.  
Drains L.

18 Field Ent.

100 Farm Ent.

98 F. Cor. 93  
85 T.P. 28

92 F. Cor. 98

07 T.P. 28


47 Side Drain 27  
New 8 1/4" 15' 12" P. 69' Long  
18 Farm Ent.

09 14" T. 25

94 Gas Sta. Ent.  
78 Side Drain 28

59 T.P. 28

17 Gas Sta. Ent.  
17 Side Drain 30  
New 15" X 40" C.M.  
Old 18" X 40" C.M.

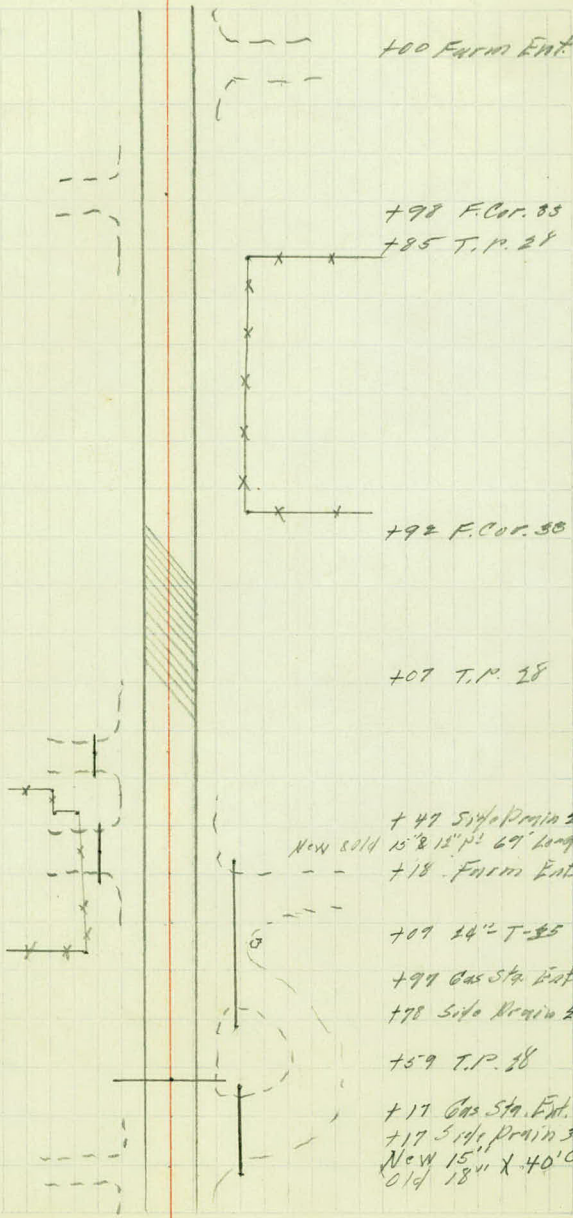

1024

1023

1022

1021

1020

1019

+40 P.P. 28

+85 T.P. 28

Cultivated

Cultivated

+19 T.P. 28

+93 P.P. 28

+20 T.P. 28

+92 Farm Ent.  
+46 Guy 18/1/50

+99 Trolley 19/1/19  
+90 Q. Tr. 24

+57 Q. Tr.  
U Irons  
1/2" x 4" x 50

+20 Q. Tr. 25

+23 T.P. 28



1029

1028

1027

1026

1025

1024

81 F. Cor. 40

89 P.P. 27

89 End of C. Rail 175  
76° Met. length.

90 F. 38


96 T.P. 27

90 F. Cor. 42

62 Cross Drain  
4" x 54" p<sup>2</sup>  
Extends 501. & 247  
Drains L.

63 Beg. of C. Rail 175

88 P.P. 27

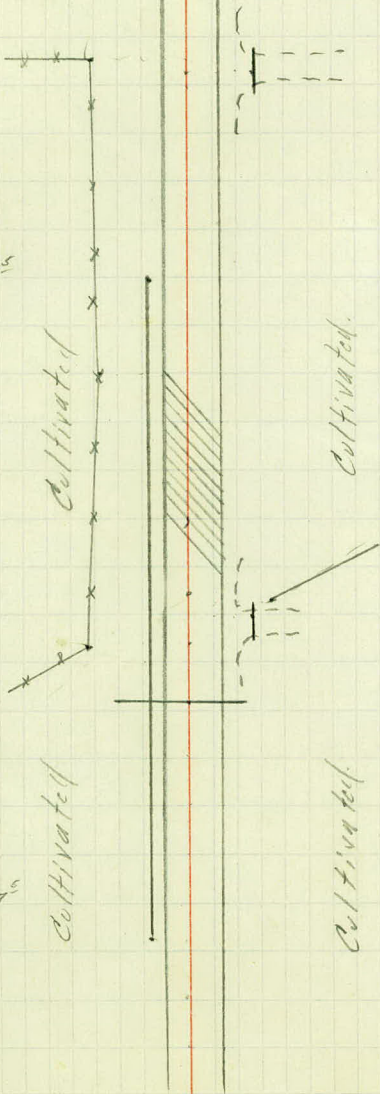

735 Farm Ent.  
725 Side Drain 27  
New 15" x 20" C.M.

+ 73 T.P. 28

Cultivated.

715 T.P. 27  
706 F. Cor. 34  
700 Field Ent.  
400 Side Drain 26  
New 15" x 16" C.M.

Cultivated.

+ 48 T.P. 28

1034

1033

1032

1031

1030

1029

+60 F. 31

+31 P.P. 26

+00 F. 31

+00 F. 30

+89 P.P. 26

+19 F. Cor. 31




+62 P.P. 27

+79 Farm Ent.

+79 Side Drain 25  
New 15" X 20" C.M.

+31 P.P. 28

+10 Mail box 17

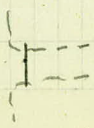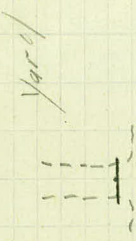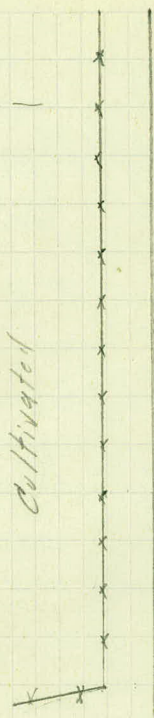

+60 C.F. 32

+53 T.P. 28

+11 C.F. 40

+91 T.P. 29

+28 T.P. 28

+09 Farm Ent.  
+09 Side Drain 27  
New 15" X 20" C.M.

Cultivated

Orchard

Yard

Yard

1039

1038

1037

1036

1035

1034

77 P.P. 27

20 F. 31

54 P.P. 27

00 F. 31

12 P.P. 27

47 F. Cor. 32

76 Kings Lane.

51 F. Cor. 31

30 Mail Box 19.

00 F. 30

90 P.P. 27.

+63 Foot Path

+63 5/40 Drain 26  
New 15" X 8" C.M.

+38 Farm Ent.

+58 Side Drain 26  
New 15" X 20" C.M.

Woodyed Pasture.

Woodyed Pasture.

+00 T. P. 28

+29 Field Ent.

+81 T. P. 28


+63 C. F. 31

+67 T. P. 24

+53 Foot Path.

+00 Farm Ent.  
+00 Side Drain 28  
New 15" X 20" C.M.

+19 T. P. 24

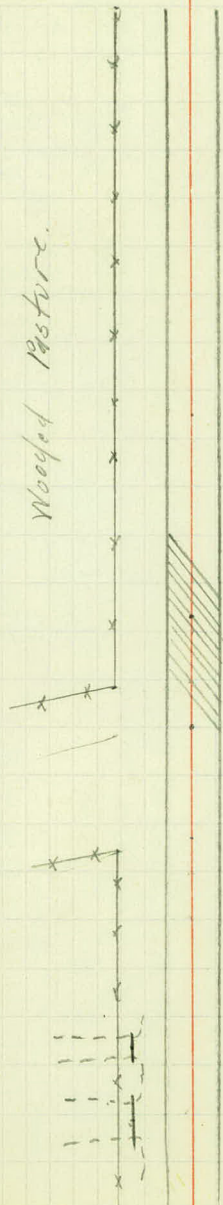

1044

1043

1042

1041

1040

1039

4-28-27

48 Farm Ent.

48 P.P. 30

85 Mail Box 19.

60 Side Road.

33 P.P. 26

24 F. Cor. 31

29 P.P. 27


00 F. 31

79 Mail Box 18

28 Sec. of F. 31

20 Farm Ent

13 F. Cor. 31

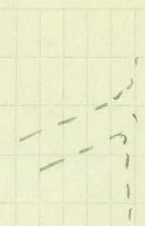

G  
G  
G  
G  
G

+65 P.P. 24

+59 T.P. 24

+00 Side Road

+30 T.P. 24

+28 T.P. 24

+13, T.P. 24,

Farm Yard.

Pasture.

1049

1048

1047

1046

1045

1044

4-29-27

00 F. 35

+00 F. 36

+94 T. P. 28

0 F. 37

+00 F. 34

3 Bay Pole 26  
2 Bay Pole 37

+63 T. P. 28

12 Bay. of C. Nail 10

+50 F. 34

38 C. F. 39

+00 F. 37

0 F. 36

06 F. Cor. 34

21 Farm Ent.  
21 Side Drain 39  
W 15" x 20  
5 P. P. 52

+96 F. Cor. 41

06 Bay Pole 26

+88 T. P. 25

2 Cross F. 33

Cultivated

X +


+03 Farm Ent.

+82 T. P. 25

03 T. P. 34

+15 Bay. of Cor. 10

Cultivated

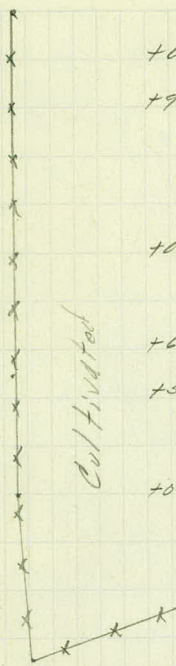

1054

1053

1052

1051

1050

1049

99 G. P. 35

50 P. P. 35

493 P. P. 35

34 Farm Ent.

70 Farm Ent.

70 Side Drain 30  
16" x 20" C.M.

+48 F. Col. 36

+46 End of C. Rail 17<sup>5</sup>  
204° = 190' length

+19 P. P. 34

Cultivated

Cultivated

+77 T. P. 25

+83 C. F. 32

+21 Foot Path

+72 Farm Ent.

+53 F. Col. 34  
+51 T. P. 27

+60 F. 34

+75 C. F. 34

+48 T. P. 28

+60 F. 35

+72 Surface Drain


+56 Bog. 4" Corp.

+20 T. P. 28

+60 F. 35  
+55 End of 4" Corp.  
509' = 190' length

+34 Cross Drain  
24" x 52" P<sup>3</sup>  
Extends 26 R. 236 L.  
Drains 4.

+24 Surface Drain

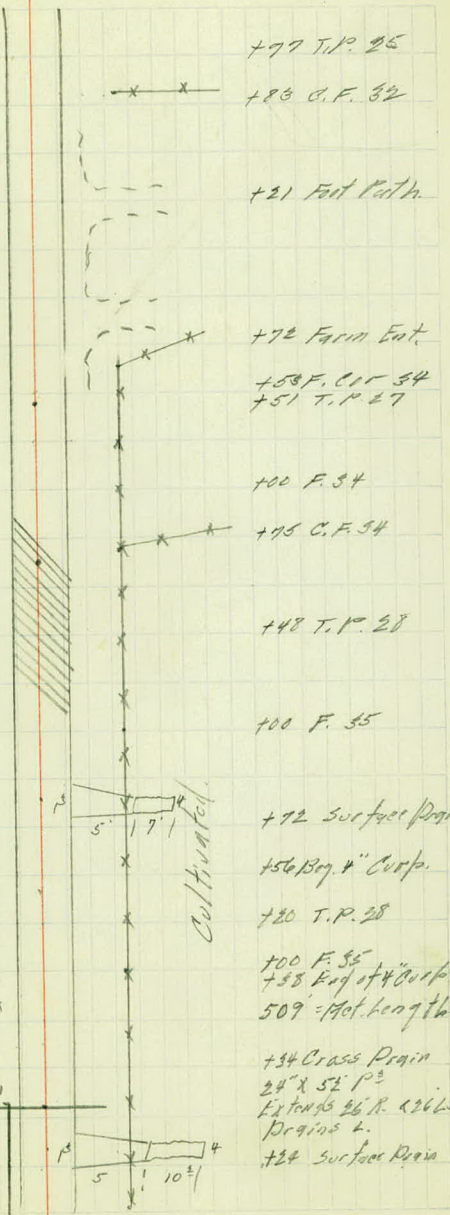

1059

1058

1057

1056

1055

1054

10 End of C. Rail 10'  
10' = Act Length.

31 C. Rail 21

38 P.P. 38

40 C. Rail 29.

40 Cross Drain  
4" X 66' P<sup>2</sup>

41 Length 71 L. & 25 K  
argins L.

47 Beg. of C. Rail 34

45 T.P. 50

52 End of C. Rail 20'  
20' = Act Length.


74 P.P. 36

88 Beg. of C. Rail 17'

90 Guy Pole 25'

92 Farm Ent.

10 P.P. 32

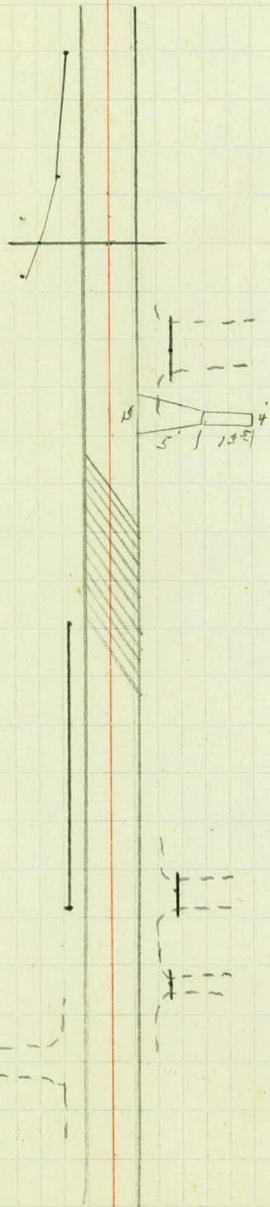

+56 Side Road  
+56 Side Drain 24  
N 20° W 18' X 30' C.M.

+36 Surface Drain

+25 T.P. 24

+32 Farm Ent.  
+32 Side Drain 28  
N 20° W 15' X 18' C.M.

+05 T.P. 29

+90 Foot Path  
+90 Side Drain 24  
12' X 8' P<sup>1</sup>

1064

1063

1062

1061

1060

1059

+00 F. 34

+00 F. 34

+00<sup>s</sup> Beg. of 2" Curp.

+72 F. Cor 34


+65 T.P. 34

+40 Side Road.

+47 P.P. 35

Chicken Ramp.

Farm Yard

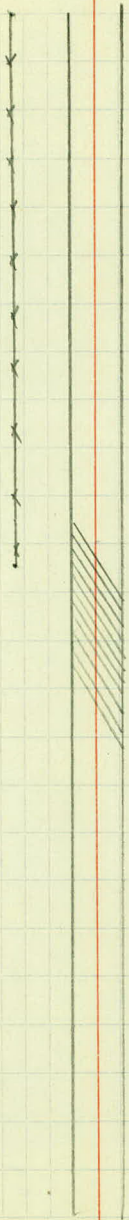

Woods

+10<sup>s</sup> Beg. of 2" Curp.

+22 Side Road.

+15<sup>s</sup> End of 4" Curp.  
1018<sup>2</sup> = Net length.

Farm Yard.

+55 Farm Ent.

1069

1068

1067

1066

1065

1064

Park

Chicken Yard

+00 F. 83

+91 F. Cor. 84  
+84 Side Road

26 End of C. Rail 17<sup>5</sup>  
28 = Act. Length

54 Beg. of 2" Curb  
98 Surface Drain  
18 Beg. of C. Rail 17<sup>5</sup>  
00 Side Road

78 End of C. Rail 17<sup>5</sup>  
82 = Act. Length  
88 F. Cor. 84  
52 Surface Drain  
44 End of 2" Curb  
44 = Act. Length  
06 Beg. of C. Rail 17<sup>5</sup>


00 F. 84

+94 End of C. Rail 17<sup>5</sup>  
81 = Act. Length  
56 Beg. of 2" Curb  
50 Surface Drain

+52 Surface Drain  
44 End of 2" Curb  
344 = Act. Length

+02 Beg. of C. Rail 17<sup>5</sup>

+16 Side Road

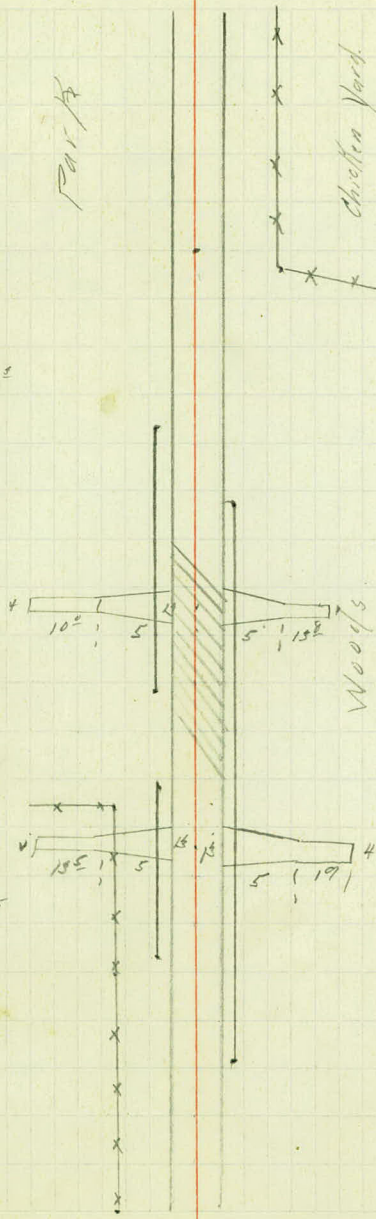

1074

1073

1072

1071

1070

1069

285 P.P. 18

263 P.P. 18

+11<sup>5</sup> Beg. 6" Corp 17

+11<sup>5</sup> 1st R. 34


+11<sup>5</sup> Pave. 27

+08 End of C. Rail 17<sup>5</sup>  
+06 = Act. Length

+58 P.P. 20

+21 End of 2" Corp  
366<sup>5</sup> = Act. Length

+12 Beg. of C. Rail 17<sup>5</sup>

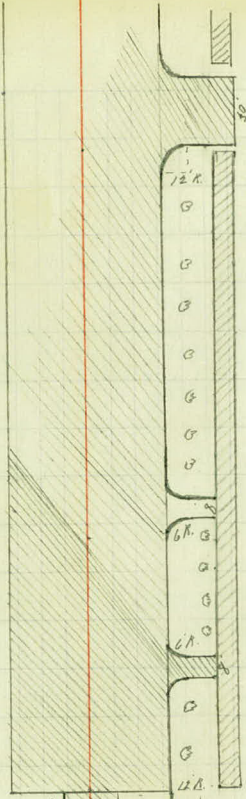

+96 End of Corp 33  
 +94 End Side Walk 27  
 +84 Corp 17

+15<sup>5</sup> Corp 17  
 +09 Beg. of Corp 27  
 +01 End of Corp 27

+95<sup>5</sup> Corp 17  
 +07 Corp 17  
 +02 Beg Corp 27

+57 End of Corp 27  
 +48 Corp 17

+09 Beg 6" Side Walk 27

+09 Corp 17

+94 Beg 6" Corp 30

+77 Side St.

+46 F. Cor. 36

+22 End of 2" Corp  
 366<sup>5</sup> = Act. Length



1079

1078

1077

1076

1075

1074


76 Corp 17  
70 Bay of Corp 22<sup>s</sup>  
60 End of Corp 22<sup>s</sup>  
54 Corp 17

67 P.P. 30  
71 Corp 17  
65 Bay of Corps 33  
42 Manhole Q  
44 End of Corp 33  
38 Corp 17

+73 10' P  
+55 Corp 17  
+40 Bay of Corp 26<sup>s</sup>  
+13 End of Corp 26<sup>s</sup>  
+01 Corp 17

+43 Catch Basin 16"  
43 Cross Drain 30"  
10" Vit.

+13 P.P. 18  
12 Manhole Q

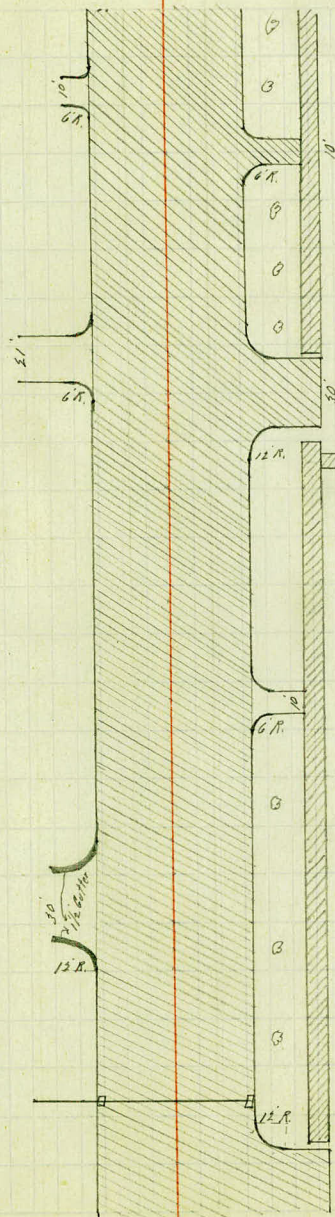

+49 Corp 17  
+44 Bay of Corp 27  
+34 End of Corp 27  
+27 Corp 17

+68 Corp 17  
+57 Bay Side Walk 37  
+56 Bay of Corp 33

+36 End of Corp 33  
+20 End Side Walk 27  
+18<sup>1/2</sup> Corp 17  
+12<sup>1/2</sup> Side Walk 6' W.H.

+22 Corp 17  
+16 Bay of Corp 27

+07 End of Corp 27  
+00 Corp 17

+43 Catch Basin 16"  
+38 Corp 17

+28 Bay Side Walk 27  
36 Bay of Corp 33

1084

1083

1082

1081

1080

1079

4-29-27

9 Corp 30

72 P.P. 23  
 77 & 6 Walk  
 79 Corp 17  
 77 Catch Basin 16<sup>2</sup>  
 17 P.P. 22

94 Corp 17  
 88 Beg. Corp 27  
 98 End of Corp 27  
 92 Corp 17


16 Beg. & Walk 27  
 13 P.P. 22  
 15<sup>5</sup> Corp 17  
 19<sup>5</sup> Beg. of Corp 27

93 End of Corp 27  
 87 Corp 17

186 P.P. 21  
 190 Manhole ft.  
 23 I. Sign Post 21

45 Corp 17  
 503 Bog of Corp 30

466 Manhole ft.  
 467 End Corp 33  
 457 Corp 17  
 463 P.P. 19  
 456 & 6 Walk 19

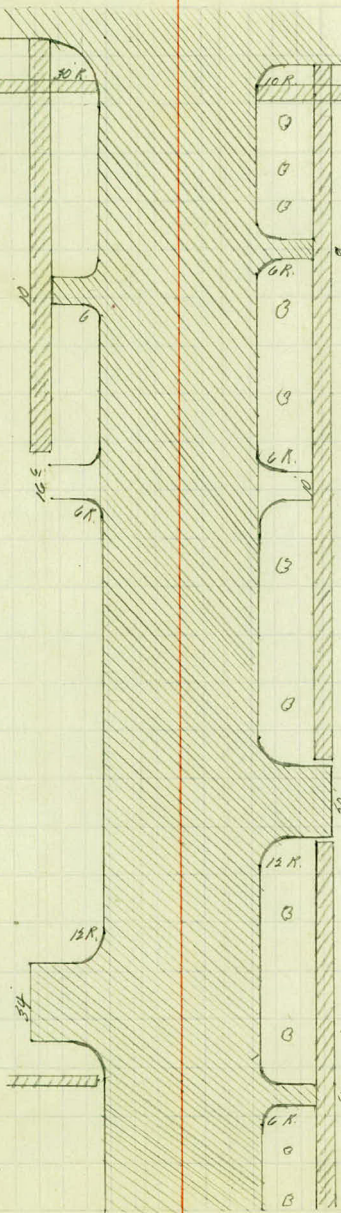

+95<sup>5</sup> Corp 27  
 +85<sup>5</sup> Corp 17  
 +84<sup>5</sup> & 6 Walk

+71 Hyd 22  
 +11 Corp 17  
 +05 Beg. of Corp 27  
 +96 End of Corp 27  
 +90 Corp 17


+11 Corp 17  
 +05 Beg. of Corp 27  
 +95 End of Corp 27  
 +87 Corp 17

+97 Corp 17  
 +87 Beg. & Walk 27  
 +85 Bog. of Corp 30

+55 End of Corp 30  
 +43 Corp 17  
 +53 End & Walk 27

+57 Corp 17  
 +51<sup>5</sup> Beg. of Corp 27

+43<sup>5</sup> End Corp 27  
 +37<sup>5</sup> Corp 17

 

# KEITH'S RAILROAD CURVE TABLES.

Published by KEUFFEL & ESSER CO., New York.

Entered according to Act of Congress in the year 1883,  
 by W. Keuffel & H. Esser, in the office of the Librarian of Congress,  
 in Washington, D.C.

Copyright, 1902, by Keuffel & Esser Co.

## HOW TO USE KEITH'S TABLES.

### EXAMPLE.

Wanted a Curve with an Ext. of about 12 ft. Angle  
 of Intersection or I. P.= $23^{\circ} 20'$  to the R. at Station  
 $542+72$ .

Ext. in Tab. IV opposite  $23^{\circ} 20' = 120.87$   
 $120.87 \div 12 = 10.07$ . Say a  $10^{\circ}$  Curve.

Tan. in Tab. IV opp.  $23^{\circ} 20' = 1183.1$   
 $1183.1 \div 10 = 118.31$ .

Tab. V. correction for A.  $23^{\circ} 20'$  for a  $10^{\circ}$  Cur. =  $0.16$   
 $118.31 + 0.16 = 118.47 =$ corrected Tangent.

(If corrected Ext. is required find in same way)  
 Ang.  $23^{\circ} 20' = 23.33^{\circ} \div 10 = 2.3333 =$ L. C.

$2^{\circ} 19\frac{1}{2}' =$ def. for sta.	542	I. P. = sta.	542+72
$4^{\circ} 49\frac{1}{2}' =$ " " "	+50	Tan. =	118.47
$7^{\circ} 19\frac{1}{2}' =$ " " "	543	B. C. = sta.	541+53.53
$9^{\circ} 49\frac{1}{2}' =$ " " "	+50	L. C. =	2.33.33
$11^{\circ} 40' =$ " " "	543+	E. C. = sta.	543+86.86
	86.86		

$100 - 53.53 = 46.47 \times 3' (\text{def. for 1 ft. of } 10^{\circ} \text{ Cur.}) = 139.41' =$   
 $2^{\circ} 19\frac{1}{2}' =$ def. for sta. 542.

Def. for 50 ft. =  $2^{\circ} 30'$  for a  $10^{\circ}$  Curve.

Def. for 36.86 ft. =  $1^{\circ} 50\frac{1}{2}'$  for a  $10^{\circ}$  Curve

(These tables are published in Field Books of  
 KEUFFEL & ESSER Co., New York, N. Y.)

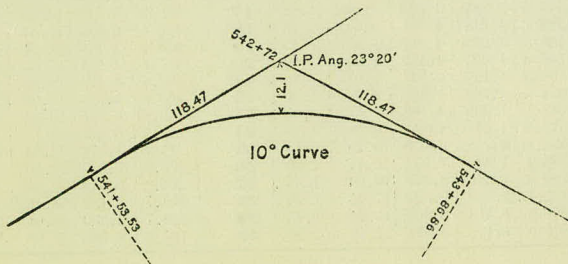


TABLE I. — Minutes in Decimals of a Degree.

<b>1'</b>	.0167	<b>11'</b>	.1833	<b>21'</b>	.3500	<b>31'</b>	.5167	<b>41'</b>	.6833	<b>51'</b>	.8500
<b>2</b>	.0333	<b>12</b>	.2000	<b>22</b>	.3667	<b>32</b>	.5333	<b>42</b>	.7000	<b>52</b>	.8667
<b>3</b>	.0500	<b>13</b>	.2167	<b>23</b>	.3833	<b>33</b>	.5500	<b>43</b>	.7167	<b>53</b>	.8833
<b>4</b>	.0667	<b>14</b>	.2333	<b>24</b>	.4000	<b>34</b>	.5667	<b>44</b>	.7333	<b>54</b>	.9000
<b>5</b>	.0833	<b>15</b>	.2500	<b>25</b>	.4167	<b>35</b>	.5833	<b>45</b>	.7500	<b>55</b>	.9167
<b>6</b>	.1000	<b>16</b>	.2667	<b>26</b>	.4333	<b>36</b>	.6000	<b>46</b>	.7667	<b>56</b>	.9333
<b>7</b>	.1167	<b>17</b>	.2833	<b>27</b>	.4500	<b>37</b>	.6167	<b>47</b>	.7833	<b>57</b>	.9500
<b>8</b>	.1333	<b>18</b>	.3000	<b>28</b>	.4667	<b>38</b>	.6333	<b>48</b>	.8000	<b>58</b>	.9667
<b>9</b>	.1500	<b>19</b>	.3167	<b>29</b>	.4833	<b>39</b>	.6500	<b>49</b>	.8167	<b>59</b>	.9833
<b>10</b>	.1667	<b>20</b>	.3333	<b>30</b>	.5000	<b>40</b>	.6667	<b>50</b>	.8333	<b>60</b>	1.0000

TABLE II. — Inches in Decimals of a Foot.

1-16	3-32	<sup>2</sup> / <sub>8</sub>	3-16	<sup>1</sup> / <sub>4</sub>	5-16	<sup>3</sup> / <sub>8</sub>	<sup>1</sup> / <sub>2</sub>	<sup>5</sup> / <sub>8</sub>	<sup>3</sup> / <sub>4</sub>	<sup>7</sup> / <sub>8</sub>
.0052	.0078	.0104	.0156	.0208	.0260	.0313	.0417	.0521	.0625	.0729
<b>1</b>	<b>2</b>	<b>3</b>	<b>4</b>	<b>5</b>	<b>6</b>	<b>7</b>	<b>8</b>	<b>9</b>	<b>10</b>	<b>11</b>
.0833	.1667	.2500	.3333	.4167	.5000	.5833	.6667	.7500	.8333	.9167

TABLE III. — Radii, Ordinates and Deflections.

Deg.	Radius	Mid. Ord.	Tan. Def.	Chd. Def.	Def. for 1 Foot	Deg.	Radius	Mid. Ord.	Tan. Def.	Chd. Def.	Def. for 1 Foot
<b>0° 10'</b>	34377.	.036	.145	.291	0.05'	<b>7°</b>	819.0	1.528	6.105	12.21	2.10'
<b>20</b>	17189.	.073	.291	.582	0.10	<b>20'</b>	781.8	1.600	6.395	12.79	2.20
<b>30</b>	11459.	.109	.436	.873	0.15	<b>30</b>	764.5	1.637	6.540	13.08	2.25
<b>40</b>	8594.4	.145	.582	1.164	0.20	<b>40</b>	747.9	1.673	6.685	13.37	2.30
<b>50</b>	6875.5	.182	.727	1.454	0.25	<b>8</b>	716.8	1.746	6.976	13.95	2.40
<b>1</b>	5729.6	.218	.873	1.745	0.30	<b>20</b>	688.2	1.819	7.266	14.53	2.50
<b>10</b>	4911.2	.255	1.018	2.036	0.35	<b>30</b>	674.7	1.855	7.411	14.82	2.55
<b>20</b>	4297.3	.291	1.164	2.327	0.40	<b>40</b>	661.7	1.892	7.556	15.11	2.60
<b>30</b>	3819.8	.327	1.309	2.618	0.45	<b>9</b>	637.3	1.965	7.846	15.69	2.70
<b>40</b>	3437.9	.364	1.454	2.909	0.50	<b>20</b>	614.6	2.037	8.136	16.27	2.80
<b>50</b>	3125.4	.400	1.600	3.200	0.55	<b>30</b>	603.8	2.074	8.281	16.56	2.85
<b>2</b>	2864.9	.436	1.745	3.490	0.60	<b>40</b>	593.4	2.110	8.426	16.85	2.90
<b>10</b>	2644.6	.473	1.891	3.781	0.65	<b>10</b>	573.7	2.183	8.716	17.43	3.00
<b>20</b>	2455.7	.509	2.036	4.072	0.70	<b>30</b>	546.4	2.292	9.150	18.30	3.15
<b>30</b>	2292.0	.545	2.181	4.363	0.75	<b>11</b>	521.7	2.402	9.585	19.16	3.30
<b>40</b>	2148.8	.582	2.327	4.654	0.80	<b>30</b>	499.1	2.511	10.02	20.04	3.45
<b>50</b>	2022.4	.618	2.472	4.945	0.85	<b>12</b>	478.3	2.620	10.45	20.91	3.60
<b>3</b>	1910.1	.655	2.618	5.235	0.90	<b>30</b>	459.3	2.730	10.89	21.77	3.75
<b>10</b>	1809.6	.691	2.763	5.526	0.95	<b>13</b>	441.7	2.839	11.32	22.64	3.90
<b>20</b>	1719.1	.727	2.908	5.817	1.00	<b>30</b>	425.4	2.949	11.75	23.51	4.05
<b>30</b>	1637.3	.764	3.054	6.108	1.05	<b>14</b>	410.3	3.058	12.18	24.37	4.20
<b>40</b>	1562.9	.800	3.199	6.398	1.10	<b>30</b>	396.2	3.168	12.62	25.24	4.35
<b>50</b>	1495.0	.836	3.345	6.689	1.15	<b>15</b>	383.1	3.277	13.05	26.11	4.50
<b>4</b>	1432.7	.873	3.490	6.980	1.20	<b>30</b>	370.8	3.387	13.49	26.97	4.65
<b>10</b>	1375.4	.909	3.635	7.271	1.25	<b>16</b>	359.3	3.496	13.92	27.84	4.80
<b>20</b>	1322.5	.945	3.718	7.561	1.30	<b>30</b>	348.5	3.606	14.35	28.70	4.95
<b>30</b>	1273.6	.982	3.926	7.852	1.35	<b>17</b>	338.3	3.716	14.78	29.56	5.10
<b>40</b>	1228.1	1.018	4.071	8.143	1.40	<b>18</b>	319.6	3.935	15.64	31.29	5.40
<b>50</b>	1185.8	1.055	4.217	8.433	1.45	<b>19</b>	302.9	4.155	16.51	33.01	5.70
<b>5</b>	1146.3	1.091	4.362	8.724	1.50	<b>20</b>	287.9	4.374	17.37	34.73	6.00
<b>10</b>	1109.3	1.127	4.507	9.014	1.55	<b>21</b>	274.4	4.594	18.22	36.44	6.30
<b>20</b>	1074.7	1.164	4.653	9.305	1.60	<b>22</b>	262.0	4.814	19.08	38.16	6.60
<b>30</b>	1042.1	1.200	4.798	9.596	1.65	<b>23</b>	250.8	5.035	19.94	39.87	6.90
<b>40</b>	1011.5	1.237	4.943	9.886	1.70	<b>24</b>	240.5	5.255	20.79	41.58	7.20
<b>50</b>	982.6	1.273	5.088	10.18	1.75	<b>25</b>	231.0	5.476	21.64	43.28	7.50
<b>6</b>	955.4	1.309	5.234	10.47	1.80	<b>26</b>	222.3	5.697	22.50	44.99	7.80
<b>10</b>	929.6	1.346	5.379	10.76	1.85	<b>27</b>	214.2	5.918	23.35	46.69	8.10
<b>20</b>	905.1	1.382	5.524	11.05	1.90	<b>28</b>	206.7	6.139	24.19	48.38	8.40
<b>30</b>	881.9	1.418	5.669	11.34	1.95	<b>29</b>	199.7	6.360	25.04	50.07	8.70
<b>40</b>	859.9	1.455	5.814	11.63	2.00	<b>30</b>	193.2	6.583	25.88	51.76	9.00

TABLE IV. — Tangents and Externals to a 1° Curve.

Angle	Tangent	External	Angle	Tangent	External	Angle	Tangent	External
<b>1°</b>	50.00	.22	<b>11°</b>	551.70	26.50	<b>21°</b>	1061.9	97.57
10'	58.34	.30	10'	560.11	27.31	10'	1070.6	99.16
20	66.67	.39	20	568.53	28.14	20	1079.2	100.75
30	75.01	.49	30	576.95	28.97	30	1087.8	102.35
40	83.34	.61	40	585.36	29.82	40	1096.4	103.97
50	91.68	.73	50	593.79	30.68	50	1105.1	105.60
<b>2</b>	100.01	.87	<b>12</b>	602.21	31.56	<b>22</b>	1113.7	107.24
10	108.35	1.02	10	610.64	32.45	10	1122.4	108.90
20	116.68	1.19	20	619.07	33.35	20	1131.0	110.57
30	125.02	1.36	30	627.50	34.26	30	1139.7	112.25
40	133.36	1.55	40	635.93	35.18	40	1148.4	113.95
50	141.70	1.75	50	644.37	36.12	50	1157.0	115.66
<b>3</b>	150.04	1.96	<b>13</b>	652.81	37.07	<b>23</b>	1165.7	117.38
10	158.38	2.19	10	661.25	38.03	10	1174.4	119.12
20	166.72	2.43	20	669.70	39.01	20	1183.1	120.87
30	175.06	2.67	30	678.15	39.99	30	1191.8	122.63
40	183.40	2.93	40	686.60	40.99	40	1200.5	124.41
50	191.74	3.21	50	695.06	42.00	50	1209.2	126.20
<b>4</b>	200.08	3.49	<b>14</b>	703.51	43.03	<b>24</b>	1217.9	128.00
10	208.43	3.79	10	711.97	44.07	10	1226.6	129.82
20	216.77	4.10	20	720.44	45.12	20	1235.3	131.65
30	225.12	4.42	30	728.90	46.18	30	1244.0	133.50
40	233.47	4.76	40	737.37	47.25	40	1252.8	135.35
50	241.81	5.10	50	745.85	48.34	50	1261.5	137.23
<b>5</b>	250.16	5.46	<b>15</b>	754.32	49.44	<b>25</b>	1270.2	139.11
10	258.51	5.83	10	762.80	50.55	10	1279.0	141.01
20	266.86	6.21	20	771.29	51.68	20	1287.7	142.93
30	275.21	6.61	30	779.77	52.89	30	1296.5	144.85
40	283.57	7.01	40	788.26	53.97	40	1305.3	146.79
50	291.92	7.43	50	796.75	55.13	50	1314.0	148.75
<b>6</b>	300.28	7.86	<b>16</b>	805.25	56.31	<b>26</b>	1322.8	150.71
10	308.64	8.31	10	813.75	57.50	10	1331.6	152.69
20	316.99	8.76	20	822.25	58.70	20	1340.4	154.69
30	325.35	9.23	30	830.76	59.91	30	1349.2	156.70
40	333.71	9.71	40	839.27	61.14	40	1358.0	158.72
50	342.08	10.20	50	847.78	62.38	50	1366.8	160.76
<b>7</b>	350.44	10.71	<b>17</b>	856.30	63.63	<b>27</b>	1375.6	162.81
10	358.81	11.22	10	864.82	64.90	10	1384.4	164.86
20	367.17	11.75	20	873.35	66.18	20	1393.2	166.95
30	375.54	12.29	30	881.88	67.47	30	1402.0	169.04
40	383.91	12.85	40	890.41	68.77	40	1410.9	171.15
50	392.28	13.41	50	898.95	70.09	50	1419.7	173.27
<b>8</b>	400.66	13.99	<b>18</b>	907.49	71.42	<b>28</b>	1428.6	175.41
10	409.03	14.58	10	916.03	72.76	10	1437.4	177.55
20	417.41	15.18	20	924.58	74.12	20	1446.3	179.72
30	425.79	15.80	30	933.13	75.49	30	1455.1	181.89
40	434.17	16.43	40	941.69	76.86	40	1464.0	184.08
50	442.55	17.07	50	950.25	78.26	50	1472.9	186.29
<b>9</b>	450.93	17.72	<b>19</b>	958.81	79.67	<b>29</b>	1481.8	188.51
10	459.32	18.38	10	967.38	81.09	10	1490.7	190.74
20	467.71	19.06	20	975.96	82.53	20	1499.6	192.99
30	476.10	19.75	30	984.53	83.97	30	1508.5	195.25
40	484.49	20.45	40	993.12	85.43	40	1517.4	197.53
50	492.88	21.16	50	1001.7	86.90	50	1526.3	199.82
<b>10</b>	501.28	21.89	<b>20</b>	1010.3	88.39	<b>30</b>	1535.3	202.12
10	509.68	22.62	10	1018.9	89.89	10	1544.2	204.44
20	518.08	23.38	20	1027.5	91.40	20	1553.1	206.77
30	526.48	24.14	30	1036.1	92.92	30	1562.1	209.12
40	534.89	24.91	40	1044.7	94.46	40	1571.0	211.48
50	543.29	25.70	50	1053.3	96.01	50	1580.0	213.86

TABLE IV. — Tangents and Externals to a 1° Curve.

Angle	Tangent	External	Angle	Tangent	External	Angle	Tangent	External
<b>31°</b>	1589.0	216.3	<b>41°</b>	2142.2	387.4	<b>51°</b>	2732.9	618.4
10'	1598.0	218.7	10'	2151.7	390.7	10'	2743.1	622.8
20	1606.9	221.1	20	2161.2	394.1	20	2753.4	627.2
30	1615.9	223.5	30	2170.8	397.4	30	2763.7	631.7
40	1624.9	226.0	40	2180.3	400.8	40	2773.9	636.2
50	1633.9	228.4	50	2189.9	404.2	50	2784.2	640.7
<b>32</b>	1643.0	230.9	<b>42</b>	2199.4	407.6	<b>52</b>	2794.5	645.2
10	1652.0	233.4	10	2209.0	411.1	10	2804.9	649.7
20	1661.0	235.9	20	2218.6	414.5	20	2815.2	654.3
30	1670.0	238.4	30	2228.1	418.0	30	2825.6	658.8
40	1679.1	241.0	40	2237.7	421.4	40	2835.9	663.4
50	1688.1	243.5	50	2247.3	425.0	50	2846.3	668.0
<b>33</b>	1697.2	246.1	<b>43</b>	2257.0	428.5	<b>53</b>	2856.7	672.7
10	1706.3	248.7	10	2266.6	432.0	10	2867.1	677.3
20	1715.3	251.3	20	2276.2	435.6	20	2877.5	682.0
30	1724.4	253.9	30	2285.9	439.2	30	2888.0	686.7
40	1733.5	256.5	40	2295.6	442.8	40	2898.4	691.4
50	1742.6	259.1	50	2305.2	446.4	50	2908.9	696.1
<b>34</b>	1751.7	261.8	<b>44</b>	2314.9	450.0	<b>54</b>	2919.4	700.9
10	1760.8	264.5	10	2324.6	453.6	10	2929.9	705.7
20	1770.0	267.2	20	2334.3	457.3	20	2940.4	710.5
30	1779.1	269.9	30	2344.1	461.0	30	2951.0	715.3
40	1788.2	272.6	40	2353.8	464.6	40	2961.5	720.1
50	1797.4	275.3	50	2363.5	468.4	50	2972.1	725.0
<b>35</b>	1806.6	278.1	<b>45</b>	2373.3	472.1	<b>55</b>	2982.7	729.9
10	1815.7	280.8	10	2383.1	475.8	10	2993.3	734.8
20	1824.9	283.6	20	2392.8	479.6	20	3003.9	739.7
30	1834.1	286.4	30	2402.6	483.8	30	3014.5	744.6
40	1843.3	289.2	40	2412.4	487.2	40	3025.2	749.6
50	1852.5	292.0	50	2422.3	491.0	50	3035.8	754.6
<b>36</b>	1861.7	294.9	<b>46</b>	2432.1	494.8	<b>56</b>	3046.5	759.6
10	1870.9	297.7	10	2441.9	498.7	10	3057.2	764.6
20	1880.1	300.6	20	2451.8	502.5	20	3067.9	769.7
30	1889.4	303.5	30	2461.7	506.4	30	3078.7	774.7
40	1898.6	306.4	40	2471.5	510.3	40	3089.4	779.8
50	1907.9	309.3	50	2481.4	514.3	50	3100.2	784.9
<b>37</b>	1917.1	312.2	<b>47</b>	2491.3	518.2	<b>57</b>	3110.9	790.1
10	1926.4	315.2	10	2501.2	522.2	10	3121.7	795.2
20	1935.7	318.1	20	2511.2	526.1	20	3132.6	800.4
30	1945.0	321.1	30	2521.1	530.1	30	3143.4	805.6
40	1954.3	324.1	40	2531.1	534.2	40	3154.2	810.9
50	1963.6	327.1	50	2541.0	538.2	50	3165.1	816.1
<b>38</b>	1972.9	330.2	<b>48</b>	2551.0	542.2	<b>58</b>	3176.0	821.4
10	1982.2	333.2	10	2561.0	546.3	10	3186.9	826.7
20	1991.5	336.3	20	2571.0	550.4	20	3197.8	832.0
30	2000.9	339.3	30	2581.0	554.5	30	3208.8	837.3
40	2010.2	342.4	40	2591.0	558.6	40	3219.7	842.7
50	2019.6	345.5	50	2601.1	562.8	50	3230.7	848.1
<b>39</b>	2029.0	348.6	<b>49</b>	2611.2	566.9	<b>59</b>	3241.7	853.5
10	2038.4	351.8	10	2621.2	571.1	10	3252.7	858.9
20	2047.8	354.9	20	2631.3	575.3	20	3263.7	864.3
30	2057.2	358.1	30	2641.4	579.5	30	3274.8	869.8
40	2066.6	361.3	40	2651.5	583.8	40	3285.8	875.3
50	2076.0	364.5	50	2661.6	588.0	50	3296.9	880.8
<b>40</b>	2085.4	367.7	<b>50</b>	2671.8	592.3	<b>60</b>	3308.0	886.4
10	2094.9	371.0	10	2681.9	596.6	10	3319.1	892.0
20	2104.3	374.2	20	2692.1	600.9	20	3330.3	897.5
30	2113.8	377.5	30	2702.3	605.3	30	3341.4	903.2
40	2123.3	380.8	40	2712.5	609.6	40	3352.6	908.8
50	2132.7	384.1	50	2722.7	614.0	50	3363.8	914.5

TABLE IV. — Tangents and Externals to a 1° Curve.

Angle	Tangent	External	Angle	Tangent	External	Angle	Tangent	External
<b>61°</b>	3375.0	920.2	<b>71°</b>	4086.9	1308.2	<b>81°</b>	4893.6	1805.3
10'	3386.3	925.9	10'	4099.5	1315.6	10'	4908.0	1814.7
20	3397.5	931.6	20	4112.1	1322.9	20	4922.5	1824.1
30	3408.8	937.3	30	4124.8	1330.3	30	4937.0	1833.6
40	3420.1	943.1	40	4137.4	1337.7	40	4951.5	1843.1
50	3431.4	948.9	50	4150.1	1345.1	50	4966.1	1852.6
<b>62</b>	3442.7	954.8	<b>72</b>	4162.8	1352.6	<b>82</b>	4980.7	1862.2
10	3454.1	960.6	10	4175.6	1360.1	10	4995.4	1871.8
20	3465.4	966.5	20	4188.5	1367.6	20	5010.0	1881.5
30	3476.8	972.4	30	4201.2	1375.2	30	5024.8	1891.2
40	3488.3	978.3	40	4214.0	1382.8	40	5039.5	1900.9
50	3499.7	984.3	50	4226.8	1390.4	50	5054.3	1910.7
<b>63</b>	3511.1	990.2	<b>73</b>	4239.7	1398.0	<b>83</b>	5069.2	1920.5
10	3522.6	996.2	10	4252.6	1405.7	10	5084.0	1930.4
20	3534.1	1002.3	20	4265.6	1413.5	20	5099.0	1940.3
30	3545.6	1008.3	30	4278.5	1421.2	30	5113.9	1950.3
40	3557.2	1014.4	40	4291.5	1429.0	40	5128.9	1960.2
50	3568.7	1020.5	50	4304.6	1436.8	50	5143.9	1970.3
<b>64</b>	3580.3	1026.6	<b>74</b>	4317.6	1444.6	<b>84</b>	5159.0	1980.4
10	3591.9	1032.8	10	4330.7	1452.5	10	5174.1	1990.5
20	3603.5	1039.0	20	4343.8	1460.4	20	5189.3	2000.6
30	3615.1	1045.2	30	4356.9	1468.4	30	5204.4	2010.8
40	3626.8	1051.4	40	4370.1	1476.4	40	5219.7	2021.1
50	3638.5	1057.7	50	4383.3	1484.4	50	5234.9	2031.4
<b>65</b>	3650.2	1063.9	<b>75</b>	4396.5	1492.4	<b>85</b>	5250.3	2041.7
10	3661.9	1070.2	10	4409.8	1500.5	10	5265.6	2052.1
20	3673.7	1076.6	20	4423.1	1508.6	20	5281.0	2062.5
30	3685.4	1082.9	30	4436.4	1516.7	30	5296.4	2073.0
40	3697.2	1089.3	40	4449.7	1524.9	40	5311.9	2083.5
50	3709.0	1095.7	50	4463.1	1533.1	50	5327.4	2094.1
<b>66</b>	3720.9	1102.2	<b>76</b>	4476.5	1541.4	<b>86</b>	5343.0	2104.7
10	3732.7	1108.6	10	4489.9	1549.7	10	5358.6	2115.3
20	3744.6	1115.1	20	4503.4	1558.0	20	5374.2	2126.0
30	3756.5	1121.7	30	4516.9	1566.3	30	5389.9	2136.7
40	3768.5	1128.2	40	4530.4	1574.7	40	5405.6	2147.5
50	3780.4	1134.8	50	4544.0	1583.1	50	5421.4	2158.4
<b>67</b>	3792.4	1141.4	<b>77</b>	4557.6	1591.6	<b>87</b>	5437.2	2169.2
10	3804.4	1148.0	10	4571.2	1600.1	10	5453.1	2180.2
20	3816.4	1154.7	20	4584.8	1608.6	20	5469.0	2191.1
30	3828.4	1161.3	30	4598.5	1617.1	30	5484.9	2202.2
40	3840.5	1168.1	40	4612.2	1625.7	40	5500.9	2213.2
50	3852.6	1174.8	50	4626.0	1634.4	50	5517.0	2224.3
<b>68</b>	3864.7	1181.6	<b>78</b>	4639.8	1643.0	<b>88</b>	5533.1	2235.5
10	3876.8	1188.4	10	4653.6	1651.7	10	5549.2	2246.7
20	3889.0	1195.2	20	4667.4	1660.5	20	5565.4	2258.0
30	3901.2	1202.0	30	4681.3	1669.2	30	5581.6	2269.3
40	3913.4	1208.9	40	4695.2	1678.1	40	5597.8	2280.6
50	3925.6	1215.8	50	4709.2	1686.9	50	5614.2	2292.0
<b>69</b>	3937.9	1222.7	<b>79</b>	4723.2	1695.8	<b>89</b>	5630.5	2303.5
10	3950.2	1229.7	10	4737.2	1704.7	10	5646.9	2315.0
20	3962.5	1236.7	20	4751.2	1713.7	20	5663.4	2326.6
30	3974.8	1243.7	30	4765.3	1722.7	30	5679.9	2338.2
40	3987.2	1250.8	40	4779.4	1731.7	40	5696.4	2349.8
50	3999.5	1257.9	50	4793.6	1740.8	50	5713.0	2361.5
<b>70</b>	4011.9	1265.0	<b>80</b>	4807.7	1749.9	<b>90</b>	5729.7	2373.3
10	4024.4	1272.1	10	4822.0	1759.0	10	5746.3	2385.1
20	4036.8	1279.3	20	4836.2	1768.2	20	5763.1	2397.0
30	4049.3	1286.5	30	4850.5	1777.4	30	5779.9	2408.9
40	4061.8	1293.6	40	4864.8	1786.7	40	5796.7	2420.9
50	4074.4	1300.9	50	4879.2	1796.0	50	5813.6	2432.9

TABLE IV. — Tangents and Externals to a 1° Curve.

Angle	Tangent	External	Angle	Tangent	External	Angle	Tangent	External
<b>91°</b>	5830.5	2444.9	<b>101°</b>	6950.6	3278.1	<b>111°</b>	8336.7	4386.1
10'	5847.5	2457.1	10'	6971.3	3294.1	10'	8362.7	4407.6
20	5864.6	2469.3	20	6992.0	3310.1	20	8388.9	4429.2
30	5881.7	2481.5	30	7012.7	3326.1	30	8415.1	4450.9
40	5898.8	2493.8	40	7033.6	3342.3	40	8441.5	4472.7
50	5916.0	2506.1	50	7054.5	3358.5	50	8468.0	4494.6
<b>92</b>	5933.2	2518.5	<b>102</b>	7075.5	3374.9	<b>112</b>	8494.6	4516.6
10	5950.5	2531.0	10	7096.6	3391.2	10	8521.3	4538.8
20	5967.9	2543.5	20	7117.8	3407.7	20	8548.1	4561.1
30	5985.3	2556.0	30	7139.0	3424.3	30	8575.0	4583.4
40	6002.7	2568.6	40	7160.3	3440.9	40	8602.1	4606.0
50	6020.2	2581.3	50	7181.7	3457.6	50	8629.3	4628.6
<b>93</b>	6037.8	2594.0	<b>103</b>	7203.2	3474.4	<b>113</b>	8656.6	4651.3
10	6055.4	2606.8	10	7224.7	3491.3	10	8684.0	4674.2
20	6073.1	2619.7	20	7246.3	3508.2	20	8711.5	4697.2
30	6090.8	2632.6	30	7268.0*	3525.2	30	8739.2	4720.3
40	6108.6	2645.5	40	7289.8	3542.4	40	8767.0	4743.6
50	6126.4	2658.5	50	7311.7	3559.6	50	8794.9	4766.9
<b>94</b>	6144.3	2671.6	<b>104</b>	7333.6	3576.8	<b>114</b>	8822.9	4790.4
10	6162.6	2684.7	10	7355.6	3594.2	10	8851.0	4814.1
20	6180.2	2697.9	20	7377.8	3611.7	20	8879.3	4837.8
30	6198.3	2711.2	30	7399.9	3629.2	30	8907.7	4861.7
40	6216.4	2724.5	40	7422.2	3646.8	40	8936.3	4885.7
50	6234.6	2737.9	50	7444.6	3664.5	50	8965.0	4909.9
<b>95</b>	6252.8	2751.3	<b>105</b>	7467.0	3682.3	<b>115</b>	8993.8	4934.1
10	6271.1	2764.8	10	7489.6	3700.2	10	9022.7	4958.6
20	6289.4	2778.3	20	7512.2	3718.2	20	9051.7	4983.1
30	6307.9	2792.0	30	7534.9	3736.2	30	9080.9	5007.8
40	6326.3	2805.6	40	7557.7	3754.4	40	9110.3	5032.6
50	6344.8	2819.4	50	7580.5	3772.6	50	9139.8	5057.6
<b>96</b>	6363.4	2833.2	<b>106</b>	7603.5	3791.0	<b>116</b>	9169.4	5082.7
10	6382.1	2847.0	10	7626.6	3809.4	10	9199.1	5107.9
20	6400.8	2861.0	20	7649.7	3827.9	20	9229.0	5133.3
30	6419.5	2875.0	30	7672.9	3846.5	30	9259.0	5158.8
40	6438.4	2889.0	40	7696.3	3865.2	40	9289.2	5184.5
50	6457.3	2903.1	50	7719.7	3884.0	50	9319.5	5210.3
<b>97</b>	6476.2	2917.3	<b>107</b>	7743.2	3902.9	<b>117</b>	9349.9	5236.2
10	6495.2	2931.6	10	7766.8	3921.9	10	9380.5	5262.3
20	6514.3	2945.9	20	7790.5	3940.9	20	9411.3	5288.6
30	6533.4	2960.3	30	7814.3	3960.1	30	9442.2	5315.0
40	6552.6	2974.7	40	7838.1	3979.4	40	9473.2	5341.5
50	6571.9	2989.2	50	7862.1	3998.7	50	9504.4	5368.2
<b>98</b>	6591.2	3003.8	<b>108</b>	7886.2	4018.2	<b>118</b>	9535.7	5395.1
10	6610.6	3018.4	10	7910.4	4037.8	10	9567.2	5422.1
20	6630.1	3033.1	20	7934.6	4057.4	20	9598.9	5449.2
30	6649.6	3047.9	30	7959.0	4077.2	30	9630.7	5476.5
40	6669.2	3062.8	40	7983.5	4097.1	40	9662.6	5504.0
50	6688.8	3077.7	50	8008.0	4117.0	50	9694.7	5531.7
<b>99</b>	6708.6	3092.7	<b>109</b>	8032.7	4137.1	<b>119</b>	9727.0	5559.4
10	6728.4	3107.7	10	8057.4	4157.3	10	9759.4	5587.4
20	6748.2	3122.9	20	8082.3	4177.5	20	9792.0	5615.5
30	6768.1	3138.1	30	8107.3	4197.9	30	9824.8	5643.8
40	6788.1	3153.3	40	8132.3	4218.4	40	9857.7	5672.3
50	6808.2	3168.7	50	8157.5	4239.0	50	9890.8	5700.9
<b>100</b>	6828.3	3184.1	<b>110</b>	8182.8	4259.7	<b>120</b>	9924.0	5729.7
10	6848.5	3199.6	10	8208.2	4280.5	10	9957.5	5758.6
20	6868.8	3215.1	20	8233.7	4301.4	20	9991.0	5787.7
30	6889.2	3230.8	30	8259.3	4322.4	30	10025.0	5817.0
40	6909.6	3246.5	40	8285.0	4343.6	40	10059.0	5846.5
50	6930.1	3262.3	50	8310.8	4364.8	50	10093.0	5876.1

Table V. Corrections for use with table IV,

COPYRIGHT, 1902, BY KEUFFEL &amp; ESSER CO.

For Tangents Add															
ANGLE	CURVE	5°	10°	15°	20°	25°	30°	35°	40°	45°	50°	55°	60°	65°	70°
10°	.03	.06	.09	.13	.16	.19	.22	.25	.28	.31	.34	.38	.42	.46	
15°	.04	.10	.14	.19	.24	.29	.34	.39	.45	.51	.53	.58	.63	.68	
20°	.06	.13	.19	.26	.32	.39	.45	.51	.58	.65	.72	.79	.84	.90	
25°	.08	.16	.24	.33	.40	.49	.58	.67	.75	.83	.90	.99	1.06	1.14	
30°	.10	.19	.29	.39	.49	.59	.69	.79	.89	.99	1.09	1.20	1.29	1.39	
35°	.11	.22	.34	.47	.58	.69	.70	.81	.92	1.04	1.29	1.42	1.54	1.66	
40°	.13	.26	.40	.53	.67	.80	.93	1.06	1.20	1.34	1.49	1.64	1.79	1.94	
45°	.15	.30	.44	.60	.76	.91	1.06	1.21	1.37	1.52	1.70	1.87	2.04	2.21	
50°	.17	.34	.51	.68	.85	1.02	1.19	1.36	1.54	1.72	1.91	2.10	2.29	2.48	
55°	.19	.38	.57	.76	.95	1.14	1.32	1.52	1.72	1.92	2.14	2.35	2.56	2.77	
60°	.21	.42	.63	.84	1.05	1.27	1.49	1.71	1.94	2.17	2.38	2.60	2.83	3.07	
65°	.23	.46	.69	.93	1.16	1.40	1.64	1.88	2.13	2.38	2.63	2.88	3.13	3.39	
70°	.25	.51	.76	1.02	1.28	1.54	1.80	2.06	2.33	2.60	2.88	3.16	3.44	3.72	
75°	.27	.56	.83	1.12	1.40	1.69	1.98	2.27	2.57	2.87	3.16	3.47	3.78	4.09	
80°	.30	.61	.91	1.22	1.53	1.84	2.15	2.46	2.78	3.10	3.44	3.78	4.12	4.46	
85°	.33	.66	1.00	1.33	1.68	2.02	2.36	2.70	3.05	3.40	3.77	4.14	4.55	4.89	
90°	.36	.72	1.09	1.45	1.83	2.20	2.57	2.94	3.32	3.70	4.10	4.50	4.91	5.32	
95°	.39	.79	1.19	1.55	2.00	2.40	2.80	3.20	3.61	4.02	4.49	4.98	5.38	5.83	
100°	.43	.86	1.30	1.74	2.18	2.62	3.06	3.50	3.95	4.40	4.88	5.37	5.85	6.34	

## For Externals Add

ANGLE	CURVE	5°	10°	15°	20°	25°	30°	35°	40°	45°	50°	55°	60°	65°	70°
10°	.001	.003	.004	.006	.007	.008	.009	.011	.012	.014	.015	.017	.018	.020	
15°	.003	.007	.010	.014	.018	.023	.027	.029	.032	.035	.039	.043	.047	.051	
20°	.006	.011	.017	.022	.028	.034	.038	.045	.051	.057	.063	.070	.076	.083	
25°	.009	.018	.027	.036	.046	.056	.065	.074	.083	.093	.106	.120	.127	.135	
30°	.013	.025	.038	.051	.065	.078	.090	.103	.116	.129	.149	.170	.179	.188	
35°	.018	.035	.054	.072	.086	.109	.131	.153	.175	.197	.213	.230	.247	.264	
40°	.023	.046	.070	.093	.117	.141	.172	.203	.234	.265	.277	.290	.315	.341	
45°	.030	.060	.093	.119	.153	.184	.216	.254	.289	.325	.351	.378	.411	.445	
50°	.037	.075	.116	.151	.189	.227	.266	.305	.345	.384	.425	.467	.508	.550	
55°	.046	.093	.142	.188	.236	.283	.332	.381	.420	.479	.530	.582	.641	.700	
60°	.056	.112	.168	.225	.283	.340	.398	.457	.516	.575	.636	.697	.774	.851	
65°	.067	.135	.204	.273	.343	.412	.483	.554	.625	.697	.771	.845	.922	1.01	
70°	.080	.159	.240	.321	.403	.485	.568	.652	.735	.819	.906	.994	1.08	1.17	
75°	.095	.182	.286	.383	.480	.578	.678	.777	.877	.977	1.07	1.18	1.29	1.39	
80°	.110	.220	.332	.445	.558	.671	.787	.903	1.02	1.13	1.25	1.38	1.50	1.62	
85°	.128	.259	.391	.524	.657	.790	.926	1.06	1.20	1.34	1.47	1.62	1.76	1.91	
90°	.149	.299	.450	.603	.756	.910	1.07	1.22	1.38	1.54	1.70	1.87	2.03	2.20	
95°	.174	.350	.522	.706	.985	1.06	1.25	1.43	1.62	1.80	1.99	2.18	2.38	2.58	
100°	.200	.401	.604	.809	1.01	1.22	1.43	1.64	1.85	2.06	2.28	2.50	2.73	2.96	

Table VI. Deflections for Sub Chords for Short Radius Curves.

Degree of Curve	Radius 50 sin. def. ang.	$\frac{1}{2}$ sub chord R = sin of def. angle				Length of arc for 100 ft.
		12.5 Ft.	15 Ft.	20 Ft.	25 Ft.	
30°	193.18	1° 51'	2° 17'	2° 58'	3° 43'	101.15
32°	181.39	1° 59'	2° 25'	3° 10'	3° 58'	101.33
34°	171.01	2° 06'	2° 33'	3° 21'	4° 12'	101.48
36°	161.80	2° 13'	2° 41'	3° 33'	4° 26'	101.66
38°	153.58	2° 20'	2° 49'	3° 44'	4° 40'	101.85
40°	146.19	2° 27'	2° 57'	3° 55'	4° 54'	102.06
42°	139.52	2° 34'	3° 05'	4° 07'	5° 08'	102.29
44°	133.47	2° 41'	3° 13'	4° 18'	5° 22'	102.53
46°	127.97	2° 48'	3° 21'	4° 29'	5° 36'	102.76
48°	122.92	2° 55'	3° 29'	4° 40'	5° 50'	103.00
50°	118.31	3° 02'	3° 38'	4° 51'	6° 04'	103.24
52°	114.06	3° 09'	3° 46'	5° 02'	6° 17'	103.54
54°	110.11	3° 16'	3° 54'	5° 13'	6° 31'	103.84
56°	106.50	3° 22'	4° 02'	5° 23'	6° 44'	104.14
58°	103.14	3° 29'	4° 10'	5° 34'	6° 57'	104.43
60°	100.00	3° 35'	4° 18'	5° 44'	7° 11'	104.72

## CURVE FORMULAS.

$$T = R \tan \frac{1}{2} I$$

$$T = 50 \tan. \frac{1}{2} I$$

$$\frac{\text{Sin. } D}{R}$$

$$\text{Sin. } D = 50$$

$$\text{Sin. } D = \frac{50 \tan. \frac{1}{2} I}{T}$$

$$R = T \cot. \frac{1}{2} I$$

$$R = 50$$

$$\frac{\text{Sin. } D}{\text{Sin. } D}$$

$$E = R \text{ ex. sec. } \frac{1}{2} I$$

$$E = T \tan \frac{1}{4} I$$

$$\text{Chord def.} = \frac{\text{chord}^2}{R}$$

$$\text{No. chords} = \frac{\frac{1}{2} I}{D}$$

$$\text{Tan. def.} = \frac{1}{2} \text{ chord def.}$$

The square of any distance, divided by twice the radius, will equal the distance from tangent to curve, very nearly.

Table IV. contains Tangents and Externals to a 1° curve. Tan. and Ext. to any other radius may be found nearly enough, by dividing the Tan. or Ext. opposite the given Central Angle by the given degree of curve.

To find Deg. of Curve, having the Central Angle and Tangent: Divide Tan. opposite the given Central Angle by the given Tangent.

To find Deg. of Curve, having the Central Angle and Tangent: Divide Ext. opposite the given Central Angle by the given External.

To find Nat. Tan. and Nat. Ex. Sec. for any angle by Table IV.: Tan. or Ext. of twice the given angle divided by the radius of a 1° curve will be the Nat. Tan. or Nat. Ex. Sec.

To find angle for a given distance and deflection.

Rule 1. Multiply the given distance by .01745 (def. for 1° for 1 ft.), and divide given deflection by the product.

Rule 2. Multiply given deflection by 57.3, and divide the product by the given distance.

To find deflection for a given angle and distance: Multiply the angle by .01745, and the product by the distance.

RIGHT ANGLE TRIANGLES. - Square the altitude, divide by twice the base. Add quotient to base for hypotenuse.

Given Base 100, Alt 10  $10^2 \div 200 = .5$ .  $100 + .5 = 100.5$  hyp.

Given Hyp. 100, Alt. 25.  $25^2 \div 200 = 3.125$ .  $100 - 3.125 = 96.875 =$  Base.

Error in first example, .002; in last, .045.

To find Tons of Rail in one mile of track: multiply weight per yard by 11, and divide by 7.

## Natural Sines

DEG.	0'	10'	20'	30'	40'	50'	DEG.	DEG.	0'	10'	20'	30'	40'	50'	DEG.
0	0000	0029	0058	0087	0116	0145	89	40	6428	6450	6472	6494	6517	6539	49
1	0175	0204	0233	0262	0291	0320	88	41	6561	6583	6604	6626	6648	6670	48
2	0349	0378	0407	0436	0465	0494	87	42	6691	6713	6734	6756	6777	6799	47
3	0523	0552	0581	0610	0640	0669	86	43	6820	6841	6862	6884	6905	6926	46
4	0698	0727	0756	0785	0814	0843	85	44	6947	6967	6988	7009	7030	7050	45
5	0872	0901	0929	0958	0987	1016	84	45	7071	7092	7112	7133	7153	7173	44
6	1045	1074	1103	1132	1161	1190	83	46	7193	7214	7234	7254	7274	7294	43
7	1219	1248	1279	1305	1334	1363	82	47	7314	7335	7355	7375	7395	7415	42
8	1392	1421	1449	1478	1507	1536	81	48	7431	7451	7470	7490	7509	7528	41
9	1564	1593	1622	1650	1679	1708	80	49	7547	7566	7585	7604	7623	7642	40
10	1736	1765	1794	1822	1851	1880	79	50	7660	7679	7698	7716	7735	7753	39
11	1908	1937	1965	1994	2022	2051	78	51	7771	7790	7808	7826	7844	7862	38
12	2079	2108	2136	2164	2193	2221	77	52	7880	7898	7916	7934	7951	7969	37
13	2250	2278	2306	2334	2363	2391	76	53	7986	8004	8021	8039	8056	8073	36
14	2419	2447	2476	2504	2532	2560	75	54	8090	8107	8124	8141	8158	8175	35
15	2588	2616	2644	2672	2700	2728	74	55	8192	8208	8225	8241	8258	8274	34
16	2756	2784	2812	2840	2868	2896	73	56	8290	8307	8323	8339	8355	8371	33
17	2924	2952	2939	3007	3035	3062	72	57	8387	8403	8418	8434	8450	8465	32
18	3090	3118	3145	3173	3201	3228	71	58	8480	8496	8511	8526	8542	8557	31
19	3256	3283	3311	3338	3365	3393	70	59	8572	8587	8601	8616	8631	8646	30
20	3420	3448	3475	3502	3529	3557	69	60	8660	8675	8689	8704	8718	8732	29
21	3584	3611	3638	3665	3692	3719	68	61	8746	8760	8774	8788	8802	8816	28
22	3746	3773	3800	3827	3854	3881	67	62	8829	8843	8857	8870	8884	8897	27
23	3907	3934	3961	3987	4014	4041	66	63	8910	8923	8936	8949	8962	8975	26
24	4067	4094	4120	4147	4173	4200	65	64	8988	9001	9013	9026	9038	9051	25
25	4226	4253	4279	4305	4331	4358	64	65	9063	9075	9088	9100	9112	9124	24
26	4384	4410	4436	4462	4488	4514	63	66	9135	9147	9159	9171	9182	9194	23
27	4540	4566	4592	4617	4643	4669	62	67	9205	9216	9228	9239	9250	9261	22
28	4695	4720	4746	4772	4797	4823	61	68	9272	9283	9293	9304	9315	9325	21
29	4848	4874	4899	4924	4950	4975	60	69	9336	9346	9356	9367	9377	9387	20
30	5000	5025	5050	5075	5100	5125	59	70	9397	9407	9417	9426	9436	9446	19
31	5150	5175	5200	5225	5250	5275	58	71	9455	9465	9474	9483	9492	9502	18
32	5299	5324	5348	5373	5398	5422	57	72	9511	9520	9528	9537	9546	9555	17
33	5446	5471	5495	5519	5544	5568	56	73	9563	9572	9580	9588	9596	9605	16
34	5592	5616	5640	5664	5688	5712	55	74	9613	9621	9628	9636	9644	9652	15
35	5736	5760	5783	5807	5831	5854	54	75	9659	9667	9674	9681	9689	9696	14
36	5878	5901	5925	5948	5972	5995	53	76	9703	9710	9717	9724	9730	9737	13
37	6018	6041	6065	6088	6111	6134	52	77	9744	9750	9757	9763	9769	9775	12
38	6157	6180	6202	6225	6248	6271	51	78	9781	9787	9793	9799	9805	9811	11
39	6293	6316	6338	6361	6383	6406	50	79	9816	9822	9827	9833	9838	9843	10

DEG.	0'	10'	20'	30'	40'	50'	DEG.
80	9848	9853	9858	9863	9868	9872	9
81	9877	9881	9886	9890	9894	9899	8
82	9903	9907	9911	9914	9918	9922	7
83	9925	9929	9932	9936	9939	9942	6
84	9945	9948	9951	9954	9957	9959	5
85	9962	9964	9967	9969	9971	9974	4
86	9976	9978	9980	9981	9983	9985	3
87	9986	9988	9989	9990	9992	9993	2
88	9994	9995	9996	9997	9997	9998	1
89	9998	9999	9999	9999	I.0000	I.0000	0

DEG.	60'	50'	40'	30'	20'	10'	DEG.
------	-----	-----	-----	-----	-----	-----	------

## Natural Cosines

Natural Tangents

deg.	0'	10'	20'	30'	40'	50'	deg.	0'	10'	20'	30'	40'	50'	deg.	
0	0000	0029	0058	0087	0116	0145	89	40	8391	8441	8491	8541	8591	8642	49
1	0175	0204	0233	0262	0291	0320	88	41	8693	8744	8796	8847	8899	8952	48
2	0349	0378	0407	0437	0466	0495	87	42	9004	9057	9110	9163	9217	9271	47
3	0524	0553	0582	0612	0641	0670	86	43	9325	9380	9435	9490	9545	9601	46
4	0699	0729	0758	0787	0816	0846	85	44	9657	9713	9770	9827	9884	9942	45
5	0875	0904	0934	0963	0992	1022	84	45	1.0000	1.0058	1.0117	1.0176	1.0235	1.0295	44
6	1051	1080	1110	1139	1169	1198	83	46	1.0355	1.0416	1.0477	1.0533	1.0599	1.0661	43
7	1228	1257	1287	1317	1346	1376	82	47	1.0724	1.0786	1.0850	1.0913	1.0977	1.1041	42
8	1405	1435	1465	1495	1524	1554	81	48	1.1106	1.1171	1.1237	1.1303	1.1369	1.1436	41
9	1584	1614	1644	1673	1703	1733	80	49	1.1504	1.1571	1.1640	1.1708	1.1778	1.1847	40
10	1763	1793	1823	1853	1883	1914	79	50	1.1918	1.1988	1.2059	1.2131	1.2203	1.2276	39
11	1944	1974	2004	2035	2065	2095	78	51	1.2349	1.2423	1.2497	1.2572	1.2647	1.2723	38
12	2126	2156	2186	2217	2247	2278	77	52	1.2799	1.2876	1.2954	1.3032	1.3111	1.3190	37
13	2309	2339	2370	2401	2432	2462	76	53	1.3270	1.3351	1.3435	1.3514	1.3597	1.3680	36
14	2493	2524	2555	2586	2617	2648	75	54	1.3764	1.3848	1.3934	1.4019	1.4106	1.4193	35
15	2679	2711	2742	2773	2805	2836	74	55	1.4281	1.4370	1.4460	1.4550	1.4641	1.4733	34
16	2867	2899	2931	2962	2994	3026	73	56	1.4826	1.4919	1.5013	1.5108	1.5204	1.5301	33
17	3057	3089	3121	3153	3185	3217	72	57	1.5399	1.5497	1.5597	1.5697	1.5798	1.5900	32
18	3249	3281	3314	3346	3378	3411	71	58	1.6003	1.6107	1.6212	1.6319	1.6426	1.6534	31
19	3443	3476	3508	3541	3574	3607	70	59	1.6643	1.6753	1.6864	1.6977	1.7090	1.7205	30
20	3640	3673	3706	3739	3772	3805	69	60	1.7321	1.7437	1.7556	1.7675	1.7797	1.7917	29
21	3839	3872	3906	3939	3973	4006	68	61	1.8040	1.8165	1.8291	1.8418	1.8546	1.8676	28
22	4040	4074	4108	4142	4176	4210	67	62	1.8807	1.8940	1.9074	1.9210	1.9347	1.9486	27
23	4245	4279	4314	4348	4383	4417	66	63	1.9626	1.9768	1.9912	2.0057	2.0204	2.0353	26
24	4452	4487	4522	4557	4592	4628	65	64	2.0503	2.0655	2.0809	2.0965	2.1123	2.1283	25
25	4663	4699	4734	4770	4806	4841	64	65	2.1445	2.1609	2.1775	2.1943	2.2113	2.2286	24
26	4877	4913	4950	4986	5022	5059	63	66	2.2450	2.2637	2.2817	2.2998	2.3183	2.3369	23
27	5095	5132	5169	5206	5243	5280	62	67	2.3559	2.3750	2.3945	2.4142	2.4342	2.4545	22
28	5317	5354	5392	5430	5467	5505	61	68	2.4751	2.4960	2.5172	2.5386	2.5605	2.5826	21
29	5543	5581	5619	5658	5697	5735	60	69	2.6051	2.6279	2.6511	2.6746	2.6985	2.7228	20
30	5774	5812	5851	5890	5930	5969	59	70	2.7475	2.7725	2.7980	2.8239	2.8502	2.8770	19
31	6009	6048	6088	6128	6168	6208	58	71	2.9042	2.9319	2.9600	2.9887	3.0178	3.0475	18
32	6249	6289	6330	6371	6412	6453	57	72	3.0777	3.1084	3.1397	3.1716	3.2041	3.2371	17
33	6494	6536	6577	6619	6661	6703	56	73	3.2709	3.3052	3.3402	3.3759	3.4124	3.4495	16
34	6745	6787	6830	6873	6916	6959	55	74	3.4874	3.5261	3.5656	3.6059	3.6470	3.6891	15
35	7002	7046	7089	7133	7177	7221	54	75	3.7321	3.7760	3.8208	3.8657	3.9136	3.9617	14
36	7256	7310	7355	7400	7445	7490	53	76	4.0108	4.0611	4.1126	4.1653	4.2193	4.2747	13
37	7536	7581	7627	7673	7720	7766	52	77	4.3315	4.3897	4.4494	4.5107	4.5736	4.6382	12
38	7813	7860	7907	7954	8002	8050	51	78	4.7046	4.7729	4.8430	4.9152	4.9894	5.0658	11
39	8098	8146	8195	8243	8292	8342	50	79	5.1446	5.2257	5.3093	5.3955	5.4845	5.5764	10

deg.	0'	10'	20'	30'	40'	50'	deg.
80	5.6713	5.7694	5.8708	5.9758	6.0844	6.1970	9
81	6.3138	6.4348	6.5606	6.6912	6.8269	6.9682	8
82	7.1154	7.2687	7.4287	7.5958	7.7704	7.9530	7
83	8.1443	8.3450	8.5555	8.7769	9.0098	9.2553	6
84	9.5144	9.7882	10.078	10.385	10.711	11.059	5
85	11.430	11.826	12.250	12.706	13.197	13.727	4
86	14.300	14.924	15.605	16.350	17.169	18.075	3
87	19.081	20.206	21.470	22.903	24.542	26.432	2
88	28.636	31.242	34.368	38.189	42.964	49.104	1
89	57.290	68.750	85.940	114.588	171.885	343.77	0

Natural Cotangents

DISTANCES FROM CENTER OF ROADWAY FOR CROSS-SECTIONING.

ROADWAY 14 FEET WIDE. SIDE SLOPES 1 1/2 TO 1.

FOR SINGLE TRACK EMBANKMENT.

	0	.1	.2	.3	.4	.5	.6	.7	.8	.9	
0	7.0	7.2	7.3	7.5	7.6	7.8	7.9	8.1	8.2	8.4	0
1	8.5	8.7	8.8	9.0	9.1	9.3	9.4	9.6	9.7	9.9	1
2	10.0	10.2	10.3	10.5	10.6	10.8	10.9	11.1	11.2	11.4	2
3	11.5	11.7	11.8	12.0	12.1	12.3	12.4	12.6	12.7	12.9	3
4	13.0	13.2	13.3	13.5	13.6	13.8	13.9	14.1	14.2	14.4	4
5	14.5	14.7	14.8	15.0	15.1	15.3	15.4	15.6	15.7	15.9	5
6	16.0	16.2	16.3	16.5	16.6	16.8	16.9	17.1	17.2	17.4	6
7	17.5	17.7	17.8	18.0	18.1	18.3	18.4	18.6	18.7	18.9	7
8	19.0	19.2	19.3	19.5	19.6	19.8	19.9	20.1	20.2	20.4	8
9	20.5	20.7	20.8	21.0	21.1	21.3	21.4	21.6	21.7	21.9	9
10	22.0	22.2	22.3	22.5	22.6	22.8	22.9	23.1	23.2	23.4	10
11	23.5	23.7	23.8	24.0	24.1	24.3	24.4	24.6	24.7	24.9	11
12	25.0	25.2	25.3	25.5	25.6	25.8	25.9	26.1	26.2	26.4	12
13	26.5	26.7	26.8	27.0	27.1	27.3	27.4	27.6	27.7	27.9	13
14	28.0	28.2	28.3	28.5	28.6	28.8	28.9	29.1	29.2	29.4	14
15	29.5	29.7	29.8	30.0	30.1	30.3	30.4	30.6	30.7	30.9	15
16	31.0	31.2	31.3	31.5	31.6	31.8	31.9	32.1	32.2	32.4	16
17	32.5	32.7	32.8	33.0	33.1	33.3	33.4	33.6	33.7	33.9	17
18	34.0	34.2	34.3	34.5	34.6	34.8	34.9	35.1	35.2	35.4	18
19	35.5	35.7	35.8	36.0	36.1	36.3	36.4	36.6	36.7	36.9	19
20	37.0	37.2	37.3	37.5	37.6	37.8	37.9	38.1	38.2	38.4	20
21	38.5	38.7	38.8	39.0	39.1	39.3	39.4	39.6	39.7	39.9	21
22	40.0	40.2	40.3	40.5	40.6	40.8	40.9	41.1	41.2	41.4	22
23	41.5	41.7	41.8	42.0	42.1	42.3	42.4	42.6	42.7	42.9	23
24	43.0	43.2	43.3	43.5	43.6	43.8	43.9	44.1	44.2	44.4	24
25	44.5	44.7	44.8	45.0	45.1	45.3	45.4	45.6	45.7	45.9	25
26	46.0	46.2	46.3	46.5	46.6	46.8	46.9	47.1	47.2	47.4	26
27	47.5	47.7	47.8	48.0	48.1	48.3	48.4	48.6	48.7	48.9	27
28	49.0	49.2	49.3	49.5	49.6	49.8	49.9	50.1	50.2	50.4	28
29	50.5	50.7	50.8	51.0	51.1	51.3	51.4	51.6	51.7	51.9	29
30	52.0	52.2	52.3	52.5	52.6	52.8	52.9	53.1	53.2	53.4	30
31	53.5	53.7	53.8	54.0	54.1	54.3	54.4	54.6	54.7	54.9	31
32	55.0	55.2	55.3	55.5	55.6	55.8	55.9	56.1	56.2	56.4	32
33	56.5	56.7	56.8	57.0	57.1	57.3	57.4	57.6	57.7	57.9	33
34	58.0	58.2	58.3	58.5	58.6	58.8	58.9	59.1	59.2	59.4	34
35	59.5	59.7	59.8	60.0	60.1	60.3	60.4	60.6	60.7	60.9	35
36	61.0	61.2	61.3	61.5	61.6	61.8	61.9	62.1	62.2	62.4	36

Calculated by Julien A. Hall, M. Am. Soc. C. E.

MADE IN GERMANY.

02499