

LOCATION OF

# ANOKA CUT-OFF

From County Rd "A" To Co. Rd. "A2"


R. Holterhoff

1927

ANOKA CUTOFF  
Co. Rd A - A2  
Halterhoff.





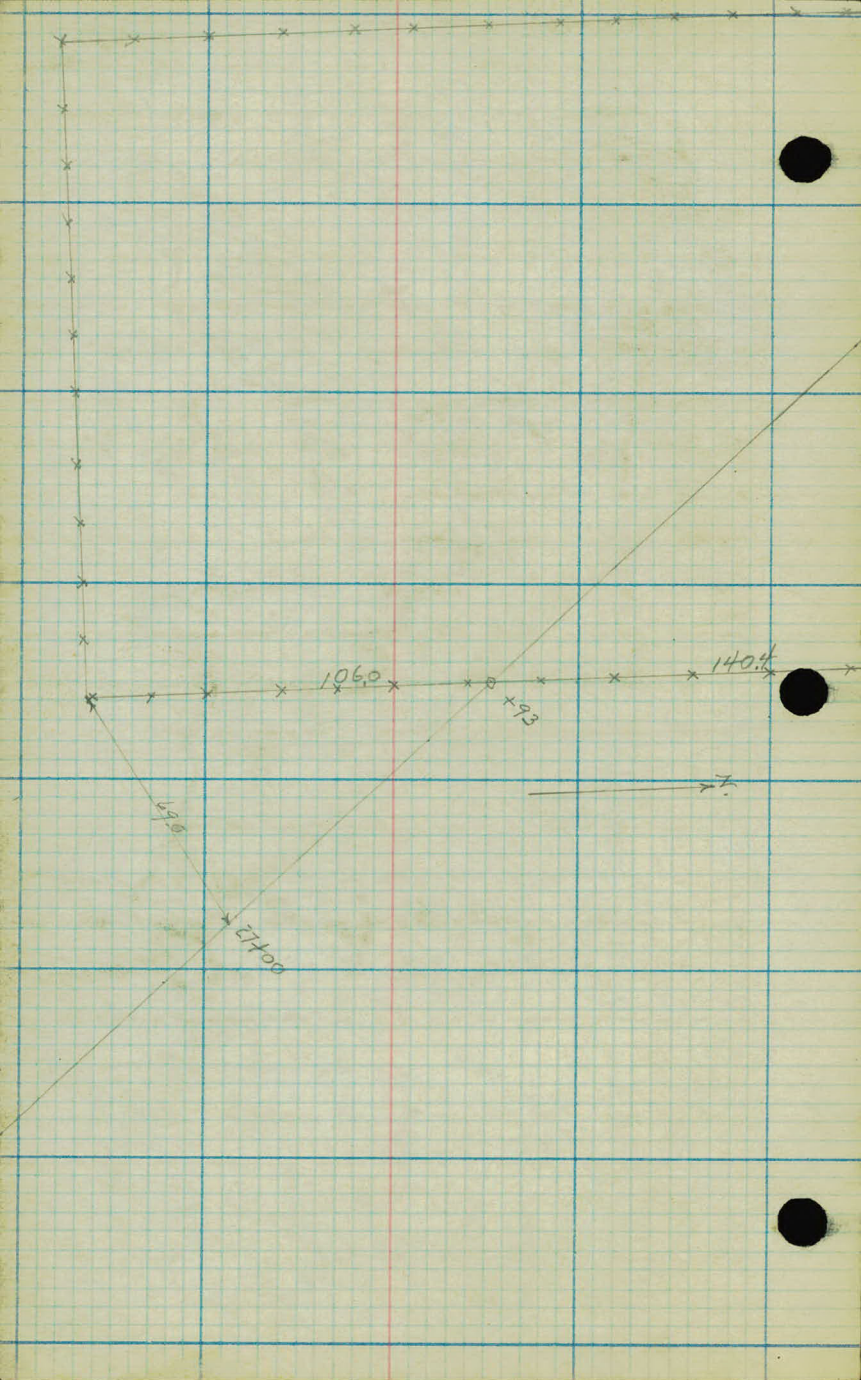

Dec. 21-27  
R.H.

N.  
↑

TP  
0.3885  
48109.80  
RR. Spike  
2113.00 TP  
108253  
39°55'

"AE"

Anda Cut off Robosca &  
(city & protected)

± Hamline Ave

± Lexington Ave

± Larpenteur Ave

49227  
4750  
31920  
26825 TP  
0700

17  
254  
197 6910.46  
852  
18917

919.52  
1.35  
77817  
830  
72647

976.47  
-11.50  
91497  
+3.33  
91830  
10.1  
90740

19077  
1079  
3008  
1232  
2317  
44

TP 2570 = 3206 EF

17.14  
17.19  
90.75  
3.33  
91028

71273 Pa Sn 38.37  
536

4590  
4575 G.P

709.06  
12.38  
42144  
43  
92101

219.58  
6.64  
213.24

93311  
1  
93301

33E

100  
87.63  
12.37

0001  
5.27  
5.25  
001

-87

U 2499