

Dr. 6-BK.124 24

OFFICE OF COUNTY ENGINEER
RAMSEY CO. MINN.

PLAN.....Survey

North County Line Road.....


From Portland Ave. To E. Co. Line.....

Road Acc't. No.

Date Filed. 1937.....

File.....


Plan Survey North County Line Road Portland Ave to E. Co. Line

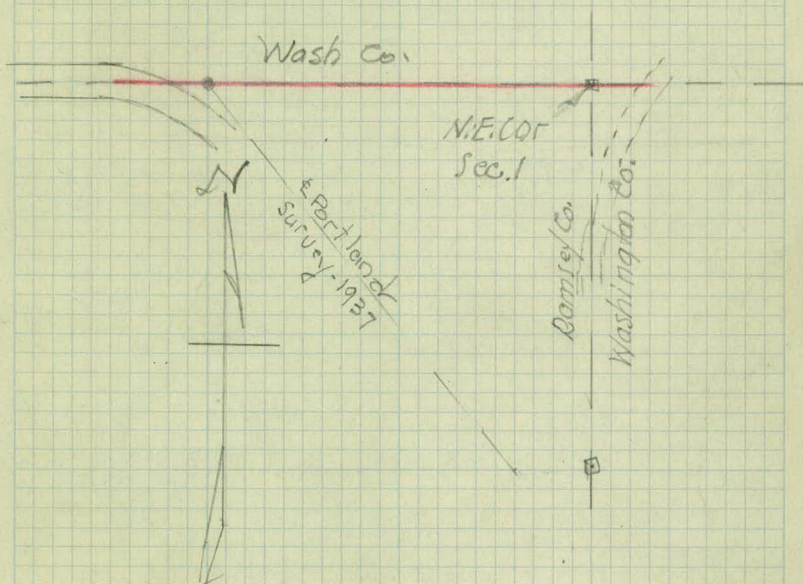

Index

alignment.	1-2
Topography	3-6
Cross sections	7-11
Soundings.	12-13
Recom.	11

W. H. Carlson
Sept 10, 1937

 

N. Co. Line Rd.

$\frac{1}{4}$ E. of E. Co. Line to E. Co. Line.

angle

Station	Point	Lt	Rt.
---------	-------	----	-----

64+22.74	E. Trail Rd.		
----------	--------------	--	--

64+03	- E. Rd. S.		
-------	-------------	--	--

61+81.91	Moro.		
----------	-------	--	--

54+27.37			
----------	--	--	--

48+72.35	1/4-1/2 Cor. as Estab.		
----------	------------------------	--	--

46+16.75	P.O.T. = P.T. Portland		
----------	------------------------	--	--

Iron Mon.

Wash Co.



F.P. x


1.90

30' Bak

42.46

Boat Spike

$$\begin{array}{r} 48 + 12.35 \\ 12 + 10.88 \\ \hline 61 + 23.23 \\ 52.46 \end{array}$$

 

Topography.
N. Co. Line Rd.

50

49

48

16-28

180

1-24

47

10-18

46

45

F-2'

4

F-2'

+50-Tim-20'

Timber Line 17

F-2.5'

+50-Timber L. 12

+72.5-Rcon. 2'

+05-24' oak 22'

+98-18' oak 37'

+72+5

+24-Rcon. 1'

+24 End. F 75

Cultivated.

Scattered oaks.



57

56

55

54

53

52

51

Marsh-0' 5

+50-Marsh-40'

F-2'

+80-Marsh-0

+62-5" Pop-10'

F-2'

+99-6" W/11-4'

+85-6" Pop. 8'

+78-5" Pop. 4'

Marsh

F-0'

Timber Line 14'

+80-Timber 10'

+60-F-0'

+34-F. Cor. 1'

scatt
oaks

+50-Timber 20'

F-0'

Timber 18'

24" oak

F-1'

+30-Timber 20'

30" oak

+40-

Cult.

Pasture

F-1'

Scattered
oaks

Timber 19'

65

64

63

62

61

60

59

58

+50-F.Line 48'

+40-F.Cor. 91

+18-A Fen 37

CRd. +24'
 d Rd. +03'
 0015
 PASTURE

+72-F.Cor. 0'

+93-F.Cor. 0'

Pasture

+98-6" Oak-12'

+82-F.Cor. 0'

+86-24" Oak 27'

+78-8" Oak 21'

+18-6" Tr Oak 27'

+12-4" Oak-12'

+96-12" Tr. 19'

+93-12" Oak-13'

F-0'

F-1'

24" Small Oaks
 #55
 Pasture


20-76'

Marsh
50'

F-2'

Marsh
40'+60-Marsh
0'

F-2.5

 

Cross Sections.

Sta.	+	π	-	Elev.
B.N.D.	4.97	944.50		939.53
46+50				938.0
47				38.2
+50				38.3
48				38.6
+50				38.7
49				39.1
+50				39.7
50				41.6
+50				40.3
51				40.3
T.P.	3.32	944.18	3.64	940.86

4.

E

Rt.

$$\begin{array}{r} 7.4 \\ 33 \end{array} \quad \begin{array}{r} 7.7 \\ 17 \end{array} \quad \begin{array}{r} 6.7 \\ 14 \end{array} \quad \begin{array}{r} 6.5 \\ 1 \end{array} \quad \begin{array}{r} 7.1 \\ 14 \end{array} \quad \begin{array}{r} 8.3 \\ 17 \end{array} \quad \begin{array}{r} 9.1 \\ 24 \end{array} \quad \begin{array}{r} 9.0 \\ 33 \end{array}$$

$$\begin{array}{r} 7.0 \\ 33 \end{array} \quad \begin{array}{r} 7.0 \\ 19 \end{array} \quad \begin{array}{r} 8.4 \\ 17 \end{array} \quad \begin{array}{r} 6.4 \\ 11 \end{array} \quad \begin{array}{r} 6.3 \\ 1 \end{array} \quad \begin{array}{r} 6.8 \\ 19 \end{array} \quad \begin{array}{r} 7.6 \\ 22 \end{array} \quad \begin{array}{r} 8.1 \\ 33 \end{array}$$

$$\begin{array}{r} 5.7 \\ 33 \end{array} \quad \begin{array}{r} 6.4 \\ 10 \end{array} \quad \begin{array}{r} 7.4 \\ 6 \end{array} \quad \begin{array}{r} 6.2 \\ 2 \end{array} \quad \begin{array}{r} 6.2 \\ 1 \end{array} \quad \begin{array}{r} 6.1 \\ 13 \end{array} \quad \begin{array}{r} 6.6 \\ 23 \end{array} \quad \begin{array}{r} 7.0 \\ 33 \end{array}$$

$$\begin{array}{r} 6.0 \\ 33 \end{array} \quad \begin{array}{r} 6.1 \\ 18 \end{array} \quad \begin{array}{r} 5.9 \\ 1 \end{array} \quad \begin{array}{r} 8.0 \\ 5 \end{array} \quad \begin{array}{r} 8.0 \\ 8 \end{array} \quad \begin{array}{r} 5.2 \\ 13 \end{array} \quad \begin{array}{r} 5.6 \\ 17 \end{array} = 5.6 \text{ bh.} \quad \begin{array}{r} 6.3 \\ 33 \end{array}$$

$$\begin{array}{r} 5.2 \\ 33 \end{array} \quad \begin{array}{r} 5.8 \\ 20 \end{array} \quad \begin{array}{r} 5.5 \\ 8 \end{array} \quad \begin{array}{r} 5.8 \\ 1 \end{array} \quad \begin{array}{r} 7.0 \\ 5 \end{array} \quad \begin{array}{r} 7.0 \\ 8 \end{array} \quad \begin{array}{r} 5.2 \\ 11 \end{array} \quad \begin{array}{r} 5.2 \\ 36 \end{array} \quad \begin{array}{r} 6.1 \\ 55 \end{array} = 5.6 \text{ bh.}$$

$$\begin{array}{r} 5.5 \\ 33 \end{array} \quad \begin{array}{r} 6.0 \\ 20 \end{array} \quad \begin{array}{r} 5.2 \\ 9 \end{array} \quad \begin{array}{r} 5.4 \\ 1 \end{array} \quad \begin{array}{r} 5.8 \\ 20 \end{array} \quad \begin{array}{r} 6.0 \\ 33 \end{array}$$

$$\begin{array}{r} 4.9 \\ 33 \end{array} \quad \begin{array}{r} 4.4 \\ 8 \end{array} \quad \begin{array}{r} 4.8 \\ 1 \end{array} \quad \begin{array}{r} 5.2 \\ 15 \end{array} \quad \begin{array}{r} 6.0 \\ 33 \end{array}$$

$$\begin{array}{r} 3.5 \\ 33 \end{array} \quad \begin{array}{r} 3.7 \\ 10 \end{array} \quad \begin{array}{r} 3.9 \\ 1 \end{array} \quad \begin{array}{r} 4.2 \\ 8 \end{array} \quad \begin{array}{r} 5.3 \\ 16 \end{array} \quad \begin{array}{r} 6.1 \\ 33 \end{array}$$

$$\begin{array}{r} 3.7 \\ 33 \end{array} \quad \begin{array}{r} 4.3 \\ 10 \end{array} \quad \begin{array}{r} 4.2 \\ 1 \end{array} \quad \begin{array}{r} 4.3 \\ 10 \end{array} \quad \begin{array}{r} 4.9 \\ 23 \end{array} \quad \begin{array}{r} 5.4 \\ 33 \end{array}$$

$$\begin{array}{r} 4.1 \\ 33 \end{array} \quad \begin{array}{r} 4.3 \\ 10 \end{array} \quad \begin{array}{r} 4.2 \\ 1 \end{array} \quad \begin{array}{r} 4.8 \\ 10 \end{array} \quad \begin{array}{r} 5.4 \\ 15 \end{array} \quad \begin{array}{r} 5.6 \\ 33 \end{array}$$

7.8
8.1
8.4
8.7
9.1
9.4
Sta.	T	A	-	Elev.
		944.18		
51+50				40.7
52				40.9
+50				38.6
53				36.6
+50				36.3
54				37.4
+32				37.1
+60				33.9
T.P.	0.30	932.37	12.11	932.07
55				26.2
+15				22.7
+50				21.7
56				21.5

4.

2

12.

$$\begin{array}{r} 35 \\ 33 \end{array} \quad \begin{array}{r} 38 \\ 10 \end{array} \quad \begin{array}{r} 32 \\ 7 \end{array} \quad \begin{array}{r} 35 \\ 1 \end{array} \quad \begin{array}{r} 35 \\ 10 \end{array} \quad \begin{array}{r} 43 \\ 15 \end{array} \quad \begin{array}{r} 43 \\ 35 \end{array}$$

$$\begin{array}{r} 36 \\ 33 \end{array} \quad \begin{array}{r} 35 \\ 9 \end{array} \quad \begin{array}{r} 28 \\ 6 \end{array} \quad \begin{array}{r} 33 \\ 1 \end{array} \quad \begin{array}{r} 30 \\ 08 \end{array} \quad \begin{array}{r} 38 \\ 12 \end{array} \quad \begin{array}{r} 34 \\ 33 \end{array}$$

$$\begin{array}{r} 48 \\ 33 \end{array} \quad \begin{array}{r} 53 \\ 14 \end{array} \quad \begin{array}{r} 51 \\ 7 \end{array} \quad \begin{array}{r} 50 \\ 3 \end{array} \quad \begin{array}{r} 56 \\ 1 \end{array} \quad \begin{array}{r} 60 \\ 10 \end{array} \quad \begin{array}{r} 70 \\ 14 \end{array} \quad \begin{array}{r} 74 \\ 33 \end{array}$$

$$\begin{array}{r} 67 \\ 33 \end{array} \quad \begin{array}{r} 75 \\ 10 \end{array} \quad \begin{array}{r} 68 \\ 5 \end{array} \quad \begin{array}{r} 76 \\ 1 \end{array} \quad \begin{array}{r} 80 \\ 18 \end{array} \quad \begin{array}{r} 74 \\ 33 \end{array}$$

$$\begin{array}{r} 77 \\ 33 \end{array} \quad \begin{array}{r} 81 \\ 10 \end{array} \quad \begin{array}{r} 73 \\ 3 \end{array} \quad \begin{array}{r} 79 \\ 1 \end{array} \quad \begin{array}{r} 76 \\ 20 \end{array} \quad \begin{array}{r} 65 \\ 33 \end{array}$$

$$\begin{array}{r} 86 \\ 33 \end{array} \quad \begin{array}{r} 78 \\ 11 \end{array} \quad \begin{array}{r} 68 \\ 5 \end{array} \quad \begin{array}{r} 68 \\ 1 \end{array} \quad \begin{array}{r} 53 \\ 13 \end{array} \quad \begin{array}{r} 47 \\ 33 \end{array}$$

$$\begin{array}{r} 89 \\ 33 \end{array} \quad \begin{array}{r} 77 \\ 12 \end{array} \quad \begin{array}{r} 70 \\ 5 \end{array} \quad \begin{array}{r} 71 \\ 1 \end{array} \quad \begin{array}{r} 63 \\ 13 \end{array} \quad \begin{array}{r} 75 \\ 33 \end{array}$$

$$\begin{array}{r} 128 \\ 33 \end{array} \quad \begin{array}{r} 114 \\ 12 \end{array} \quad \begin{array}{r} 101 \\ 2 \end{array} \quad \begin{array}{r} 103 \\ 1 \end{array} \quad \begin{array}{r} 92 \\ 9 \end{array} \quad \begin{array}{r} 107 \\ 33 \end{array}$$

$$\begin{array}{r} 75 \\ 33 \end{array} \quad \begin{array}{r} 71 \\ 20 \end{array} \quad \begin{array}{r} 58 \\ 4 \end{array} \quad \begin{array}{r} 62 \\ 1 \end{array} \quad \begin{array}{r} 58 \\ 21 \end{array} \quad \begin{array}{r} 55 \\ 33 \end{array}$$

$$\begin{array}{r} 97 \\ 33 \end{array} \quad \begin{array}{r} 97 \\ 1 \end{array} \quad \begin{array}{r} 87 \\ 33 \end{array}$$

$$\begin{array}{r} 107 \\ 33 \end{array} \quad \begin{array}{r} 107 \\ 1 \end{array} \quad \begin{array}{r} 105 \\ 33 \end{array}$$

$$\begin{array}{r} 107 \\ 33 \end{array}$$

$$\begin{array}{r} 109 \\ 1 \end{array}$$

$$\begin{array}{r} 107 \\ 33 \end{array}$$

Pl. 24" Culv. Equal.

D. 24" Culv. Equal.

$$\begin{array}{r} 41.2 \\ 10.8 \\ 32 \end{array}$$

Sta.	+	x	-	Elev.
		932.37		
56+50				21.7
57				23.0
+4/5				24.7
58				22.6
+50				22.6
59				25.0
T.P.	5.39	936.39	1.37	931.00
+55				29.9
1				
60+0				31.8
+50				30.3
61+0				30.5
+50				28.7
61+81.91				28.3
B.M.			8.11	928.28

LT. L RT

$$\frac{10.3}{33}$$

$$\frac{10.1}{33}$$

$$\frac{10.4}{33}$$

$$\frac{9.3}{33}$$

$$\frac{9.7}{10}$$

$$\frac{9.4}{10}$$

$$\frac{9.0}{10}$$

$$\frac{9.7}{33}$$

$$\frac{7.6}{33}$$

$$\frac{7.7}{9}$$

$$\frac{7.7}{9}$$

$$\frac{8.1}{19}$$

$$\frac{9.9}{29}$$

$$\frac{9.9}{33}$$

$$\frac{9.7}{33}$$

$$\frac{9.8}{10}$$

$$\frac{9.8}{10}$$

$$\frac{10.3}{33}$$

$$\frac{7.4}{33}$$

$$\frac{8.6}{8}$$

$$\frac{9.8}{9}$$

$$\frac{10.0}{9}$$

$$\frac{10.3}{33}$$

$$\frac{3.5}{33}$$

$$\frac{5.5}{6}$$

$$\frac{7.4}{10}$$

$$\frac{10.0}{18}$$

$$\frac{10.2}{33}$$

LSLko

$$\frac{3.0}{50}$$

$$\frac{3.6}{33}$$

$$\frac{4.8}{5}$$

$$\frac{6.5}{10}$$

$$\frac{8.1}{9}$$

$$\frac{12.7}{34}$$

$$\frac{12.2}{140}$$

$$\frac{2.4}{50}$$

$$\frac{4.0}{17}$$

$$\frac{3.8}{5}$$

$$\frac{4.6}{10}$$

$$\frac{7.0}{17}$$

$$\frac{11.2}{36}$$

$$\frac{14.1}{50}$$

$$\frac{3.2}{50}$$

$$\frac{5.0}{16}$$

$$\frac{4.8}{5}$$

$$\frac{5.1}{10}$$

$$\frac{7.3}{15}$$

$$\frac{13.7}{50}$$

$$\frac{5.1}{50}$$

$$\frac{6.1}{13}$$

$$\frac{5.8}{4}$$

$$\frac{5.9}{10}$$

$$\frac{8.0}{20}$$

$$\frac{12.6}{50}$$

$$\frac{14.0}{58}$$

$$\frac{8.5}{50}$$

$$\frac{8.3}{19}$$

$$\frac{7.6}{3}$$

$$\frac{7.7}{10}$$

$$\frac{8.7}{27}$$

$$\frac{11.4}{50}$$

$$\frac{14.0}{70}$$

$$\frac{9.2}{50}$$

$$\frac{9.2}{21}$$

$$\frac{8.5}{4}$$

$$\frac{8.1}{10}$$

$$\frac{8.7}{27}$$

$$\frac{11.4}{50}$$

pop Iron Mon.

Edge Mark.

Sta. + - Elev.

936.39

N. Co. Line extd into Wash Co.

6240

+50


6340

+70

6440

+22 1/2 Rd.

End grading @ Sta. 6422 in
Wash County.

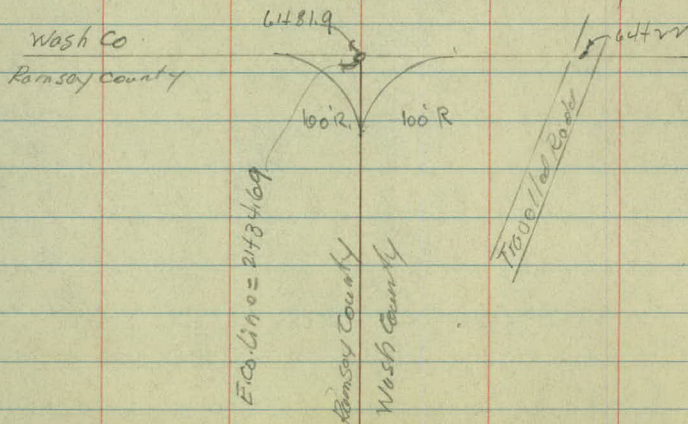

L

E

Rt

$$\frac{9.6}{33}$$

$$\frac{9.6}{17}$$

$$\frac{8.8}{3}$$

$$9.0$$

$$\frac{9.1}{33}$$

$$\frac{9.8}{33}$$

$$\frac{10.2}{15}$$

$$\frac{10.0}{5}$$

$$\frac{10.2}{-}$$

$$\frac{10.2}{10}$$

$$\frac{11.6}{33}$$

$$\frac{10.0}{33}$$

$$\frac{11.6}{17}$$

$$\frac{11.9}{8}$$

$$\frac{12.1}{-}$$

$$\frac{12.7}{15}$$

$$\frac{13.4}{33}$$

$$\frac{8.6}{33}$$

$$\frac{10.1}{9}$$

$$\frac{11.3}{4}$$

$$\frac{11.0}{-}$$

$$\frac{12.2}{12}$$

$$\frac{13.2}{33}$$

$$\frac{10.0}{33}$$

$$\frac{12.0}{22}$$


$$\frac{11.6}{-}$$

$$\frac{11.4}{21}$$

- Rd.

$$\frac{11.5}{50}$$

$$\frac{11.4}{-}$$

 

Soundings.

No. Co Line Rd.

Sta.

Depth of Peat.

5410

+30

58

+75

+45

57

+30

56

+30

55+15

Lt.

¢

Rt.

$$\begin{array}{r} 80 \\ \hline 20 \end{array}$$

$$\begin{array}{r} 90 \\ \hline 10 \end{array}$$

$$\begin{array}{r} 20 \\ \hline \end{array}$$

$$\begin{array}{r} 40 \\ \hline 20 \end{array}$$

$$\begin{array}{r} 90 \\ \hline 20 \end{array}$$

$$\begin{array}{r} 20 \\ \hline \end{array}$$

$$\begin{array}{r} 20 \\ \hline 20 \end{array}$$

00 - Pent.

00 Pent.

$$\begin{array}{r} 90 \\ \hline 20 \end{array}$$

$$\begin{array}{r} 10 \\ \hline \end{array}$$

$$\begin{array}{r} 30 \\ \hline 20 \end{array}$$

$$\begin{array}{r} 40 \\ \hline 20 \end{array}$$

$$\begin{array}{r} 50 \\ \hline \end{array}$$

$$\begin{array}{r} 60 \\ \hline 20 \end{array}$$

$$\begin{array}{r} 60 \\ \hline 20 \end{array}$$

$$\begin{array}{r} 60 \\ \hline \end{array}$$

$$\begin{array}{r} 60 \\ \hline 20 \end{array}$$

$$\begin{array}{r} 50 \\ \hline 20 \end{array}$$

$$\begin{array}{r} 60 \\ \hline \end{array}$$

$$\begin{array}{r} 40 \\ \hline 20 \end{array}$$

00 Pent.

