

Book-46-Dt. 6

PRELIMINARY SURVEY
OF
PROPOSED

PAYNE AVENUE
CUT-OFF
EXTENSION

from Westminster St to Frost Ave

7+00

7+00

7+00

6+00

5+00

4+00

3+00

2+00

1+00

0+00

2515
70'

















EAST MARYLAND

2+00

1+00

0+00

7+00

8+00

9+00

1
0700 - 9400

MONT. E. CONY. PHILLIN

4110 BARNUM















(2)

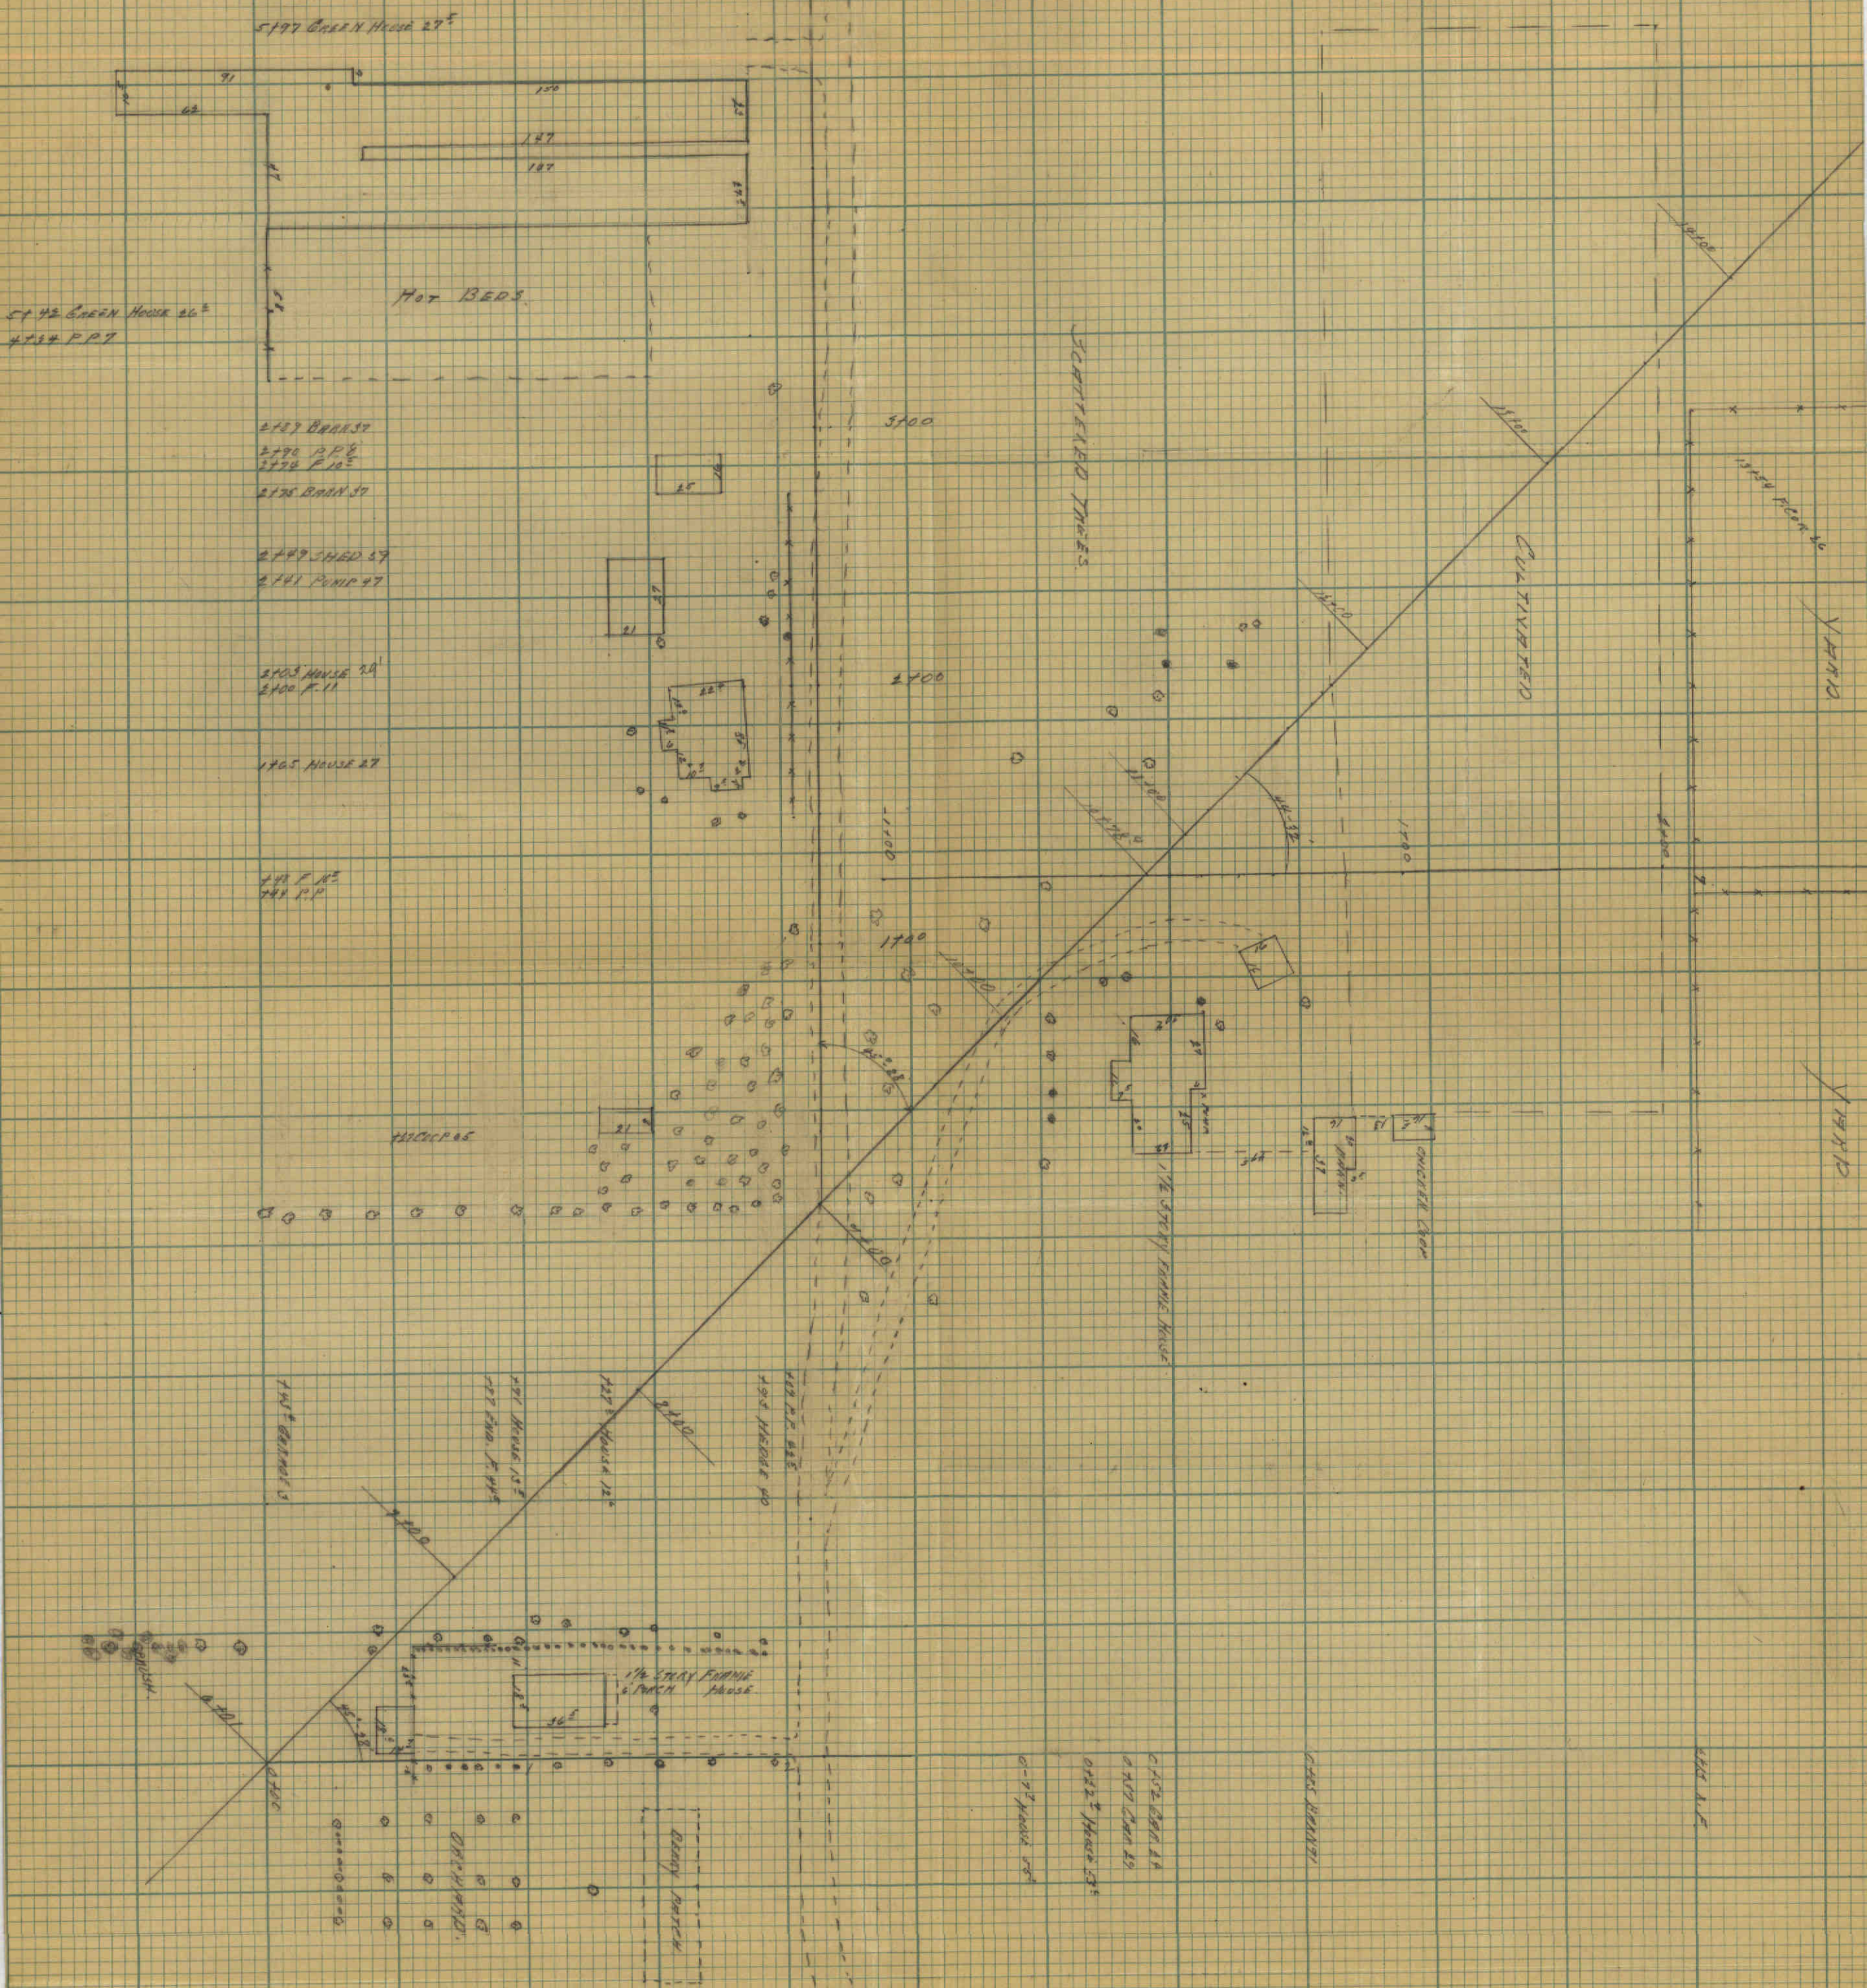

3

3

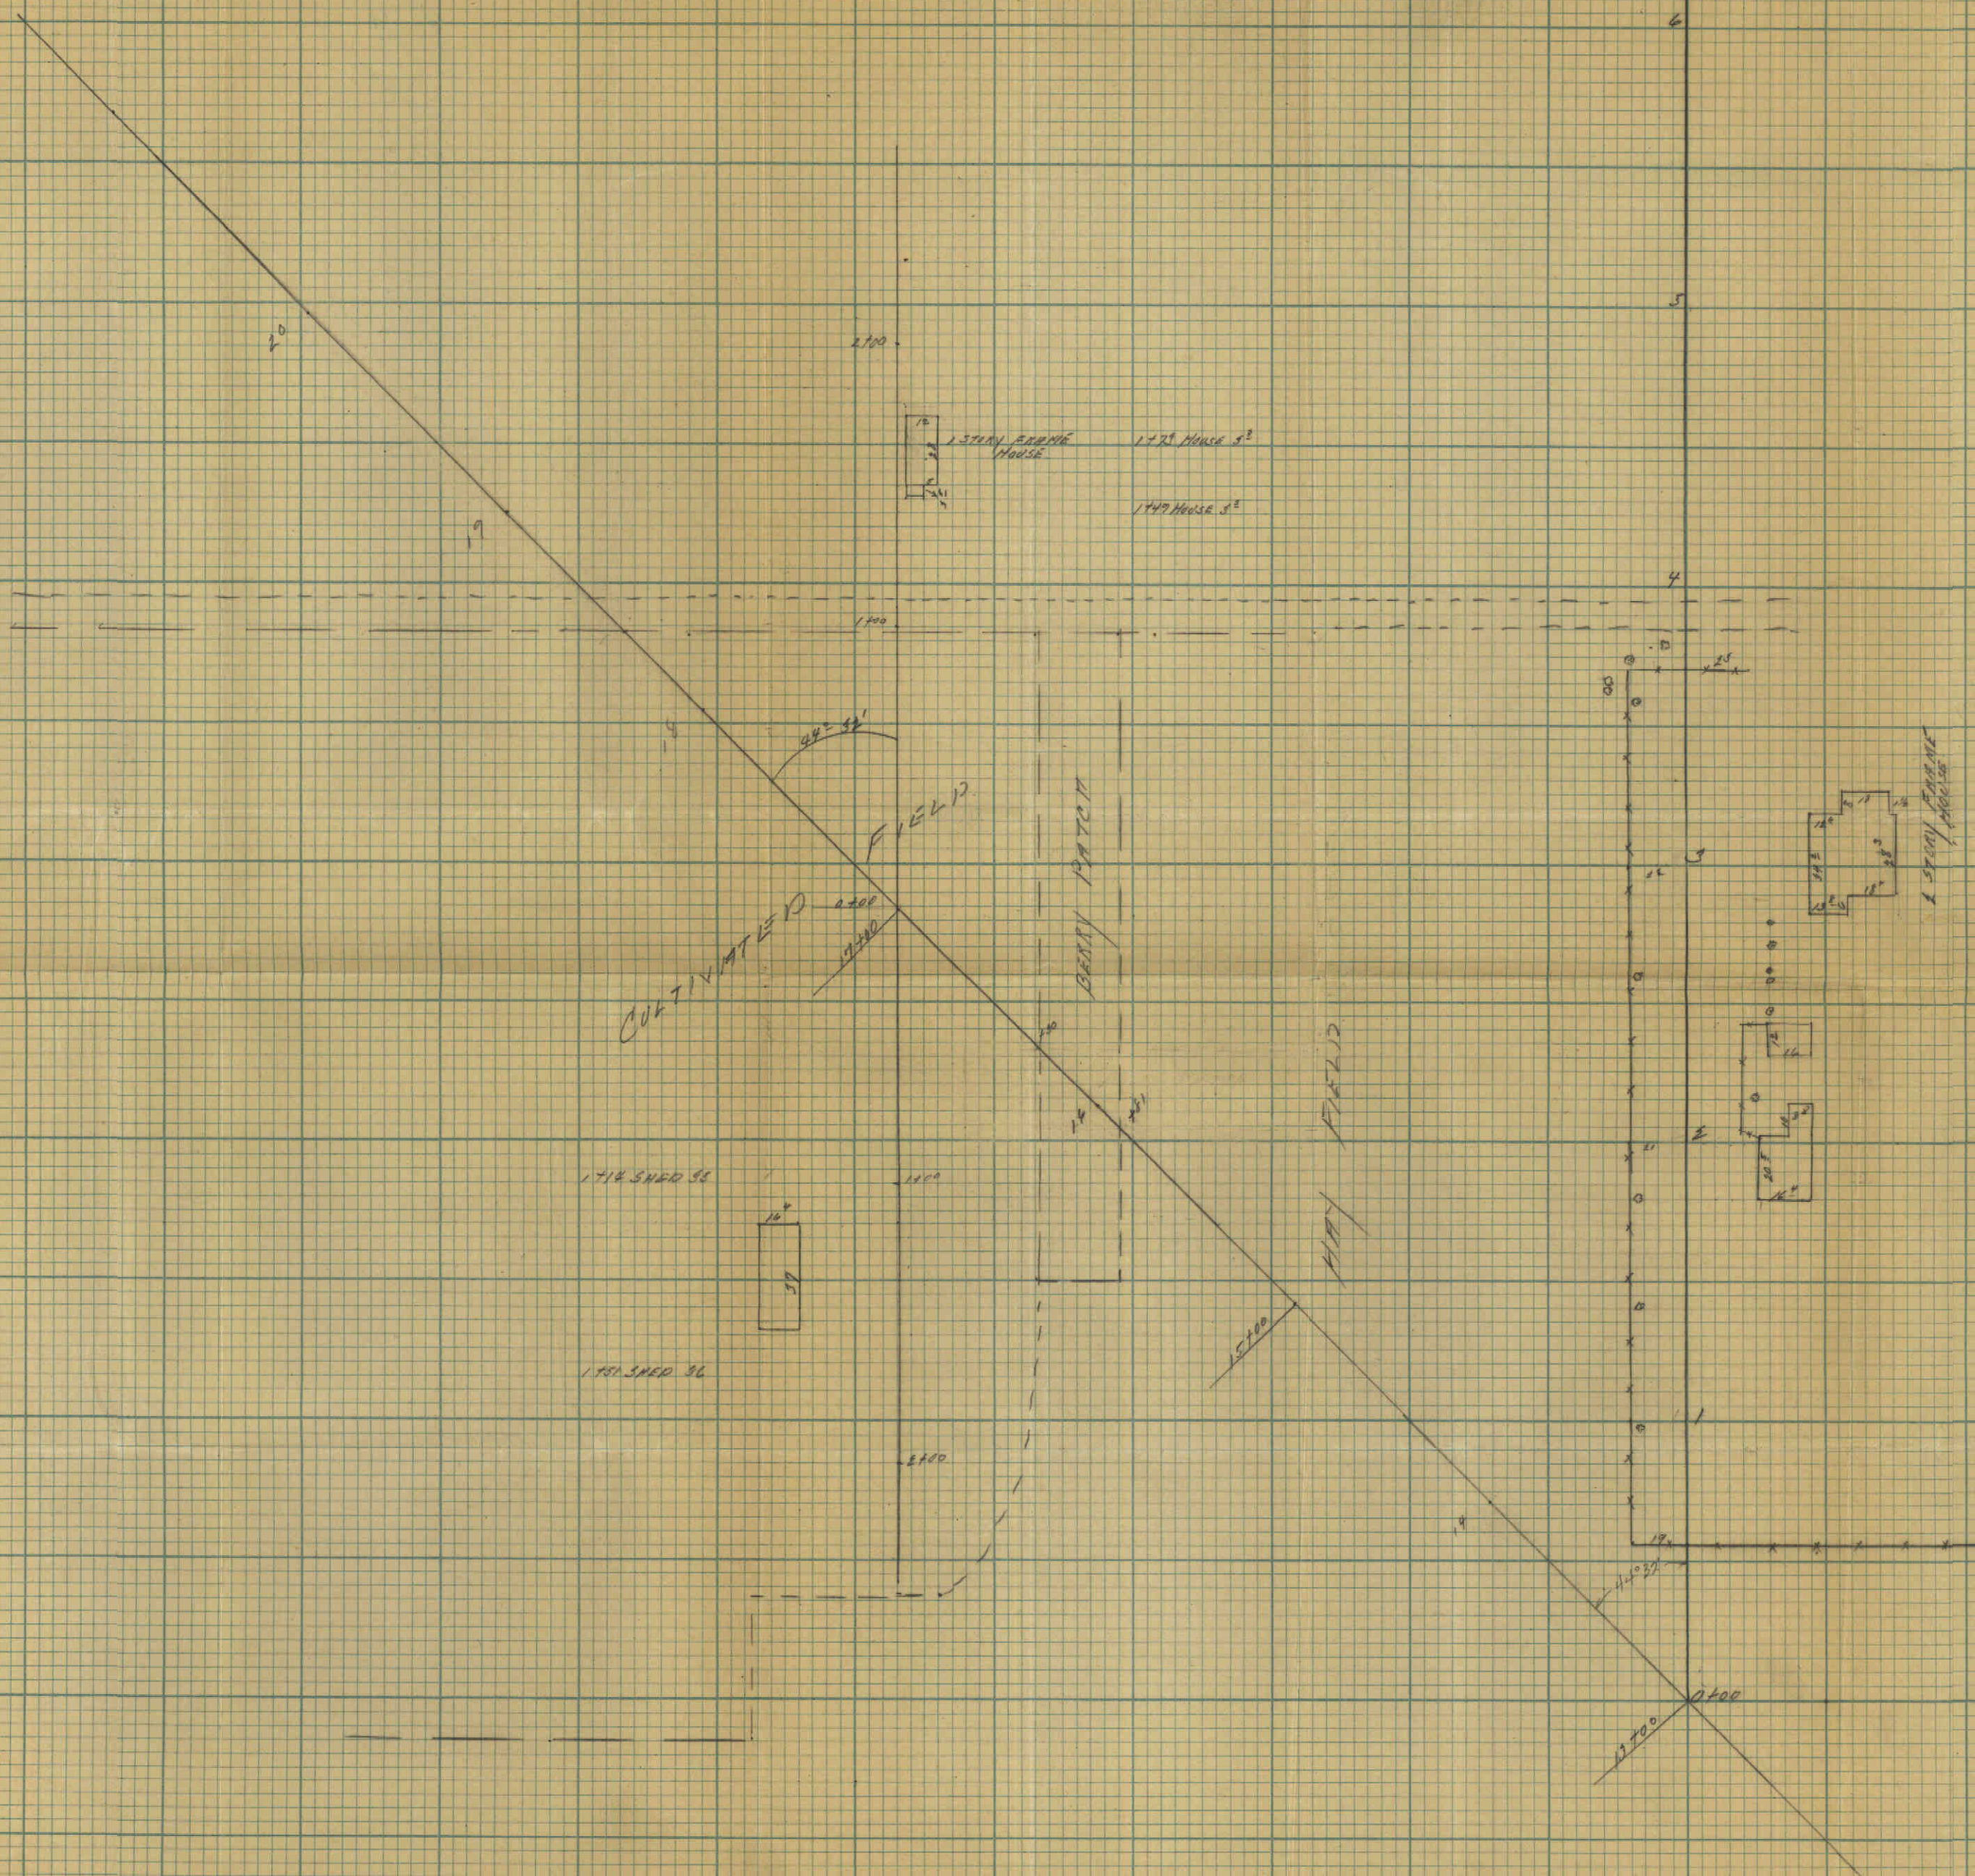

3470 X F

3417 HOUSE 49



























4

4

CULTIVATED

CULTIVATED FIELD


PASTURE

BERRY PATCH

0770 OUT HOUSE #2

1781⁵ HOUSE 16⁵

1761⁵ HOUSE 19⁵

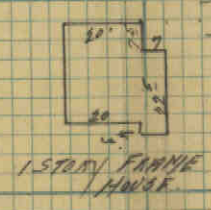

1756⁵ HOUSE 26⁵

1735⁵ HOUSE 25⁵

1795 GAR 95





1798 GAR 95

1758 Coop 11⁵

1765 Coop 12⁵

1739 Coop 13

1709 Coop 14

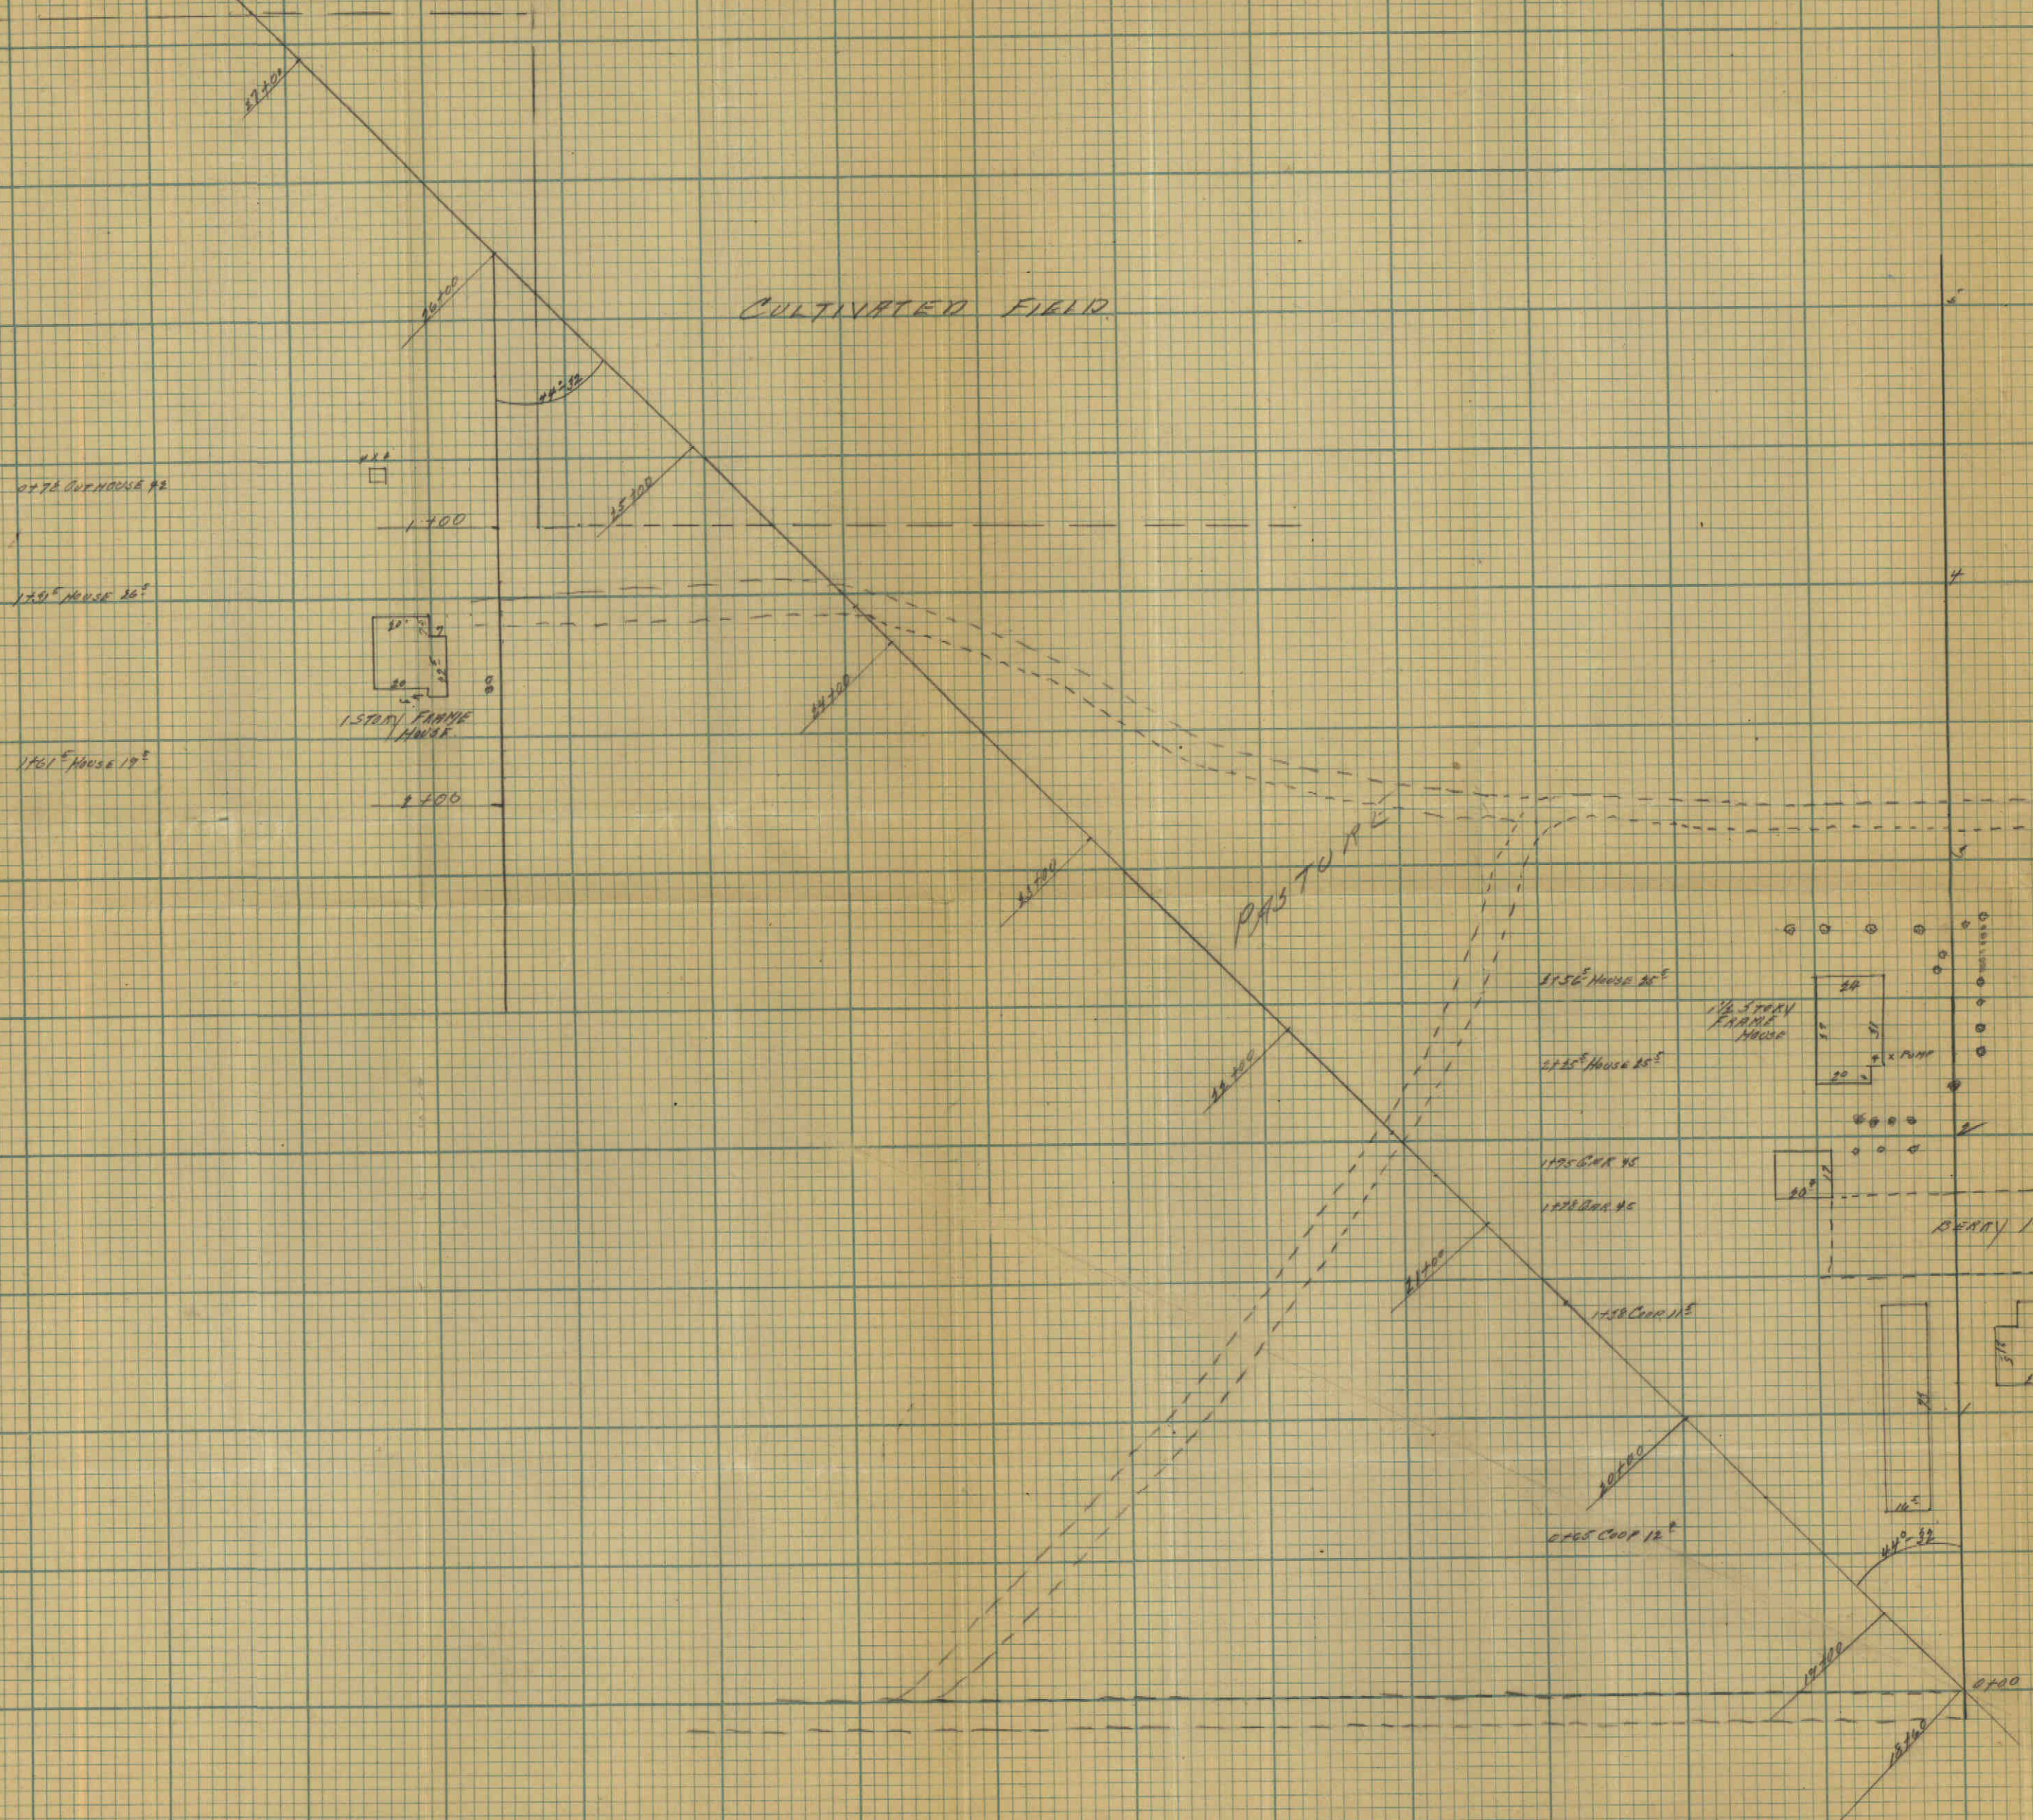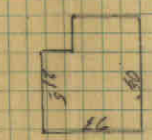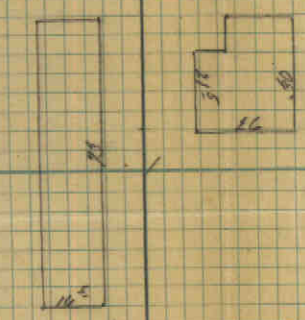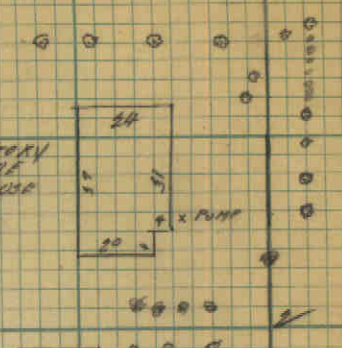

5

1433 P.P. 8 LT

1465² HOUSE 25²

1495 HOUSE 25²

2400 S. WALK 4 LT
2400 S. WALK 2 LT

2429 HOUSE 25

2451² HOUSE 29

LT

RT

2400 S. WALK 2 LT
2400 S. WALK 4 LT

1500² HOUSE
1500² HOUSE

Garage

Garage

1500² HOUSE
1500² HOUSE

BEARDY PATCH

Garage

2475 T.P. 25

1510 HOUSE 25

Garage

1 1/2 STORY FRAME HOUSE

1 1/2 OUT HOUSE

Garage














2403 T.P. 25

2479 P.P. 25
2481 HOUSE 25

1 1/2 STORY FRAME HOUSE

1 1/2 STORY HOUSE

2453 HOUSE 25

2453 HOUSE 25







WOODED

PASTURE

CULTIVATED FIELD

CULTIVATED FIELD

2426 F.C. 15

2426 F. 11

1400 F. 10

2458 F.C. 10

4400












 

14

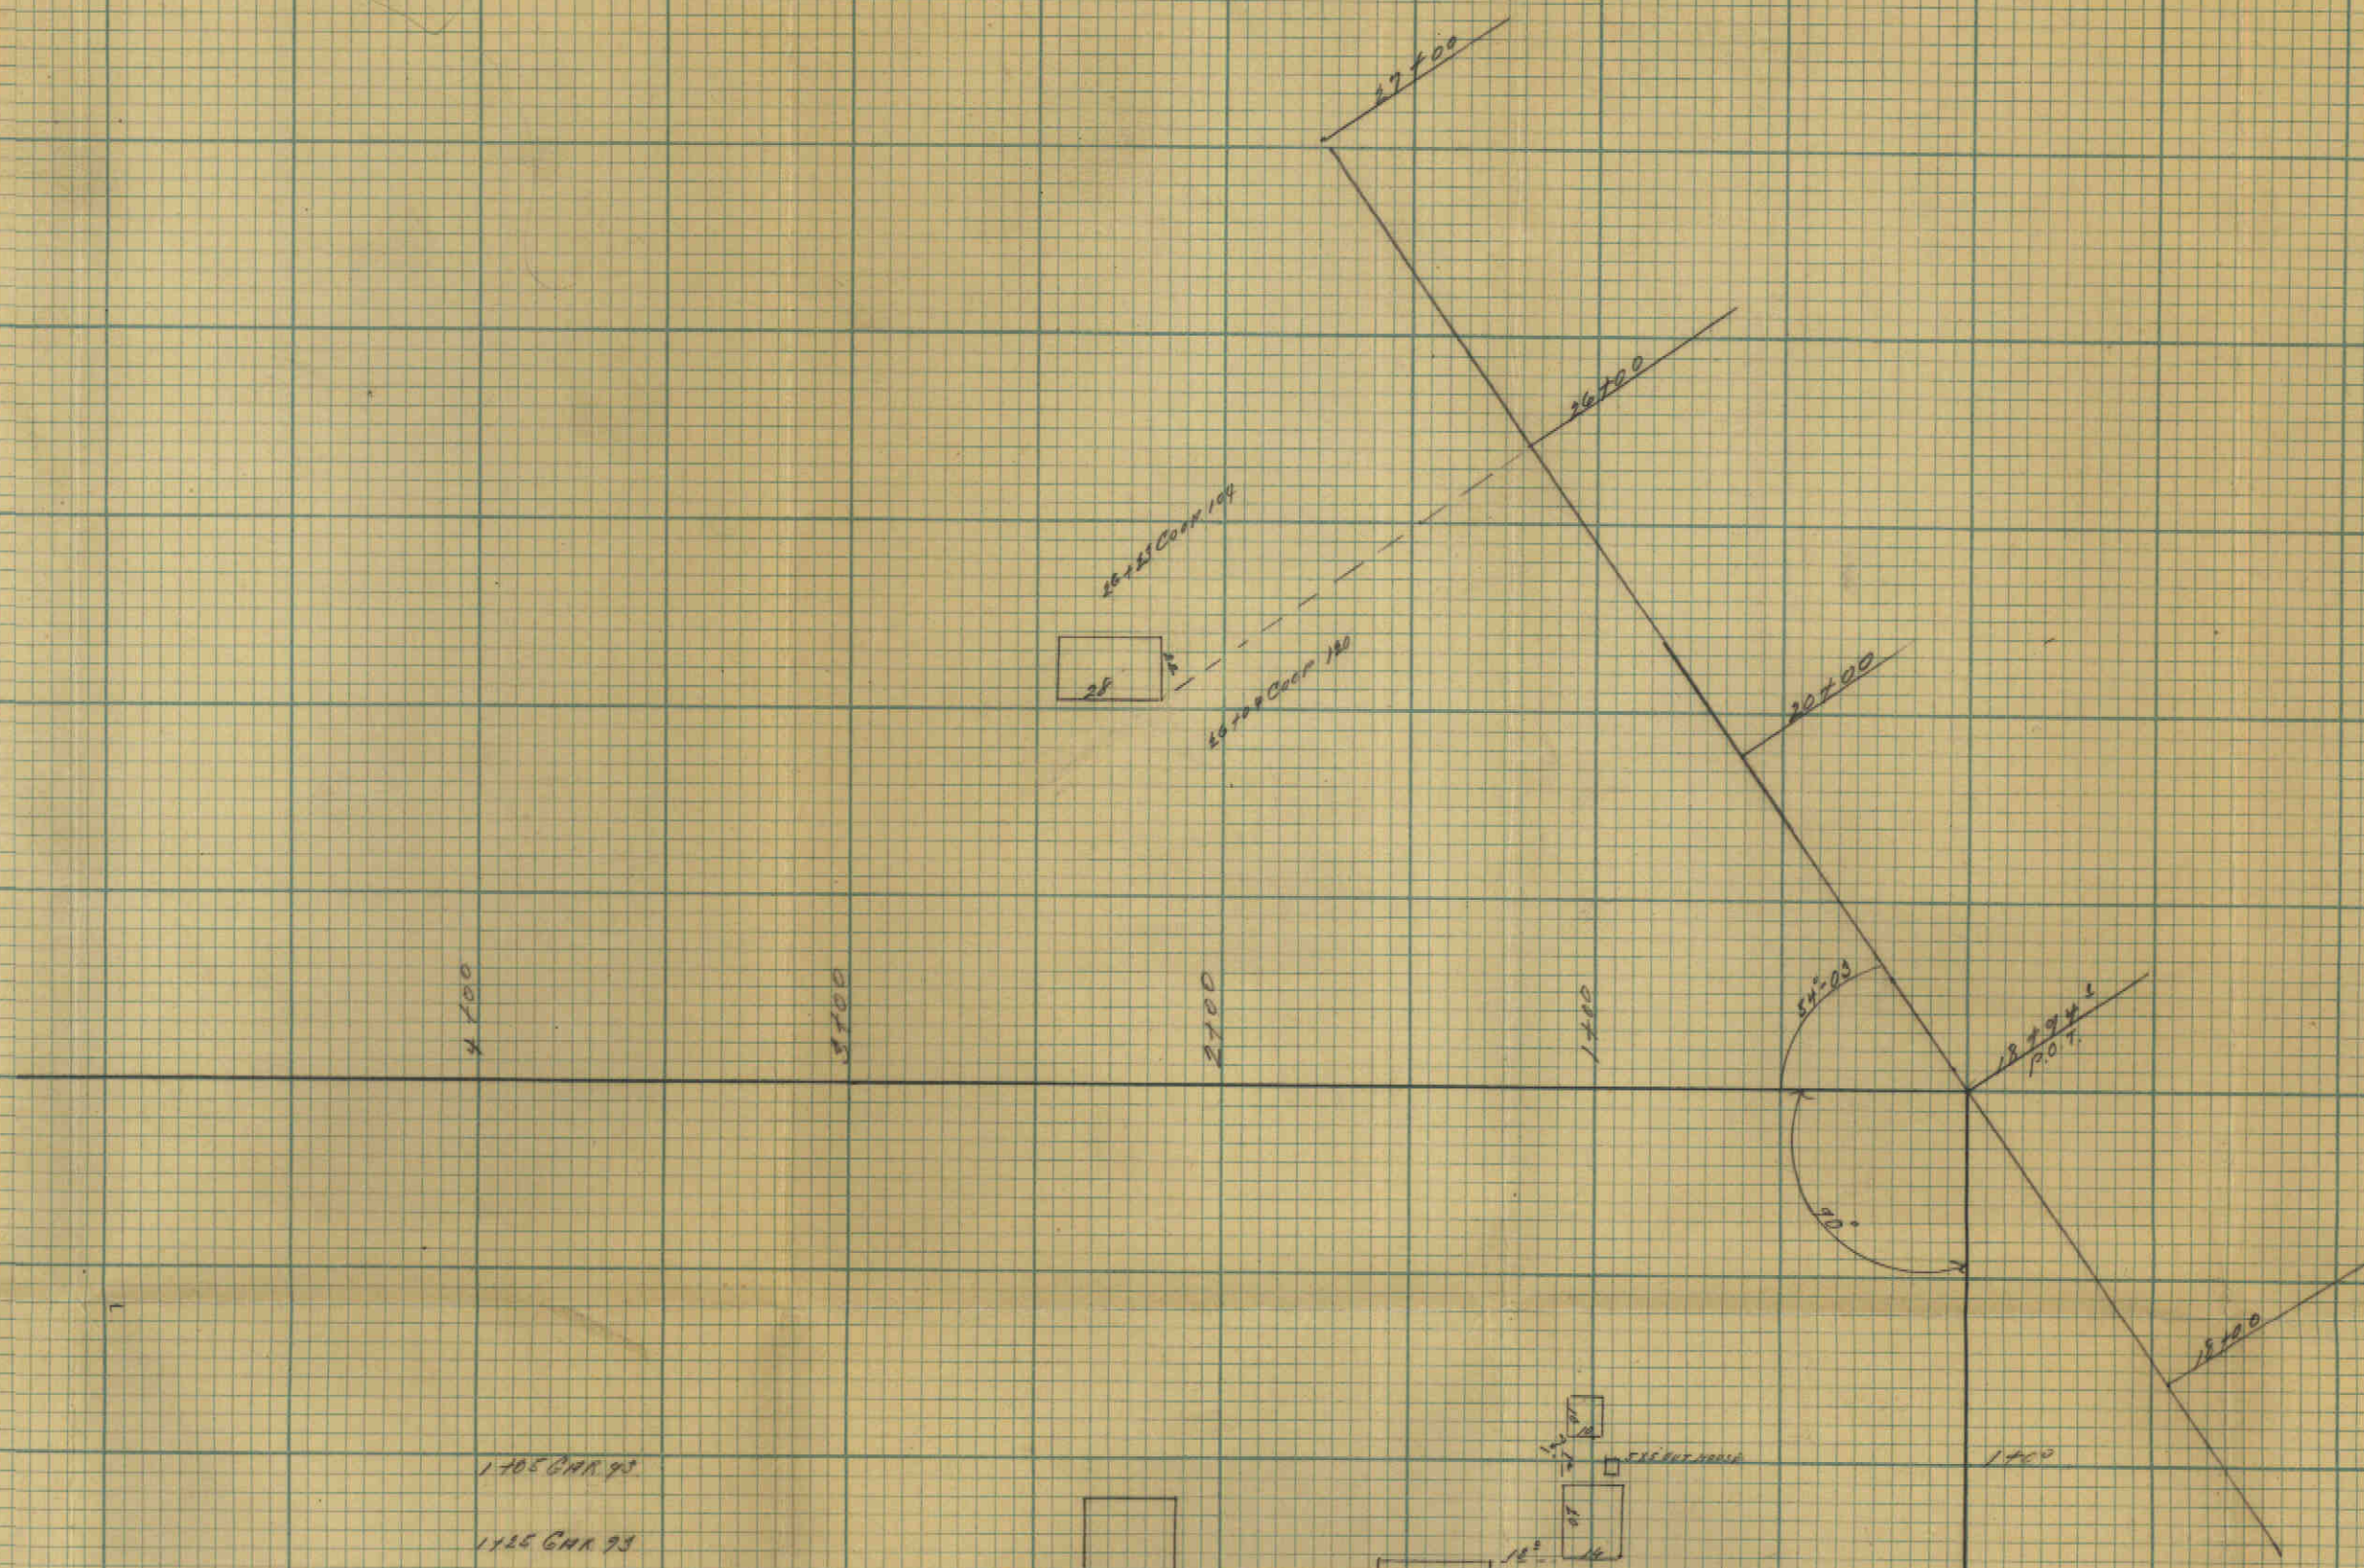


1105 GRN 93
1115 GRN 93
1157 HOUSE 127'

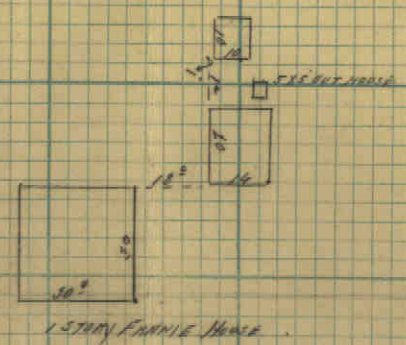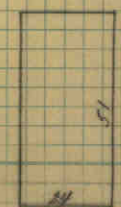


2100

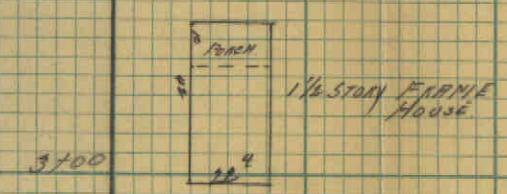

2102 HOUSE 19'
3104 HOUSE 19'

PAYNE AVE CUT-OFF EXTENSION
ALIGNMENT.

"A" LINE

STA. POINT, Δ LT. Δ RT.


$18+94^{\frac{1}{2}}$ P.O.T.

$8+14^{\frac{82}{2}}$ P.O.T.

0+00

$54^{\circ}03'$

5-6-29

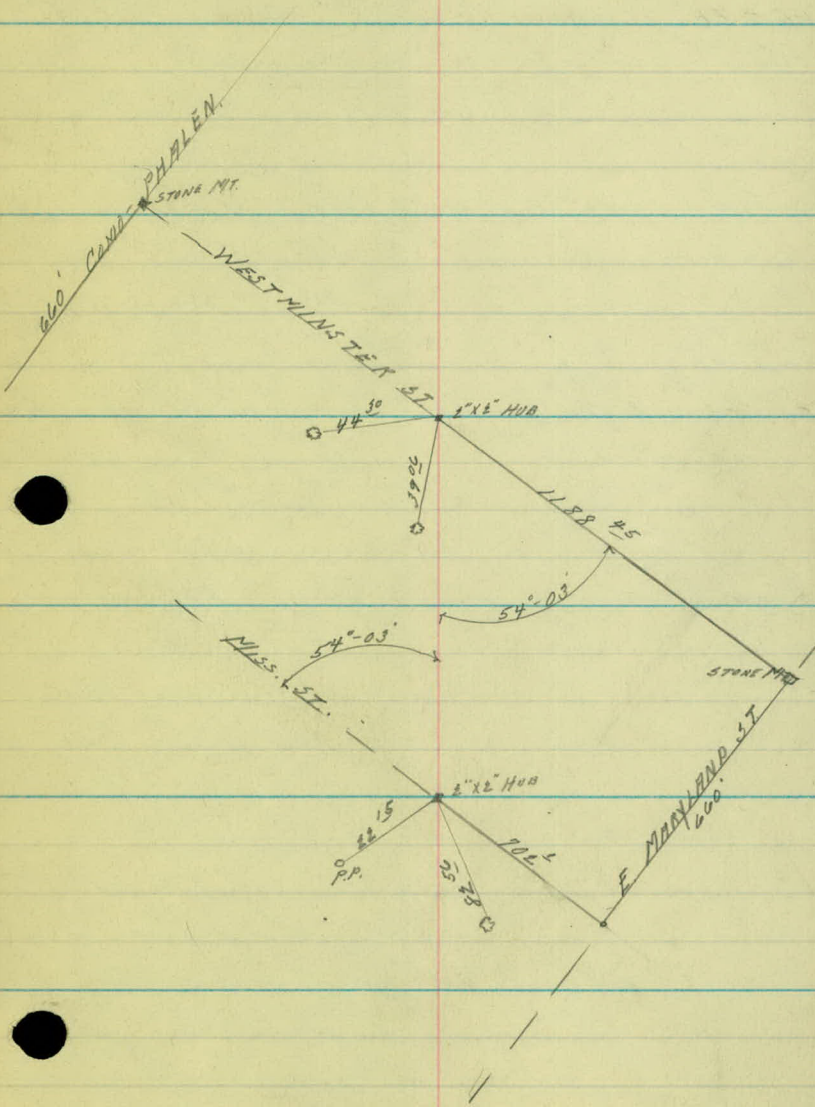

STA. POINT. Δ LT. Δ RT.

$$36 + 64^{\frac{2}{2}}$$


$$40 + 41^{\frac{2}{2}} \text{ P. I. } 11^{\circ} 50'$$


$$33 + 94^{\frac{4}{4}} \text{ P.O.T.}$$

$$33 + 18^{\frac{2}{2}} \text{ P.O.T.}$$

5-6-29

155.17
 431.50
 586.67

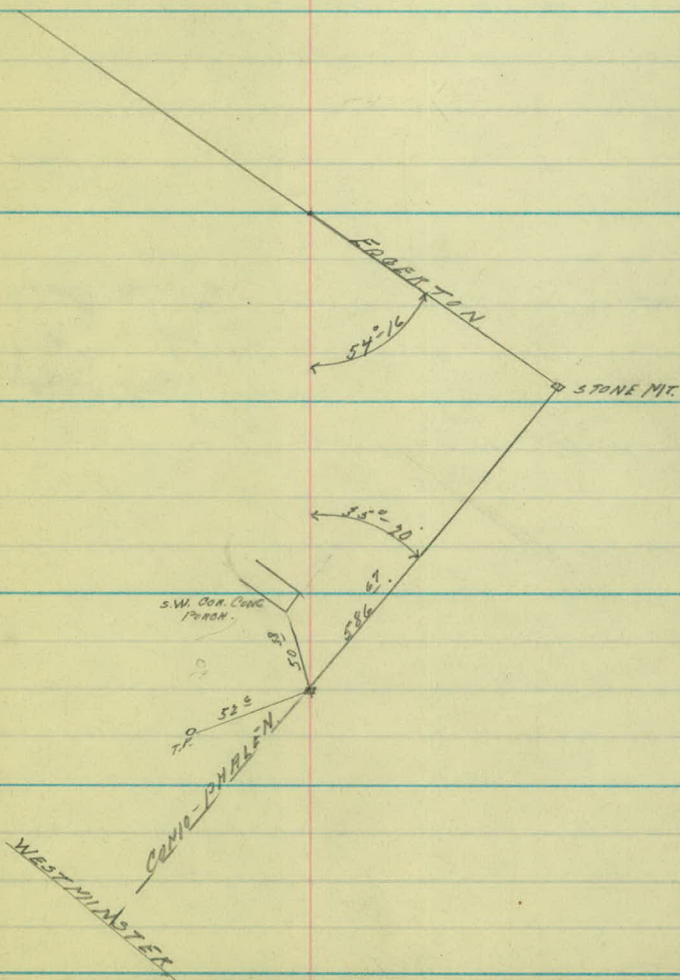

 

PAYNE AVE. CUT-OFF EXTENSION.

CENTER LINE LEVELS.

"A" LINE

STA.	+	H.I.	-	ROD.	ELEV.
13.M.	0.94	854.11			853.17
	1.10	841.58	13.63		840.48
	0.31	828.15	13.74		827.84
	0.49	815.11	13.53		814.62
	1.92	804.22	12.81		802.30
13.M.			3.02		801.20

-7+02'				2.1	802.1
-7+00				2.1	02.1
-6+85				2.2	02.0
-6+50				3.8	800.4
-6+00				4.6	799.6
-5+00				5.2	99.0
-4+00				4.7	799.5
-3+00				3.5	800.7
-2+00				2.6	01.6
	6.20	807.92	1.50		801.72
-1+00				6.0	01.9
0+00				4.8	03.1
13.M.	6.32	809.41	4.83		803.09
+16				6.4	03.0
+20				7.3	02.1
+41				7.0	802.4
+47				10.8	798.6
+48				10.8	798.6
+51				8.5	800.9
+00				7.9	01.5

SPK IN T.P. S.E. COR. INT. E. MARYLAND & WESTMINSTER.

SPK IN P.P. N.W. COR. INT. E. MARYLAND & MISS. ST.

CENTER LINE E. MARYLAND

SPK IN P.P. LT. STA. 0+00

STA	+	H.I. 809.41	-	ROD	ELEV
	+63			8.0	801.4
	+73			6.9	02.5
2+00				6.4	03.0
	+07			7.5	801.9
	+09			9.4	800.0
	+14			9.4	800.0
	+16			8.0	01.4
3+00				7.6	01.8
	+50			6.9	02.5
4+00				5.7	03.7
	+50			4.7	04.7
5+00				2.8	06.6
		9.57	816.78	2.20	807.21
	+50			7.6	09.2
6+00				5.0	11.8
	+50			4.5	12.5
7+00				4.6	12.2
	+50			5.8	11.0
	+77 ⁵	EDGE OF S. WALK		5.0	11.8
	+85	" " " "		5.0	11.8
8+00				5.9	10.9
	+17			4.9	11.9
	+36			5.8	11.0
	+52			5.1	11.7
9+00				5.5	11.3

5-8-29

STA	+	H.I. ✓ 816.78	-	ROD	ELEV.
+50				4.3	12.5
+75				4.5	12.3
+90				6.4	10.4
10 +00				6.6	10.2
+50				5.7	11.2
11 +00				3.8	13.0
+50				1.6	15.2
12 +00				0.3	16.8
		✓ 13.76 829.84	0.70	✓ 816.08	
+50				12.1	17.7
13 +00				10.6	19.2
+50				8.7	21.1
14 +00				1.7	28.1
		✓ 13.12 841.78	1.18	✓ 828.66	
+33				10.8	31.0
15 +00				12.2	29.6
+50				12.4	29.4
+88				10.7	31.1
+96				7.9	33.9
16 +00				7.9	33.9
+14				11.4	30.2
+33				8.1	33.7
B.M.			3.10		838.68
17 +00				6.9	34.9
		✓ 13.30 853.85	1.23	✓ 840.55	

5-8-29

SAX IN P.P. 65 RT 3TH. 15750

STA	+	H.I.	-	ROD	ELEV.
		853.85			
+50				11.4	44.3
18+00				0.7	53.8
		✓		✓	
	11.76	865.36	0.25	853.60	
+50				2.9	62.5
		✓		✓	
	4.47	869.47	0.36	865.00	
+76				2.1	67.5
19+00				1.9	67.6
+50				9.6	59.9
		✓		✓	
	0.76	859.27	11.96	857.51	
20+00				7.4	50.9
+50				11.8	46.5
13.M.			9.31		848.96
		✓		✓	
	4.04	848.98	13.33	844.94	
21+00				5.5	43.5
+37				5.3	43.7
22+00				2.7	46.3
+28				3.8	45.2
+50				6.5	42.5
		✓		✓	
	4.80	841.00	12.78	836.20	
23+00				8.1	37.9
+40				12.6	28.4
24+00				11.3	29.7
+28				10.3	30.7
+34				8.5	32.5
25+00				6.0	35.0

5-8-29

NAIL IN POST 5' LT. STA. 20+35

STATION	+	H.I.	-	ROD	ELEV.
		841.00			
+50				1.5	39.5
	12.91	853.28	0.63	840.37	
20+00				4.0	49.3
B.M.	3.04	853.25	3.04	850.24	850.21
+16				1.0	52.3
	13.25	866.14	0.36	852.89	
+50				10.4	55.7
27+00				7.1	59.0
+50				3.5	62.6
	11.60	877.36	0.38	865.76	
28+00				11.3	66.1
+50				7.2	68.2
29+00				8.1	69.2
+50				2.5	74.9
	15.31	890.45	0.22	877.14	
30+00				8.2	82.3
+50				5.9	84.6
31+00				0.1	90.4
	12.64	902.40	0.69	889.76	
+50				4.0	98.40
+75				2.7	99.7
32+00				3.5	98.9
+50				5.6	96.8
+93				0.3	02.4
	6.56	908.61	0.35	902.05	

5-8-29

24+00 B.M.

SPK IN T.P. 400' RT. STA 24+00.

ON STAKE

ON ROCK

STATION	+	H.I.	-	ROD.	ELEV.
		908.61			
33+00				3.2	05.4
+06				3.2	05.4
+15				5.6	02.0
+38				4.6	04.0
34+00				4.0	04.6
+23				5.7	02.9
+50				11.8	96.8
	6.67	902.63	12.65	895.96	
+77				12.6	90.0
35+00				12.5	90.1
+50				10.1	92.5
36+00				9.8	92.8
+25				6.6	96.0
+46				5.6	97.0
+50				3.6	99.0
+80				2.4	00.2
	11.82	914.24	0.21	902.42	
37+00				12.3	01.9
+08				13.1	01.1
+20				8.4	05.8
+38				8.6	05.6
+50				5.8	08.4
	7.90	921.51	0.63	913.61	
38+00				6.0	15.5
+27				3.7	17.8

ON ROCK.

STA.	+	H.I.	-	ROD	ELEV.
		921.51			
	+38			10.1	11.4
	+51			9.7	11.8
	+66			9.1	12.4
	+67			10.0	11.5
39	+00			8.0	13.5
	+18			7.9	13.6
	+20			7.2	14.3
	+34			6.5	15.0
	+44			6.1	15.4
	+50			5.3	16.2
40	+00			4.9	16.6
	+08			4.9	16.6
40	+41			4.6	16.9
13. N1.			1.64	917.87	919.87

5-8-29

TOP OF HYD S.W. COR INT. ERIENTON & NEVADA.

