


Book-52- Dr. 6

PLANS SURVEY

JORDAN CUTOFF

①

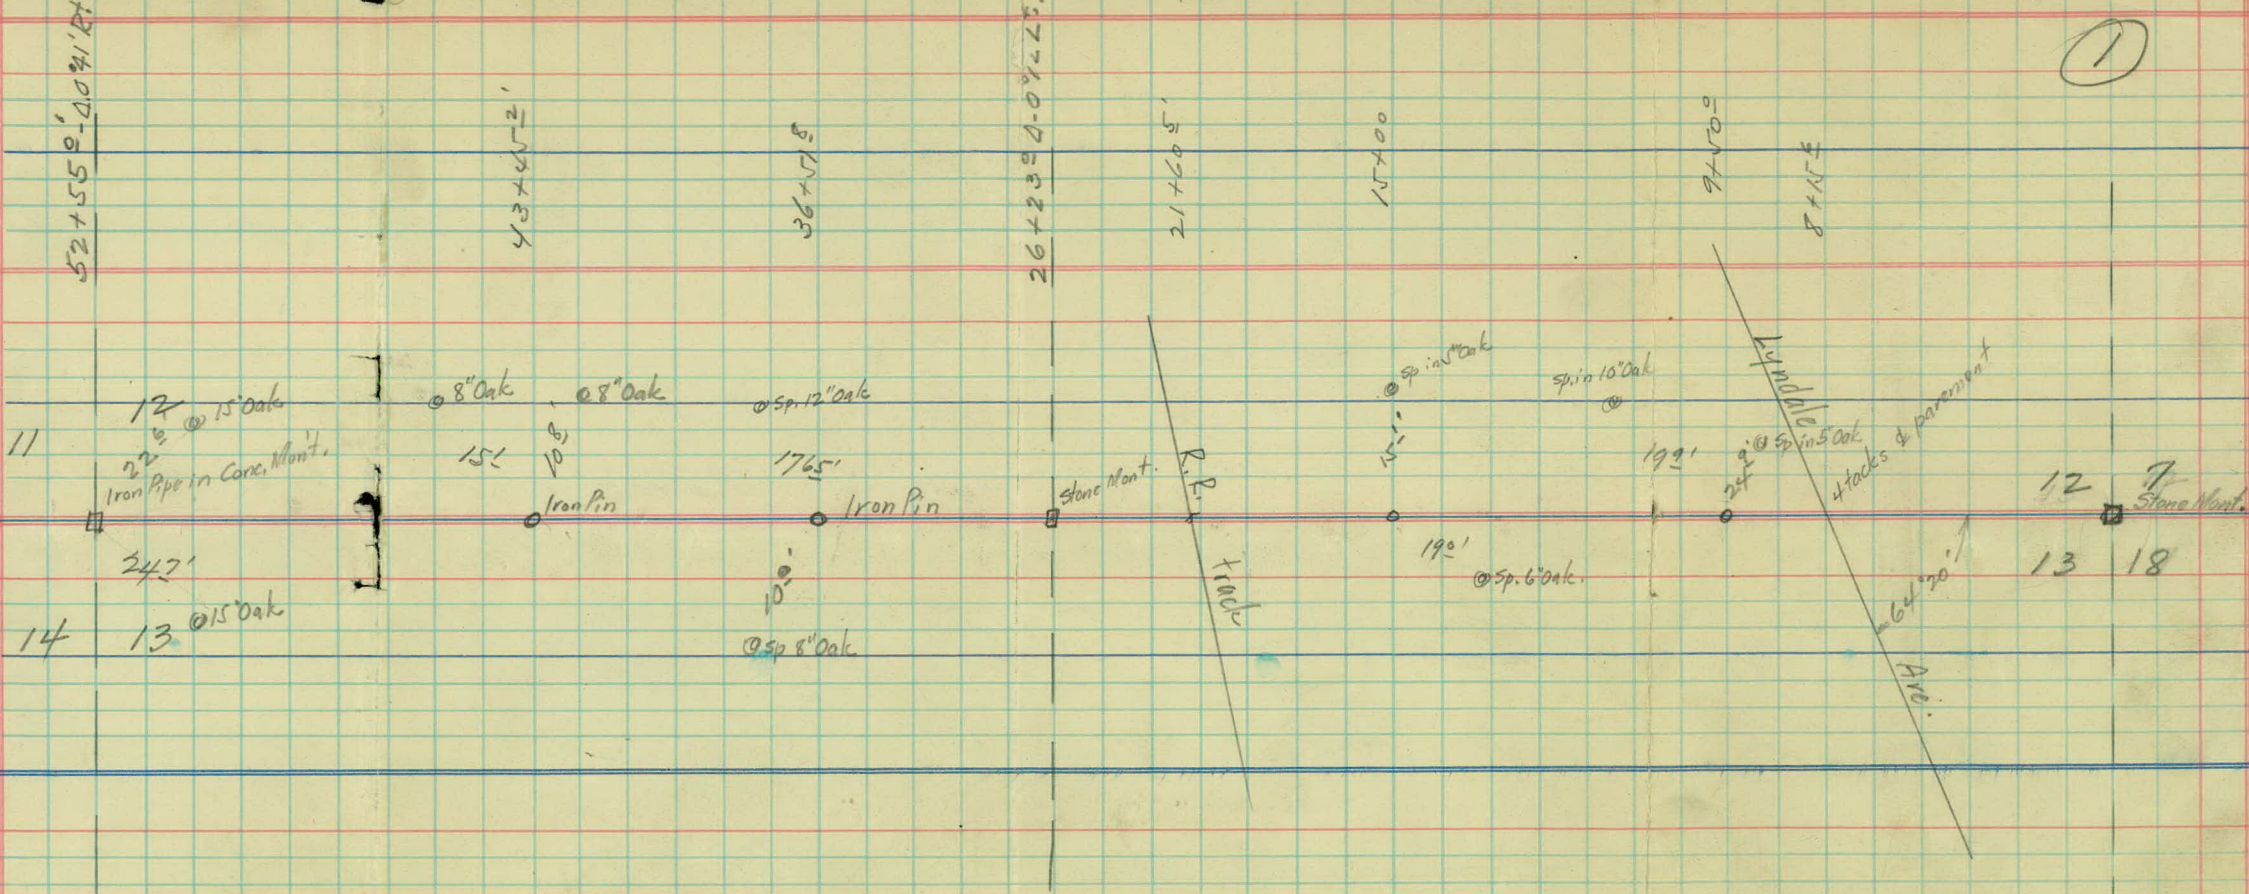

104 + 920
52 + 550
52 + 870

SCOTT Co.

10

15

DAKOTA Co.

11

Suppose to be Iron pipe
but was not located
by Dakota Co. in 4-12-26
used fence corner.

104+92.0

104+37- E of N+ S,

Road.

104+92.0
78+56.5
26+3.5

78+56.5 4-0'29'1/4

Stone Mont.

4'9"

F.P. 0

spike

17'

o F.P.

o 5" Oak

555'

o 1" Oak

5

o 3" Oak

67'

2 1/2

o 4" Oak

11

12

14

13

69+23.8


62+35.1

59+14.8

52+55.8

2

JORDAN CUT-OFF

 

Sta Point A Rt. Δ ht.

26+34³⁰ P.I. 0°-26'

10+50⁴⁷ P.O.T.

8+74²⁰ P.O.T.

1+62⁶⁰ P.O.T.

0+49⁴⁰ P.O.T. & Rd.

0+00

24 Point ΔR ΔL

58+25⁵² P.O.T.

55+26⁵² P.O.T.

52+34⁶⁵ P.I.

46+13⁸² P.O.T.

42+54⁸⁰ P.O.T.

36+66⁵⁰ P.O.T.

1/13/28

CWS.

D.P.

D.S.

A MC.

57²⁸

10" Oak

Iron Pin

39²⁸

14" Oak

F.P.

0

20¹⁰

Hub

10²¹

F.P.

12" Oak

24²¹ 16" Oak

22⁴⁹

Mont Iron pipe

4" Oak

6⁵²

6" Oak

5⁰⁰

2 pike

6" Stump

6" Oak

6⁵²

17

2¹⁸

Nail

2 pike

31⁴⁵

14" Oak

6.5' above Ground

8" Oak

Sta Point ART ALT

90+00 P.O.T.

83+30⁷⁵ P.O.T. E.R.R.


78+68⁵⁵ P.I. 0°-12"

76+83³⁰ P.O.T.

68+40¹⁰ P.O.T.

61+44²⁰ P.O.T.

1/13/28
CH. 3
D.P.
D.S.
A.M.C.

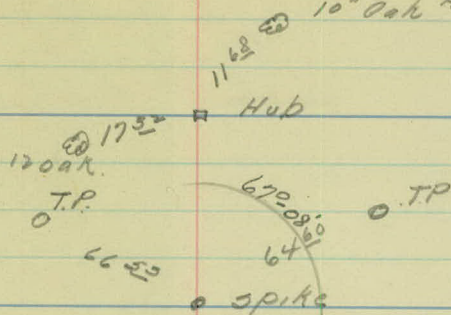


No Ties.

Mont.

No Ties

Iron Pin

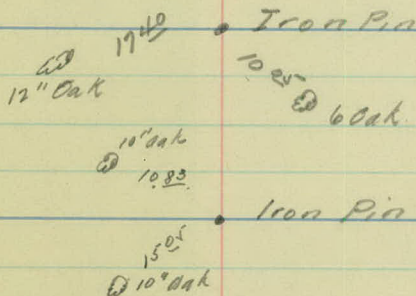

Sta	Point	Alt	Alt.
-----	-------	-----	------

118+00	P.O.T.		
--------	--------	--	--

108+50 ⁰	P.O.T.		
---------------------	--------	--	--



104+87 ²	PI		
---------------------	----	--	--

99+84 ³⁰	P.O.T.		
---------------------	--------	--	--

96+77 ⁰	P.T.	0°15"	E Pav.
--------------------	------	-------	--------

95+42 ²⁰	P.O.T.		
---------------------	--------	--	--

1/12/28
 C.W.S.
 D.P.
 D.S.
 A.M.C.

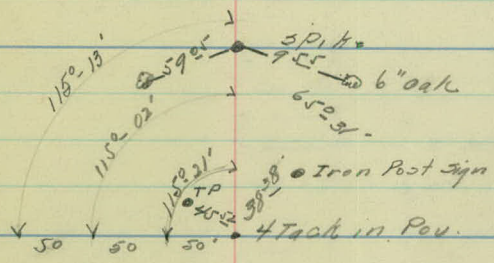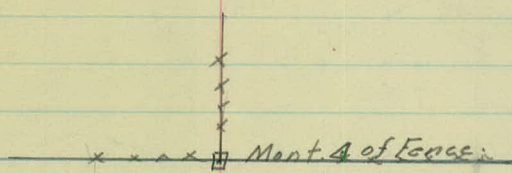

12" Oak
 @ 248'

198°
 @ 100' Oak.

