

Dr. 6 - BK. 89

OFFICE OF COUNTY ENGINEER
RAMSEY CO. MINN.

Property Survey

S.W. $\frac{1}{4}$ of the N.W. $\frac{1}{4}$ of the S.W. $\frac{1}{4}$

SEC. 14-29-23

From _____ To _____

Road Acc't. No. _____

Date Filed 1-6-36

File 6

10/3/35
H. Purcell

TRAVERSE
FOR
SW. 1/4 of the NW 1/4 of the SW. 1/4
SEC. 14 T 29 R 23

Sta	Bearing	Dist.	Latitude		Departure	
			N+	S-	E+	W-
A	East	657.27			657.27	
B	N 0° 29' 30" W	658.88	658.85			5.65
C	N 89° 53' 30" W	655.79		1.24		655.79
D	S 0° 22' E	659.95		659.91	4.22	
Totals		2631.89	660.09	659.94		
					661.49	661.44

Error in Lat. 0.15


" " Dep 0.05

Relative Error in Closure = $\frac{\sqrt{0.15^2 + 0.05^2}}{2631.89} = .000060 \pm$

SW 1/4 - NW 1/4 - SW 1/4
SEC 14 T 29 R 23

Co Rd #2

14

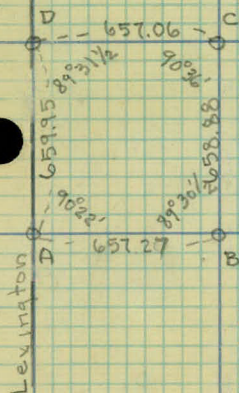

Larpenieur

