

Dr. 6 - BK. 97

OFFICE OF COUNTY ENGINEER
RAMSEY CO. MINN.

Misc'l Survey

KELLER GOLF COURSE

From To

Road Acc't. No.

Date Filed 1936

File B.97 D.6

Ties to Water Main
Kellar Golf Course

10+80.8


P.I

$\Delta 12^{\circ}-03' R.$

2+45 $\frac{1}{2}$ Service Rd.

0+00

Gate Valve.

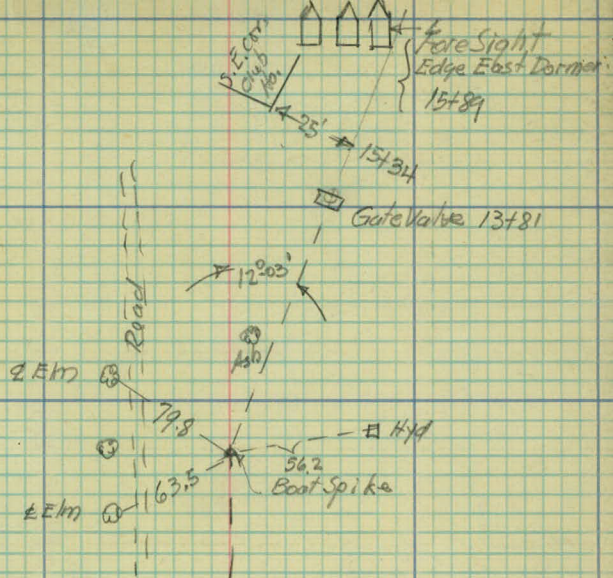

Water Main
To Barr

6+70 = 4" X 2" Tee

