

Dr. 8- BK. 10

*Surveys to determine encroachment
on Rice St. R/W. 7-16-29*

HRT TOROG FROM LNBP
FIVE TO CO ROAD "B"

3

2

1 + 62 BLDG. 48²

1 + 32 BLDG. 47² L.


1

7-16-21

1

2

2700

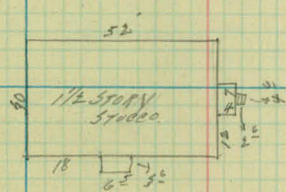

1700

2+00

1+00

1+00 EDGE OF PAVE 15¹

0+70 BLDG. 51²

0+46⁵ CONC BASE 37²

0+45 GAS PUMP 37²

0+40 GAS PUMP 38

3' V

0+38 CONC BASE 37² 3' WIDE 2' RAD AT EACH END

0+35 PORTABLE SIGN 37⁵

0+30 BLDG 51²

0+00

0+26 2' X 2' CONC BASE FOR AIR PUMP 57²

0+00 EDGE OF PAVE 15²


7-16-29

2

1400

4

1400

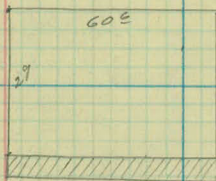

6' CONC. WALK.

1400

1400 RYE
STONE MT.

8+28 BLDG 44³

8+08 BLDG 44⁷

8+00

8+00 PAVE 15¹

7+68 BLDG 44⁸

7+18 BLDG 44⁹

7+ BLDG

7+07 GAR. 33⁵

7+00

7+00 PAVE 14²

6+89 GAR. 33⁵

6+00

7-16-29

3

4




POP STAND

1 STORY FRAME

8400

How was the
Chicken?

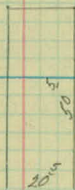

CHICKEN SHACK.

1 1/2 STORY
STUCCO.

7400



FRAME GYM

16+00 PAVE 15³

16+00 15+51 BLDG 36

15+47^c " 36

15+46^c " 32⁴

15+42^c " 29^c

15+38^c " 28⁵

15+34^c " 29⁵

15+31^c " 32²

15+30^c BLDG 36

15 15+11 BLDG 36


15+00^{PAVE} PAVE 15⁵

7-16-2


4


15

15

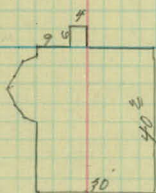

15

 


 

27+35 EDGE OF PAVE 13⁵

27+00 EDGE OF PAVE 13³

26+31⁷ EDGE OF PAVE 13⁵

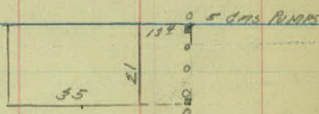

4 PORTABLE SIGNS IN FRONT OF GAS STR. 20' L.

26+35 END OF CURB 49⁵

27+05 CONC. BASE 44¹

26+74 CONC. BASE 44¹

26+64 - 1⁵ x 1⁵ CONC. BASE FOR AIR PUMP 68' LT.

26+99 BLOC 45⁵

26+78. BLOC. 45⁵

26+90⁵ CENTER OF CONC. BASE 33⁵

26+80 CENTER OF CONC. BASE 33⁵


3' x 16'

LOAD. AT EACH END.

7-16-29

5

1 STORY STUCCO.

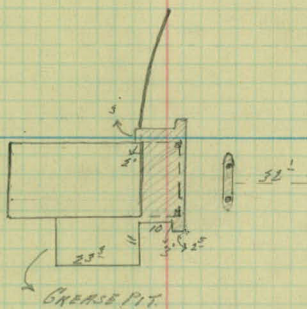

Co. ROAD 17² STONE MT.
267317

✓ 31+21 EDGE OF PAVE 12

31+21 CONC BASE 51⁴

31+11 CONC BASE 22³

✓ 31+09 BLDG 46⁵

31+06 1'x1' WOODEN PILLAR 33⁵

31 31+03 CENTER OF GAS PUMP 34⁴

30+96 PORTABLE SIGN 21

30+98 CENTER OF GAS PUMP 34⁴

30+89 CONC BASE 47

30+93 CONC BASE 23

31+00 EDGE OF PAVE 11⁸

30+93 CONC BASE 35²

✓ 30+77 BLDG 47¹

30+95 1'x1' WOODEN PILLAR
33² TO FACE OF PILLAR

30+78 GAS PUMP 49⁵

30+60 CONC BASE 25⁶

30+57 AIR PUMP 23¹

30+56 CONC BASE 21⁶

30+59 OIL TACK 26⁵


30 ✓ 30+39 EDGE OF PAVE 12⁰

30+00 EDGE OF PAVE 12⁰

7-16-25

9

52

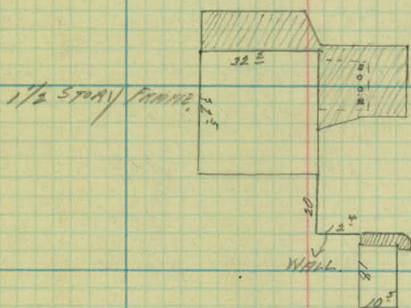

5/

30

33

✓ 32+00 EDGE OF PAVE 12'

✓ 32+06 GAS VALVE 31^E

✓ 32+04 AIR SIGN 28⁹

✓ 32+04 BLDG 36

✓ 32+04 CONC BASE 27⁷

✓ 32+02 CENTER IF GAS PUMP 29^E

32 ✓ 31+92 CENTER IF GAS PUMP 29^E

✓ 31+89 CENTER OF LIGHT POLE 29⁵

✓ 31+83 CENTER IF GAS PUMP 29^E

✓ 31+78 BLDG 35³

✓ 31+71 CONC BASE 27³

✓ 31+70 GAS VALVE 35^E

✓ 31+70 PORTABLE SIGN 29

✓ 31+59 " " 35

31 ✓ 31+00 EDGE OF PAVE 12'


7-16-29

Co. KOPP B
STONE MT.

53


4

32

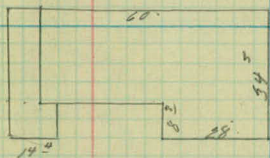

2 STORY FRAME

31

 

8-30-28

MONT.

DALL ST.

WEST

1700

755 PORTABLE SIGN 27' LT.

759 CENTER OF
AIR PUMP 3 1/2' LT.

← CONC. BASE
18" DIAMETER
1 1/2' ABOVE GROUND

734 4" PIPE FOR FLOOD LIGHT 24' LT.

0700

MONT.

RICE ST.

0747 CENTER 5' SIGN 28' LT.

0741 - CENTER OF 5'
SIGN 28' LT.

Co. Road A =

