

Dr 8. Bk 128

OFFICE OF COUNTY ENGINEER
RAMSEY CO. MINN.

.....Survey

AUDITORS SUB. #89

From Sec. 6-30-29 To

Road Acc't. No.

Date Filed

File

AUDITORS SUBDIVISION No. 89


SEC. 6-30-29

2- Pages


H. G. Parker
4/22/38


Found all ments with exceptions of the
 S. $\frac{1}{4}$ - $\frac{1}{4}$ Cor and the S.W. Cor Sec. 6. Est S.W. Cor Sec. 6
 by measuring 170' N. in a straight line with M.G.
 and W. $\frac{1}{4}$ Cor Sec. 7 and placed a 2" x 2" hub.

In est. prop line of Highway U.S. 10 used R. of
 pay.

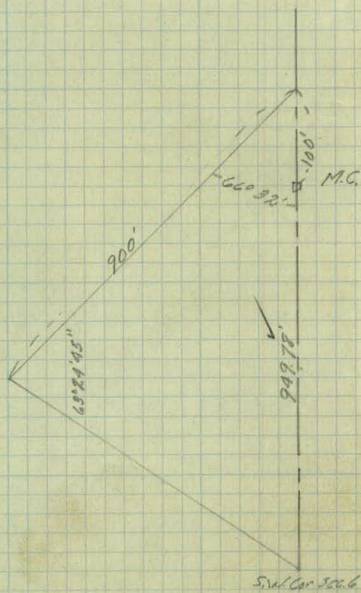


2

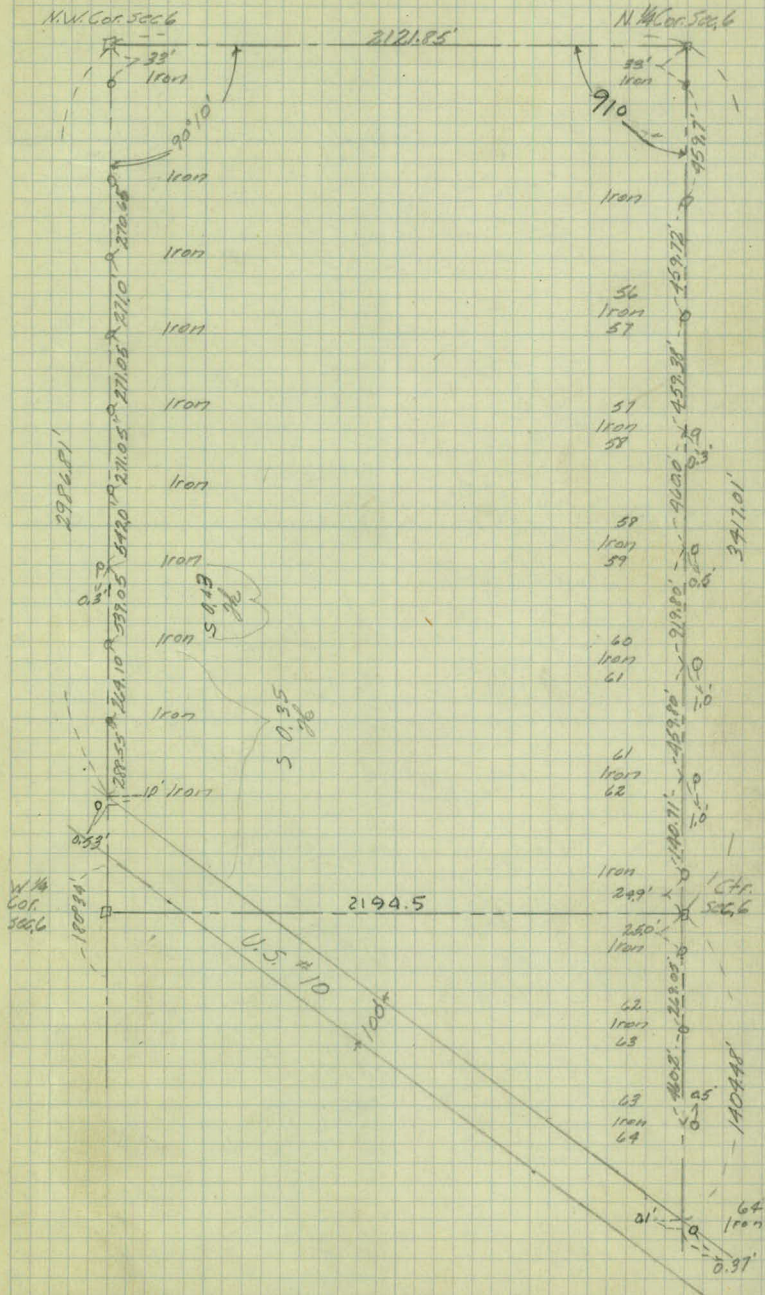

 



 

2981.81
373.88
3490.19

Section 6 - T30 N - R23 W
Moundsview Township

Check of distance from
center of section to West
 $\frac{1}{4}$ Cor. and traverse line
locating that portion of
Wood Lake in S.W. $\frac{1}{4}$ of
this section



H. Bratger

H. Wilke H. chain

L. Goldberg R. chain

A. Moeschter R. chain

5/21/38

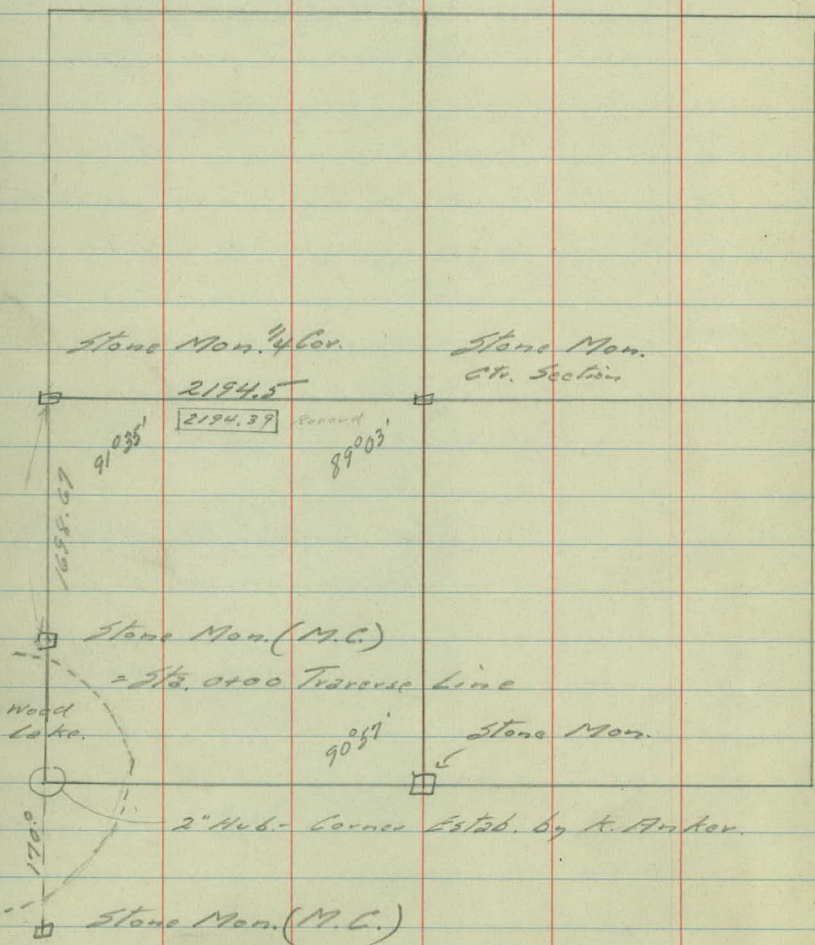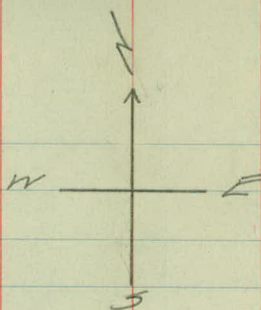

Traverse line Sta 0+00 = M.C.
1698.67 ft. So. of W. $\frac{1}{4}$ Cor.
Traverse left from above Two
Monuments as base line.

Angle.

Sta. Point Lt. Rt.

To Close M.C.
Sta. 0+00

24+23.65 P.I. 104°12' (M.C.)

16+00 P.I. 59°37'

10+26.4 P.I. 85°14'

0+00 P.I. 69°03' (M.C.)

3 1/2

2" Hub.
S.W. Cor. Sec. 6
Etab. by
K Anker.

Stone Men. (M.C.) Sta 24+23.5

170°
76° 01' 1"

8.0

Present Water
Line.

WOOD
LAKE

Transverse Line

120° 41'

X-sec. Line 300

200

100


0

P.I. 16+49.9

P.I. Sta 16+00


West. ↑

S 1/4 Cor. Sec. 6. Stone Men.

 

Closure.

$$\begin{array}{r}
 180^{\circ} 00' \\
 \underline{69^{\circ} 03'} \\
 110^{\circ} 57' \\
 85^{\circ} 14' \\
 59^{\circ} 37' \\
 \underline{104^{\circ} 12'} \\
 360^{\circ} 00'
 \end{array}$$

 

7+00

50 37

4

Present Shore line

6+00

50 35

Probable High
Water Line

5+00

35 40

WOOD
LAKE

4+00

25 51

3+00

15 68

2+00

83


1+00


115


Section line


0+00


M.C.

 

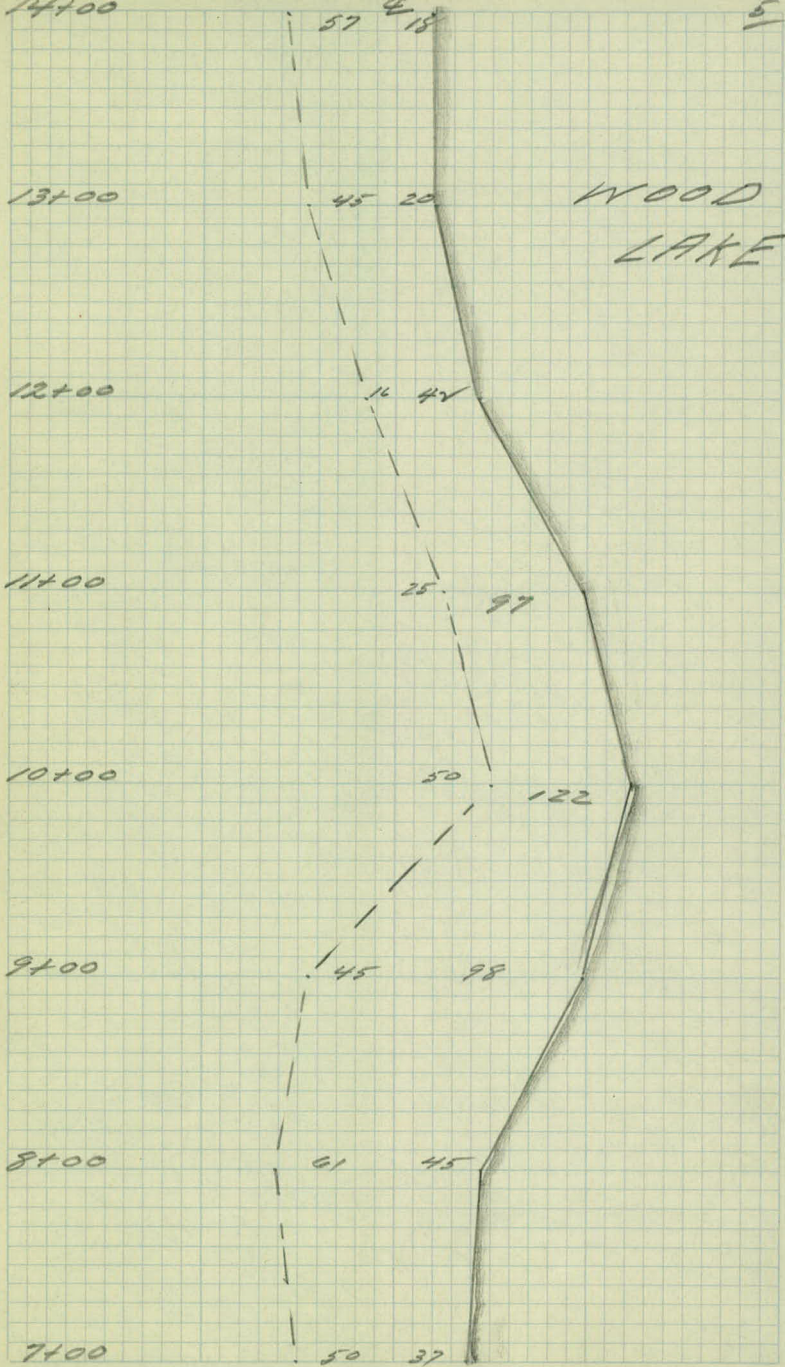

 

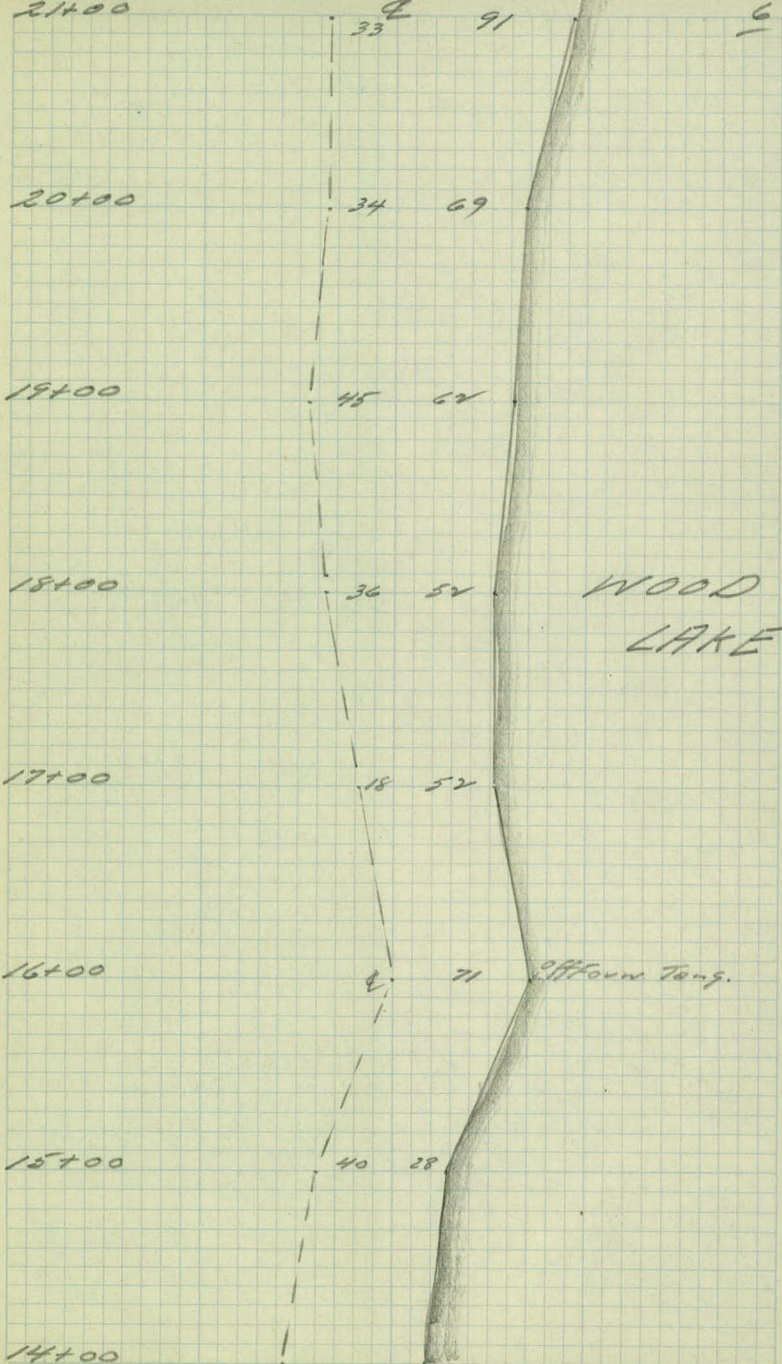

 

2

2

