

Dr. 8 - BK 134

OFFICE OF COUNTY ENGINEER
RAMSEY CO. MINN.

Beautification Survey

Co. Rd. "B"

Near S.T.H. #61 To
From

Road Acc't. No.

Date Filed

File

Plan Survey


St. Fr. Hy #61 near Co. Rd "B"

2/2/38

Plotted by G.D.C.
3-15-38

Angle

Sta. Point Rt. Lt.

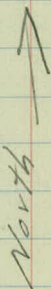

2+148 P.T.


$D = 15^{\circ} 2'$ Lt.

$D = 7^{\circ}$

$T = 108.1$

$L = 214.8$

0+00 = 73+62.3 P.C. (See Map Highway Dept
betw. St. Paul & White Bear. S.P. 1-52
our File T-27)

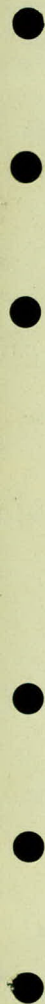


7
6
5
4
3
2
1
0

+ 65 Cross Drain 96' 18" Conc Pipe Rt. Side
24" C.M. Left Side

7405 Undergr. Cntr. Drive


4. P. Plans 8" Spaced 15'

North
 +68 Roper Box
 +55 Mail Box
 +53 Mail Box
 12 Safflower
 80 AS
 PL 10"

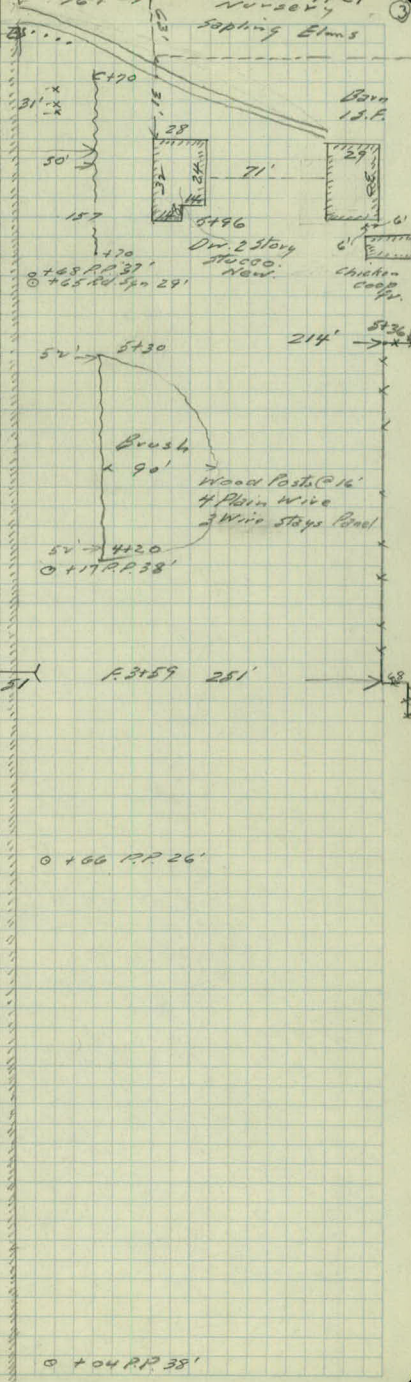

2. To Hy #61 = 24' End to End.

0 + 04 RP 38'

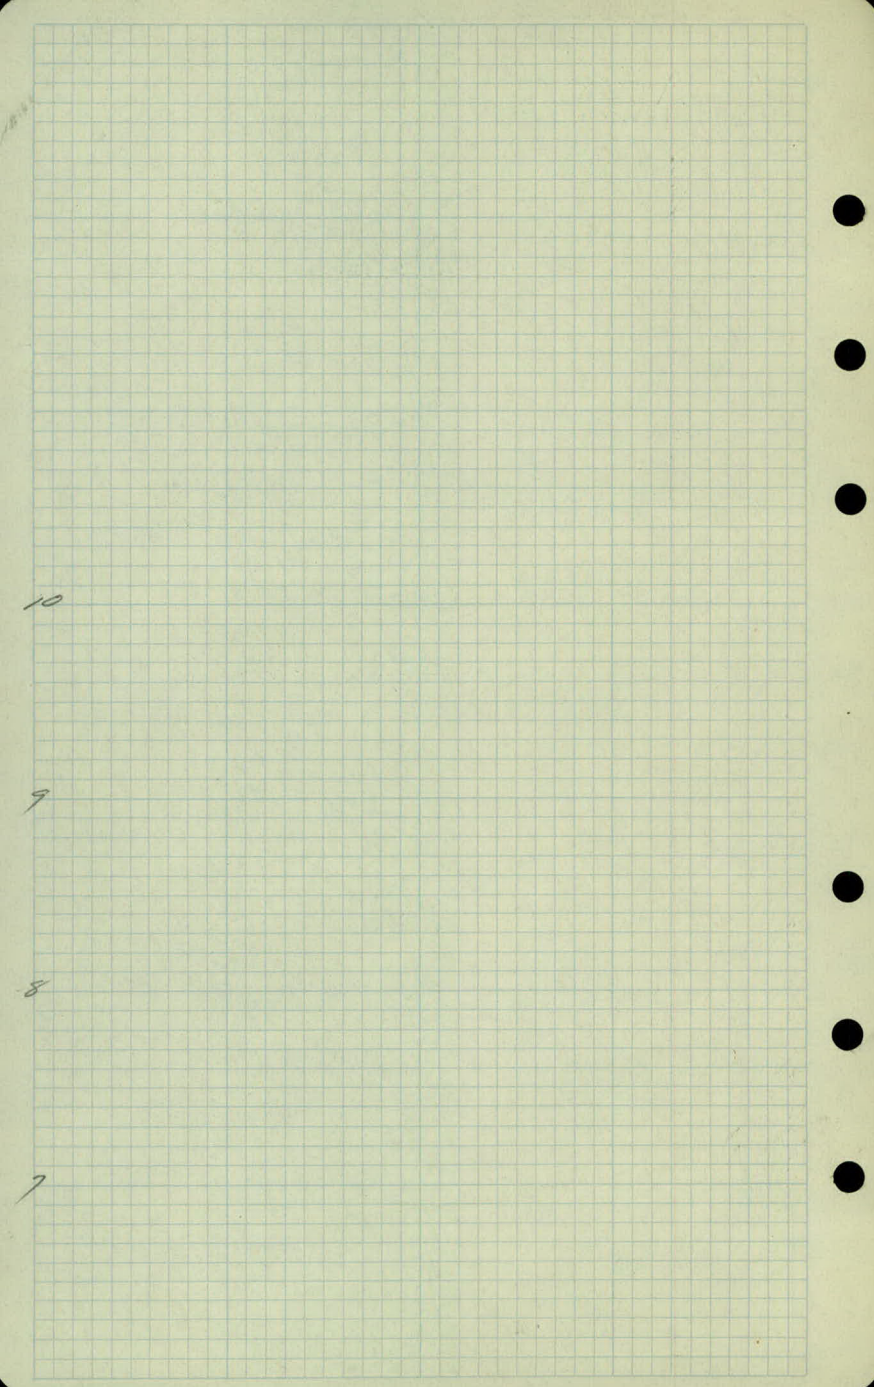

30' 0" + 20 Mail Box

39' 0" + 26 P.P. & Ave Light.

Abandoned
Dr. Fdn.

38'
26'


37'

+46

Great Lakes
Pipe Line Ring
2 - 6" Lines

+66

3 + 21 P.P. 37' 8" 22'

 

North ↑

2+14.8 P.T.

15'00"

P.T. 1+08

62'10"

"A" - Approx. Co. Rd. "B"


Base

0+00

33.3

0+00

P.C.

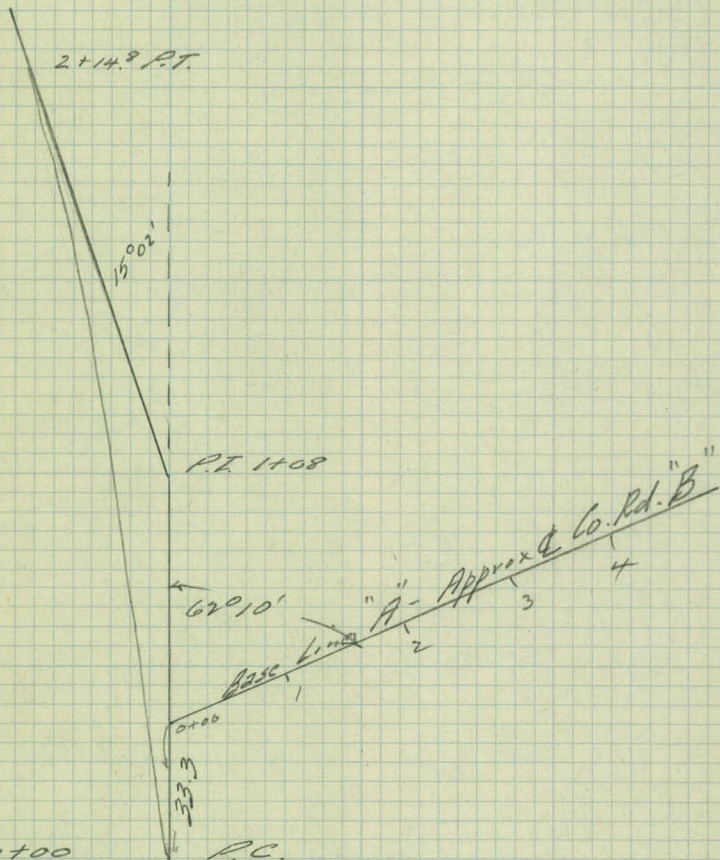

Base Line "17"

Shoulder

Shoulder.

4

15'

15'

+65 = Dwelling 15-Ft.

+33 Garage - Frame
For Papered Shack

3

15'

15'

+57 Chicken Coop.
Frame For Paper
Shack

+39

24" x 55' Cone Pipe #15-63


2


12'

12'

1

0+00

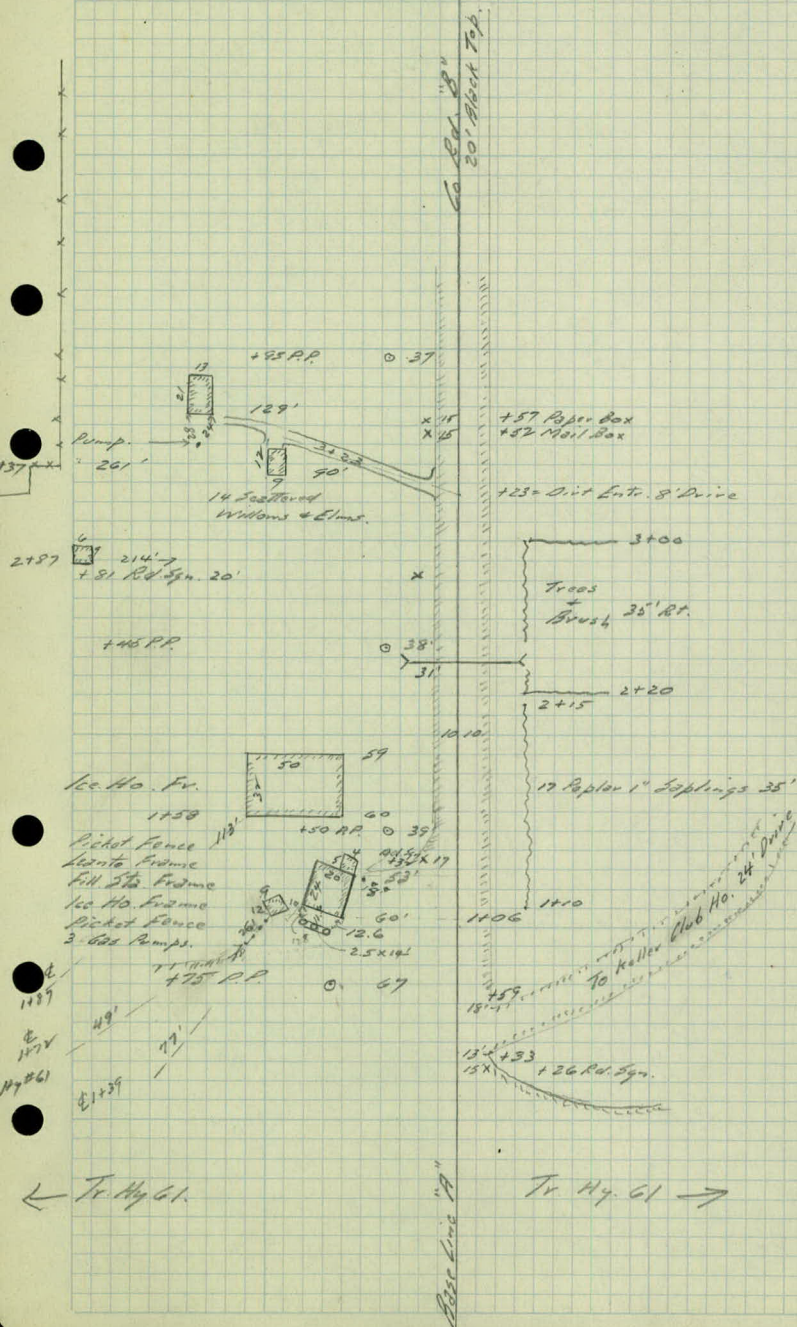

 

2
Plan Survey

St. Tr. Hy. #61 near Co. Rd. "B"

Preliminary cross-section

2/2/58

Sta.	+	π	-	Elev.
B.M.	10.66	875.04		864.38
T.P.	7.73	879.81	2.96	872.08
B.M.	5.13	875.52	9.42	870.39

0+00 71.2

0+50 70.2

Section thru Base line "A" - Co. Rd "B"

Culvert 2+39 Base line "A"

1+00 69.5

1+25 69.1

1+50 68.7

T.P.	1.62	872.01	5.13	870.39
------	------	--------	------	--------

Spike in 16" Oak near So. end Keller Lake Island.

Top of 5s and Conc. oil pump platform @ Filling St.

[illegible]

10.4	6.69.1	6.69.5	70.5

Filling 5th Floor

Gas Pump B25C

[illegible]

Sta.	+	π	-	Elev.
		872.01		

2+00				68.1
------	--	--	--	------

+50				67.4
-----	--	--	--	------

3+00				67.0
------	--	--	--	------

+50				66.7
-----	--	--	--	------

+65 Cross Drain

4				66.6
---	--	--	--	------

+50				66.6
-----	--	--	--	------

5				66.4
---	--	--	--	------

T.P.	11.75	879.58	4.18	867.83
------	-------	--------	------	--------

+50				66.7
-----	--	--	--	------

6				66.8
---	--	--	--	------

T.P.	11.84	879.65	11.75	867.83
------	-------	--------	-------	--------

+50				
-----	--	--	--	--

Sta. + π - Elev.

878.65

7+00

67.3

T.P.

13.16

880.26

12.55

867.10

+50

67.4

8+00

67.7

+50

68.2

9+00

68.8

+50

69.5

10+00

T.P.

5.27

873.10

12.43

867.83

T.P.

6.92

879.72

0.30

872.80

T.P.

2.79

868.70

13.81

865.91

B.M.

4.31


864.39

864.38

10	70.0	69.5	68.8	68.2	67.7	67.4	12.4
3		108	115	121	126	129	
12	69.9	69.3	68.5	67.9	67.2	67.1	12.7
4		110	118	124	131	134	
34	70.2	69.8	69.2	68.0	67.5	67.4	36
		105	111	123	128	129	46
		42	50	54	51	51	143



 

1
Co. Rd. "B"

TH #61 to White Bear Ave.

Locating:

~~Traveled Roadway~~

Entrances

Streets

Rec. 7/18/52

Drawn up

- Sta
0+00 E of old STH. #61 Regraded
+30 Beginning of Bl. Top
+50 Keller course Ent 50' wide
Right
+65 Beginning Service sta Ent. Lt.
1+25 End Ser. sta. Ent. Lt.
+75 Ent Left
3+36 Ent Left Conc 13' Left
4+12 Ent Right
4+94 Ent Left
5+17 Ent Left
7+53 E 18' street Right
8+26 Ent Left
9+10 Ent Left

15 July 1952

Kvidera
Moeschter
Clark
Benson

2

Sta

9+50 18' Ent Right

10+08 Ent Left

10+48 Ent Right

10+71 40' Ent Left or double

11+91 Ent Right

13+74 Ent Right 20' Ent

14+63 16' Ent Right

15+55 Φ Street R & L 24' wide


17+22 Double Ent Left 25' wide

18+39 Ent Left

18+47 Ent Right

19+20 Conc Ent 16' Left

Ent around Pole

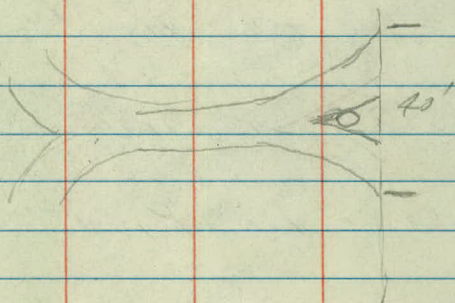

Sta

22+13 E Street R & Left 24'

23+33 Ent Right

24+29 Ent Right

25+59 Ent Right

25+96 Ent Right

28+80 E Street R & L English

2 E Birmingham North

Ent Rt across from Birmingham

51+38' Ent Right

51+38' Ent Left

52+38' Ent Right

54+94' Ent Right

Sta



55+95 Ent Right

64+26 Ent Right

65+35 Ent Left

68+12 Ent Right

72+12 Ent Left

72+28 Ent Right

73+36 $\frac{1}{2}$ Street Left

75+06 Ent Left


76+70 Ent Left

76+95 Ent Right

78+78 Ent Left

79+25 $\frac{1}{2}$ Prosperity Ave

5

 

sta



81+57 Ent Right

83+74 Ent Right

83+94 Ent Right

84+81 Ent Right

94+88 Ent Left

