

Dr. 8 - Bk. 164

OFFICE OF COUNTY ENGINEER
RAMSEY CO. MINN.

..... PLAN Survey

..... EAST AVENUE

From Minnehaha St to Maryland St.

Add Stillwater Rd. Conn. 1946

Road Acc't. No.

te Filed.

File.

LAKEWOOD DRIVE Profile 1960


Plan Survey

East Avenue from Minnehaha St.
to Intersection with North
Line of Section 25, or
Maryland St.

12/28.

{ Bratager
Wilke
Goldberg
Moeschter

New Canada Township
Section 25

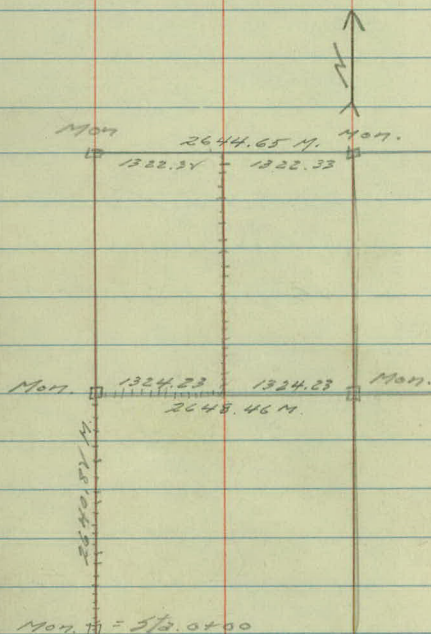

Alignment


Angle

Sta.	Point	Lt.	Rt.	Defl.
------	-------	-----	-----	-------

26+40 ⁸²	P.I.			
---------------------	------	--	--	--

0+00	Mon.			
------	------	--	--	--

Reference Points

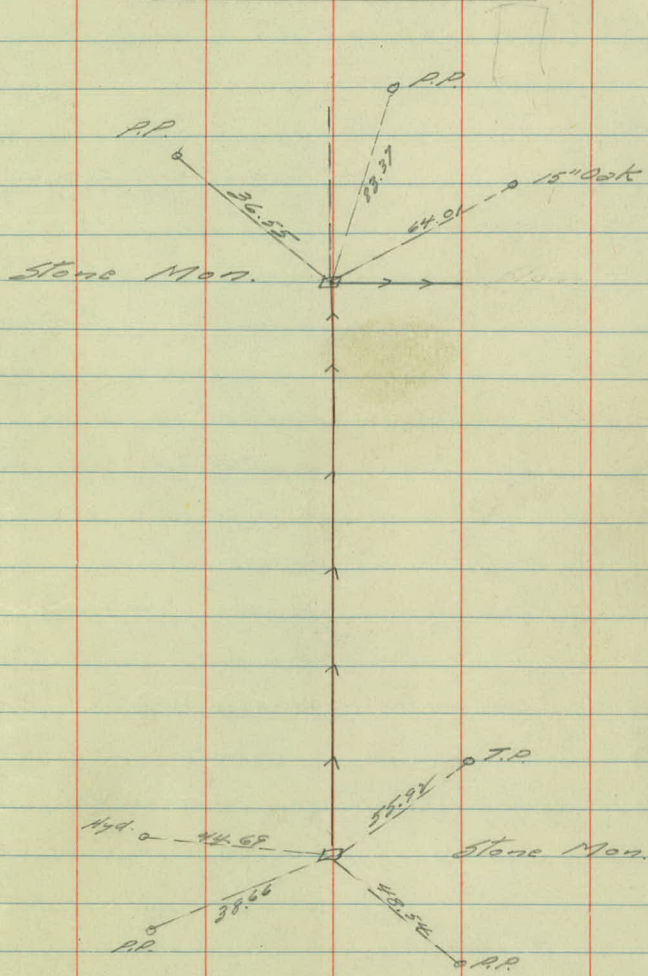


Angle

Sta.	Point	Lt.	Rt.	Defl.
+				
40+79.81	P.T.			44°32'
+50				40°21½'
40				33°21½'
39+65.05	P.I.	89°04'		D=22°00'
				T=203.34
+50				26°21½' L=318.10
39				19°21½'
+50				13°21½'
38				5°21½'
37+61.71	P.C.			

Reference Points



4

(Spike)

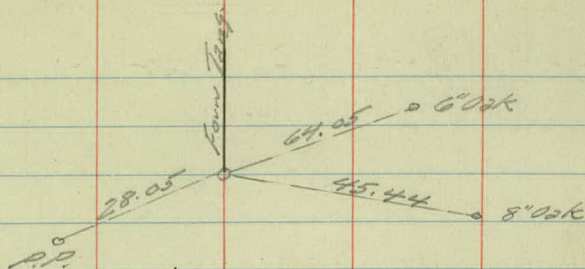

1/4 1/4 line

(Spike)

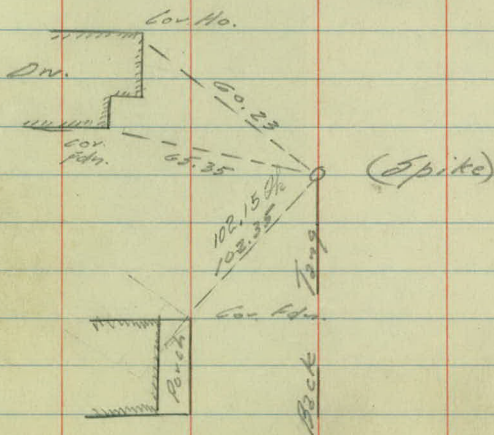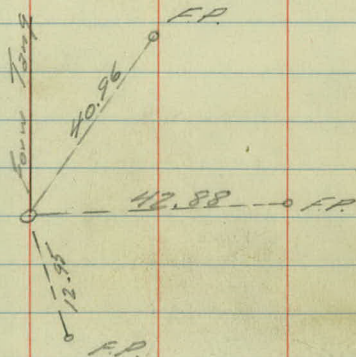



Angle.

Sta. Point Lt. Rt.

65+18.75 P.I. $90^{\circ}54'$

Reference Points

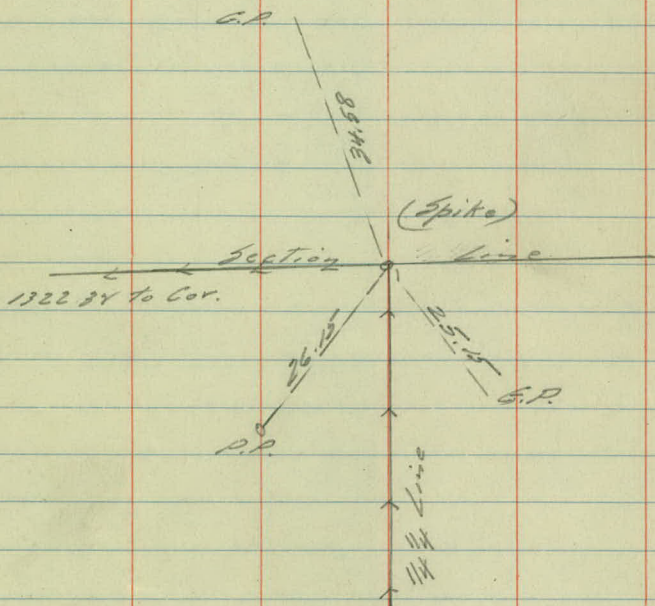


 

Artificial Topography

Back to
Limit
11 9

3

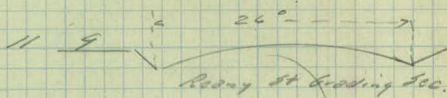

2

12 10

1

14 10

Rubble Gutter Section



0+00

Scattered Trees

+32 Approx of Heavy St.
+30 M.H. 30' Lt.

25' Spd.
37.00

+98 Rd 397 19°

+73 P.P. 21

+63 Approx of Alley

+52 = 15' x 24' C.M. 23'

170 P.P. 23

+57 End of No. 18°

+35 Rd. 394 22

+34 P.P. 23

0131 6th Basin to face 18°

+30 2

6" Conc Walk

Bl'd. +18 2

Conc.

0120 Hyd. 39°

25' Fr.
+84 On. 64°
10' Dist. Entr.
3458 = Combination
10' 4' 15" x 34' C.M. 22

3400 Fr. 26° 22'
Entr. to Lock Dr.
18' 6" 18°
32 10' 6" 83
N 1/2 S. Fr. Dr.
33 = Comb. 12' 4' 15"
x 68' C.M. 22°

1487 Fr. 31° 2'
1487 Rap from 30°

Back yard
Excav. in
Hillside

Black top Area
15' Story Stucco

155' Bl. 27° 34°
184' Bl. 27° 34°
25' 500
182
Pumps
18' x 24' C.M.

51' 11' 10°
10°
1/2 Rad.

+42 M.H. 24' 6" 24° Dr. in
+50 P.P. 26
+45 Rd. 394 21

59' 58"
53' 12"
9°
35'

Minnehaha St.

Note: Orig paving covered
with Blacktop.

+44' R. Radius 72' Lt.
134' Edge Paving 28' Lt.
+163 Edge Paving 4
+10' R. Radius 26' Lt.

Black 100
9 9

11

9 7

10

10 10

9

10 10

8

10 10

7

10 10

6

9 9

5

FC 35

+43 P.P. 22

FC 35

+05 P.P. 25

FC 35

+154 2

+67 P.P. 23

+39 P.P. 22

+03 P.P. 22

+94 Approx. Alley


12' Dirt Entr.

+08 P.P. 20

Pasture

Cultivated

Scattered Trees & Bush

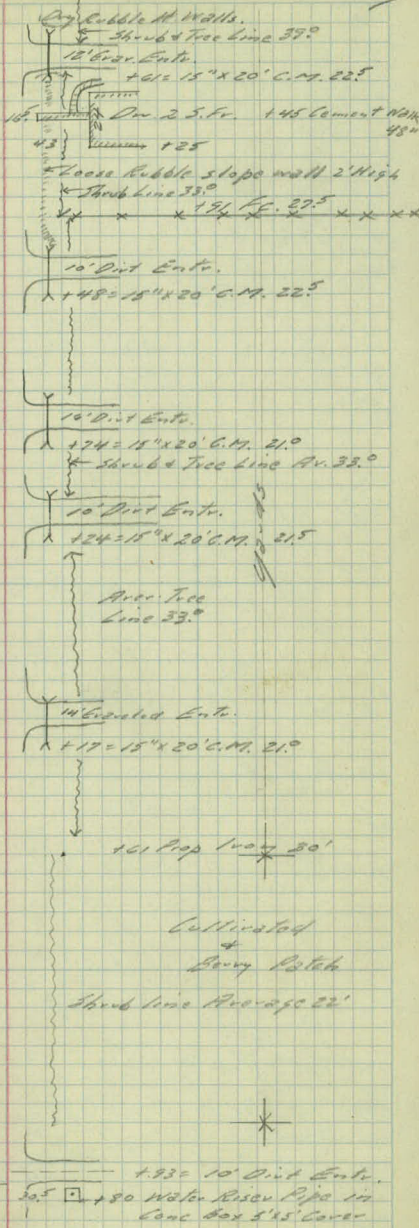

40-15

18

Backtop.
10 9

17

10 8

16

10 8

15

10 8

14

10 8

13

10 9

12

9 9

11

Ec. 34

Ec. 30°

1

+99PP.29

Ec. 34

Ec. 30°

+68PP.29

+139PP.29

Ec. 34

+10PP.28

Ec. 35

+154PP.29

End in Pasture

End in Cultivation

+13 Rd. 594.18

Dry Rubble Hood Walk. +24 Ec. 30°
Dirt Entr.

+08 = 15' x 20' c. r. 235

Tree Line 35'

Dry Rubble H. walls. +22 Ec. 28°
14' Dirt Entr.

+15 = 15' x 20' c. r. 32

155 = 2 Prop. Irons

27 28' 230'

Tree + Shrub Line @ 39°

yards

25

Blacktop.
12 7

24

9 7

23

8 9

22

7 9

21

8 10

+26

8 16

20

+50

12 11

19

10 9

18

+110 P.P. 29 -

FC 34 -

FC 30.

+41 Rd. 34m 14'

+46 Rd. 34m 15'

FC 34.

+83 P.P. 29 -

FC 30.

+55 P.P. 29 -

+24 = 18" x 66' C.M.

FC 35.

FC 34.

+35 P.P. 29.

+22 Hydrant 12"

+115 Edge Paving -

+885 Edge Paving -

+87 P.P. 34.

+855 Edge Paving -

+65 Fe. Cor. 36 -

+89 P.P. 29 -

+27 P.P. 30 -

+26 Bl. Top. +10 Rd. 34m 34'

+10 Fe. Cor. 35.0 -

20x12 Culvert 29'

15" x 62' Conc.

Conc. H. Rd. 12" x 4' x 6' Hi.

+41 End. Fe. 30.0 -

71.31'

Conc. Paved Hy.

Postline

Postline

Postline

Postline

Postline

Black Top.

25

27

9 11

26



12 16

25


+ 87 = 12" x 20' C.M. 15.0
 + 61 = 8" Elm 26.
 + 30 = 6" 1/2 34.89
 + 30 Dm. 66.0


+ 81 = 6" Elm wood 27.
 27
 + 80 B.C. 42.0
 + 82 = 4" Elm 29.
 + 93 = 12" Oak 39.

+ 61 End. Fc. 21.0

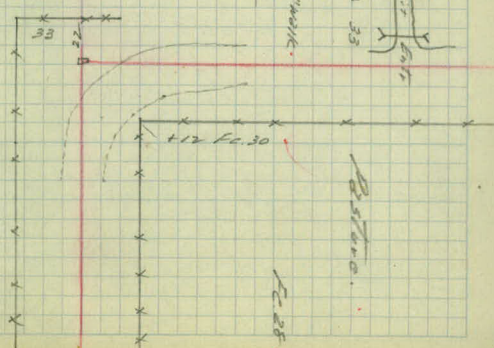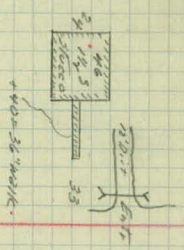

+ 25 Bl. Top 41.24
 + 15 Bl. Top 28.24
 Fc. 34

 

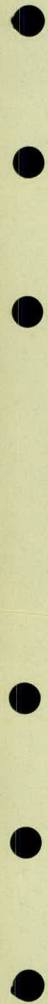

33

Rd
10-9

32

Rd
9-10

31

Rd
9-10

30

Rd
10-9

29

Rd
10-9

28

Rd
10-9

+10 Ent -



Yards

+54 Garage 87'

+27 1/2" Oak 36' 37'

+00 House 79' 1500'

Fe 38'

+91 TP&PP 21'

+85 12" Oak 19'

Woods

Fe 39'

+21 TP&PP 21'

Fe 35'

Cultivated

+61 Rd Sign 14'

+51 TP&PP 22'

+15 Bay Woods 40'

Fe 38'

+25 End Berry Patch 29'

Fe 31'

Pasture

+00 Berry Patch 29'

Fe 29'

40

Rd
15-5

39

Rd
13-9

38

Rd
11-10

37

Rd
10-10

36

Rd
10-10

35

Rd
9-10

34

Rd
9-10

0.533"

17

Sea Handed Oaks
+ Stumps
150 Fc 16'

Fc 33'

+90 Bay Woods 35'

- +76 Prop Iron
- +63 T.P.P.P. 23'
- +44 12" Tree 31'
- +17 6" Tree 22'

- +52 6" Tree 30'
- +50 End E 30'
- +40 6" Tree 27'
- +24 10" Tree 23'

Woods

Fc 23'

Cultivated

- +48 Fc Cor 26' + End Yard
- +29 12" Tree 22'
- +18 15" Tree 40'

Yard

+60 End Woods
+50 Fc 43'

+24 X Drain
15' x 38' CM
18' RT

Fc 31'

- +79 15" Tree 40'
- +58 House 59'
- +48 T.P.P.P. 18'
- +38 Ent 12' x 18' CM 13'

1 1/2 Story
Frame
43'

- +27 End Row Trees 17'
- +15 Ent 12' x 16' CM 14'

- +90 15" Tree 24'
- +72 12" Tree 30'
- +61 Ent 12' x 6" CM 14'
- +51 House 28'

Small
Trees 17'

1 1/2 Story
Frame
34'

- +32 Bay Row 2" Trees 19'
- +28 T.P.P.P. 19'

Woods
+ Pasture

Fc 33'

Fc 43'

33.4" 0 +98 Prop Iron

Cultivated

+20 X Drain
15' x 38' CM - 18'

+08 Rd Sign 22'
Fc 41'

+59 T.P.P.P. 20'

+39 Ent 12' x 11' CM 14'

Woods

+29 End Yard + Row 2" Trees 29'

Fc 40'

47

Rel
14-7

46

Rel
13-7

45

Rel
12-7

44

Rel
11-8

43

Rel
10-8

42

Rel
10-8

41

Rel
10-7

+82 TRAPP 25' -

+27 10" Oak 38' -

+82 X Drain 30" X 36' CM -

+07 TP 24' -

+25 End Yard Beg Lowlands

+34 T.P. 25' -

+23 Ent 15" X 20' CM 17' -

+13 End Woods -

+64 Rd Sign 16'

+00 Beg Woods 33' -

+49 TP 25' -

+30 X Fc 25' -

Waste

Scattered Trees

Pasture

Fc 20' -

Fc 20' -

+70 Beg Marsh
End Woods

Fc 20' -

Fc 18' -

Fc 18' -

Fc 17' -

+40 End Woods
Fc 12' -

54

Rel
10-9

53

Rel
9-9

52

Rel
9-10

51

Rel
10-8

50

Rel
10-10

49

Rel
10-10

48

Rel
10-8

+68 T.P.P.P. 24'

+67 G. Pole 17'

+39 Ent 10 X 20.
G.M. 13'

+09 T.P.P.P. 25'

Cultivated

+84 X 17'

+32 T.P.P.P. 25'

Cultivated

Cultivated

+58 T.P.P.P. 25'

+80 Fe Cox 18'.
End Marsh.

XII XII
XII XII

Fe 23'

61

Rd
10-9

60

Rd
9-10

59

Rd
8-9

58

Rd
8-10

57

Rd
10-9

56

Rd
10-8

55

Rd
9-9

+69 TPIPP 22' -

Fc 24'

+98 Fc Cor.

Fc 23'.

+94 TPIPP 23'.

Fc 22'.

+92 Fc Cor 22'.

+50 Beg Marsh -

+44 TPIPP 25'.

+45 Ent.

Marsh / Brush

Marsh

19 19'

+73 XPrain.

36 x 36' C.M.

Marsh

Cultivated

Cultivated

65

718

Rd
30-11
Rd
19-7

64

Rd
6-12

63

Rd
7-8

62

Rd
10-8

Waste

+39 G.Pole 29'

+03 C.Pole 20'

+03 T.P.P.P 20'

+65 Emil Berry Patch -
 +35 Beg. Berry Patch 25'

Cultivated

Cultivated

+35 End Marsh -
 +35 T.P.P.P 21'


✓

x x x x x x x

Marsh & Brush

FC 22'

Cultivated

 

Bench Levels.

Sta.	+	-	-	Elev.
B.M.	9.25	1004.99		995.74
T.P.	1.65	1004.74	1.90	1003.09
B.M.	1.06	1004.74	1.06	1003.68
T.P.	1.00	998.27	13.47	991.27
T.P.	0.19	979.06	13.40	978.87
B.M.	10.85	976.41	13.50	965.56
B.M.	13.58	988.83	1.16	975.25
T.P.	10.69	999.46	0.06	988.77
T.P.	3.46	994.19	8.73	990.73
B.M.	3.58	994.19	3.58	990.61
T.P.	0.39	981.24	13.34	980.85
T.P.	0.16	967.77	13.63	967.61
T.P.	1.09	955.69	13.17	954.60
B.M.	3.94	955.69	3.94	951.75
T.P.	10.83	966.37	0.15	955.54
T.P.	17.84	978.13	0.08	966.29
T.P.	7.46	986.22	0.37	978.76
B.M.	7.78	986.22	7.78	978.44
T.P.	0.91	974.19	12.94	973.28
T.P.	0.68	961.64	13.17	961.04
B.M.			5.55	956.09

Description

Top of Hyd. N.W. Cor. East Ave. & Minnehaha St.

Top of Brick Ent. Step N.W. Cor. Rt. Sts. 10+45
Dwelling 4814

Top Hyd. N.W. Cor. Stillwater Canal & East Ave. 20+15


Top of Monument Sts. 26+40.85

Spike in 24" Oak 50' Rt. 37+95

Spike in 12" Oak 40' Lt. Sts. 47+30 ✓
↓

Spike in P.P. 30' Lt. Sts. 54+75

Spike in G.P. 20' Rt. Sts. 65+00

 

East Avenue

Cross Sections

12/38

Sta. + K - Elev.

B.M. 2.94 998.68 995.74

0+00

93.3

Lt.

Ct.

Rt.

Top of Hyd. M.W. Cor. East Ave. & Minnehaha

0+18 { Top of curb 40' Lt.

Black top at curb.

6.8

6.4

0+30 Top of walk & curb 19' Lt.

5.8

0+39 Catch basin Lt.

{ Top

5.44

{ Intake

6.55

{ Bottom

8.8

0+59 = Bottom rubble gutter Lt.

6.1

0+42 = M.H. Rt. { Elev grate top

5.2

{ Bottom of M.H.

10.9

0+58 Side culvert Rt.

{ So End

5.7

{ No End.

5.1

Oil pump platform Rt.

{ Top

3.5

{ Ground

3.4

floor fill etc. Rt 0+95

1.84

6.7
50

5.4

4.2
50

Sta.	+	π	-	Elev.
------	---	-------	---	-------

998.68

0+18				93.2
------	--	--	--	------

0+30				93.4
------	--	--	--	------

0+33				93.4
------	--	--	--	------

T.P.	6.93	1002.67	2.94	995.74
------	------	---------	------	--------

0+63				94.3
------	--	--	--	------

0+90				95.1
------	--	--	--	------

1+00				95.3
------	--	--	--	------

+50				97.7
-----	--	--	--	------

+64	(Alley Lt.)			98.1
-----	-------------	--	--	------

+80				98.7
-----	--	--	--	------

T.P.	7.05	1006.76	2.96	999.71
------	------	---------	------	--------

2				99.3
---	--	--	--	------

+33 Side Culvert Rt.

+50				1000.3
-----	--	--	--	--------

Lt.

E

Rt.

$$\begin{array}{ccccccc} & & 929 & & 922 & & \\ \frac{71}{30} & \frac{68}{40} & \frac{58}{16} & \frac{5.5}{\cancel{5.5}} & \frac{44}{36} & \frac{42}{50} & \end{array}$$

$$\frac{62}{50} \quad \frac{57}{27} \quad \frac{68}{19} \quad \frac{61}{19} \quad \frac{57}{11} \quad \frac{53}{\cancel{5.3}} \quad \frac{63}{11} \quad \frac{44}{38} \quad \frac{42}{50}$$

$$\frac{32}{50} \quad \frac{30}{53} \quad \frac{44}{32} \quad \frac{52}{28} \quad \frac{65}{20} \quad \frac{60}{14} \quad \frac{56}{9} \quad \frac{53}{\cancel{5.3}} \quad \frac{62}{15} \quad \frac{43}{45} \quad \frac{42}{50}$$

$$\frac{52}{51} \quad \frac{24}{30} \quad \frac{22}{19} \quad \frac{22}{20} \quad \frac{20}{17} \quad \frac{29}{13} \quad \frac{56}{8} \quad \frac{84}{\cancel{84}} \quad \frac{86}{11} \quad \frac{82}{20} \quad \frac{29}{38} \quad \frac{85}{50}$$

$$\frac{45}{50} \quad \frac{37}{30} \quad \frac{73}{27} \quad \frac{20}{22} \quad \frac{89}{19} \quad \frac{81}{16} \quad \frac{76}{7} \quad \frac{76}{\cancel{76}} \quad \frac{76}{5} \quad \frac{28}{10} \quad \frac{26}{16} \quad \frac{24}{21} \quad \frac{73}{39} \quad \frac{75}{50}$$

$$\frac{45}{50} \quad \frac{37}{30} \quad \frac{60}{28} \quad \frac{25}{23} \quad \frac{87}{18} \quad \frac{28}{16} \quad \frac{73}{9} \quad \frac{72}{\cancel{72}} \quad \frac{73}{7} \quad \frac{25}{9} \quad \frac{22}{16} \quad \frac{84}{18} \quad \frac{84}{19} \quad \frac{68}{21} \quad \frac{66}{31}$$

$$\frac{44}{50} \quad \frac{37}{28} \quad \frac{20}{24} \quad \frac{70}{20} \quad \frac{56}{16} \quad \frac{52}{8} \quad \frac{50}{\cancel{50}} \quad \frac{52}{6} \quad \frac{54}{9} \quad \frac{53}{13} \quad \frac{58}{19} \quad \frac{56}{22} \quad \frac{48}{46} \quad \frac{50}{50}$$

$$\frac{57}{50} \quad \frac{47}{30} \quad \frac{50}{18} \quad \frac{46}{6} \quad \frac{6}{\cancel{41}} \quad \frac{47}{6} \quad \frac{53}{14} \quad \frac{50}{14} \quad \frac{51}{17} \quad \frac{17}{19} \quad \frac{17}{22} \quad \frac{24}{28} \quad \frac{23}{37} \quad \frac{40}{40} \quad \frac{40}{50}$$

$$\frac{39}{50} \quad \frac{25}{28} \quad \frac{58}{24} \quad \frac{59}{18} \quad \frac{47}{15} \quad \frac{43}{8} \quad \frac{40}{\cancel{40}} \quad \frac{43}{7} \quad \frac{46}{10} \quad \frac{44}{14} \quad \frac{46}{19} \quad \frac{56}{21} \quad \frac{40}{31} \quad \frac{40}{50}$$

$$\frac{86}{50} \quad \frac{73}{30} \quad \frac{86}{24} \quad \frac{57}{19} \quad \frac{53}{15} \quad \frac{27}{7} \quad \frac{75}{\cancel{75}} \quad \frac{78}{5} \quad \frac{81}{10} \quad \frac{28}{15} \quad \frac{93}{21} \quad \frac{28}{26} \quad \frac{73}{28} \quad \frac{44}{30} \quad \frac{44}{50}$$

$$\frac{50 \text{ End.}}{92}$$

$$\frac{No. \text{ End.}}{80}$$

$$\frac{86}{50} \quad \frac{28}{29} \quad \frac{20}{26} \quad \frac{88}{18} \quad \frac{23}{15} \quad \frac{67}{6} \quad \frac{65}{\cancel{65}} \quad \frac{20}{9} \quad \frac{67}{14} \quad \frac{68}{16} \quad \frac{27}{18} \quad \frac{68}{23} \quad \frac{45}{28} \quad \frac{43}{50}$$

Sta. + - Elev.

1006.76

2+54 (Drive Rt) 01.2

3 01.4

3+06 01.5

+30 (2 Reedy St Lt) 01.9

+30 (M.H.) 30 Lt.

+46 Hydrant Lt.

02.1

+50

02.1

+60

+58 Side Culvert Rt.

02.2

+70

T.P. 3.12 1008.53 1.35 1005.41

4 02.4

+80 03.0

Lt.

E

Rt.

$\frac{45}{80}$	$\frac{56}{30}$	$\frac{68}{23}$	$\frac{65}{18}$	$\frac{60}{13}$	$\frac{56}{9}$	$\frac{58}{9}$	$\frac{54}{16}$	$\frac{43}{80}$
-----------------	-----------------	-----------------	-----------------	-----------------	----------------	----------------	-----------------	-----------------

54

$\frac{73}{80}$	$\frac{59}{12}$	$\frac{55}{9}$	$\frac{53}{8}$	$\frac{55}{8}$	$\frac{54}{18}$	$\frac{72}{19}$	$\frac{69}{24}$	$\frac{53}{26}$	$\frac{47}{50}$
-----------------	-----------------	----------------	----------------	----------------	-----------------	-----------------	-----------------	-----------------	-----------------

$\frac{96}{100}$	$\frac{71}{80}$	$\frac{62}{33}$	$\frac{51}{10}$	$\frac{49}{8}$	$\frac{54}{8}$	$\frac{54}{15}$	$\frac{65}{18}$	$\frac{60}{25}$	$\frac{48}{28}$	$\frac{46}{50}$
------------------	-----------------	-----------------	-----------------	----------------	----------------	-----------------	-----------------	-----------------	-----------------	-----------------

Top of Cover
5.3Road Surface
4.9Top
963Ground Surface
6.8

$\frac{74}{50}$	$\frac{68}{28}$	$\frac{52}{18}$	$\frac{59}{15}$	$\frac{49}{8}$	$\frac{47}{9}$	$\frac{52}{9}$	$\frac{50}{14}$	$\frac{67}{18}$	$\frac{67}{23}$	$\frac{45}{26}$	$\frac{34}{50}$
-----------------	-----------------	-----------------	-----------------	----------------	----------------	----------------	-----------------	-----------------	-----------------	-----------------	-----------------

$\frac{69}{50}$	$\frac{60}{34}$	$\frac{64}{23}$	$\frac{52}{12}$	$\frac{48}{7}$	$\frac{47}{9}$	$\frac{50}{9}$	$\frac{42}{21}$	$\frac{20}{50}$	Also Grade of Ent. Rt.
-----------------	-----------------	-----------------	-----------------	----------------	----------------	----------------	-----------------	-----------------	---------------------------

No End
7.5No End
6.5

$\frac{24}{50}$	$\frac{17}{31}$	$\frac{40}{34}$	$\frac{60}{26}$	$\frac{64}{19}$	$\frac{50}{16}$	$\frac{47}{6}$	$\frac{46}{10}$	$\frac{48}{29}$	$\frac{38}{50}$
-----------------	-----------------	-----------------	-----------------	-----------------	-----------------	----------------	-----------------	-----------------	-----------------

$\frac{38}{50}$	$\frac{27}{33}$	$\frac{79}{26}$	$\frac{80}{19}$	$\frac{65}{15}$	$\frac{64}{8}$	$\frac{61}{14}$	$\frac{64}{14}$	$\frac{80}{17}$	$\frac{78}{24}$	$\frac{50}{27}$	$\frac{42}{50}$
-----------------	-----------------	-----------------	-----------------	-----------------	----------------	-----------------	-----------------	-----------------	-----------------	-----------------	-----------------

$\frac{36}{50}$	$\frac{32}{31}$	$\frac{76}{21}$	$\frac{75}{18}$	$\frac{62}{14}$	$\frac{61}{8}$	$\frac{59}{13}$	$\frac{74}{18}$	$\frac{69}{22}$	$\frac{44}{28}$	$\frac{37}{37}$	$\frac{42}{40}$	$\frac{34}{50}$
-----------------	-----------------	-----------------	-----------------	-----------------	----------------	-----------------	-----------------	-----------------	-----------------	-----------------	-----------------	-----------------

Sta. + K - Elev.

1008.53

4+80

4+94

03.4

4+93

5

03.5

+43

03.6

+73

03.6

6

03.5

+50

02.3

7

02.9

+17 C.M. Side drain

T.P. 2.54 1007.10 3.97 1004.56

+50

02.6

24.

2

Rt.

Top of water riser corer Rt 31

$\frac{37}{50}$ $\frac{40}{35}$ $\frac{54}{13}$ 51 Alley Lt.

Entr. Rt.

51 $\frac{54}{10}$ $\frac{41}{29}$ $\frac{40}{50}$

$\frac{24}{50}$ $\frac{22}{34}$ $\frac{74}{26}$ $\frac{76}{20}$ $\frac{56}{15}$ $\frac{52}{8}$ 50 $\frac{55}{11}$ $\frac{45}{24}$ $\frac{46}{37}$ $\frac{42}{50}$

$\frac{41}{50}$ $\frac{46}{28}$ $\frac{76}{25}$ $\frac{73}{18}$ $\frac{53}{14}$ 49 $\frac{55}{14}$ $\frac{66}{17}$ $\frac{61}{30}$ $\frac{45}{50}$

$\frac{66}{50}$ $\frac{63}{37}$ $\frac{69}{26}$ $\frac{77}{24}$ $\frac{79}{19}$ $\frac{53}{15}$ 49 $\frac{56}{14}$ $\frac{67}{18}$ $\frac{62}{19}$ $\frac{48}{50}$

$\frac{69}{50}$ $\frac{68}{28}$ $\frac{78}{25}$ $\frac{79}{20}$ $\frac{57}{15}$ 50 $\frac{56}{14}$ $\frac{66}{17}$ $\frac{59}{21}$ $\frac{47}{50}$

$\frac{66}{50}$ $\frac{63}{27}$ $\frac{78}{26}$ $\frac{78}{19}$ $\frac{57}{14}$ 57 $\frac{57}{14}$ $\frac{68}{18}$ $\frac{61}{22}$ $\frac{52}{26}$ $\frac{37}{40}$ $\frac{35}{50}$

$\frac{26}{50}$ $\frac{65}{41}$ $\frac{59}{29}$ $\frac{83}{25}$ $\frac{82}{19}$ $\frac{58}{14}$ 56 $\frac{60}{10}$ $\frac{59}{15}$ $\frac{73}{19}$ $\frac{73}{23}$ $\frac{43}{28}$ $\frac{37}{50}$

50 End
725

No End
815

Sec Two Entr. Rt.

57 $\frac{60}{10}$ $\frac{50}{34}$ $\frac{44}{50}$

$\frac{59}{50}$ $\frac{46}{30}$ $\frac{66}{27}$ $\frac{69}{19}$ $\frac{48}{14}$ $\frac{48}{11}$ 45 $\frac{48}{14}$ $\frac{61}{18}$ $\frac{63}{24}$ $\frac{43}{27}$ $\frac{33}{50}$

Sta. + π - Elev.

1007.10

8

02.4

+24 Side drain Rt.

Sec. Thru Entr.

+50

02.3

+74 Side drain Rt.

Sec. Thru Entr.

9

01.9

+48

01.4

+48 Side Drain Rt.

Sec. Thru Entr.

10

00.5

+60

19.8

B.M. 3.42 1007.10 3.42 1003.68

T.P. 1.97 1002.28 6.79 1000.31

Lt.

E

Rt.

41 39 42 70 70 50 47 51 48 65 64 47 43
50 44 31 27 19 14 11 15 19 25 26 50

So End
68

No End
69

47 51 44 37
11 45 50

40 40 47 72 72 51 52 48 53 50 68 67 48 43
50 44 30 26 20 18 11 11 18 18 24 29 50

So End
70

No End
71

50 54 50 44 45
11 27 37 50

51 54 53 48 73 73 56 55 52 55 53 71 68 46 37
50 46 36 31 27 19 18 10 10 16 16 19 24 28 50

91 80 73 84 83 63 62 57 61 58 95 75 57 48
50 24 29 26 19 16 11 11 10 14 78 24 28 50

So End
79

No End
80

59 80 63 56
12 20

103 93 87 84 80 72 66 21 74 81 81 56 62
50 22 29 24 19 16 10 16 19 23 26 50

105 96 88 90 89 88 76 78 73 75 74 84 83 63 56 56
50 26 26 24 20 14 10 11 10 16 21 24 26 43 50

Top of Brick wall at Entrance dwelling #812
N.W. Cor.

Sta. + x - Elev.

1002.28

+61 Side culvert Rt.

Sec thru Eutr.

11 98.9

+39 Side culvert Rt.

Sec thru Eutr.

+60 97.2

12 95.8

+50 94.0

13 91.4

+09 Side culvert Rt.

Sec thru Eutr.

T.P. 1.07 990.34 13.01 989.27

+50 98.4

14 97.3

+50 850

Lt.

E

Et.

So. End

44

No. End

51

28	26	13	07
8	21	50	

53	48	49	67	60	41	40	34	38	41	48	18	12
63	34	30	25	23	19	15	10	10	17	21	28	50
50												

So. End

60

No. End

67

48	50	30	24
7	37	50	

75	59	52	51	70	74	58	51	54	60	67	30	26
50	38	31	25	24	18	15	7	7	17	22	28	50

84	66	62	86	87	68	70	67	65	70	74	74	80	81	40	37
50	33	25	23	19	15	9	8	9	13	17	20	23	29	50	

75	80	73	107	105	87	88	83	87	87	98	58	55	53
50	34	27	23	19	16	10	10	17	17	19	23	29	50

108	104	107	130	121	113	104	106	108	115	115	78	66
50	34	26	22	18	15	10	11	17	22	24	28	50

So. End

130

No. End

139

114	116	108	104	94
10	15	30	50	

23	21	14	24	23	17	13	9	12	14	24	24	105	112
20	20	25	22	19	16	11	0	8	17	20	25	27	50

48	42	36	61	63	37	37	30	35	36	48	48	14	12	17
50	35	22	24	18	16	10	5	8	16	20	23	25	26	50

62	54	50	80	82	53	58	54	60	70	71	48	49	50
50	33	25	22	18	15	10	5	11	18	24	27	36	50

Sta + K - Elev.

990.34

15

82.6

+50

80.3

T.P.

1.12

980.47

10.99

979.35

+80

78.7

16

78.0

+50

76.0

17

74.2

+50

72.0

18

69.9

T.P.

225

968.94

13.78

966.69

+50

67.9

19

66.5

+50

65.0

+64

64.7

Lt.

E

Et.

$\frac{75}{50}$	$\frac{68}{33}$	$\frac{64}{27}$	$\frac{56}{24}$	$\frac{95}{18}$	$\frac{85}{15}$	$\frac{81}{10}$	$\frac{77}{1}$	$\frac{82}{9}$	$\frac{84}{16}$	$\frac{94}{19}$	$\frac{95}{23}$	$\frac{84}{26}$	$\frac{56}{88}$	$\frac{58}{33}$	$\frac{73}{50}$
-----------------	-----------------	-----------------	-----------------	-----------------	-----------------	-----------------	----------------	----------------	-----------------	-----------------	-----------------	-----------------	-----------------	-----------------	-----------------

$\frac{102}{50}$	$\frac{100}{35}$	$\frac{53}{26}$	$\frac{121}{23}$	$\frac{121}{20}$	$\frac{105}{16}$	$\frac{104}{11}$	$\frac{100}{10}$	$\frac{105}{8}$	$\frac{105}{16}$	$\frac{116}{19}$	$\frac{121}{24}$	$\frac{105}{27}$	$\frac{116}{34}$	$\frac{126}{50}$
------------------	------------------	-----------------	------------------	------------------	------------------	------------------	------------------	-----------------	------------------	------------------	------------------	------------------	------------------	------------------

$\frac{30}{50}$	$\frac{36}{38}$	$\frac{38}{34}$	$\frac{33}{26}$	$\frac{40}{25}$	$\frac{40}{22}$	$\frac{19}{17}$	$\frac{22}{11}$	$\frac{16}{1}$	$\frac{20}{8}$	$\frac{21}{16}$	$\frac{51}{20}$	$\frac{55}{30}$	$\frac{58}{50}$
-----------------	-----------------	-----------------	-----------------	-----------------	-----------------	-----------------	-----------------	----------------	----------------	-----------------	-----------------	-----------------	-----------------

$\frac{51}{50}$	$\frac{52}{35}$	$\frac{54}{28}$	$\frac{57}{23}$	$\frac{56}{21}$	$\frac{30}{17}$	$\frac{30}{10}$	$\frac{35}{1}$	$\frac{30}{8}$	$\frac{31}{16}$	$\frac{59}{22}$	$\frac{63}{30}$	$\frac{68}{50}$
-----------------	-----------------	-----------------	-----------------	-----------------	-----------------	-----------------	----------------	----------------	-----------------	-----------------	-----------------	-----------------

$\frac{76}{50}$	$\frac{73}{35}$	$\frac{70}{30}$	$\frac{70}{25}$	$\frac{65}{19}$	$\frac{20}{15}$	$\frac{20}{11}$	$\frac{45}{1}$	$\frac{48}{7}$	$\frac{50}{16}$	$\frac{77}{23}$	$\frac{76}{26}$	$\frac{72}{30}$	$\frac{65}{43}$	$\frac{58}{50}$
-----------------	-----------------	-----------------	-----------------	-----------------	-----------------	-----------------	----------------	----------------	-----------------	-----------------	-----------------	-----------------	-----------------	-----------------

$\frac{85}{50}$	$\frac{83}{35}$	$\frac{78}{29}$	$\frac{83}{19}$	$\frac{110}{14}$	$\frac{66}{9}$	$\frac{63}{1}$	$\frac{67}{8}$	$\frac{72}{15}$	$\frac{91}{19}$	$\frac{91}{22}$	$\frac{66}{26}$	$\frac{68}{39}$	$\frac{67}{50}$
-----------------	-----------------	-----------------	-----------------	------------------	----------------	----------------	----------------	-----------------	-----------------	-----------------	-----------------	-----------------	-----------------

$\frac{87}{50}$	$\frac{84}{34}$	$\frac{82}{27}$	$\frac{108}{24}$	$\frac{108}{19}$	$\frac{92}{15}$	$\frac{90}{10}$	$\frac{85}{1}$	$\frac{88}{8}$	$\frac{91}{15}$	$\frac{108}{19}$	$\frac{113}{23}$	$\frac{74}{27}$	$\frac{75}{33}$	$\frac{83}{50}$
-----------------	-----------------	-----------------	------------------	------------------	-----------------	-----------------	----------------	----------------	-----------------	------------------	------------------	-----------------	-----------------	-----------------

$\frac{88}{50}$	$\frac{85}{36}$	$\frac{81}{30}$	$\frac{132}{24}$	$\frac{130}{20}$	$\frac{112}{14}$	$\frac{110}{10}$	$\frac{106}{1}$	$\frac{109}{8}$	$\frac{112}{16}$	$\frac{129}{18}$	$\frac{130}{25}$	$\frac{86}{29}$	$\frac{94}{34}$	$\frac{104}{50}$
-----------------	-----------------	-----------------	------------------	------------------	------------------	------------------	-----------------	-----------------	------------------	------------------	------------------	-----------------	-----------------	------------------

$\frac{+14}{50}$	$\frac{+14}{30}$	$\frac{30}{25}$	$\frac{30}{20}$	$\frac{17}{15}$	$\frac{10}{1}$	$\frac{13}{10}$	$\frac{12}{15}$	$\frac{28}{15}$	$\frac{28}{24}$	$\frac{13}{27}$	$\frac{25}{34}$	$\frac{32}{50}$
------------------	------------------	-----------------	-----------------	-----------------	----------------	-----------------	-----------------	-----------------	-----------------	-----------------	-----------------	-----------------

$\frac{32}{30}$	$\frac{40}{38}$	$\frac{37}{28}$	$\frac{45}{24}$	$\frac{44}{18}$	$\frac{35}{16}$	$\frac{28}{14}$	$\frac{24}{1}$	$\frac{26}{13}$	$\frac{48}{19}$	$\frac{56}{29}$	$\frac{58}{50}$
-----------------	-----------------	-----------------	-----------------	-----------------	-----------------	-----------------	----------------	-----------------	-----------------	-----------------	-----------------

$\frac{57}{30}$	$\frac{12}{35}$	$\frac{60}{24}$	$\frac{58}{18}$	$\frac{117}{10}$	$\frac{39}{1}$	$\frac{38}{15}$	$\frac{71}{24}$	$\frac{78}{28}$	$\frac{61}{30}$	$\frac{84}{35}$	$\frac{84}{37}$	$\frac{74}{38}$	$\frac{65}{39}$	$\frac{50}{50}$
-----------------	-----------------	-----------------	-----------------	------------------	----------------	-----------------	-----------------	-----------------	-----------------	-----------------	-----------------	-----------------	-----------------	-----------------

$\frac{54}{50}$	$\frac{58}{44}$	$\frac{67}{37}$	$\frac{62}{20}$	$\frac{50}{16}$	$\frac{51}{13}$	$\frac{42}{1}$	$\frac{40}{18}$	$\frac{36}{21}$	$\frac{38}{26}$	$\frac{52}{33}$	$\frac{43}{40}$	$\frac{40}{50}$
-----------------	-----------------	-----------------	-----------------	-----------------	-----------------	----------------	-----------------	-----------------	-----------------	-----------------	-----------------	-----------------

Sta.	+	X	-	Elev.
		768.94		
19+55		Culvert Rt.		
				63.7
+85		Edge Pavement		
+88.5		E Paving		63.89
20+11.5		Edge Paving		63.6
B.M.	3.38	768.94	3.38	765.56
+31				63.4
+50				62.5
+75				63.8
21				64.2
+24		C.M X-Culvert		
+38				64.8
+70				65.5
22				66.5

LT

E

RT

So. End

No. End.

9.1
77 73 57 56
50 33 27 21 5.0

E Br 11.1
32
50

E Br
64 6.0 5.05 4.2 Edge Br 36
50 33 30 38 50
43

E Bring
66 62 5.3 51 67 71 54 45
50 36 21 25 34 37 50

Top of Hydrant N.W. Cor Stillwater Ave. + East Ave.

5/2 20+15
E Br Edge Br 64 68 59 55 51 57 96 96 78 71 54 53
76 70 40 26 8 15 21 30 31 33 38 45 50
82 50

103 127 122 91 66 58 51 56 97 97 85 62 59
50 44 34 25 18 7 14 19 28 30 33 43 50

154 140 70 58 51 55 10.4 10.6 87
50 34 18 14 16 25 35 50

160 155 62 52 4.7 52 11.0 11.2 11.4 10.4 10.1
50 35 16 8 13 24 32 34 44 50

120 120
16 13.5

162 156 55 46 41 45 48 10.6 11.2 54
50 33 14 8 11 16 27 34 50

168 145 51 40 34 38 48 8.4 8.6 7.5 5.3
50 34 15 9 11 17 25 30 35 50

161 130 34 28 24 27 34 6.9 6.8 3.7 1.0
50 32 16 9 11 16 22 25 34 50

Sta. + K - Elev.

968.94

T.P. 7.02 973.56 2.40 966.54

22+35 68.0

+73 69.3

23 70.1

+27 70.9

+60 71.9

24 73.2

T.P. 7.83 980.55 0.44 973.12

24

+50 74.9

25 75.9

+50 75.9

26 76.1

B.M. 5.69 980.94 5.70 975.25

Lt.

E

Rt.

$\frac{178}{50}$	$\frac{168}{33}$	$\frac{20}{18}$	$\frac{63}{14}$	$\frac{56}{10}$	$\frac{62}{10}$	$\frac{62}{15}$	$\frac{57}{20}$	$\frac{87}{22}$	$\frac{71}{28}$	$\frac{33}{31}$	$\frac{24}{38}$	$\frac{12}{50}$
------------------	------------------	-----------------	-----------------	-----------------	-----------------	-----------------	-----------------	-----------------	-----------------	-----------------	-----------------	-----------------

$\frac{180}{50}$	$\frac{157}{34}$	$\frac{57}{17}$	$\frac{47}{12}$	$\frac{43}{14}$	$\frac{51}{20}$	$\frac{70}{26}$	$\frac{63}{30}$	$\frac{23}{50}$
------------------	------------------	-----------------	-----------------	-----------------	-----------------	-----------------	-----------------	-----------------

$\frac{184}{50}$	$\frac{123}{42}$	$\frac{140}{29}$	$\frac{45}{16}$	$\frac{35}{9}$	$\frac{40}{15}$	$\frac{43}{21}$	$\frac{72}{24}$	$\frac{74}{27}$	$\frac{55}{50}$	$\frac{34}{50}$
------------------	------------------	------------------	-----------------	----------------	-----------------	-----------------	-----------------	-----------------	-----------------	-----------------

$\frac{163}{50}$	$\frac{136}{33}$	$\frac{38}{12}$	$\frac{27}{15}$	$\frac{31}{20}$	$\frac{60}{29}$	$\frac{68}{50}$
------------------	------------------	-----------------	-----------------	-----------------	-----------------	-----------------

$\frac{124}{50}$	$\frac{108}{37}$	$\frac{83}{27}$	$\frac{29}{16}$	$\frac{17}{15}$	$\frac{20}{21}$	$\frac{50}{24}$	$\frac{50}{27}$	$\frac{31}{50}$
------------------	------------------	-----------------	-----------------	-----------------	-----------------	-----------------	-----------------	-----------------

$\frac{78}{50}$	$\frac{51}{26}$	$\frac{52}{21}$	$\frac{10}{15}$	$\frac{0.9}{10}$	$\frac{0.4}{10}$
-----------------	-----------------	-----------------	-----------------	------------------	------------------

$\frac{7.8}{9}$	$\frac{7.5}{14}$	$\frac{7.6}{19}$	$\frac{7.5}{23}$	$\frac{6.7}{28}$	$\frac{6.4}{34}$	$\frac{5.3}{50}$
-----------------	------------------	------------------	------------------	------------------	------------------	------------------

$\frac{100}{50}$	$\frac{80}{43}$	$\frac{85}{34}$	$\frac{80}{26}$	$\frac{94}{25}$	$\frac{50}{18}$	$\frac{67}{14}$	$\frac{61}{9}$	$\frac{62}{15}$	$\frac{61}{20}$	$\frac{81}{24}$	$\frac{77}{29}$	$\frac{36}{38}$	$\frac{38}{50}$
------------------	-----------------	-----------------	-----------------	-----------------	-----------------	-----------------	----------------	-----------------	-----------------	-----------------	-----------------	-----------------	-----------------

$\frac{60}{50}$	$\frac{50}{34}$	$\frac{44}{26}$	$\frac{67}{25}$	$\frac{77}{19}$	$\frac{59}{15}$	$\frac{5.6}{11}$	$\frac{51}{14}$	$\frac{52}{8}$	$\frac{52}{14}$	$\frac{70}{20}$	$\frac{63}{26}$	$\frac{30}{29}$	$\frac{2.6}{50}$
-----------------	-----------------	-----------------	-----------------	-----------------	-----------------	------------------	-----------------	----------------	-----------------	-----------------	-----------------	-----------------	------------------

$\frac{54}{50}$	$\frac{47}{34}$	$\frac{41}{26}$	$\frac{66}{23}$	$\frac{66}{20}$	$\frac{54}{16}$	$\frac{51}{14}$	$\frac{50}{19}$	$\frac{68}{23}$	$\frac{68}{28}$	$\frac{37}{50}$
-----------------	-----------------	-----------------	-----------------	-----------------	-----------------	-----------------	-----------------	-----------------	-----------------	-----------------

$\frac{7.3}{50}$	$\frac{67}{44}$	$\frac{64}{34}$	$\frac{60}{25}$	$\frac{68}{23}$	$\frac{69}{19}$	$\frac{53}{15}$	$\frac{49}{17}$	$\frac{58}{17}$	$\frac{63}{20}$	$\frac{63}{26}$	$\frac{58}{28}$	$\frac{57}{50}$
------------------	-----------------	-----------------	-----------------	-----------------	-----------------	-----------------	-----------------	-----------------	-----------------	-----------------	-----------------	-----------------

Top of Monument Sta. 26+40.85

Sta + K - Elev.

980.94

26+40.85

75.9

26+40.85

75.7

T.P. 8.61 983.86 5.69 975.25

27 74.6

+50

72.5

+66

Ent. Lt Culvert

78.2

28

78.9

+50

79.8

29

80.7

+35

81.7

+65

83.2

30

T.P. 12.30 995.58 0.58 983.28

T.P. 8.15 995.58 8.15 987.43

Lt.

E

Rt.

$$\begin{array}{r} 83 \ 6.9 \\ 50 \ 34 \ 25 \end{array} \quad \begin{array}{r} 6.2 \\ 23 \end{array} \quad \begin{array}{r} 7.2 \\ 19 \end{array} \quad \begin{array}{r} 7.0 \\ 14 \end{array} \quad \begin{array}{r} 5.2 \\ 14 \end{array} \quad \begin{array}{r} 5.2 \\ 29 \end{array} \quad \begin{array}{r} 4.5 \\ 29 \end{array} \quad \begin{array}{r} 4.4 \\ 50 \end{array}$$

$$\begin{array}{r} 6.7 \\ 50 \end{array} \quad \begin{array}{r} 5.8 \\ 23 \end{array} \quad \begin{array}{r} 5.4 \\ 16 \end{array} \quad \begin{array}{r} 5.2 \\ 22 \end{array} \quad \begin{array}{r} 5.0 \\ 22 \end{array} \quad \begin{array}{r} 4.9 \\ 50 \end{array}$$

$$\begin{array}{r} 9.4 \\ 50 \end{array} \quad \begin{array}{r} 7.2 \\ 18 \end{array} \quad \begin{array}{r} 7.1 \\ 11 \end{array} \quad 7.3 \quad \begin{array}{r} 7.9 \\ 11 \end{array} \quad \begin{array}{r} 8.1 \\ 13 \end{array} \quad \begin{array}{r} 8.7 \\ 16 \end{array} \quad \begin{array}{r} 8.9 \\ 29 \end{array} \quad \begin{array}{r} 8.3 \\ 50 \end{array}$$

$$\begin{array}{r} 7.8 \\ 50 \end{array} \quad \begin{array}{r} 7.4 \\ 20 \end{array} \quad \begin{array}{r} 7.8 \\ 18 \end{array} \quad \begin{array}{r} 7.7 \\ 15 \end{array} \quad \begin{array}{r} 6.5 \\ 11 \end{array} \quad 6.4 \quad \begin{array}{r} 6.7 \\ 11 \end{array} \quad \begin{array}{r} 7.5 \\ 13 \end{array} \quad \begin{array}{r} 7.7 \\ 29 \end{array} \quad \begin{array}{r} 6.8 \\ 50 \end{array}$$

$$\begin{array}{r} 7.4 \\ 50 \end{array} \quad \begin{array}{r} 7.0 \\ 18 \end{array} \quad \begin{array}{r} 6.3 \\ 11 \end{array} \quad 8.0 \quad 6.2 \text{ West End} \quad \begin{array}{r} 7.7 \\ \text{East End} \end{array}$$

$$\begin{array}{r} 6.4 \\ 50 \end{array} \quad \begin{array}{r} 6.1 \\ 29 \end{array} \quad \begin{array}{r} 6.7 \\ 15 \end{array} \quad \begin{array}{r} 5.9 \\ 11 \end{array} \quad 5.7 \quad \begin{array}{r} 6.1 \\ 9 \end{array} \quad \begin{array}{r} 6.7 \\ 13 \end{array} \quad \begin{array}{r} 6.6 \\ 29 \end{array} \quad \begin{array}{r} 6.2 \\ 50 \end{array}$$

$$\begin{array}{r} 4.9 \\ 50 \end{array} \quad \begin{array}{r} 4.7 \\ 24 \end{array} \quad \begin{array}{r} 6.3 \\ 16 \end{array} \quad \begin{array}{r} 5.7 \\ 14 \end{array} \quad \begin{array}{r} 5.3 \\ 11 \end{array} \quad 5.0 \quad \begin{array}{r} 5.3 \\ 10 \end{array} \quad \begin{array}{r} 6.1 \\ 14 \end{array} \quad \begin{array}{r} 5.0 \\ 16 \end{array} \quad \begin{array}{r} 5.4 \\ 20 \end{array} \quad \begin{array}{r} 5.4 \\ 32 \end{array} \quad \begin{array}{r} 5.0 \\ 50 \end{array}$$

$$\begin{array}{r} 4.3 \\ 50 \end{array} \quad \begin{array}{r} 4.5 \\ 23 \end{array} \quad \begin{array}{r} 5.8 \\ 18 \end{array} \quad \begin{array}{r} 5.8 \\ 16 \end{array} \quad \begin{array}{r} 4.7 \\ 13 \end{array} \quad \begin{array}{r} 4.4 \\ 10 \end{array} \quad 4.1 \quad \begin{array}{r} 4.4 \\ 10 \end{array} \quad \begin{array}{r} 4.5 \\ 12 \end{array} \quad \begin{array}{r} 6.1 \\ 14 \end{array} \quad \begin{array}{r} 4.9 \\ 17 \end{array} \quad \begin{array}{r} 5.3 \\ 22 \end{array} \quad \begin{array}{r} 6.0 \\ 31 \end{array} \quad \begin{array}{r} 4.3 \\ 50 \end{array}$$

$$\begin{array}{r} 5.2 \\ 50 \end{array} \quad \begin{array}{r} 5.6 \\ 25 \end{array} \quad \begin{array}{r} 6.1 \\ 23 \end{array} \quad \begin{array}{r} 5.7 \\ 18 \end{array} \quad \begin{array}{r} 3.8 \\ 13 \end{array} \quad 3.2 \quad \begin{array}{r} 3.4 \\ 10 \end{array} \quad \begin{array}{r} 6.3 \\ 16 \end{array} \quad \begin{array}{r} 6.7 \\ 21 \end{array} \quad \begin{array}{r} 6.3 \\ 28 \end{array} \quad \begin{array}{r} 5.9 \\ 40 \end{array} \quad \begin{array}{r} 5.5 \\ 50 \end{array}$$

$$\begin{array}{r} 4.9 \\ 50 \end{array} \quad \begin{array}{r} 5.4 \\ 24 \end{array} \quad \begin{array}{r} 5.6 \\ 18 \end{array} \quad \begin{array}{r} 2.7 \\ 12 \end{array} \quad \begin{array}{r} 2.2 \\ 6 \end{array} \quad 2.2 \quad \begin{array}{r} 2.5 \\ 10 \end{array} \quad \begin{array}{r} 5.8 \\ 16 \end{array} \quad \begin{array}{r} 6.0 \\ 20 \end{array} \quad \begin{array}{r} 5.1 \\ 27 \end{array} \quad \begin{array}{r} 5.3 \\ 34 \end{array} \quad \begin{array}{r} 5.0 \\ 50 \end{array}$$

$$\begin{array}{r} 3.8 \\ 50 \end{array} \quad \begin{array}{r} 4.4 \\ 18 \end{array} \quad \begin{array}{r} 1.3 \\ 12 \end{array} \quad 0.7 \quad \begin{array}{r} 1.2 \\ 11 \end{array} \quad \begin{array}{r} 2.8 \\ 16 \end{array} \quad \begin{array}{r} 3.1 \\ 30 \end{array} \quad \begin{array}{r} 3.8 \\ 35 \end{array} \quad \begin{array}{r} 5.1 \\ 50 \end{array}$$

P.P. 25' Lt Stn 33+25

Sta. + T - Elev.

995.58

30+50

85.4

31

87.9

+40

89.9

+70

90.9

T.P.

10.20

1002.85

2.93

992.65

3v

92.0

+25

92.7

+50

93.3

33

94.4

+47

95.0

+61

See the End Lt.

+80

95.0

34

94.8

Lt.

E

Rt.

$$\begin{array}{cccccccccccc} 116 & 117 & 124 & 120 & 105 & 102 & 107 & 126 & 128 & 138 \\ 50 & 44 & 23 & 14 & 10 & 11 & 16 & 34 & 20 \end{array}$$

$$\begin{array}{cccc} 109 & 104 & 93 & 81 \\ 50 & 23 & 15 & 11 \end{array}$$

$$\begin{array}{cccccccc} 77 & 83 & 87 & 87 & 86 & 81 & 81 \\ 10 & 13 & 31 & 37 & 44 & 50 \end{array}$$

$$\begin{array}{cccccccccccc} 53 & 70 & 65 & 66 & 68 & 57 & 62 & 65 & 36 & 46 & 50 & 51 \\ 50 & 21 & 18 & 15 & 13 & 9 & 14 & 18 & 29 & 36 & 50 \end{array}$$

$$\begin{array}{cccccccccccc} 62 & 49 & 22 & 60 & 60 & 54 & 48 & 47 & 51 & 53 & 09 & 07 & 14 \\ 50 & 24 & 18 & 15 & 14 & 13 & 5 & 10 & 13 & 19 & 36 & 50 \end{array}$$

$$\begin{array}{cccccccccccc} 111 & 108 & 103 & 102 & 117 & 109 & 111 & 114 & 116 & 102 & 77 & 75 & 75 \\ 50 & 31 & 19 & 14 & 11 & 6 & 10 & 14 & 17 & 19 & 37 & 50 \end{array}$$

$$\begin{array}{cccccccccccc} 104 & 59 & 80 & 115 & 115 & 108 & 102 & 107 & 98 & 58 & 57 & 46 \\ 50 & 34 & 24 & 18 & 14 & 11 & 11 & 16 & 21 & 38 & 50 \end{array}$$

$$\begin{array}{cccccccccccc} 94 & 81 & 77 & 110 & 110 & 101 & 96 & 100 & 87 & 38 & 41 & 36 \\ 50 & 27 & 18 & 14 & 13 & 10 & 11 & 16 & 22 & 38 & 50 \end{array}$$

$$\begin{array}{cccccccccccc} 56 & 61 & 57 & 97 & 91 & 85 & 88 & 90 & 95 & 85 & 55 & 48 & 41 \\ 50 & 18 & 14 & 14 & 10 & 9 & 14 & 13 & 15 & 19 & 39 & 50 \end{array}$$

$$\begin{array}{cccc} 52 & 38 & 78 & 80 \\ 50 & 20 & 15 & 17 \end{array}$$

$$\begin{array}{cccccccc} 79 & 83 & 87 & 87 & 54 & 64 & 68 \\ 10 & 12 & 14 & 18 & 39 & 50 \end{array}$$

$$\begin{array}{cccc} 65 & 66 & 78 & 78 \\ 50 & 45 & 10 & 10 \end{array}$$

$$\begin{array}{cccccccc} 54 & 40 & 35 & 84 & 83 & 79 & 93 & 84 \\ 50 & 32 & 20 & 13 & 10 & 10 & 13 & 14 \end{array}$$

$$\begin{array}{cccc} 52 & 44 & 43 & 87 & 84 \\ 50 & 35 & 19 & 13 & 8 \end{array}$$

$$\begin{array}{cccc} 81 & 84 & 86 & 51 & 57 & 57 \\ 10 & 13 & 18 & 42 & 50 \end{array}$$

Sta. + X - Elev.

1002.85

34+28

94.4

+48

94.1

T.P. 5.00 998.15 9.70 993.15

+70

93.8

35

93.3

+19 X-Culvert

93.1

+65

92.6

+77

92.5

36

92.2

+33

91.8

+57

91.5

37

90.9

T.P. 4.49 994.40 8.24 989.91

+80

90.1

Lt.

E

Rt.

$\frac{76}{50}$	$\frac{67}{34}$	$\frac{70}{18}$	$\frac{87}{14}$	$\frac{87}{13}$	$\frac{88}{10}$	$\frac{85}{/}$	$\frac{90}{11}$	$\frac{94}{13}$	$\frac{94}{14}$	$\frac{82}{18}$	$\frac{84}{39}$	$\frac{88}{50}$
-----------------	-----------------	-----------------	-----------------	-----------------	-----------------	----------------	-----------------	-----------------	-----------------	-----------------	-----------------	-----------------

$\frac{96}{50}$	$\frac{104}{22}$	$\frac{109}{17}$	$\frac{107}{14}$	$\frac{93}{11}$	$\frac{88}{/}$	$\frac{92}{12}$	$\frac{108}{16}$	$\frac{113}{40}$	$\frac{110}{50}$
-----------------	------------------	------------------	------------------	-----------------	----------------	-----------------	------------------	------------------	------------------

$\frac{85}{50}$	$\frac{87}{40}$	$\frac{83}{18}$	$\frac{49}{10}$	$\frac{44}{/}$	$\frac{48}{11}$	$\frac{81}{19}$	$\frac{83}{40}$	$\frac{85}{50}$
-----------------	-----------------	-----------------	-----------------	----------------	-----------------	-----------------	-----------------	-----------------

$\frac{106}{50}$	$\frac{109}{19}$	$\frac{54}{10}$		$\frac{49}{/}$	$\frac{53}{11}$	$\frac{106}{20}$	$\frac{111}{25}$	$\frac{105}{41}$	$\frac{104}{50}$
------------------	------------------	-----------------	--	----------------	-----------------	------------------	------------------	------------------	------------------

$\frac{116}{50}$	$\frac{122}{19}$	$\frac{56}{9}$	$\frac{51}{/}$	$\frac{55}{11}$	$\frac{122}{113}$	$\frac{110}{30}$	$\frac{103}{50}$
------------------	------------------	----------------	----------------	-----------------	-------------------	------------------	------------------

$\frac{97}{50}$	$\frac{88}{24}$	$\frac{80}{17}$	$\frac{60}{10}$	$\frac{56}{/}$	$\frac{60}{11}$	$\frac{72}{16}$	$\frac{58}{19}$	$\frac{68}{42}$	$\frac{60}{50}$
-----------------	-----------------	-----------------	-----------------	----------------	-----------------	-----------------	-----------------	-----------------	-----------------

$\frac{92}{50}$	$\frac{90}{47}$	$\frac{74}{40}$	$\frac{59}{10}$	$\frac{68}{13}$	$\frac{61}{9}$	$\frac{57}{/}$	$\frac{62}{14}$	$\frac{67}{13}$	$\frac{67}{15}$	$\frac{42}{17}$	$\frac{41}{26}$	$\frac{42}{44}$	$\frac{42}{50}$
-----------------	-----------------	-----------------	-----------------	-----------------	----------------	----------------	-----------------	-----------------	-----------------	-----------------	-----------------	-----------------	-----------------

$\frac{69}{50}$	$\frac{41}{17}$	$\frac{71}{14}$	$\frac{71}{13}$	$\frac{65}{10}$	$\frac{60}{/}$	$\frac{63}{11}$	$\frac{66}{13}$	$\frac{21}{18}$	$\frac{11}{44}$	$\frac{10}{50}$
-----------------	-----------------	-----------------	-----------------	-----------------	----------------	-----------------	-----------------	-----------------	-----------------	-----------------

$\frac{75}{50}$	$\frac{51}{18}$	$\frac{75}{14}$	$\frac{75}{17}$	$\frac{68}{10}$	$\frac{64}{/}$	$\frac{67}{11}$	$\frac{72}{13}$	$\frac{72}{15}$	$\frac{34}{20}$	$\frac{15}{41}$	$\frac{69}{50}$
-----------------	-----------------	-----------------	-----------------	-----------------	----------------	-----------------	-----------------	-----------------	-----------------	-----------------	-----------------

$\frac{87}{50}$	$\frac{70}{17}$	$\frac{81}{14}$	$\frac{81}{13}$	$\frac{72}{11}$	$\frac{67}{/}$	$\frac{71}{11}$	$\frac{76}{14}$	$\frac{76}{15}$	$\frac{49}{19}$	$\frac{33}{38}$	$\frac{27}{50}$
-----------------	-----------------	-----------------	-----------------	-----------------	----------------	-----------------	-----------------	-----------------	-----------------	-----------------	-----------------

$\frac{91}{50}$	$\frac{84}{41}$	$\frac{78}{17}$	$\frac{86}{14}$	$\frac{86}{12}$	$\frac{77}{10}$	$\frac{73}{/}$	$\frac{75}{14}$	$\frac{83}{14}$	$\frac{83}{16}$	$\frac{71}{19}$	$\frac{64}{35}$	$\frac{60}{50}$
-----------------	-----------------	-----------------	-----------------	-----------------	-----------------	----------------	-----------------	-----------------	-----------------	-----------------	-----------------	-----------------

$\frac{64}{50}$	$\frac{44}{17}$	$\frac{57}{15}$	$\frac{59}{13}$	$\frac{48}{11}$	$\frac{43}{/}$	$\frac{45}{12}$	$\frac{55}{15}$	$\frac{55}{16}$	$\frac{40}{21}$	$\frac{43}{31}$	$\frac{41}{39}$	$\frac{41}{50}$
-----------------	-----------------	-----------------	-----------------	-----------------	----------------	-----------------	-----------------	-----------------	-----------------	-----------------	-----------------	-----------------

Sta.	+	π	-	Elev
		994.40		
B.M.	3.79	994.40	3.79	990.61
38				89.3
+23	X-Culvert			
+50				88.3
39				87.0
+50				84.7
T.P.	2.13	985.36	11.17	983.23
40				81.7
+50				78.4
T.P.	5.30	980.35	10.31	975.05
X +80				75.8
41				74.2
+50				70.0
T.P.	5.97	975.55	10.77	969.58
42				66.6
+50				63.8
+75				62.4

Lt.

E

Rt.

Spike in 24" oak 50' Rt. 215 37+95

$$\begin{array}{r} 81 \quad 83 \quad 86 \quad 63 \\ 50 \quad 39 \quad 18 \quad 14 \end{array} \quad \begin{array}{r} 61 \quad 49 \quad 75 \\ 10 \quad 16 \end{array} \quad \begin{array}{r} 80 \quad 76 \quad 60 \\ 23 \quad 34 \quad 50 \end{array}$$

$$\begin{array}{r} 144 \\ 103 \\ 109 \quad 78 \\ 50 \quad 37 \quad 22 \quad 14 \end{array}$$

$$\begin{array}{r} 124 \\ 92 \\ 61 \quad 55 \quad 61 \quad 62 \\ 13 \quad 16 \quad 26 \end{array} \quad \begin{array}{r} 67 \quad 53 \quad 38 \quad 21 \\ 31 \quad 35 \quad 43 \quad 50 \end{array}$$

$$\begin{array}{r} 159 \\ 50 \end{array} \quad \begin{array}{r} 126 \\ 24 \end{array} \quad \begin{array}{r} 84 \\ 15 \end{array} \quad \begin{array}{r} 79 \\ 4 \end{array} \quad \begin{array}{r} 74 \\ 74 \end{array} \quad \begin{array}{r} 67 \quad 70 \\ 13 \quad 16 \end{array} \quad \begin{array}{r} 65 \quad 00 \\ 25 \quad 37 \end{array} \quad \begin{array}{r} 114 \\ 41 \end{array} \quad \begin{array}{r} 104 \\ 50 \end{array}$$

$$\begin{array}{r} 178 \\ 50 \end{array} \quad \begin{array}{r} 123 \\ 31 \end{array} \quad \begin{array}{r} 111 \\ 20 \end{array} \quad \begin{array}{r} 116 \\ 18 \end{array} \quad \begin{array}{r} 100 \\ 5 \end{array} \quad \begin{array}{r} 97 \\ 97 \end{array} \quad \begin{array}{r} 90 \quad 61 \\ 12 \quad 25 \end{array} \quad \begin{array}{r} 15 \\ 34 \end{array} \quad \begin{array}{r} 164 \\ 48 \end{array} \quad \begin{array}{r} 180 \\ 62 \end{array} \quad \begin{array}{r} 1102 \\ 85 \end{array}$$

$$\begin{array}{r} 112 \\ 50 \end{array} \quad \begin{array}{r} 82 \\ 40 \end{array} \quad \begin{array}{r} 47 \\ 21 \end{array} \quad \begin{array}{r} 52 \\ 20 \end{array} \quad \begin{array}{r} 51 \\ 15 \end{array} \quad \begin{array}{r} 38 \\ 5 \end{array} \quad \begin{array}{r} 37 \\ 37 \end{array} \quad \begin{array}{r} 38 \quad 33 \quad 23 \\ 5 \quad 9 \quad 10 \end{array} \quad \begin{array}{r} 16 \\ 15 \end{array} \quad \begin{array}{r} 168 \\ 25 \end{array} \quad \begin{array}{r} 186 \\ 35 \end{array} \quad \begin{array}{r} 1132 \\ 67 \end{array}$$

$$\begin{array}{r} 125 \\ 50 \end{array} \quad \begin{array}{r} 113 \\ 24 \end{array} \quad \begin{array}{r} 89 \\ 18 \end{array} \quad \begin{array}{r} 71 \\ 4 \end{array} \quad \begin{array}{r} 70 \\ 70 \end{array} \quad \begin{array}{r} 68 \quad 67 \\ 8 \quad 11 \end{array} \quad \begin{array}{r} 26 \\ 17 \end{array} \quad \begin{array}{r} 124 \\ 50 \end{array}$$

$$\begin{array}{r} 127 \\ 50 \end{array} \quad \begin{array}{r} 117 \\ 38 \end{array} \quad \begin{array}{r} 100 \\ 28 \end{array} \quad \begin{array}{r} 54 \\ 13 \end{array} \quad \begin{array}{r} 46 \\ 46 \end{array} \quad \begin{array}{r} 45 \quad 54 \\ 8 \quad 11 \end{array} \quad \begin{array}{r} 54 \\ 17 \end{array} \quad \begin{array}{r} 22 \quad 00 \\ 31 \quad 41 \end{array} \quad \begin{array}{r} 113 \\ 50 \end{array}$$

$$\begin{array}{r} 146 \\ 50 \end{array} \quad \begin{array}{r} 132 \\ 30 \end{array} \quad \begin{array}{r} 110 \\ 21 \end{array} \quad \begin{array}{r} 70 \\ 11 \end{array} \quad \begin{array}{r} 62 \\ 62 \end{array} \quad \begin{array}{r} 86 \\ 8 \end{array} \quad \begin{array}{r} 88 \\ 13 \end{array} \quad \begin{array}{r} 59 \\ 18 \end{array} \quad \begin{array}{r} 24 \\ 34 \end{array} \quad \begin{array}{r} 50 \end{array}$$

$$\begin{array}{r} 170 \\ 50 \end{array} \quad \begin{array}{r} 167 \\ 27 \end{array} \quad \begin{array}{r} 108 \\ 12 \end{array} \quad \begin{array}{r} 104 \\ 10.4 \end{array} \quad \begin{array}{r} 105 \\ 8 \end{array} \quad \begin{array}{r} 145 \\ 15 \end{array} \quad \begin{array}{r} 153 \\ 30 \end{array} \quad \begin{array}{r} 141 \\ 50 \end{array}$$

$$\begin{array}{r} 131 \\ 50 \end{array} \quad \begin{array}{r} 131 \\ 21 \end{array} \quad \begin{array}{r} 94 \\ 13 \end{array} \quad \begin{array}{r} 90 \\ 90 \end{array} \quad \begin{array}{r} 94 \quad 134 \quad 139 \quad 136 \\ 9 \quad 16 \quad 19 \quad 50 \end{array}$$

$$\begin{array}{r} 84 \\ 50 \end{array} \quad \begin{array}{r} 101 \\ 30 \end{array} \quad \begin{array}{r} 111 \\ 22 \end{array} \quad \begin{array}{r} 142 \\ 17 \end{array} \quad \begin{array}{r} 119 \\ 13 \end{array} \quad \begin{array}{r} 118 \\ 18 \end{array} \quad \begin{array}{r} 123 \\ 9 \end{array} \quad \begin{array}{r} 145 \\ 16 \end{array} \quad \begin{array}{r} 148 \\ 18 \end{array} \quad \begin{array}{r} 145 \\ 50 \end{array}$$

$$\begin{array}{r} 26 \\ 50 \end{array} \quad \begin{array}{r} 45 \\ 42 \end{array} \quad \begin{array}{r} 74 \\ 25 \end{array} \quad \begin{array}{r} 145 \\ 16 \end{array} \quad \begin{array}{r} 134 \\ 13 \end{array} \quad \begin{array}{r} 132 \\ 132 \end{array} \quad \begin{array}{r} 136 \\ 10 \end{array} \quad \begin{array}{r} 145 \\ 13 \end{array} \quad \begin{array}{r} 145 \\ 15 \end{array} \quad \begin{array}{r} 132 \\ 16 \end{array} \quad \begin{array}{r} 150 \\ 26 \end{array} \quad \begin{array}{r} 148 \\ 50 \end{array}$$

151.75

Sta	+	A	-	Elev
		975.55		

43				41.1
----	--	--	--	------

+40				59.6
-----	--	--	--	------

TP	1.61	965.76	11.40	964.15
----	------	--------	-------	--------

+22				58.1
-----	--	--	--	------

44				57.0
----	--	--	--	------

+18	Entr. Lt			
-----	----------	--	--	--

+50				55.1
-----	--	--	--	------

45				53.5
----	--	--	--	------

TP	2.10	955.53	12.33	953.43
----	------	--------	-------	--------

+50				52.0
-----	--	--	--	------

46				51.1
----	--	--	--	------

+50				50.7
-----	--	--	--	------

+81	Cross Culvert			
-----	---------------	--	--	--

BM	3.78	955.53	3.78	951.75
----	------	--------	------	--------

Lt

R

Rt

$\frac{0.937}{50}$ $\frac{5.0}{34}$ $\frac{10.5}{28}$ $\frac{14.2}{17}$ $\frac{16.3}{16}$ $\frac{18.2}{13}$ $\frac{14.5}{14.5}$ $\frac{14.9}{10}$ $\frac{15.1}{13}$ $\frac{15.1}{14}$ $\frac{12.8}{18}$ $\frac{13.3}{22}$ $\frac{14.2}{30}$

$\frac{5.5}{50}$ $\frac{8.2}{26}$ $\frac{13.0}{24}$ $\frac{16.6}{16}$ $\frac{17.5}{14}$ $\frac{16.8}{11}$ $\frac{16.0}{16.0}$ $\frac{16.5}{10}$ $\frac{16.9}{11}$ $\frac{16.9}{14}$ $\frac{13.4}{20}$ $\frac{14.8}{34}$ $\frac{14.2}{50}$

$\frac{37}{50}$ $\frac{5.3}{21}$ $\frac{7.6}{20}$ $\frac{8.4}{17}$ $\frac{8.2}{11}$ $\frac{7.7}{10}$ $\frac{8.0}{13}$ $\frac{8.9}{15}$ $\frac{8.8}{19}$ $\frac{6.3}{37}$ $\frac{5.5}{43}$ $\frac{4.3}{50}$

$\frac{8.2}{50}$ $\frac{9.0}{30}$ $\frac{8.7}{21}$ $\frac{10.1}{18}$ $\frac{10.1}{17}$ $\frac{9.2}{14}$ $\frac{8.8}{10}$ $\frac{9.2}{13}$ $\frac{10.5}{15}$ $\frac{10.5}{18}$ $\frac{8.2}{37}$ $\frac{3.7}{50}$

$\frac{11.8}{50}$ $\frac{11.4}{27}$ $\frac{10.2}{17}$ $\frac{9.9}{10}$

$\frac{12.7}{50}$ $\frac{11.9}{25}$ $\frac{11.1}{19}$ $\frac{11.3}{13}$ $\frac{10.8}{8}$ $\frac{10.7}{10.7}$ $\frac{11.5}{8}$ $\frac{12.2}{11}$ $\frac{12.2}{14}$ $\frac{7.6}{19}$ $\frac{5.7}{29}$ $\frac{0.7}{50}$

$\frac{14.3}{50}$ $\frac{12.8}{26}$ $\frac{12.4}{21}$ $\frac{12.6}{14}$ $\frac{12.3}{12.3}$ $\frac{12.6}{7}$ $\frac{12.3}{8}$ $\frac{12.6}{14}$ $\frac{9.2}{18}$ $\frac{3.1}{50}$

$\frac{5.7}{50}$ $\frac{5.0}{23}$ $\frac{4.5}{18}$ $\frac{3.7}{11}$ $\frac{3.4}{4}$ $\frac{3.5}{7}$ $\frac{3.8}{8}$ $\frac{3.4}{14}$ $\frac{4.1}{14}$ $\frac{2.4}{33}$ $\frac{1.8}{50}$ $\frac{0.2}{50}$

$\frac{6.8}{50}$ $\frac{6.7}{21}$ $\frac{6.0}{18}$ $\frac{5.0}{14}$ $\frac{4.4}{4.4}$ $\frac{4.5}{6}$ $\frac{4.3}{8}$ $\frac{5.6}{14}$ $\frac{6.0}{20}$ $\frac{6.3}{31}$ $\frac{5.5}{50}$

$\frac{6.6}{50}$ $\frac{6.6}{18}$ $\frac{5.4}{15}$ $\frac{4.8}{4.8}$ $\frac{4.8}{7}$ $\frac{4.8}{8}$ $\frac{5.0}{10}$ $\frac{6.6}{15}$ $\frac{6.2}{50}$

$\frac{1.2}{7.7}$

$\frac{1.2}{7.3}$

Surface Beaver Lake Lt.

7.3

Spike in 12" Oak 40' Lt. Ho. 47+30

Sta + Δ - Elev

955.53

47 50.7

+50 50.8

48 51.8

+50 53.7

T.P. 9.25 963.77 1.06 954.47

49 56.3

+50 59.9

+85 62.7

T.P. 12.40 975.35 0.77 962.95

50 64.1

T.P. 10.53 979.91 5.97 969.38

+25 66.5

+50 69.1

T.P. 10.04 983.88 6.07 973.84

51 72.9

T.P. 9.90 987.41 6.37 977.51

+50 77.5

L+

L

R+

$\frac{70}{50}$ $\frac{71}{37}$ $\frac{66}{19}$ $\frac{52}{14}$ $\frac{48}{1}$ $\frac{51}{9}$ $\frac{66}{15}$ $\frac{69}{20}$ $\frac{67}{50}$

$\frac{60}{50}$ $\frac{51}{45}$ $\frac{57}{27}$ $\frac{63}{23}$ $\frac{60}{19}$ $\frac{48}{14}$ $\frac{47}{1}$ $\frac{51}{9}$ $\frac{68}{13}$ $\frac{67}{21}$ $\frac{66}{50}$

$\frac{57}{50}$ $\frac{50}{47}$ $\frac{59}{28}$ $\frac{63}{17}$ $\frac{39}{12}$ $\frac{37}{1}$ $\frac{43}{16}$ $\frac{68}{14}$ $\frac{68}{50}$

$\frac{52}{50}$ $\frac{42}{45}$ $\frac{41}{41}$ $\frac{58}{31}$ $\frac{57}{19}$ $\frac{19}{11}$ $\frac{18}{1}$ $\frac{21}{11}$ $\frac{65}{17}$ $\frac{68}{50}$

$\frac{82.6}{50}$ $\frac{50.5}{46}$ $\frac{92.1}{43}$ $\frac{52.9}{18}$ $\frac{56.4}{11}$ $\frac{56.3}{1}$ $\frac{55.9}{11}$ $\frac{50.5}{22}$ $\frac{50.1}{50}$

$\frac{53.5}{50}$ $\frac{54.3}{41}$ $\frac{56.4}{39}$ $\frac{56.9}{27}$ $\frac{56.9}{18}$ $\frac{59.5}{12}$ $\frac{59.9}{38}$ $\frac{58.9}{12}$ $\frac{55.7}{18}$ $\frac{55.1}{27}$ $\frac{54.1}{41}$ $\frac{54.7}{50}$ ✓

$\frac{62.1}{50}$ $\frac{63.2}{43}$ $\frac{61.7}{37}$ $\frac{61.4}{28}$ $\frac{60.0}{36}$ $\frac{60.2}{19}$ $\frac{62.3}{12}$ $\frac{62.7}{10}$ $\frac{62.1}{16}$ $\frac{61.7}{20}$ $\frac{61.3}{24}$ $\frac{61.2}{25}$ $\frac{62.8}{0.9}$ ✓

$\frac{64.7}{50}$ $\frac{65.7}{41}$ $\frac{64.9}{28}$ $\frac{63.0}{25}$ $\frac{62.7}{17}$ $\frac{63.7}{12}$ $\frac{64.0}{6}$ $\frac{64.1}{11}$ $\frac{63.6}{10}$ $\frac{63.2}{12}$ $\frac{64.2}{14}$ $\frac{64.8}{38}$ $\frac{65.3}{50}$ ✓

$\frac{68.4}{50}$ $\frac{69.4}{39}$ $\frac{68.9}{29}$ $\frac{66.3}{26}$ $\frac{67.1}{20}$ $\frac{65.4}{17}$ $\frac{65.4}{15}$ $\frac{66.1}{13}$ $\frac{66.5}{10}$ $\frac{65.9}{14}$ $\frac{65.3}{13}$ $\frac{65.9}{17}$ $\frac{69.1}{22}$ $\frac{68.6}{43}$ $\frac{67.8}{50}$ ✓

$\frac{73.0}{50}$ $\frac{72.9}{46}$ $\frac{74.7}{34}$ $\frac{73.4}{30}$ $\frac{71.1}{26}$ $\frac{70.7}{20}$ $\frac{67.9}{12}$ $\frac{68.8}{13}$ $\frac{69.1}{10}$ $\frac{68.6}{7}$ $\frac{67.9}{14}$ $\frac{72.9}{18}$ $\frac{72.0}{23}$ $\frac{72.1}{28}$ $\frac{68.2}{50}$ ✓

$\frac{78.9}{50}$ $\frac{82.4}{34}$ $\frac{82.4}{29}$ $\frac{73.9}{18}$ $\frac{72.8}{14}$ $\frac{73.4}{12}$ $\frac{73.9}{10}$ $\frac{73.4}{8}$ $\frac{72.8}{10}$ $\frac{73.2}{14}$ $\frac{74.3}{14}$ $\frac{72.8}{18}$ $\frac{70.2}{50}$ ✓

$\frac{83.8}{50}$ $\frac{86.1}{37}$ $\frac{79.8}{31}$ $\frac{77.8}{16}$ $\frac{76.8}{13}$ $\frac{77.0}{12}$ $\frac{77.5}{9}$ $\frac{77.0}{10}$ $\frac{77.8}{16}$ $\frac{80.5}{18}$ $\frac{78.9}{23}$ $\frac{78.2}{28}$ $\frac{72.6}{50}$ ✓

Sta	+	X	-	Elev
-----	---	---	---	------

987.41

52

80.5

T.P.

11.19

992.69

5.91

981.50

+50

82.7

53

83.7

+30

84.0

+66

83.3

54

82.4

+35

80.9

+76

78.8

T.P.

4.63

983.07

14.25

978.44

55

77.5

+50

Entr Lt.

74.9

56

72.2

+45

69.5

T.P.

2.95

974.02

12.00

971.07

L+

L

R+

86.2 16.6 86.0 80.1 80.4
 $\frac{12}{50} \frac{08}{27} \frac{14}{23} \frac{73}{74} \frac{70}{7}$

80.5 79.9 82.2 75.3
 $\frac{69}{12} \frac{75}{18} \frac{52}{18} \frac{121}{50}$

✓

86.6 87.4 82.9 82.4
 $\frac{61}{50} \frac{53}{22} \frac{98}{16} \frac{103}{11}$

82.7 81.9 84.6 78.2
 $\frac{100}{12} \frac{108}{18} \frac{81}{18} \frac{145}{50}$

✓

87.1 88.6 89.5 85.0 83.5
 $\frac{56}{50} \frac{41}{34} \frac{32}{21} \frac{77}{16} \frac{92}{11}$

83.7 83.4 83.2 86.7 85.7 84.2
 $\frac{50}{7} \frac{93}{11} \frac{95}{19} \frac{60}{19} \frac{70}{26} \frac{85}{50}$

✓

86.4 87.9 89.0 84.7 83.5
 $\frac{63}{50} \frac{48}{34} \frac{37}{20} \frac{50}{16} \frac{92}{12}$

84.0 83.4 84.6 87.8 87.4 86.8 86.8
 $\frac{97}{12} \frac{93}{16} \frac{81}{20} \frac{49}{20} \frac{53}{26} \frac{59}{39} \frac{59}{50}$

✓

83.8 86.0 86.8 83.7 82.8
 $\frac{89}{50} \frac{67}{27} \frac{59}{20} \frac{50}{16} \frac{89}{13}$

83.3 83.0 84.7 88.2 87.7 87.0
 $\frac{94}{11} \frac{77}{16} \frac{80}{21} \frac{45}{30} \frac{50}{50} \frac{57}{50}$

✓

81.1 83.1 84.0 81.8 81.7 82.1
 $\frac{46}{50} \frac{56}{26} \frac{27}{19} \frac{109}{15} \frac{110}{11} \frac{106}{6}$

82.4 82.1 82.8 87.1 86.8 86.5
 $\frac{103}{9} \frac{106}{14} \frac{59}{20} \frac{56}{25} \frac{59}{25} \frac{62}{50}$

✓

76.7 79.2 80.2 80.2 80.9
 $\frac{140}{50} \frac{135}{37} \frac{125}{21} \frac{125}{14} \frac{118}{10}$

80.5 81.5 82.9 85.4
 $\frac{122}{10} \frac{112}{13} \frac{98}{19} \frac{73}{50}$

✓

76.0 76.6 77.8 78.5 78.8
 $\frac{127}{50} \frac{161}{22} \frac{149}{13} \frac{142}{6} \frac{139}{12}$

78.5 78.2 79.9 83.6
 $\frac{142}{12} \frac{141}{13} \frac{128}{19} \frac{81}{50}$

✓

74.7 74.7 75.7 76.2 77.5 76.9 78.8 81.4
 $\frac{84}{50} \frac{84}{22} \frac{74}{15} \frac{64}{11} \frac{56}{12} \frac{62}{20} \frac{43}{20} \frac{17}{39} \frac{+01}{50}$

83.2
 $\frac{56}{12} \frac{54}{20} \frac{75}{39} \frac{83.2}{50}$

✓

71.2 72.3 74.6 74.9 74.2 74.6 79.2 72.6
 $\frac{115}{50} \frac{108}{31} \frac{85}{9} \frac{82}{52} \frac{59}{10} \frac{85}{15} \frac{39}{24} \frac{05}{50}$

72.2 71.7 73.5 79.5 82.3 83.8
 $\frac{109}{10} \frac{114}{19} \frac{96}{26} \frac{86}{50} \frac{08}{50} \frac{107}{75}$

✓

69.5 71.7 71.7 71.0 71.5 72.2 71.7 73.5 79.5 82.3 83.8
 $\frac{130}{50} \frac{44}{28} \frac{44}{19} \frac{121}{17} \frac{116}{17} \frac{109}{10} \frac{114}{19} \frac{96}{26} \frac{86}{50} \frac{08}{50} \frac{107}{75}$

69.5 69.6 68.8 69.3 69.5 69.1 68.9 69.8 70.8 80.8 82.4 82.7
 $\frac{135}{50} \frac{122}{41} \frac{96}{20} \frac{53}{21} \frac{135}{16} \frac{143}{12} \frac{138}{4} \frac{136}{136} \frac{140}{9} \frac{142}{12} \frac{133}{144} \frac{123}{18} \frac{23}{27} \frac{07}{35} \frac{04}{75}$

✓



✓

Sta. + π - Elev

974.02

56+75 22.7

57 26.1

T.P. 1.78 966.70 9.10 964.92

+30 64.5

+85 61.0

58 60.0

T.P. 0.72 960.03 7.39 959.31

+50 56.7

59 54.2

+50 52.3

+72 Cross Culvert

60 50.4

T.P. 0.17 956.26 3.94 956.09

+50 49.9

61 49.2

Lt

L

Rt

$$\frac{139}{50} \quad \frac{109}{48} \quad \frac{71}{34} \quad \frac{23}{21} \quad \frac{70}{15} \quad \frac{67}{9} \quad \frac{63}{8} \quad \frac{67}{10} \quad \frac{71}{13} \quad \frac{70}{14} \quad \frac{59}{29} \quad \frac{123}{40} \quad \frac{160}{40} \quad \frac{122}{25}$$

$$\frac{253}{86} \quad \frac{233}{67} \quad \frac{202}{53} \quad \frac{134}{36} \quad \frac{61}{20} \quad \frac{87}{14} \quad \frac{82}{8} \quad \frac{79}{9} \quad \frac{83}{13} \quad \frac{81}{16} \quad \frac{70}{16} \quad \frac{125}{30} \quad \frac{144}{41} \quad \frac{155}{66}$$

$$\frac{166}{61} \quad \frac{140}{40} \quad \frac{49}{21} \quad \frac{20}{17} \quad \frac{27}{10} \quad \frac{22}{9} \quad \frac{29}{15} \quad \frac{19}{15} \quad \frac{167}{28} \quad \frac{110}{23}$$

$$\frac{180}{75} \quad \frac{176}{50} \quad \frac{156}{27} \quad \frac{63}{11} \quad \frac{57}{8} \quad \frac{60}{10} \quad \frac{67}{10} \quad \frac{54}{17} \quad \frac{25}{21} \quad \frac{09}{28} \quad \frac{05}{40} \quad \frac{105}{50}$$

$$\frac{180}{50} \quad \frac{140}{27} \quad \frac{73}{10} \quad \frac{67}{10} \quad \frac{72}{18} \quad \frac{77}{25} \quad \frac{70}{35} \quad \frac{24}{50} \quad \frac{12}{50}$$

$$\frac{111}{50} \quad \frac{97}{22} \quad \frac{36}{9} \quad \frac{33}{10} \quad \frac{37}{12} \quad \frac{38}{16} \quad \frac{48}{16} \quad \frac{53}{38} \quad \frac{32}{46} \quad \frac{105}{52}$$

$$\frac{113}{50} \quad \frac{105}{23} \quad \frac{100}{18} \quad \frac{62}{10} \quad \frac{58}{11} \quad \frac{62}{16} \quad \frac{81}{16} \quad \frac{75}{43} \quad \frac{64}{50}$$

$$\frac{114}{50} \quad \frac{113}{19} \quad \frac{107}{15} \quad \frac{84}{10} \quad \frac{77}{11} \quad \frac{80}{11} \quad \frac{101}{16} \quad \frac{98}{20} \quad \frac{90}{50}$$

$$\frac{117.73}{12.3}$$

surface Reservoir

$$\frac{11.38}{11.4}$$

$$\frac{948.63}{11.4}$$

$$\frac{45}{80} \quad \frac{115}{17} \quad \frac{100}{10} \quad \frac{96}{11} \quad \frac{98}{17} \quad \frac{111}{24} \quad \frac{109}{50} \quad \frac{108}{50}$$

$$\frac{80}{50} \quad \frac{80}{37} \quad \frac{79}{15} \quad \frac{73}{12} \quad \frac{73}{9} \quad \frac{72}{9} \quad \frac{69}{12} \quad \frac{75}{14} \quad \frac{76}{22} \quad \frac{76}{38} \quad \frac{75}{50}$$

$$\frac{82}{50} \quad \frac{82}{32} \quad \frac{49}{23} \quad \frac{79}{15} \quad \frac{73}{11} \quad \frac{72}{10} \quad \frac{70}{11} \quad \frac{76}{15} \quad \frac{76}{50}$$

Sta + A - Elev

956.26

61+50 49.2

62 49.5

+50 49.8

63 50.3

+50 50.7

64 51.6

TP 9.07 965.16 0.17 956.09

+50 52.9

65 55.2

+18 56.5

+18 54.5
Going West on Maryland St

+50 57.0

LL 61.4

B.M. 9.07 956.09

L+

L

PX

$$\frac{7.9}{50} \quad \frac{7.7}{10} \quad \frac{7.2}{11} \quad \frac{7.3}{9} \quad 7.1 \quad \frac{7.1}{10} \quad \frac{7.2}{12} \quad \frac{7.6}{13} \quad \frac{7.5}{50}$$

$$\frac{8.0}{50} \quad \frac{7.9}{21} \quad \frac{8.0}{15} \quad \frac{7.0}{11} \quad 6.8 \quad \frac{7.1}{9} \quad \frac{6.8}{11} \quad \frac{7.4}{14} \quad \frac{7.4}{50}$$

$$\frac{8.0}{50} \quad \frac{7.8}{20} \quad \frac{7.5}{11} \quad \frac{6.6}{9} \quad 6.5 \quad \frac{6.7}{11} \quad \frac{7.3}{14} \quad \frac{7.1}{16} \quad \frac{6.8}{50}$$

$$\frac{8.0}{50} \quad \frac{7.6}{29} \quad \frac{7.7}{17} \quad \frac{6.2}{10} \quad 6.0 \quad \frac{6.3}{10} \quad \frac{6.2}{13} \quad \frac{6.7}{15} \quad \frac{6.1}{17} \quad \frac{6.2}{50}$$

$$\frac{7.4}{50} \quad \frac{6.8}{14} \quad \frac{5.7}{8} \quad 5.6 \quad \frac{5.9}{11} \quad \frac{6.0}{13} \quad \frac{6.5}{15} \quad \frac{6.2}{50}$$

$$\frac{5.9}{50} \quad \frac{5.7}{30} \quad \frac{5.1}{26} \quad \frac{5.8}{18} \quad \frac{5.5}{12} \quad 4.7 \quad \frac{5.1}{13} \quad \frac{6.1}{21} \quad \frac{5.8}{50}$$

$$\frac{11.1}{50} \quad \frac{12.6}{24} \quad \frac{13.1}{17} \quad \frac{12.8}{12} \quad \frac{12.3}{9} \quad 12.3 \quad \frac{12.8}{15} \quad \frac{12.6}{17} \quad \frac{14.4}{26} \quad \frac{14.5}{50}$$

$$\frac{8.5}{50} \quad \frac{10.3}{30} \quad \frac{10.0}{26} \quad \frac{10.2}{16} \quad \frac{10.6}{11} \quad 10.0 \quad \frac{10.1}{5} \quad \frac{10.0}{10} \quad \frac{10.6}{21} \quad \frac{12.4}{50}$$


$$\frac{6.8}{50} \quad \frac{8.7}{26} \quad \frac{8.7}{15} \quad 8.7 \quad \frac{9.0}{13} \quad \frac{9.8}{23} \quad \frac{10.8}{40} \quad \frac{11.8}{50}$$

$$\frac{11.7}{50} \quad \frac{10.8}{30} \quad 8.7 \quad \frac{6.6}{50}$$

$$\frac{11.7}{50} \quad \frac{9.8}{8} \quad \frac{8.3}{6} \quad 8.2 \quad \frac{7.2}{9} \quad \frac{6.6}{18} \quad \frac{5.0}{30} \quad \frac{3.4}{50}$$

$$\frac{9.5}{50} \quad \frac{6.8}{25} \quad \frac{6.1}{7} \quad \frac{3.4}{1} \quad 3.8 \quad \frac{3.4}{11} \quad \frac{3.9}{20} \quad \frac{2.9}{23} \quad \frac{2.6}{28} \quad \frac{1.6}{32} \quad \frac{1.0}{50}$$

SpKin G. Polc 20' Rt Sta 65+00

 

East Ave.

slope stakes

Sta.	+	π	-	Grade
B.M.	425	956.00		(751.75)

45				541
----	--	--	--	-----

150				53.8
-----	--	--	--	------

46				53.8
----	--	--	--	------

150				
-----	--	--	--	--

182	Culv.			
-----	-------	--	--	--

47				
----	--	--	--	--

150				53.8
-----	--	--	--	------

48				54.2
----	--	--	--	------

150				55.3
-----	--	--	--	------

T.P.	8.49	962.57	1.62	954.58
------	------	--------	------	--------

49				57.2
----	--	--	--	------

150				59.9
-----	--	--	--	------

Gr. Rod.

LH

R

RH

Sph. in 12" o.d. 40' L. 47150

$$1.9 \quad 16.8' / \begin{array}{r} 2.8 \\ -0.9 \end{array} \quad \begin{array}{r} 26 \\ -0.7 \end{array}$$

$$2.2 \quad 20.0' / \begin{array}{r} 4.7 \\ -2.5 \end{array} \quad \begin{array}{r} 40 \\ -1.8 \end{array} \quad \begin{array}{r} 71 \\ -0.9 / 16.8' \end{array}$$

$$2.2 \quad 25.0' / \begin{array}{r} 7.2 \\ -5.0 \end{array} \quad \begin{array}{r} 5.0 \\ -2.8 \end{array} \quad \begin{array}{r} 6.3 \\ -0.1 / 23.2 \end{array}$$

$$2.2 \quad 25.0' / \begin{array}{r} 7.2 \\ -5.0 \end{array} \quad \begin{array}{r} 5.3 \\ -3.1 \end{array} \quad \begin{array}{r} 7.2 \\ -5.0 / 25.0 \end{array}$$

$$21.0' / \begin{array}{r} 8.0 \\ -4.0 \end{array}$$

$$EI. \begin{array}{r} 2.7 \\ 48.3 / 21.0 \end{array}$$

$$25.0' / \begin{array}{r} 7.2 \\ -5.0 \end{array}$$

$$\begin{array}{r} 5.4 \\ -3.2 \end{array}$$

$$\begin{array}{r} 1.9 \\ -5.1 / 26.4' \end{array}$$

$$2.2 \quad 24.0' / \begin{array}{r} 6.7 \\ -4.5 \end{array} \quad \begin{array}{r} 5.3 \\ -3.1 \end{array} \quad \begin{array}{r} 8.1 \\ -5.7 / 26.1 \end{array}$$

$$1.8 \quad 23.6' / \begin{array}{r} 6.6 \\ -4.8 \end{array} \quad \begin{array}{r} 4.2 \\ -2.4 \end{array} \quad \begin{array}{r} 8.2 \\ -6.4 / 27.8' \end{array}$$

$$0.7 \quad 26.2' / \begin{array}{r} 6.3 \\ -5.6 \end{array} \quad \begin{array}{r} 6.3 \\ -1.6 \end{array} \quad \begin{array}{r} 8.0 \\ -7.3 / 29.6 \end{array}$$

$$5.7 \quad 23.8' / \begin{array}{r} 10.1 \\ -7.4 \end{array} \quad \begin{array}{r} 6.5 \\ -0.8 \end{array} \quad \begin{array}{r} 13.1 \\ -7.4 / 29.8' \end{array}$$

$$3.0 \quad 21.6' / \begin{array}{r} 6.3 \\ -3.3 \end{array} \quad \begin{array}{r} 2.0 \\ -0.0 \end{array} \quad \begin{array}{r} 7.3 \\ -0.3 / 23.6' \end{array}$$

Sta	+	π	-	Grade
B.M.		958.17		956.09

58	100			59.5
----	-----	--	--	------

	+50			57.0
--	-----	--	--	------

59				54.8
----	--	--	--	------

	+50			53.3
--	-----	--	--	------

60				52.3
----	--	--	--	------

	+50			52.0
--	-----	--	--	------

61		culv. 10.2/19.0'		
----	--	---------------------	--	--

I.P.	6.98	955.87	928.	949.87
------	------	--------	------	--------

	+50			
--	-----	--	--	--

62				
----	--	--	--	--

	+50			
--	-----	--	--	--

63				52.0
----	--	--	--	------

Gr. Rod Lt 2 Rt

Spk. in G.P. 20' Pt. 65400

$$11.3 \quad 33.0' / \begin{array}{r} 86 \\ -99 \end{array}$$

$$1.2 \quad 30.2' / \begin{array}{r} 8.8 \\ -7.6 \end{array} \quad \begin{array}{r} 15 \\ -0.3 \end{array} \quad \begin{array}{r} 3.0 \\ -18/8.6' \end{array}$$

$$3.4 \quad 26.2' / \begin{array}{r} 9.0 \\ -5.6 \end{array} \quad \begin{array}{r} 4.0 \\ -0.6 \end{array} \quad \begin{array}{r} 6.6 \\ -24/21.4' \end{array}$$

$$4.9 \quad 24.2' / \begin{array}{r} 9.5 \\ -4.6 \end{array} \quad \begin{array}{r} 6.0 \\ -1.1 \end{array} \quad \begin{array}{r} 8.2 \\ -2.3/21.6 \end{array}$$

$$5.9 \quad 23.0' / \begin{array}{r} 9.9 \\ -4.0 \end{array} \quad \begin{array}{r} 7.9 \\ -2.0 \end{array} \quad \begin{array}{r} 9.6 \\ -3.7/22.4' \end{array}$$

$$6.2 \quad 22.8' / \begin{array}{r} 10.1 \\ -3.9 \end{array} \quad \begin{array}{r} 9.0 \\ -2.8 \end{array} \quad \begin{array}{r} 9.7 \\ -3.5/22.0' \end{array}$$

$$6.2 \quad 22.6' / \begin{array}{r} 10.0 \\ -3.8 \end{array} \quad \begin{array}{r} 9.3 \\ -3.1 \end{array} \quad \begin{array}{r} 9.5 \\ -3.7/22.4' \end{array} \quad \text{Calc. - 19'}$$

$$3.9 \quad 22.6' / \begin{array}{r} 7.7 \\ -3.8 \end{array} \quad \begin{array}{r} 1.0 \\ -3.1 \end{array} \quad \begin{array}{r} 7.7 \\ -3.8/22.6 \end{array}$$

$$2.9 \quad 23.0' / \begin{array}{r} 7.7 \\ -4.0 \end{array} \quad \begin{array}{r} 6.7 \\ -2.8 \end{array} \quad \begin{array}{r} 7.3 \\ -4.4/22.2' \end{array}$$

$$3.9 \quad 22.4' / \begin{array}{r} 7.6 \\ -3.7 \end{array} \quad \begin{array}{r} 6.3 \\ -2.4 \end{array} \quad \begin{array}{r} 6.9 \\ -3.0/21.0' \end{array}$$

$$3.9 \quad 21.6' / \begin{array}{r} 7.2 \\ -3.3 \end{array} \quad \begin{array}{r} 5.9 \\ -2.0 \end{array} \quad \begin{array}{r} 6.0 \\ -2.1/19.2 \end{array}$$

5/0	+	π	-	Grade
		955.87		

63	+50			52.2
----	-----	--	--	------

64				52.8
----	--	--	--	------

	+50			53.8
--	-----	--	--	------

65				55.2
----	--	--	--	------

B.M.			-0.22	
------	--	--	-------	--

(956.09)

Gr. Eod.

Lt.

L

Rt.

3.7

$$21.0 / \frac{6.7}{-3.0}$$

$$\frac{5.4}{-1.7}$$

$$\frac{6.2}{-2.5} / 20.0$$

3.1

$$20.2 / \frac{5.7}{-2.6}$$

$$\frac{4.6}{-1.5}$$

$$\frac{5.6}{-2.5} / 20.0$$

2.1


$$18.0 / \frac{3.6}{-1.5}$$

$$\frac{3.2}{-1.1}$$

$$\frac{4.2}{-2.1} / 19.2$$

0.7

Spk. in G.P. 20' Rt. 65+00'

 

9/4/46

Alignment

East Ave Ext.
Stillwater Rd. conn.

7- Pages

Sta	Point	Δ Lt	Δ Rt
-----	-------	-------------	-------------


3 +07	P.O.T. = Proposed location of steps		
-------	-------------------------------------	--	--

2 +27.3	P.I.	0°23'±	
---------	------	--------	--

0 +00 =	Stillwater Cut Off		
---------	--------------------	--	--

9-4-76 Cloudy & Windy
 K.A.
 A.M.
 M.B.
 C.F.

43

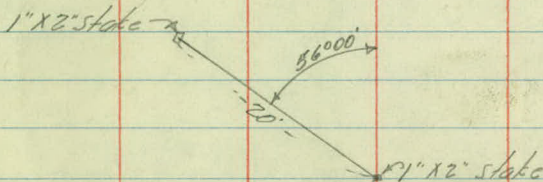



Found iron assumed
 iron on sec. line

$\uparrow \frac{1}{4} \frac{1}{4}$

ASSUMING IRON AS P.I.
 of East Ave.

(Lakewood Drive)
 91' 11" 1/2

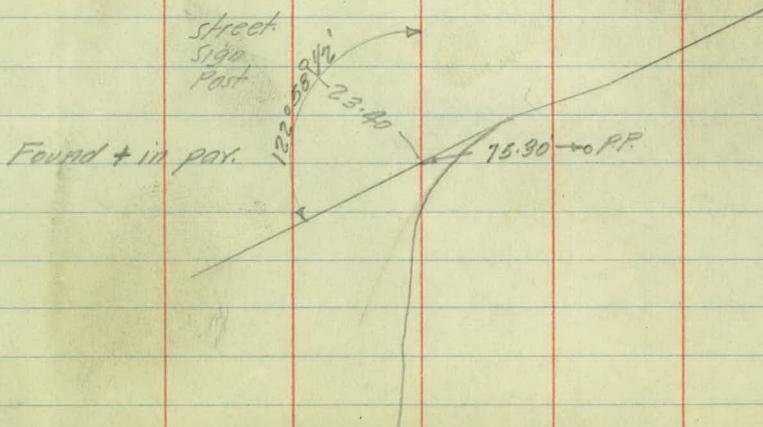

 

Topography

5

4

3

Road - 39'

+24 Cor Woods - 19'
50-60 = Trail

+56 T.P - 25'

14-23 = Trail

2

T

3-10 = Trail


+50 Trail 6-0'


1

Trail = 6-0

+48-12" x 20' Dredge & Spoil 12-8'
+50 Trail 7-5'

0

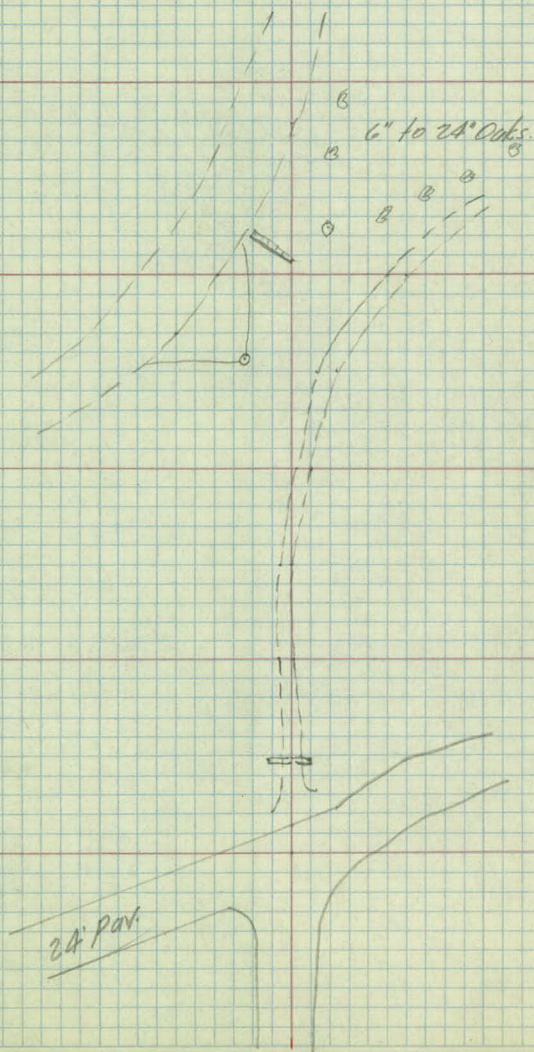

 

Levels

Sta	+	π	-	Elev
B.M.	1.28	101.28		100.00

0 100			1.28	100.00
-------	--	--	------	--------

H44			1.18	100.1
-----	--	--	------	-------

+ 48 12" X 20' IRON CURV				98.7
--------------------------	--	--	--	------

1				97.5
---	--	--	--	------

+ 50				96.3
------	--	--	--	------

2				93.5
---	--	--	--	------

+ 20				92.1
T.P.	2.47	94.26	9.49	91.79

+ 41				90.6
------	--	--	--	------

lt. & Bl.
+ 10 par sta 0100 (assume data)

4.88	2.9	2.6	2.8	F.L.
12	8		6	4.50
				8

49	41	38	40	2.8	2.8
34	18		13	17	41

54	6.2	50	5.0	4.2
20	20		12	15

14.6	11.3	9.4	7.8	6.9	5.8	5.4
50	34	17		12	24	34

16.5	13.2	11.1	9.2	8.2	6.6	6.2
50	35	19		15	36	50

Top Iron & sta 2127.3

14.4	12.8	37	21	0.2	0.0
50	14		24	43	50

Sta	+	π	-	Elev.
		94.26		

2	+70			87.8
---	-----	--	--	------

3				84.3
---	--	--	--	------

407				83.0
-----	--	--	--	------

Profile of proposed location of steps

415				81.7
-----	--	--	--	------

474				65.3
-----	--	--	--	------

T.P.	900	102.60	0.66	93.60
------	-----	--------	------	-------

B.M.			2.60	100.00
------	--	--	------	--------

(100.00)

LT

C

RT

22.1 21.5 16.1 14.5 14.3 6.8 6.5 5.1 3.2
52 44 31 21 13 2 27 50

Shoulder

23.6 23.9 22.3 21.8 10.3 10.0 8.0 6.6
50 39 33 20 4 32 50

E road

Edge road

25.8 25.7 24.0 23.2 17.1 11.8 11.3
41 26 23 18.5 8 2.5


Shoulder

24.9 25.3 23.5 23.4 15.7 12.6 11.2 9.8 9.3
44 25 22 18 4 12 36 50

E road

28.7 29 29.0 27.7 26.9 20.4 19.4 19.0
16 0 6 16 34 50

+ in pos. sta 0+00

 


1
LAKEWOOD DRIVE

Case to Maryland

Profile

13 pages

Rec. 7/21/60

 

Profile

956.09 G.P.

Sta	+	·	-	Elev.
		988.17		
BM	9.15	987.59		978.44 979.02
		982.90		982.29
BM	0.61	982.32	5.88	981.71
		969.38		969.38
B.M.	0.00	968.80	13.52	968.80
		958.91		956.74
T.P.	2.17	958.33	12.69	956.16
		961.50		957.41
B.M.	4.09	960.92	1.50	956.83

43+

0.00 61.5

+50

2.0 59.5

44

3.3 58.2

+50

4.7 56.8

45

5.9 55.6

+50

7.0 54.5

46

7.7 53.8

July 11, 1960

3

Spike in PP 30' Lt Sta 54+75

SE CORNER OF BOTTOM STEP^{HOUSE} #1075

NW CORNER OF TOP STEP HOUSE #1068

S Edge of M.H

NE Edge of Pumping Stn. 45+30 40' Lt

STA	+	Δ	-	ELV
-----	---	----------	---	-----

961.50
960.92

46+50

8.1

53.4

47

7.9

53.6

+50

8.1

53.4

48

7.9

53.6

+50

6.9

54.6

49

4.6

56.9

T.P

12.99

969.82

969.15

4.67

956.83

956.25

(956.16)

+50

9.4

60.4

+77

7.52

62.30

+96

6.90

62.92

50

5.1

64.7

FK
JL
WM
JH

July 20, 1960

4

MH

Cor Conc Ent Lt

" " " "

Sta	+	Σ	-	Elev.
		969.82		
		969.15		

50+24			3.28	66.54
-------	--	--	------	-------

+29			3.24	66.58
-----	--	--	------	-------

+43			0.88	68.94
-----	--	--	------	-------

T.P.	13.26	982.04 981.37	1.04	968.78 968.11
------	-------	------------------	------	------------------

+50			12.2	69.8
-----	--	--	------	------

51			7.6	74.4
----	--	--	-----	------

+50			3.7	78.3
-----	--	--	-----	------

+55				
-----	--	--	--	--

✓

July 20, 1960

5

End Conc Ent Ribbon 28' Rt

" " " " "

± 9' Conc Ent 32' Rt

75.33

75.90

76.57

77.54

6.71 6.14 5.47 4.50

60 49 39 29

Joint

75.26

75.42

→ 6.78 6.62

65 68

Garage floor

Sta	+	π	-	Elev
-----	---	-------	---	------

982.04
981.37

52			0.88	81.16
----	--	--	------	-------

T.P.	8.78	989.96 989.29	0.86	981.18 980.51
------	------	------------------	------	------------------

+50			6.4	83.6
-----	--	--	-----	------

53			5.4	84.6
----	--	--	-----	------

+05			5.30	84.66
-----	--	--	------	-------

+35			4.4	85.6
-----	--	--	-----	------

+50			5.4	84.6
-----	--	--	-----	------

+80			11.66	78.30
-----	--	--	-------	-------

54			7.04	82.92
----	--	--	------	-------

+50			9.26	80.70
-----	--	--	------	-------

BM	0.58	979.73 979.02	10.81	978.48
----	------	------------------	-------	--------

979.15

979.02

978.44

July 20, 1960

6

Top M H £

House 73' Lt

Garage ent Lt 85'

Spike in PP 30' Lt Sta 54+75

Sta	+	π	-	Elev
		979.73 979.02		

55			1.94	77.79
----	--	--	------	-------

+50			4.36	75.37
-----	--	--	------	-------

+80			6.16	73.57 972.86
-----	--	--	------	----------------------------

56			7.2	72.5
----	--	--	-----	------

+50			9.9	69.8
-----	--	--	-----	------

57			12.7	67.0
----	--	--	------	------

TP	0.71	967.76 967.05	12.68	967.05 966.34
----	------	------------------	-------	------------------

+50			4.1	63.7
-----	--	--	-----	------

+66			5.42	962.34 961.63
-----	--	--	------	-----------------------------

58			7.1	60.7
----	--	--	-----	------

+50			10.0	57.8
-----	--	--	------	------

59			11.8	56.0
----	--	--	------	------

July 20, 1960

7

Top MH £

612
432
180

Begin 15' fill Lt

Clean
Fill
Wanted Sign

Top MH £

Sta	+	π	-	Elev.
		967.76 967.05		
59+16		.	12.76	55.0
		958.12		955.0
TP	3.12	957.41	12.76	954.29
+50			3.4	54.7
60			4.1	54.0
+50			4.6	53.5
61			4.7	53.4
+50			4.6	53.5
62			4.2	53.9
+16			3.80	954.32 53.61
+50			4.1	54.0

£ July 20, 1960

8

Top MH £

S. Rim MH

49.1	49.0	51.0	53.1	54.0	53.6	50.7	50.4
9.0	9.1	7.1	5.0	4.1	4.5	7.4	7.7
50	44	30	21		20	26	40

Top MH £

Sta	+	π	-	Elev
		958.12 957.41		
63			3.9	54.2
+50			3.7	54.4
TP	7.80	962.08 961.37	3.84	953.57 954.28 957.11
BM	1.94	959.19 958.48	4.83	957.25 956.54 956.09
62+16			4.89	954.30 953.59 953.61
TP		967.11		954.99
59+16	12.12	966.40	4.20	959.28 954.24
57+66			4.81	962.30 961. 61+63
TP	13.63	979.92 979.21	0.82	966.29 965.58
55+80		X	5.17	78 974.75 972.86
BM			0.81	979.11 978.40 978.49
62+16	3.66	957.26		953.60 ?
61+00	{		9.45	947.81 ?
			10.60	946.66 ?

July 20, 1960

9

Spike in GP 20' Rt Sta 65+00

M H

M H

M H


Spike in PP 30' Lt Sta 54+75

M H

FL inv E

FL inv W

} 36" X Drain

 

Additional Topography

48

47

46

+63 ^{MH}
61

+34 S.E. Cor Pump Sta
51

45

+07 End Conc Ent
36

+67 SW Cor Ho
104

+445 Rtre
Gav

+15 S.E. Cor Gav-Brez Ho
125

44

+30 S.W. Cor Ho
113


43

+01 MH
E

FK
JL
WM
RL
JH

July 11, 1960

11

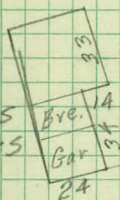

53

$$+24 \text{ L.O.} + 29 \frac{\text{Wall}}{18}$$

52

$$+47 \frac{\text{S.E. Cor Ho.}}{68} \quad +47 \frac{\text{Cor Conc Ent}}{29}$$

51

$$+50 \frac{\text{SW Cor Ho.}}{62} \\ +43 \frac{\text{Cor Conc Ent}}{32} \\ +26 \frac{\text{Conc Ribbon Ent}}{28} \quad +34 \frac{\text{2' Wall}}{35}$$

50

$$+77 \frac{\text{Cor Conc Ent}}{30}$$

$$+75 \frac{\text{SE Cor Ho}}{67}$$

$$+88 \frac{\text{SW Cor Ho}}{64}$$


49

$$+95 \frac{\text{MH}}{2}$$


48

Rock Wall

1-5-5

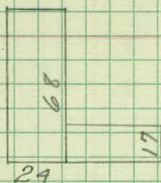


2-5-F

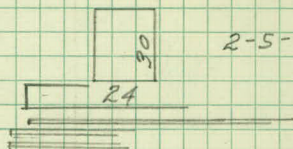

1 1/2-5-F



1-5-B

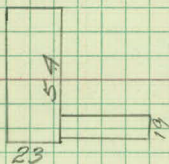

+ 45 $\frac{\text{Ent} \neq}{1+}$

55

154 $\frac{\text{Ent } 15" \times 20" \text{ CM}}{23}$

54

+30 $\frac{\text{SE Cor Ho}}{73}$


+19 $\frac{\text{Partially Used}}{\text{Ent}}$

53


+05 $\frac{\text{M II}}{2}$

July 11, 1960

13

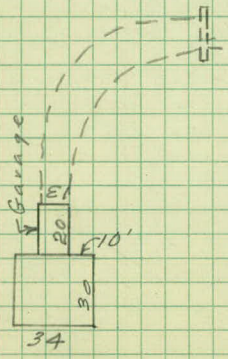

1-5-F

 


1
Beaver Lake

House Locations

Stationing same as East Ave Plan

3 pages

 

FK
AM
LC
MMc

May 27, 1954
60° Overcast, Damp

2

Locations

Sta

33+26 SW Cor Ho 90' Lt.

32+70 SW Cor Double Gar. 90' Lt.

30+73 SW Cor Ho 90' Lt.

29+85 SW Cor Ho 90' Lt.

29+10 SW Cor Ho 90' Lt.

Sta

67+90 NE Cor garage 45' Lt.

66+79 Double garage NE Cor. 35' Lt.

54+45 SE Cor Garage 180' Lt.

54+05 Range tie South side Ho Lt.

53+80 SE Cor Ho 200' Lt.

53+30 SE Cor Ho 70' Lt.

44+80 Range tie So side Ho.

44+60 SE Cor Ho 110' Lt.

Bear Lake

4

72+53 NE Cor Ho 45'

68+12 NE Cor Ho 60'