

Book # 47 - Dr. # 8

MAINTENANCE SURVEY

ARCADE STR.
AT
KELLER PKWY.
FOR
DRAINAGE.

On North Side of Lake Ger.

G. P.

S.W. Cor.

K. P.

No. 1

891.07

MAINTENANCE INVESTIGATION
SURVEY FOR DRAINAGE AT ARCADE ST.
AND KELLER PKWY. ON NORTH SIDE
OF LAKE GERVAIS.

P.J. Crone

2-17-28

2 +00

+03 House 35

+00 pitch 15

+62 House 36


1 +00

+00 & Ditch 16


+50 - 12" Vit. 57⁵ 52 Long.
+07 - 12" C.M. 76⁵


0 +00

0 +39 Rbl 18" Vit 17 50 Long.
0 -11 Rbl 18" Vit 17 to Center.

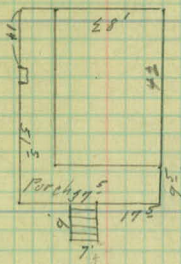

Lake

 

 

B.M.

5.70

870.90

865.20

13.80

57.60

0+00

E. Keller Parkway

6.4

64.5

1+00

6.5

64.4

1+50

5.4

65.5

T.P.

9.07

875.02

4.95

865.95

2+00

8.4

66.6

2+50

7.2

67.8

3+00

5.9

69.1

3+50

4.0

71.0

4+00

1.7

73.3

B.M.

9.82

865.20

Lt.

TOP OF N.W. COR. CONC. CURB ABUT. S. SIDE KELLAN PKY
AT ARCADE ST.

	66.9	66.6	66.7	66.3	65.6	65.1	
	7.0	7.3	7.2	7.6	5.3	5.8	
Ditch	400	300	200	150	100	50	
10.0	60.9	10.50	60.40	10.60	60.30		60.7
70	61.9						10.20 12" C.M.
		40.95	10.72				10.75
		59.95	60.18				59.95 L.F.
12.6	62.4	6.20	Windows	5.11	64.64		
10.8	64.2	6.16	Gr.		64.74		
9.5	65.5	6.20	Cellar Elev.		64.64		
7.7	67.3	7.10	Gr. Elev. Cellar	5.11	63.80		
5.7	68.3						

