

Book #55-Dr. #8

OFFICE OF COUNTY ENGINEER
RAMSEY CO. MINN.

DITCH Survey

DITCH No. 10

From..... To.....

Road Acc't. No.

Date Filed..... File.....

Plf. Ex. D.

County Ditch

No 10

Stadia

Location and Culture

Aug 1928 Lubins

Location Survey for County Ditch #10

Aug 22 - 1928

180°-00' = North Dec. 8°-05'

At 01	at Marvair St + Hoyt Ave.		
To 02		510'	180°-00'
at Wood Bridge		155	267-45
Note Bridge is 8' N of	at Hoyt Ave.		
Sta 5+00		390	178°-15'
" 1+70		208	211-12
2+90		180	176-10

At 02			
To 01		510	0°-00'
S.W. Cor. Garb.		90	16-45
SE		68	346-30
NE		31	279-10
N.W.		30	24-150
6+42		23	155-30
L. in Ditch W + So.		170	173-45
N.W. Cor Ho		140	339-00
03		338	119-52
N.E. Cor Ho		287	8-35
" " " Barn.		297	18-10
N.E. Co House X			90-35
Angle of wheelock Pkwy.			245-00
S.W. Cor Ho			213-00
" " " "			221-00

4403

To 02

L. Ditch N & E

L. Road N & E

N. W Cor Damb Gunge

SW Cor Barn *

N. E. Cor Ho *

W PKW Sign

04

338

36

40

50

790

299-52

123-00

80-00

341-30

257-40

327-00

103-56

161-18

4404

To 03

S. W Cor Ho *

N. E. " Ho *

R. Farm Bridge

N-S Fence

Cor Sot W RR to Ho

Cor N & W Fence Lumpy

Bridge

L. Ditch Sot N. W.

W PKW Sign

05

790

341-18

309-40

43-00

412 116-20

482 116-18

470 137-22

445 77-05

210 294-10

2-35 294-10

47-00

720 87-35

4405


To 04

720 267-35

Cor E-W & So Fence.	60	18-40
NE Can Hot		320-40
Cor E-W & No Fence.	380	81-05
So Edge Swamp	200	155-00

O 6	465 ¹⁰²⁰	82-30
SE Can Hot Ab.		175-01
" " House.		166-12
" " "		157-12
E Wood Bridge	705	145-52

at O 6		
To O 5	1020	262-30
Φ Lamp.	9	180-00
" "	650	283-25
" "	200	103-00
" "	700	94-15
SE Can Hot Ab.		213-30 ✓
So End Cul.	108	294-12 ✓
NW " "	114	262-50
47+68 L Ditch E-W & So.	35	40-30
44+56 L " N & E	54	160-45
E-W Fence Ramp.	75	170-00
N.E Can Celery & Ditch	200	83-05
NW " " " "	290	86-05
S.E Can House		208-35
" " " "		200-10

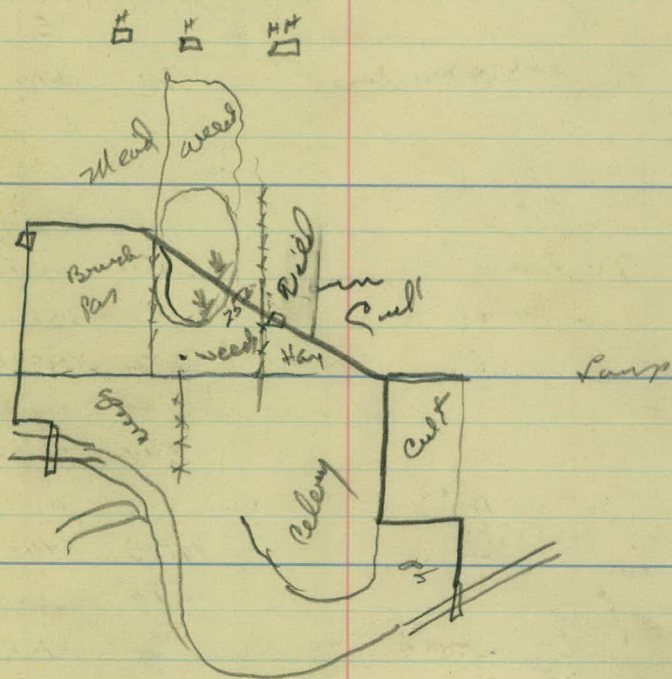

L. Dutch E+So.	707	179-35
NE Can Ro.	460	58-50
NW " Barn	410	44-20
NE " Ho	488	36-30
SE " Hot Ho.	430	33-40
L in Ciley Field	400	31-50
SW Can Ciley	425	37-20
SW Can Ciley	480	25-00
Road So to Farm	230	287-45
SE Can Ciley & N-SW Dike	440	4-10
S+WC Can Ciley	3-80	0-00
# Rd.	360	312-00
SW Can Ciley	550	1-30
SE " "	550	356-30
E Can Ciley	320	319-00
L in Ciley	282	317-00
E Can Ciley.	240	310-20
NW Can Ho	570	345-30
" " " Hot Ho	475	346-30
SE Can Ciley	440	350-15
No Can Ciley	190	323-00
NE Can Ciley	233	7-15
L in Ciley can Mand.	300	43-10

DM

HH

