

Book #65-Dr. #8

X

OFFICE OF COUNTY ENGINEER  
RAMSEY CO. MINN.

Ditch

Survey

EAST CO. LINE ROAD

From..... To.....

Road Acc't. No. 4


Date Filed. 9-20-30 File.....

9-30

LEVELS TAKEN  
IN DITCHES  
~~1400' RD NEAR~~  
~~60 RD E.~~

MAINTENANCE

E. Co. June Ref

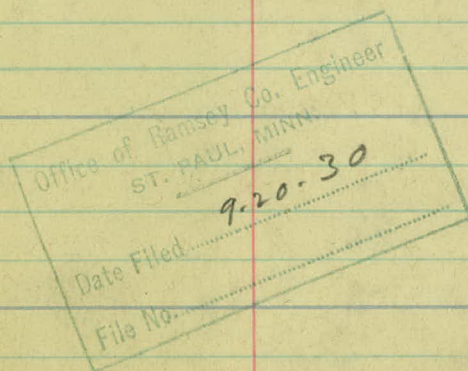

2.72 10272

- Lt 17

100.00

95.72 → 6.8 ft lowline

1 +00

2 = Δ Pt.

3

4

5

6

+48 = side Drain Elev. So. End = 95.32

7

TP 6.16 10224 6.64 9608

8

9

10

11

12

13

14

+50

Top of Hump.

15

16

3.42 100.76 4.9 97.34

17

18

+25 Int. side Rd. East.



Lt

Pt

spike in top 0 + 30.

95.9 68 4.5 98.2

95.7 7.0 5.8 96.9

95.9 6.8 6.1 96.6

95.7 7.0 6.3 96.4

95.3 7.4 7.0 95.7

95.3 7.4 7.4 95.3

Field Entrance.

95.3 7.4 7.3 95.4

95.3 6.9 6.7 95.5

95.7 6.5 6.4 95.8

96.2 6.0 6.2 96.0

96.2 6.0 6.2 96.0

96.0 6.2 6.6 95.6

96.0 6.2 6.3 95.9

95.6 6.6 6.6 95.6

96.0 6.2 6.3 95.9

95.6 6.6 6.3 95.9

94.9 7.3 7.3 94.9

94.4 6.4 6.3 94.5

92.6 8.2 8.2 92.6

90.4 10.4

