

Book # 97-Dr^y 8

OFFICE OF COUNTY ENGINEER
RAMSEY CO. MINN.

GRAVEL PIT Survey

WHEELOCK PKWY. & WATER DEPT. R.W.

From..... To.....

Road Acc't. No.

Date Filed.....

File 8

6/6/35

Pirtall
Skoglund
Bell
Goldberg

Measurements at Prop. Pt.
Wheelock Pky & W. W. R/W

~~E~~

+78 Test Ho
56

+60 Cor Fdn
148

5

4


3

2

1

0

Intersection W. Pky and E. W.W./R/W

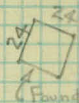

South

E. Water Dept. R/W

Wheeler Parkway

10+00 End Low Area Left

9

8


7

+60 Test Ho.
67

+15 Test Ho.
38-65

6

5

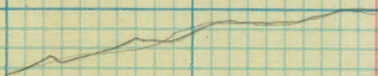

E. Water Dept. RW 7

Test Ho.

902

0

1

2

3

W.S. 900.00