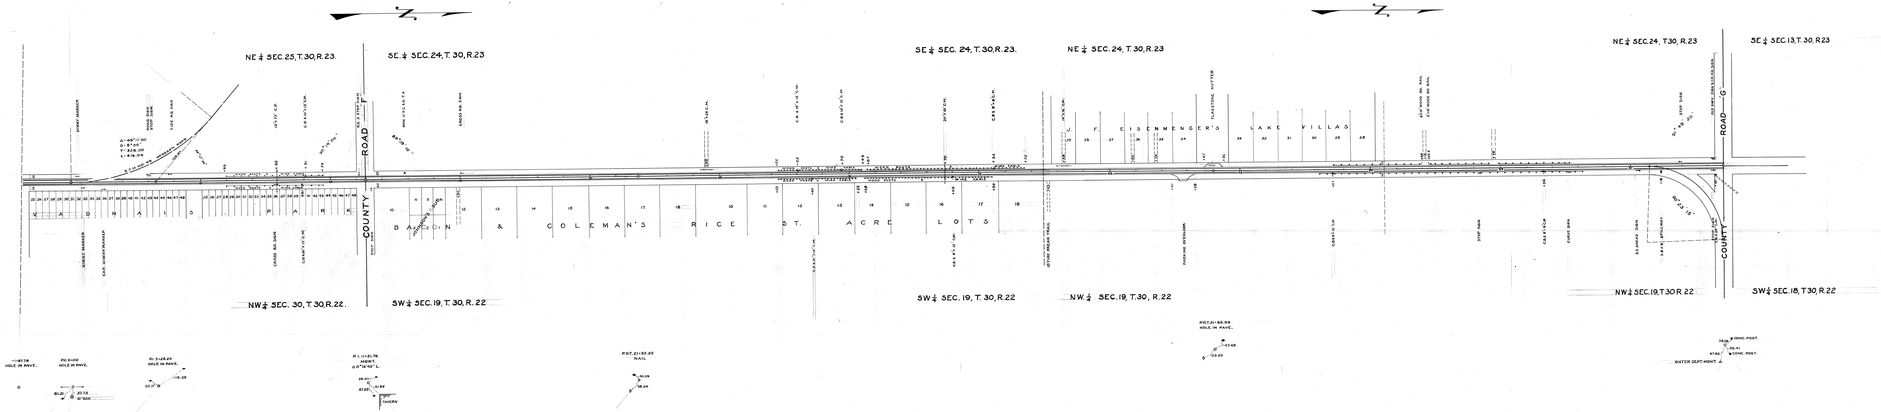
NE ¼ SEC. 25, T. 30, R. 23.
SE. ¼ SEC. 24, T. 30, R. 23
SE ¼ SEC. 24, T. 30, R. 23.
NE ¼ SEC. 24, T. 30, R. 23
NE ¼ SEC. 24, T. 30, R. 23
SE ¼ SEC. 13, T. 30, R. 23
COUNTY ROAD
COUNTY ROAD
B A G G O N & C O L E M A N ' S R I C E D T. A C R E L O T S
F. EISENMENGER'S LAKE VILLAS
NW ¼ SEC. 30, T. 30, R. 22.
SW ¼ SEC. 19, T. 30, R. 22
SW ¼ SEC. 19, T. 30, R. 22
N.W. ¼ SEC. 19, T. 30, R. 22
NW ¼ SEC. 19, T. 30 R. 22
SW ¼ SEC. 18, T. 30, R. 22